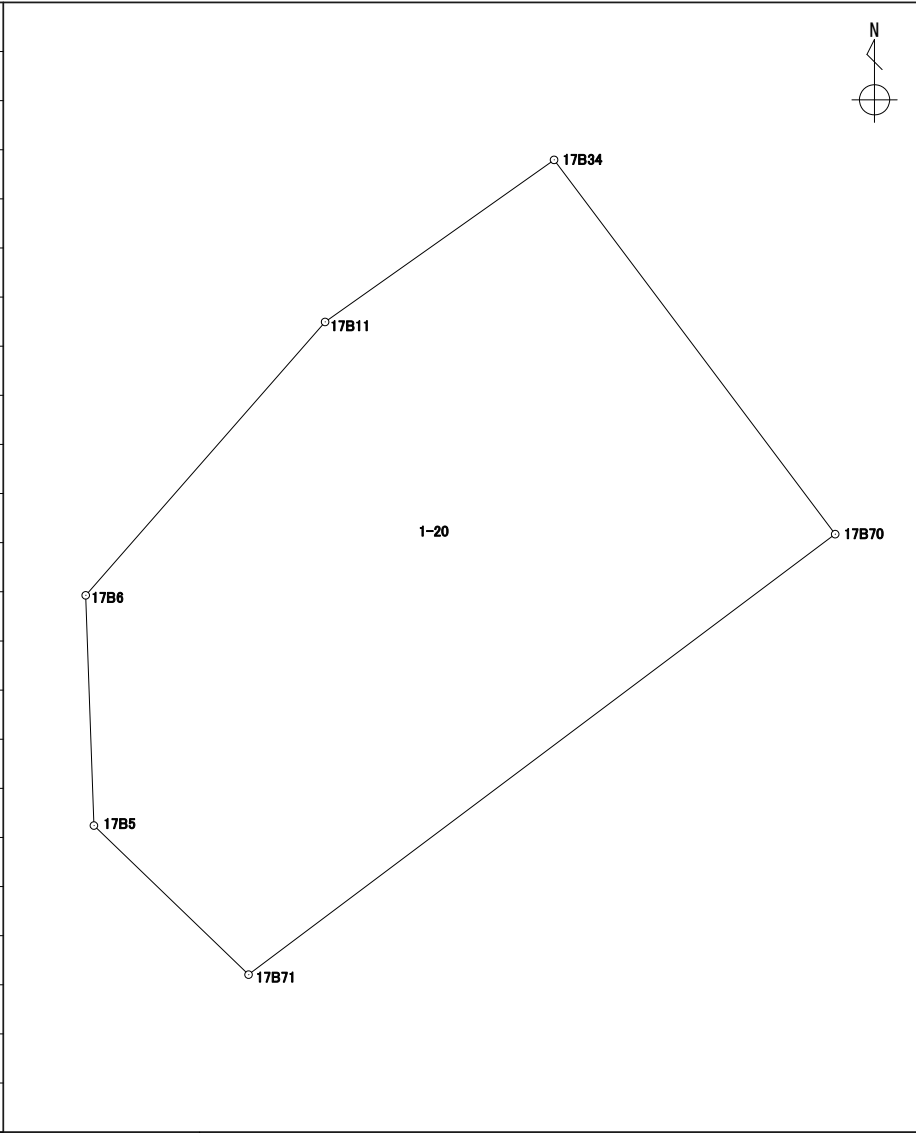
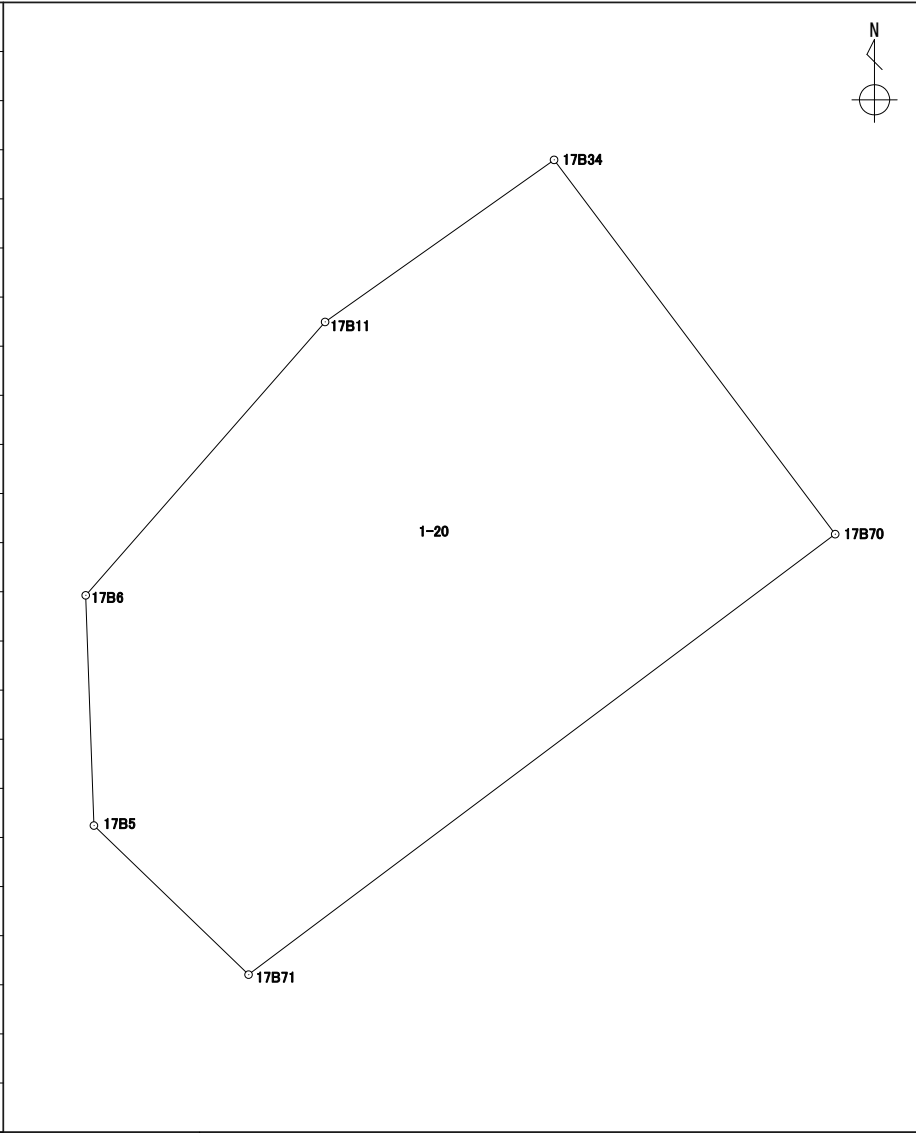


座標面積計算書

世界測地系 (測地成果2011)

地番 1-20

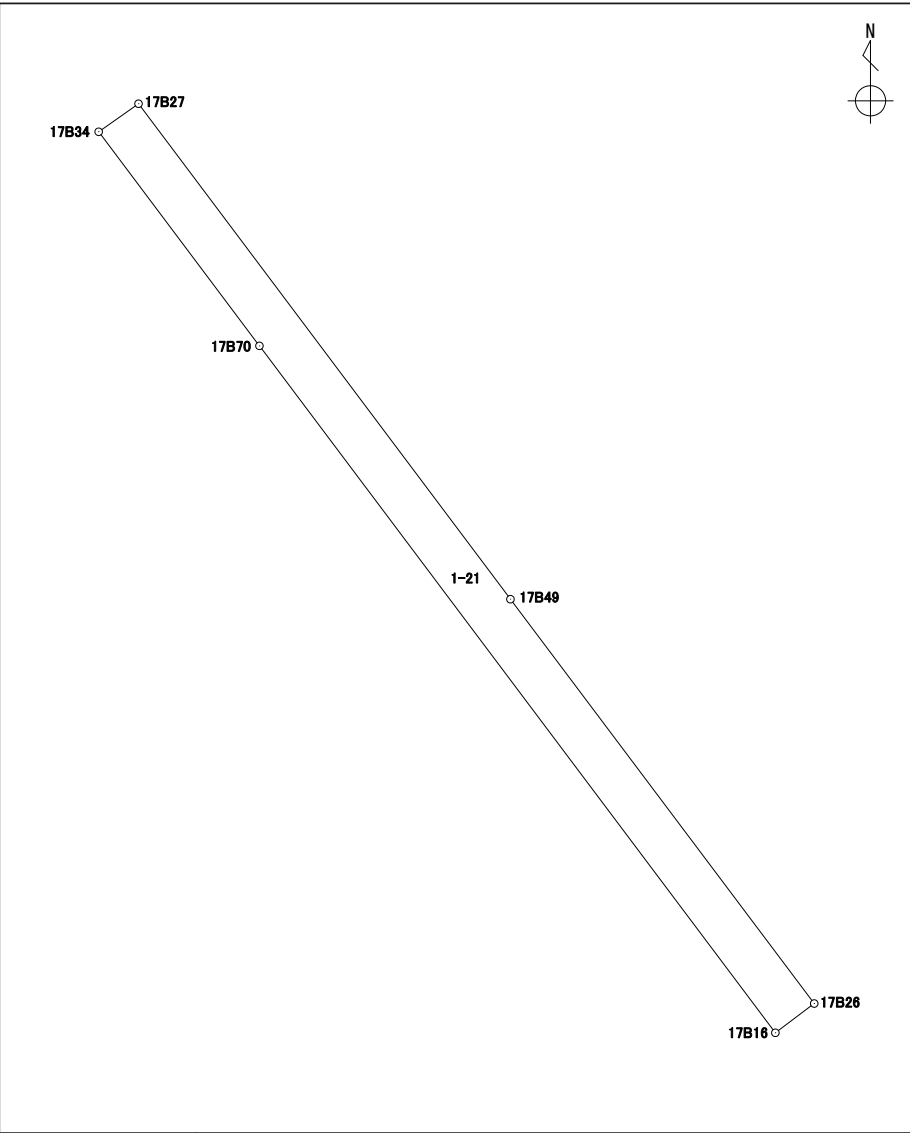
| 境界点 | X | Y | 辺長 | 方向角 | 備考 |  | | | |
|-----------------------------------|-----------|------------|--------|--------------|-------|--|--|--|--|
| 17B5 | 43377.743 | -67633.657 | 3.729 | 133° 56' 46" | | | |  | |
| 17B71 | 43375.155 | -67630.972 | 12.737 | 53° 06' 11" | | | | | |
| 17B70 | 43382.802 | -67620.786 | 8.127 | 323° 05' 16" | | | | | |
| 17B34 | 43389.300 | -67625.667 | 4.871 | 234° 42' 40" | | | | | |
| 17B11 | 43386.486 | -67629.643 | 6.309 | 221° 12' 54" | | | | | |
| 17B6 | 43381.740 | -67633.800 | 3.999 | 177° 57' 04" | | | | | |
| | | | | | | | | | |
| | | | | | | | | | |
| 面積算出公式 | | | 面積 | 97.9916395 | 街区一画地 | 17-保14 | | | |
| $A=1/2 \sum X_n(Y_{n+1}-Y_{n-1})$ | | | 地積 | 97.99 | | | | | |

座標面積計算書

世界測地系 (測地成果2011)

| | |
|----|------|
| 地番 | 1-21 |
|----|------|

| 境界点 | X | Y | 辺長 | 方向角 | 備考 |
|-------|-----------|------------|--------|--------------|----|
| 17B34 | 43389.300 | -67625.667 | 1.479 | 54° 50' 58" | |
| 17B27 | 43390.152 | -67624.457 | 18.808 | 143° 06' 10" | |
| 17B49 | 43375.111 | -67613.165 | 15.353 | 143° 04' 40" | |
| 17B26 | 43362.837 | -67603.942 | 1.476 | 233° 02' 13" | |
| 17B16 | 43361.949 | -67605.122 | 26.080 | 323° 05' 15" | |
| 17B70 | 43382.802 | -67620.786 | 8.127 | 323° 05' 16" | |
| | | | | | |
| | | | | | |
| | | | | |
|---------------------------------------|----|------------|-------|-------|
| 面積算出公式 | 面積 | 50.4620570 | 街区一画地 | 17-11 |
| $A=1/2 \sum X_n(Y_{(n+1)}-Y_{(n-1)})$ | 地積 | 50.46 | | |

座標面積計算書

世界測地系 (測地成果2011)

地番 1-22

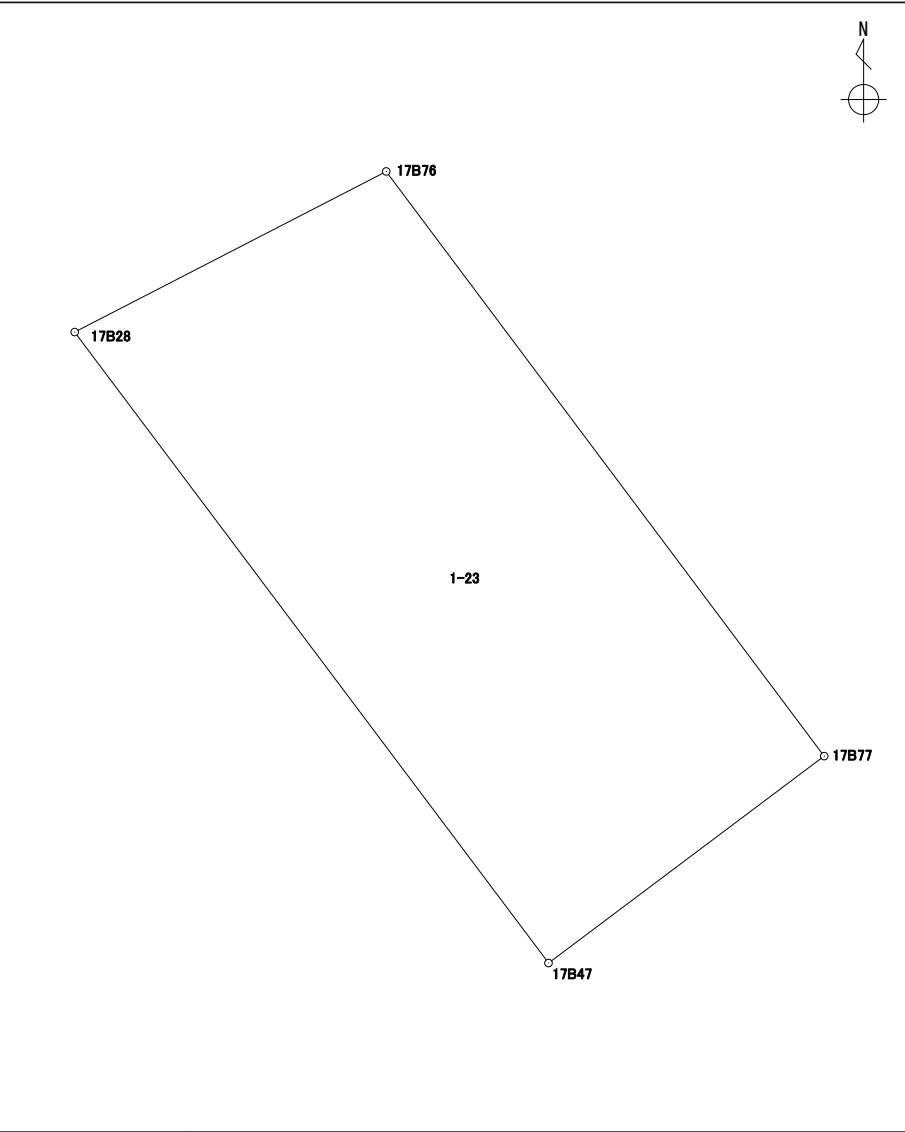
| 境界点 | X | Y | 辺長 | 方向角 | 備考 | | |
|---------------------------------------|-----------|------------|--------|--------------|-------|--|--|
| 17B28 | 43395.601 | -67614.728 | 17.324 | 143° 05' 25" | | <div style="text-align: right; margin-bottom: 10px;"> </div> | |
| 17B47 | 43381.749 | -67604.324 | 4.542 | 231° 53' 02" | | | |
| 17B48 | 43378.945 | -67607.898 | 6.514 | 233° 56' 53" | | | |
| 17B49 | 43375.111 | -67613.165 | 18.808 | 323° 06' 10" | | | |
| 17B27 | 43390.152 | -67624.457 | 2.704 | 54° 37' 03" | | | |
| 17B12 | 43391.718 | -67622.252 | 8.466 | 62° 42' 09" | | | |
| | | | | | | | |
| | | | | | | | |
| 面積算出公式 | | | 面積 | 201.8389010 | 街区一画地 | 17-16 | |
| $A=1/2 \sum X_n(Y_{(n+1)}-Y_{(n-1)})$ | | | 地積 | 201.83 | | | |

座標面積計算書

世界測地系 (測地成果2011)

| | |
|----|------|
| 地番 | 1-23 |
|----|------|

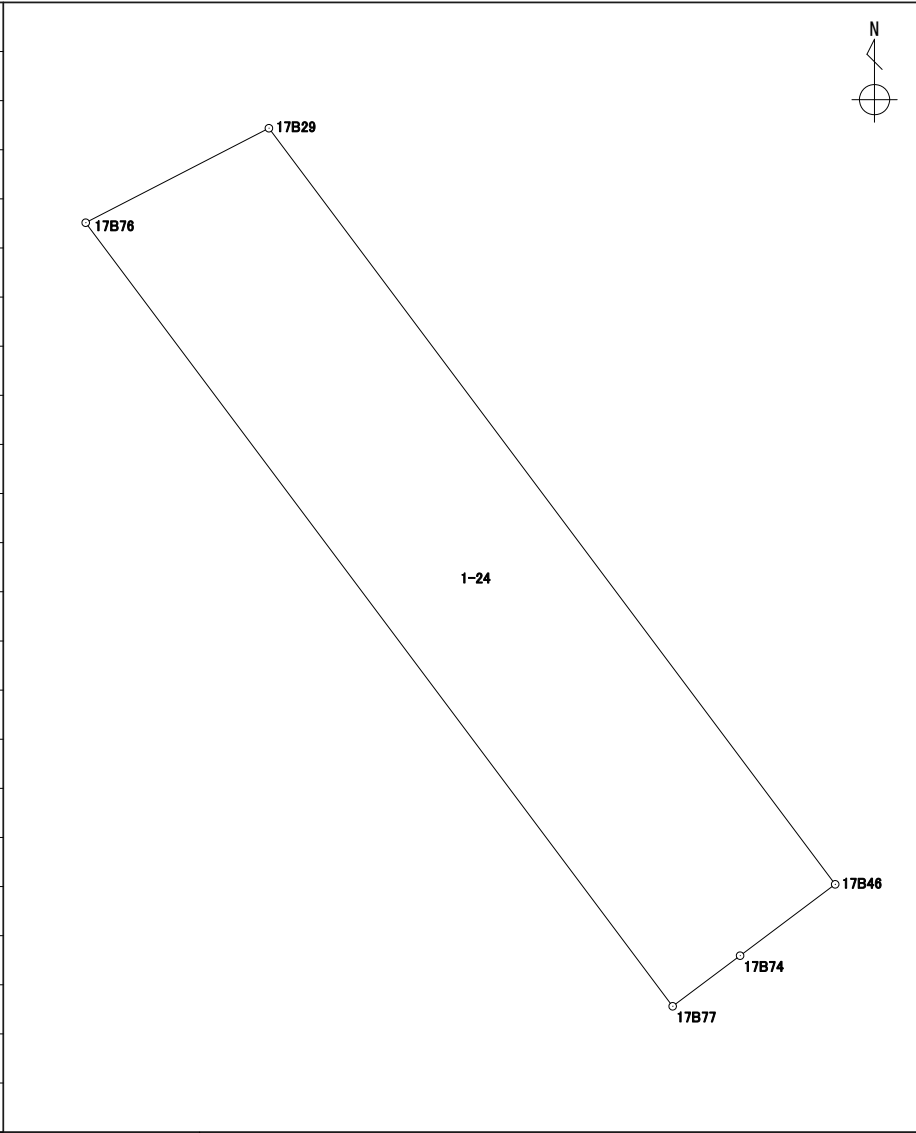
| 境界点 | X | Y | 辺長 | 方向角 | 備考 |
|--|-----------|------------|--------|--------------|-------|
| 17B76 | 43399.127 | -67607.888 | 16.039 | 143° 09' 31" | |
| 17B77 | 43386.291 | -67598.271 | 7.567 | 233° 06' 59" | |
| 17B47 | 43381.749 | -67604.324 | 17.324 | 323° 05' 25" | |
| 17B28 | 43395.601 | -67614.728 | 7.695 | 62° 43' 44" | |
| | | | | | |
| | | | | | |
| 面積算出公式 | | | 面 積 | 126.4044530 | 街区一画地 |
| $A=1/2 \sum X_n(Y_{n+1})-Y_n(X_{n+1})$ | | | 地 積 | 126.40 | 17-17 |



座標面積計算書

世界測地系 (測地成果2011)

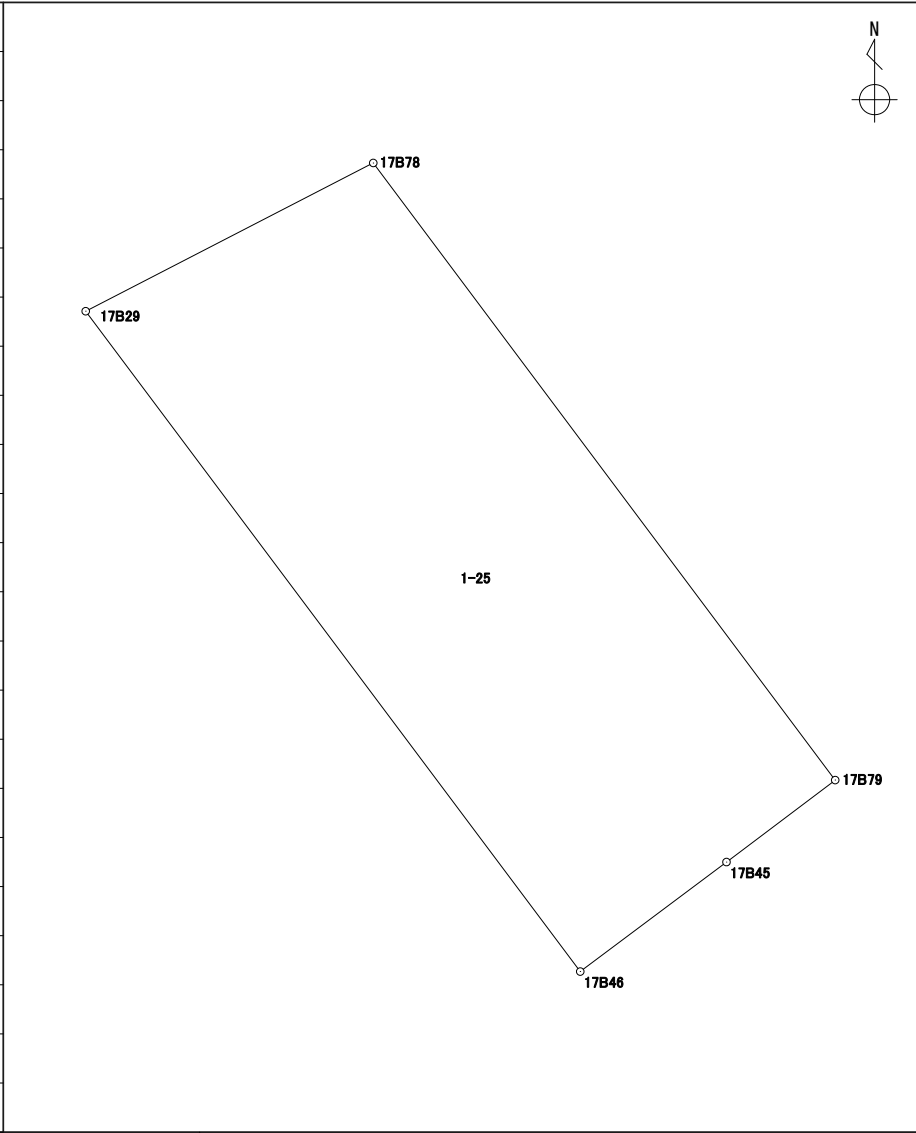
地番 1-24

| 境界点 | X | Y | 辺長 | 方向角 | 備考 |  | | | |
|-----------------------------------|-----------|------------|--------|--------------|-------|--|--|--------|--|
| 17B29 | 43400.675 | -67604.886 | 3.377 | 242° 43' 19" | | | | | |
| 17B76 | 43399.127 | -67607.888 | 16.039 | 143° 09' 31" | | | | | |
| 17B77 | 43386.291 | -67598.271 | 1.381 | 53° 07' 19" | | | | | |
| 17B74 | 43387.120 | -67597.166 | 1.947 | 53° 07' 06" | | | | | |
| 17B46 | 43388.289 | -67595.608 | 15.475 | 323° 09' 51" | | | | | |
| | | | | | | | | | |
| | | | | | | | | | |
| 面積算出公式 | | | 面積 | 52.4711565 | 街区一画地 | | | 17-保11 | |
| $A=1/2 \sum X_n(Y_{n+1}-Y_{n-1})$ | | | 地積 | 52.47 | | | | | |

座標面積計算書

世界測地系 (測地成果2011)

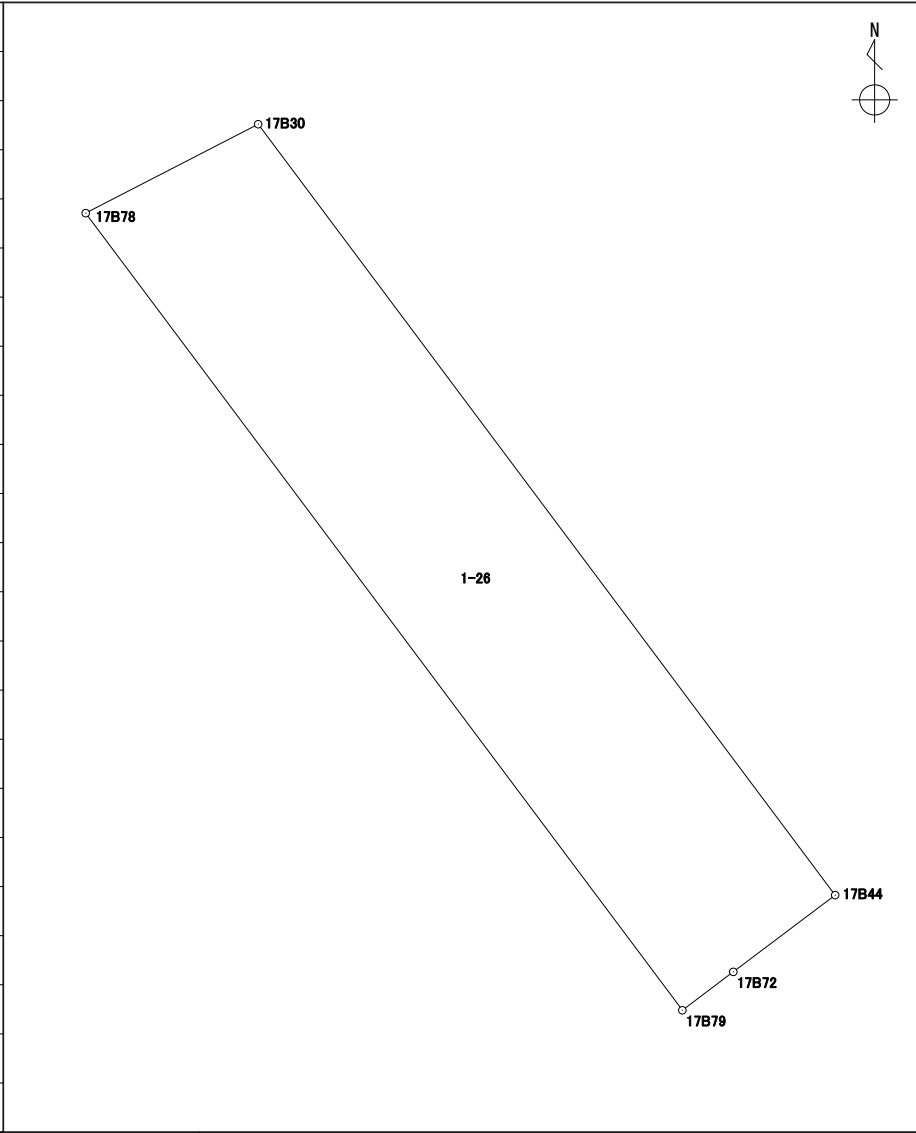
地番 1-25

| 境界点 | X | Y | 辺長 | 方向角 | 備考 |  | | | |
|-----------------------------------|-----------|------------|--------|--------------|-------|--|--|-------|--|
| 17B78 | 43403.456 | -67599.491 | 14.460 | 143° 10' 51" | | | | | |
| 17B79 | 43391.880 | -67590.825 | 2.553 | 232° 59' 28" | | | | | |
| 17B45 | 43390.343 | -67592.864 | 3.427 | 233° 11' 01" | | | | | |
| 17B46 | 43388.289 | -67595.608 | 15.475 | 323° 09' 51" | | | | | |
| 17B29 | 43400.675 | -67604.886 | 6.069 | 62° 43' 48" | | | | | |
| | | | | | | | | | |
| | | | | | | | | | |
| 面積算出公式 | | | 面積 | 89.5708120 | 街区一画地 | | | 17-18 | |
| $A=1/2 \sum X_n(Y_{n+1}-Y_{n-1})$ | | | 地積 | 89.57 | | | | | |

座標面積計算書

世界測地系 (測地成果2011)

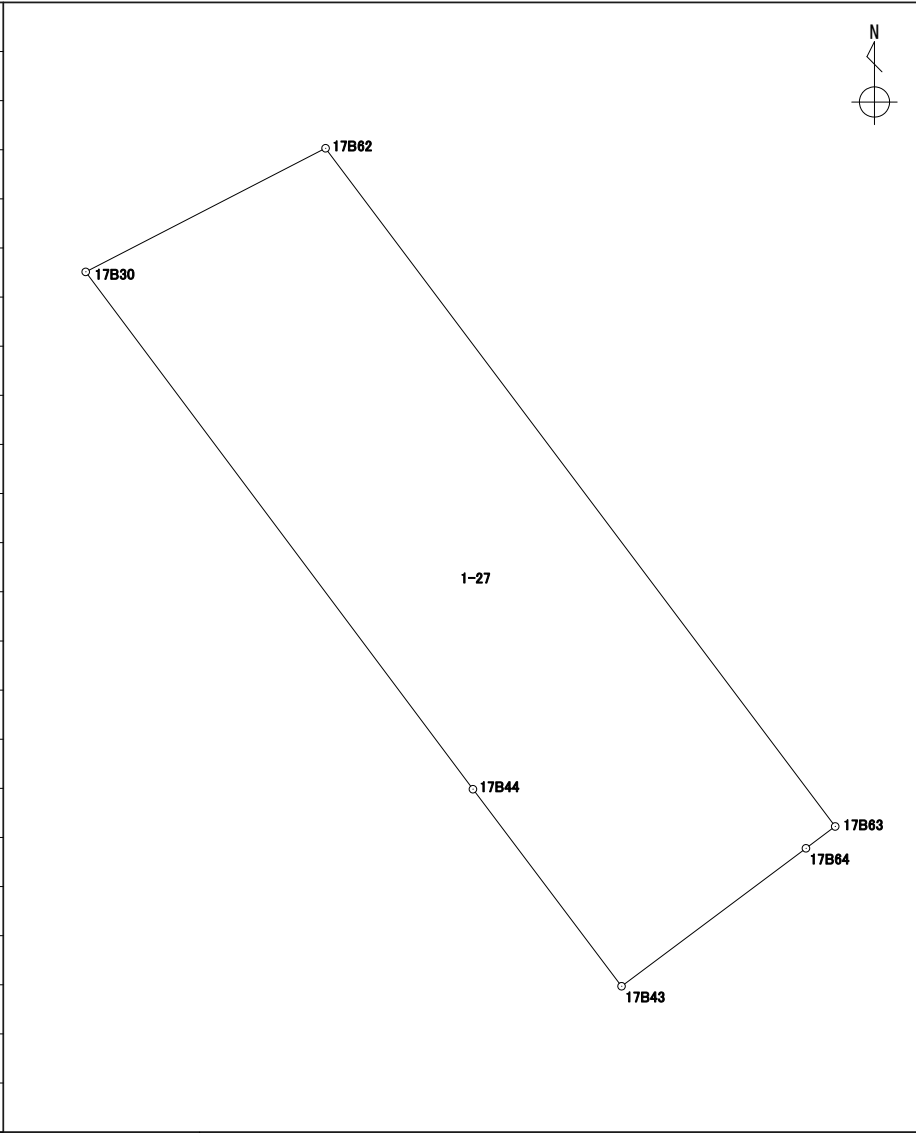
地番 1-26

| 境界点 | X | Y | 辺長 | 方向角 | 備考 |  | | | |
|-----------------------------------|-----------|------------|--------|--------------|-------|--|--|--------|--|
| 17B30 | 43404.747 | -67596.986 | 2.818 | 242° 44' 05" | | | | | |
| 17B78 | 43403.456 | -67599.491 | 14.460 | 143° 10' 51" | | | | | |
| 17B79 | 43391.880 | -67590.825 | 0.926 | 52° 58' 54" | | | | | |
| 17B72 | 43392.438 | -67590.085 | 1.852 | 53° 01' 52" | | | | | |
| 17B44 | 43393.552 | -67588.605 | 13.984 | 323° 10' 48" | | | | | |
| | | | | | | | | | |
| | | | | | | | | | |
| 面積算出公式 | | | 面積 | 39.5250690 | 街区一画地 | | | 17-保10 | |
| $A=1/2 \sum X_n(Y_{n+1}-Y_{n-1})$ | | | 地積 | 39.52 | | | | | |

座標面積計算書

世界測地系 (測地成果2011)

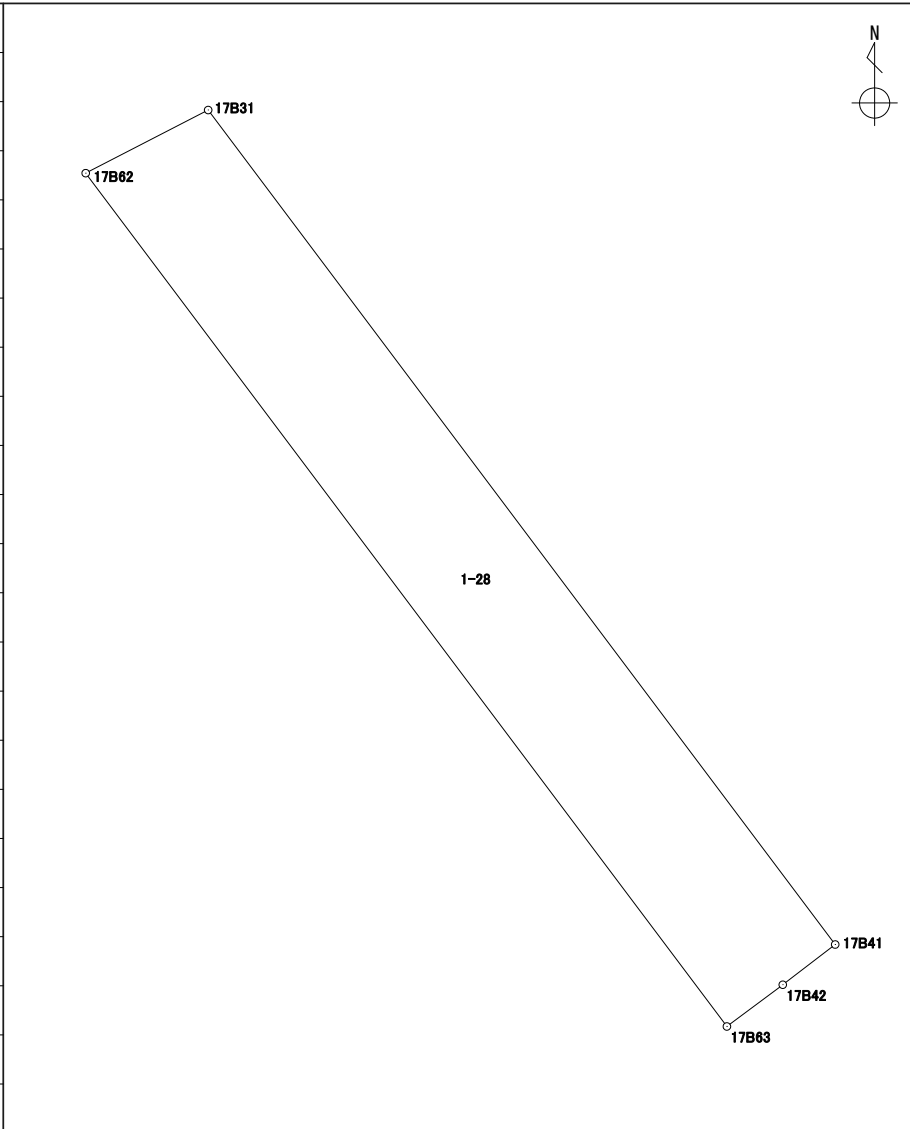
地番 1-27

| 境界点 | X | Y | 辺長 | 方向角 | 備考 |  | | | |
|-----------------------------------|-----------|------------|--------|--------------|-------|--|--|--|--|
| 17B30 | 43404.747 | -67596.986 | 5.840 | 62° 44' 30" | | | | | |
| 17B62 | 43407.422 | -67591.794 | 18.358 | 143° 04' 22" | | | | | |
| 17B63 | 43392.746 | -67580.764 | 0.790 | 233° 13' 54" | | | | | |
| 17B64 | 43392.273 | -67581.397 | 4.983 | 233° 12' 22" | | | | | |
| 17B43 | 43389.288 | -67585.388 | 5.341 | 322° 58' 01" | | | | | |
| 17B44 | 43393.552 | -67588.605 | 13.984 | 323° 10' 48" | | | | | |
| | | | | | | | | | |
| | | | | | | | | | |
| 面積算出公式 | | | 面積 | 108.7836555 | 街区一画地 | 17-9 | | | |
| $A=1/2 \sum X_n(Y_{n+1}-Y_{n-1})$ | | | 地積 | 108.78 | | | | | |

座標面積計算書

世界測地系 (測地成果2011)

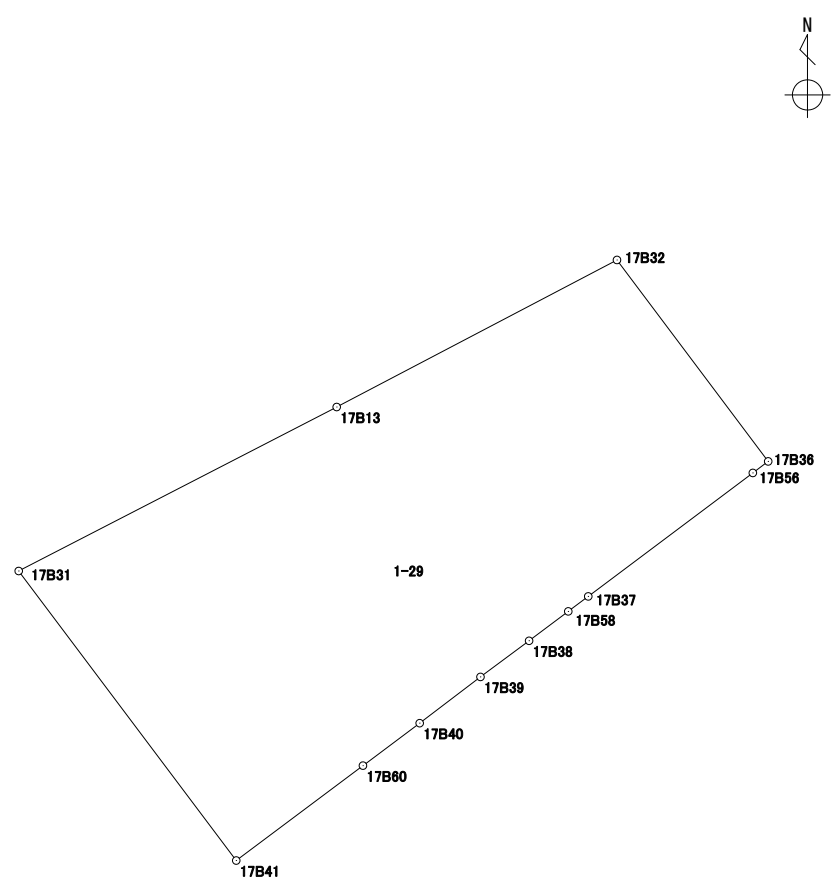
地番 1-28

| 境界点 | X | Y | 辺長 | 方向角 | 備考 |  | | | |
|-----------------------------------|-----------|------------|--------|--------------|-------|--|--|--|--|
| 17B62 | 43407.422 | -67591.794 | 18.358 | 143° 04' 22" | | | | | |
| 17B63 | 43392.746 | -67580.764 | 1.199 | 53° 14' 07" | | | | | |
| 17B42 | 43393.464 | -67579.803 | 1.136 | 52° 30' 19" | | | | | |
| 17B41 | 43394.156 | -67578.901 | 17.953 | 323° 04' 26" | | | | | |
| 17B31 | 43408.508 | -67589.687 | 2.370 | 242° 43' 56" | | | | | |
| | | | | | | | | | |
| | | | | | | | | | |
| 面積算出公式 | | | 面積 | 42.4321620 | 街区一画地 | 17-保9 | | | |
| $A=1/2 \sum X_n(Y_{n+1}-Y_{n-1})$ | | | 地積 | 42.43 | | | | | |

座標面積計算書

世界測地系 (測地成果2011)

地番 1-29

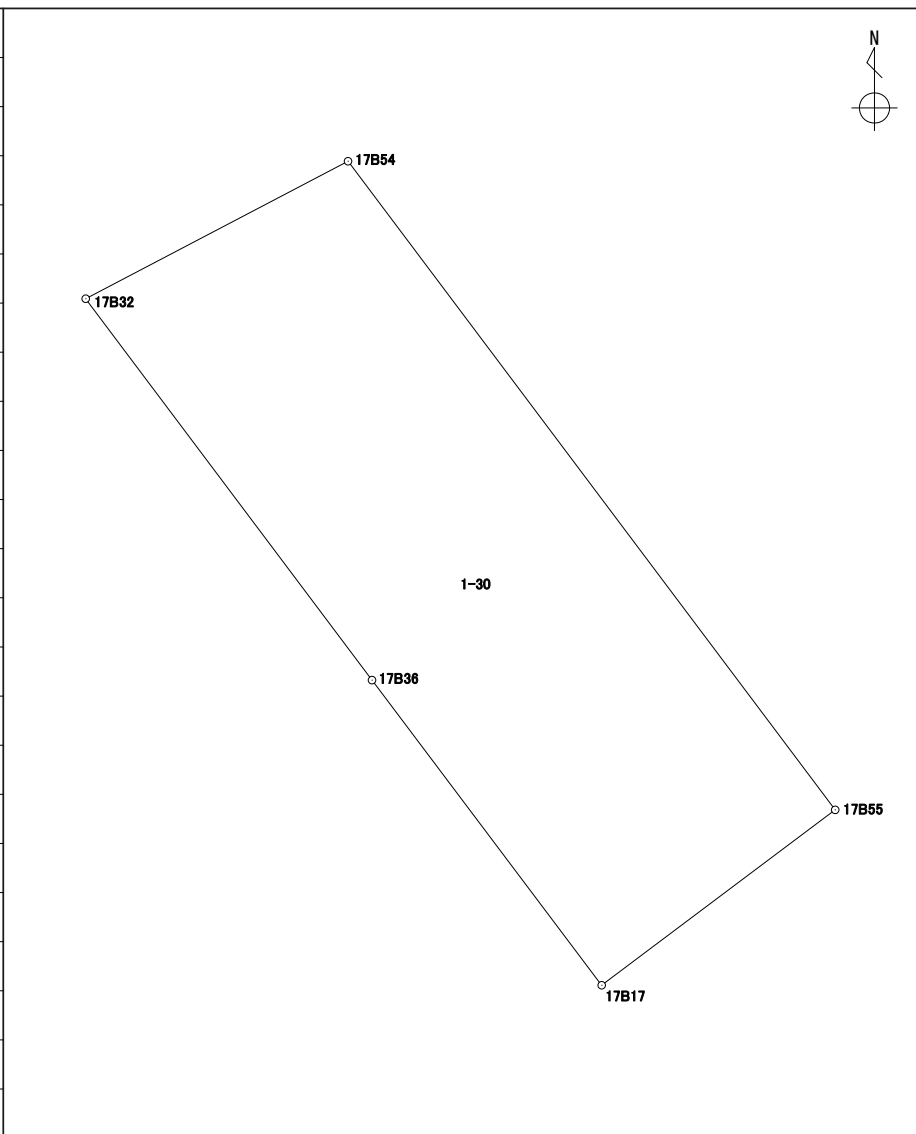
| 境界点 | X | Y | 辺長 | 方向角 | 備考 |  | |
|-----------------------------------|-----------|------------|--------|--------------|-------|--|--|
| 17B31 | 43408.508 | -67589.687 | 17.739 | 62° 43' 33" | | | |
| 17B13 | 43416.637 | -67573.920 | 15.691 | 62° 19' 16" | | | |
| 17B32 | 43423.926 | -67560.024 | 12.486 | 143° 05' 59" | | | |
| 17B36 | 43413.941 | -67552.527 | 0.951 | 233° 07' 05" | | | |
| 17B56 | 43413.370 | -67553.288 | 10.201 | 233° 07' 44" | | | |
| 17B37 | 43407.249 | -67561.449 | 1.237 | 233° 06' 42" | | | |
| 17B58 | 43406.506 | -67562.439 | 2.427 | 233° 07' 14" | | | |
| 17B38 | 43405.049 | -67564.381 | 3.003 | 233° 23' 36" | | | |
| 17B39 | 43403.258 | -67566.792 | 3.787 | 232° 44' 12" | | | |
| 17B40 | 43400.965 | -67569.806 | 3.512 | 233° 10' 56" | | | |
| 17B60 | 43398.860 | -67572.618 | 7.848 | 233° 10' 42" | | | |
| 17B41 | 43394.156 | -67578.901 | 17.953 | 323° 04' 26" | | | |
| | | | | | | | |
| | | | | | | | |
| 面積算出公式 | | | 面積 | 500.8916705 | 街区一画地 | 17-10 | |
| $A=1/2 \sum X_n(Y_{n+1}-Y_{n-1})$ | | | 地積 | 500.89 | | | |

座標面積計算書

世界測地系 (測地成果2011)

| | |
|----|------|
| 地番 | 1-30 |
|----|------|

| 境界点 | X | Y | 辺長 | 方向角 | 備考 |
|-------|-----------|------------|--------|--------------|----|
| 17B32 | 43423.926 | -67560.024 | 7.754 | 62° 20' 52" | |
| 17B54 | 43427.525 | -67553.155 | 21.237 | 143° 05' 05" | |
| 17B55 | 43410.545 | -67540.399 | 7.646 | 233° 05' 28" | |
| 17B17 | 43405.953 | -67546.513 | 9.998 | 323° 01' 29" | |
| 17B36 | 43413.941 | -67552.527 | 12.486 | 323° 05' 59" | |
| | | | | | |
| | | | | | |
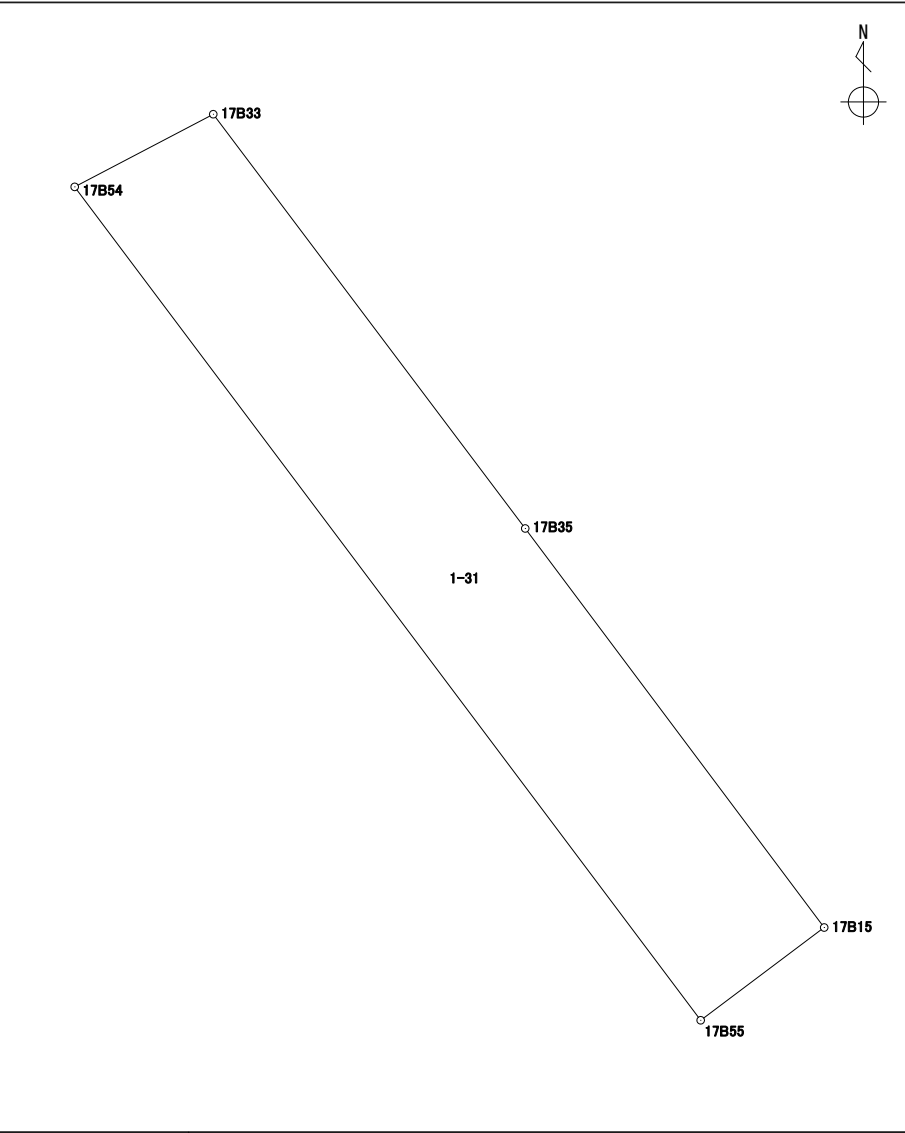
| | | | | |
|--------|----|-------------|-------|------|
| 面積算出公式 | 面積 | 167.3188260 | 街区一画地 | 17-3 |
| | 地積 | 167.31 | | |

$$A = 1/2 \sum X_n(Y_{n+1} - Y_{n-1})$$

座標面積計算書

世界測地系 (測地成果2011)

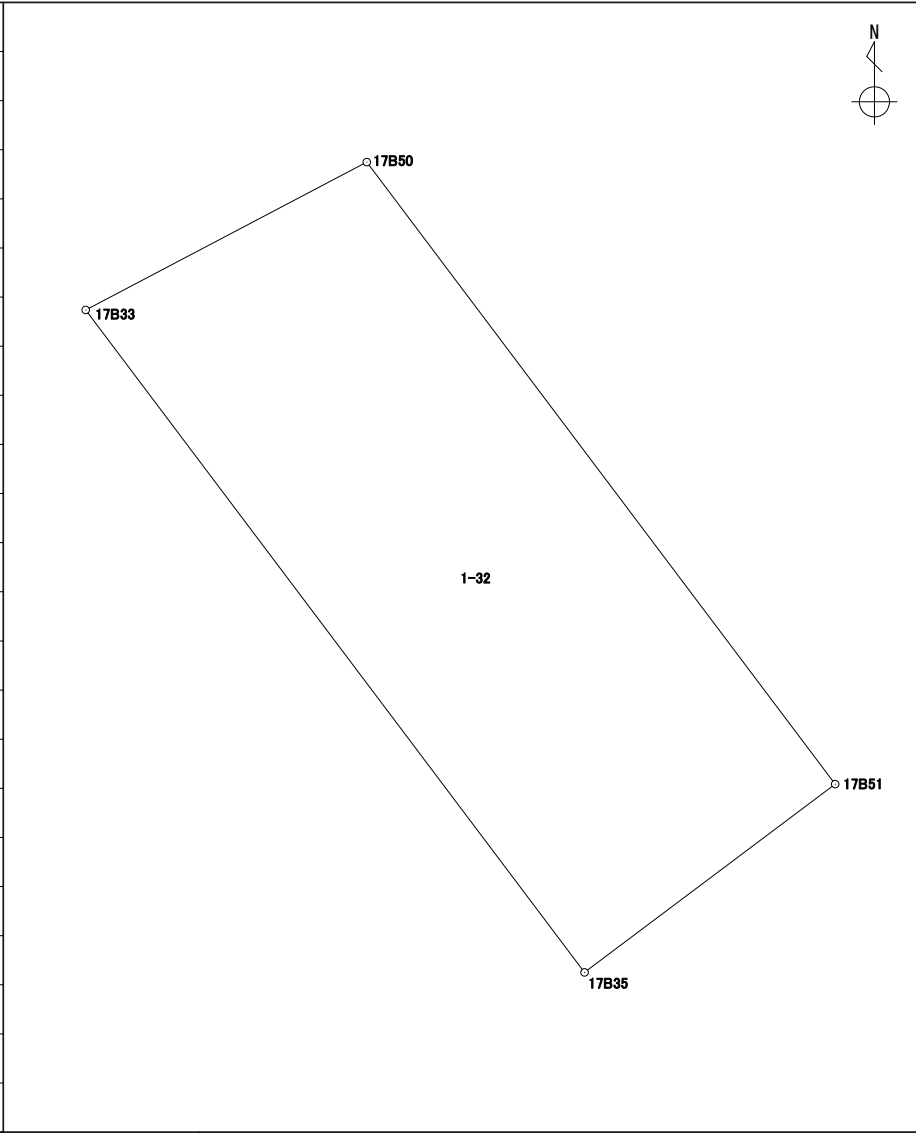
地番 1-31

| 境界点 | X | Y | 辺長 | 方向角 | 備考 |  | | | |
|-----------------------------------|-----------|------------|--------|--------------|-------|--|--|-------|--|
| 17B54 | 43427.525 | -67553.155 | 21.237 | 143° 05' 05" | | | | | |
| 17B55 | 43410.545 | -67540.399 | 3.147 | 53° 05' 50" | | | | | |
| 17B15 | 43412.435 | -67537.882 | 10.159 | 323° 09' 18" | | | | | |
| 17B35 | 43420.565 | -67543.974 | 10.566 | 323° 00' 47" | | | | | |
| 17B33 | 43429.005 | -67550.331 | 3.188 | 242° 20' 31" | | | | | |
| | | | | | | | | | |
| | | | | | | | | | |
| 面積算出公式 | | | 面積 | 66.1658150 | 街区一画地 | | | 17-保3 | |
| $A=1/2 \sum X_n(Y_{n+1}-Y_{n-1})$ | | | 地積 | 66.16 | | | | | |

座標面積計算書

世界測地系 (測地成果2011)

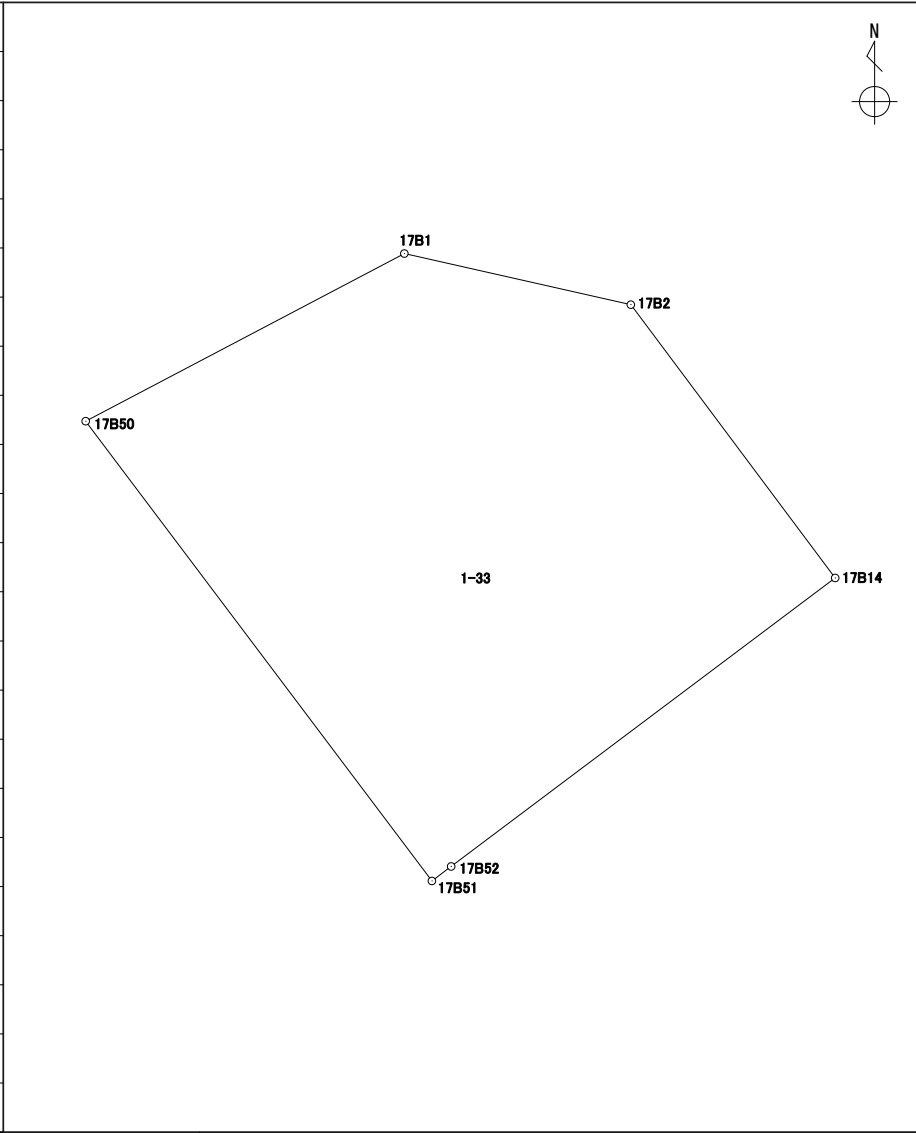
地番 1-32

| 境界点 | X | Y | 辺長 | 方向角 | 備考 |  | | | |
|-----------------------------------|-----------|------------|--------|--------------|-------|--|--|--|--|
| 17B33 | 43429.005 | -67550.331 | 4.047 | 62° 15' 26" | | | | | |
| 17B50 | 43430.889 | -67546.749 | 9.921 | 143° 00' 48" | | | | | |
| 17B51 | 43422.964 | -67540.780 | 3.994 | 233° 05' 24" | | | | | |
| 17B35 | 43420.565 | -67543.974 | 10.566 | 323° 00' 47" | | | | | |
| | | | | | | | | | |
| | | | | | | | | | |
| 面積算出公式 | | | 面積 | 40.9203745 | 街区一画地 | 17-保1 | | | |
| $A=1/2 \sum X_n(Y_{n+1}-Y_{n-1})$ | | | 地積 | 40.92 | | | | | |

座標面積計算書

世界測地系 (測地成果2011)

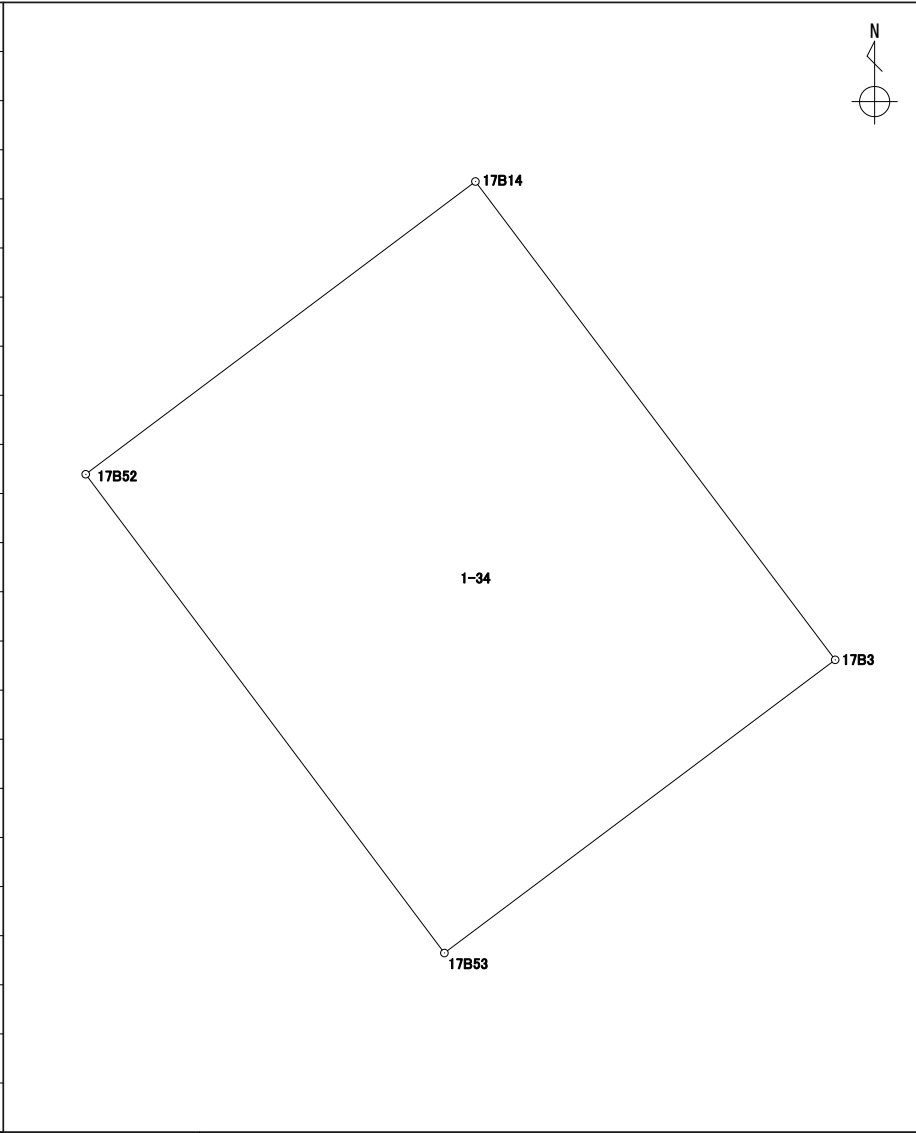
地番 1-33

| 境界点 | X | Y | 辺長 | 方向角 | 備考 |  | | | |
|---------------------------------------|-----------|------------|-------|--------------|-------|--|--|--|--|
| 17B1 | 43433.779 | -67541.255 | 4.002 | 102° 43' 00" | | | | | |
| 17B2 | 43432.898 | -67537.351 | 5.883 | 143° 12' 08" | | | | | |
| 17B14 | 43428.187 | -67533.827 | 8.280 | 233° 05' 24" | | | | | |
| 17B52 | 43423.214 | -67540.448 | 0.415 | 233° 01' 11" | | | | | |
| 17B51 | 43422.964 | -67540.780 | 9.921 | 323° 00' 48" | | | | | |
| 17B50 | 43430.889 | -67546.749 | 6.207 | 62° 15' 16" | | | | | |
| | | | | | | | | | |
| | | | | | | | | | |
| 面積算出公式 | | | 面積 | 76.8754330 | 街区一画地 | 17-1 | | | |
| $A=1/2 \sum X_n(Y_{(n+1)}-Y_{(n-1)})$ | | | 地積 | 76.87 | | | | | |

座標面積計算書

世界測地系 (測地成果2011)

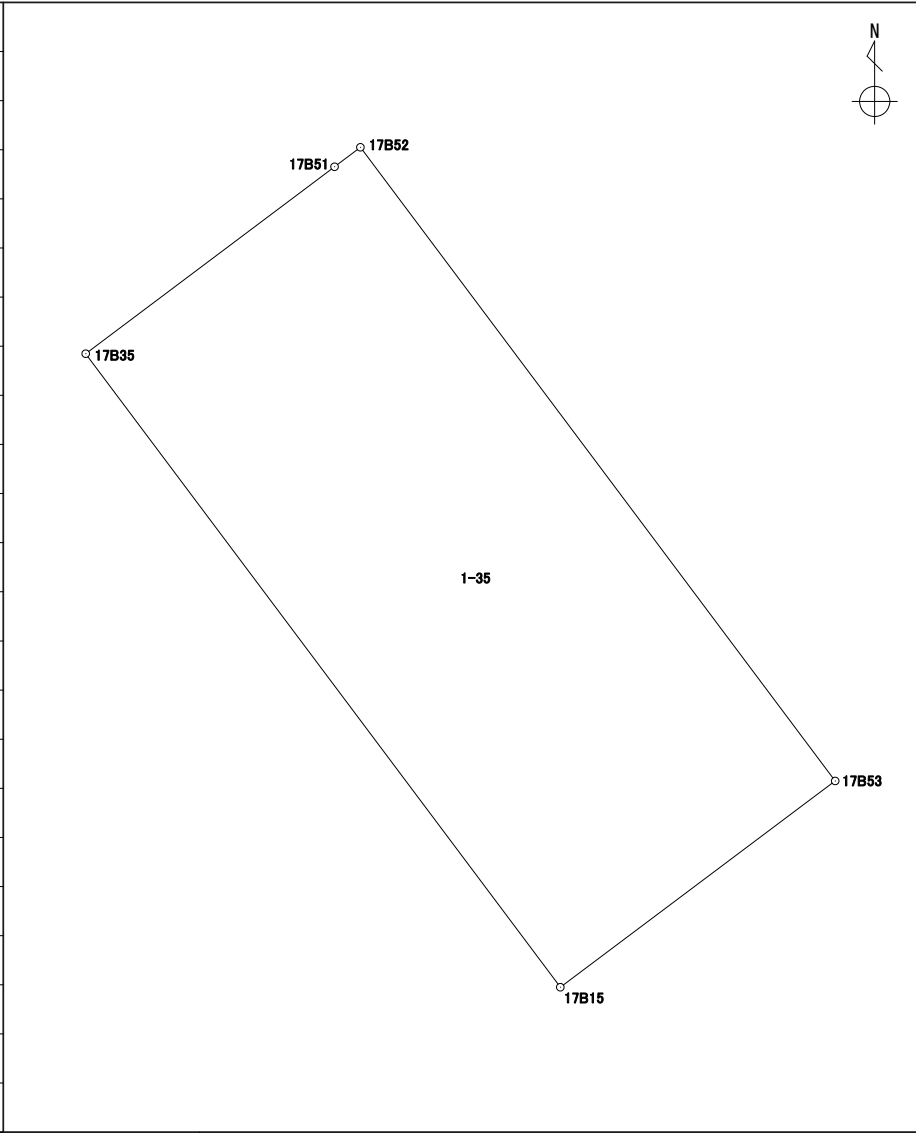
地番 1-34

| 境界点 | X | Y | 辺長 | 方向角 | 備考 |  | | | |
|-----------------------------------|-----------|------------|--------|--------------|-------|--|--|------|--|
| 17B52 | 43423.214 | -67540.448 | 8.280 | 53° 05' 24" | | | | | |
| 17B14 | 43428.187 | -67533.827 | 10.167 | 143° 02' 52" | | | | | |
| 17B3 | 43420.062 | -67527.715 | 8.299 | 233° 07' 33" | | | | | |
| 17B53 | 43415.082 | -67534.354 | 10.162 | 323° 09' 10" | | | | | |
| | | | | | | | | | |
| | | | | | | | | | |
| 面積算出公式 | | | 面積 | 84.2635345 | 街区一画地 | | | 17-2 | |
| $A=1/2 \sum X_n(Y_{n+1}-Y_{n-1})$ | | | 地積 | 84.26 | | | | | |

座標面積計算書

世界測地系 (測地成果2011)

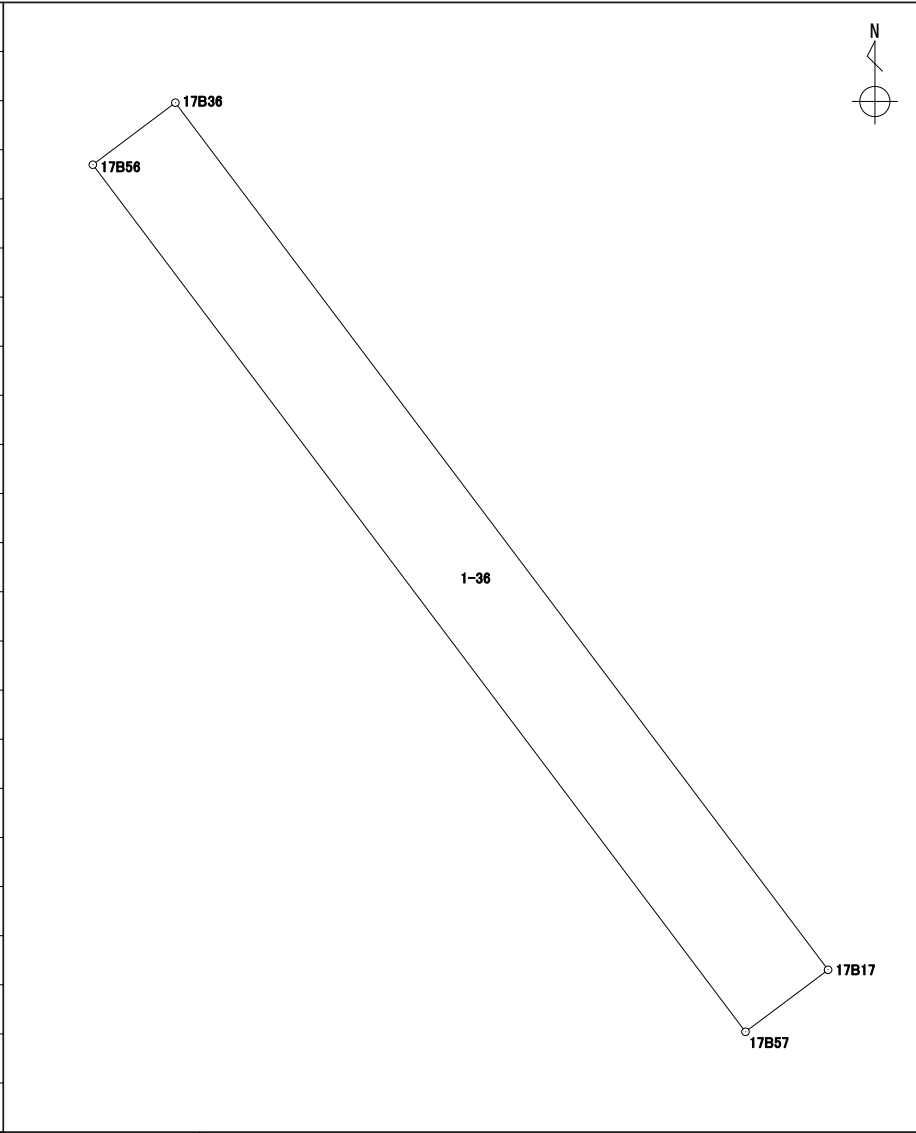
地番 1-35

| 境界点 | X | Y | 辺長 | 方向角 | 備考 |  | | | |
|-----------------------------------|-----------|------------|--------|--------------|-------|--|--|-------|--|
| 17B35 | 43420.565 | -67543.974 | 3.994 | 53° 05' 24" | | | | | |
| 17B51 | 43422.964 | -67540.780 | 0.415 | 53° 01' 11" | | | | | |
| 17B52 | 43423.214 | -67540.448 | 10.162 | 143° 09' 10" | | | | | |
| 17B53 | 43415.082 | -67534.354 | 4.410 | 233° 07' 11" | | | | | |
| 17B15 | 43412.435 | -67537.882 | 10.159 | 323° 09' 18" | | | | | |
| | | | | | | | | | |
| | | | | | | | | | |
| 面積算出公式 | | | 面積 | 44.8112850 | 街区一画地 | | | 17-保2 | |
| $A=1/2 \sum X_n(Y_{n+1}-Y_{n-1})$ | | | 地積 | 44.81 | | | | | |

座標面積計算書

世界測地系 (測地成果2011)

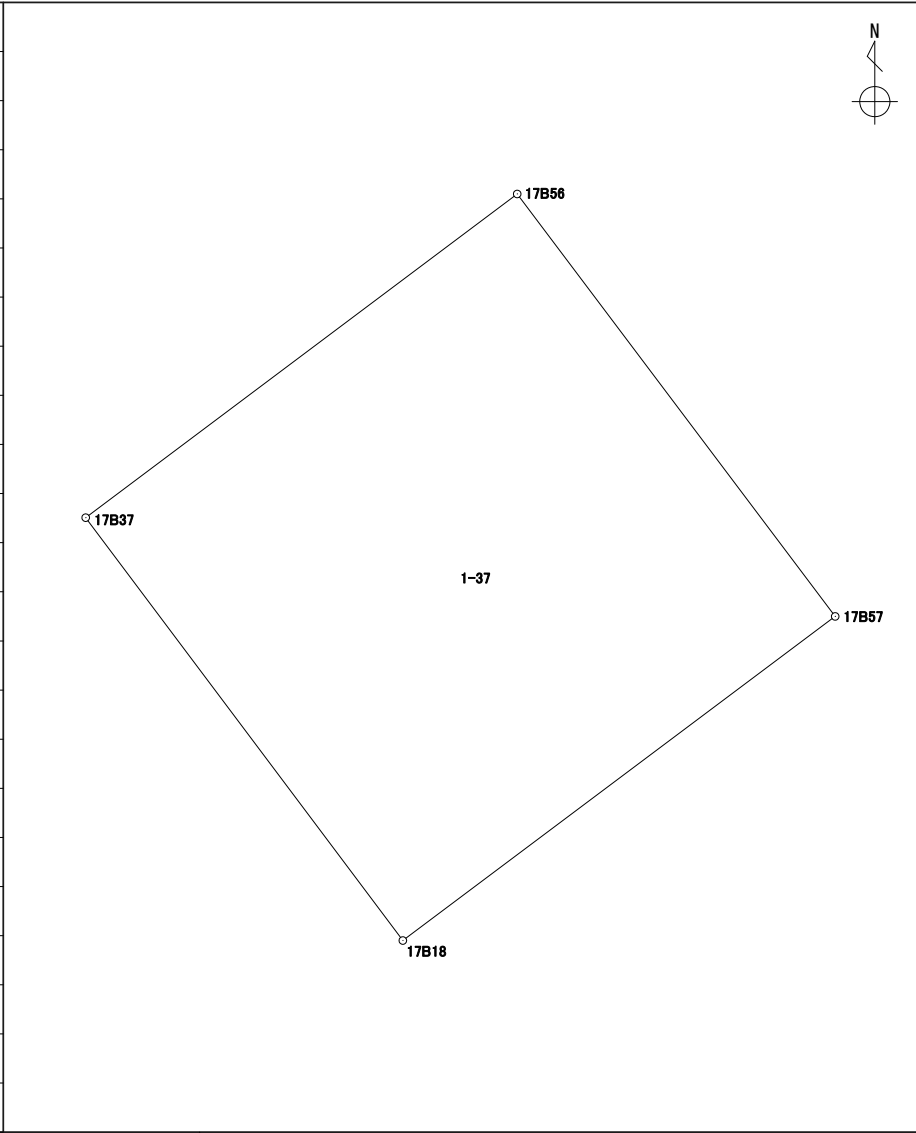
地番 1-36

| 境界点 | X | Y | 辺長 | 方向角 | 備考 |  | | |
|-----------------------------------|-----------|------------|-------|--------------|-------|--|--|--------|
| 17B56 | 43413.370 | -67553.288 | 9.998 | 143° 01' 29" | | | | |
| 17B57 | 43405.382 | -67547.274 | 0.951 | 53° 07' 05" | | | | |
| 17B17 | 43405.953 | -67546.513 | 9.998 | 323° 01' 29" | | | | |
| 17B36 | 43413.941 | -67552.527 | 0.951 | 233° 07' 05" | | | | |
| | | | | | | | | |
| | | | | | | | | |
| 面積算出公式 | | | 面積 | 9.5128620 | 街区一画地 | | | 17-保15 |
| $A=1/2 \sum X_n(Y_{n+1}-Y_{n-1})$ | | | 地積 | 9.51 | | | | |

座標面積計算書

世界測地系 (測地成果2011)

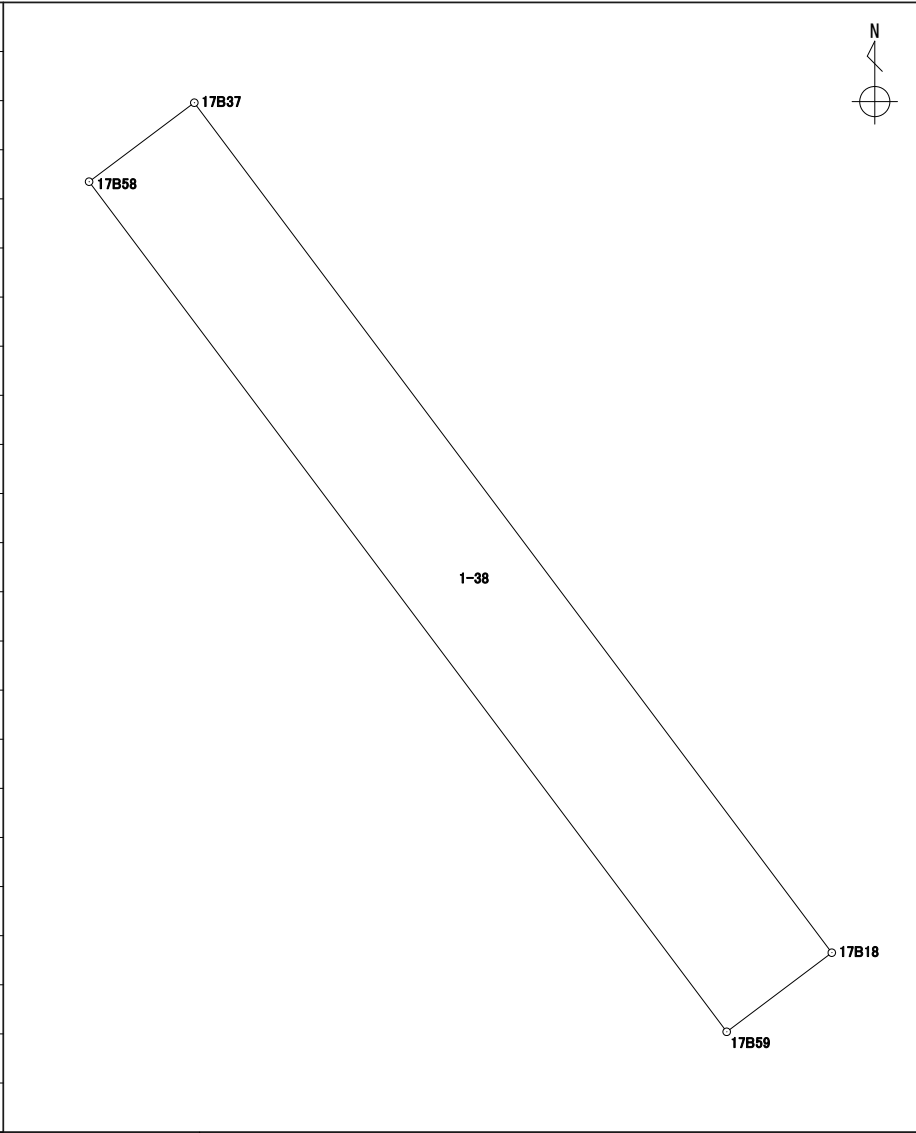
地番 1-37

| 境界点 | X | Y | 辺長 | 方向角 | 備考 |  | | | |
|---------------------------------------|-----------|------------|--------|--------------|-------|--|--|--|--|
| 17B37 | 43407.249 | -67561.449 | 10.201 | 53° 07' 44" | | | | | |
| 17B56 | 43413.370 | -67553.288 | 9.998 | 143° 01' 29" | | | | | |
| 17B57 | 43405.382 | -67547.274 | 10.219 | 233° 08' 49" | | | | | |
| 17B18 | 43399.253 | -67555.451 | 9.995 | 323° 07' 32" | | | | | |
| | | | | | | | | | |
| | | | | | | | | | |
| 面積算出公式 | | | 面積 | 102.0733980 | 街区一画地 | 17-4 | | | |
| $A=1/2 \sum X_n(Y_{(n+1)}-Y_{(n-1)})$ | | | 地積 | 102.07 | | | | | |

座標面積計算書

世界測地系 (測地成果2011)

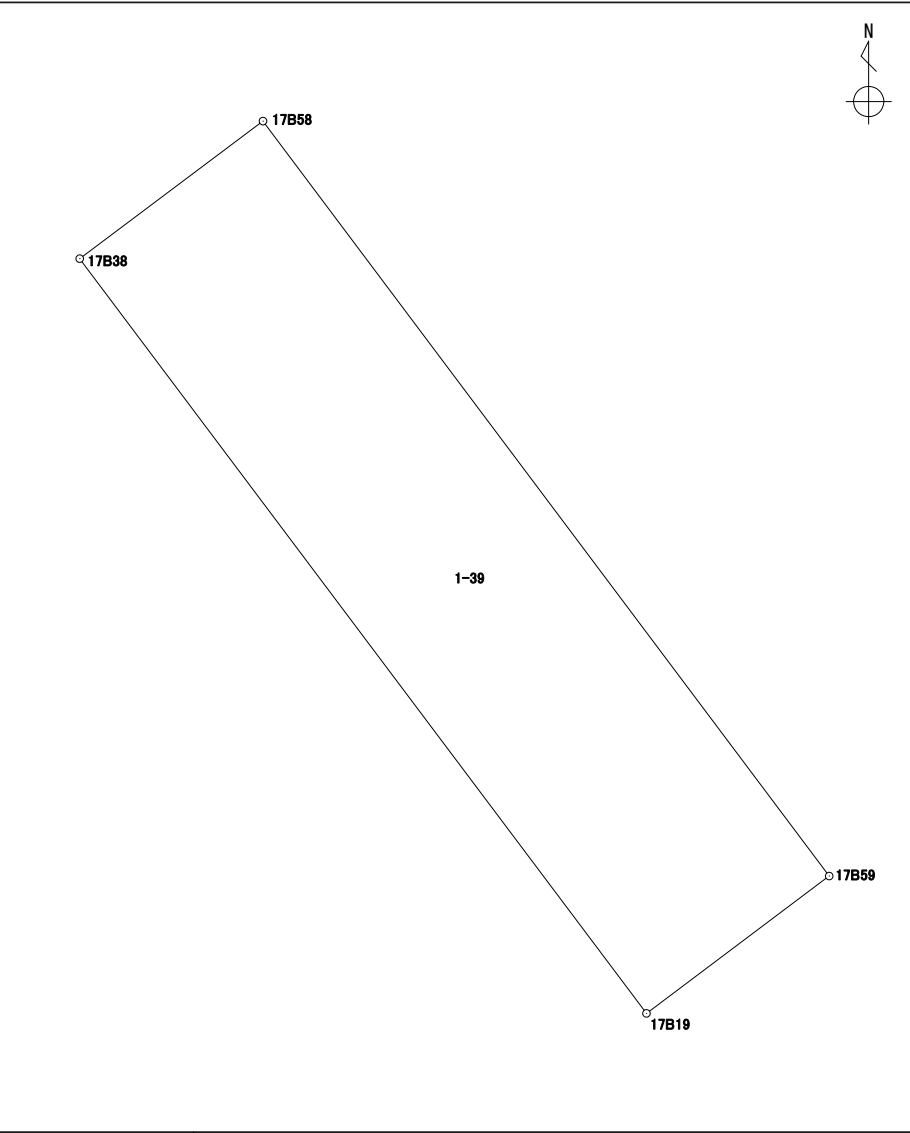
| | |
|----|------|
| 地番 | 1-38 |
|----|------|

| 境界点 | X | Y | 辺長 | 方向角 | 備考 |  | | |
|-----------------------------------|-----------|------------|-------|--------------|-------|--|--|-------|
| 17B58 | 43406.506 | -67562.439 | 9.997 | 143° 07' 28" | | | | |
| 17B59 | 43398.509 | -67556.440 | 1.237 | 53° 02' 48" | | | | |
| 17B18 | 43399.253 | -67555.451 | 9.995 | 323° 07' 32" | | | | |
| 17B37 | 43407.249 | -67561.449 | 1.237 | 233° 06' 42" | | | | |
| | | | | | | | | |
| | | | | | | | | |
| 面積算出公式 | | | 面積 | 12.3724215 | 街区一画地 | | | 17-保6 |
| $A=1/2 \sum X_n(Y_{n+1}-Y_{n-1})$ | | | 地積 | 12.37 | | | | |

座標面積計算書

世界測地系 (測地成果2011)

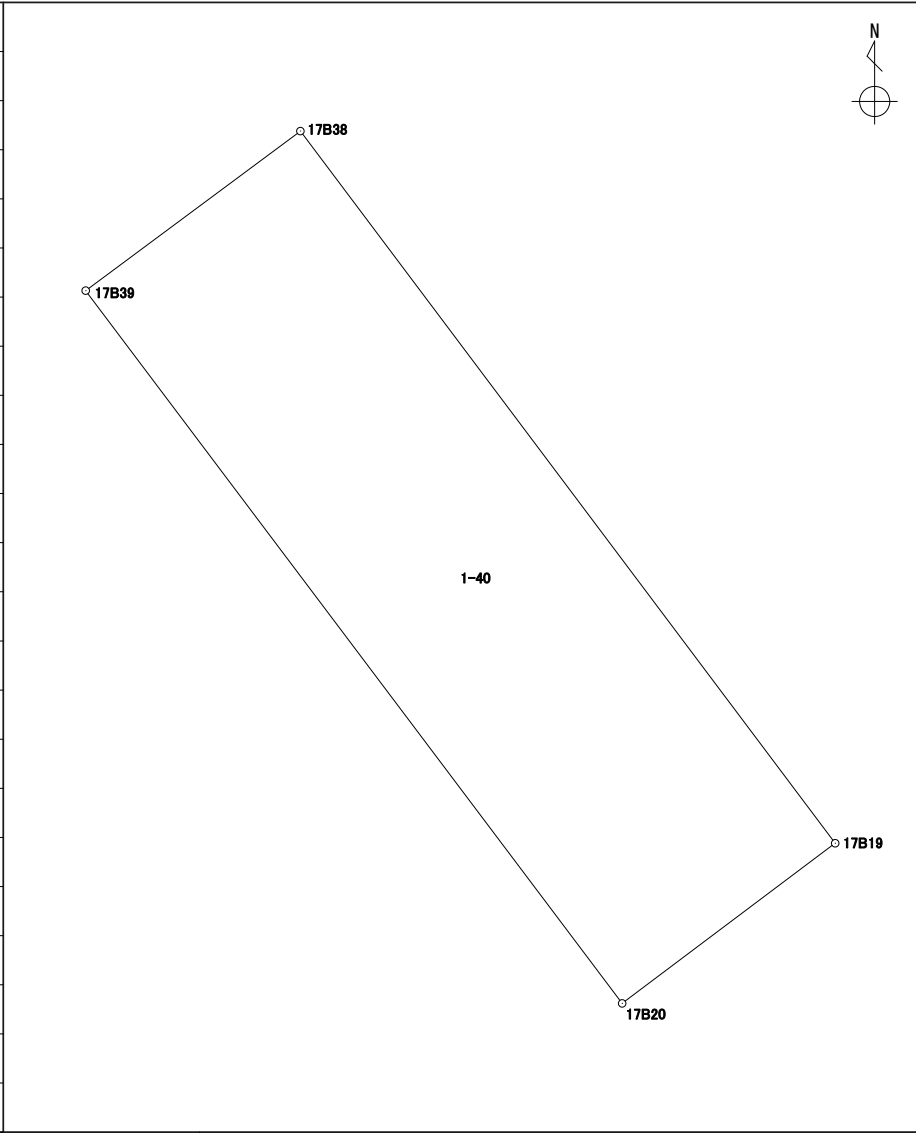
地番 1-39

| 境界点 | X | Y | 辺長 | 方向角 | 備考 |  | | | |
|-----------------------------------|-----------|------------|-------|--------------|-------|--|--|--|--|
| 17B58 | 43406.506 | -67562.439 | 9.997 | 143° 07' 28" | | | | | |
| 17B59 | 43398.509 | -67556.440 | 2.421 | 233° 04' 24" | | | | | |
| 17B19 | 43397.054 | -67558.376 | 9.999 | 323° 05' 24" | | | | | |
| 17B38 | 43405.049 | -67564.381 | 2.427 | 53° 07' 14" | | | | | |
| | | | | | | | | | |
| | | | | | | | | | |
| 面積算出公式 | | | 面積 | 24.2431560 | 街区一画地 | 17-5 | | | |
| $A=1/2 \sum X_n(Y_{n+1}-Y_{n-1})$ | | | 地積 | 24.24 | | | | | |

座標面積計算書

世界測地系 (測地成果2011)

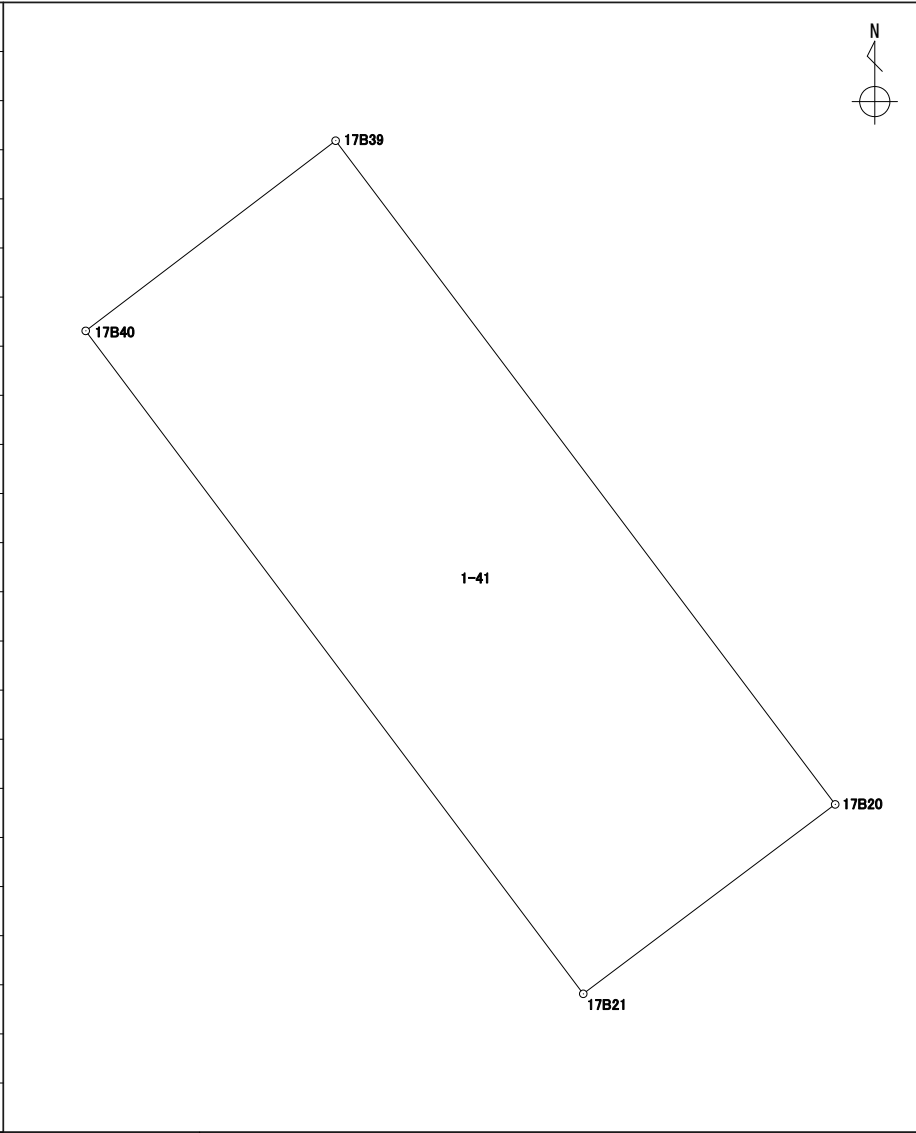
地番 1-40

| 境界点 | X | Y | 辺長 | 方向角 | 備考 |  | | | |
|-----------------------------------|-----------|------------|--------|--------------|-------|--|--|--------|--|
| 17B39 | 43403.258 | -67566.792 | 10.016 | 143° 01' 38" | | | | | |
| 17B20 | 43395.256 | -67560.768 | 2.992 | 53° 04' 08" | | | | | |
| 17B19 | 43397.054 | -67558.376 | 9.999 | 323° 05' 24" | | | | | |
| 17B38 | 43405.049 | -67564.381 | 3.003 | 233° 23' 36" | | | | | |
| | | | | | | | | | |
| | | | | | | | | | |
| 面積算出公式 | | | 面積 | 30.0014180 | 街区一画地 | | | 17-保17 | |
| $A=1/2 \sum X_n(Y_{n+1}-Y_{n-1})$ | | | 地積 | 30.00 | | | | | |

座標面積計算書

世界測地系 (測地成果2011)

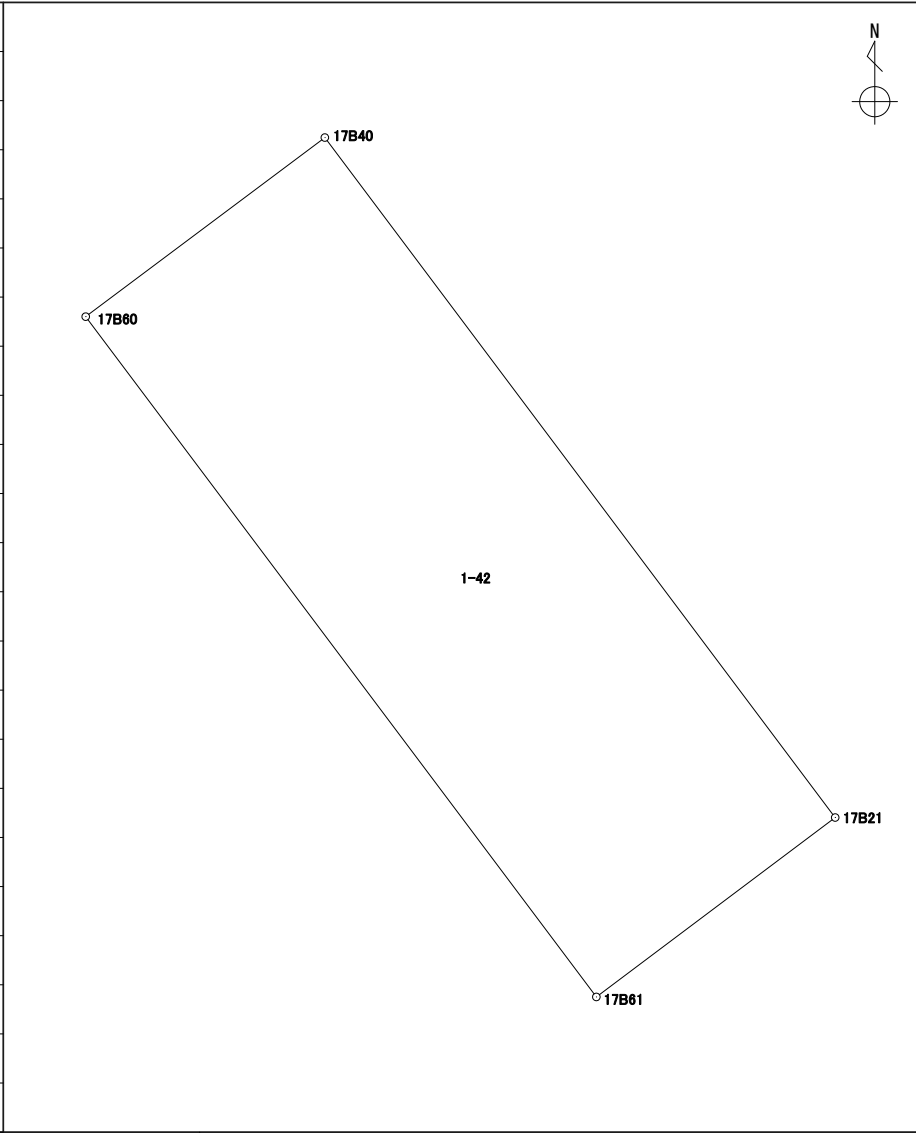
地番 1-41

| 境界点 | X | Y | 辺長 | 方向角 | 備考 |  | | | |
|---------------------------------------|-----------|------------|--------|--------------|-------|--|--|--|--|
| 17B40 | 43400.965 | -67569.806 | 3.787 | 52° 44' 12" | | | | | |
| 17B39 | 43403.258 | -67566.792 | 10.016 | 143° 01' 38" | | | | | |
| 17B20 | 43395.256 | -67560.768 | 3.800 | 233° 03' 50" | | | | | |
| 17B21 | 43392.972 | -67563.806 | 9.994 | 323° 06' 22" | | | | | |
| | | | | | | | | | |
| | | | | | | | | | |
| 面積算出公式 | | | 面積 | 37.9588970 | 街区一画地 | 17-6 | | | |
| $A=1/2 \sum X_n(Y_{(n+1)}-Y_{(n-1)})$ | | | 地積 | 37.95 | | | | | |

座標面積計算書

世界測地系 (測地成果2011)

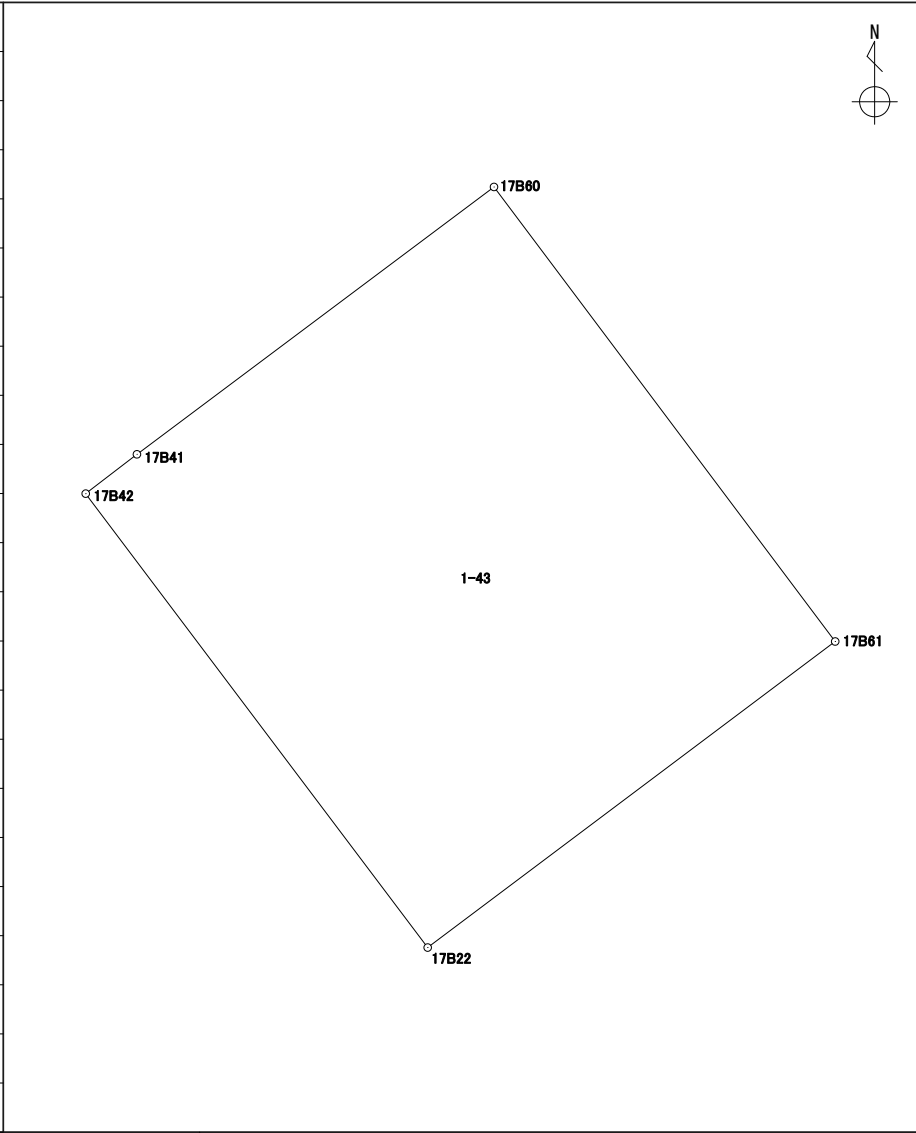
地番 1-42

| 境界点 | X | Y | 辺長 | 方向角 | 備考 |  | | | |
|-----------------------------------|-----------|------------|--------|--------------|-------|--|--|-------|--|
| 17B60 | 43398.860 | -67572.618 | 10.000 | 143° 06' 05" | | | | | |
| 17B61 | 43390.863 | -67566.614 | 3.511 | 53° 05' 27" | | | | | |
| 17B21 | 43392.972 | -67563.806 | 9.994 | 323° 06' 22" | | | | | |
| 17B40 | 43400.965 | -67569.806 | 3.512 | 233° 10' 56" | | | | | |
| | | | | | | | | | |
| | | | | | | | | | |
| 面積算出公式 | | | 面積 | 35.1121640 | 街区一画地 | | | 17-保7 | |
| $A=1/2 \sum X_n(Y_{n+1}-Y_{n-1})$ | | | 地積 | 35.11 | | | | | |

座標面積計算書

世界測地系 (測地成果2011)

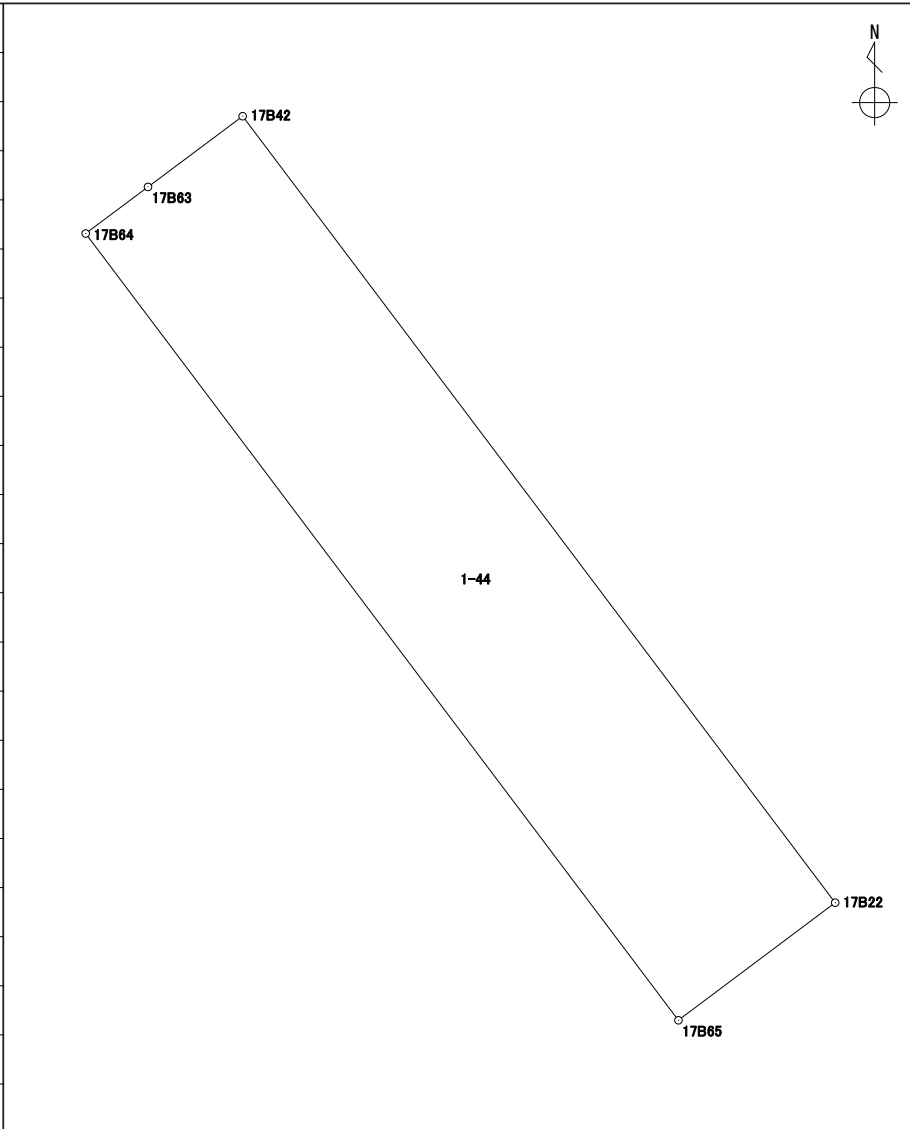
地番 1-43

| 境界点 | X | Y | 辺長 | 方向角 | 備考 |  | | | |
|--|-----------|------------|--------|--------------|-------|--|--|------|--|
| 17B60 | 43398.860 | -67572.618 | 10.000 | 143° 06' 05" | | | | | |
| 17B61 | 43390.863 | -67566.614 | 8.967 | 233° 05' 44" | | | | | |
| 17B22 | 43385.478 | -67573.785 | 9.999 | 322° 59' 58" | | | | | |
| 17B42 | 43393.464 | -67579.803 | 1.136 | 52° 30' 19" | | | | | |
| 17B41 | 43394.156 | -67578.901 | 7.848 | 53° 10' 42" | | | | | |
| | | | | | | | | | |
| | | | | | | | | | |
| 面積算出公式 | | | 面積 | 89.8176965 | 街区一画地 | | | 17-7 | |
| $A=1/2 \sum X_n(Y_{n+1})-Y_n(X_{n+1})$ | | | 地積 | 89.81 | | | | | |

座標面積計算書

世界測地系 (測地成果2011)

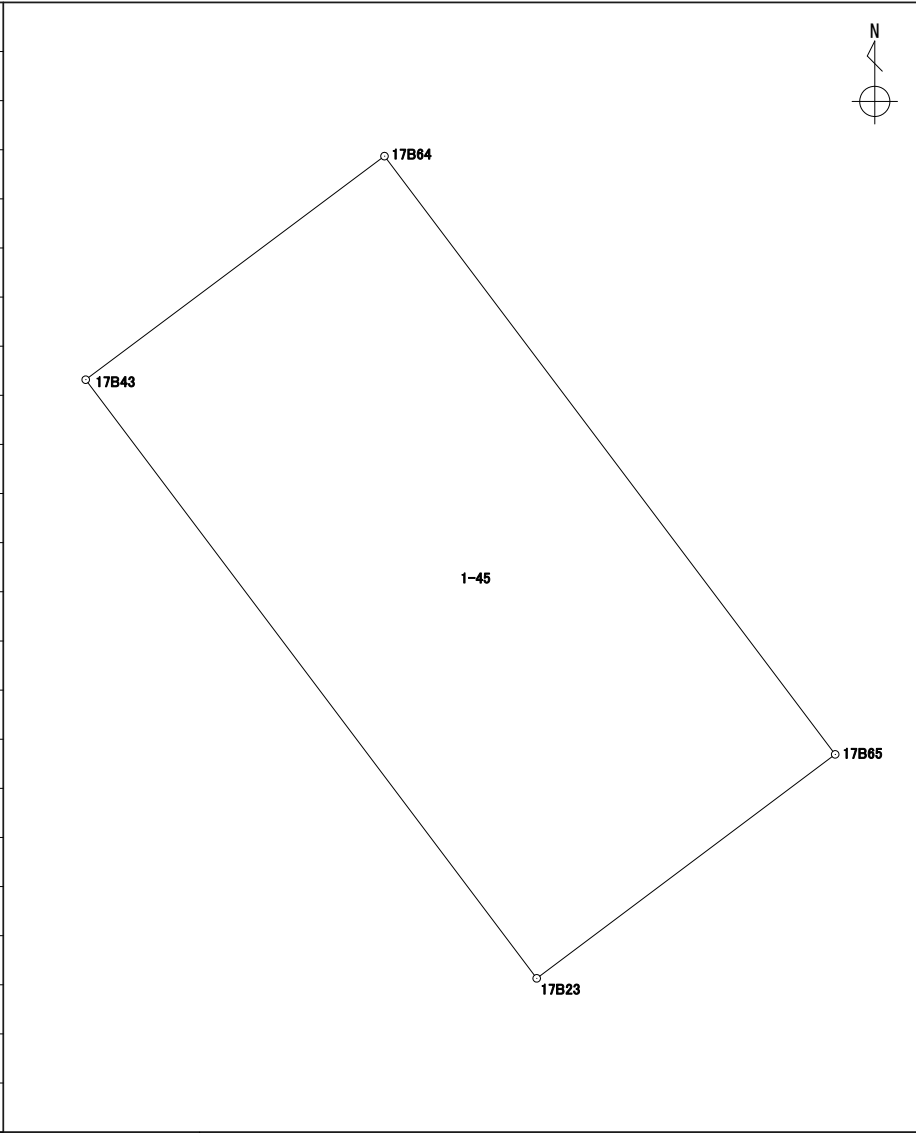
地番 1-44

| 境界点 | X | Y | 辺長 | 方向角 | 備考 |  | | | |
|-----------------------------------|-----------|------------|--------|--------------|-------|--|--|-------|--|
| 17B64 | 43392.273 | -67581.397 | 10.003 | 143° 00' 02" | | | | | |
| 17B65 | 43384.284 | -67575.377 | 1.990 | 53° 07' 48" | | | | | |
| 17B22 | 43385.478 | -67573.785 | 9.999 | 322° 59' 58" | | | | | |
| 17B42 | 43393.464 | -67579.803 | 1.199 | 233° 14' 07" | | | | | |
| 17B63 | 43392.746 | -67580.764 | 0.790 | 233° 13' 54" | | | | | |
| | | | | | | | | | |
| | | | | | | | | | |
| 面積算出公式 | | | 面積 | 19.9017745 | 街区一画地 | | | 17-保8 | |
| $A=1/2 \sum X_n(Y_{n+1}-Y_{n-1})$ | | | 地積 | 19.90 | | | | | |

座標面積計算書

世界測地系 (測地成果2011)

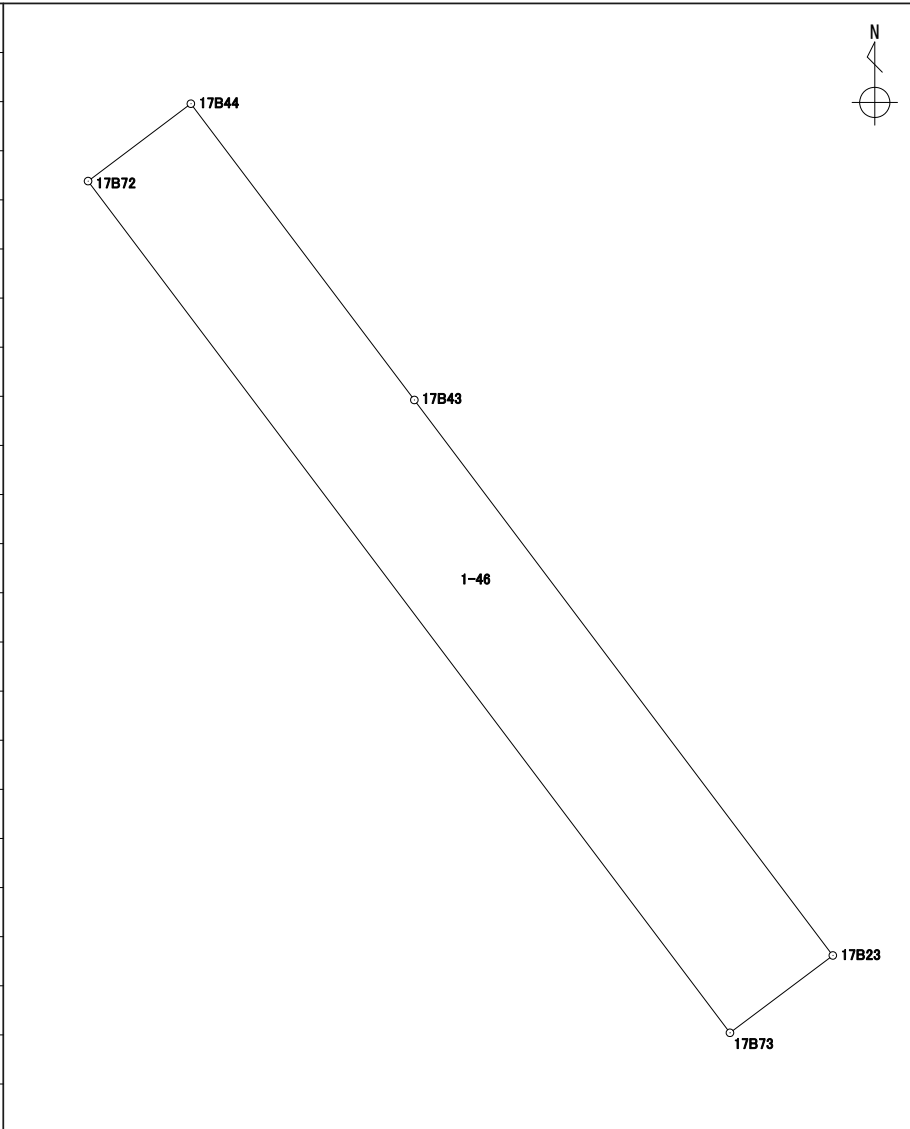
地番 1-45

| 境界点 | X | Y | 辺長 | 方向角 | 備考 |  | | | |
|---------------------------------------|-----------|------------|--------|--------------|-------|--|--|------|--|
| 17B65 | 43384.284 | -67575.377 | 4.984 | 233° 07' 24" | | | | | |
| 17B23 | 43381.293 | -67579.364 | 10.010 | 323° 00' 11" | | | | | |
| 17B43 | 43389.288 | -67585.388 | 4.983 | 53° 12' 22" | | | | | |
| 17B64 | 43392.273 | -67581.397 | 10.003 | 143° 00' 02" | | | | | |
| | | | | | | | | | |
| | | | | | | | | | |
| 面積算出公式 | | | 面積 | 49.8738240 | 街区一画地 | | | 17-8 | |
| $A=1/2 \sum X_n(Y_{(n+1)}-Y_{(n-1)})$ | | | 地積 | 49.87 | | | | | |

座標面積計算書

世界測地系 (測地成果2011)

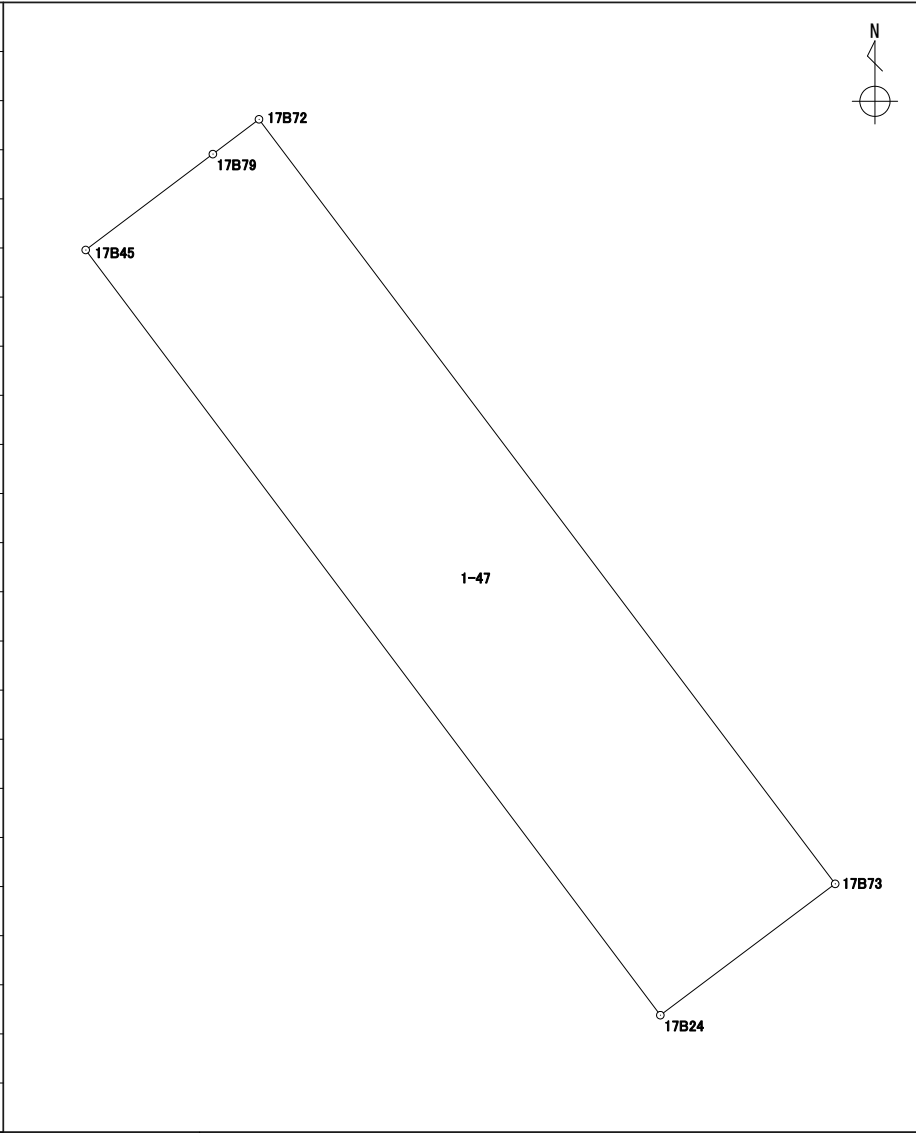
地番 1-46

| 境界点 | X | Y | 辺長 | 方向角 | 備考 |  | | | |
|-----------------------------------|-----------|------------|--------|--------------|-------|--|--|--------|--|
| 17B43 | 43389.288 | -67585.388 | 5.341 | 322° 58' 01" | | | | | |
| 17B44 | 43393.552 | -67588.605 | 1.852 | 233° 01' 52" | | | | | |
| 17B72 | 43392.438 | -67590.085 | 15.350 | 142° 59' 29" | | | | | |
| 17B73 | 43380.180 | -67580.845 | 1.852 | 53° 04' 28" | | | | | |
| 17B23 | 43381.293 | -67579.364 | 10.010 | 323° 00' 11" | | | | | |
| | | | | | | | | | |
| | | | | | | | | | |
| 面積算出公式 | | | 面積 | 28.4547955 | 街区一画地 | | | 17-保12 | |
| $A=1/2 \sum X_n(Y_{n+1}-Y_{n-1})$ | | | 地積 | 28.45 | | | | | |

座標面積計算書

世界測地系 (測地成果2011)

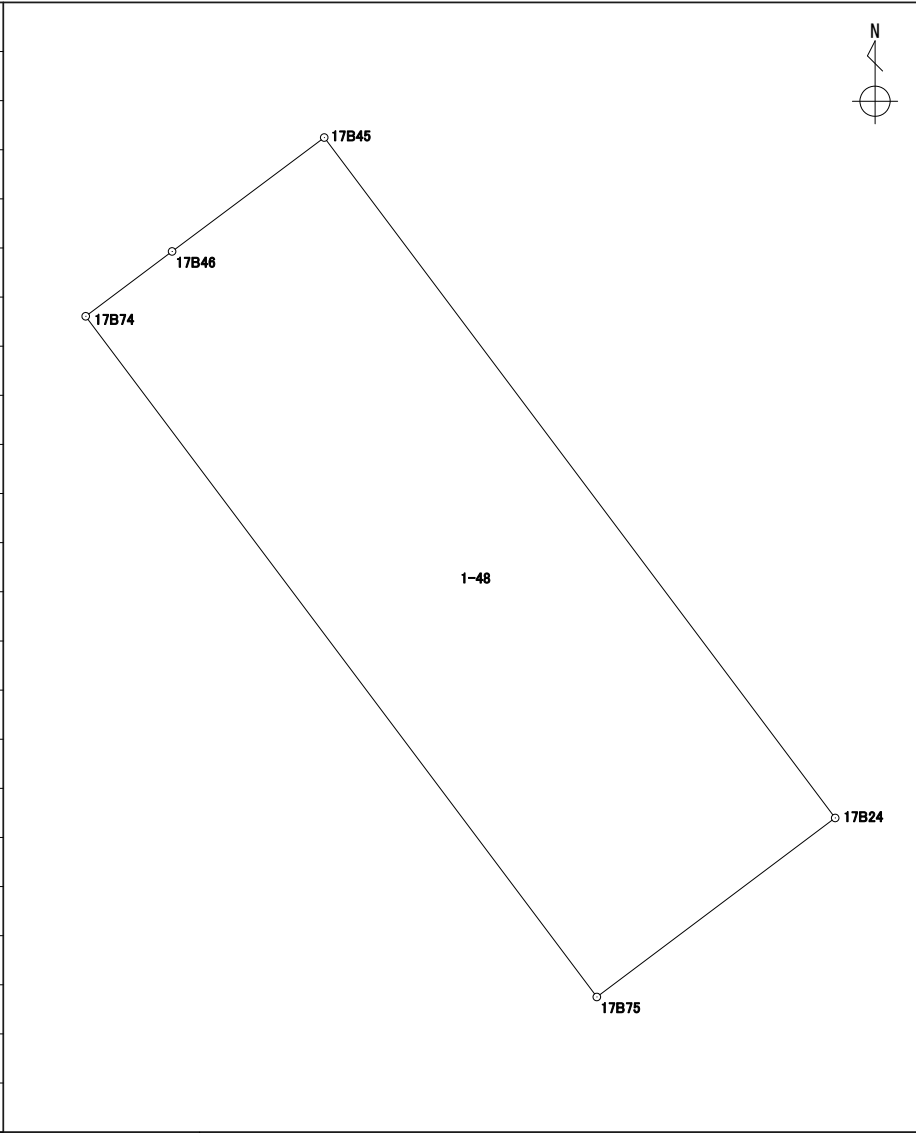
地番 1-47

| 境界点 | X | Y | 辺長 | 方向角 | 備考 |  | | | |
|-----------------------------------|-----------|------------|--------|--------------|-------|--|--|-------|--|
| 17B72 | 43392.438 | -67590.085 | 15.350 | 142° 59' 29" | | | | | |
| 17B73 | 43380.180 | -67580.845 | 3.506 | 233° 05' 27" | | | | | |
| 17B24 | 43378.074 | -67583.649 | 15.344 | 323° 05' 26" | | | | | |
| 17B45 | 43390.343 | -67592.864 | 2.553 | 52° 59' 28" | | | | | |
| 17B79 | 43391.880 | -67590.825 | 0.926 | 52° 58' 54" | | | | | |
| | | | | | | | | | |
| | | | | | | | | | |
| 面積算出公式 | | | 面積 | 53.6157330 | 街区一画地 | | | 17-13 | |
| $A=1/2 \sum X_n(Y_{n+1}-Y_{n-1})$ | | | 地積 | 53.61 | | | | | |

座標面積計算書

世界測地系 (測地成果2011)

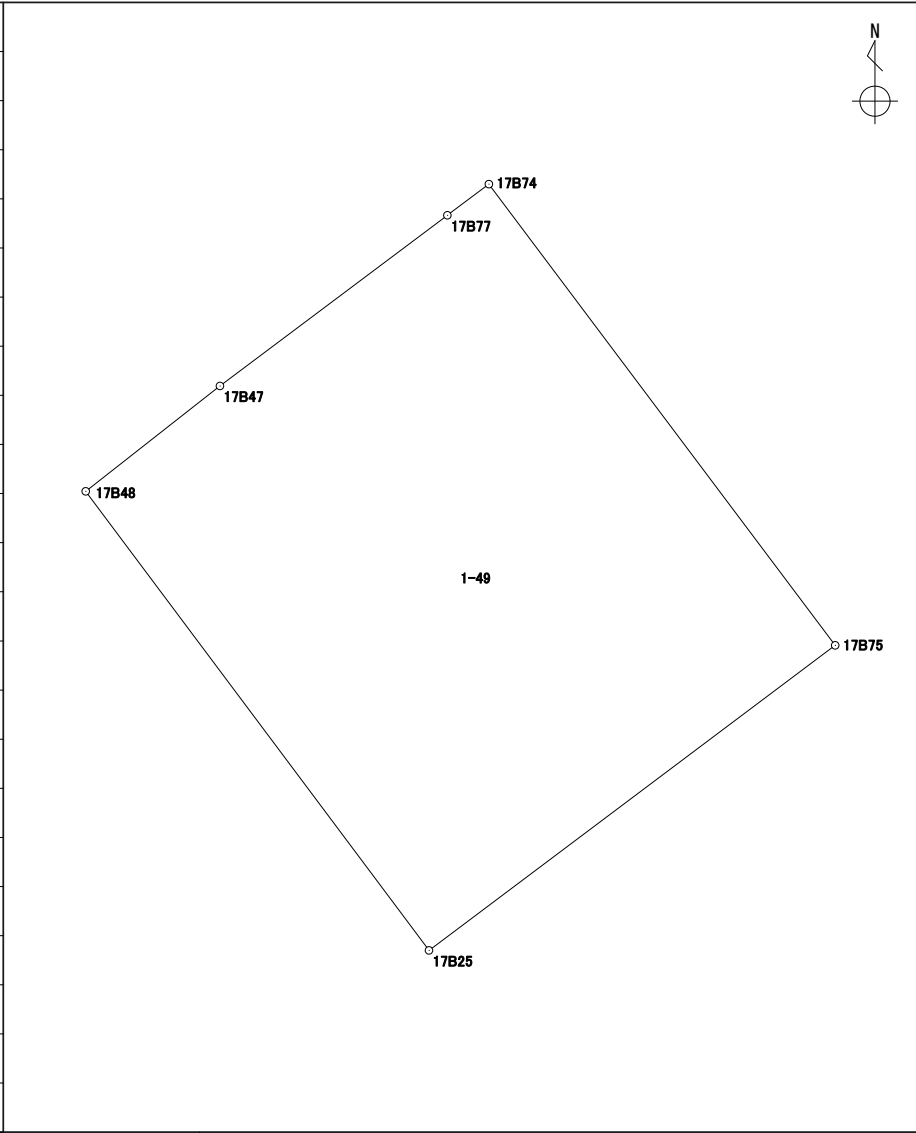
| | |
|----|------|
| 地番 | 1-48 |
|----|------|

| 境界点 | X | Y | 辺長 | 方向角 | 備考 |  | | | |
|-----------------------------------|-----------|------------|--------|--------------|-------|--|--|--------|--|
| 17B45 | 43390.343 | -67592.864 | 3.427 | 233° 11' 01" | | | | | |
| 17B46 | 43388.289 | -67595.608 | 1.947 | 233° 07' 06" | | | | | |
| 17B74 | 43387.120 | -67597.166 | 15.350 | 143° 05' 34" | | | | | |
| 17B75 | 43374.846 | -67587.948 | 5.376 | 53° 05' 53" | | | | | |
| 17B24 | 43378.074 | -67583.649 | 15.344 | 323° 05' 26" | | | | | |
| | | | | | | | | | |
| | | | | | | | | | |
| 面積算出公式 | | | 面積 | 82.5052085 | 街区一画地 | | | 17-保13 | |
| $A=1/2 \sum X_n(Y_{n+1}-Y_{n-1})$ | | | 地積 | 82.50 | | | | | |

座標面積計算書

世界測地系 (測地成果2011)

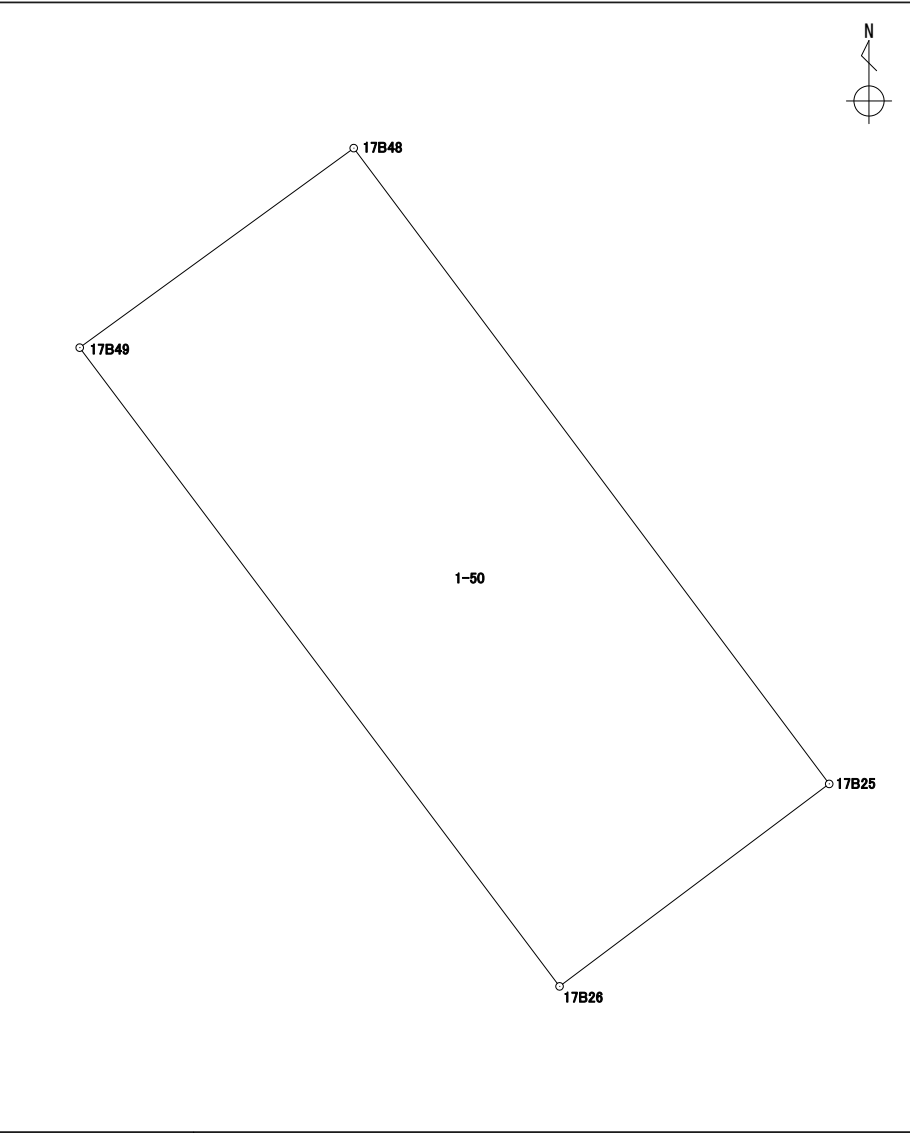
地番 1-49

| 境界点 | X | Y | 辺長 | 方向角 | 備考 |  | | | |
|-----------------------------------|-----------|------------|--------|--------------|-------|--|--|--|--|
| 17B74 | 43387.120 | -67597.166 | 15.350 | 143° 05' 34" | | | | | |
| 17B75 | 43374.846 | -67587.948 | 13.520 | 233° 05' 59" | | | | | |
| 17B25 | 43366.728 | -67598.760 | 15.256 | 323° 12' 16" | | | | | |
| 17B48 | 43378.945 | -67607.898 | 4.542 | 51° 53' 02" | | | | | |
| 17B47 | 43381.749 | -67604.324 | 7.567 | 53° 06' 59" | | | | | |
| 17B77 | 43386.291 | -67598.271 | 1.381 | 53° 07' 19" | | | | | |
| | | | | | | | | | |
| | | | | | | | | | |
| 面積算出公式 | | | 面積 | 207.1151285 | 街区一画地 | 17-14 | | | |
| $A=1/2 \sum X_n(Y_{n+1}-Y_{n-1})$ | | | 地積 | 207.11 | | | | | |

座標面積計算書

世界測地系 (測地成果2011)

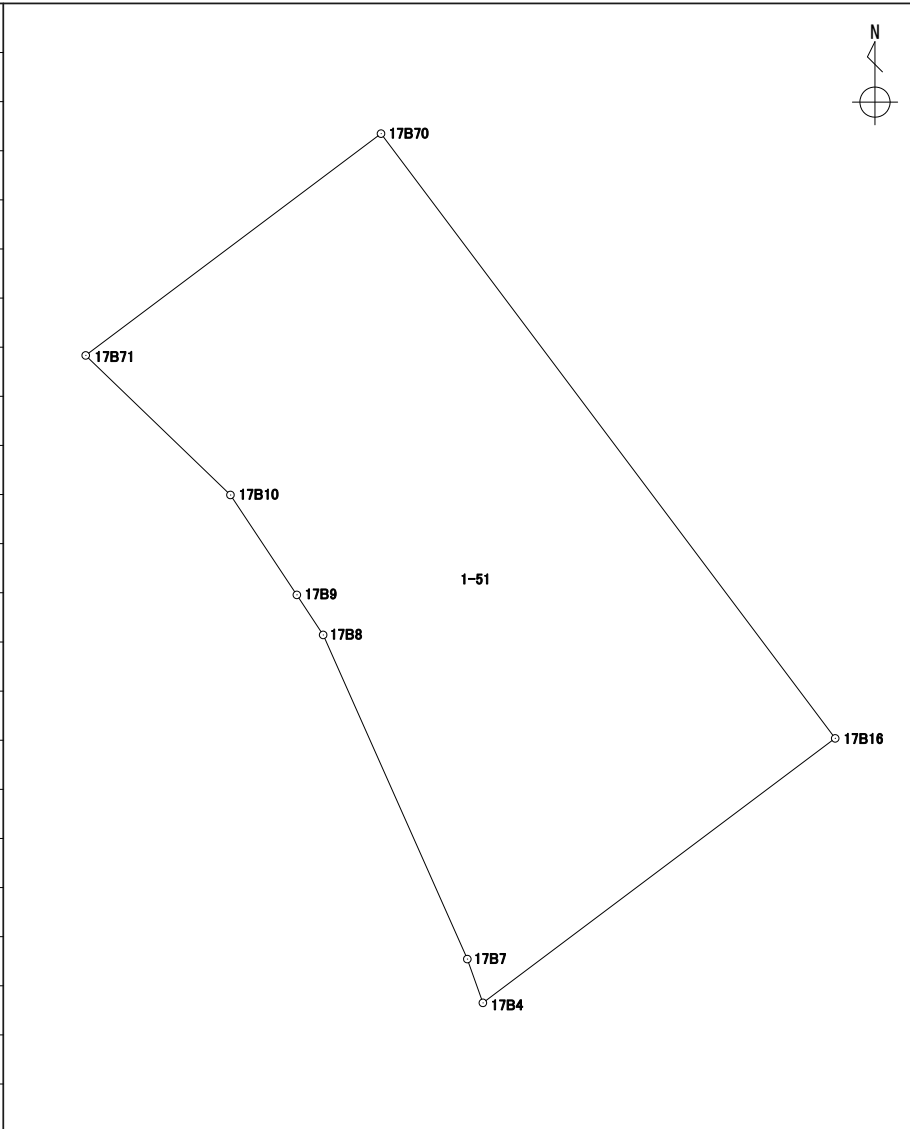
地番 1-50

| 境界点 | X | Y | 辺長 | 方向角 | 備考 |  | | | |
|--|-----------|------------|--------|--------------|-------|--|--|-------|--|
| 17B49 | 43375.111 | -67613.165 | 6.514 | 53° 56' 53" | | | | | |
| 17B48 | 43378.945 | -67607.898 | 15.256 | 143° 12' 16" | | | | | |
| 17B25 | 43366.728 | -67598.760 | 6.480 | 233° 05' 54" | | | | | |
| 17B26 | 43362.837 | -67603.942 | 15.353 | 323° 04' 40" | | | | | |
| | | | | | | | | | |
| | | | | | | | | | |
| 面積算出公式 | | | 面積 | 99.4362960 | 街区一画地 | | | 17-15 | |
| $A=1/2 \sum X_n(Y_{n+1})-Y_n(X_{n+1})$ | | | 地積 | 99.43 | | | | | |

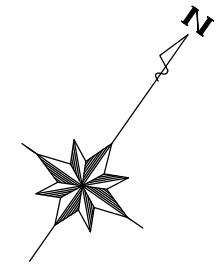
座標面積計算書

世界測地系 (測地成果2011)

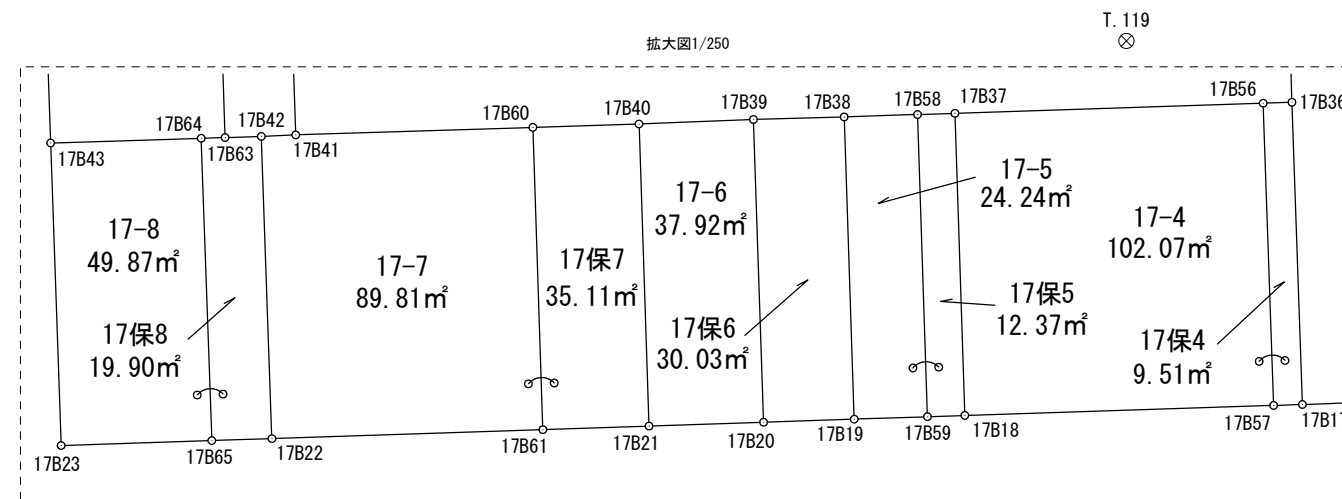
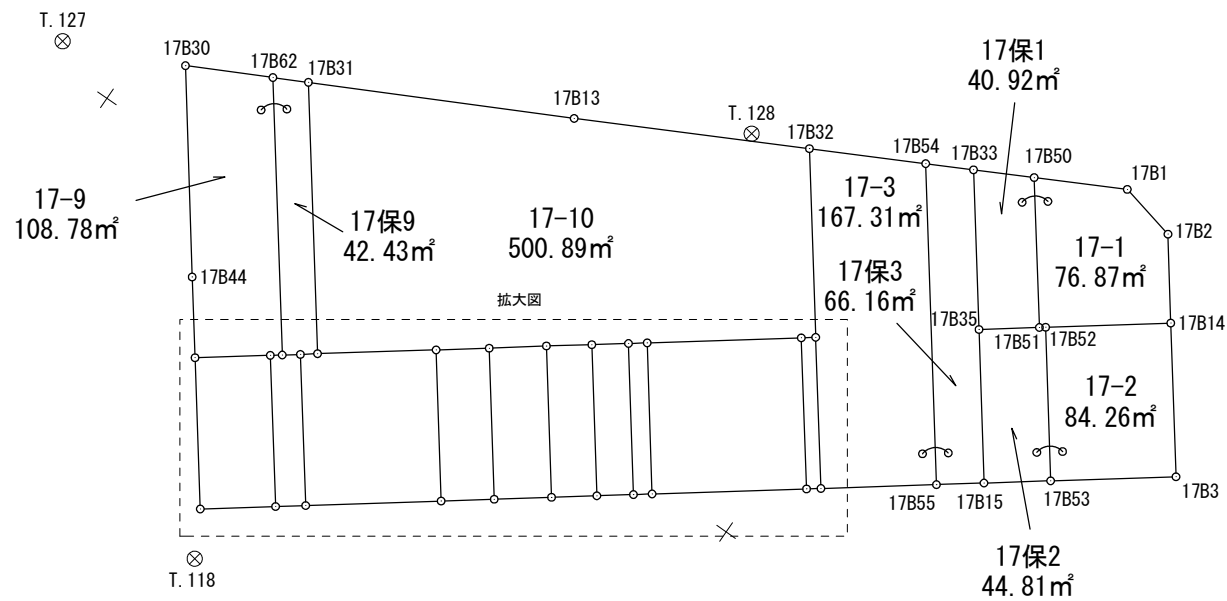
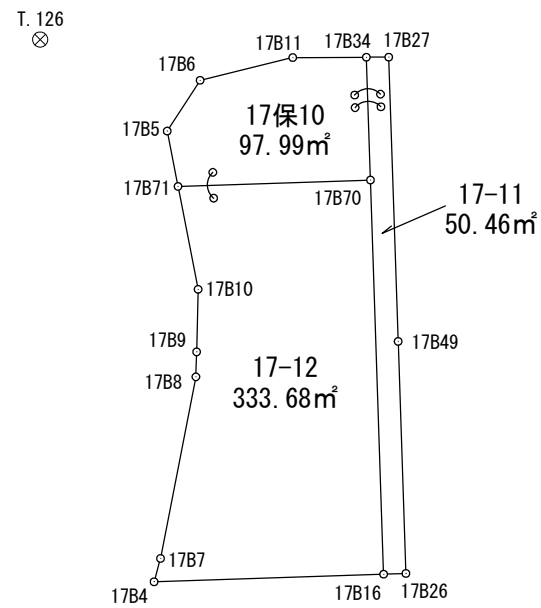
地番 1-51

| 境界点 | X | Y | 辺長 | 方向角 | 備考 |  | | | |
|---------------------------------------|-----------|------------|--------|--------------|-------|--|--|--|--|
| 17B71 | 43375.155 | -67630.972 | 12.737 | 53° 06' 11" | | | | | |
| 17B70 | 43382.802 | -67620.786 | 26.080 | 143° 05' 15" | | | | | |
| 17B16 | 43361.949 | -67605.122 | 15.193 | 233° 06' 24" | | | | | |
| 17B4 | 43352.828 | -67617.273 | 1.602 | 340° 25' 23" | | | | | |
| 17B7 | 43354.338 | -67617.810 | 12.233 | 336° 01' 13" | | | | | |
| 17B8 | 43365.516 | -67622.782 | 1.652 | 326° 42' 15" | | | | | |
| 17B9 | 43366.897 | -67623.689 | 4.137 | 326° 22' 31" | | | | | |
| 17B10 | 43370.342 | -67625.980 | 6.934 | 313° 57' 15" | | | | | |
| | | | | | | | | | |
| | | | | | | | | | |
| 面積算出公式 | | | 面積 | 333.6889725 | 街区一画地 | 17-12 | | | |
| $A=1/2 \sum X_n(Y_{(n+1)}-Y_{(n-1)})$ | | | 地積 | 333.68 | | | | | |

17街区 出来形確認図 (2025.39㎡)

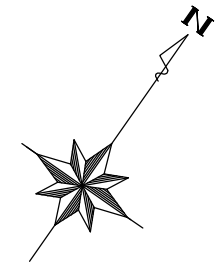
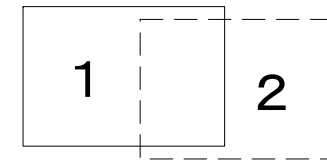


S=1:500

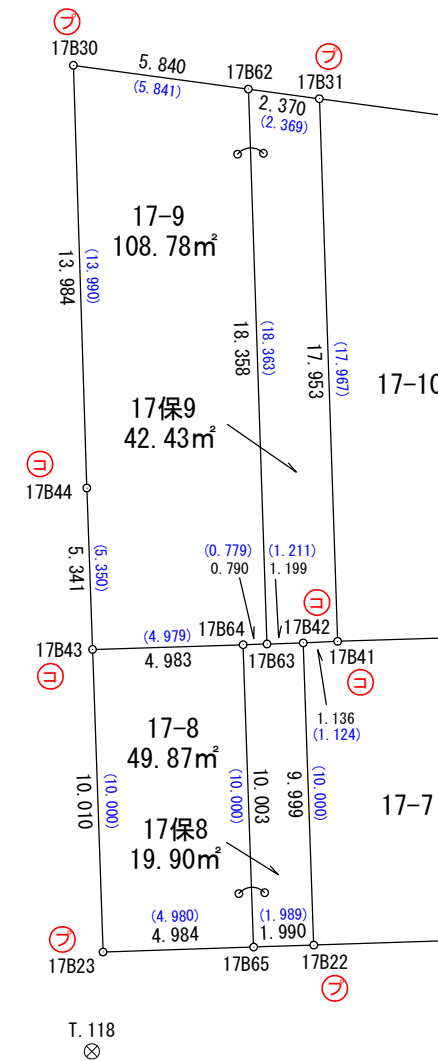
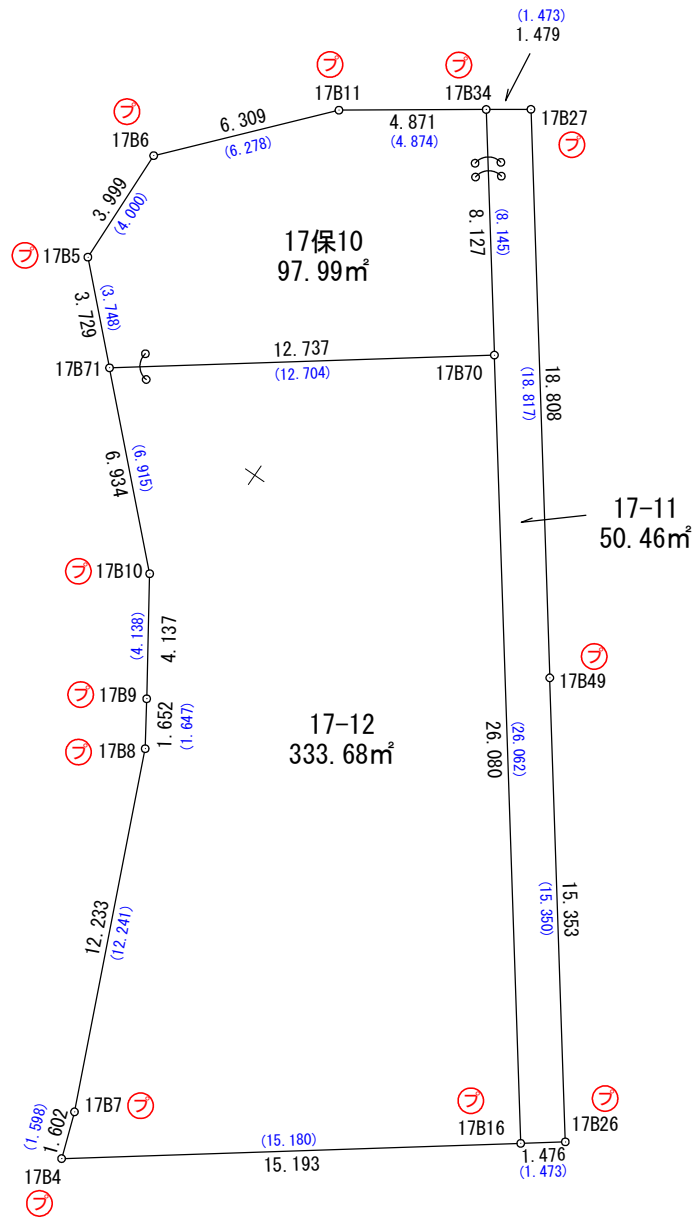


全体図

17街区 出来形確認図 (2025.39m²)



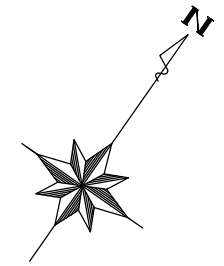
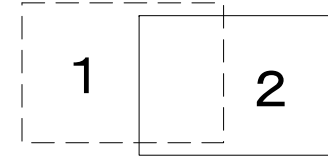
S=1:250



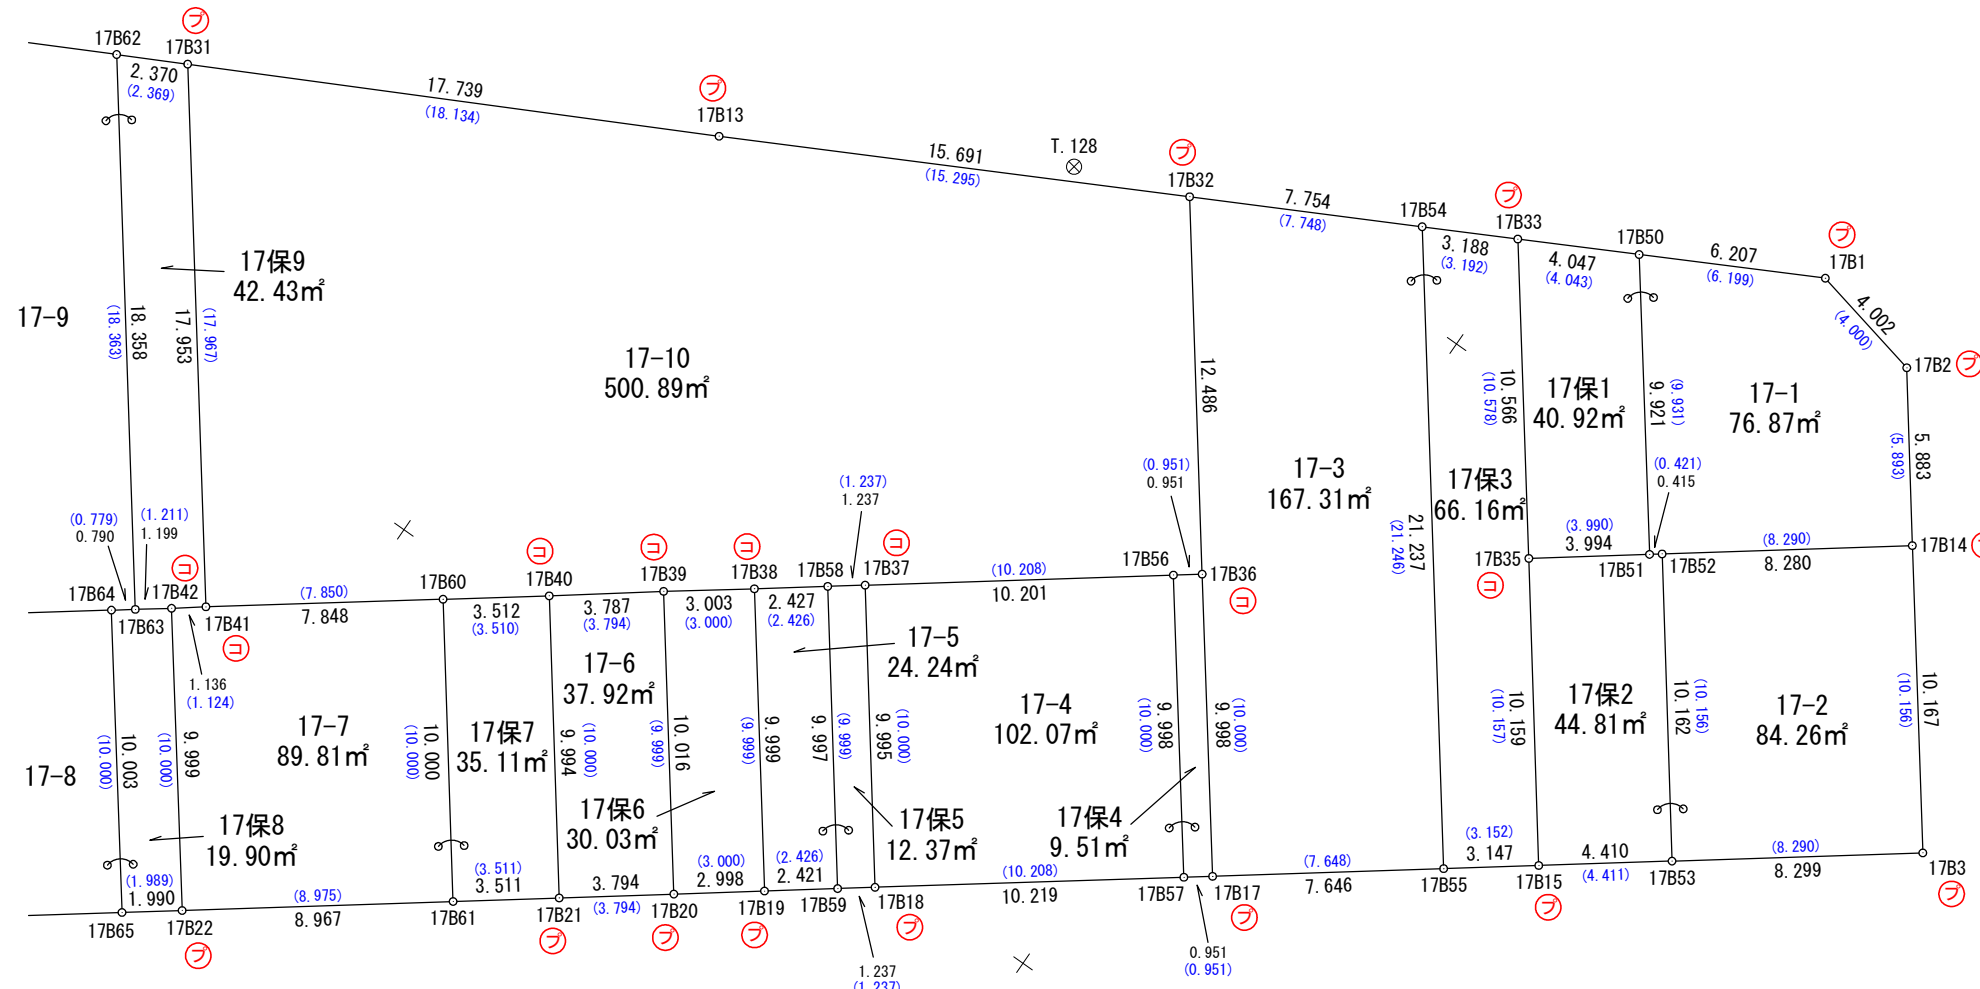
※青文字は事業計画当初の距離

| 凡 例 | |
|-----|---------|
| ⊕ | 合 成 杭 |
| ⊖ | 金 属 錐 |
| ⊗ | コンクリート杭 |
| ⊕ | 刻 み |
| ⊖ | プ レ ー ト |
| ⊗ | 基 準 点 |
| ○ | 計 算 点 |

17街区 出来形確認図 (2025.39㎡)



S=1:250



※青文字は事業計画当初の距離

| 凡 例 | |
|-----|---------|
| ⊕ | 合 成 杭 |
| ⊖ | 金 属 鉋 |
| ⊗ | コンクリート杭 |
| ⊕ | 刻 み |
| ⊖ | プ レ ー ト |
| ⊗ | 基 準 点 |
| ○ | 計 算 点 |

T. 127

T. 128

T. 118

T. 119