


北部第三地区 画地出来形確認測量原図

〈169街区〉

平成二十四年三月

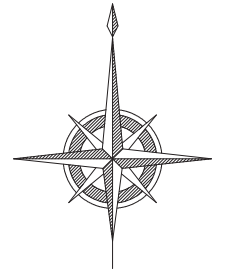

S=1:500



前橋市

画地出来形面積計算書

世界測地系


現場名：北部第三地区

地番名： 169_1

点名	Xn	Yn	距離	方向角	Yn+1-Yn-1	Xn × (Yn+1-Yn-1)
169B. 3	48459.167	-70515.493	5.321	157° 47' 34"	-3.327	-161223.648609
169B. 2	48454.241	-70513.482	5.443	72° 17' 15"	7.196	348676.718236
169B. 6	48455.897	-70508.297	5.651	340° 48' 19"	3.327	161212.769319
169B. 4	48461.234	-70510.155	5.724	248° 49' 57"	-7.196	-348727.039864

倍面積合計	-61.200918
1/2	30.6004590

合計面積	30.6004590
------	------------

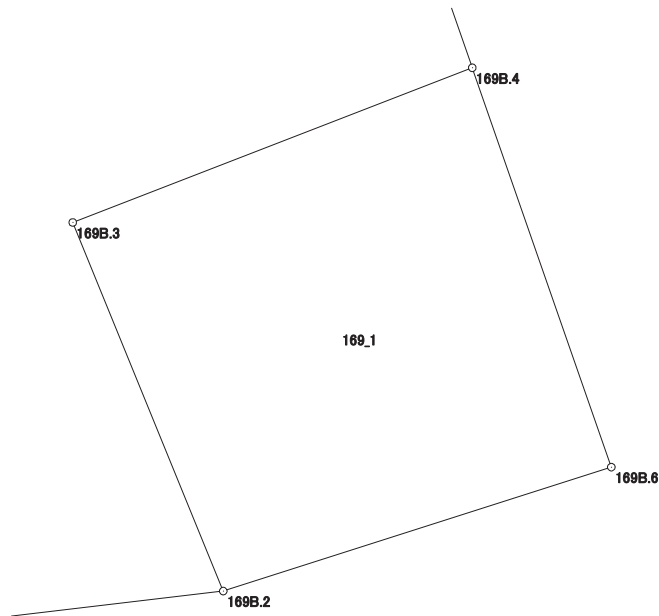

画地出来形面積計算書

世界測地系

現場名：北部第三地区

地番名： 169_2

点名	Xn	Yn	距離	方向角	Yn+1-Yn-1	Xn × (Yn+1-Yn-1)
K307	48474.154	-70533.220	20.535	155° 01' 56"	6.731	326279.530574
K306	48455.538	-70524.552	2.957	143° 59' 54"	10.406	504228.328428
169B.1	48453.146	-70522.814	9.396	83° 18' 27"	11.070	536376.326220
169B.2	48454.241	-70513.482	5.321	337° 47' 34"	7.321	354733.498361
169B.3	48459.167	-70515.493	5.724	68° 49' 57"	3.327	161223.648609
169B.4	48461.234	-70510.155	41.618	340° 48' 41"	-8.341	-404215.152794
169B.5	48500.540	-70523.834	5.038	273° 17' 59"	-18.709	-907396.602860
K310	48500.830	-70528.864	6.689	182° 57' 54"	-5.376	-260740.462080
K309	48494.150	-70529.210	13.508	188° 49' 40"	-2.419	-117307.348850
K308	48480.802	-70531.283	6.924	196° 14' 40"	-4.010	-194408.016020

倍面積合計	-1226.250412
1/2	613.1252060

合計面積	613.1252060
------	-------------

