
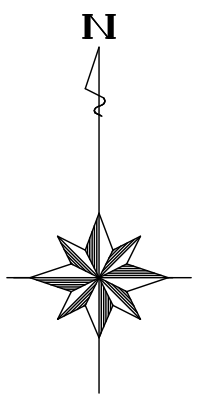


100街区 出来形確認測量図

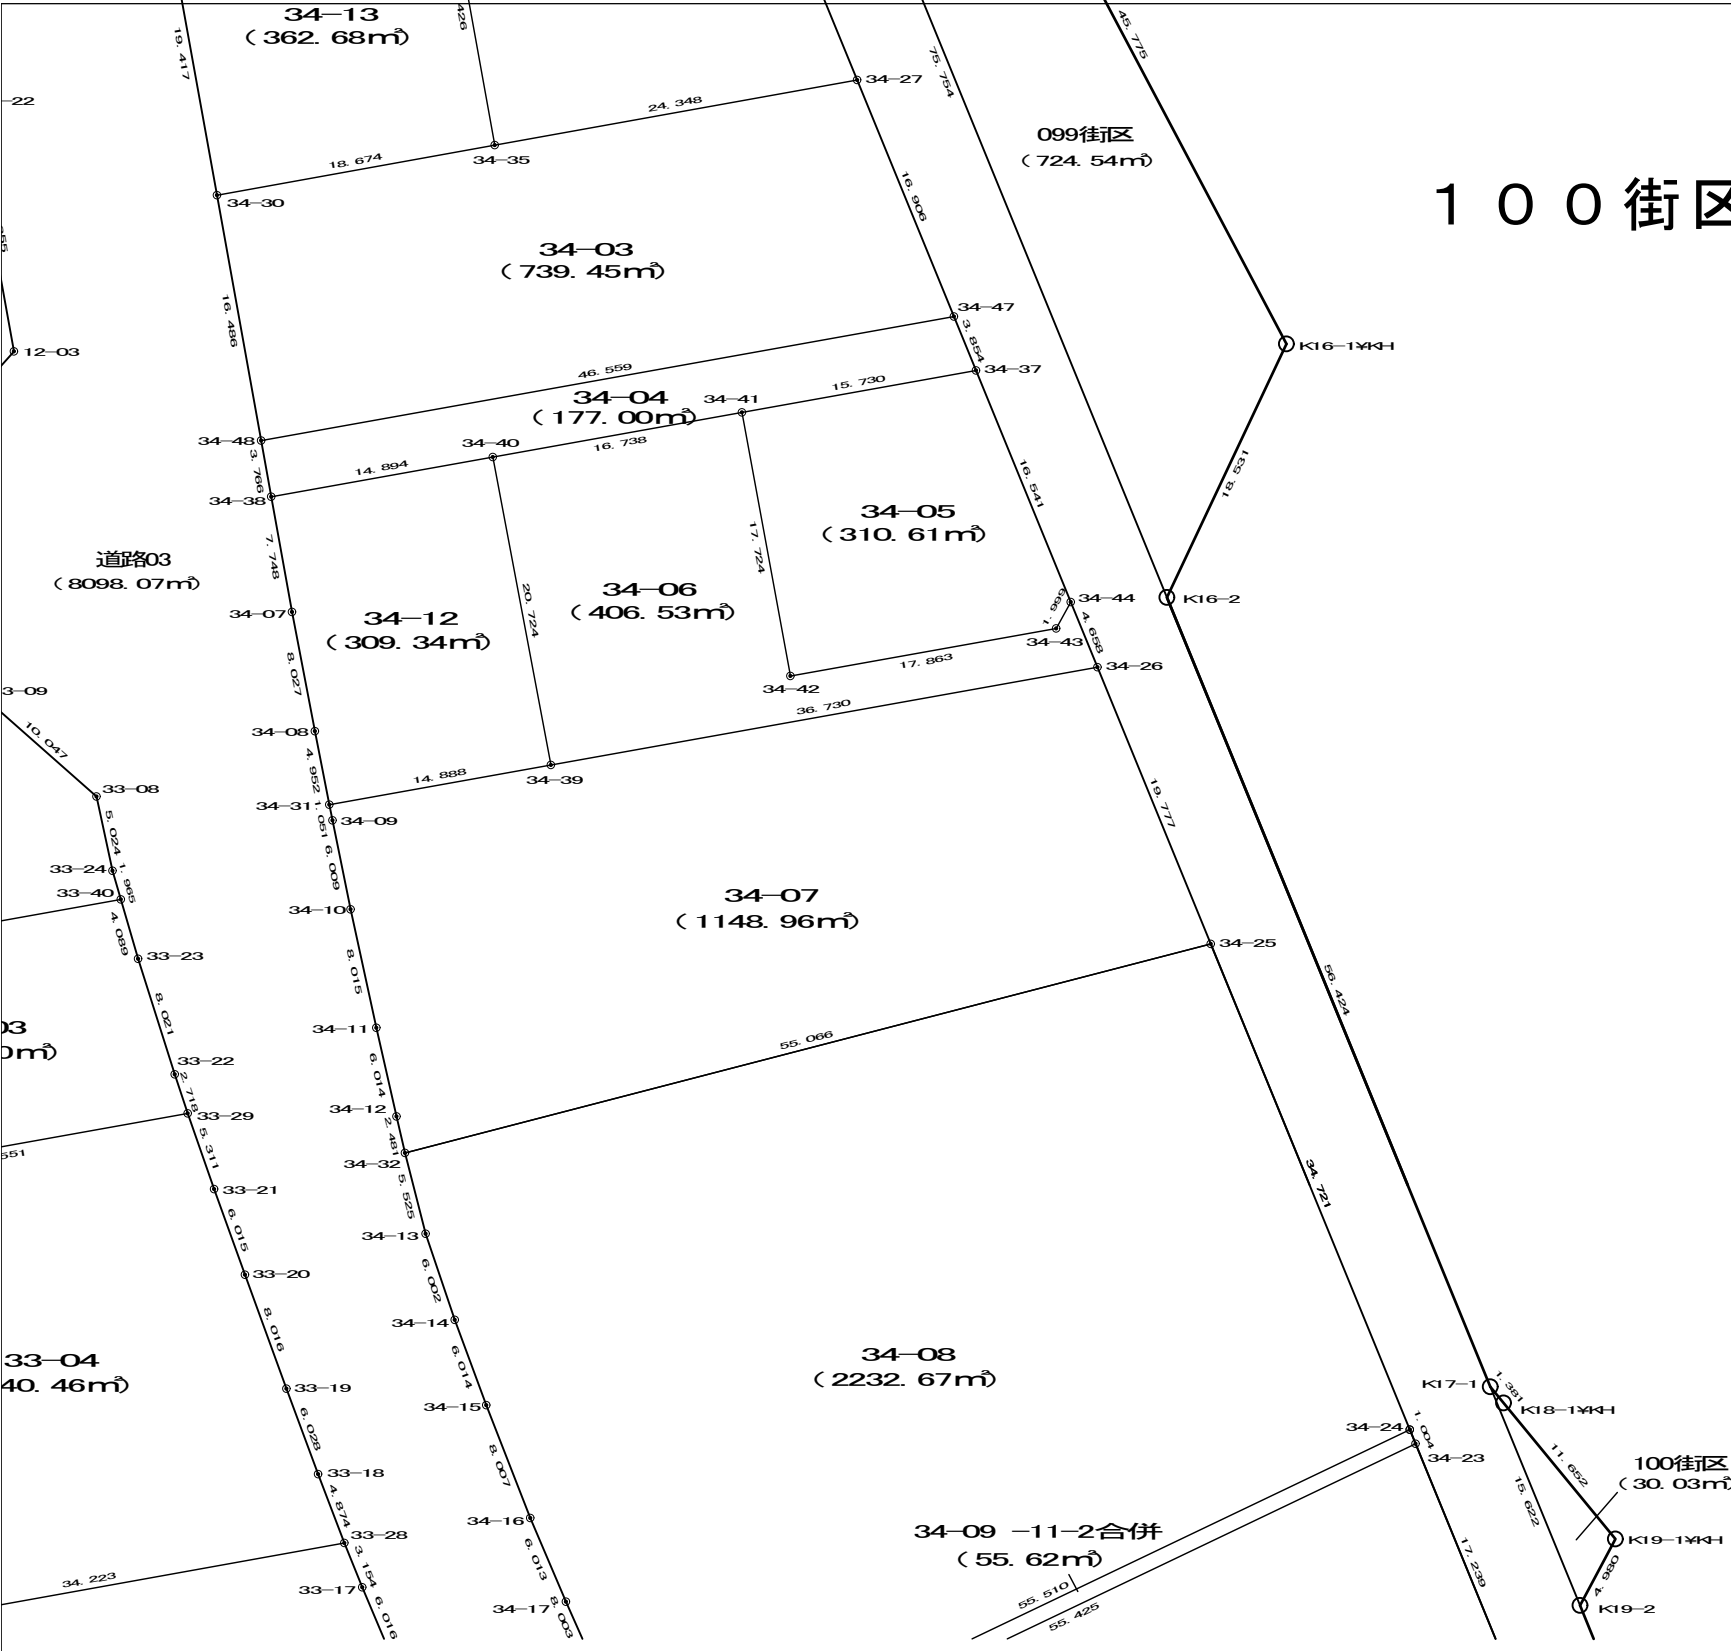

縮尺 1 : 500

画地面積(座標法)計算簿

画地番号：100街区

点名	Xn	Yn	距離	方向角	X _{n+1} -X _{n-1}	Y _{n+1} -Y _{n-1}	X _n *(Y _{n+1} -Y _{n-1})	Y _n *(X _{n+1} -X _{n-1})
K17-1	47902.262	-70887.599	1.381	140° 26' 00"	13.385	-5.058	-242289.641196	-948830.512615
K18-1	47901.197	-70886.719	11.652	140° 31' 09"	-10.059	8.289	397053.021933	713049.506421
K19-1	47892.203	-70879.310	4.980	208° 09' 55"	-13.385	5.058	242238.762774	948719.564350
K19-2	47887.812	-70881.661	15.622	337° 39' 38"	10.059	-8.289	-396942.073668	-712998.627999
							倍面積	60.069843
							面積	30.0349215
							地積	30.03