




101-1街区 出来形確認測量図
101-2街区

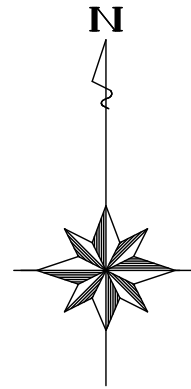


縮尺 1 : 500

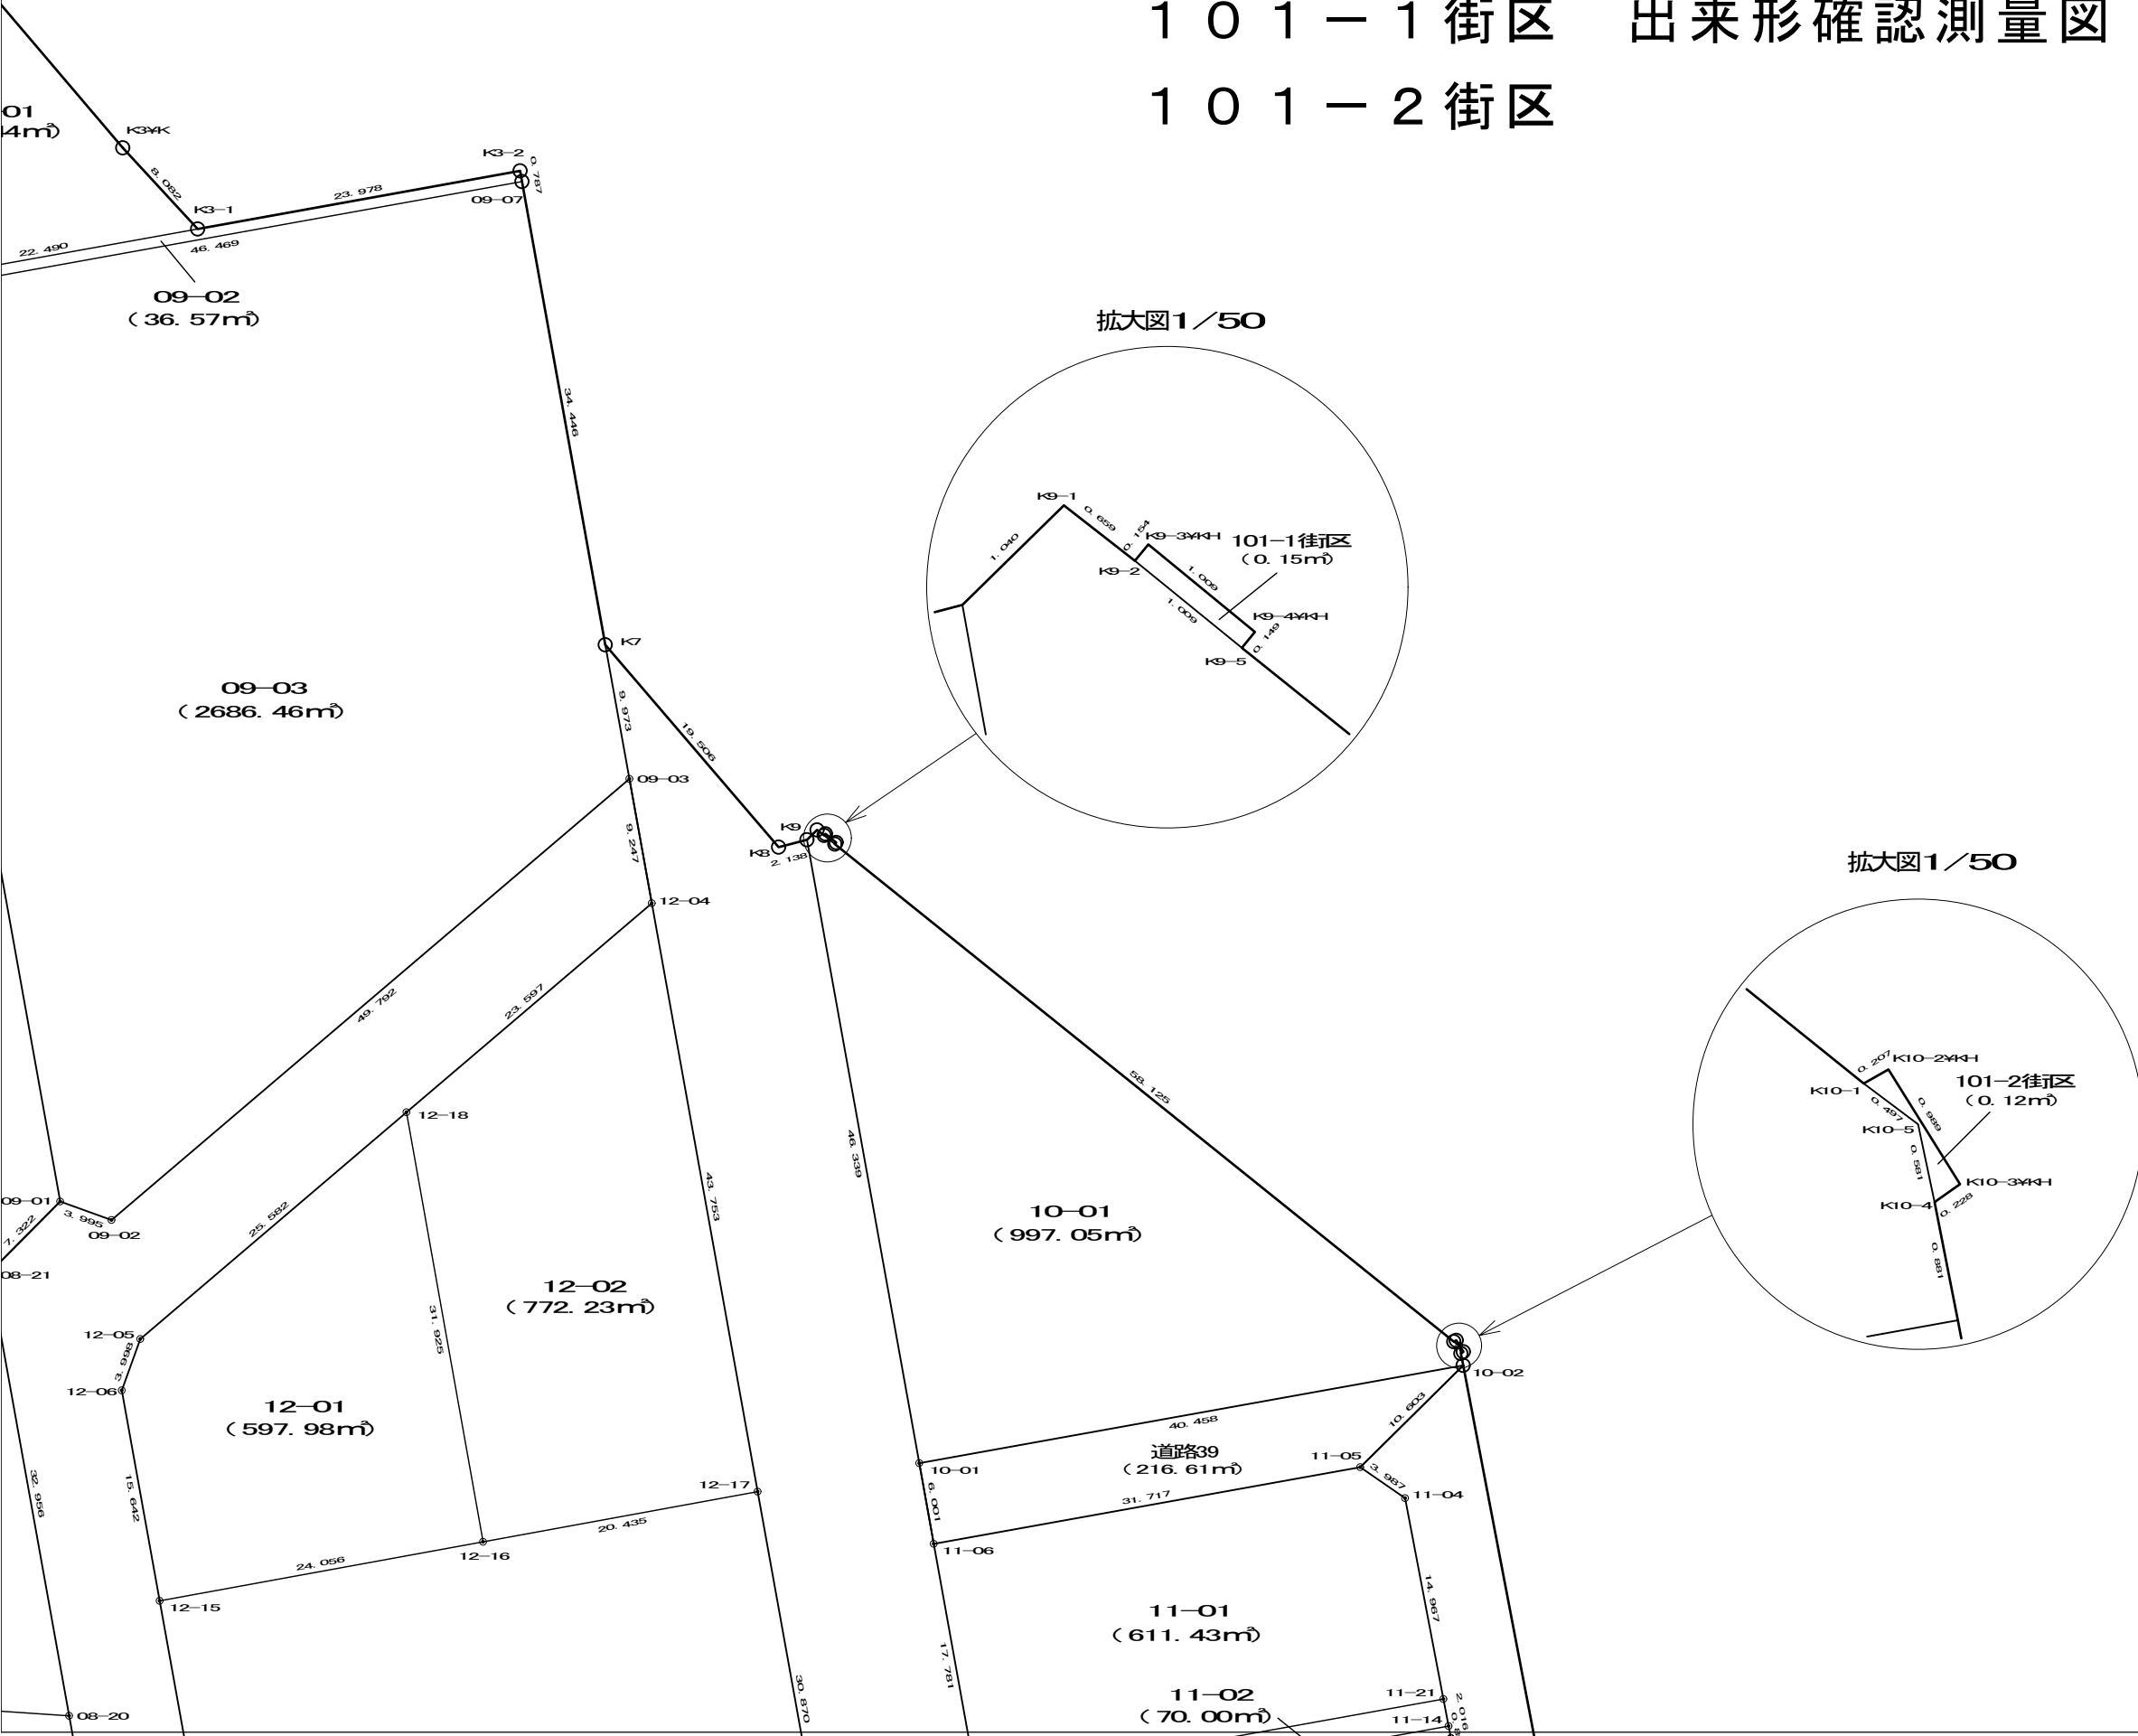


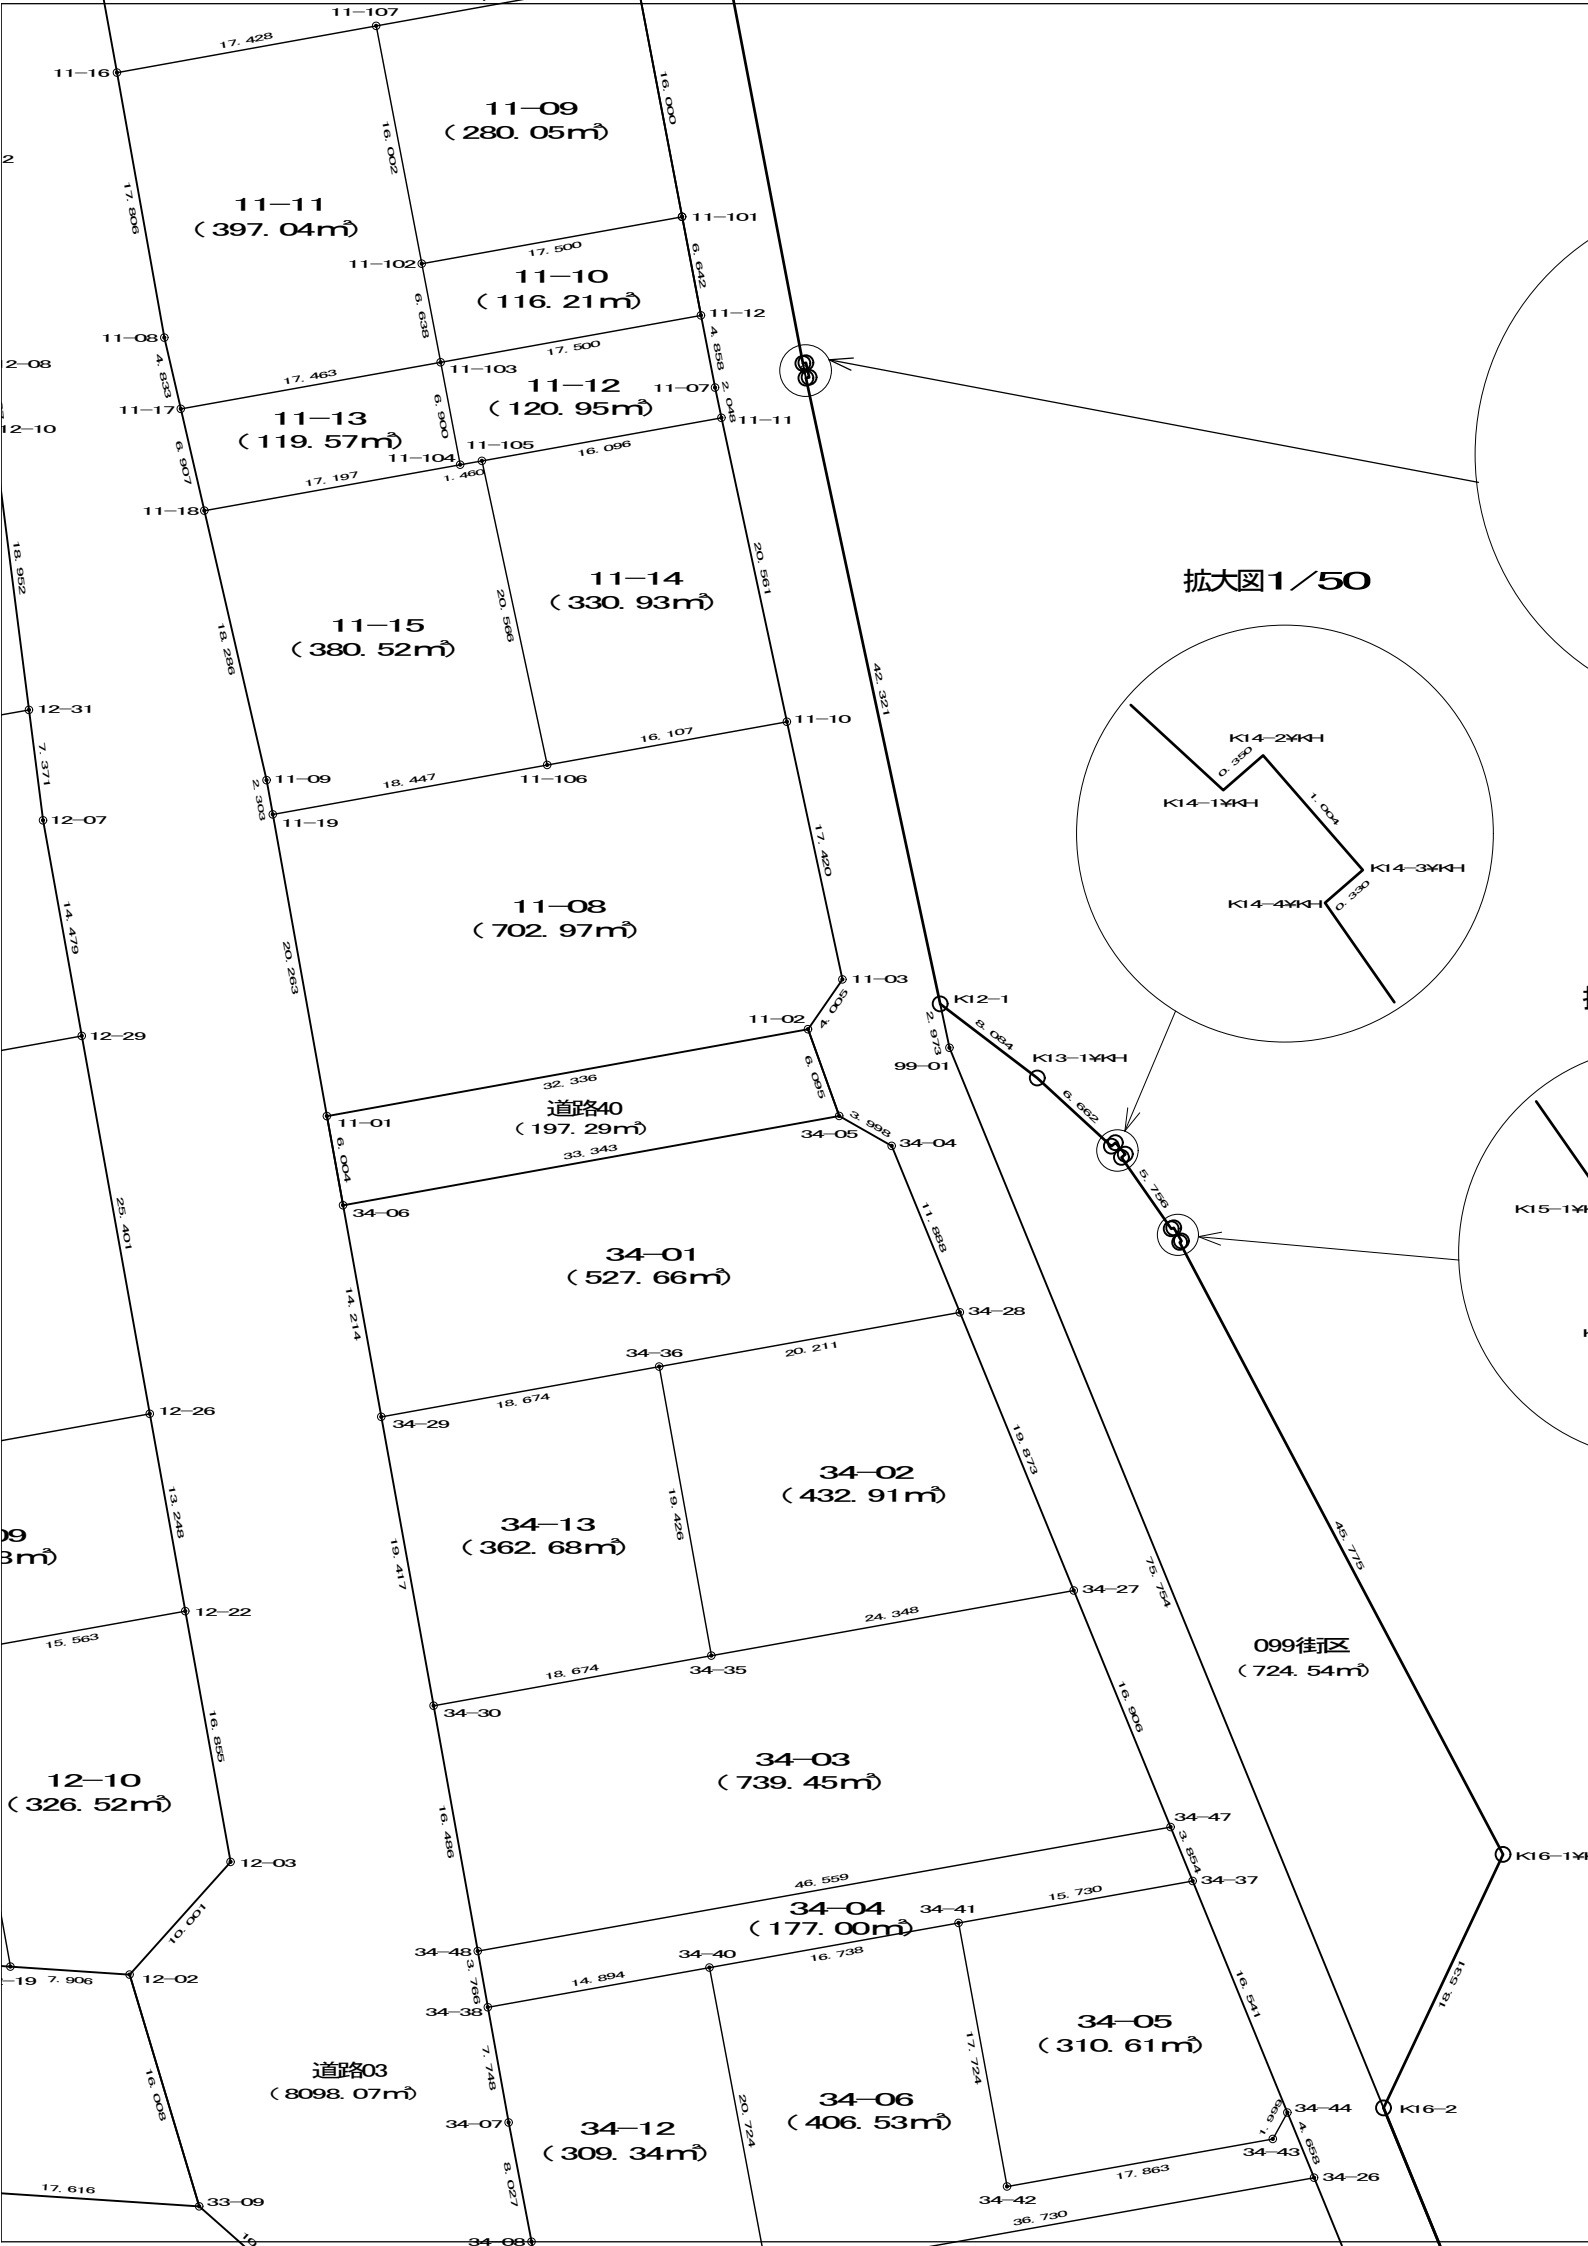


拡大図1/50

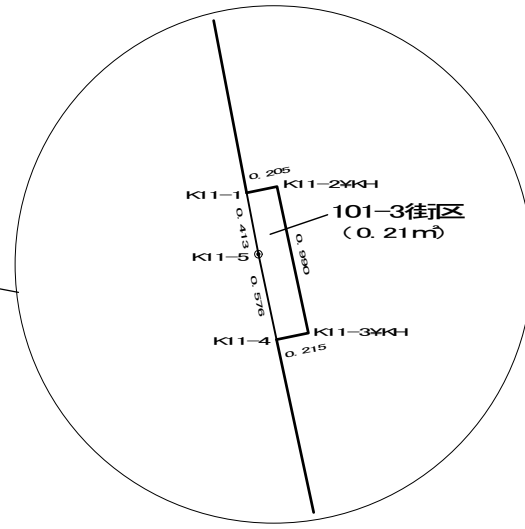


拡大図1/50

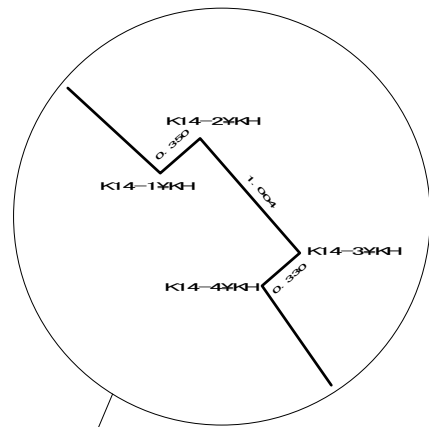

拡大図1/50

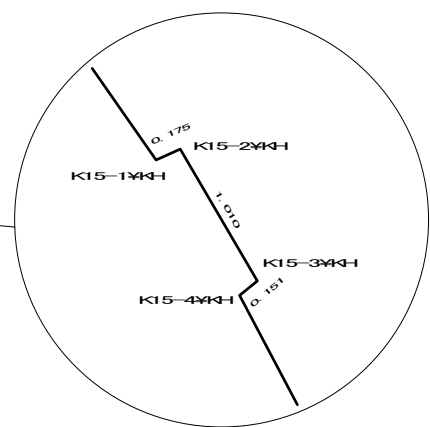


99街区 出来形確認測量図
101-3街区

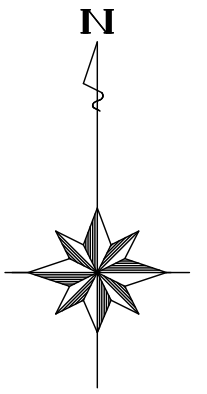


縮尺1:500


拡大図 1/50

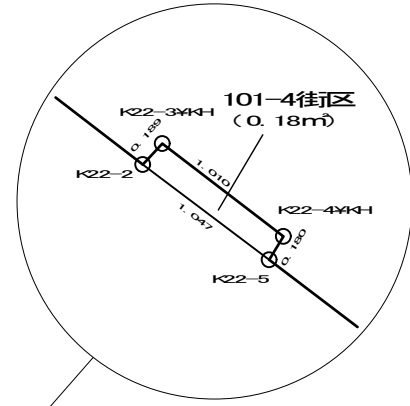


拡大図 1/50

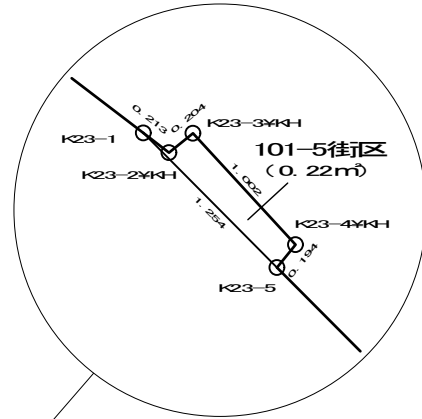


拡大図 1/50

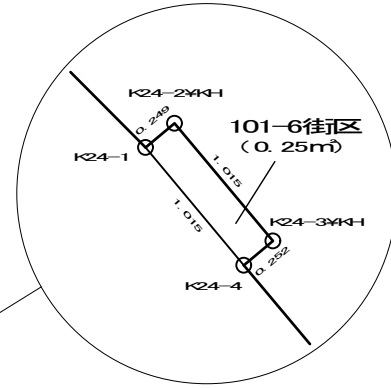


拡大図 1/50

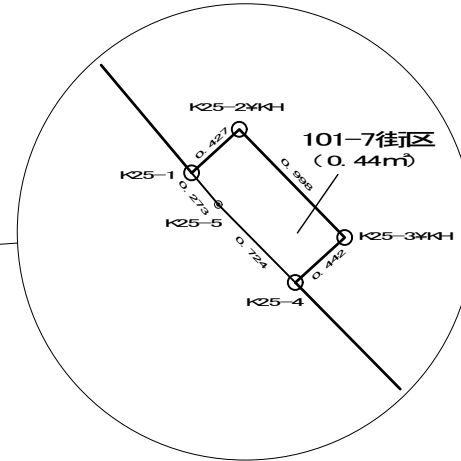

拡大図 1/50

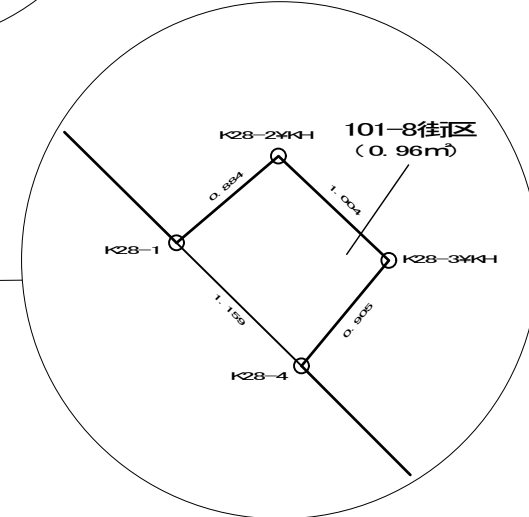

101-4街区 出来形確認測量図
 101-5街区
 101-6街区
 101-7街区
 101-8街区

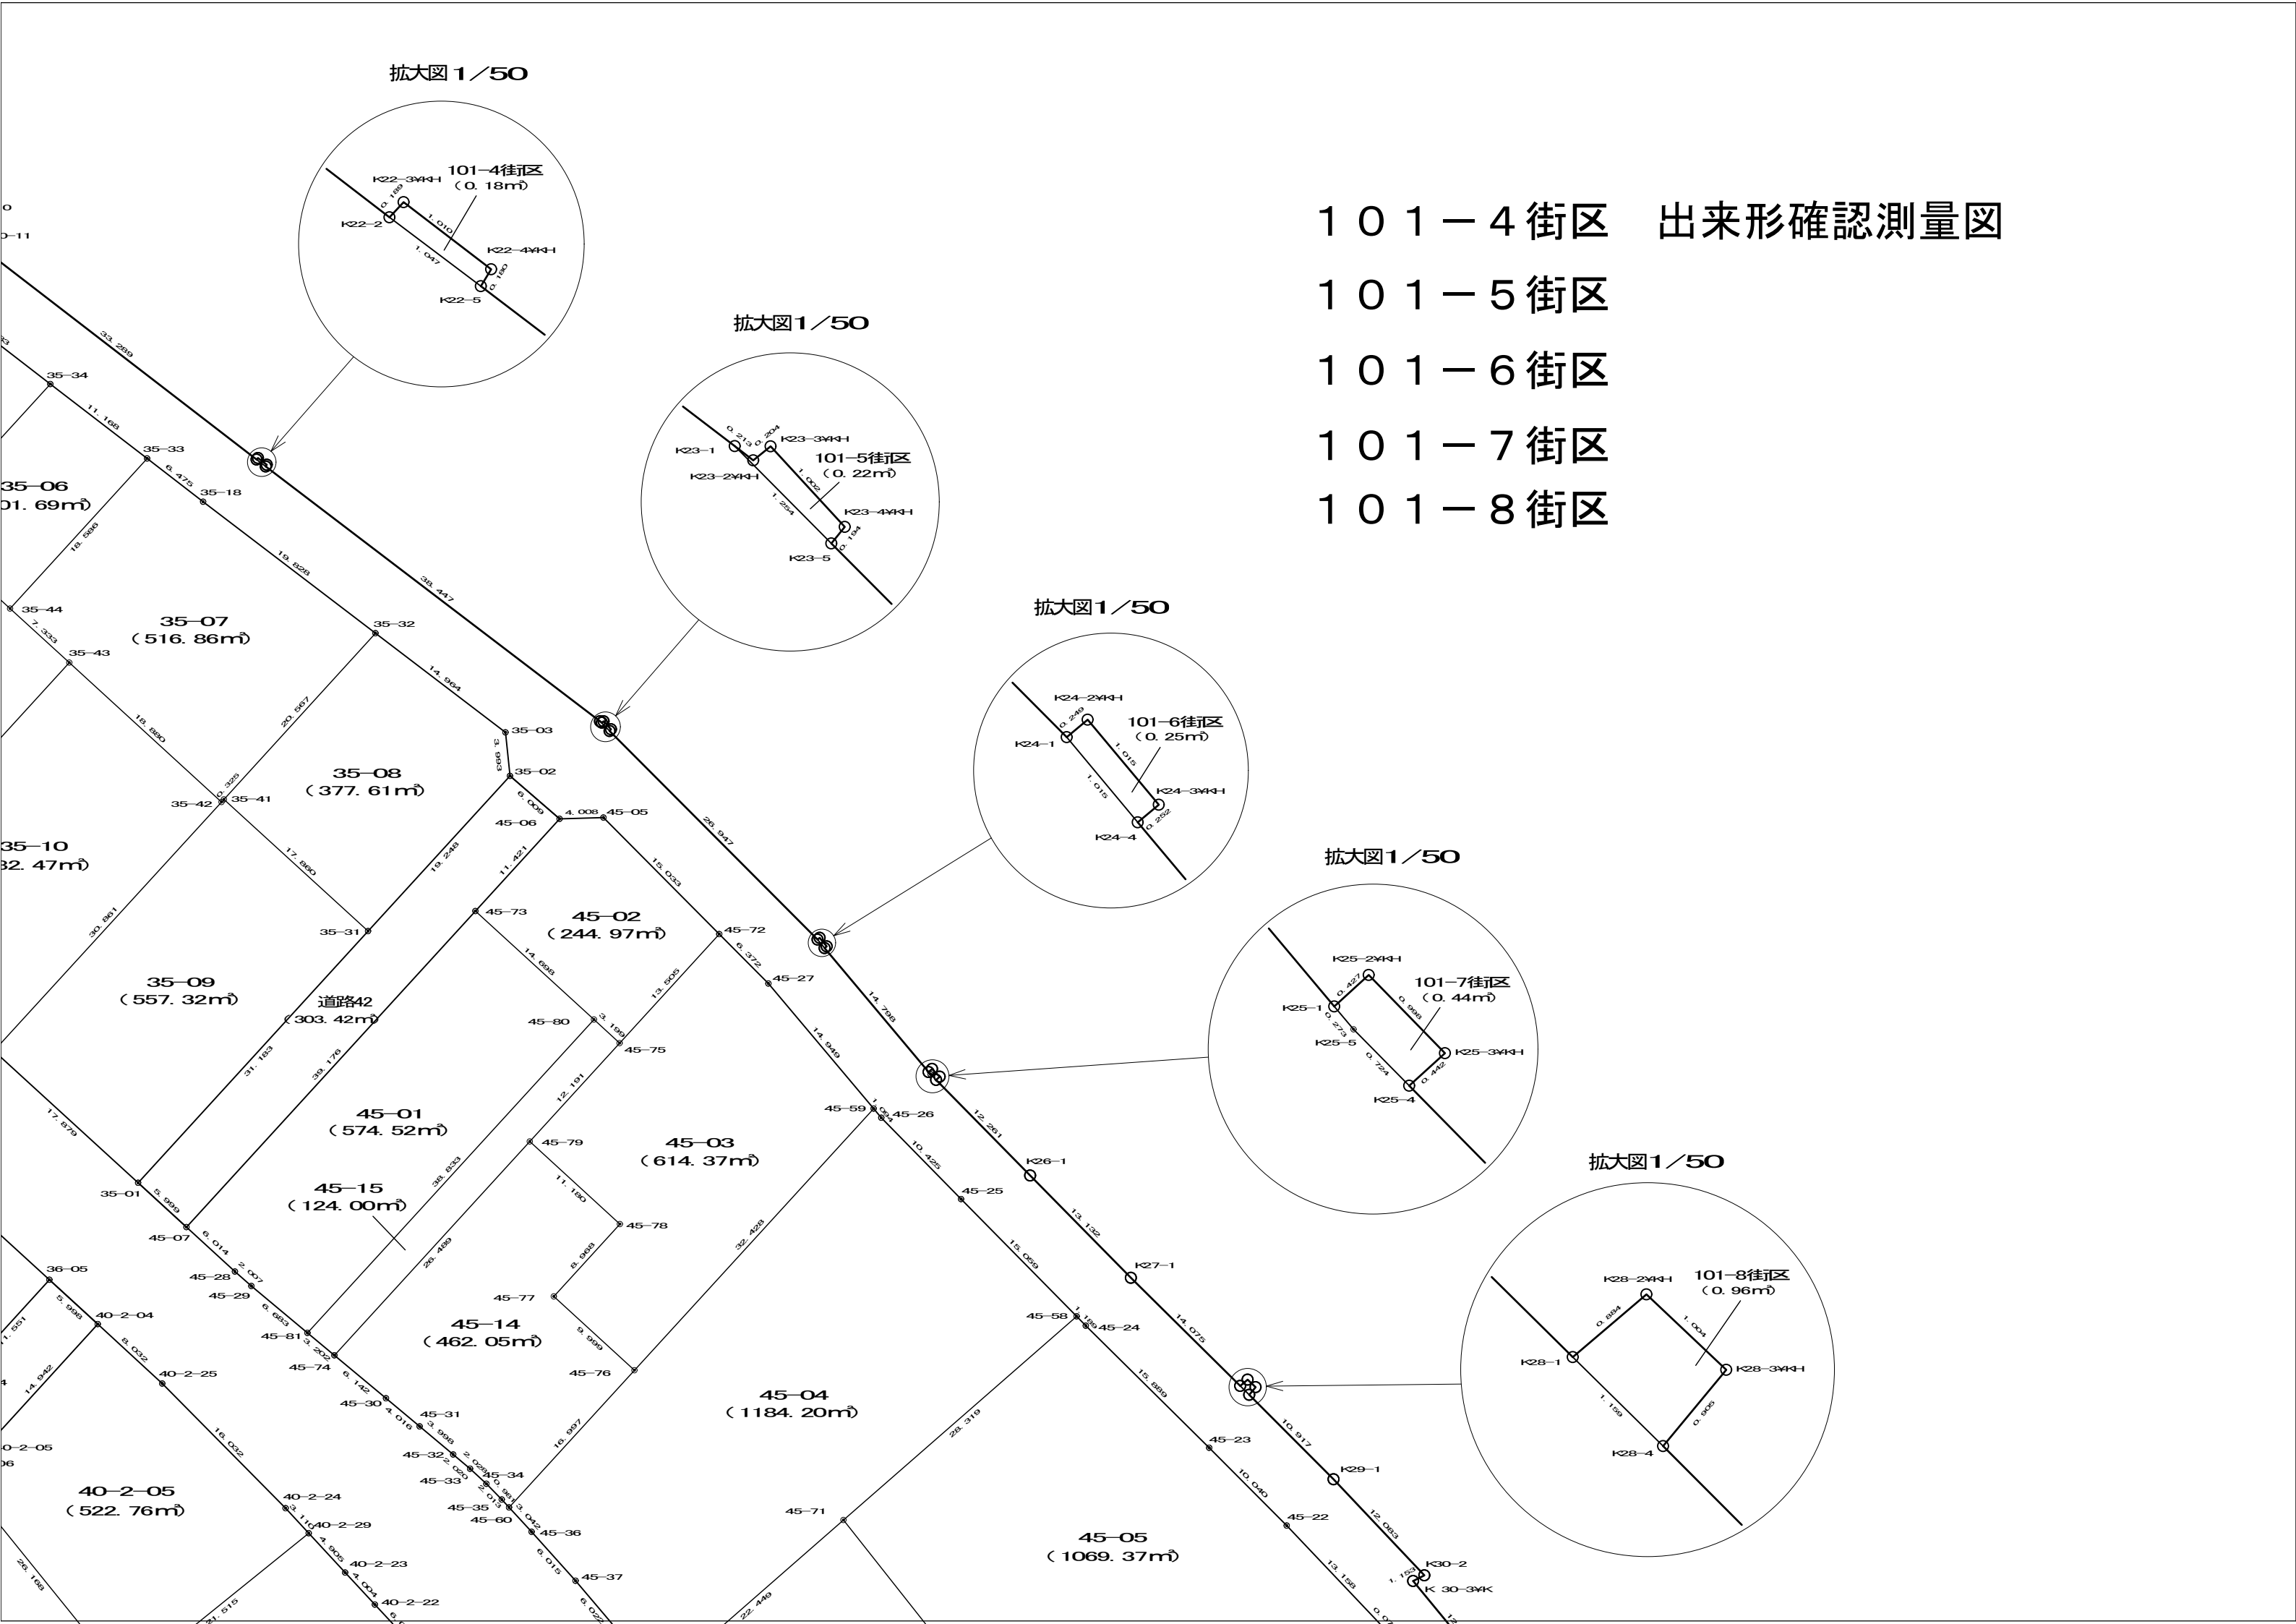

画地面積(座標法)計算簿

画地番号：101-1街区

点名	Xn	Yn	距離	方向角	X _{n+1} -X _{n-1}	Y _{n+1} -Y _{n-1}	X _n *(Y _{n+1} -Y _{n-1})	Y _n *(X _{n+1} -X _{n-1})
K9-2	48178.562	-71007.572	0.154	39° 14' 15"	0.757	-0.685	-33002.314970	-53752.732004
K9-3ㄗKH	48178.682	-71007.474	1.009	129° 24' 47"	-0.521	0.878	42300.882796	36994.893954
K9-4ㄗKH	48178.041	-71006.694	0.149	219° 18' 59"	-0.757	0.685	33001.958085	53752.067358
K9-5	48177.925	-71006.789	1.009	309° 07' 47"	0.521	-0.878	-42300.218150	-36994.537069
							倍面積	0.307761
							面積	0.1538805
							地積	0.15

画地面積(座標法)計算簿

画地番号：101-2街区

点名	Xn	Yn	距離	方向角	X _{n+1} -X _{n-1}	Y _{n+1} -Y _{n-1}	X _n *(Y _{n+1} -Y _{n-1})	Y _n *(X _{n+1} -X _{n-1})
K10-1	48141.518	-70961.478	0.207	60° 35' 50"	0.401	-0.217	-10446.709406	-28455.552678
K10-2 YKH	48141.620	-70961.297	0.989	148° 00' 47"	-0.737	0.705	33939.842100	52298.475889
K10-3 YKH	48140.781	-70960.773	0.228	234° 59' 15"	-0.970	0.337	16223.443197	68831.949810
K10-4	48140.650	-70960.960	0.581	348° 05' 28"	0.438	-0.307	-14779.179550	-31080.900480
K10-5	48141.219	-70961.080	0.497	306° 54' 57"	0.868	-0.518	-24937.151442	-61594.217440
							倍面積	0.244899
							面積	0.1224495
							地積	0.12

画地面積(座標法)計算簿

画地番号：101-3街区

点名	Xn	Yn	距離	方向角	X _{n+1} -X _{n-1}	Y _{n+1} -Y _{n-1}	X _n *(Y _{n+1} -Y _{n-1})	Y _n *(X _{n+1} -X _{n-1})
K11-1	48069.837	-70947.393	0.205	78° 28' 15"	0.447	0.123	5912.589951	-31713.484671
K11-2	48069.878	-70947.192	0.990	167° 52' 22"	-0.927	0.409	19660.580102	65768.046984
K11-3	48068.910	-70946.984	0.215	258° 28' 53"	-1.011	-0.003	-144.206730	71727.400824
K11-4	48068.867	-70947.195	0.576	347° 59' 19"	0.521	-0.331	-15910.794977	-36963.488595
K11-5	48069.431	-70947.315	0.413	349° 07' 30"	0.970	-0.198	-9517.747338	-68818.895550
							倍面積	0.421008
							面積	0.2105040
							地積	0.21

画地面積(座標法)計算簿

画地番号：101-4街区

点名	Xn	Yn	距離	方向角	X _{n+1} -X _{n-1}	Y _{n+1} -Y _{n-1}	X _n *(Y _{n+1} -Y _{n-1})	Y _n *(X _{n+1} -X _{n-1})
K22-2	47817.313	-70826.428	0.189	42° 51' 47"	0.768	-0.708	-33854.657604	-54394.696704
K22-3¥KH	47817.452	-70826.299	1.010	127° 26' 14"	-0.475	0.931	44518.047812	33642.492025
K22-4¥KH	47816.838	-70825.497	0.180	211° 23' 58"	-0.768	0.708	33854.321304	54393.981696
K22-5	47816.684	-70825.591	1.047	306° 55' 29"	0.475	-0.931	-44517.332804	-33642.155725
倍面積								0.378708
面積								0.1893540
地積								0.18

画地面積(座標法)計算簿

画地番号：101-5街区

点名	Xn	Yn	距離	方向角	X _{n+1} -X _{n-1}	Y _{n+1} -Y _{n-1}	X _n *(Y _{n+1} -Y _{n-1})	Y _n *(X _{n+1} -X _{n-1})
K23-1	47793.381	-70795.010	0.213	127° 34' 07"	0.760	-0.715	-34172.267415	-53804.207600
K23-2¥KH	47793.251	-70794.841	0.204	51° 09' 53"	-0.002	0.328	15676.186328	141.589682
K23-3¥KH	47793.379	-70794.682	1.002	137° 20' 44"	-0.609	0.838	40050.851602	43113.961338
K23-4¥KH	47792.642	-70794.003	0.194	219° 09' 55"	-0.888	0.556	26572.708952	62865.074664
K23-5	47792.491	-70794.126	1.254	315° 11' 38"	0.739	-1.007	-48127.038437	-52316.859114
							倍面積	0.441030
							面積	0.2205150
							地積	0.22

画地面積(座標法)計算簿

画地番号：101-6街区

点名	Xn	Yn	距離	方向角	X _{n+1} -X _{n-1}	Y _{n+1} -Y _{n-1}	X _n *(Y _{n+1} -Y _{n-1})	Y _n *(X _{n+1} -X _{n-1})
K24-1	47773.403	-70775.104	0.249	50° 11' 40"	0.940	-0.458	-21880.218574	-66528.597760
K24-2¥KH	47773.563	-70774.912	1.015	140° 02' 08"	-0.618	0.844	40320.887172	43738.895616
K24-3¥KH	47772.785	-70774.260	0.252	230° 08' 11"	-0.940	0.458	21879.935530	66527.804400
K24-4	47772.623	-70774.454	1.015	320° 11' 40"	0.618	-0.844	-40320.093812	-43738.612572
							倍面積	0.510316
							面積	0.2551580
							地積	0.25

画地面積(座標法)計算簿

画地番号：101-7街区

点名	Xn	Yn	距離	方向角	X _{n+1} -X _{n-1}	Y _{n+1} -Y _{n-1}	X _n *(Y _{n+1} -Y _{n-1})	Y _n *(X _{n+1} -X _{n-1})
K25-1	47761.292	-70764.936	0.427	47° 39' 15"	0.497	0.139	6638.819588	-35170.173192
K25-2¥KH	47761.580	-70764.620	0.998	135° 43' 49"	-0.427	1.013	48382.480540	30216.492740
K25-3¥KH	47760.865	-70763.923	0.442	227° 39' 24"	-1.013	0.370	17671.520050	71683.853999
K25-4	47760.567	-70764.250	0.724	315° 23' 29"	0.218	-0.836	-39927.834012	-15426.606500
K25-5	47761.083	-70764.759	0.273	319° 44' 21"	0.725	-0.686	-32764.102938	-51304.450275
							倍面積	0.883228
							面積	0.4416140
							地積	0.44

画地面積(座標法)計算簿

画地番号：101-8街区

点名	Xn	Yn	距離	方向角	X _{n+1} -X _{n-1}	Y _{n+1} -Y _{n-1}	X _n *(Y _{n+1} -Y _{n-1})	Y _n *(X _{n+1} -X _{n-1})
K28-1	47732.585	-70736.414	0.884	49° 37' 50"	1.387	-0.152	-7255.352920	-98111.406218
K28-2¥KH	47733.158	-70735.740	1.004	133° 23' 11"	-0.117	1.404	67017.353832	8276.081580
K28-3¥KH	47732.468	-70735.010	0.905	219° 40' 04"	-1.387	0.152	7255.335136	98109.458870
K28-4	47731.771	-70735.588	1.159	314° 34' 51"	0.117	-1.404	-67015.406484	-8276.063796
							倍面積	1.929564
							面積	0.9647820
							地積	0.96
							合計地積	472367.89