
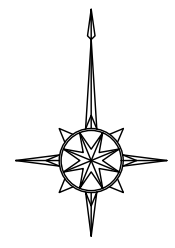


21-1街区 画地出来形確認図 (9819.95m²)

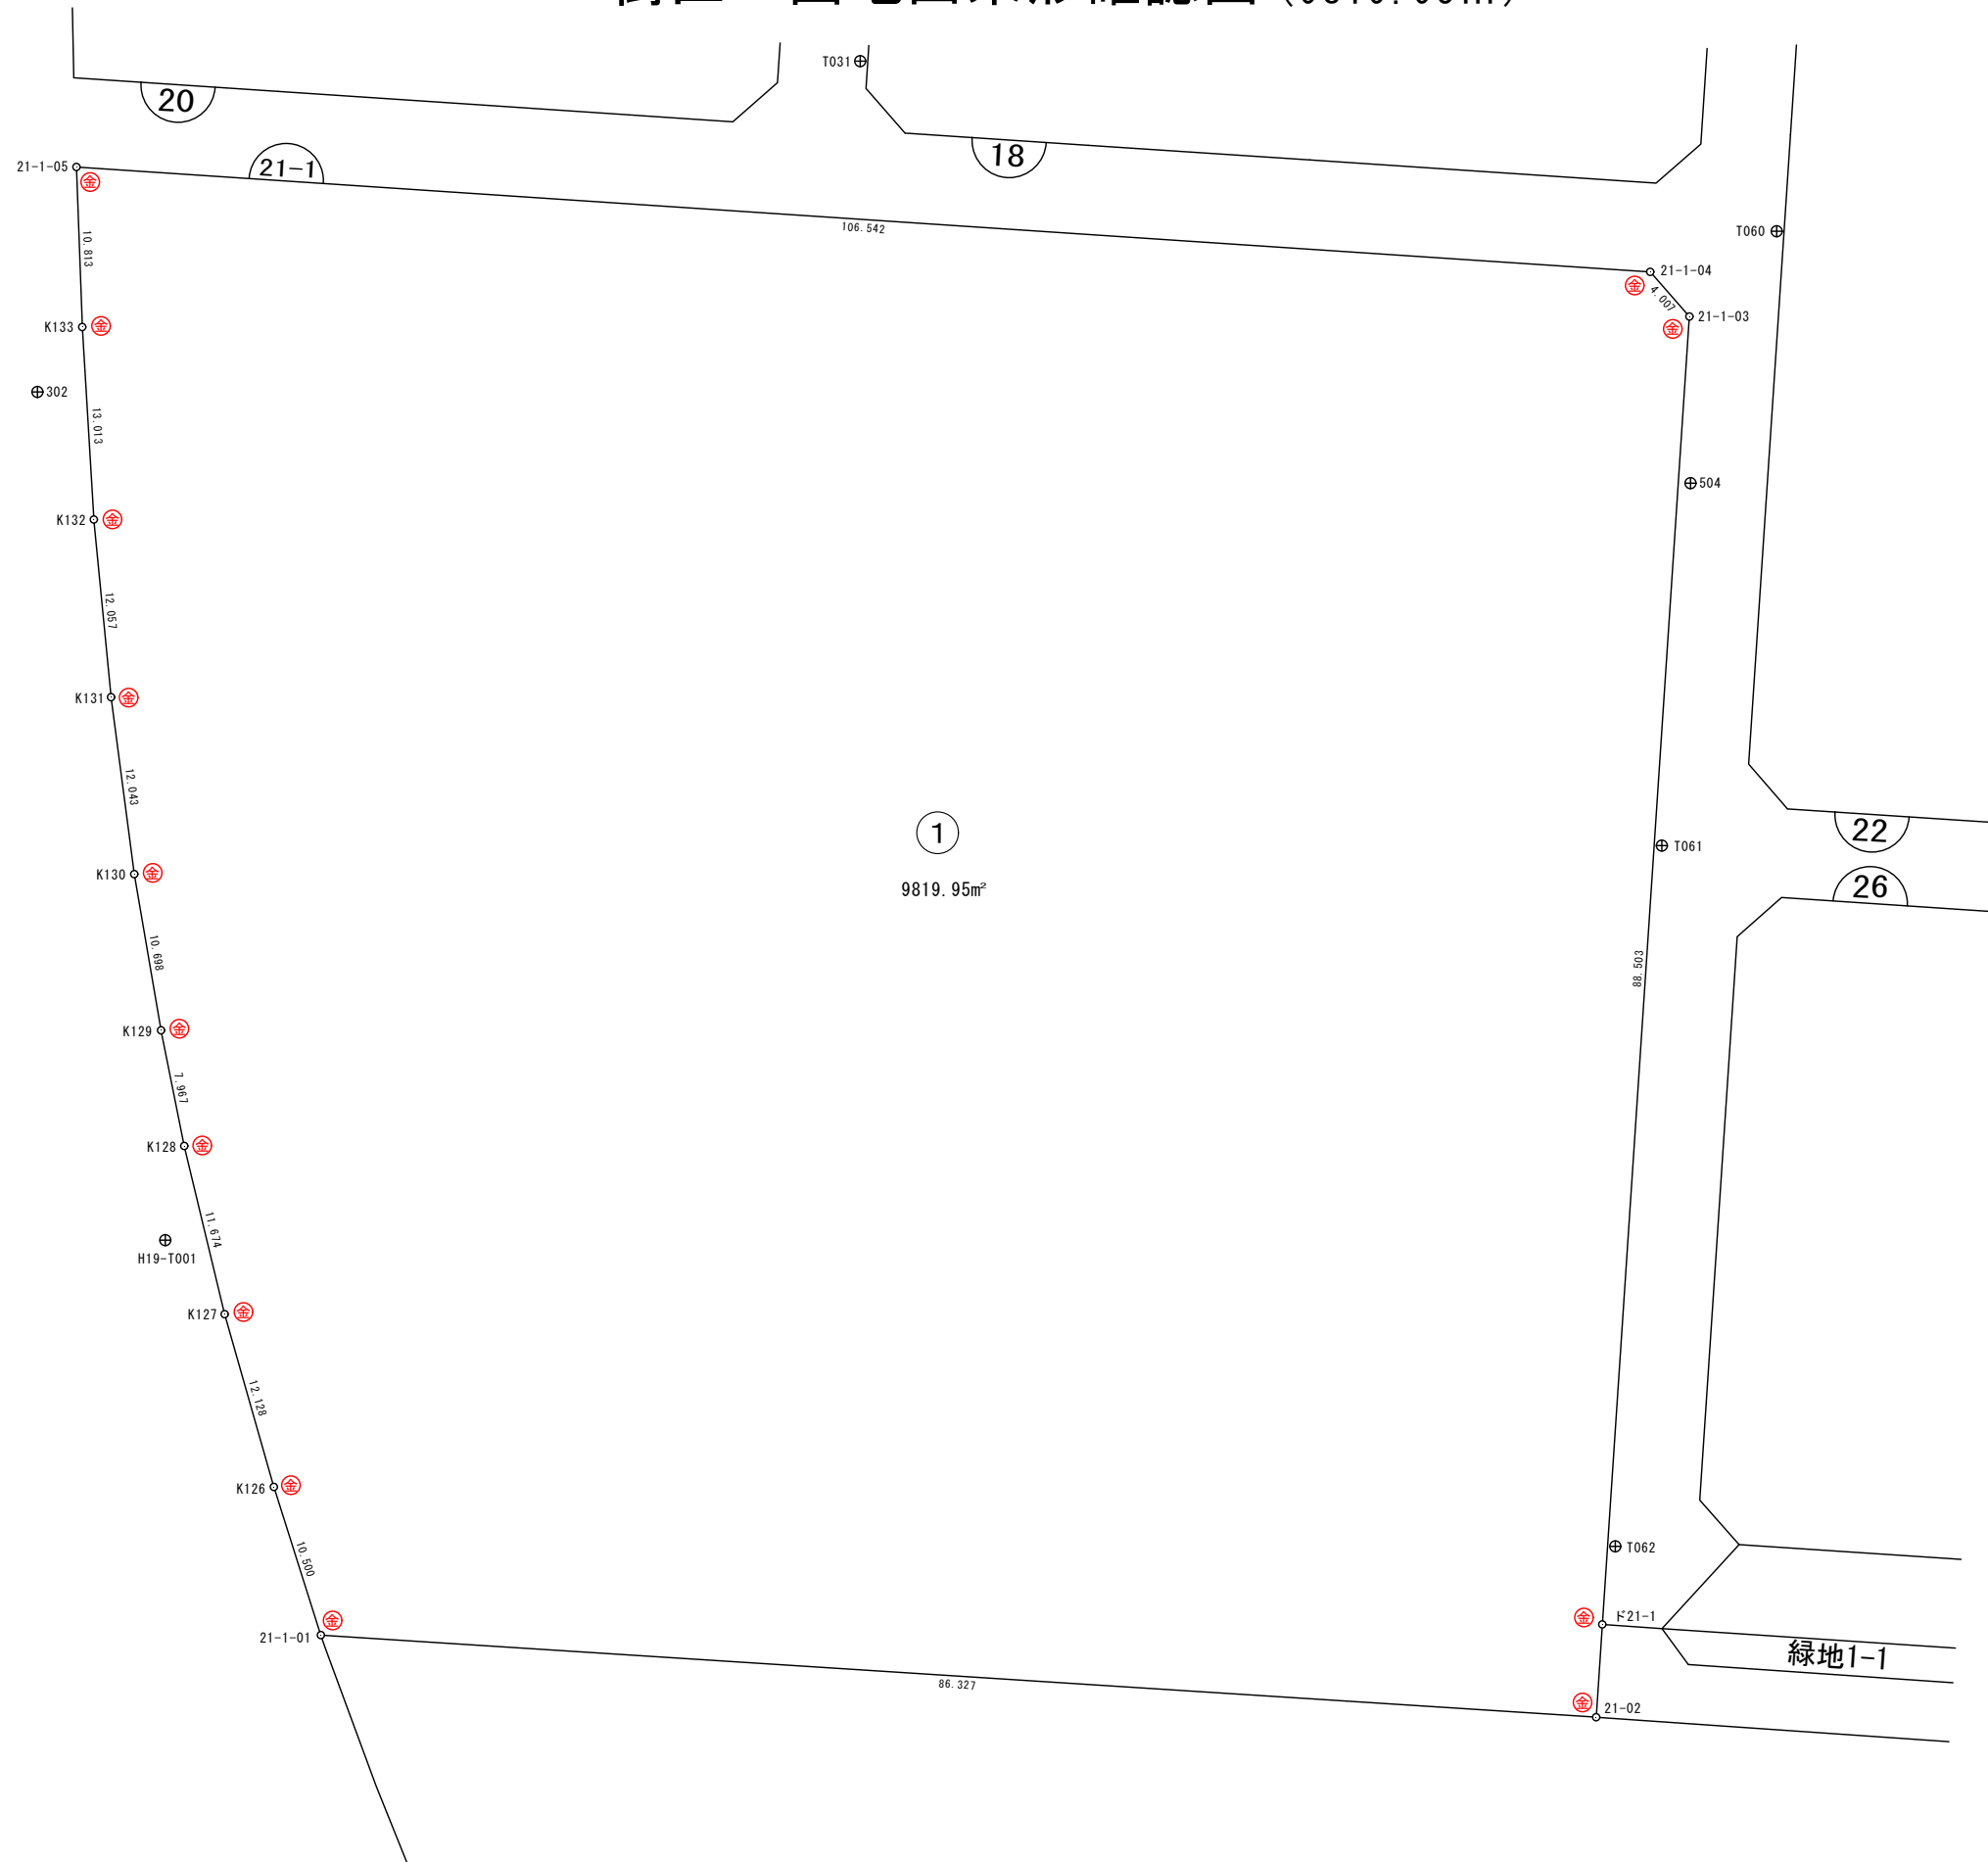

S=1:500

凡 例	
事 項	記 号
金属プレート	⊕
コンクリート杭	⊖
金属 鈹	⊗
合成樹脂杭	⊕
マーキング	⊗

公共設施用地面積計算簿

21-1街区

点名	Xn	Yn	距離	方向角	X _{n+1} -X _{n-1}	Y _{n+1} -Y _{n-1}	Y _n *(X _{n+1} -X _{n-1})	X _n *(Y _{n+1} -Y _{n-1})	
21-1-01	47752.698	-71408.302	10.500	342° 24' 01"	15.550	-89.324	-1110399.096100	-4265461.996152	
K126	47762.707	-71411.477	12.128	344° 05' 53"	21.673	-6.498	-1547700.941021	-310362.070086	
K127	47774.371	-71414.800	11.674	346° 29' 32"	23.016	-6.050	-1643683.036800	-289034.944550	
K128	47785.723	-71417.527	7.967	348° 38' 32"	19.163	-4.296	-1368574.069901	-205287.466008	
K129	47793.534	-71419.096	10.698	350° 17' 31"	18.356	-3.373	-1310968.926176	-161207.590182	
K130	47804.079	-71420.900	12.043	352° 30' 35"	22.486	-3.374	-1605970.357400	-161290.962546	
K131	47816.020	-71422.470	12.057	354° 28' 10"	23.942	-2.732	-1709996.776740	-130633.366640	
K132	47828.021	-71423.632	13.013	356° 33' 49"	24.991	-1.942	-1784947.987312	-92882.016782	
K133	47841.011	-71424.412	10.813	357° 53' 26"	23.796	-1.178	-1699615.307952	-56356.710958	
21-1-05	47851.817	-71424.810	106.542	93° 48' 37"	3.726	105.909	-266128.842060	5067938.086653	
21-1-04	47844.737	-71318.503	4.007	138° 42' 47"	-10.091	108.951	719675.013773	5212731.940887	
21-1-03	47841.726	-71315.859	88.503	183° 48' 34"	-91.319	-3.236	6512492.928021	-154815.825336	
ㄈ21-1	47753.418	-71321.739	6.274	183° 46' 59"	-94.569	-6.294	6744825.535491	-300560.012892	
21-02	47747.157	-71322.153	86.327	273° 40' 48"	-0.720	-86.563	51351.950160	-4133137.151391	
							倍面積	-19639.914017	19639.914017
							面積		9819.9570085
							地積		9819.95