



# 84-1, 84-2街区 画地出来形確認図 (4104.83m<sup>2</sup>)

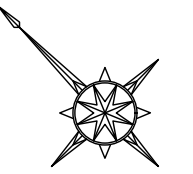

S=1:500

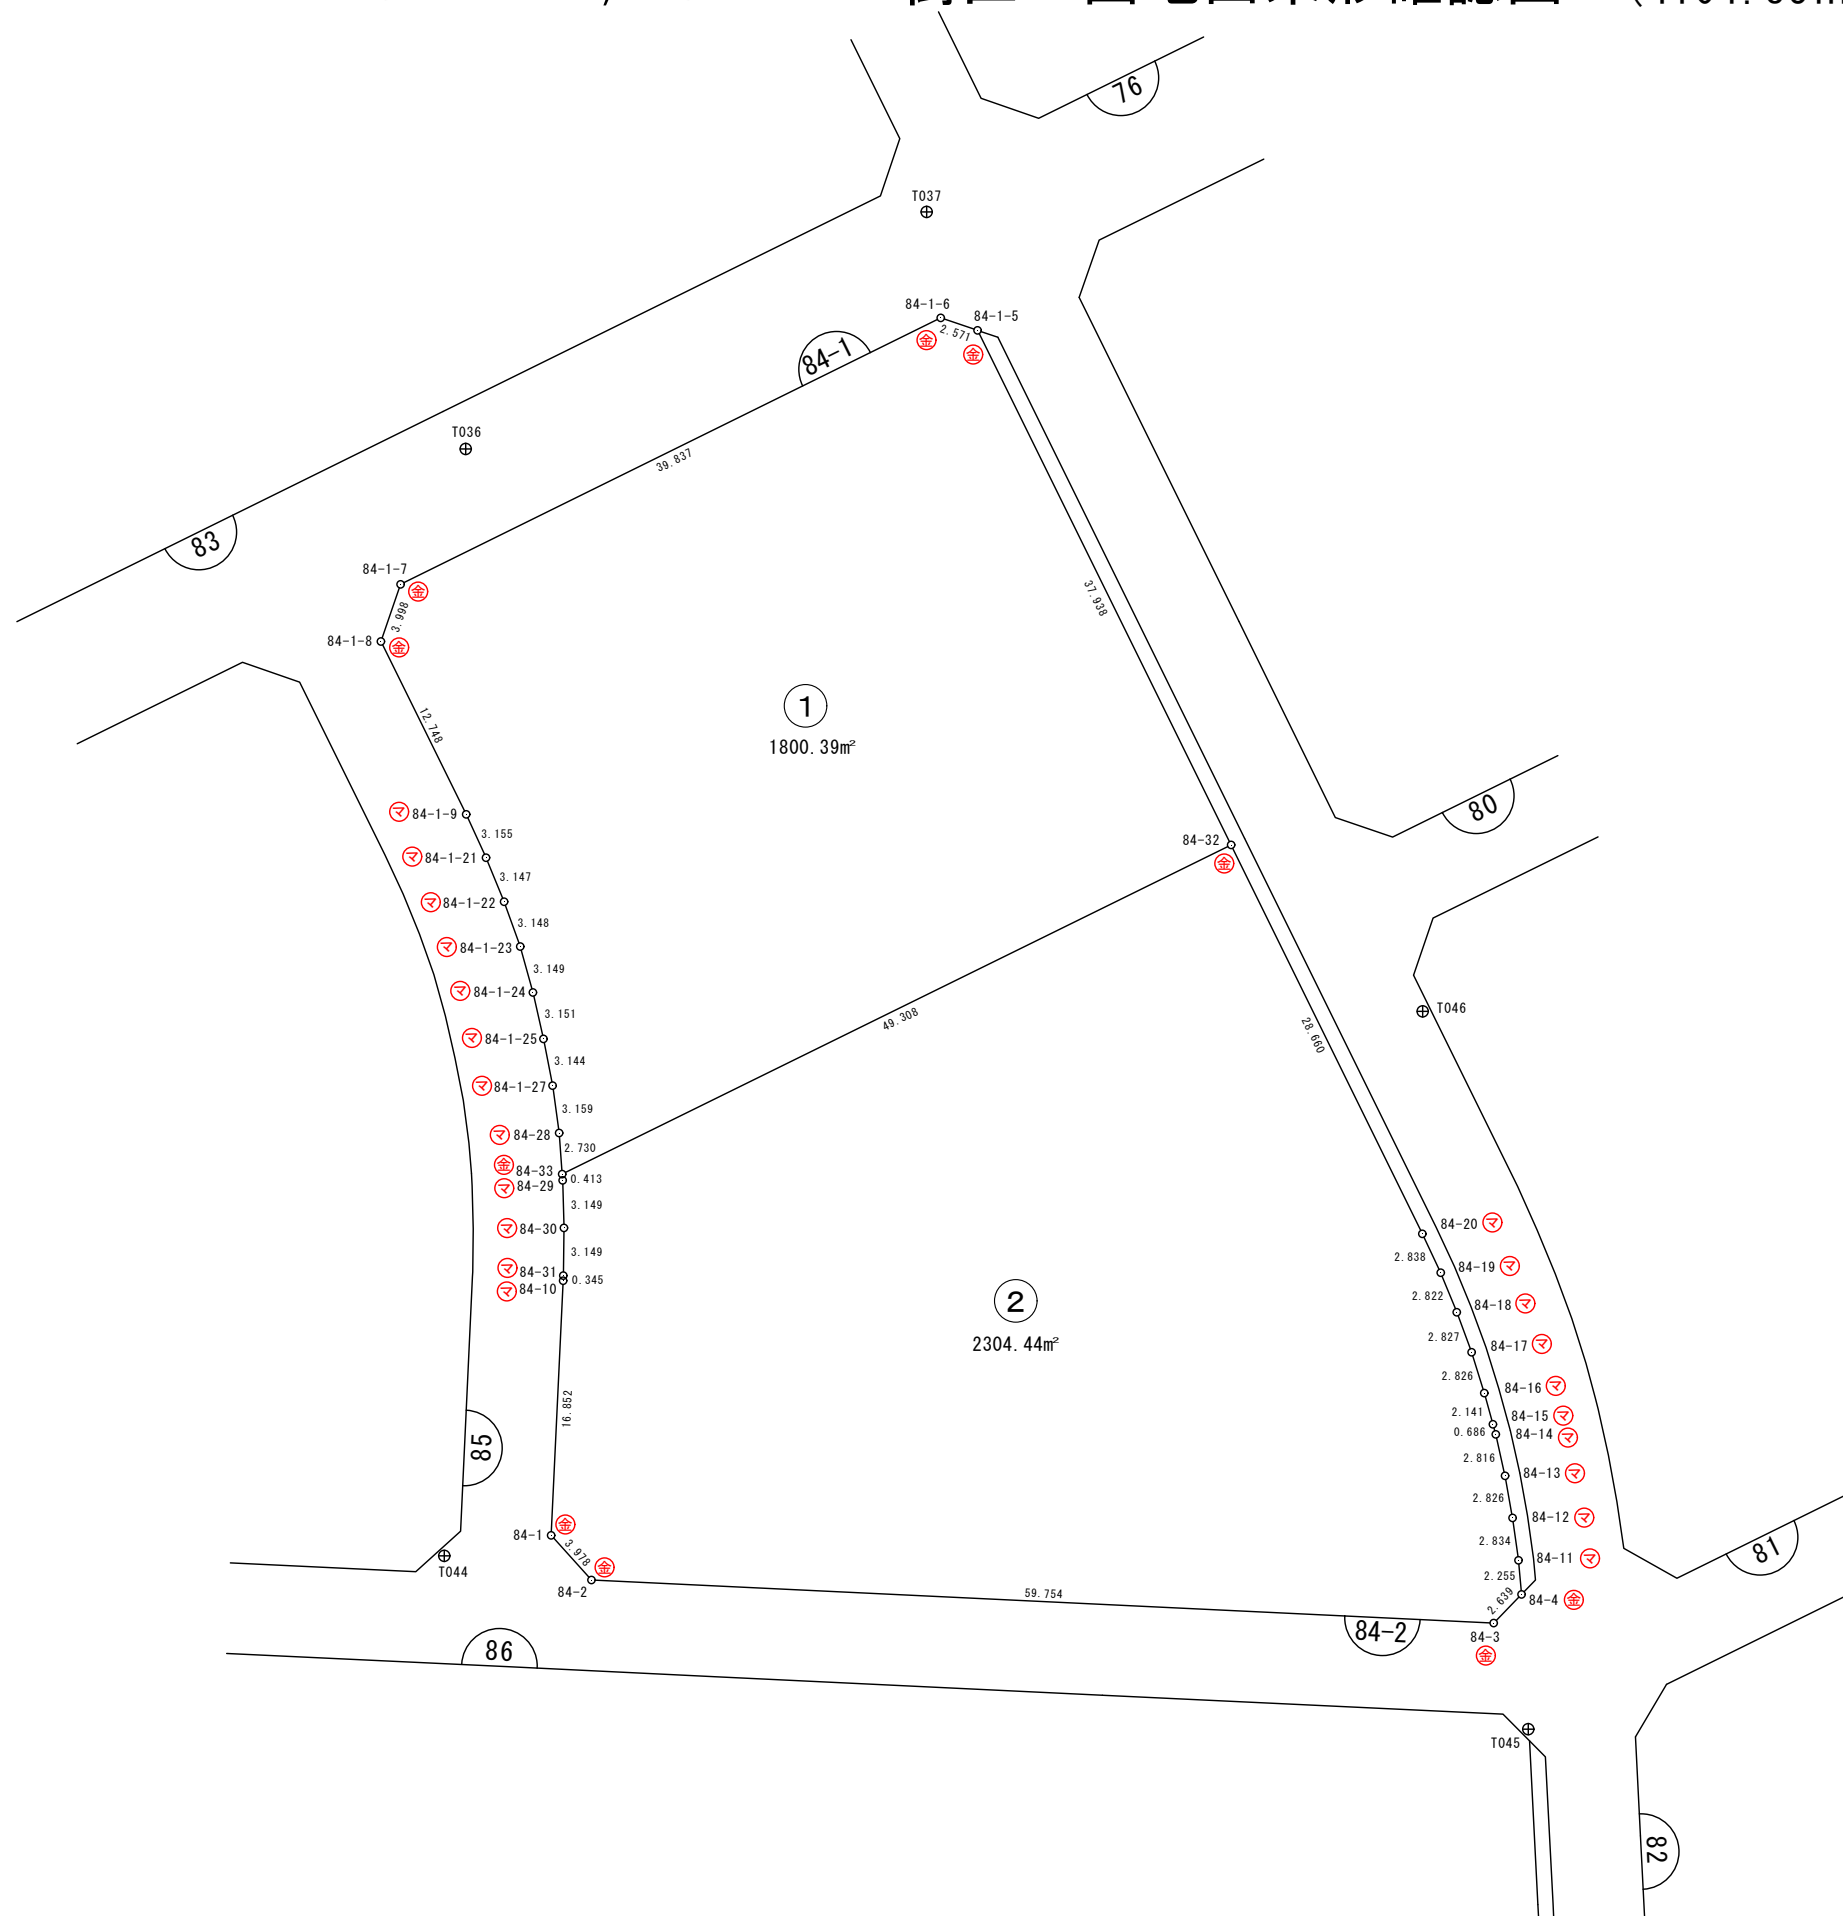

凡 例	
事 項	記 号
金属プレート	Ⓜ
コンクリート杭	Ⓜ
金属釘	Ⓜ
合成樹脂杭	Ⓜ
マーキング	Ⓜ

# 公共設施用地面積計算簿

84- 1街区

点名	X <sub>n</sub>	Y <sub>n</sub>	距離	方向角	X <sub>n+1</sub> -X <sub>n-1</sub>	Y <sub>n+1</sub> -Y <sub>n-1</sub>	Y <sub>n</sub> *(X <sub>n+1</sub> -X <sub>n-1</sub> )	X <sub>n</sub> *(Y <sub>n+1</sub> -Y <sub>n-1</sub> )	
84-1-7	47560.655	-71144.148	3.998	243° 58' 47"	11.053	-41.316	-786356.267844	-1965016.021980	
84-1-8	47558.901	-71147.741	12.748	198° 43' 35"	-13.828	-7.686	983830.962548	-365537.713086	
84-1-9	47546.827	-71151.834	3.155	200° 25' 20"	-15.031	-5.194	1069483.216854	-246958.219438	
84-1-21	47543.870	-71152.935	3.147	202° 48' 32"	-5.858	-2.321	416813.893230	-110349.322270	
84-1-22	47540.969	-71154.155	3.148	205° 08' 56"	-5.751	-2.558	409207.545405	-121609.798702	
84-1-23	47538.119	-71155.493	3.149	209° 28' 43"	-5.592	-2.888	397901.516856	-137290.087672	
84-1-24	47535.377	-71157.043	3.151	212° 11' 32"	-5.409	-3.229	384888.445587	-153491.732333	
84-1-25	47532.710	-71158.722	3.144	213° 56' 34"	-5.276	-3.435	375433.417272	-163274.858850	
84-1-27	47530.101	-71160.478	3.159	217° 10' 42"	-5.126	-3.665	364768.610228	-174197.820165	
84-28	47527.584	-71162.387	2.730	220° 44' 16"	-4.586	-3.691	326350.706782	-175424.312544	
84-33	47525.515	-71164.169	49.308	108° 48' 21"	-17.964	44.894	1278393.131916	2133610.470410	
84-32	47509.620	-71117.493	37.938	18° 45' 57"	20.027	58.881	-1424270.032311	2797413.935220	
84-1-5	47545.542	-71105.288	2.571	333° 45' 14"	38.228	11.068	-2718212.949664	526234.058856	
84-1-6	47547.848	-71106.425	39.837	288° 45' 09"	15.113	-38.860	-1074631.401025	-1847709.373280	
							倍面積	3600.795834	-3600.795834
							面積		1800.3979170
							地積		1800.39

## 画地面積(座標法)計算簿

画地番号：84- 2

点名	Xn	Yn	距離	方向角	X <sub>n+1</sub> -X <sub>n-1</sub>	Y <sub>n+1</sub> -Y <sub>n-1</sub>	X <sub>n</sub> *(Y <sub>n+1</sub> -Y <sub>n-1</sub> )	Y <sub>n</sub> *(X <sub>n+1</sub> -X <sub>n-1</sub> )
84-1	47509.141	-71181.578	3.978	182° 54' 38"	-15.314	-12.667	-601798.289047	1090074.685492
84-2	47505.168	-71181.780	59.754	137° 43' 58"	-48.192	39.988	1899636.657984	3430392.341760
84-3	47460.949	-71141.590	2.639	89° 01' 23"	-44.174	42.829	2032704.984721	3142608.596660
84-4	47460.994	-71138.951	2.255	39° 54' 35"	1.775	4.086	193925.621484	-126271.638025
84-11	47462.724	-71137.504	2.834	36° 59' 57"	3.994	3.153	149649.968772	-284123.190976
84-12	47464.988	-71135.798	2.826	34° 52' 15"	4.583	3.322	157678.690136	-326015.362234
84-13	47467.307	-71134.182	2.816	32° 23' 52"	4.697	3.125	148335.334375	-334117.252854
84-14	47469.685	-71132.673	0.686	29° 35' 23"	2.975	1.848	87723.977880	-211619.702175
84-15	47470.282	-71132.334	2.141	29° 34' 09"	2.460	1.396	66268.513672	-174985.541640
84-16	47472.145	-71131.277	2.826	27° 47' 54"	4.363	2.375	112746.344375	-310345.761551
84-17	47474.645	-71129.959	2.827	24° 37' 30"	5.070	2.496	118496.713920	-360628.892130
84-18	47477.215	-71128.781	2.822	22° 45' 32"	5.173	2.270	107773.278050	-367949.184113
84-19	47479.818	-71127.689	2.838	19° 48' 51"	5.273	2.054	97523.546172	-375056.304097
84-20	47482.488	-71126.727	28.660	18° 47' 43"	29.802	10.196	484131.447648	-2119718.718054
84-32	47509.620	-71117.493	49.308	288° 48' 21"	43.027	-37.442	-1778855.192040	-3059972.371311
84-33	47525.515	-71164.169	0.413	220° 58' 38"	15.583	-46.947	-2231180.352705	-1108951.245527
84-29	47525.203	-71164.440	3.149	223° 25' 04"	-2.600	-2.436	-115771.394508	185027.544000
84-30	47522.915	-71166.605	3.149	225° 44' 00"	-4.486	-4.420	-210051.284300	319253.390030
84-31	47520.717	-71168.860	0.345	227° 06' 45"	-2.433	-2.508	-119181.958236	173153.836380
84-10	47520.482	-71169.113	16.852	227° 42' 12"	-11.576	-12.718	-604365.490076	823853.652088
							倍面積	-4608.881723
							面積	2304.4408615
							地積	2304.44