





拡大図1/50

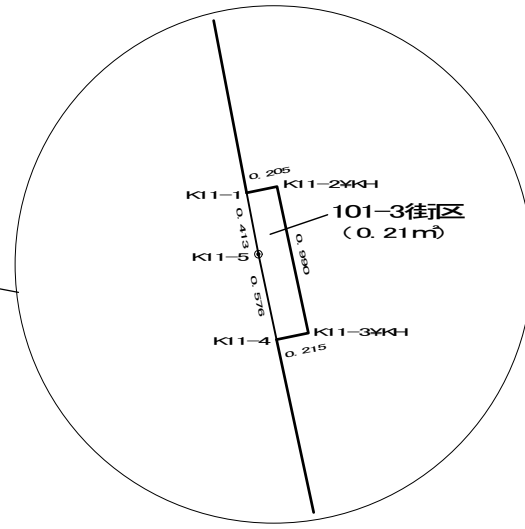

拡大図1/50

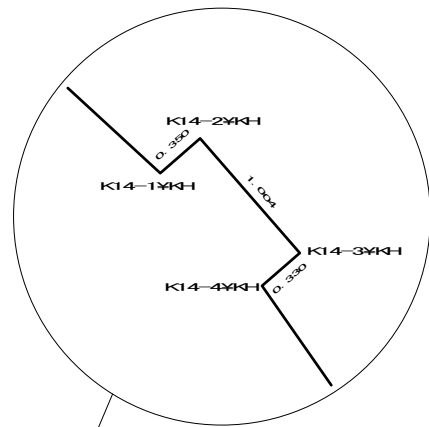

拡大図1/50

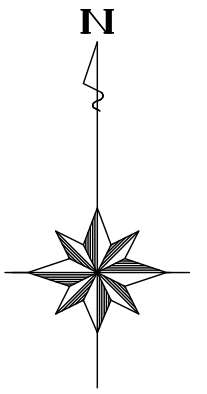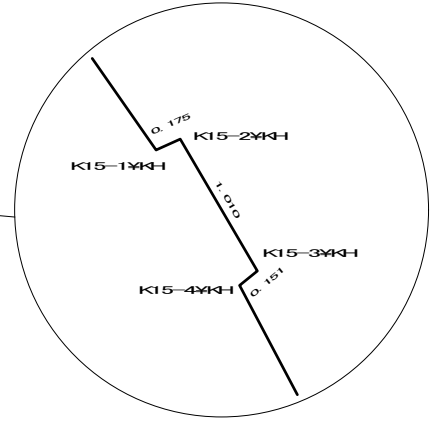

縮尺1:500

99街区 出来形確認測量図
101-3街区

画地面積(座標法)計算簿

画地番号：099街区

点名	X _n	Y _n	距離	方向角	X _{n+1} -X _{n-1}	Y _{n+1} -Y _{n-1}	X _n *(Y _{n+1} -Y _{n-1})	Y _n *(X _{n+1} -X _{n-1})
K12-1	48027.487	-70938.317	8.084	127° 22' 13"	-1.999	5.804	278751.534548	141805.695683
K13-1#KH	48022.580	-70931.892	6.662	132° 39' 51"	-9.422	11.324	543807.695920	668320.286424
K14-1#KH	48018.065	-70926.993	0.350	48° 56' 14"	-4.285	5.163	247917.269595	303922.165005
K14-2#KH	48018.295	-70926.729	1.004	138° 59' 48"	-0.528	0.923	44320.886285	37449.312912
K14-3#KH	48017.537	-70926.070	0.330	228° 55' 42"	-0.975	0.410	19687.190170	69152.918250
K14-4#KH	48017.320	-70926.319	5.756	145° 06' 12"	-4.938	3.044	146164.722080	350234.163222
K15-1#KH	48012.599	-70923.026	0.175	65° 46' 20"	-4.649	3.453	165787.504347	329721.147874
K15-2#KH	48012.671	-70922.866	1.010	149° 40' 42"	-0.800	0.670	32168.489570	56738.292800
K15-3#KH	48011.799	-70922.356	0.151	230° 37' 50"	-0.968	0.393	18868.637007	68652.840608
K15-4#KH	48011.703	-70922.473	45.775	152° 08' 26"	-40.566	21.274	1021400.969622	2877041.039718
K16-1#KH	47971.233	-70901.082	18.531	205° 15' 40"	-57.229	13.483	646796.134539	4057598.021778
K16-2	47954.474	-70908.990	75.754	337° 43' 56"	53.346	-36.614	-1755805.111036	-3782710.980540
99-01	48024.579	-70937.696	2.973	347° 56' 44"	73.013	-29.327	-1408416.828333	-5179373.998048
							倍面積	1449.094314
							面積	724.5471570
							地積	724.54