


101街区 画地出来形確認図 (4332.18m²)

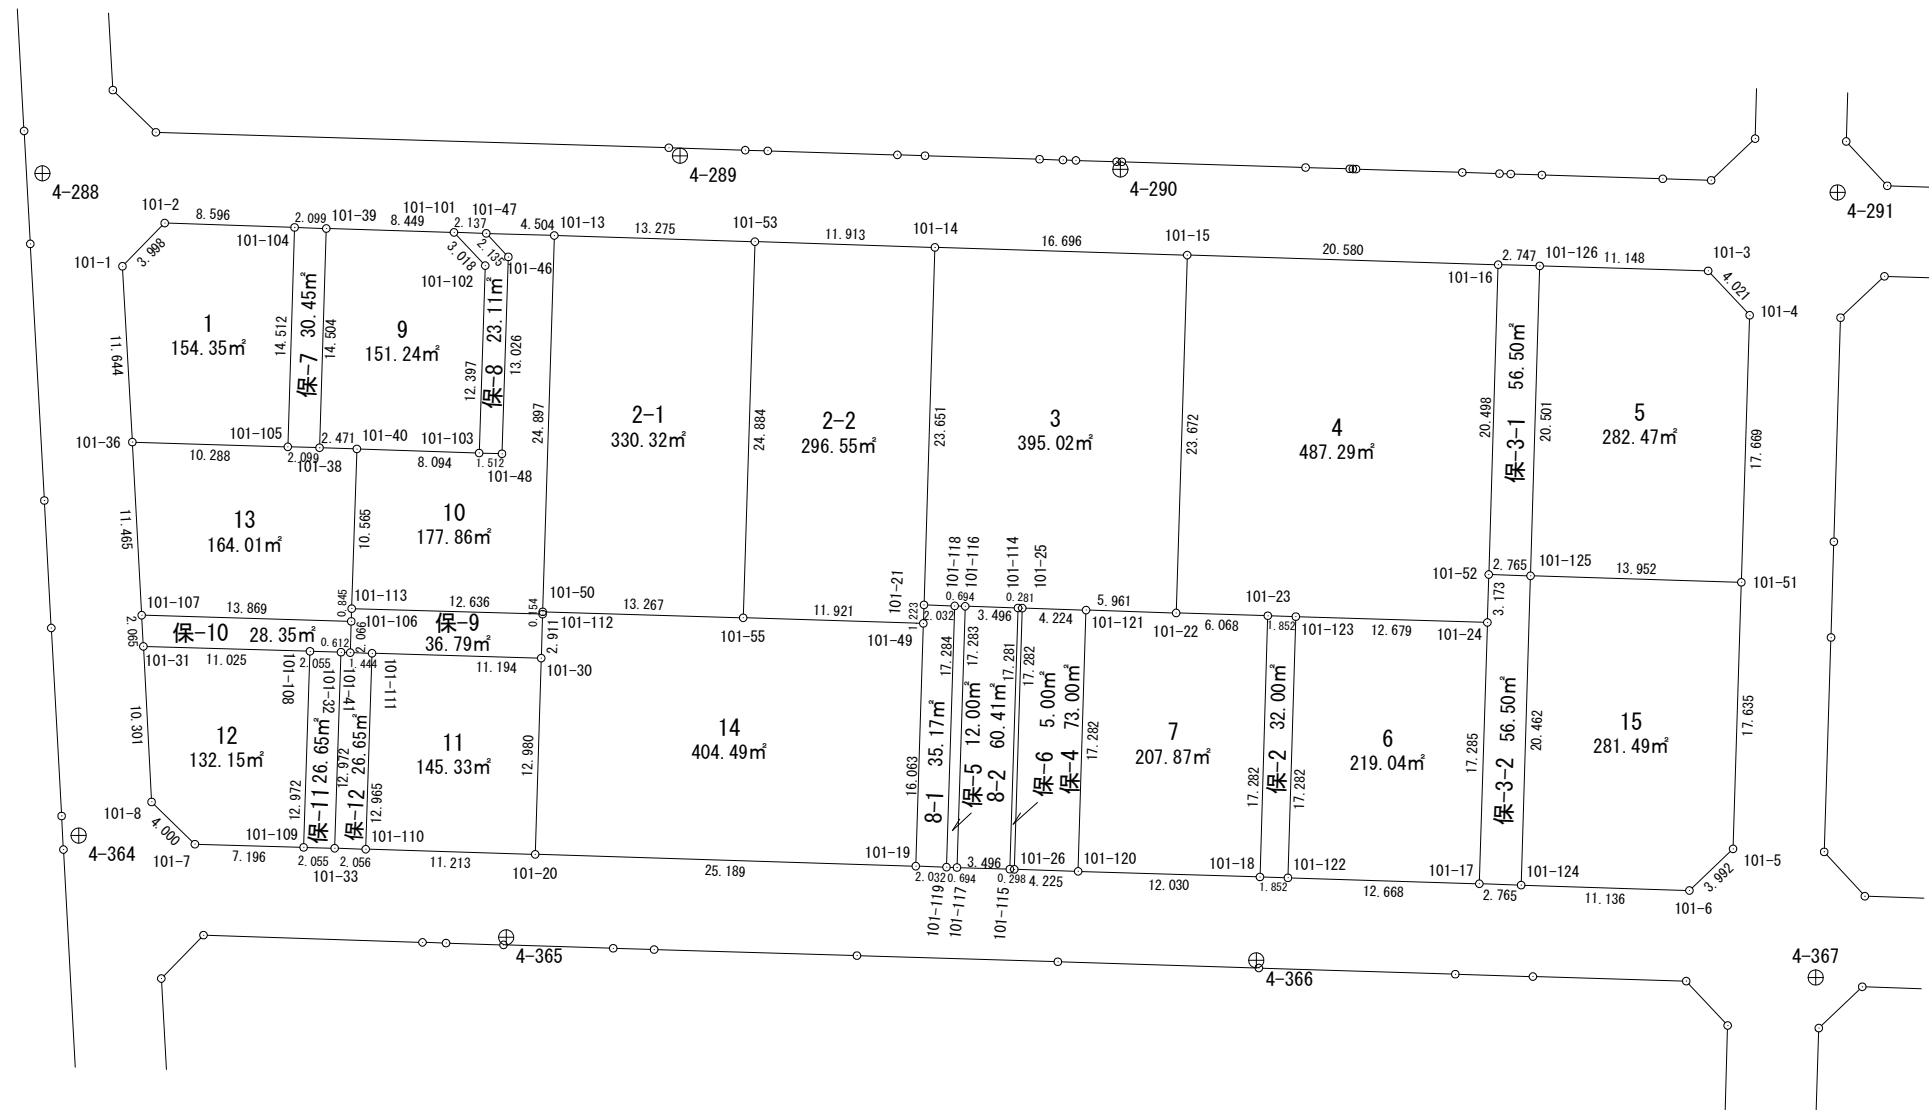

S=1/500




面積計算書 (座標法)

世界測地系 (測地成果2011)

所在	地番	公簿地目	現況地目	地積	所有者
前橋市六供町四丁目	101-1			154.35 m ²	

点名	X座標	Y座標	辺長	方向角	測角	DX	倍積 (Y×DX)
101-104	41406.941	-67783.433	8.596	271-56-24	90-10-15	14.796	-1002923.674668
101-2	41407.232	-67792.024	3.998	224-20-28	132-24-04	-2.568	174089.917632
101-1	41404.373	-67794.818	11.644	176-46-49	132-26-21	-14.485	982007.938730
101-36	41392.747	-67794.164	10.288	91-43-56	94-57-07	-11.937	809258.935668
101-105	41392.436	-67783.881	14.512	1-46-09	90-02-13	14.194	-962124.406914

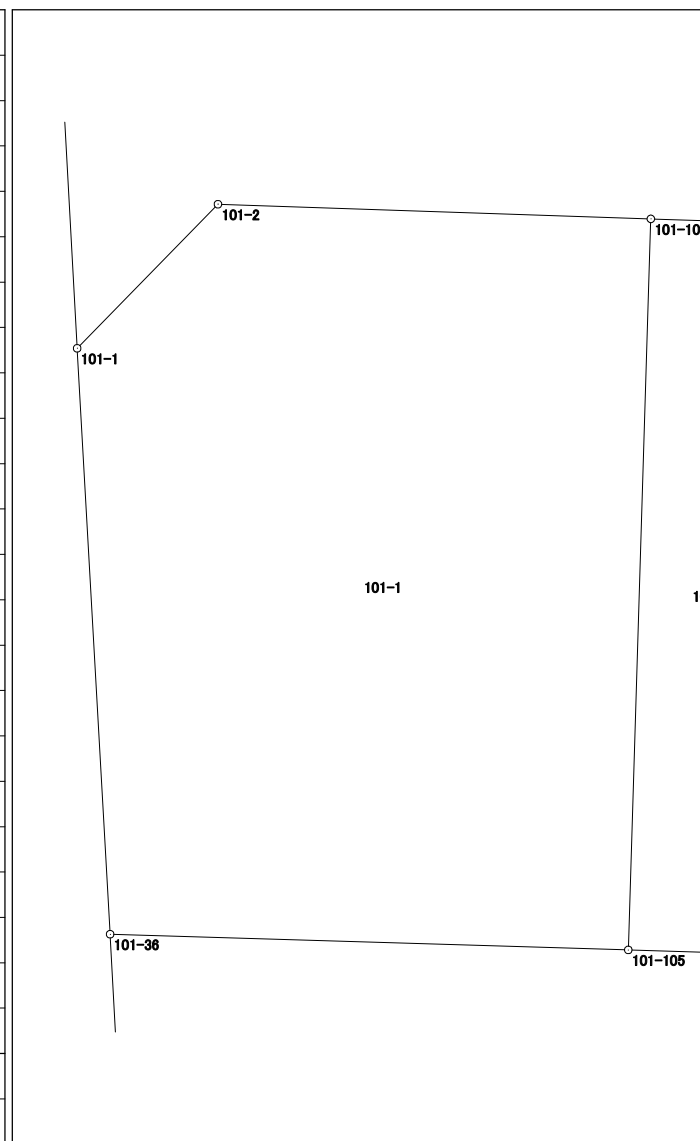

倍面積	308.710448
面積	154.3552240


面積計算書（座標法）

世界測地系（測地成果2011）

所在	地番	公簿地目	現況地目	地積	所有者
前橋市六供町四丁目	101-2-1			330.32 m ²	

点名	X座標	Y座標	辺長	方向角	測角	DX	倍積 (Y×DX)
101-13	41406.408	-67766.252	24.897	181-46-04	90-00-24	-24.477	1658714.550204
101-50	41381.523	-67767.020	13.267	91-42-22	89-56-18	-25.280	1713150.265600
101-55	41381.128	-67753.759	24.884	1-47-13	90-04-51	24.477	-1658408.759043
101-53	41406.000	-67752.983	13.275	271-45-40	89-58-27	25.280	-1712795.410240

倍面積	660.646521
面積	330.3232605

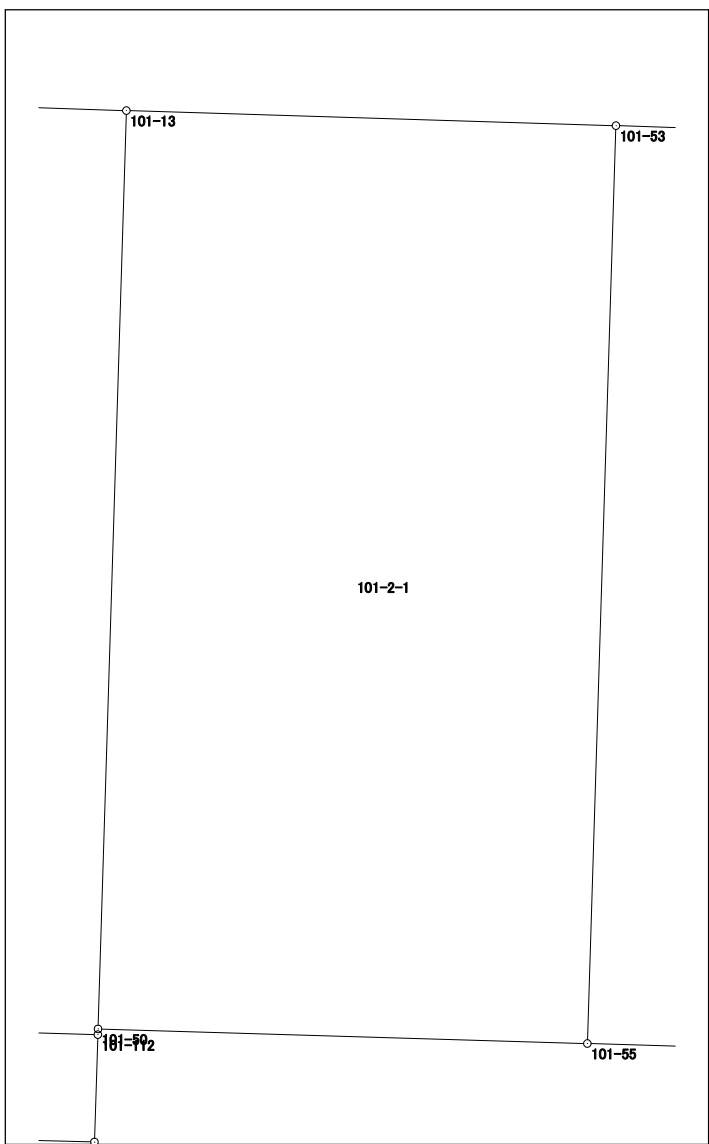


面積計算書（座標法）

世界測地系（測地成果2011）

所 在	地 番	公簿地目	現況地目	地 積	所 有 者
前橋市六供町四丁目	101-2-2			296.55 m ²	

点 名	X 座標	Y 座標	辺 長	方 向 角	測 角	DX	倍 積 (Y×DX)
101-53	41406.000	-67752.983	24.884	181-47-13	89-57-50	-24.493	1659473.812619
101-55	41381.128	-67753.759	11.921	91-46-26	89-59-13	-25.241	1710172.630919
101-49	41380.759	-67741.844	1.223	2-03-44	90-17-18	0.853	-57783.792932
101-21	41381.981	-67741.800	23.651	1-45-15	179-41-31	24.862	-1684196.631600
101-14	41405.621	-67741.076	11.913	271-49-23	90-04-08	24.019	-1627072.904444
						倍面積	593.114562
						面 積	296.5572810

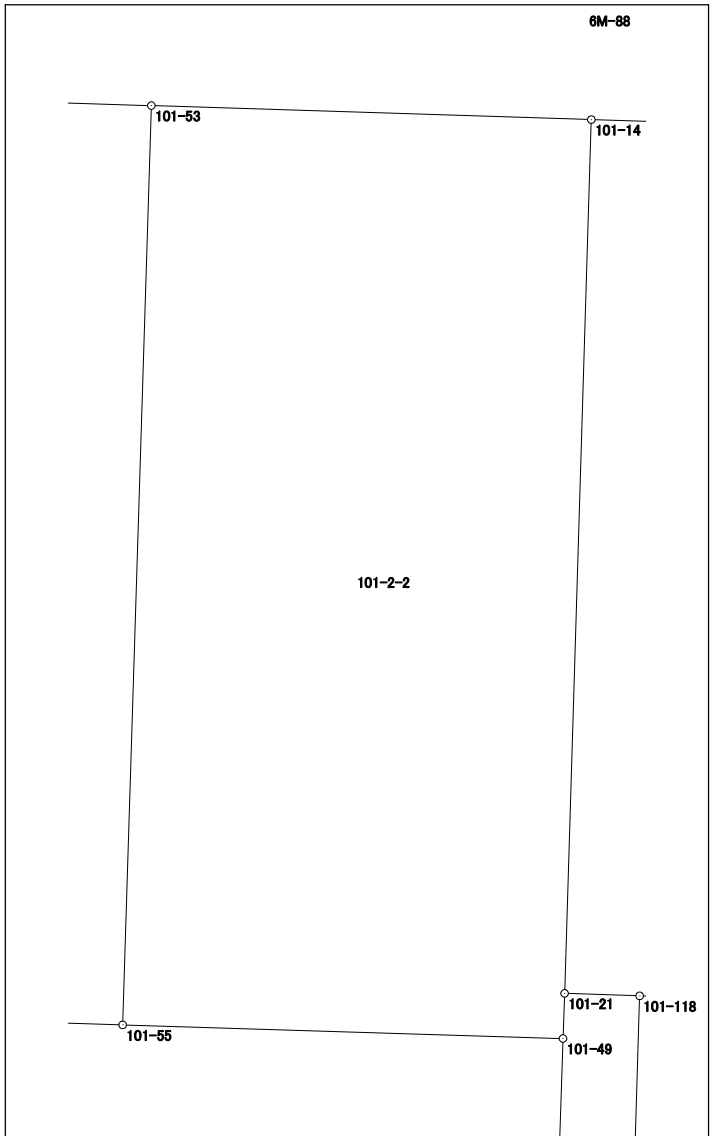

面積計算書（座標法）

世界測地系（測地成果2011）

所 在	地 番	公簿地目	現況地目	地 積	所 有 者
前橋市六供町四丁目	101-3			395.02 m ²	

点 名	X 座標	Y 座標	辺 長	方 向 角	測 角	DX	倍 積 (Y×DX)	
101-14	41405.621	-67741.076	23.651	181-45-15	90-00-13	-23.130	1566851.087880	
101-21	41381.981	-67741.800	2.032	91-53-22	90-08-07	-23.707	1605954.852600	
101-118	41381.914	-67739.769	0.694	91-53-53	180-00-31	-0.090	6096.579210	
101-116	41381.891	-67739.075	3.496	91-53-06	179-59-13	-0.138	9347.992350	
101-114	41381.776	-67735.581	0.281	91-50-04	179-56-58	-0.124	8399.212044	
101-25	41381.767	-67735.300	4.224	91-46-38	179-56-34	-0.140	9482.942000	
101-121	41381.636	-67731.078	5.961	91-47-17	180-00-39	-0.317	21470.751726	
101-22	41381.450	-67725.120	23.672	1-46-19	89-59-02	23.475	-1589847.192000	
101-15	41405.111	-67724.388	16.696	271-45-02	89-58-43	24.171	-1636966.182348	
倍面積							790.043462	
面 積							395.0217310	


面積計算書（座標法）

世界測地系（測地成果2011）

所 在	地 番	公簿地目	現況地目	地 積	所 有 者
前橋市六供町四丁目	101-4			487.29 m ²	

点 名	X 座標	Y 座標	辺 長	方 向 角	測 角	DX	倍 積 (Y×DX)
101-15	41405.111	-67724.388	23.672	181-46-19	90-00-34	-23.028	1559557.206864
101-22	41381.450	-67725.120	6.068	91-45-24	89-59-05	-23.847	1615040.936640
101-23	41381.264	-67719.055	1.852	91-45-50	180-00-26	-0.243	16455.730365
101-123	41381.207	-67717.204	12.679	91-45-29	179-59-39	-0.446	30201.872984
101-24	41380.818	-67704.531	3.173	1-36-26	89-50-57	2.783	-188421.709773
101-52	41383.990	-67704.442	20.498	1-44-40	180-08-14	23.660	-1601887.097720
101-16	41404.478	-67703.818	20.580	271-45-45	90-01-05	21.121	-1429972.339978

倍面積	974.599382
面 積	487.2996910

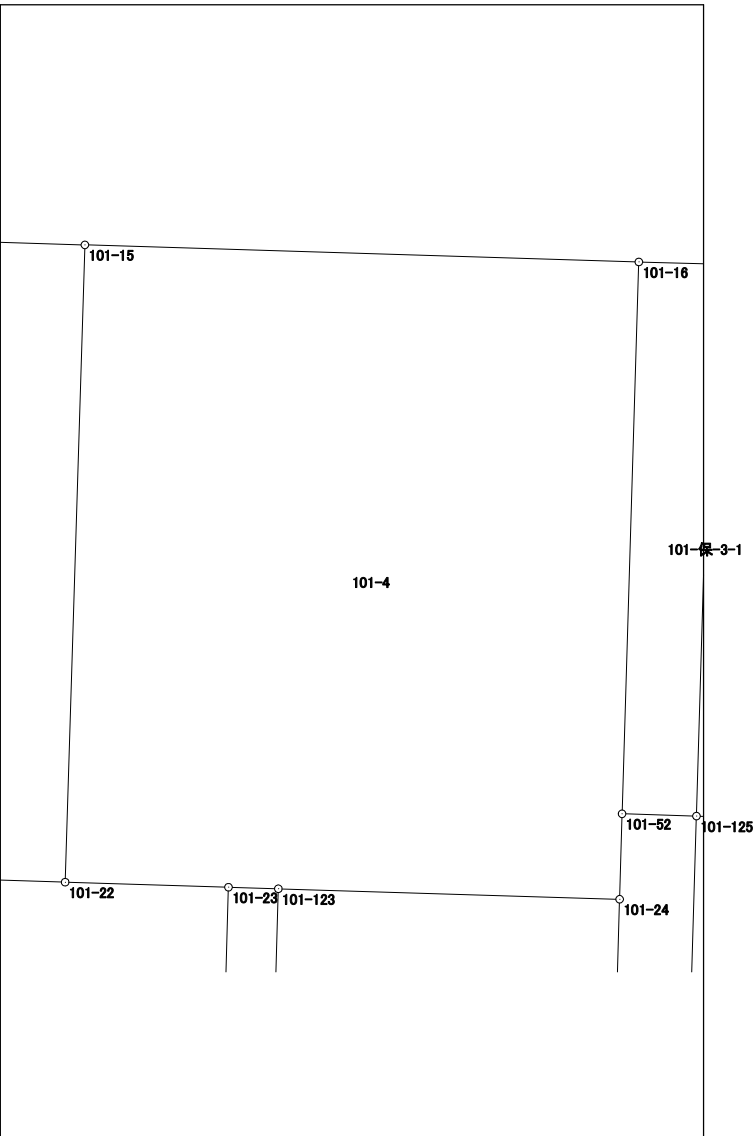


面積計算書 (座標法)

世界測地系 (測地成果2011)

所在	地番	公簿地目	現況地目	地積	所有者
前橋市六供町四丁目	101-5			282.47 m ²	

点名	X座標	Y座標	辺長	方向角	測角	Dx	倍積 (Y×Dx)
101-125	41383.905	-67701.678	13.952	91-45-58	90-04-20	-20.922	1416454.507116
101-51	41383.475	-67687.733	17.669	1-47-25	90-01-27	17.230	-1166259.639590
101-4	41401.135	-67687.181	4.021	316-53-05	135-05-40	20.595	-1394017.492695
101-3	41404.070	-67689.929	11.148	271-40-51	134-47-46	3.262	-220804.548398
101-126	41404.397	-67701.072	20.501	181-41-38	90-00-47	-20.165	1365192.116880

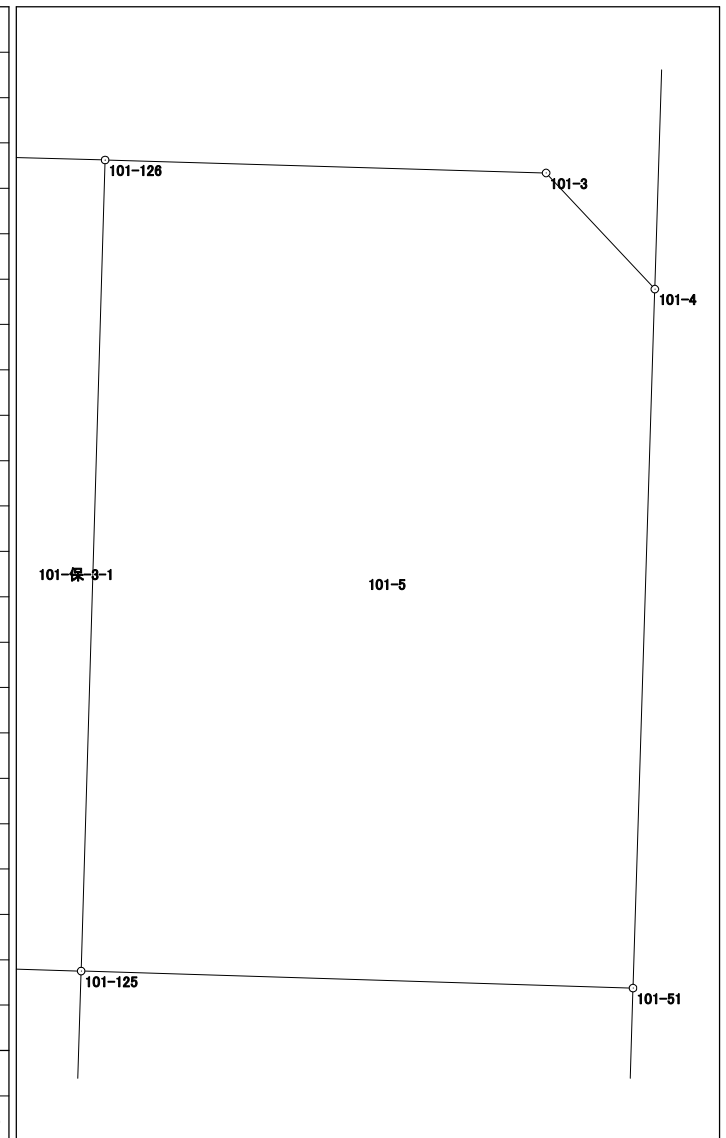


倍面積	564.943313
面積	282.4716565

面積計算書 (座標法)

世界測地系 (測地成果2011)

所在	地番	公簿地目	現況地目	地積	所有者
前橋市六供町四丁目	101-6			219.04 m ²	

点名	X座標	Y座標	辺長	方向角	測角	DX	倍積 (Y×DX)
101-122	41363.933	-67717.726	12.668	91-46-24	90-02-33	-17.666	1196301.347516
101-17	41363.541	-67705.064	17.285	1-46-01	89-59-37	16.885	-1143200.005640
101-24	41380.818	-67704.531	12.679	271-45-29	89-59-28	17.666	-1196068.244646
101-123	41381.207	-67717.204	17.282	181-43-51	89-58-22	-16.885	1143404.989540

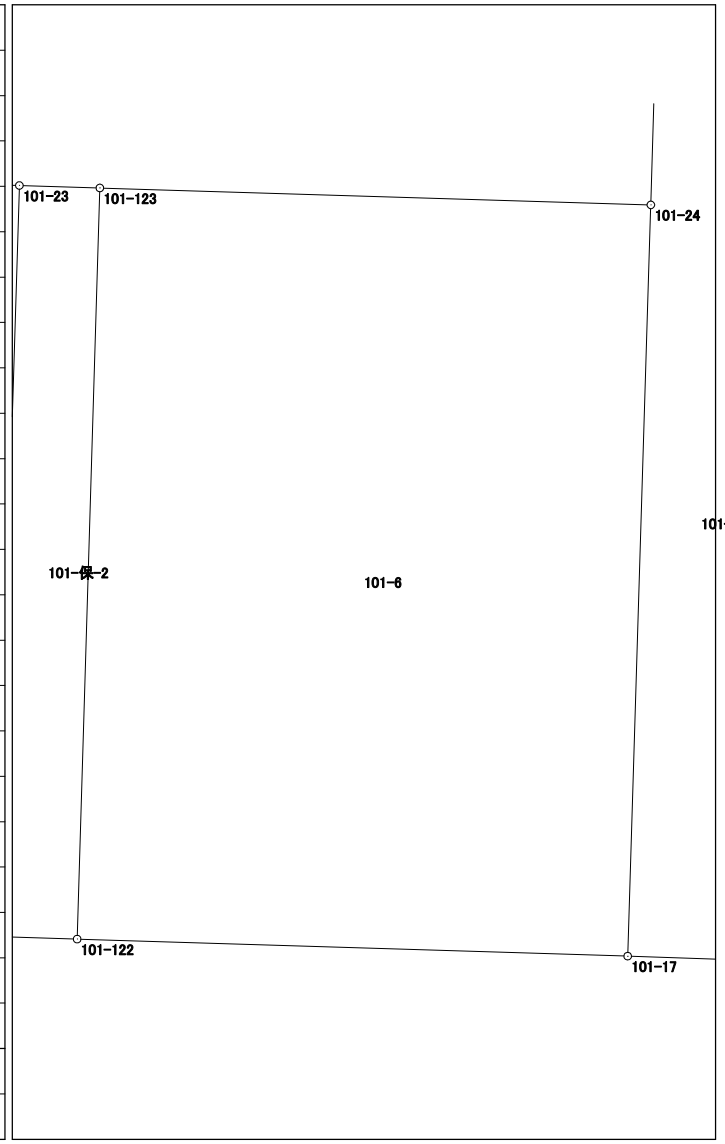


倍面積	438.086770
面積	219.0433850

面積計算書 (座標法)

世界測地系 (測地成果2011)

所在	地番	公簿地目	現況地目	地積	所有者
前橋市六供町四丁目	101-7			207.87 m ²	

点名	X座標	Y座標	辺長	方向角	測角	DX	倍積 (Y×DX)
101-120	41364.362	-67731.601	12.030	91-46-19	90-02-16	-17.646	1195191.831246
101-18	41363.990	-67719.577	17.282	1-43-51	89-57-32	16.902	-1144596.290454
101-23	41381.264	-67719.055	6.068	271-45-24	90-01-33	17.460	-1182374.700300
101-22	41381.450	-67725.120	5.961	271-47-17	180-01-53	0.372	-25193.744640
101-121	41381.636	-67731.078	17.282	181-44-03	89-56-46	-17.088	1157388.660864

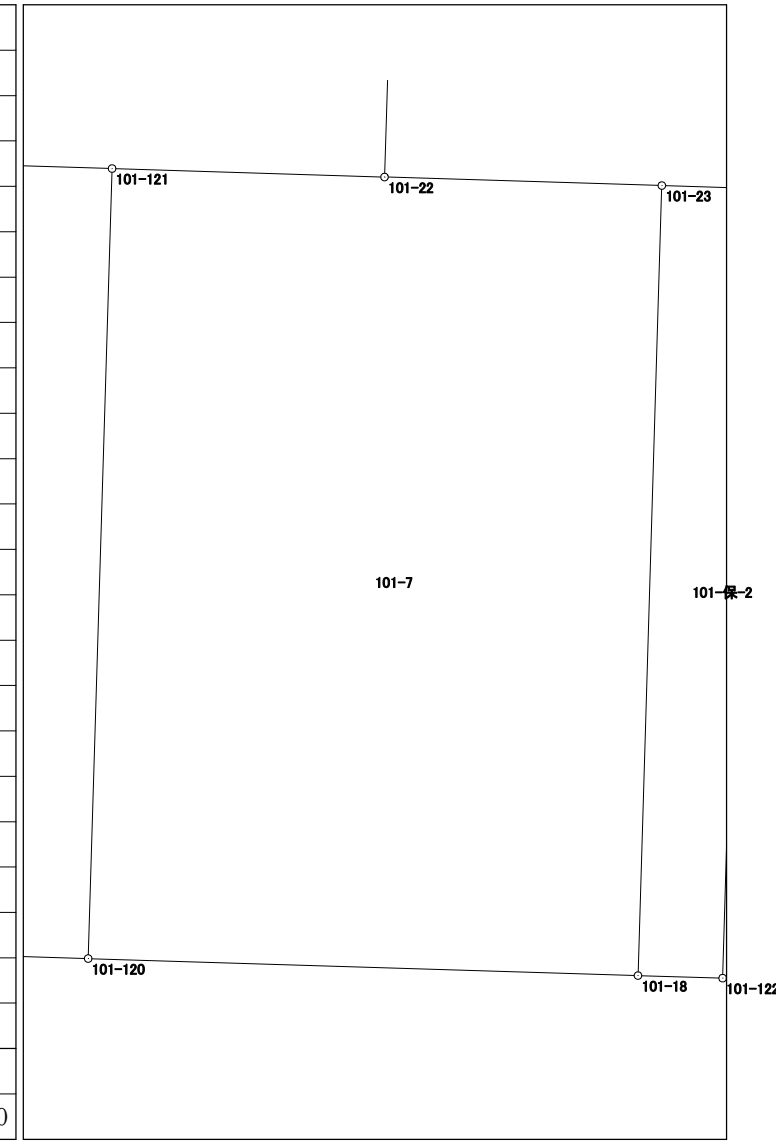


倍面積	415.756716
面積	207.8783580

面積計算書 (座標法)

世界測地系 (測地成果2011)

所在	地番	公簿地目	現況地目	地積	所有者
前橋市六供町四丁目	101-8-1			35.17 m ²	

点名	X座標	Y座標	辺長	方向角	測角	DX	倍積 (Y×DX)
101-118	41381.914	-67739.769	2.032	271-53-22	90-05-45	17.343	-1174810.813767
101-21	41381.981	-67741.800	1.223	182-03-44	90-10-22	-1.155	78241.779000
101-49	41380.759	-67741.844	16.063	181-46-23	179-42-39	-17.277	1170375.838788
101-19	41364.704	-67742.341	2.032	91-51-40	90-05-17	-16.121	1092074.279261
101-119	41364.638	-67740.310	17.284	1-47-37	89-55-57	17.210	-1165810.735100
						倍面積	70.348182
						面積	35.1740910

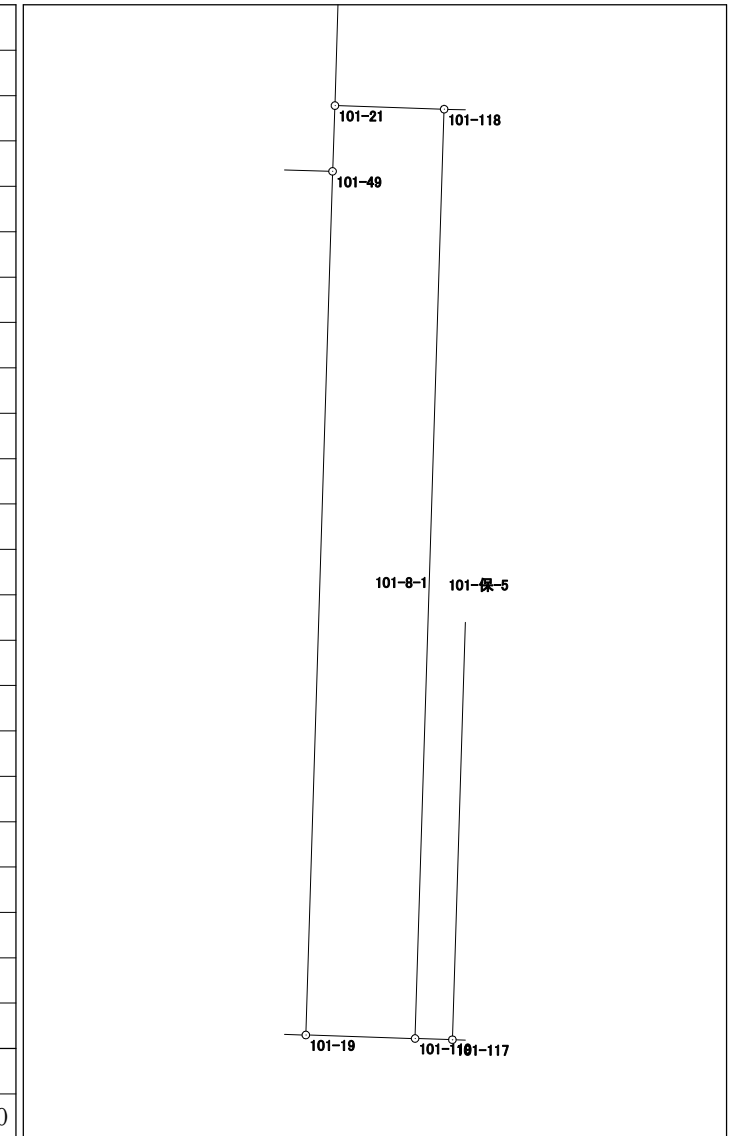


面積計算書（座標法）

世界測地系（測地成果2011）

所在	地番	公簿地目	現況地目	地積	所有者
前橋市六供町四丁目	101-8-2			60.41 m ²	

点名	X座標	Y座標	辺長	方向角	測角	DX	倍積 (Y×DX)
101-114	41381.776	-67735.581	3.496	271-53-06	90-05-28	17.388	-1177786.282428
101-116	41381.891	-67739.075	17.283	181-47-37	89-54-31	-17.160	1162402.527000
101-117	41364.616	-67739.616	3.496	91-51-09	90-03-32	-17.388	1177856.443008
101-115	41364.503	-67736.122	17.281	1-47-38	89-56-29	17.160	-1162351.853520

倍面積	120.834060
面積	60.4170300

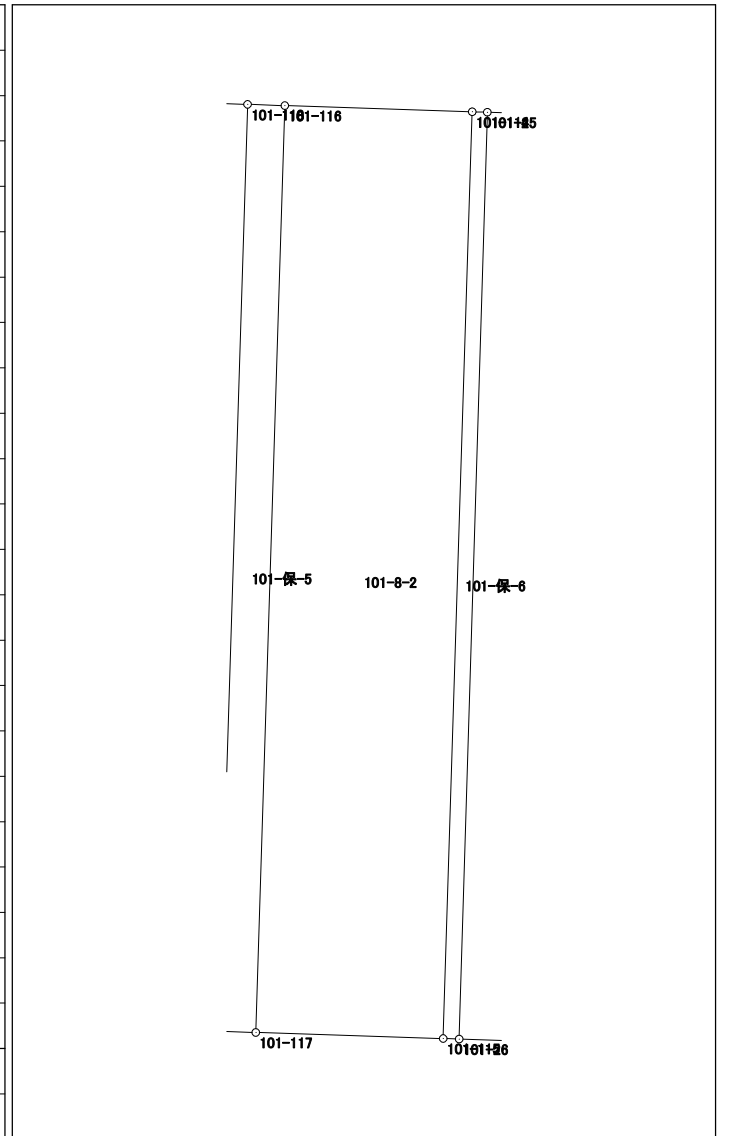


面積計算書 (座標法)

世界測地系 (測地成果2011)

所在	地番	公簿地目	現況地目	地積	所有者
前橋市六供町四丁目	101-13			164.01 m ²	

点名	X座標	Y座標	辺長	方向角	測角	DX	倍積 (Y×DX)
101-106	41380.890	-67779.683	0.845	1-49-48	90-08-24	0.436	-29551.941788
101-113	41381.735	-67779.656	10.565	1-51-38	180-01-50	11.404	-772959.197024
101-40	41392.294	-67779.313	2.471	271-49-55	89-58-17	10.638	-721036.331694
101-38	41392.373	-67781.783	2.099	271-43-12	179-53-17	0.142	-9625.013186
101-105	41392.436	-67783.881	10.288	271-43-56	180-00-44	0.374	-25351.171494
101-36	41392.747	-67794.164	11.465	176-54-36	85-10-40	-11.137	755023.604468
101-107	41381.299	-67793.546	13.869	91-41-24	94-46-48	-11.857	803828.074922

倍面積	328.024204
面積	164.0121020

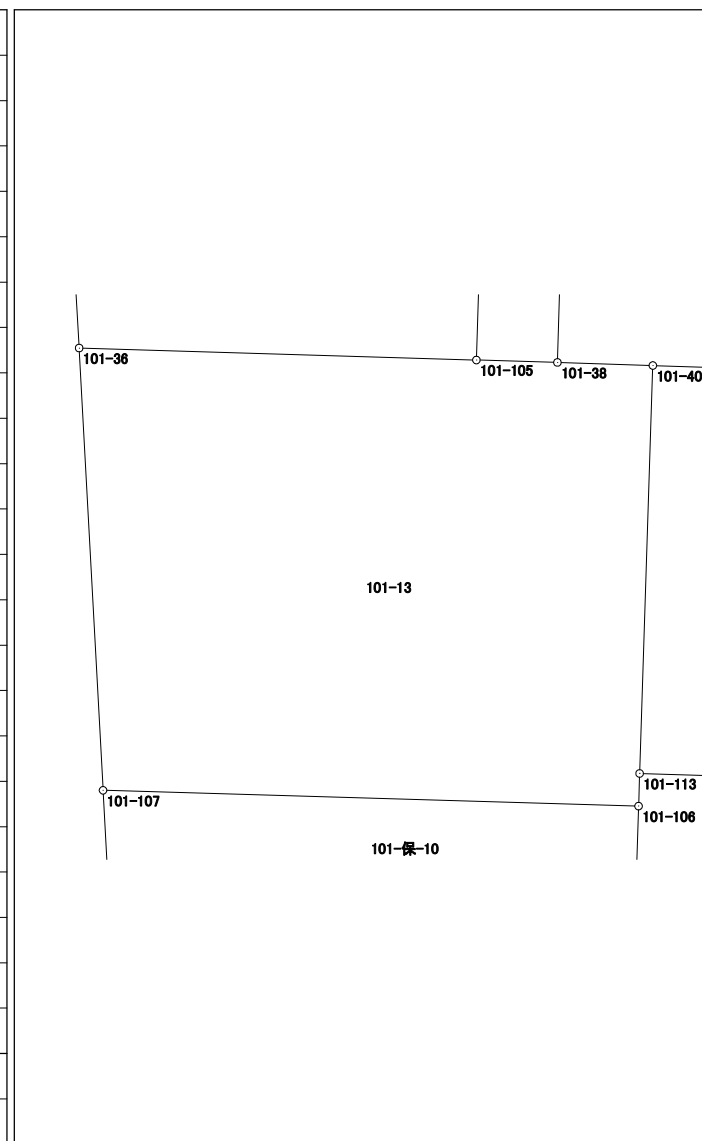


面積計算書 (座標法)

世界測地系 (測地成果2011)

所在	地番	公簿地目	現況地目	地積	所有者
前橋市六供町四丁目	101-14			404.49 m ²	

点名	X 座標	Y 座標	辺長	方向角	測角	DX	倍積 (Y×DX)
101-50	41381.523	-67767.020	0.154	181-51-35	90-09-13	0.241	-16331.851820
101-112	41381.369	-67767.025	2.911	181-49-50	179-58-15	-3.064	207638.164600
101-30	41378.459	-67767.118	12.980	181-45-57	179-56-07	-15.884	1076412.902312
101-20	41365.485	-67767.518	25.189	91-46-36	90-00-39	-13.755	932142.210090
101-19	41364.704	-67742.341	16.063	1-46-23	89-59-47	15.274	-1034696.516434
101-49	41380.759	-67741.844	11.921	271-46-26	90-00-03	16.424	-1112592.045856
101-55	41381.128	-67753.759	13.267	271-42-22	179-55-56	0.764	-51763.871876
倍面積							808.991016
面積							404.495080

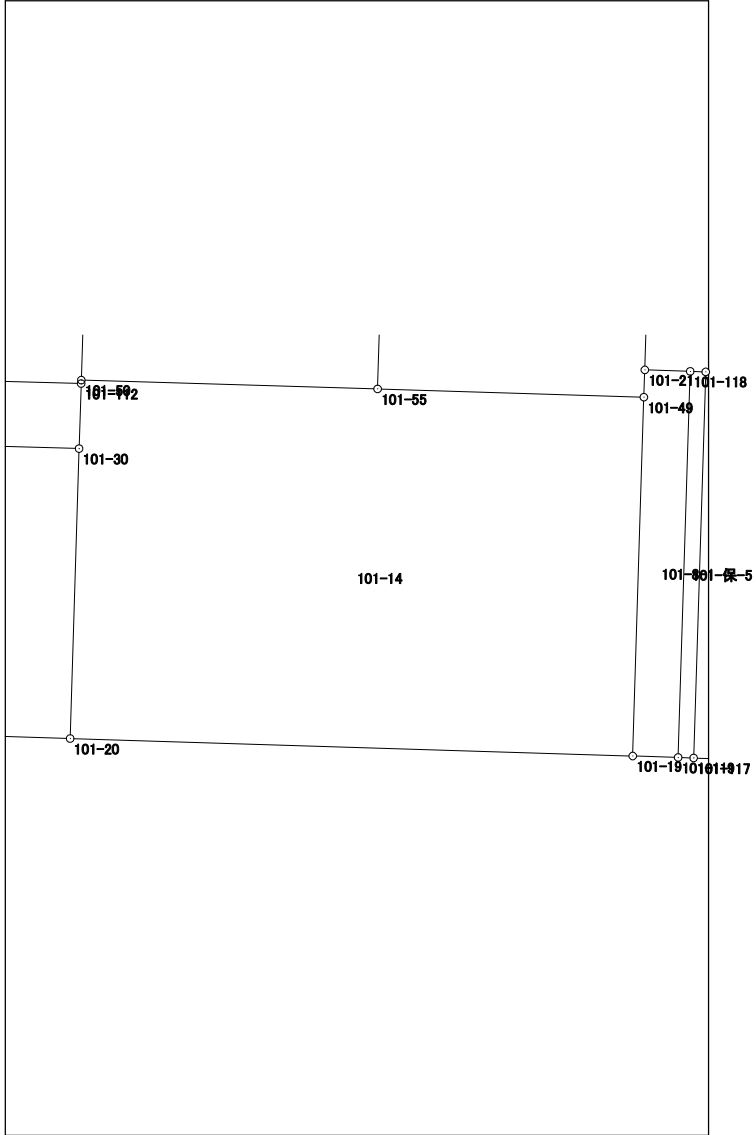


面積計算書 (座標法)

世界測地系 (測地成果2011)

所在	地番	公簿地目	現況地目	地積	所有者
前橋市六供町四丁目	101-15			281.49 m ²	

点名	X座標	Y座標	辺長	方向角	測角	DX	倍積 (Y×DX)
101-124	41363.452	-67702.300	11.136	91-50-32	90-06-01	-20.811	1408952.565300
101-6	41363.094	-67691.170	3.992	46-22-49	134-32-17	2.396	-162188.043320
101-5	41365.848	-67688.280	17.635	1-46-39	135-23-50	20.381	-1379554.834680
101-51	41383.475	-67687.733	13.952	271-45-58	89-59-19	18.057	-1222237.394781
101-125	41383.905	-67701.678	20.462	181-44-31	89-58-33	-20.023	1355590.698594

倍面積	562.991113
面積	281.495565

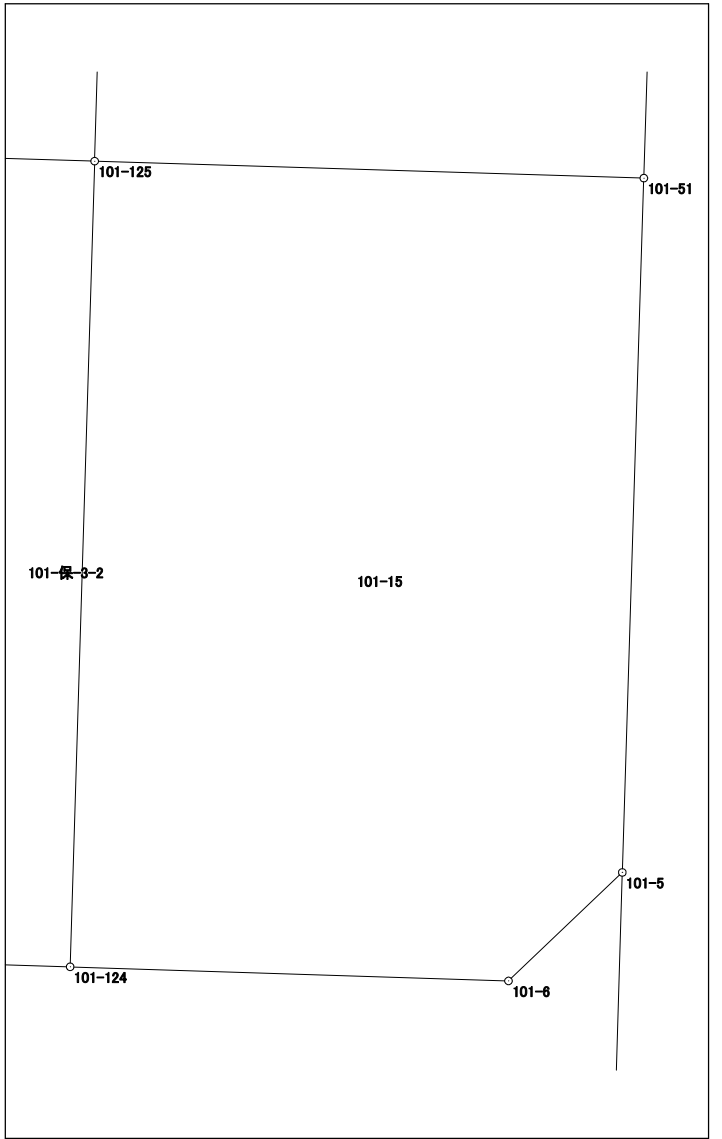


面積計算書 (座標法)

世界測地系 (測地成果2011)

所 在	地 番	公簿地目	現況地目	地 積	所 有 者
前橋市六供町四丁目	101-保-2			32.00 m ²	

点 名	X 座標	Y 座標	辺 長	方 向 角	測 角	DX	倍 積 (Y×DX)
101-23	41381.264	-67719.055	17.282	181-43-51	89-58-01	-17.217	1165918.969935
101-18	41363.990	-67719.577	1.852	91-45-50	90-01-59	-17.331	1173647.988987
101-122	41363.933	-67717.726	17.282	1-43-51	89-58-01	17.217	-1165896.088542
101-123	41381.207	-67717.204	1.852	271-45-50	90-01-59	17.331	-1173606.862524
倍面積							64.007856
面 積							32.0039280

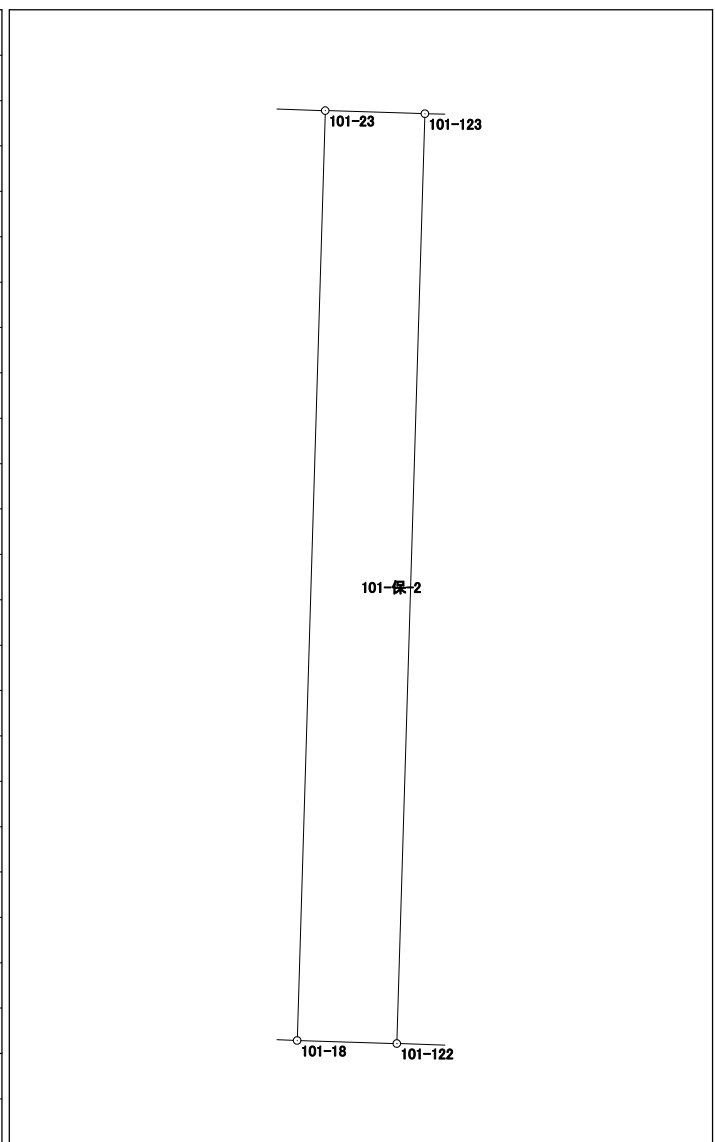


面積計算書（座標法）

世界測地系（測地成果2011）

所 在	地 番	公簿地目	現況地目	地 積	所 有 者
前橋市六供町四丁目	101-保-3-1			56.50 m ²	

点 名	X 座標	Y 座標	辺 長	方 向 角	測 角	DX	倍 積 (Y×DX)
101-125	41383.905	-67701.678	20.501	1-41-38	89-55-57	20.407	-1381588.142946
101-126	41404.397	-67701.072	2.747	271-41-23	89-59-45	20.573	-1392814.154256
101-16	41404.478	-67703.818	20.498	181-44-40	90-03-17	-20.407	1381631.813926
101-52	41383.990	-67704.442	2.765	91-45-41	90-01-01	-20.573	1392883.485266
						倍面積	113.001990
						面 積	56.5009950

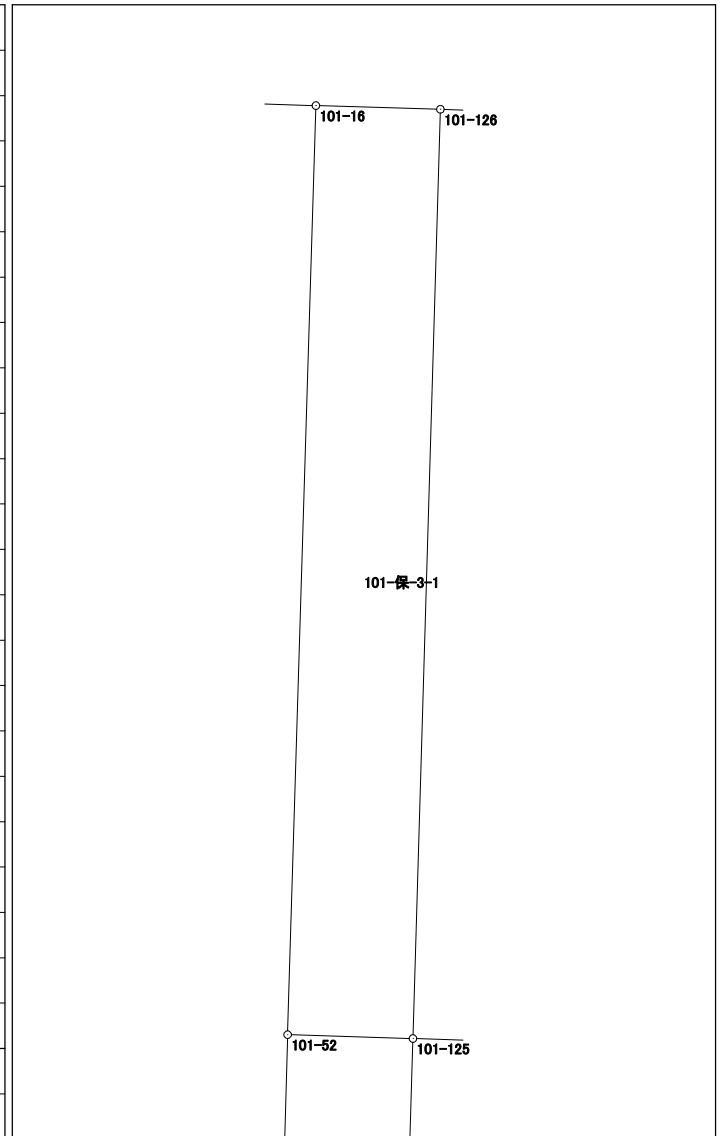


面積計算書 (座標法)

世界測地系 (測地成果2011)

所在	地番	公簿地目	現況地目	地積	所有者
前橋市六供町四丁目	101-保-3-2			56.50 m ²	

点名	X座標	Y座標	辺長	方向角	測角	DX	倍積 (Y×DX)
101-52	41383.990	-67704.442	3.173	181-36-26	89-50-45	-3.087	209003.612454
101-24	41380.818	-67704.531	17.285	181-46-01	180-09-35	-20.449	1384489.954419
101-17	41363.541	-67705.064	2.765	91-50-39	90-04-38	-17.366	1175766.141424
101-124	41363.452	-67702.300	20.462	1-44-31	89-53-52	20.364	-1378689.637200
101-125	41383.905	-67701.678	2.765	271-45-41	90-01-10	20.538	-1390457.062764
						倍面積	113.008333
						面積	56.5041665

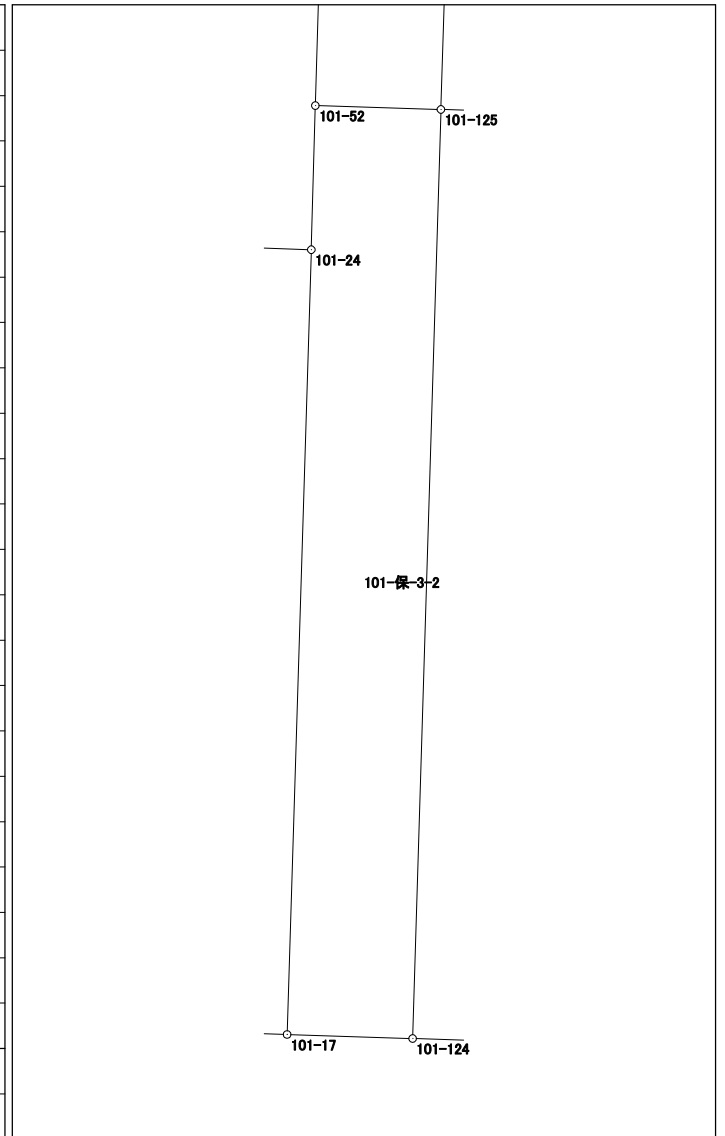


面積計算書（座標法）

世界測地系（測地成果2011）

所 在	地 番	公簿地目	現況地目	地 積	所 有 者
前橋市六供町四丁目	101-保-4			73.00 m ²	


点 名	X 座標	Y 座標	辺 長	方 向 角	測 角	DX	倍 積 (Y×DX)
101-25	41381.767	-67735.300	17.282	181-44-15	89-57-37	-17.143	1161186.247900
101-26	41364.493	-67735.824	4.225	91-46-36	90-02-21	-17.405	1178942.016720
101-120	41364.362	-67731.601	17.282	1-44-03	89-57-27	17.143	-1161122.835943
101-121	41381.636	-67731.078	4.224	271-46-38	90-02-35	17.405	-1178859.412590
						倍面積	146.016087
						面 積	73.0080435

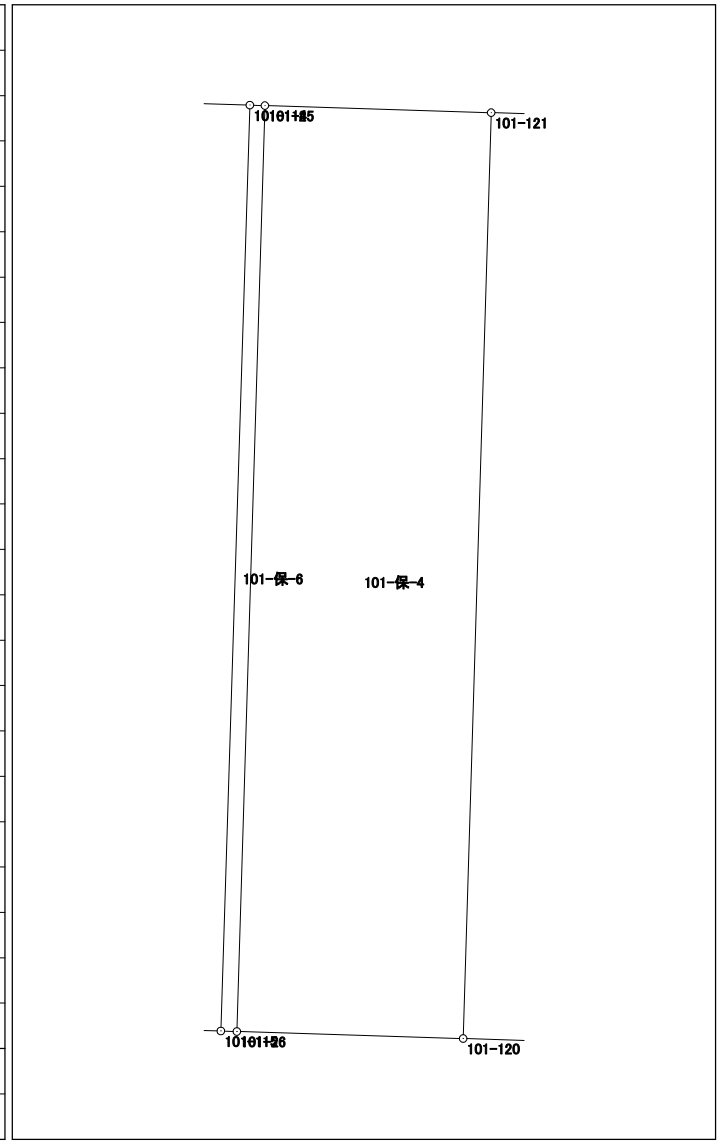

面積計算書（座標法）

世界測地系（測地成果2011）

所在	地番	公簿地目	現況地目	地積	所有者
前橋市六供町四丁目	101-保-6			5.00 m ²	

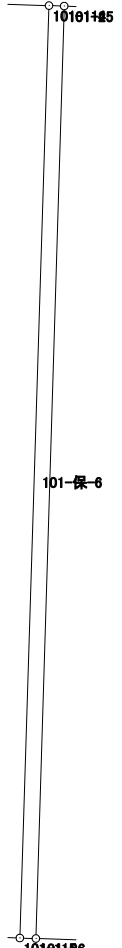点名	X 座標	Y 座標	辺長	方向角	測角	DX	倍積 (Y×DX)	
101-26	41364.493	-67735.824	17.282	1-44-15	89-48-56	17.264	-1169391.265536	
101-25	41381.767	-67735.300	0.281	271-50-04	90-05-49	17.283	-1170669.189900	
101-114	41381.776	-67735.581	17.281	181-47-38	89-57-34	-17.264	1169387.070384	
101-115	41364.503	-67736.122	0.298	91-55-19	90-07-41	-17.283	1170683.396526	


倍面積	10.011474
面積	5.0057370

面積計算書（座標法）

世界測地系（測地成果2011）

所 在	地 番	公簿地目	現況地目	地 積	所 有 者
前橋市六供町四丁目	101-保-7			30.45 m ²	

点 名	X 座標	Y 座標	辺 長	方 向 角	測 角	DX	倍 積 (Y×DX)
101-38	41392.373	-67781.783	14.504	1-46-12	90-03-00	14.434	-978362.255822
101-39	41406.870	-67781.335	2.099	271-56-18	90-10-06	14.568	-987438.488280
101-104	41406.941	-67783.433	14.512	181-46-09	89-49-51	-14.434	978386.071922
101-105	41392.436	-67783.881	2.099	91-43-12	89-57-03	-14.568	987475.578408
						倍面積	60.906228
						面 積	30.4531140

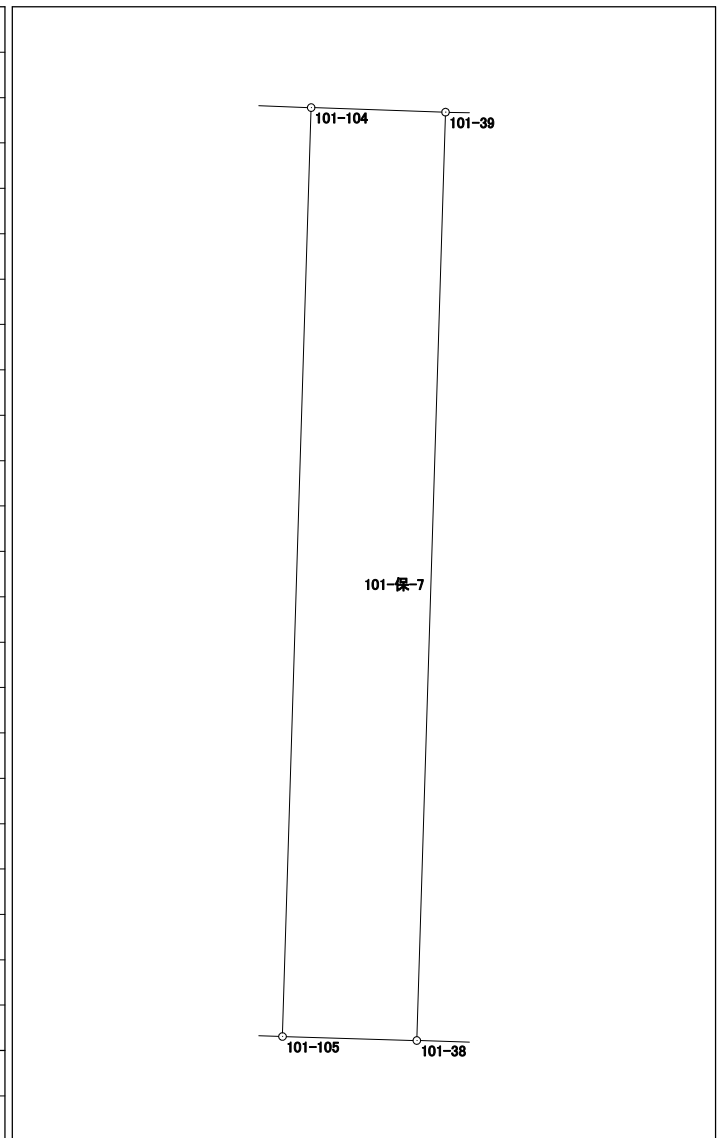


面積計算書（座標法）

世界測地系（測地成果2011）

所 在	地 番	公簿地目	現況地目	地 積	所 有 者
前橋市六供町四丁目	101-保-8			23.11 m ²	


点 名	X 座標	Y 座標	辺 長	方 向 角	測 角	DX	倍 積 (Y×DX)
101-101	41406.614	-67772.890	3.018	136-46-20	45-01-45	-2.134	144627.347260
101-102	41404.415	-67770.823	12.397	181-51-13	225-04-53	-14.590	988776.307570
101-103	41392.024	-67771.224	1.512	91-53-43	90-02-30	-12.441	843141.797784
101-48	41391.974	-67769.713	13.026	1-51-08	89-57-25	12.969	-878905.407897
101-46	41404.993	-67769.292	2.135	316-47-02	134-55-54	14.575	-987737.430900
101-47	41406.549	-67770.754	2.137	271-44-35	134-57-33	1.621	-109856.392234
						倍面積	46.221583
						面 積	23.1107915

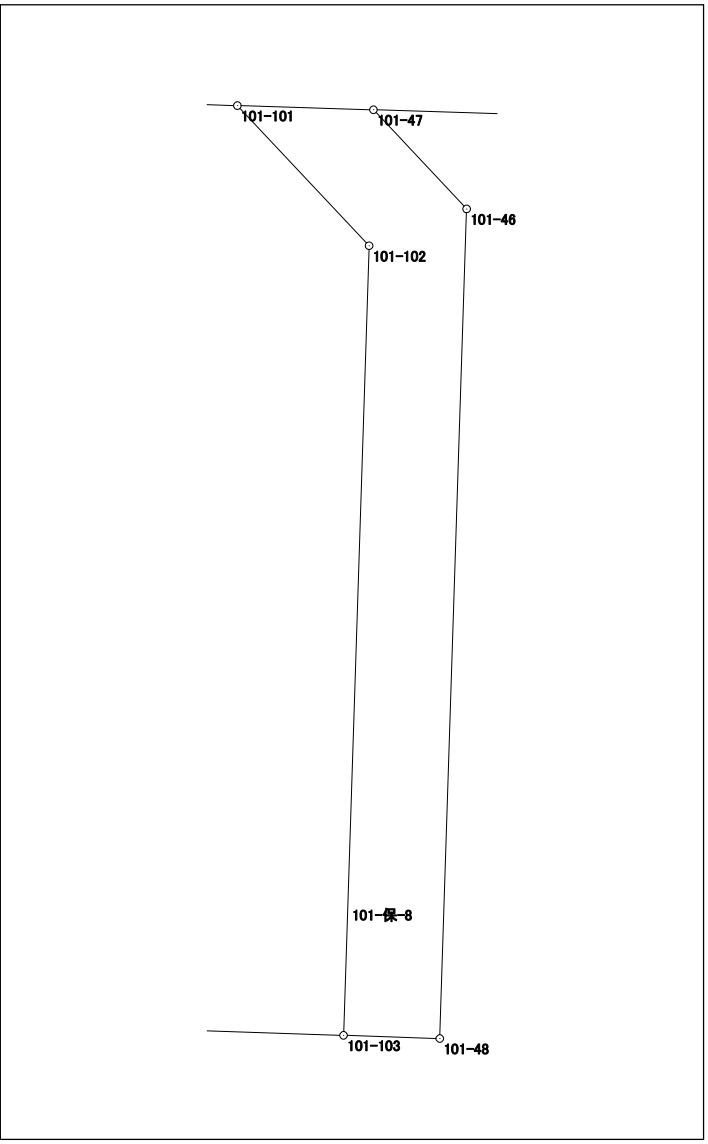

面積計算書（座標法）

世界測地系（測地成果2011）

所 在	地 番	公簿地目	現況地目	地 積	所 有 者
前橋市六供町四丁目	101-保-9			36.79 m ²	

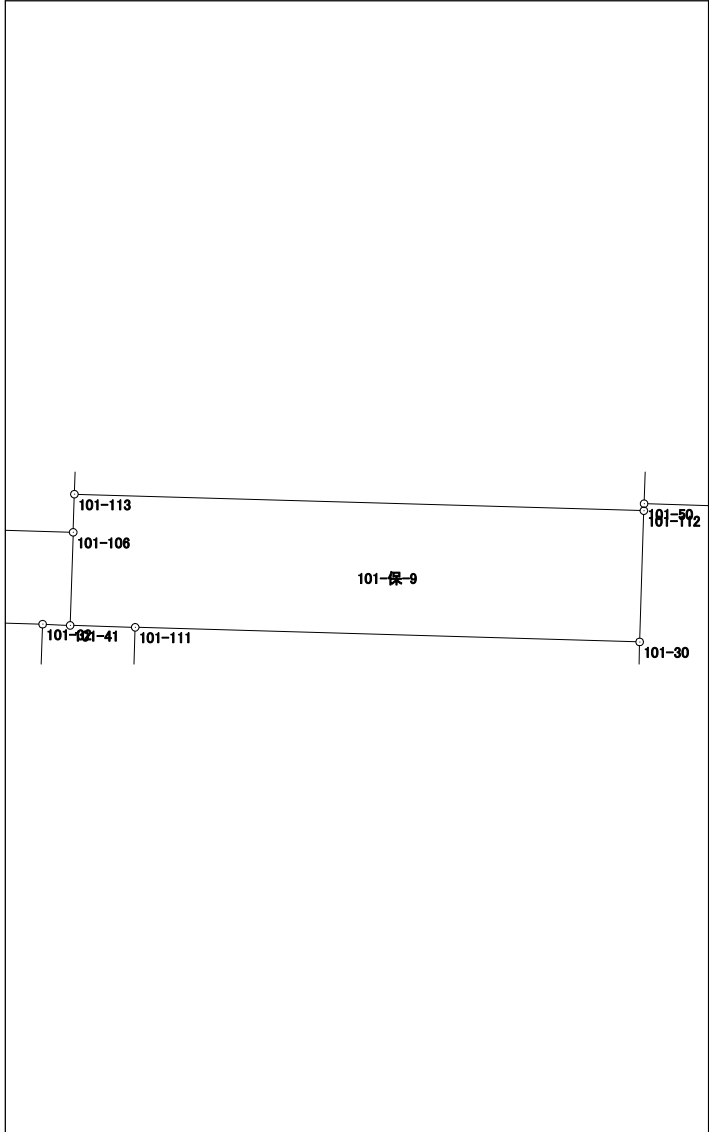
点 名	X 座標	Y 座標	辺 長	方 向 角	測 角	DX	倍 積 (Y×DX)	
101-41	41378.825	-67779.750	1.444	91-40-02	89-48-32	-2.107	142811.933250	
101-111	41378.783	-67778.307	11.194	91-39-31	179-59-29	-0.366	24806.860362	
101-30	41378.459	-67767.118	2.911	1-49-50	90-10-19	2.586	-175245.767148	
101-112	41381.369	-67767.025	12.636	271-39-35	89-49-45	3.276	-222004.773900	
101-113	41381.735	-67779.656	0.845	181-49-48	90-10-13	-0.479	32466.455224	
101-106	41380.890	-67779.683	2.066	181-51-30	180-01-42	-2.910	197238.877530	
							倍面積	
							面 積	36.7926590

面積計算書 (座標法)

世界測地系 (測地成果2011)

所在	地番	公簿地目	現況地目	地積	所有者
前橋市六供町四丁目	101-保-10			28.35 m ²	

点名	X座標	Y座標	辺長	方向角	測角	Dx	倍積 (Y×Dx)
101-41	41378.825	-67779.750	2.066	1-51-30	89-19-41	2.038	-138135.130500
101-106	41380.890	-67779.683	13.869	271-41-24	89-49-54	2.474	-167686.935742
101-107	41381.299	-67793.546	2.065	176-55-07	85-13-43	-1.653	112062.731538
101-31	41379.237	-67793.435	11.025	91-41-21	94-46-14	-2.387	161822.929345
101-108	41378.912	-67782.415	2.055	91-40-24	179-59-03	-0.385	26096.229775
101-32	41378.852	-67780.361	0.612	92-31-49	180-51-25	-0.087	5896.891407

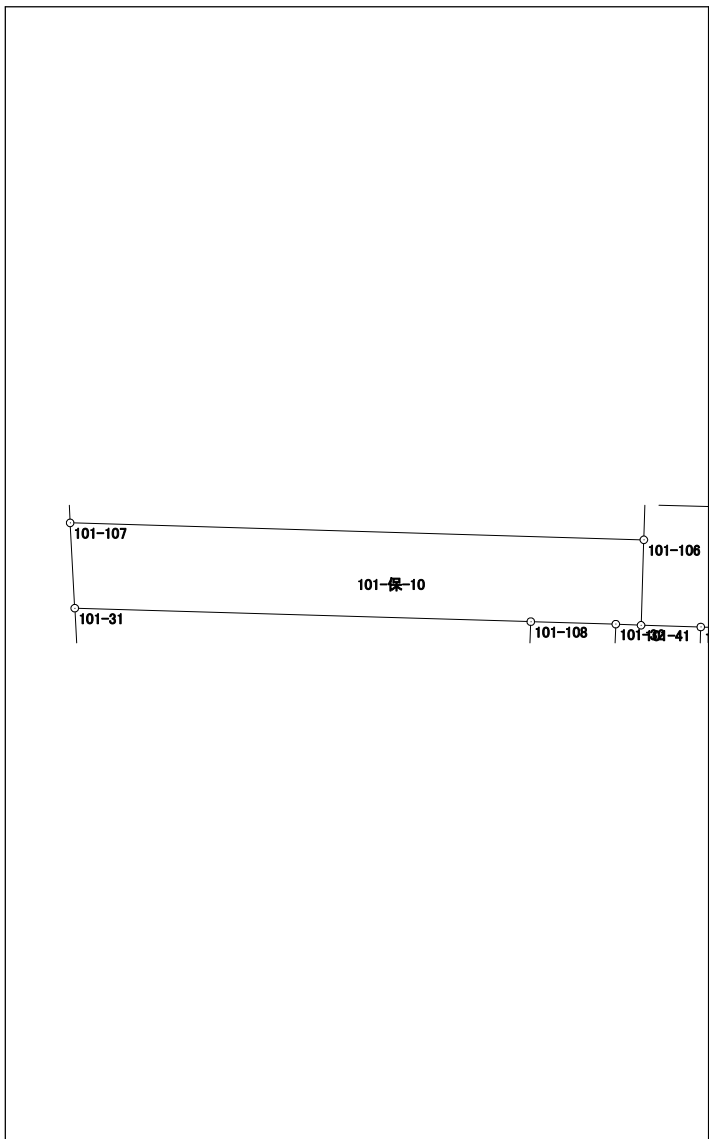

倍面積	56.715823
面積	28.3579115


面積計算書 (座標法)

世界測地系 (測地成果2011)

所 在	地 番	公簿地目	現況地目	地 積	所 有 者
前橋市六供町四丁目	101-保-11			26.65 m ²	

点 名	X 座標	Y 座標	辺 長	方 向 角	測 角	DX	倍 積 (Y×DX)
101-33	41365.887	-67780.781	12.972	1-51-20	90-10-56	12.905	-874710.978805
101-32	41378.852	-67780.361	2.055	271-40-24	89-49-04	13.025	-882839.202025
101-108	41378.912	-67782.415	12.972	181-51-20	90-10-56	-12.905	874732.065575
101-109	41365.947	-67782.835	2.055	91-40-24	89-49-04	-13.025	882871.425875

倍面積	53.310620
面 積	26.6553100

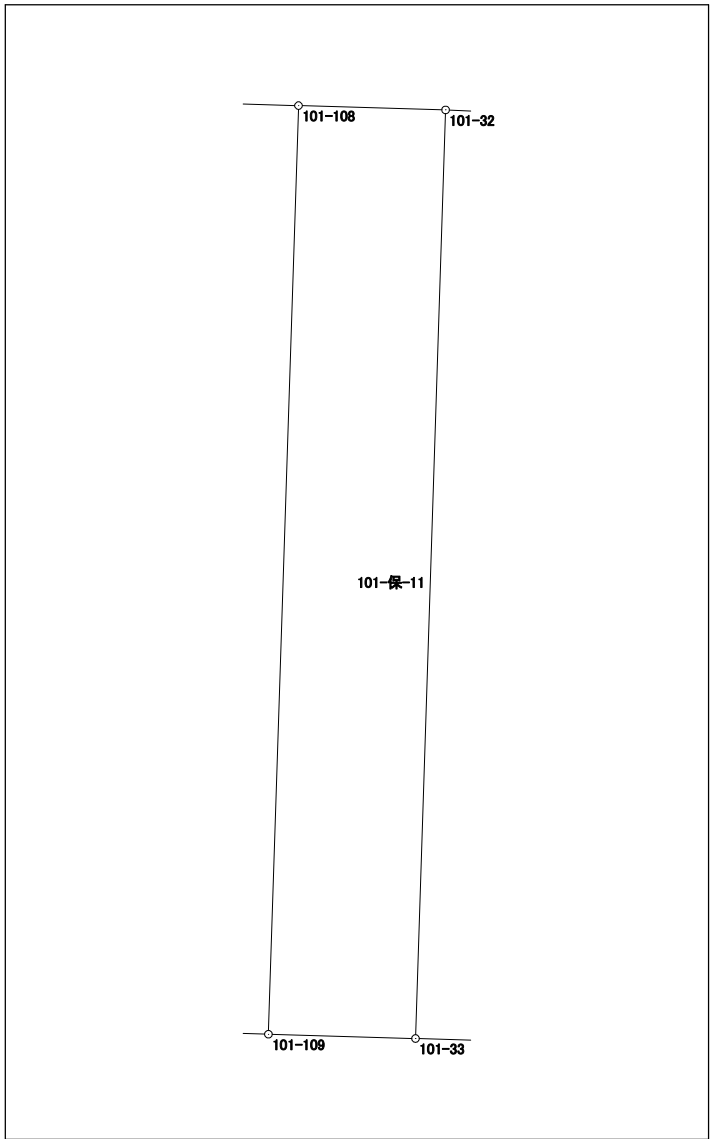

面積計算書（座標法）

世界測地系（測地成果2011）

所在	地番	公簿地目	現況地目	地積	所有者
前橋市六供町四丁目	101-保-12			26.65 m ²	

点名	X座標	Y座標	辺長	方向角	測角	DX	倍積 (Y×DX)
101-32	41378.852	-67780.361	12.972	181-51-20	89-19-31	-12.938	876942.310618
101-33	41365.887	-67780.781	2.056	91-43-41	89-52-21	-13.027	882980.234087
101-110	41365.825	-67778.726	12.965	1-51-07	90-07-26	12.896	-874074.450496
101-111	41378.783	-67778.307	1.444	271-40-02	89-48-55	13.000	-881117.991000
101-41	41378.825	-67779.750	0.612	272-31-49	180-51-47	0.069	-4676.802750

倍面積	53.300459
面積	26.6502295

