



102街区 画地出来形確認図 (4959.56㎡)

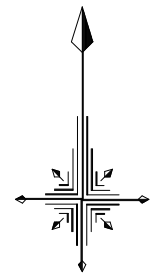

S=1/500

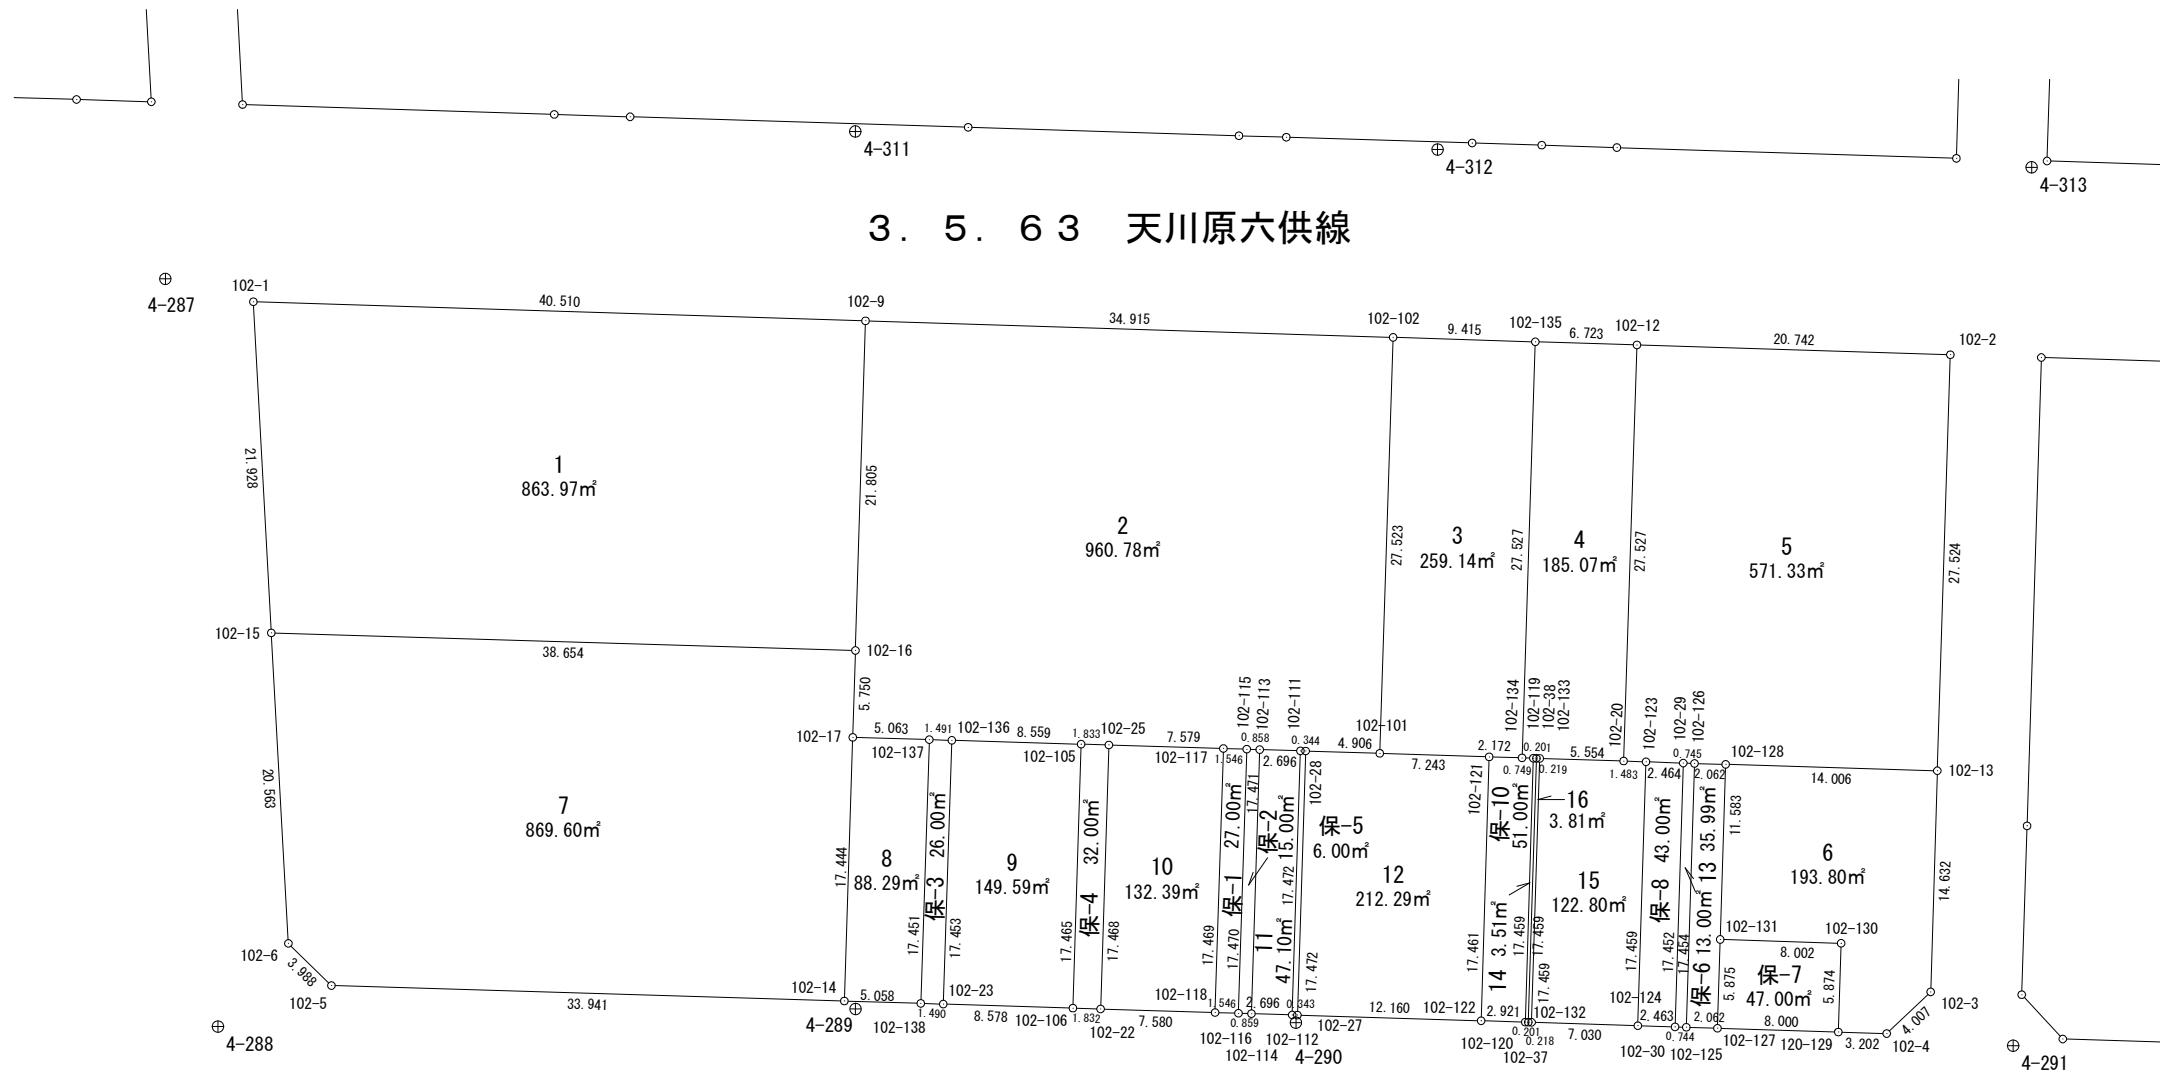

面積計算書（座標法）

世界測地系（測地成果2011）

所 在	地 番	公簿地目	現況地目	地 積	所 有 者
前橋市六供町四丁目	102-1			863.97 m ²	


点 名	X 座標	Y 座標	辺 長	方 向 角	測 角	DX	倍 積 (Y×DX)	
102-1	41458.450	-67797.768	21.928	176-54-08	85-06-56	-20.633	1398871.347144	
102-15	41436.554	-67796.583	38.654	91-43-22	94-49-14	-23.058	1563253.610814	
102-16	41435.392	-67757.946	21.805	1-45-20	90-01-58	20.633	-1398049.699818	
102-9	41457.187	-67757.278	40.510	271-47-12	90-01-52	23.058	-1562347.316124	
						倍面積	1727.942016	
						面 積	863.9710080	

面積計算書（座標法）

世界測地系（測地成果2011）

所 在	地 番	公簿地目	現況地目	地 積	所 有 者
前橋市六供町四丁目	102-2			960.78 m ²	

点 名	X 座標	Y 座標	辺 長	方 向 角	測 角	DX	倍 積 (Y×DX)
102-9	41457.187	-67757.278	21.805	181-45-20	89-57-54	-20.704	1402846.683712
102-16	41435.392	-67757.946	5.750	181-44-03	179-58-43	-27.542	1866189.348732
102-17	41429.645	-67758.120	5.063	91-42-32	89-58-29	-5.898	399637.391760
102-137	41429.494	-67753.059	1.491	91-41-29	179-58-57	-0.195	13211.846505
102-136	41429.450	-67751.569	8.559	91-42-02	180-00-33	-0.298	20189.967562
102-105	41429.196	-67743.014	1.833	91-41-18	179-59-16	-0.308	20864.848312
102-25	41429.142	-67741.182	7.579	91-45-43	180-04-25	-0.287	19441.719234
102-117	41428.909	-67733.607	1.546	91-44-33	179-58-50	-0.280	18965.409960
102-115	41428.862	-67732.062	0.858	91-44-09	179-59-36	-0.073	4944.440526
102-113	41428.836	-67731.204	2.696	91-45-50	180-01-41	-0.109	7382.701236
102-111	41428.753	-67728.509	0.344	91-49-53	180-04-03	-0.094	6366.479846
102-28	41428.742	-67728.165	4.906	91-48-37	179-58-44	-0.166	11242.875390
102-101	41428.587	-67723.261	27.523	1-50-04	90-01-27	27.354	-1852502.081394
102-102	41456.096	-67722.380	34.915	271-47-26	89-57-22	28.600	-1936860.068000

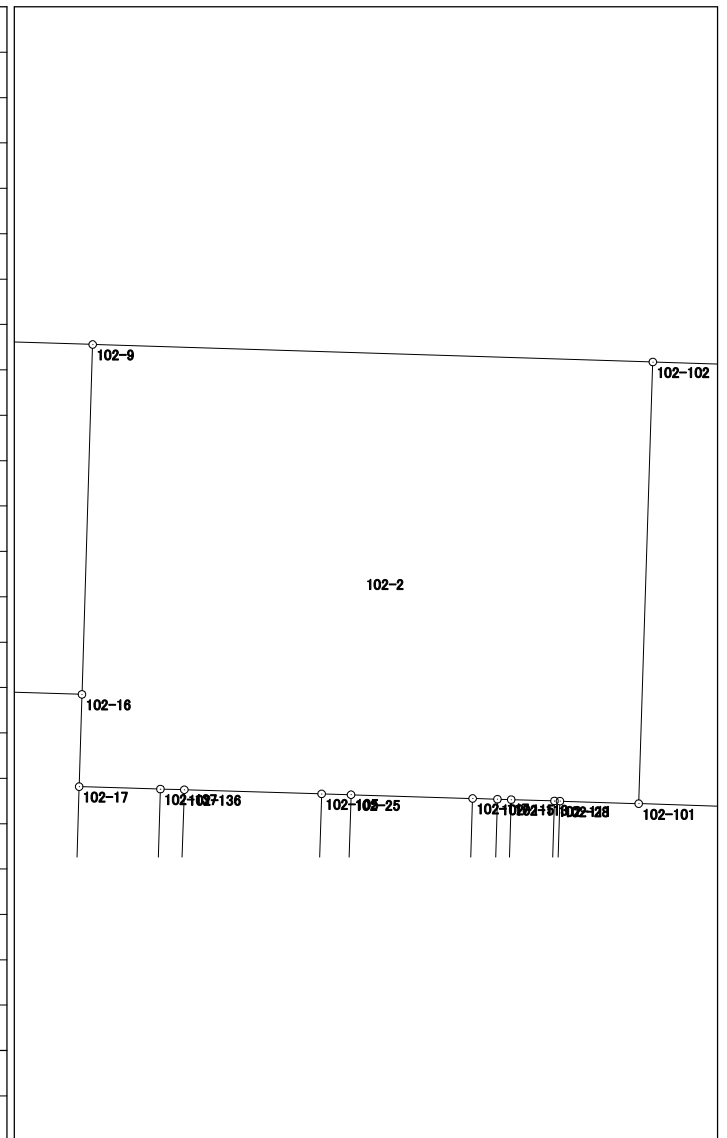


倍面積	1921.563381
面 積	960.7816905

面積計算書 (座標法)

世界測地系 (測地成果2011)

所 在	地 番	公簿地目	現況地目	地 積	所 有 者
前橋市六供町四丁目	102-4			185.07 m ²	

点 名	X 座標	Y 座標	辺 長	方 向 角	測 角	DX	倍 積 (Y×DX)
102-134	41428.289	-67713.851	0.749	91-50-07	90-00-04	-27.537	1864636.314987
102-119	41428.265	-67713.102	0.201	91-42-35	179-52-28	-0.030	2031.393060
102-38	41428.259	-67712.901	0.219	91-49-51	180-07-16	-0.013	880.267713
102-133	41428.252	-67712.682	5.554	91-47-06	179-57-15	-0.180	12188.282760
102-20	41428.079	-67707.131	27.527	1-50-03	90-02-57	27.340	-1851112.961540
102-12	41455.592	-67706.250	6.723	271-47-24	89-57-21	27.723	-1877020.368750
102-135	41455.802	-67712.970	27.527	181-50-03	90-02-39	-27.303	1848767.219910

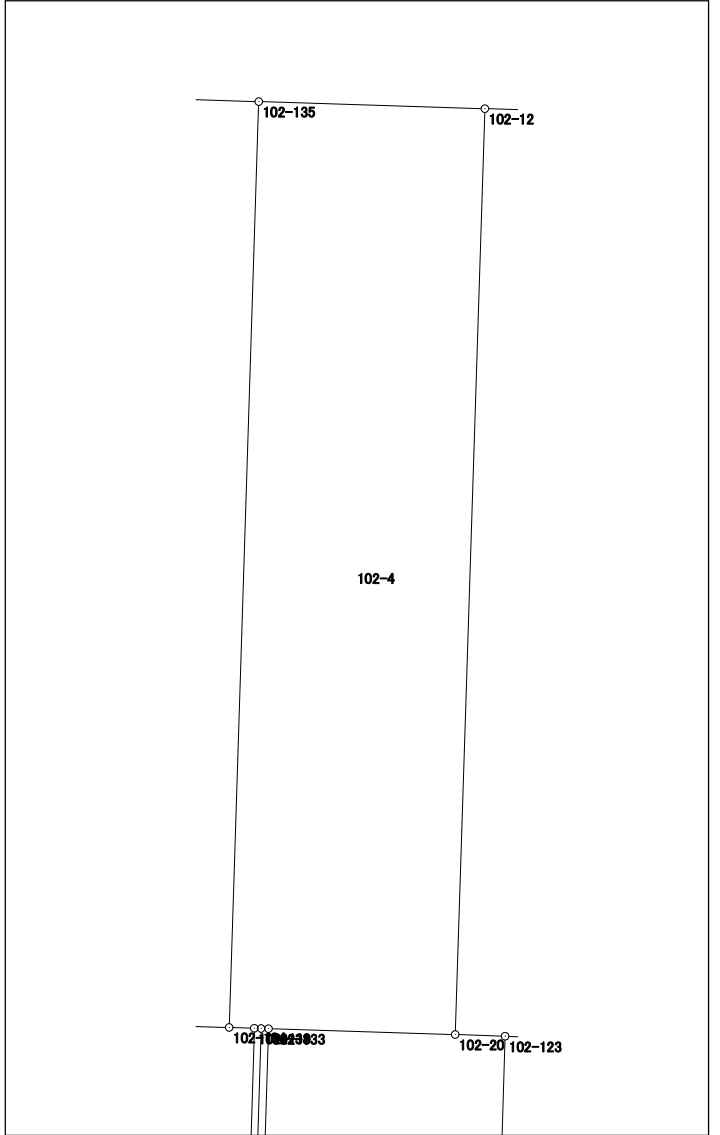


倍面積	370.148140
面 積	185.0740700

面積計算書（座標法）

世界測地系（測地成果2011）

所 在	地 番	公簿地目	現況地目	地 積	所 有 者
前橋市六供町四丁目	102-6			193.80 m ²	

点 名	X 座標	Y 座標	辺 長	方 向 角	測 角	DX	倍 積 (Y×DX)
102-128	41427.858	-67700.381	11.583	181-47-10	90-04-04	-11.157	755333.150817
102-131	41416.281	-67700.742	8.002	91-48-43	90-01-33	-11.830	800899.777860
102-130	41416.028	-67692.744	5.874	181-48-17	269-59-34	-6.124	414550.364256
120-129	41410.157	-67692.929	3.202	91-48-28	90-00-11	-5.972	404262.171988
102-4	41410.056	-67689.729	4.007	46-31-37	134-43-09	2.656	-179783.920224
102-3	41412.813	-67686.821	14.632	1-43-24	135-11-47	17.382	-1176532.322622
102-13	41427.438	-67686.381	14.006	271-43-06	89-59-42	15.045	-1018341.602145

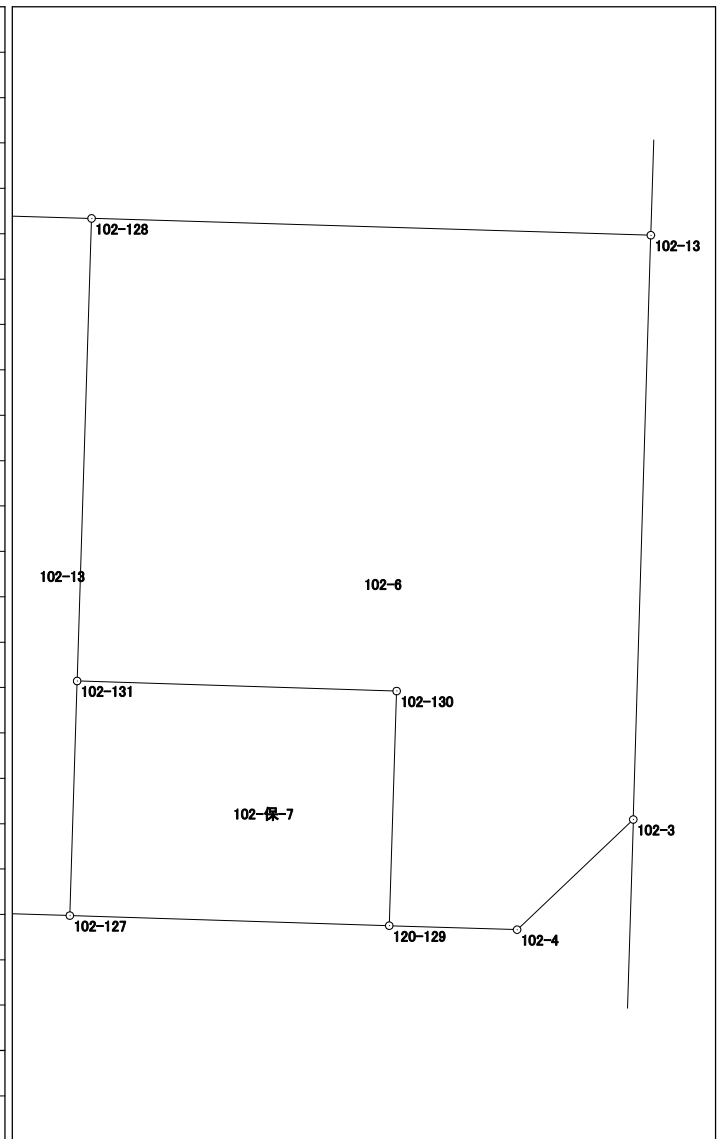


倍面積	387.619930
面 積	193.8099650

面積計算書（座標法）

世界測地系（測地成果2011）

所在	地番	公簿地目	現況地目	地積	所有者
前橋市六供町四丁目	102-7			869.60 m ²	

点名	X座標	Y座標	辺長	方向角	測角	DX	倍積 (Y×DX)
102-15	41436.554	-67796.583	20.563	176-51-09	85-07-47	-19.370	1313219.812710
102-6	41416.022	-67795.454	3.988	134-24-02	137-32-53	-23.322	1581125.578188
102-5	41413.232	-67792.605	33.941	91-43-32	137-19-30	-3.812	258425.410260
102-14	41412.210	-67758.679	17.444	1-50-11	90-06-39	16.413	-1112123.198427
102-17	41429.645	-67758.120	5.750	1-44-03	179-53-52	23.182	-1570768.737840
102-16	41435.392	-67757.946	38.654	271-43-22	89-59-19	6.909	-468139.648914

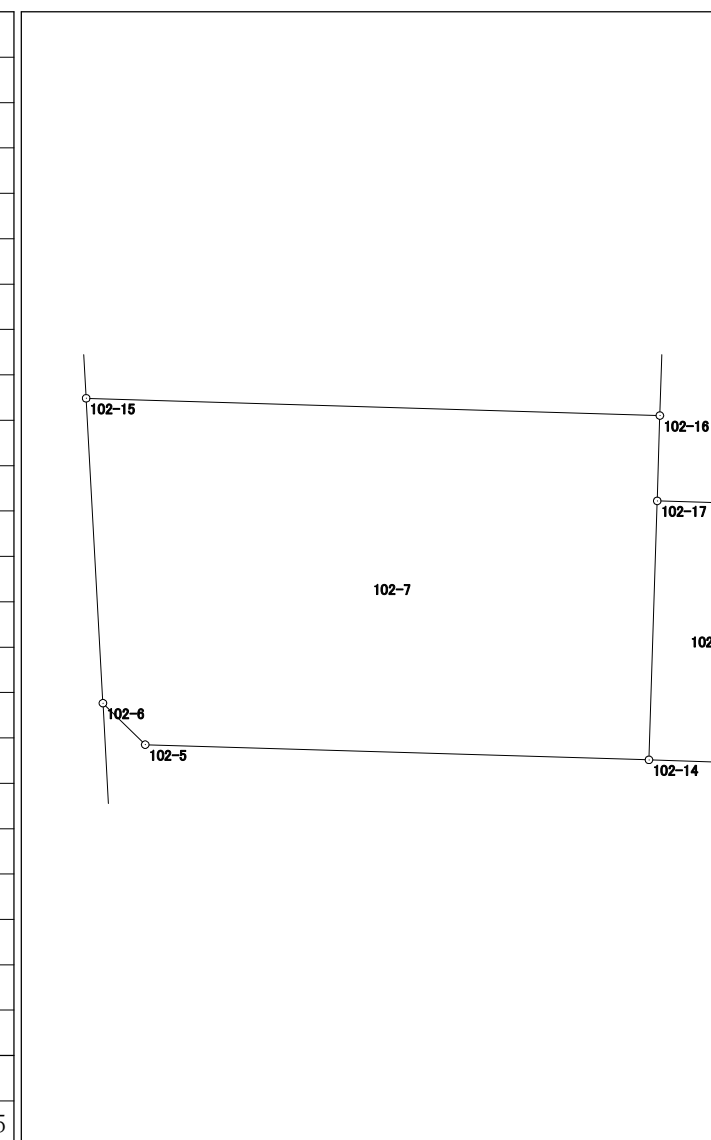


倍面積	1739.215977
面積	869.6079885

面積計算書（座標法）

世界測地系（測地成果2011）

所 在	地 番	公簿地目	現況地目	地 積	所 有 者
前橋市六供町四丁目	102-8			88.29 m ²	

点 名	X 座標	Y 座標	辺 長	方 向 角	測 角	DX	倍 積 (Y×DX)
102-137	41429.494	-67753.059	5.063	271-42-32	89-51-25	17.593	-1191979.566987
102-17	41429.645	-67758.120	17.444	181-50-11	90-07-39	-17.284	1171131.346080
102-14	41412.210	-67758.679	5.058	91-47-24	89-57-13	-17.593	1192078.439647
102-138	41412.052	-67753.623	17.451	1-51-07	90-03-43	17.284	-1171053.619932
倍面積							176.598808
面 積							88.2994040

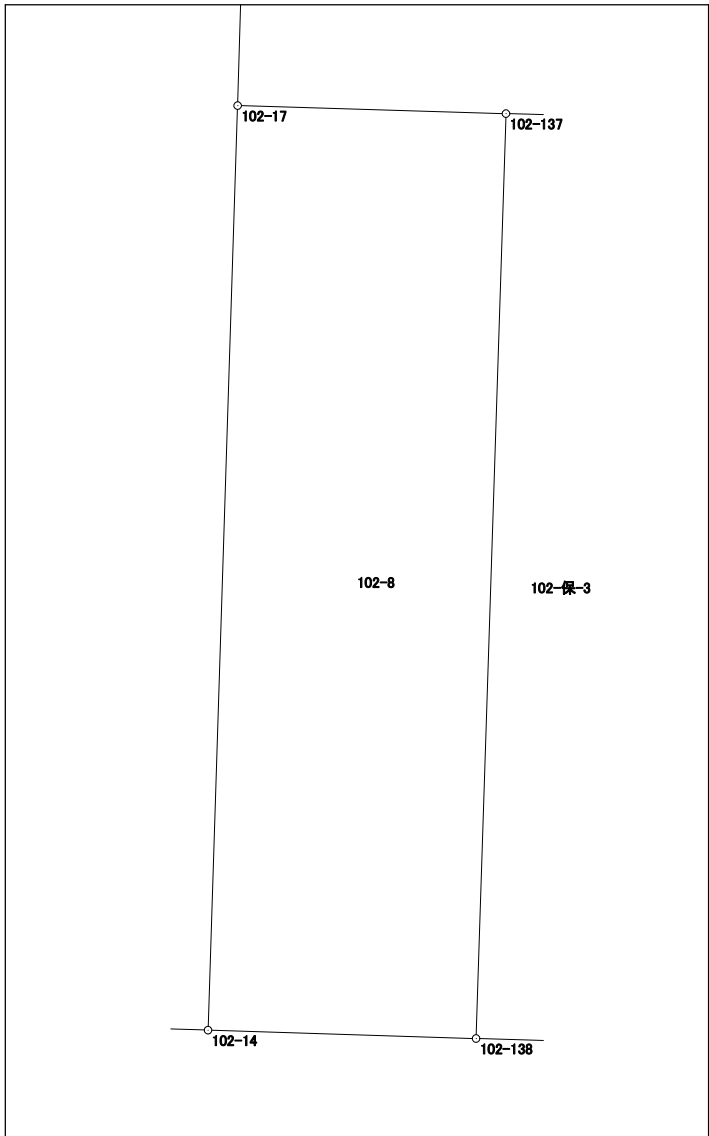


面積計算書 (座標法)

世界測地系 (測地成果2011)

所在	地番	公簿地目	現況地目	地積	所有者
前橋市六供町四丁目	102-9			149.59 m ²	

点名	X座標	Y座標	辺長	方向角	測角	DX	倍積 (Y×DX)
102-23	41412.006	-67752.134	8.578	91-46-37	89-55-19	-17.710	1199890.293140
102-106	41411.740	-67743.560	17.465	1-47-30	90-00-53	17.190	-1164511.796400
102-105	41429.196	-67743.014	8.559	271-42-02	89-54-32	17.710	-1199728.777940
102-136	41429.450	-67751.569	17.453	181-51-18	90-09-16	-17.190	1164649.471110

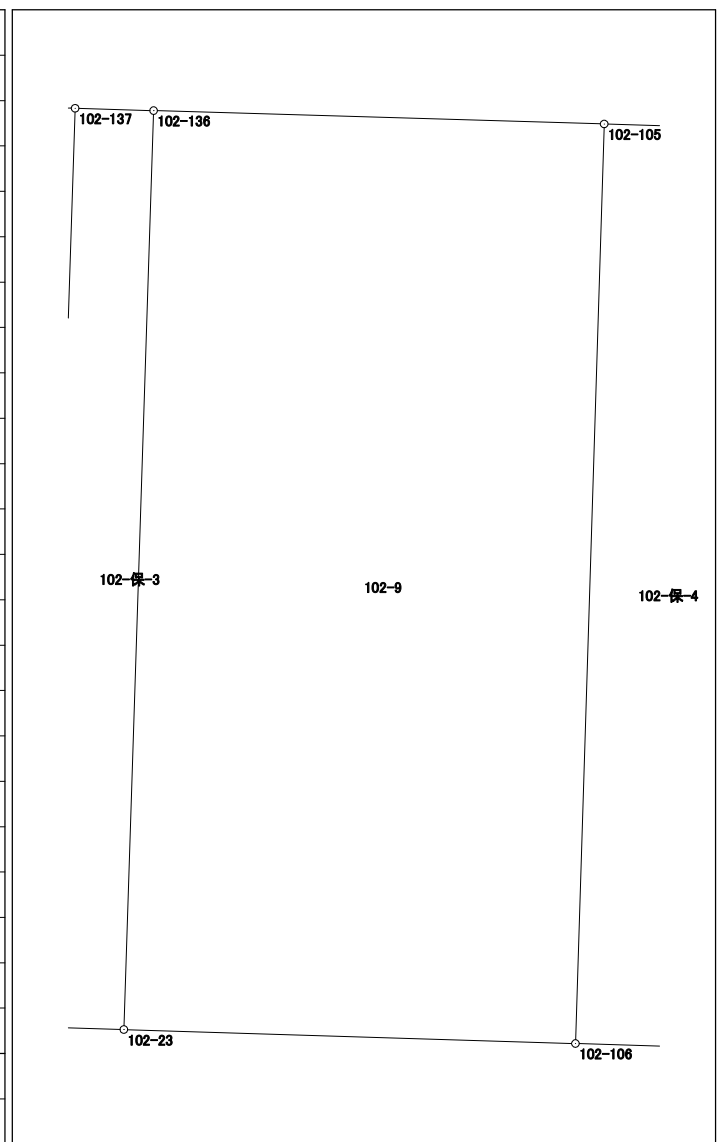


倍面積	299.189910
面積	149.5949550

面積計算書（座標法）

世界測地系（測地成果2011）

所 在	地 番	公簿地目	現況地目	地 積	所 有 者
前橋市六供町四丁目	102-10			132.39 m ²	

点 名	X 座標	Y 座標	辺 長	方 向 角	測 角	DX	倍 積 (Y×DX)
102-25	41429.142	-67741.182	17.468	181-47-40	90-01-57	-17.226	1166909.601132
102-22	41411.683	-67741.729	7.580	91-46-09	89-58-29	-17.693	1198554.411197
102-118	41411.449	-67734.153	17.469	1-47-28	90-01-19	17.226	-1166788.519578
102-117	41428.909	-67733.607	7.579	271-45-43	89-58-15	17.693	-1198410.708651

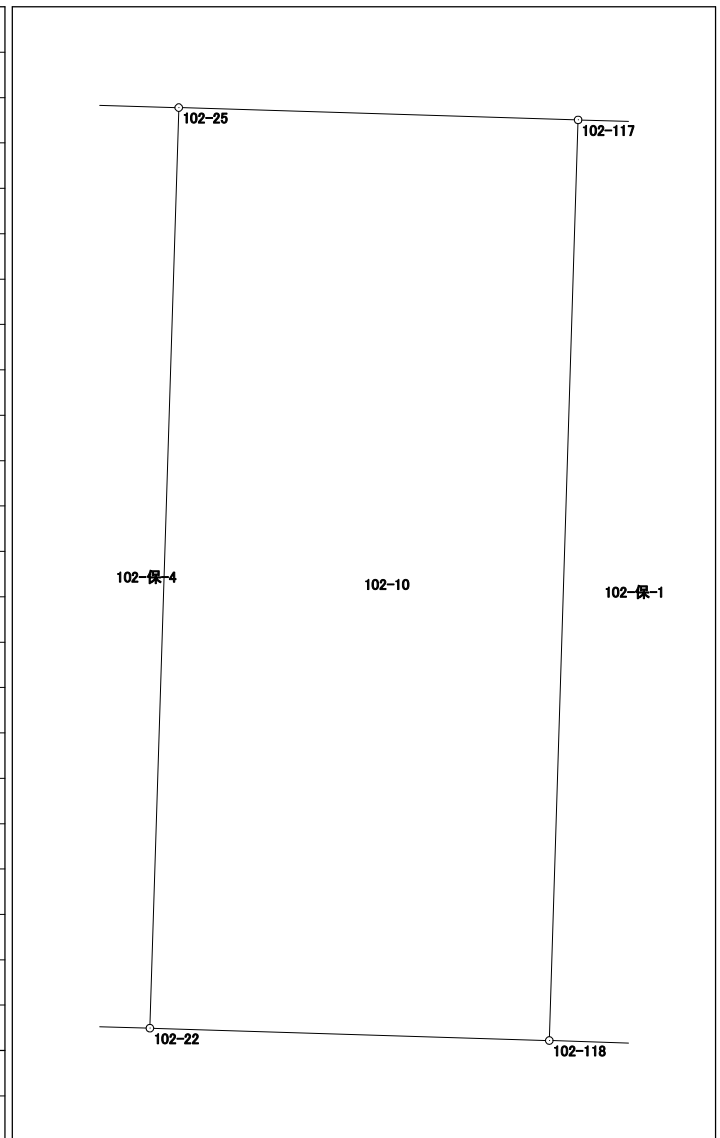


倍面積	264.784100
面 積	132.3920500

面積計算書（座標法）

世界測地系（測地成果2011）

所 在	地 番	公簿地目	現況地目	地 積	所 有 者
前橋市六供町四丁目	102-11			47.10 m ²	

点 名	X 座標	Y 座標	辺 長	方 向 角	測 角	DX	倍 積 (Y×DX)
102-113	41428.836	-67731.204	17.471	181-47-16	90-01-26	-17.379	1177100.594316
102-114	41411.374	-67731.749	2.696	91-47-07	89-59-51	-17.546	1188421.267954
102-112	41411.290	-67729.054	17.472	1-47-15	90-00-08	17.379	-1177063.229466
102-111	41428.753	-67728.509	2.696	271-45-50	89-58-35	17.546	-1188364.418914
						倍面積	94.213890
						面 積	47.1069450

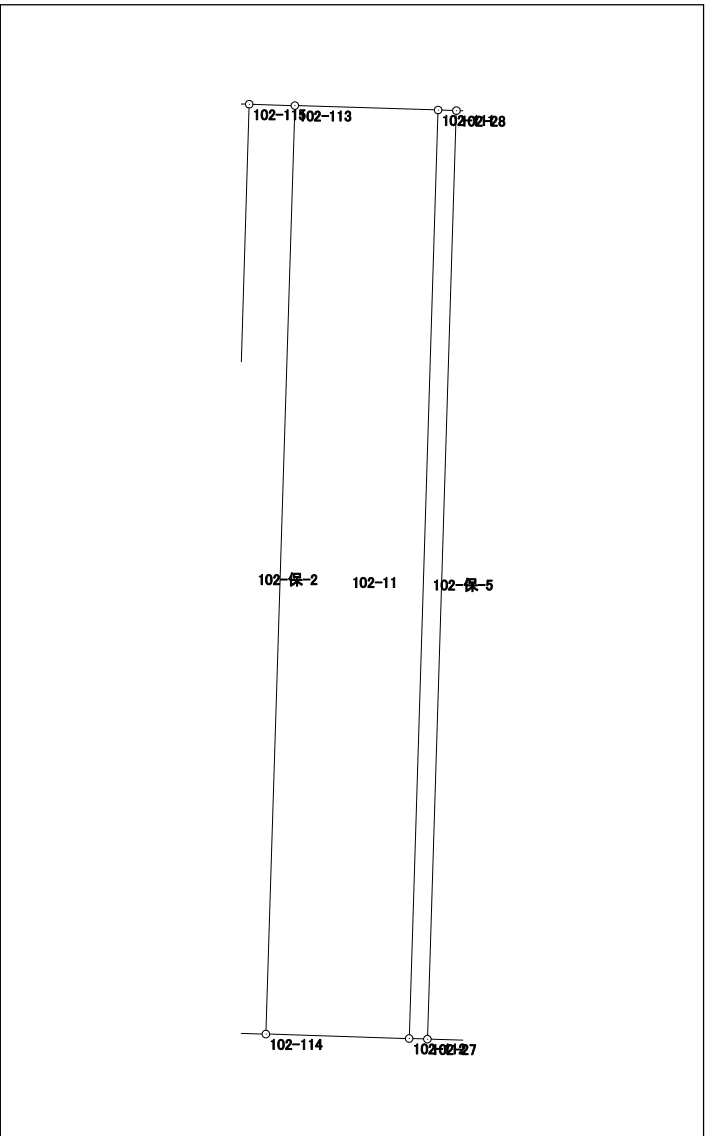


面積計算書（座標法）

世界測地系（測地成果2011）

所 在	地 番	公簿地目	現況地目	地 積	所 有 者
前橋市六供町四丁目	102-12			212.29 m ²	

点 名	X 座標	Y 座標	辺 長	方 向 角	測 角	DX	倍 積 (Y×DX)
102-121	41428.357	-67716.022	7.243	271-49-11	90-03-50	17.683	-1197422.417026
102-101	41428.587	-67723.261	4.906	271-48-37	179-59-26	0.385	-26073.455485
102-28	41428.742	-67728.165	17.472	181-47-27	89-58-50	-17.308	1172239.079820
102-27	41411.279	-67728.711	12.160	91-46-02	89-58-35	-17.838	1208144.746818
102-122	41410.904	-67716.557	17.461	1-45-21	89-59-19	17.078	-1156463.360446
						倍面積	424.593681
						面 積	212.2968405

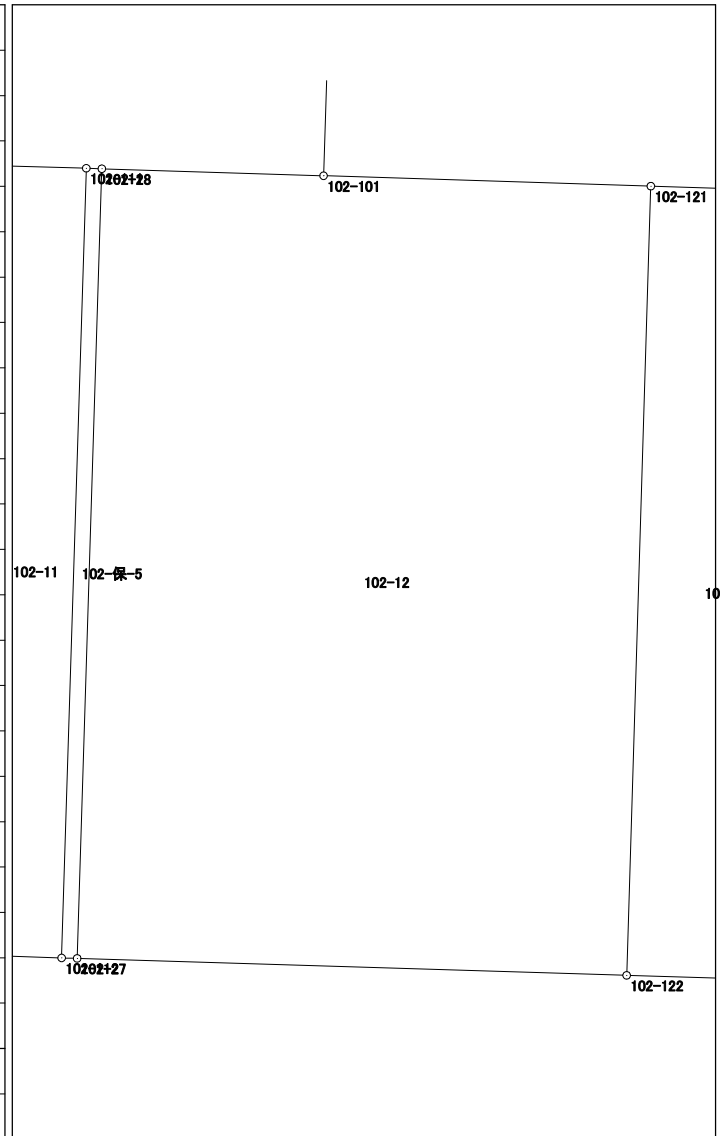


面積計算書（座標法）

世界測地系（測地成果2011）

所在	地番	公簿地目	現況地目	地積	所有者
前橋市六供町四丁目	102-13			35.99 m ²	

点名	X座標	Y座標	辺長	方向角	測角	DX	倍積(Y×DX)
102-126	41427.920	-67702.442	17.454	181-47-10	90-03-47	-17.384	1176939.251728
102-125	41410.474	-67702.986	2.062	91-48-23	90-01-13	-17.511	1185546.987846
102-127	41410.409	-67700.925	5.875	1-47-06	89-58-43	5.807	-393139.271475
102-131	41416.281	-67700.742	11.583	1-47-10	180-00-04	17.449	-1181310.247158
102-128	41427.858	-67700.381	2.062	271-43-23	89-56-13	11.639	-787964.734459
倍面積							71.986482
面積							35.9932410

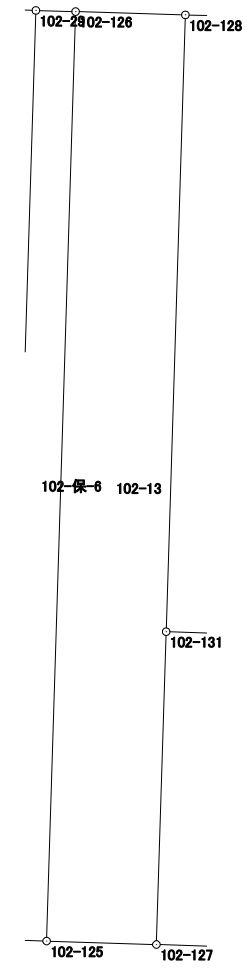


面積計算書（座標法）

世界測地系（測地成果2011）

所 在	地 番	公簿地目	現況地目	地 積	所 有 者
前橋市六供町四丁目	102-14			3.51 m ²	

点 名	X 座標	Y 座標	辺 長	方 向 角	測 角	DX	倍 積 (Y×DX)
102-37	41410.808	-67713.436	17.459	1-45-22	90-02-47	17.445	-1181260.891020
102-38	41428.259	-67712.901	0.201	271-42-35	89-57-13	17.457	-1182064.112757
102-119	41428.265	-67713.102	17.459	181-45-22	90-02-47	-17.445	1181255.064390
102-120	41410.814	-67713.637	0.201	91-42-35	89-57-13	-17.457	1182076.961109
						倍面積	7.021722
						面 積	3.5108610

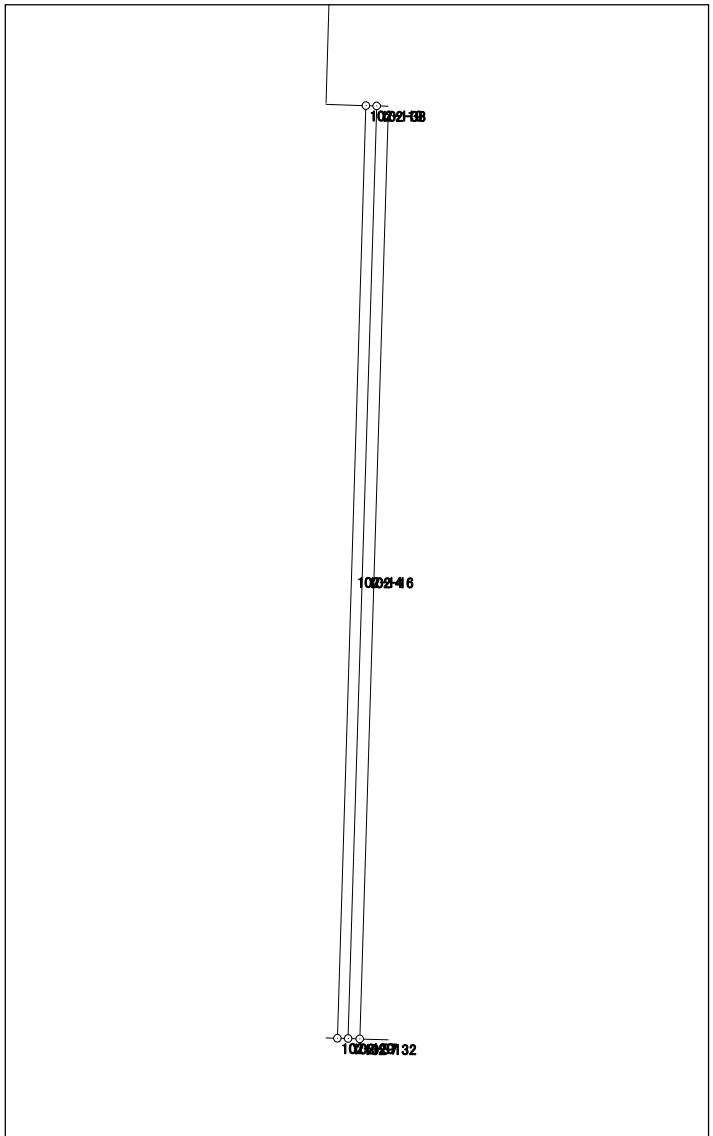


面積計算書（座標法）

世界測地系（測地成果2011）

所 在	地 番	公簿地目	現況地目	地 積	所 有 者
前橋市六供町四丁目	102-15			122.80 m ²	

点 名	X 座標	Y 座標	辺 長	方 向 角	測 角	DX	倍 積 (Y×DX)
102-132	41410.801	-67713.218	7.030	91-49-34	90-04-01	-17.675	1196831.128150
102-124	41410.577	-67706.192	17.459	1-46-56	89-57-22	17.227	-1166374.569584
102-123	41428.028	-67705.649	1.483	271-58-15	90-11-19	17.502	-1184984.268798
102-20	41428.079	-67707.131	5.554	271-47-06	179-48-51	0.224	-15166.397344
102-133	41428.252	-67712.682	17.459	181-45-33	89-58-27	-17.278	1169939.719596
						倍面積	245.612020
						面 積	122.8060100

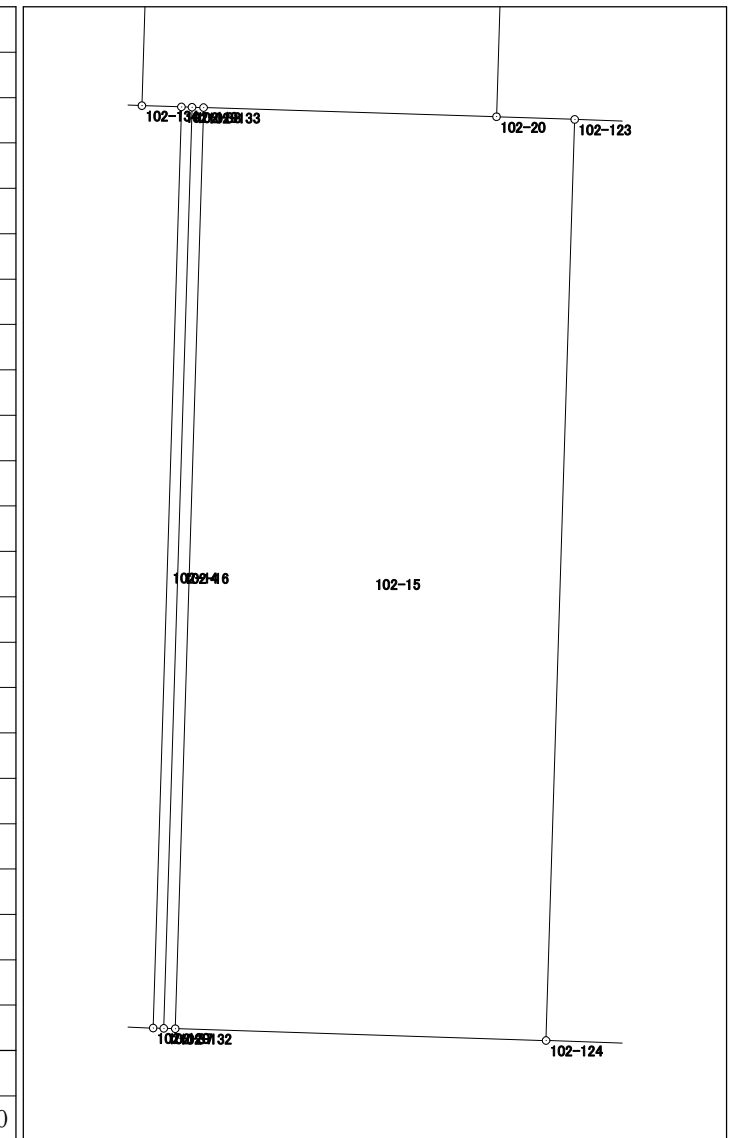


面積計算書（座標法）

世界測地系（測地成果2011）

所 在	地 番	公簿地目	現況地目	地 積	所 有 者
前橋市六供町四丁目	102-16			3.81 m ²	

点 名	X 座標	Y 座標	辺 長	方 向 角	測 角	DX	倍 積 (Y×DX)
102-37	41410.808	-67713.436	0.218	91-50-21	90-04-59	-17.458	1182141.165688
102-132	41410.801	-67713.218	17.459	1-45-33	89-55-12	17.444	-1181189.374792
102-133	41428.252	-67712.682	0.219	271-49-51	90-04-18	17.458	-1182128.002356
102-38	41428.259	-67712.901	17.459	181-45-22	89-55-31	-17.444	1181183.845044
						倍面積	7.633584
						面 積	3.8167920

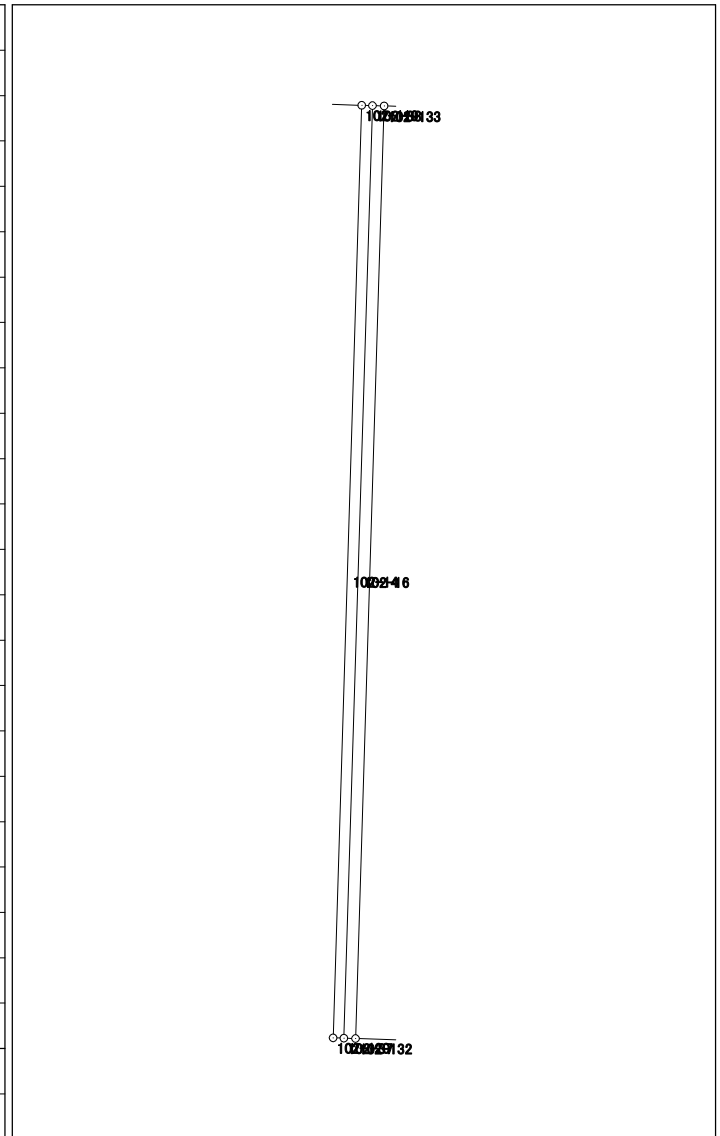


面積計算書（座標法）

世界測地系（測地成果2011）

所在	地番	公簿地目	現況地目	地積	所有者
前橋市六供町四丁目	102-保-1			27.00 m ²	

点名	X座標	Y座標	辺長	方向角	測角	DX	倍積 (Y×DX)
102-115	41428.862	-67732.062	1.546	271-44-33	89-57-05	17.508	-1185852.941496
102-117	41428.909	-67733.607	17.469	181-47-28	90-02-55	-17.413	1179445.298691
102-118	41411.449	-67734.153	1.546	91-46-46	89-59-18	-17.508	1185889.550724
102-116	41411.401	-67732.608	17.470	1-47-28	90-00-42	17.413	-1179427.903104

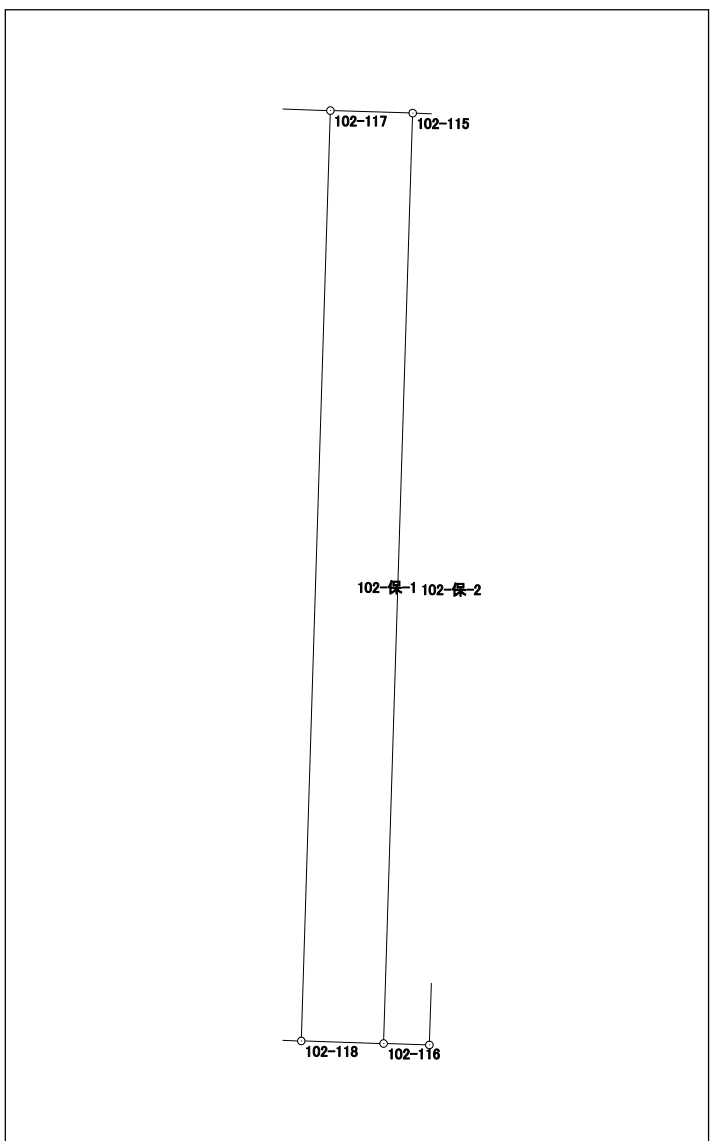


倍面積	54.004815
面積	27.0024075

面積計算書 (座標法)

世界測地系 (測地成果2011)

所在	地番	公簿地目	現況地目	地積	所有者
前橋市六供町四丁目	102-保-2			15.00 m ²	

点名	X座標	Y座標	辺長	方向角	測角	DX	倍積 (Y×DX)
102-114	41411.374	-67731.749	17.471	1-47-16	89-59-15	17.435	-1180903.043815
102-113	41428.836	-67731.204	0.858	271-44-09	89-56-53	17.488	-1184483.295552
102-115	41428.862	-67732.062	17.470	181-47-28	90-03-19	-17.435	1180908.500970
102-116	41411.401	-67732.608	0.859	91-48-01	90-00-33	-17.488	1184507.848704
						倍面積	30.010307
						面積	15.0051535

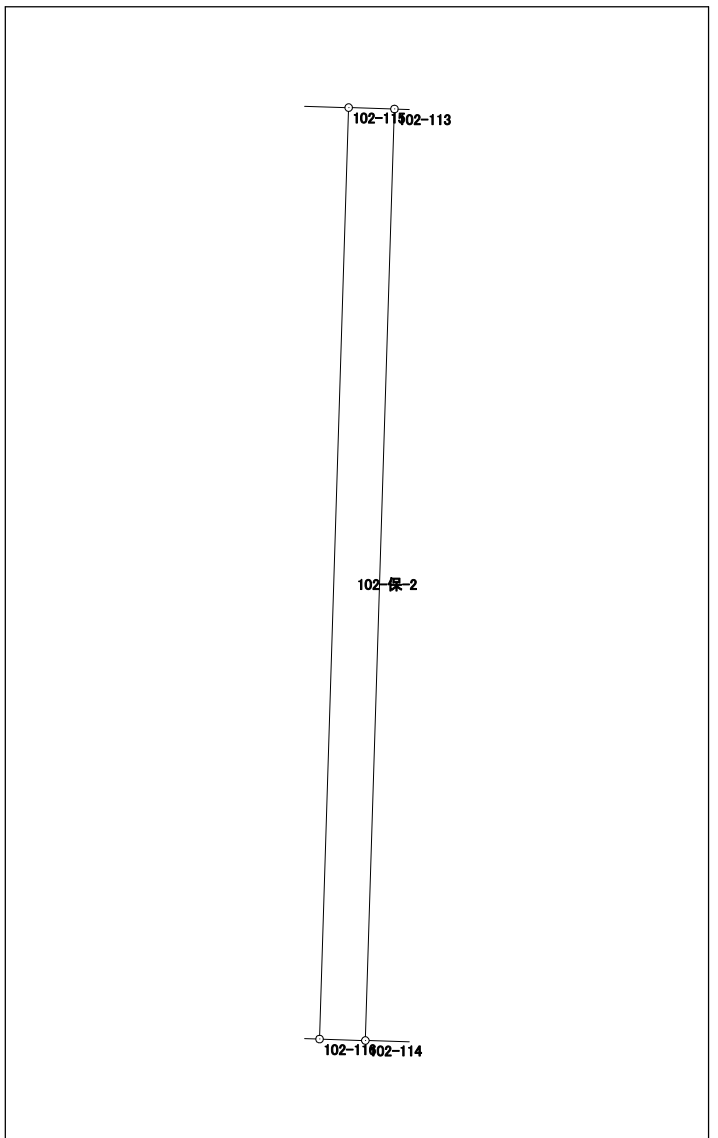


面積計算書（座標法）

世界測地系（測地成果2011）

所在	地番	公簿地目	現況地目	地積	所有者
前橋市六供町四丁目	102-保-3			26.00 m ²	

点名	X座標	Y座標	辺長	方向角	測角	DX	倍積 (Y×DX)
102-23	41412.006	-67752.134	17.453	1-51-18	90-05-08	17.398	-1178751.627332
102-136	41429.450	-67751.569	1.491	271-41-29	89-50-11	17.488	-1184839.438672
102-137	41429.494	-67753.059	17.451	181-51-07	90-09-38	-17.398	1178767.720482
102-138	41412.052	-67753.623	1.490	91-46-10	89-55-03	-17.488	1184875.359024

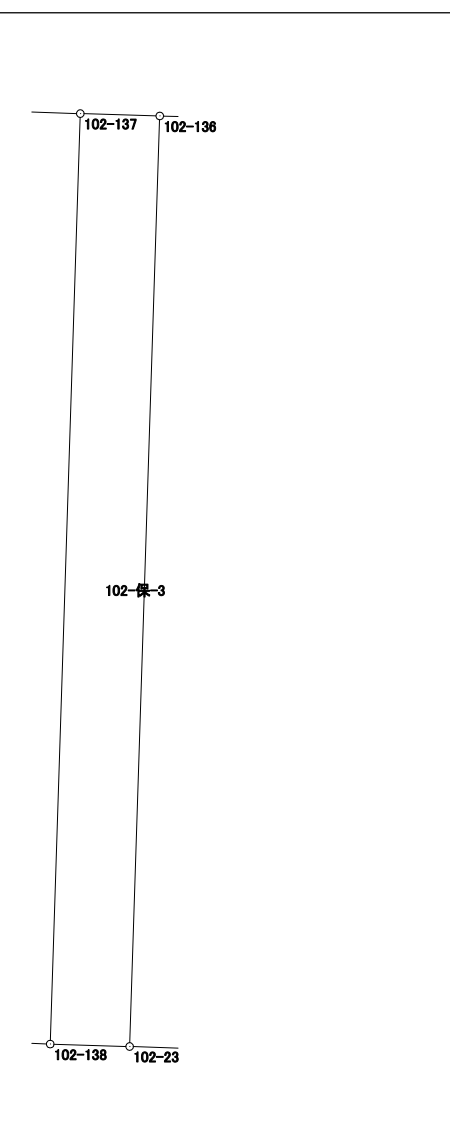


倍面積	52.013502
面積	26.0067510

面積計算書（座標法）

世界測地系（測地成果2011）

所 在	地 番	公簿地目	現況地目	地 積	所 有 者
前橋市六供町四丁目	102-保-4			32.00 m ²	

点 名	X 座標	Y 座標	辺 長	方 向 角	測 角	DX	倍 積 (Y×DX)
102-22	41411.683	-67741.729	17.468	1-47-40	90-00-41	17.402	-1178841.568058
102-25	41429.142	-67741.182	1.833	271-41-18	89-53-38	17.513	-1186351.320366
102-105	41429.196	-67743.014	17.465	181-47-30	90-06-12	-17.402	1178863.929628
102-106	41411.740	-67743.560	1.832	91-46-59	89-59-29	-17.513	1186392.966280

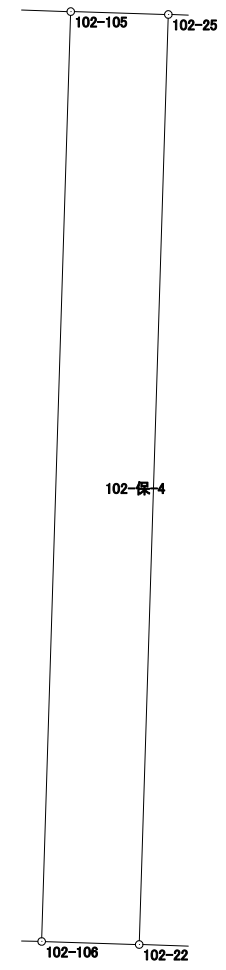


倍面積	64.007484
面 積	32.0037420

面積計算書 (座標法)

世界測地系 (測地成果2011)

所在	地番	公簿地目	現況地目	地積	所有者
前橋市六供町四丁目	102-保-5			6.00 m ²	

点名	X座標	Y座標	辺長	方向角	測角	DX	倍積 (Y×DX)
102-27	41411.279	-67728.711	17.472	1-47-27	89-57-14	17.452	-1182001.464372
102-28	41428.742	-67728.165	0.344	271-49-53	90-02-26	17.474	-1183481.955210
102-111	41428.753	-67728.509	17.472	181-47-15	89-57-22	-17.452	1181997.939068
102-112	41411.290	-67729.054	0.343	91-50-13	90-02-58	-17.474	1183497.489596

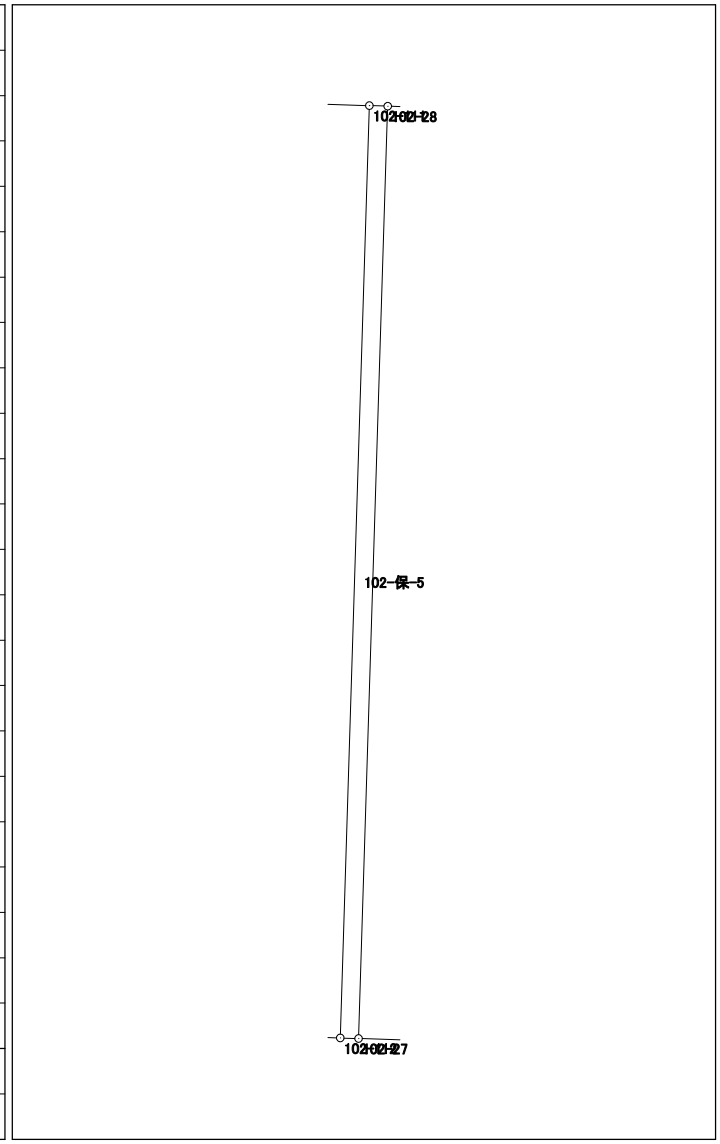


倍面積	12.009082
面積	6.0045410

面積計算書（座標法）

所在	地番	公簿地目	現況地目	地積	所有者
前橋市六供町四丁目	102-保-6			13.00 m ²	

点名	X座標	Y座標	辺長	方向角	測角	DX	倍積 (Y×DX)
102-29	41427.942	-67703.187	17.452	181-46-59	90-05-30	-17.422	1179524.923914
102-30	41410.498	-67703.730	0.744	91-50-51	90-03-52	-17.468	1182648.755640
102-125	41410.474	-67702.986	17.454	1-47-10	89-56-19	17.422	-1179521.422092
102-126	41427.920	-67702.442	0.745	271-41-29	89-54-19	17.468	-1182626.256856

倍面積	26.000606
面積	13.0003030

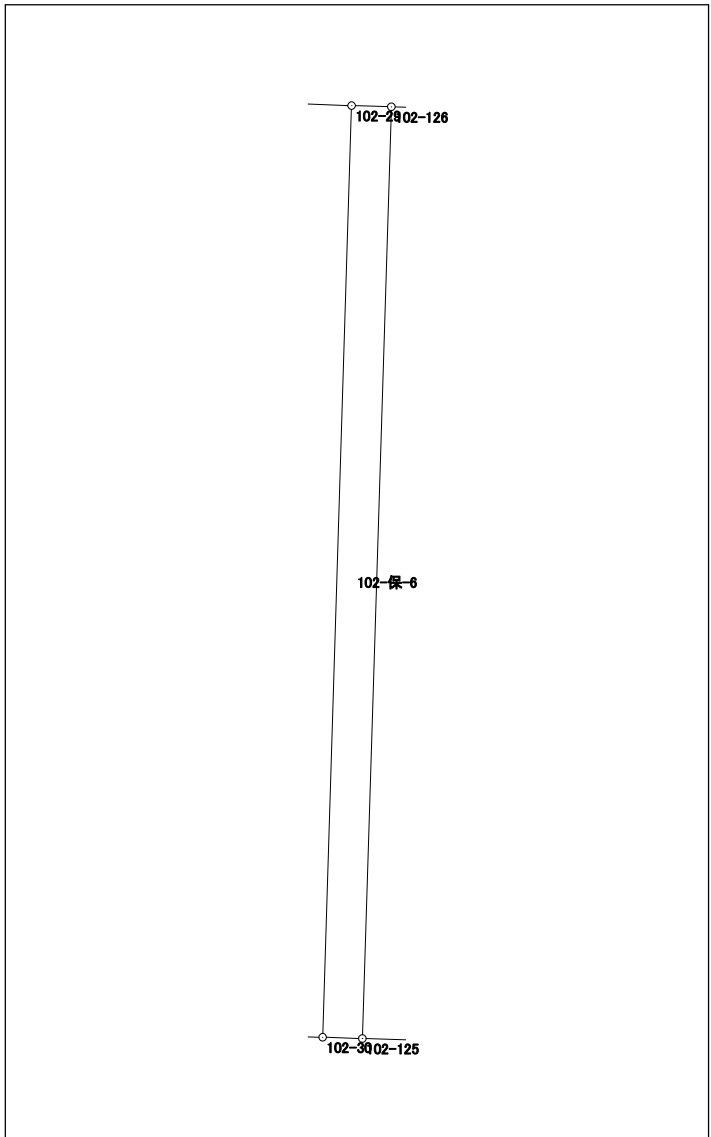


面積計算書（座標法）

世界測地系（測地成果2011）

所在	地番	公簿地目	現況地目	地積	所有者
前橋市六供町四丁目	102-保-7			47.00 m ²	

点名	X座標	Y座標	辺長	方向角	測角	DX	倍積 (Y×DX)
102-127	41410.409	-67700.925	8.000	91-48-18	90-01-12	-6.124	414600.464700
120-129	41410.157	-67692.929	5.874	1-48-17	89-59-59	5.619	-380366.568051
102-130	41416.028	-67692.744	8.002	271-48-43	90-00-26	6.124	-414550.364256
102-131	41416.281	-67700.742	5.875	181-47-06	89-58-23	-5.619	380410.469298

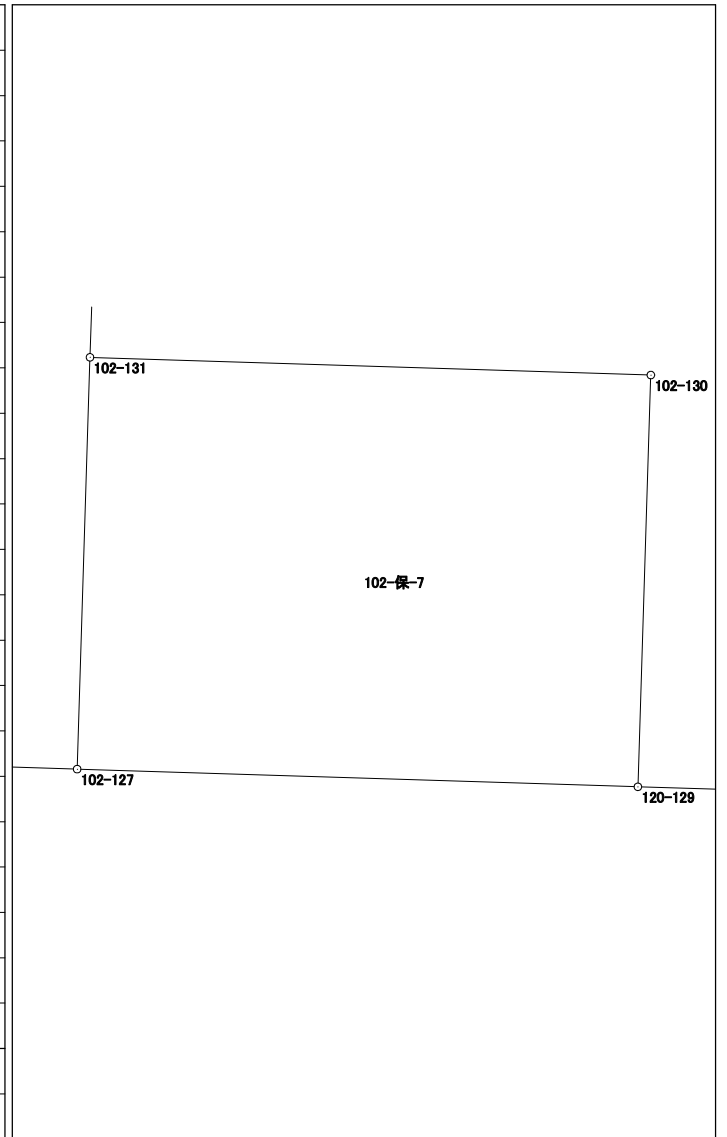


倍面積	94.001691
面積	47.0008455

面積計算書 (座標法)

世界測地系 (測地成果2011)

所在	地番	公簿地目	現況地目	地積	所有者
前橋市六供町四丁目	102-保-8			43.00 m ²	

点名	X座標	Y座標	辺長	方向角	測角	DX	倍積 (Y×DX)
102-30	41410.498	-67703.730	17.452	1-46-59	89-56-43	17.365	-1175675.271450
102-29	41427.942	-67703.187	2.464	272-00-02	90-13-03	17.530	-1186836.868110
102-123	41428.028	-67705.649	17.459	181-46-56	89-46-54	-17.365	1175708.594885
102-124	41410.577	-67706.192	2.463	91-50-16	90-03-20	-17.530	1186889.545760
						倍面積	86.001085
						面積	43.0005425

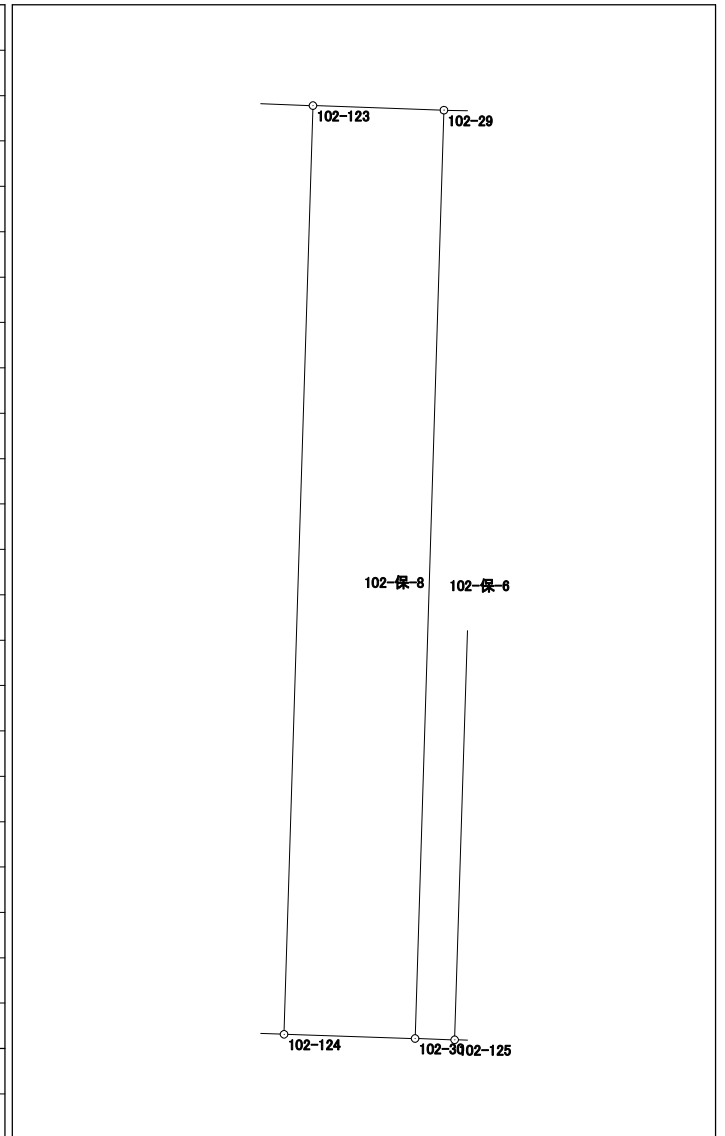

面積計算書 (座標法)

世界測地系 (測地成果2011)

所在	地番	公簿地目	現況地目	地積	所有者
前橋市六供町四丁目	102-保-10			51.00 m ²	

点名	X座標	Y座標	辺長	方向角	測角	DX	倍積 (Y×DX)
102-120	41410.814	-67713.637	17.459	1-45-22	89-59-27	17.361	-1175576.451957
102-119	41428.265	-67713.102	0.749	271-50-07	90-04-45	17.475	-1183286.457450
102-134	41428.289	-67713.851	2.172	271-47-39	179-57-32	0.092	-6229.674292
102-121	41428.357	-67716.022	17.461	181-45-21	89-57-42	-17.385	1177243.042470
102-122	41410.904	-67716.557	2.921	91-45-55	90-00-34	-17.543	1187951.559451
						倍面積	102.018222
						面積	51.0091110

