



105街区 画地出来形確認図 (3805.43m²)

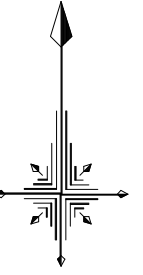

S=1/500

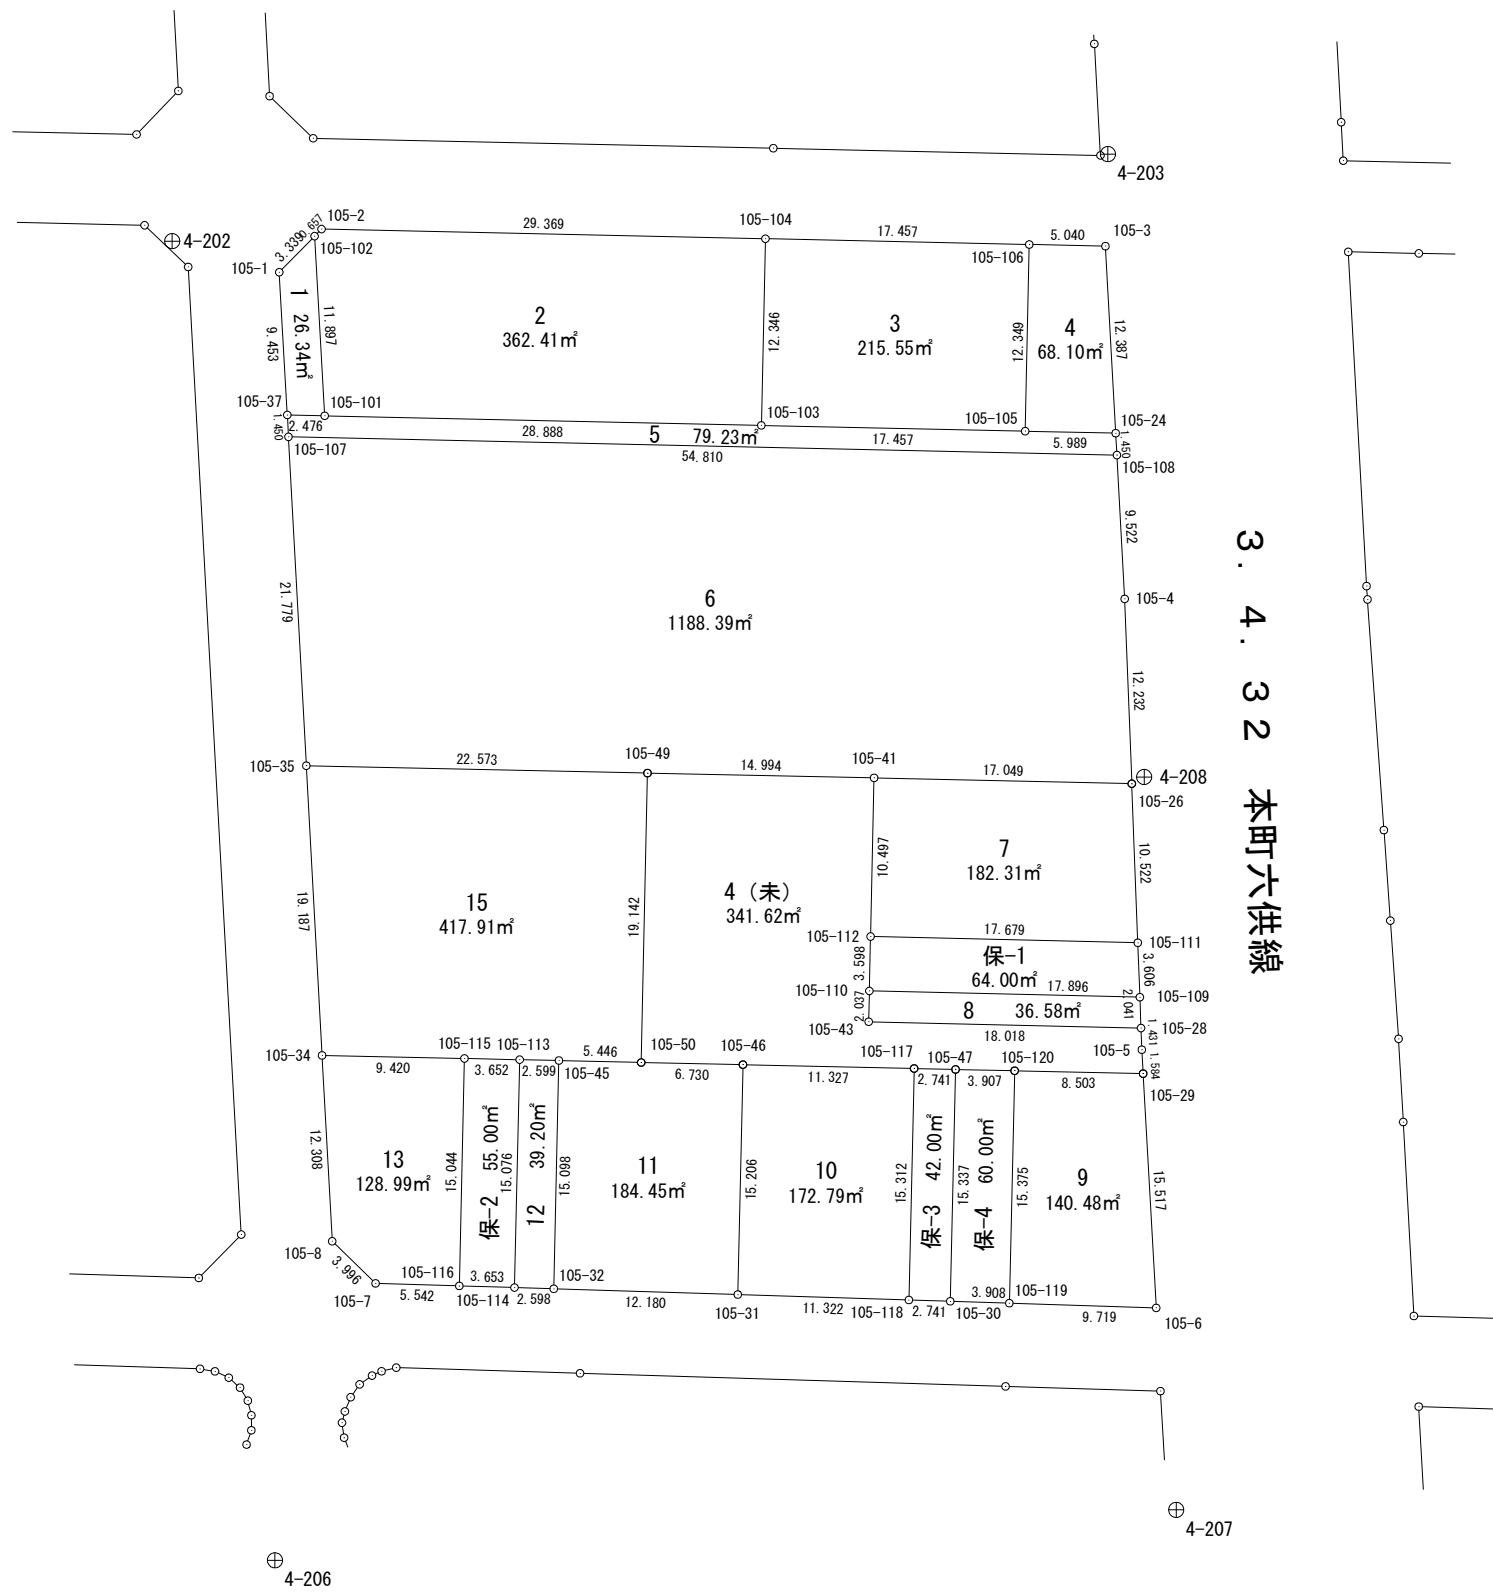


面積計算書（座標法）

世界測地系（測地成果2011）

所 在	地 番	公簿地目	現況地目	地 積	所 有 者
前橋市六供町二丁目	105-1			26.34 m ²	

点 名	X 座標	Y 座標	辺 長	方 向 角	測 角	DX	倍 積 (Y×DX)
105-1	41329.781	-67917.024	9.453	176-46-47	132-21-44	-11.823	802982.974752
105-37	41320.343	-67916.493	2.476	91-16-23	94-29-36	-9.493	644731.268049
105-101	41320.288	-67914.018	11.897	356-46-35	85-30-12	11.823	-802947.434814
105-102	41332.166	-67914.687	3.339	224-25-03	47-38-28	9.493	-644714.123691
						倍面積	52.684296
						面 積	26.3421480

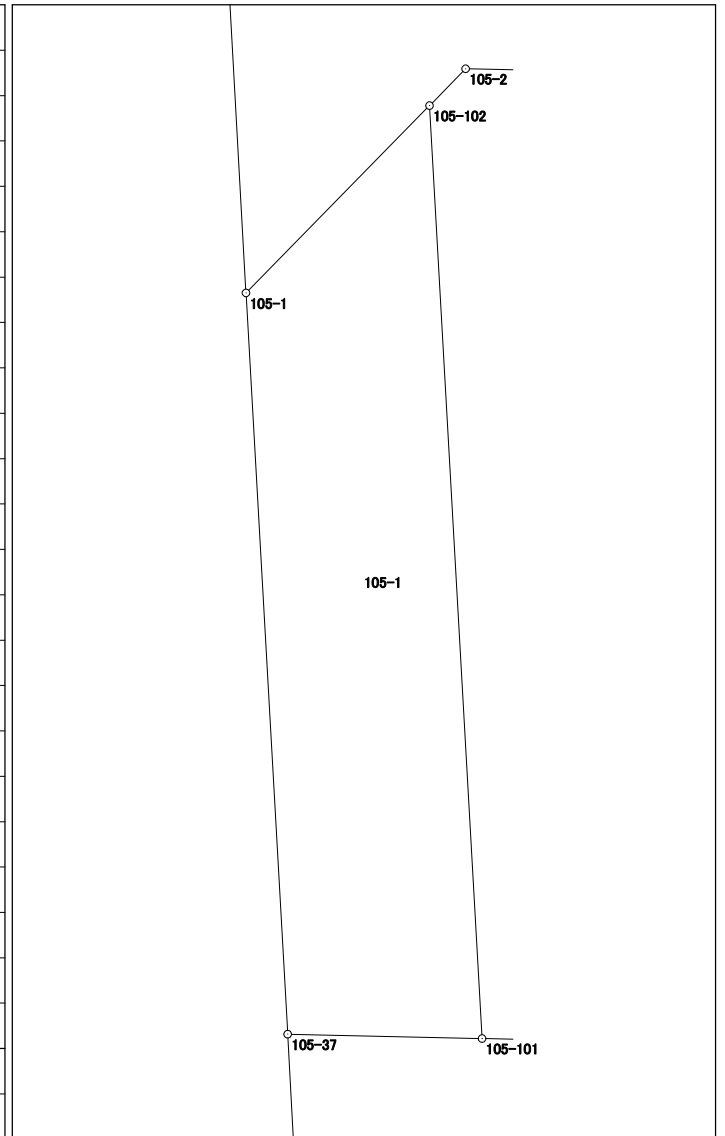


面積計算書 (座標法)

世界測地系 (測地成果2011)

所在	地番	公簿地目	現況地目	地積	所有者
前橋市六供町二丁目	105-2			362.41 m ²	

点名	X座標	Y座標	辺長	方向角	測角	DX	倍積 (Y×DX)
105-102	41332.166	-67914.687	11.897	176-46-35	132-19-53	-12.347	838542.640389
105-101	41320.288	-67914.018	28.888	91-15-42	94-29-07	-12.514	849876.021252
105-103	41319.652	-67885.137	12.346	1-15-45	90-00-03	11.707	-794731.298859
105-104	41331.995	-67884.865	29.369	271-14-55	89-59-10	12.983	-881349.202295
105-2	41332.635	-67914.227	0.657	224-26-42	133-11-47	0.171	-11613.332817
						倍面積	724.827670
						面積	362.4138350

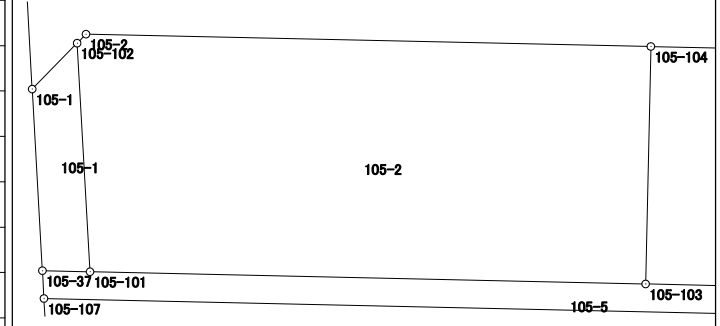


面積計算書（座標法）

世界測地系（測地成果2011）

所 在	地 番	公簿地目	現況地目	地 積	所 有 者
前橋市六供町二丁目	105-4			68.10 m ²	

点 名	X 座標	Y 座標	辺 長	方 向 角	測 角	DX	倍 積 (Y×DX)
105-105	41319.268	-67867.684	5.989	91-15-46	90-00-02	-12.478	846852.960952
105-24	41319.136	-67861.696	12.387	356-52-01	85-36-15	12.236	-830355.712256
105-3	41331.504	-67862.373	5.040	271-15-02	94-23-01	12.478	-846786.690294
105-106	41331.614	-67867.412	12.349	181-15-44	90-00-42	-12.236	830425.653232
						倍面積	136.211634
						面 積	68.1058170

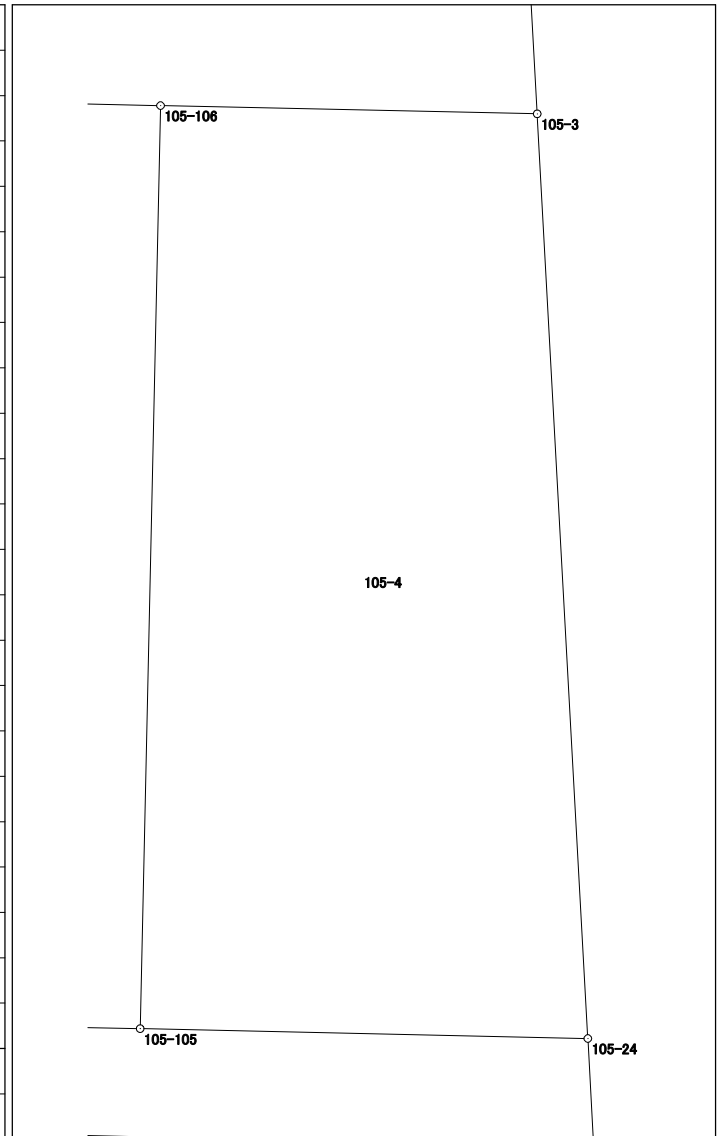


面積計算書 (座標法)

世界測地系 (測地成果2011)

所在	地番	公簿地目	現況地目	地積	所有者
前橋市六供町二丁目	105-6			1188.39 m ²	

点名	X座標	Y座標	辺長	方向角	測角	DX	倍積 (Y×DX)
105-107	41318.895	-67916.414	21.779	176-53-48	85-38-05	-20.540	1395003.143560
105-35	41297.148	-67915.235	22.573	91-14-19	94-20-31	-22.235	1510095.250225
105-49	41296.660	-67892.667	14.994	91-12-00	179-57-41	-0.802	54449.918934
105-41	41296.346	-67877.676	17.049	91-18-27	180-06-27	-0.703	47718.006228
105-26	41295.957	-67860.631	12.232	357-47-53	86-29-26	11.834	-803062.707254
105-4	41308.180	-67861.101	9.522	356-53-37	179-05-44	21.731	-1474689.585831
105-108	41317.688	-67861.617	54.810	271-15-43	94-22-06	10.715	-727137.226155


倍面積	2376.799707
面積	1188.3998535

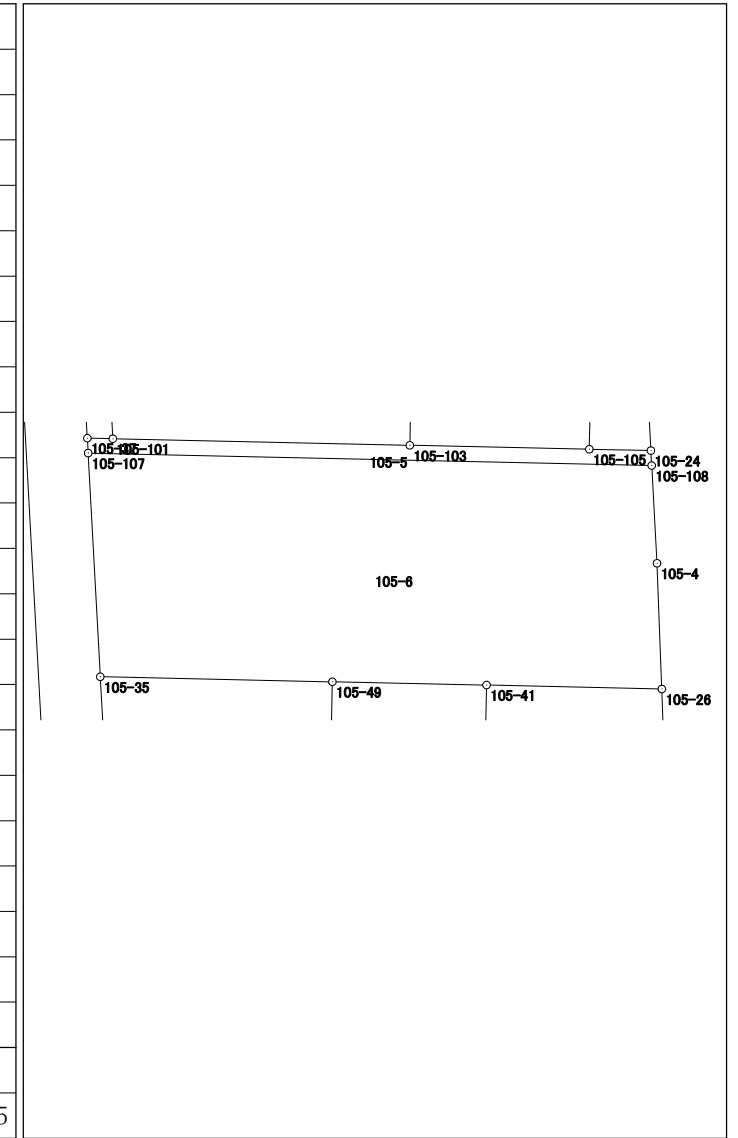

面積計算書（座標法）

世界測地系（測地成果2011）

所在	地番	公簿地目	現況地目	地積	所有者
前橋市六供町二丁目	105-7			182.31 m ²	

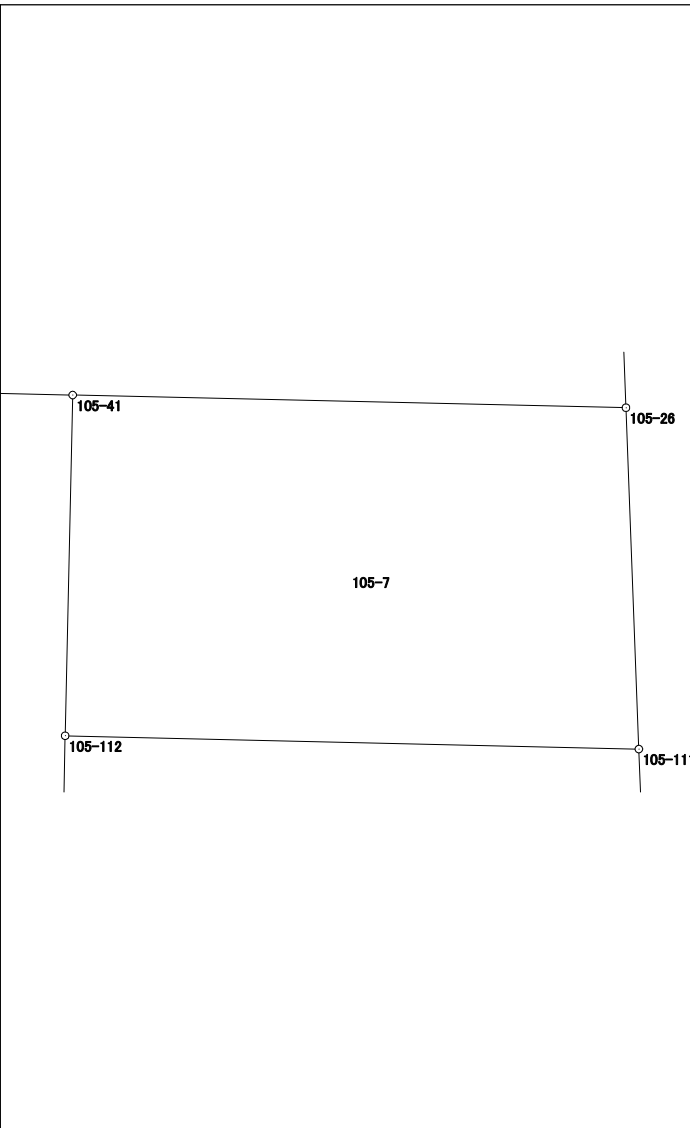
点名	X座標	Y座標	辺長	方向角	測角	DX	倍積 (Y×DX)	
105-111	41285.442	-67860.234	10.522	357-50-16	86-30-32	10.105	-685727.664570	
105-26	41295.957	-67860.631	17.049	271-18-27	93-28-11	10.904	-739952.320424	
105-41	41296.346	-67877.676	10.497	181-15-59	89-57-32	-10.105	685903.915980	
105-112	41285.852	-67877.908	17.679	91-19-44	90-03-45	-10.904	740140.708832	
倍面積							364.639818	
面積							182.319090	

面積計算書（座標法）

世界測地系（測地成果2011）

所在	地番	公簿地目	現況地目	地積	所有者
前橋市六供町二丁目	105-8			36.58 m ²	

点名	X座標	Y座標	辺長	方向角	測角	DX	倍積 (Y×DX)
105-43	41280.218	-67878.034	18.018	91-19-57	90-04-01	-2.456	166708.451504
105-28	41279.799	-67860.021	2.041	357-50-18	86-30-21	1.621	-110001.094041
105-109	41281.839	-67860.098	17.896	271-19-55	93-29-37	2.456	-166664.400688
105-110	41282.255	-67877.989	2.037	181-15-56	89-56-01	-1.621	110030.220169
						倍面積	73.176944
						面積	36.5884720

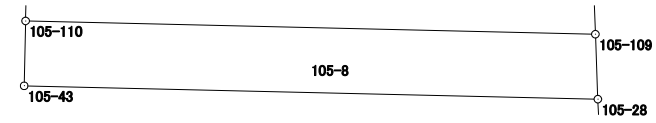


面積計算書（座標法）

世界測地系（測地成果2011）

所在	地番	公簿地目	現況地目	地積	所有者
前橋市六供町二丁目	105-9			140.48 m ²	

点名	X座標	Y座標	辺長	方向角	測角	DX	倍積(Y×DX)
105-119	41261.606	-67868.732	9.719	91-50-23	90-32-07	-15.683	1064385.323956
105-6	41261.294	-67859.018	15.517	356-48-42	84-58-19	15.181	-1030167.752258
105-29	41276.787	-67859.881	8.503	271-16-49	94-28-07	15.683	-1064246.513723
105-120	41276.977	-67868.382	15.375	181-18-16	90-01-27	-15.181	1030309.907142
						倍面積	280.965117
						面積	140.4825585

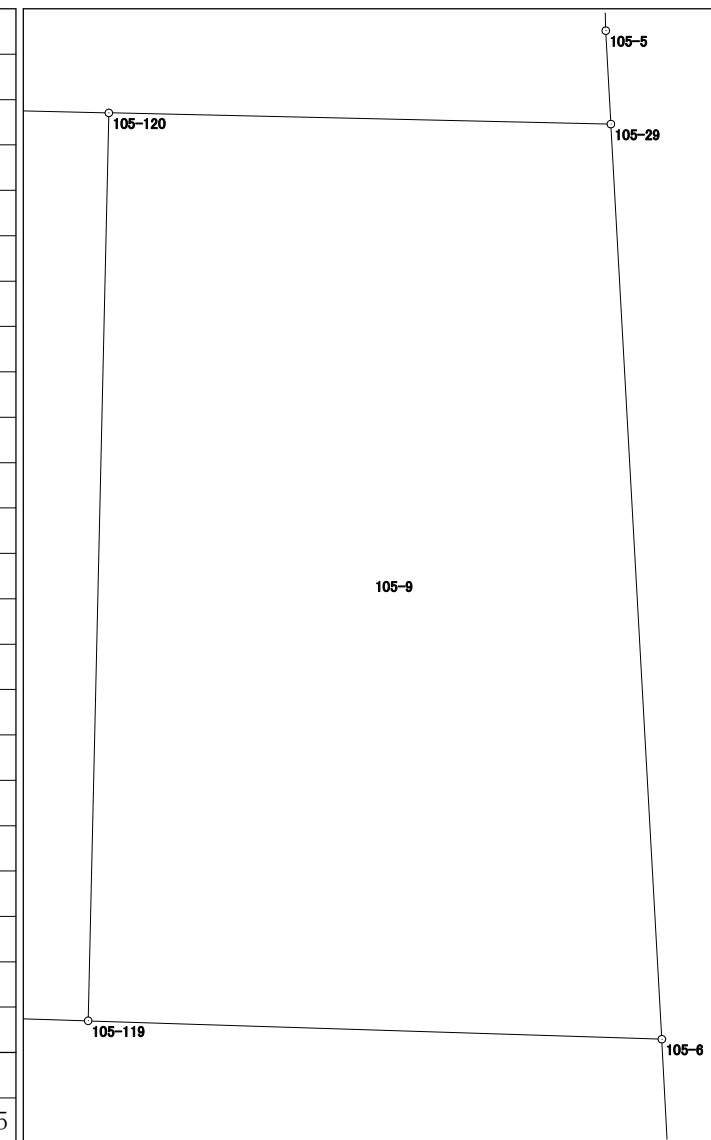


面積計算書（座標法）

世界測地系（測地成果2011）

所 在	地 番	公簿地目	現況地目	地 積	所 有 者
前橋市六供町二丁目	105-10			172.79 m ²	

点 名	X 座標	Y 座標	辺 長	方 向 角	測 角	DX	倍 積 (Y×DX)
105-117	41277.126	-67875.028	11.327	271-17-24	89-58-49	15.563	-1056339.060764
105-46	41277.381	-67886.352	15.206	181-17-20	89-59-56	-14.947	1014697.303344
105-31	41262.179	-67886.694	11.322	91-49-38	90-32-18	-15.563	1056520.618722
105-118	41261.818	-67875.378	15.312	1-18-35	89-28-57	14.947	-1014533.274966
						倍面積	345.586336
						面 積	172.7931680

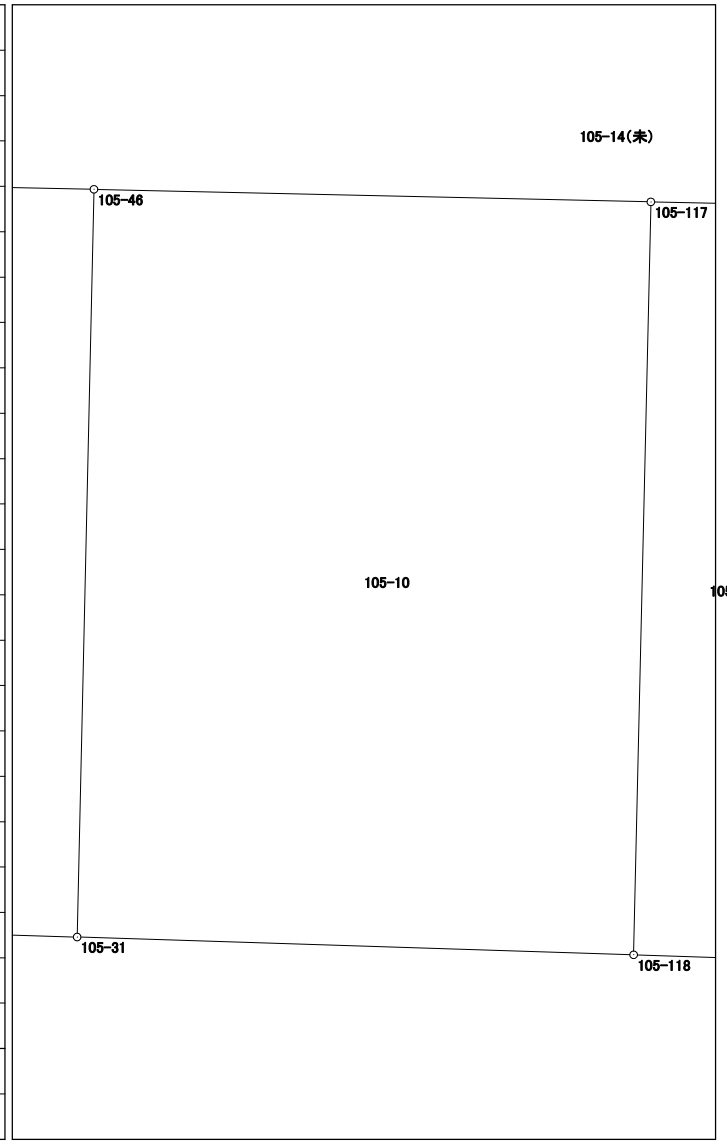


面積計算書（座標法）

世界測地系（測地成果2011）

所 在	地 番	公簿地目	現況地目	地 積	所 有 者
前橋市六供町二丁目	105-12			39.20 m ²	

点 名	X 座 標	Y 座 標	辺 長	方 向 角	測 角	DX	倍 積 (Y×DX)
105-45	41277.654	-67898.525	2.599	271-14-05	89-55-59	15.150	-1028662.653750
105-113	41277.710	-67901.123	15.076	181-18-00	90-03-55	-15.016	1019603.262968
105-114	41262.638	-67901.465	2.598	91-43-13	90-25-13	-15.150	1028707.194750
105-32	41262.560	-67898.868	15.098	1-18-06	89-34-53	15.016	-1019569.401888

倍面積	78.402080
面 積	39.2010400

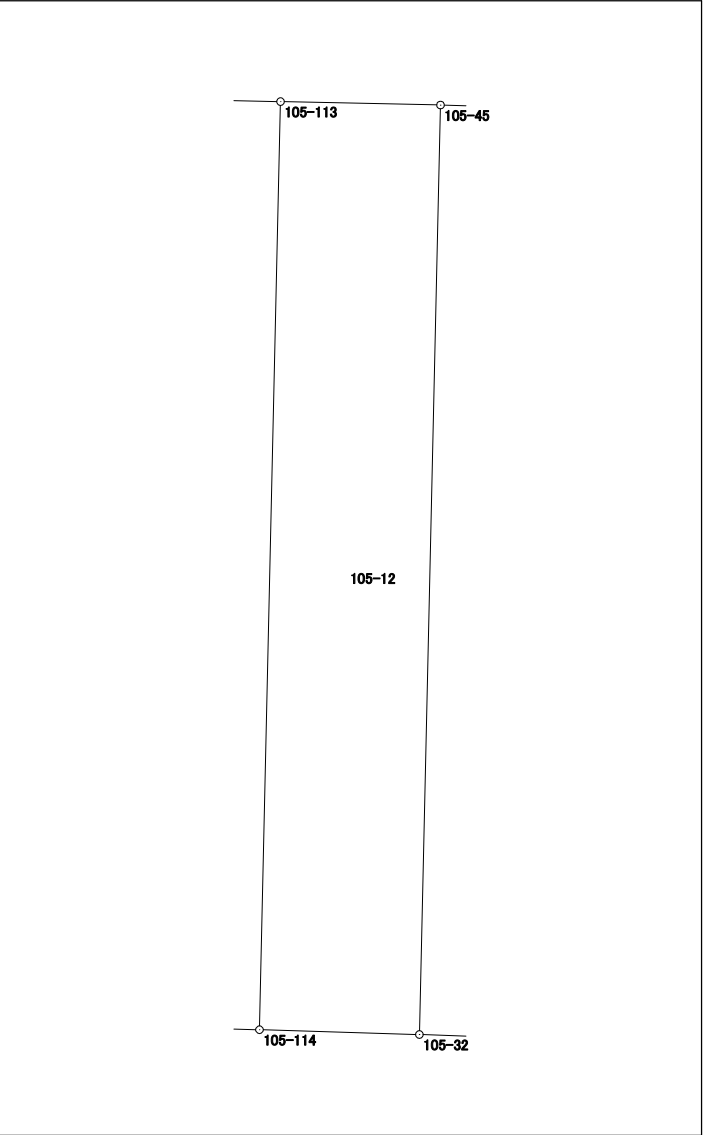


面積計算書 (座標法)

世界測地系 (測地成果2011)

所在	地番	公簿地目	現況地目	地積	所有者
前橋市六供町二丁目	105-14 (未)			341.62 m ²	

点名	X座標	Y座標	辺長	方向角	測角	DX	倍積 (Y×DX)
105-49	41296.660	-67892.667	19.142	181-14-21	90-02-21	-18.824	1278011.563608
105-50	41277.522	-67893.081	6.730	91-12-01	89-57-40	-19.279	1308910.708599
105-46	41277.381	-67886.352	11.327	91-17-24	180-05-23	-0.396	26882.995392
105-117	41277.126	-67875.028	2.741	91-17-47	180-00-23	-0.317	21516.383876
105-47	41277.064	-67872.288	3.907	91-16-33	179-58-46	-0.149	10112.970912
105-120	41276.977	-67868.382	8.503	91-16-49	180-00-16	-0.277	18799.541814
105-29	41276.787	-67859.881	1.584	356-53-18	85-36-29	1.392	-94460.954352
105-5	41278.369	-67859.967	1.431	357-50-15	180-56-57	3.012	-204394.220604
105-28	41279.799	-67860.021	18.018	271-19-57	93-29-42	1.849	-125473.178829
105-43	41280.218	-67878.034	2.037	1-15-56	269-55-59	2.456	-166708.451504
105-110	41282.255	-67877.989	3.598	1-17-24	180-01-28	5.634	-382424.590026
105-112	41285.852	-67877.908	10.497	1-15-59	179-58-35	14.091	-956467.601628
105-41	41296.346	-67877.676	14.994	271-12-00	89-56-01	10.808	-733621.922208

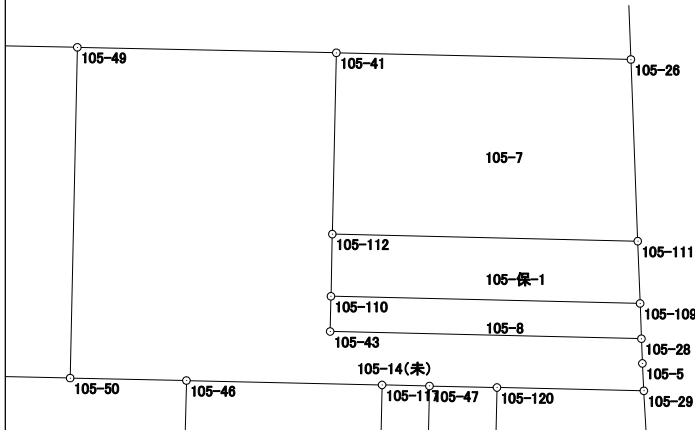


倍面積	683.245050
面積	341.6225250

面積計算書（座標法）

世界測地系（測地成果2011）

所在	地番	公簿地目	現況地目	地積	所有者
前橋市六供町二丁目	105-15			417.91 m ²	

点名	X座標	Y座標	辺長	方向角	測角	DX	倍積 (Y×DX)
105-35	41297.148	-67915.235	19.187	176-53-02	85-38-43	-18.671	1268045.352685
105-34	41277.989	-67914.192	9.420	91-13-21	94-20-19	-19.360	1314818.757120
105-115	41277.788	-67904.774	3.652	91-13-26	180-00-05	-0.279	18945.431946
105-113	41277.710	-67901.123	2.599	91-14-05	180-00-39	-0.134	9098.750482
105-45	41277.654	-67898.525	5.446	91-23-20	180-09-15	-0.188	12764.922700
105-50	41277.522	-67893.081	19.142	1-14-21	89-51-01	19.006	-1290375.897486
105-49	41296.660	-67892.667	22.573	271-14-19	89-59-58	19.626	-1332461.482542
						倍面積	835.834905
						面積	417.9174525

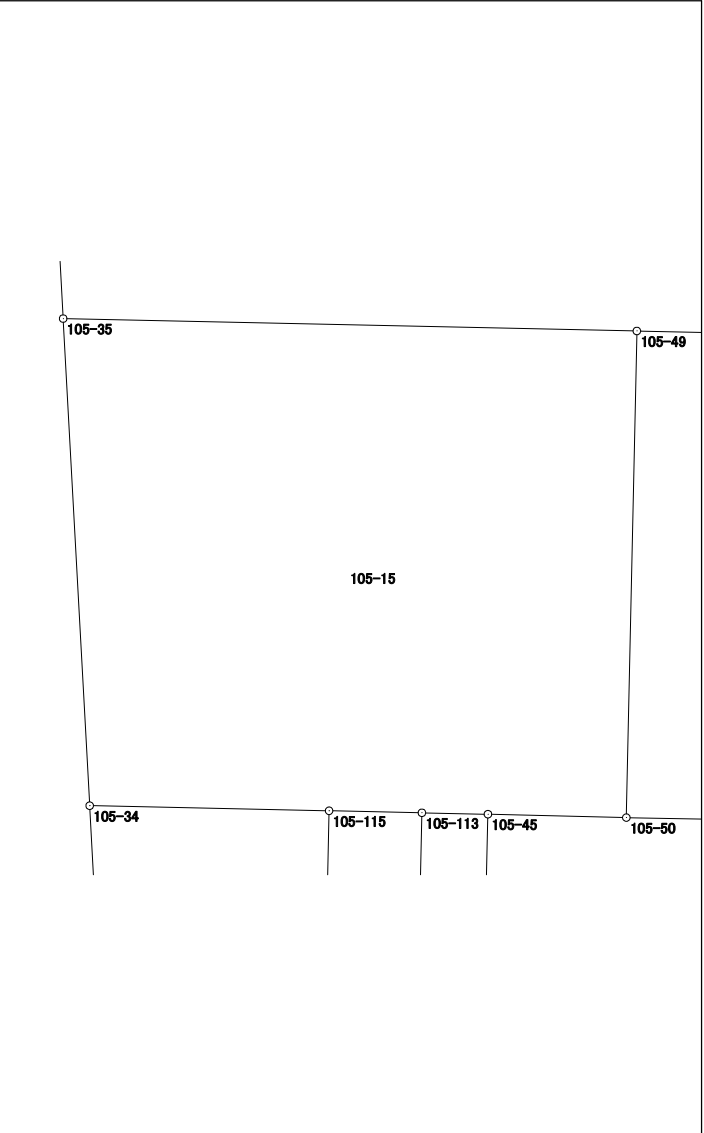


面積計算書 (座標法)

世界測地系 (測地成果2011)

所在	地番	公簿地目	現況地目	地積	所有者
前橋市六供町二丁目	105-保-1			64.00 m ²	

点名	X座標	Y座標	辺長	方向角	測角	DX	倍積 (Y×DX)
105-110	41282.255	-67877.989	17.896	91-19-55	90-02-31	-4.013	272394.369857
105-109	41281.839	-67860.098	3.606	357-50-18	86-30-23	3.187	-216270.132326
105-111	41285.442	-67860.234	17.679	271-19-44	93-29-26	4.013	-272323.119042
105-112	41285.852	-67877.908	3.598	181-17-24	89-57-40	-3.187	216326.892796
						倍面積	128.011285
						面積	64.0056425

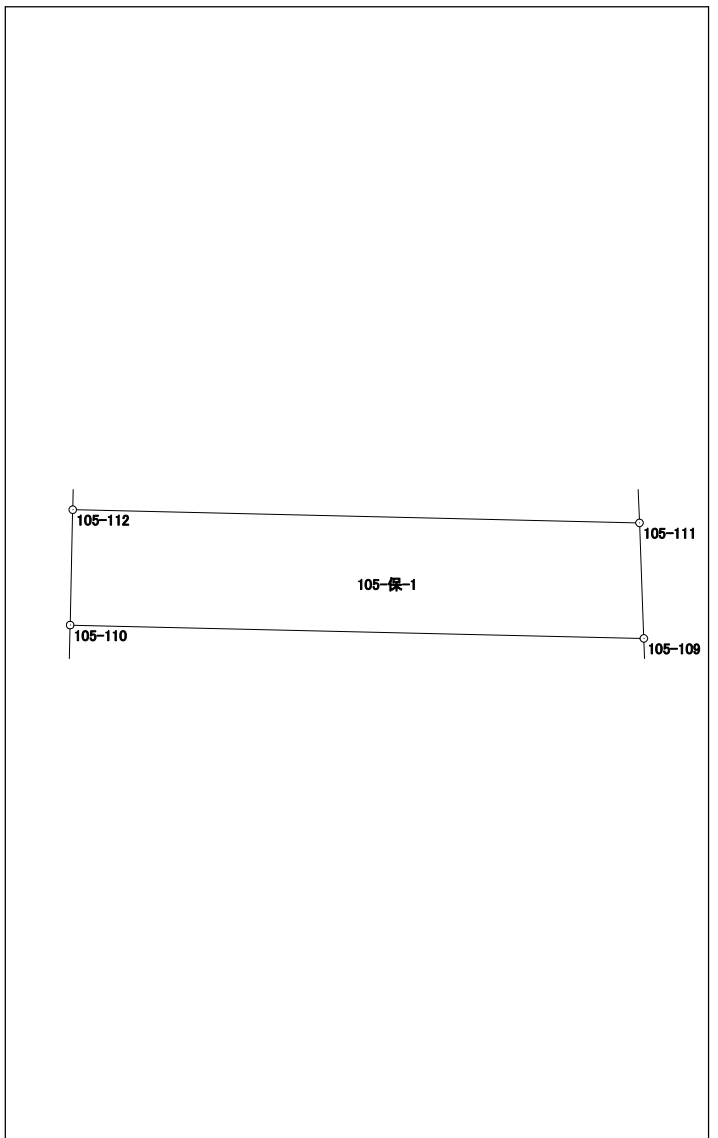


面積計算書（座標法）

世界測地系（測地成果2011）

所 在	地 番	公簿地目	現況地目	地 積	所 有 者
前橋市六供町二丁目	105-保-3			42.00 m ²	

点 名	X 座標	Y 座標	辺 長	方 向 角	測 角	DX	倍 積 (Y×DX)
105-30	41261.731	-67872.638	15.337	1-18-28	89-29-21	15.246	-1034786.238948
105-47	41277.064	-67872.288	2.741	271-17-47	89-59-19	15.395	-1044893.873760
105-117	41277.126	-67875.028	15.312	181-18-35	90-00-48	-15.246	1034822.676888
105-118	41261.818	-67875.378	2.741	91-49-07	90-30-32	-15.395	1044941.444310

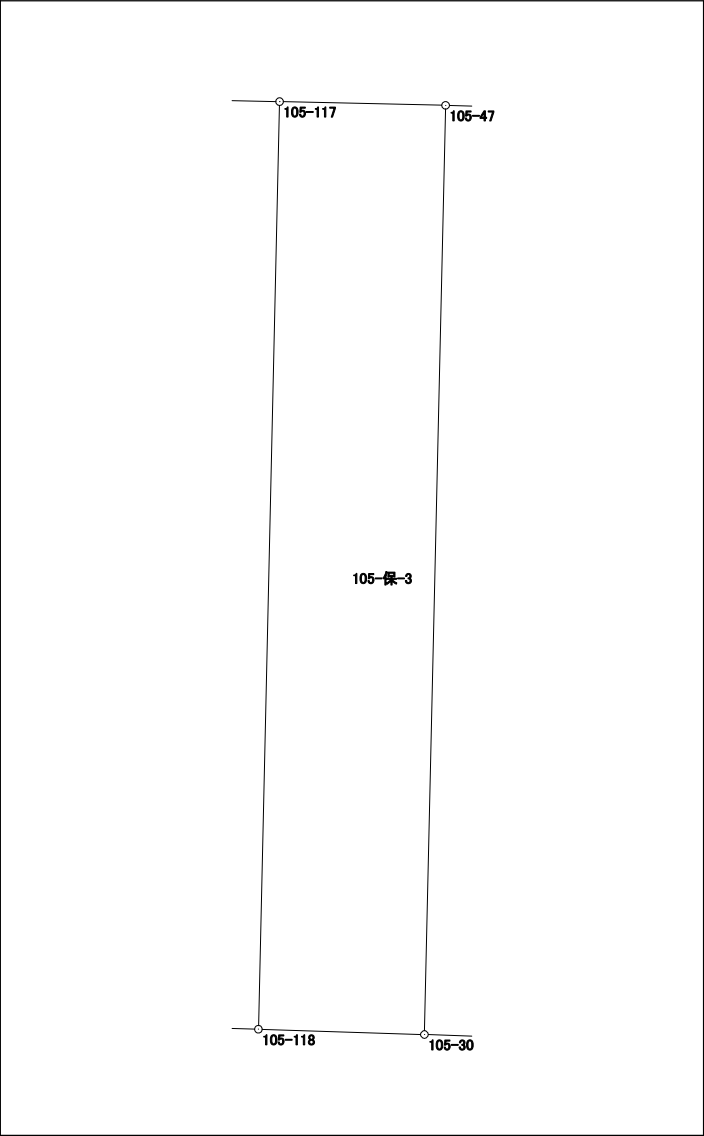

倍面積	84.008490
面 積	42.0042450

面積計算書（座標法）

世界測地系（測地成果2011）

所 在	地 番	公簿地目	現況地目	地 積	所 有 者
前橋市六供町二丁目	105-保-4			60.00 m ²	

点 名	X 座標	Y 座標	辺 長	方 向 角	測 角	DX	倍 積 (Y×DX)
105-47	41277.064	-67872.288	15.337	181-18-28	90-01-55	-15.246	1034780.902848
105-30	41261.731	-67872.638	3.908	91-49-59	90-31-31	-15.458	1049175.238204
105-119	41261.606	-67868.732	15.375	1-18-16	89-28-17	15.246	-1034726.688072
105-120	41276.977	-67868.382	3.907	271-16-33	89-58-17	15.458	-1049109.448956
						倍面積	120.004024
						面 積	60.0020120

