



# 108街区 画地出来形確認図 (5968.54m<sup>2</sup>)

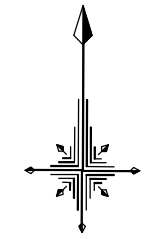

S=1/500

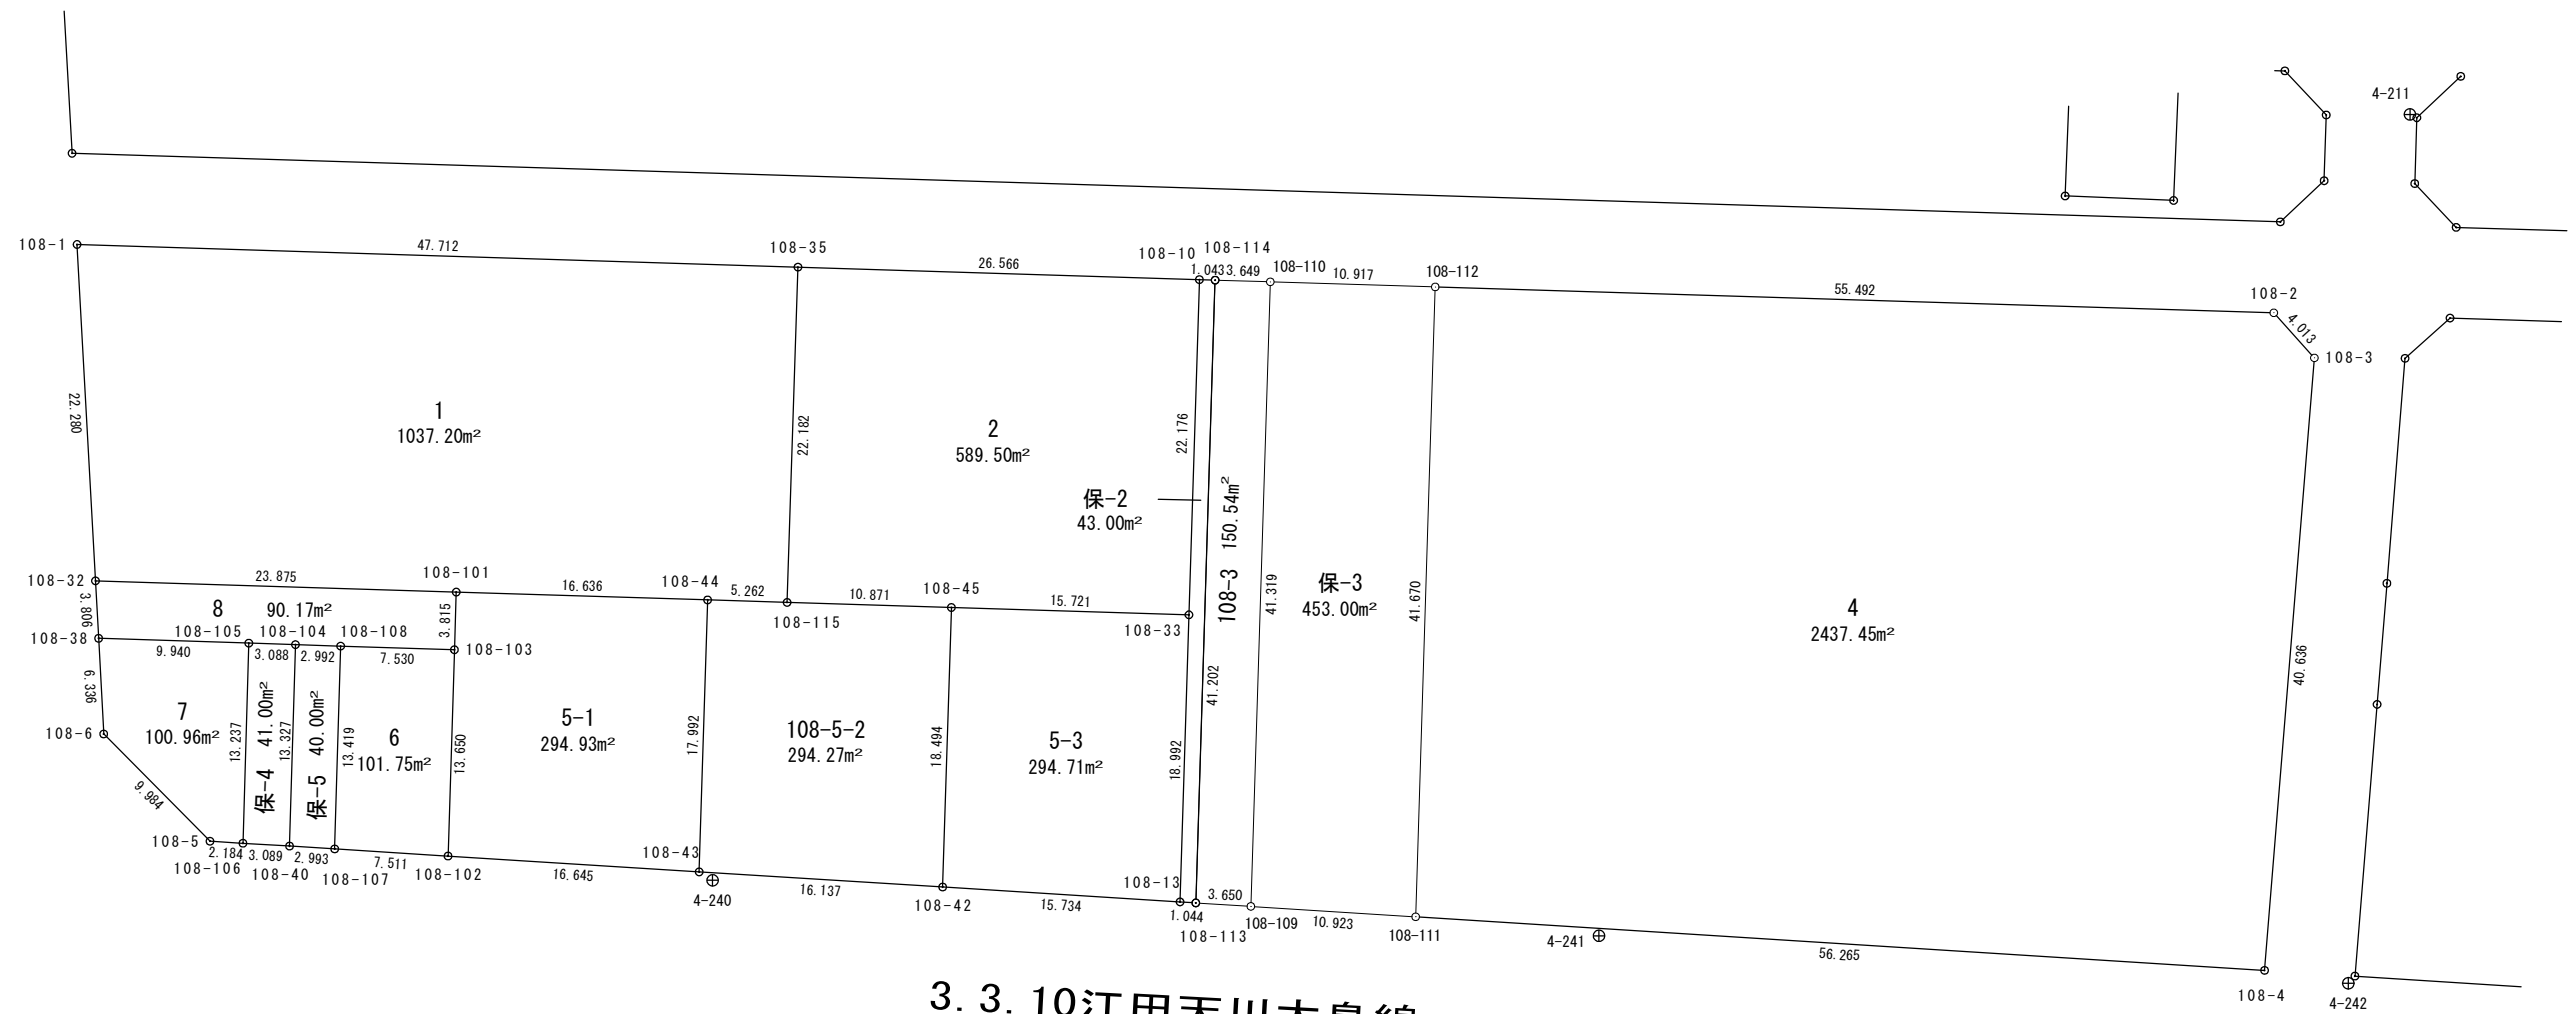

3. 3. 10江田天川大島線

⊕ 3-18

⊕ 4-242

⊕ 4-241

⊕ 4-240



# 面積計算書 (座標法)

世界測地系 (測地成果2011)

所在	地番	公簿地目	現況地目	地積	所有者
前橋市六供町四丁目	108-2			589.50 m <sup>2</sup>	


点名	X座標	Y座標	辺長	方向角	測角	DX	倍積 (Y×DX)		
108-35	41237.215	-67793.080	22.182	181-51-18	90-04-16	-21.343	1446907.706440		
108-115	41215.045	-67793.798	10.871	91-46-35	89-55-17	-22.507	1525835.011586		
108-45	41214.708	-67782.932	15.721	91-46-04	179-59-29	-0.822	55717.570104		
108-33	41214.223	-67767.218	22.176	1-47-08	90-01-04	21.680	-1469193.286240		
108-10	41236.388	-67766.527	26.566	271-47-02	89-59-54	22.992	-1558087.988784		
倍面積							1179.013106		
面積							589.5065530		

# 面積計算書 (座標法)

世界測地系 (測地成果2011)

所在	地番	公簿地目	現況地目	地積	所有者
前橋市六供町四丁目	108-3			150.54 m <sup>2</sup>	

点名	X座標	Y座標	辺長	方向角	測角	Dx	倍積 (Y×Dx)
108-114	41236.356	-67765.484	41.202	181-46-54	90-00-25	-41.069	2783060.662396
108-113	41195.174	-67766.765	3.650	93-36-45	91-49-51	-41.412	2806357.272180
108-109	41194.944	-67763.122	41.319	1-46-56	88-10-11	41.069	-2782963.657418
108-110	41236.243	-67761.837	3.649	271-46-29	89-59-33	41.412	-2806153.193844

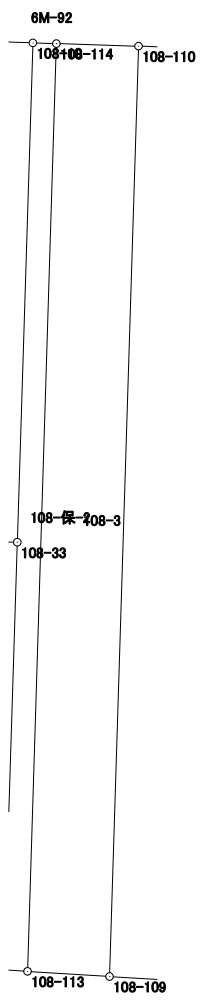


倍面積	301.083314
面積	150.5416570

# 面積計算書（座標法）

世界測地系（測地成果2011）

所 在	地 番	公簿地目	現況地目	地 積	所 有 者
前橋市六供町四丁目	108-4			2437.45 m <sup>2</sup>	


点 名	X 座標	Y 座標	辺 長	方 向 角	測 角	DX	倍 積 (Y×DX)
108-111	41194.256	-67752.221	56.265	93-36-44	91-49-48	-45.195	3062061.628095
108-4	41190.711	-67696.068	40.636	4-39-04	91-02-20	36.957	-2501843.585076
108-3	41231.213	-67692.773	4.013	317-59-22	133-20-18	43.484	-2943552.541132
108-2	41234.195	-67695.459	55.492	271-46-01	133-46-39	4.693	-317694.789087
108-112	41235.906	-67750.925	41.670	181-46-56	90-00-55	-39.939	2705904.193575
						倍面積	4874.906375
						面 積	2437.4531875

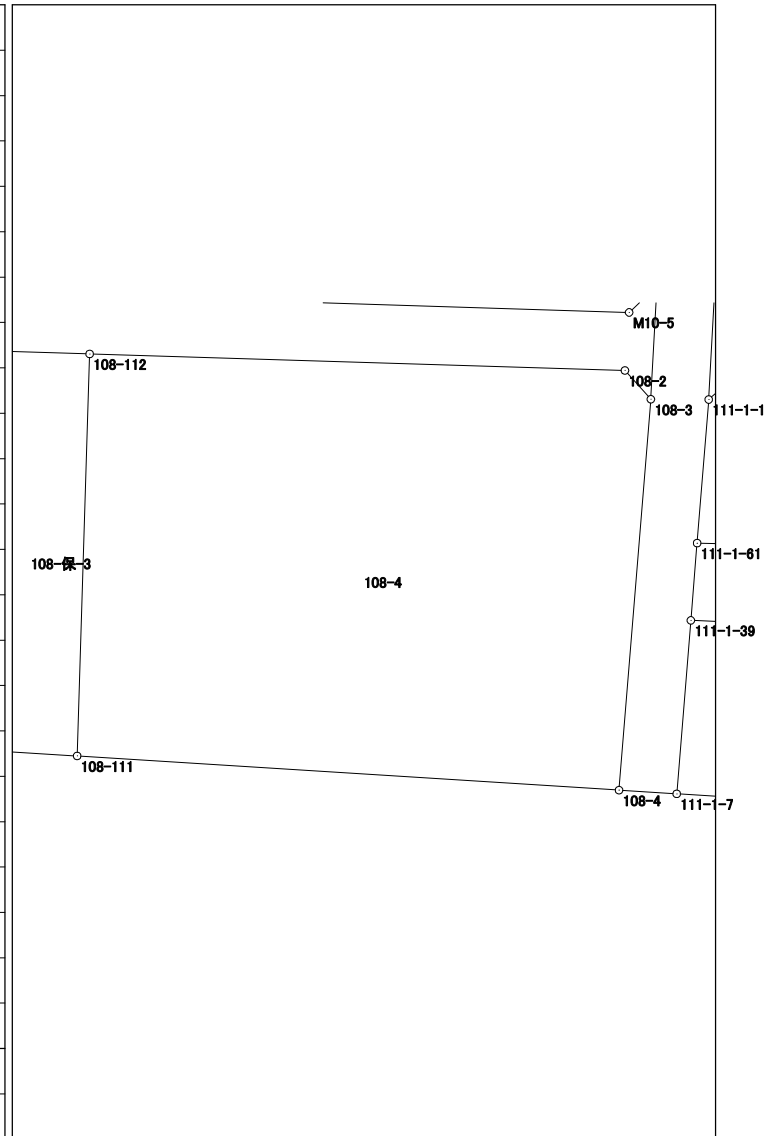

# 面積計算書 (座標法)

世界測地系 (測地成果2011)

所 在	地 番	公簿地目	現況地目	地 積	所 有 者
前橋市六供町四丁目	108-5-1			294.93 m <sup>2</sup>	

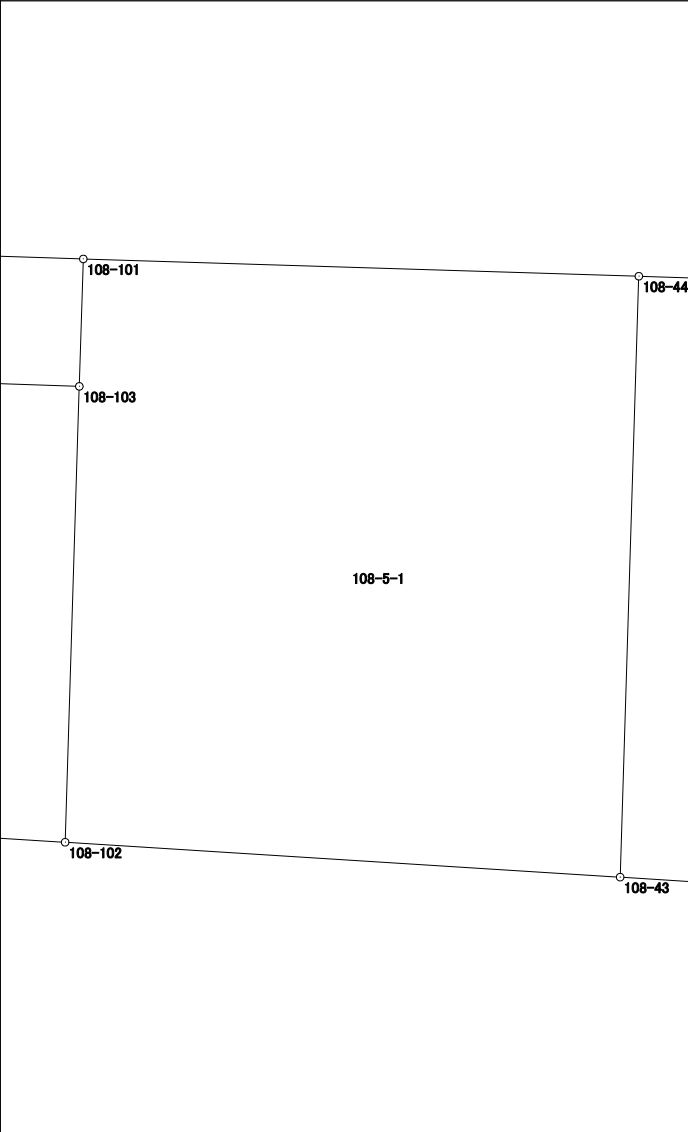
点 名	X 座標	Y 座標	辺 長	方 向 角	測 角	DX	倍 積 (Y×DX)	
108-103	41211.913	-67815.804	13.650	181-46-48	179-59-33	-17.456	1183792.674624	
108-102	41198.270	-67816.228	16.645	93-35-58	91-49-10	-14.688	996084.756864	
108-43	41197.225	-67799.616	17.992	1-46-50	88-10-52	16.938	-1148389.895808	
108-44	41215.208	-67799.057	16.636	271-47-04	90-00-14	18.501	-1254350.353557	
108-101	41215.726	-67815.685	3.815	181-47-15	90-00-11	-3.295	223452.682075	
						倍面積	589.864198	
						面 積	294.9320990	

# 面積計算書 (座標法)

世界測地系 (測地成果2011)

所在	地番	公簿地目	現況地目	地積	所有者
前橋市六供町四丁目	108-5-2			294.27 m <sup>2</sup>	

点名	X座標	Y座標	辺長	方向角	測角	DX	倍積 (Y×DX)
108-43	41197.225	-67799.616	16.137	93-33-36	91-46-46	-18.985	1287175.709760
108-42	41196.223	-67783.510	18.494	1-47-28	88-13-52	17.483	-1185059.105330
108-45	41214.708	-67782.932	10.871	271-46-35	89-59-07	18.822	-1275810.346104
108-115	41215.045	-67793.798	5.262	271-46-31	179-59-56	0.500	-33896.899000
108-44	41215.208	-67799.057	17.992	181-46-50	90-00-19	-17.820	1208179.195740

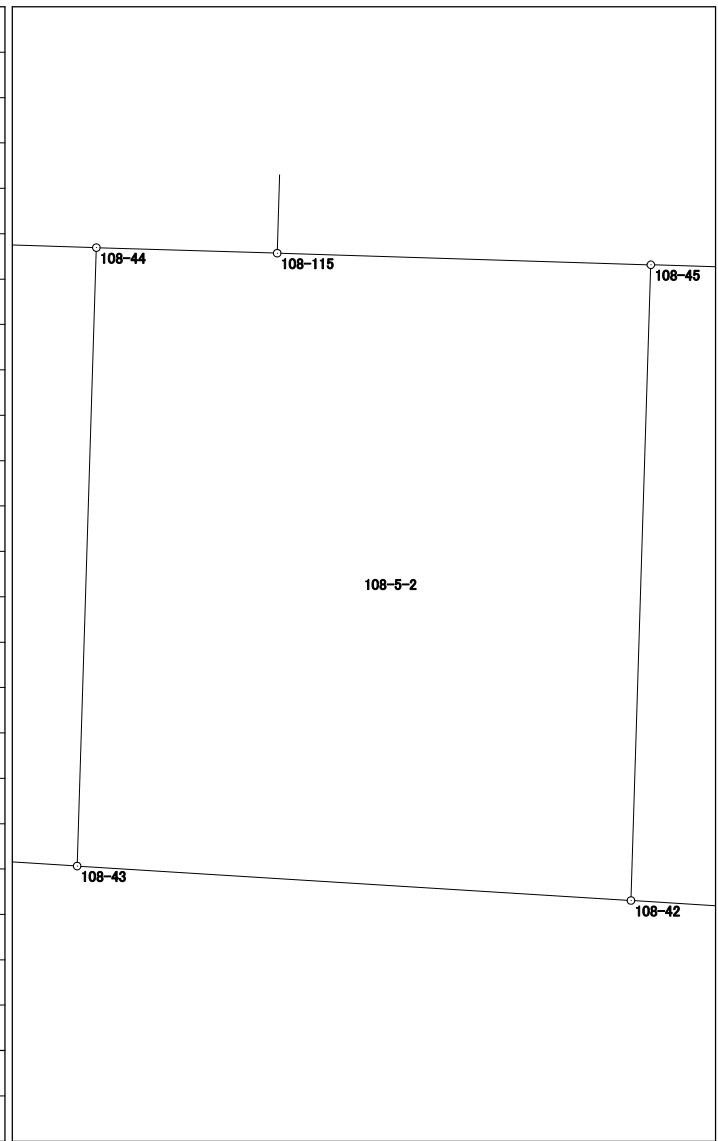


倍面積	588.555066
面積	294.2775330

# 面積計算書 (座標法)

世界測地系 (測地成果2011)

所在	地番	公簿地目	現況地目	地積	所有者
前橋市六供町四丁目	108-5-3			294.71 m <sup>2</sup>	

点名	X座標	Y座標	辺長	方向角	測角	DX	倍積 (Y×DX)
108-42	41196.223	-67783.510	15.734	93-34-55	91-47-27	-19.468	1319609.372680
108-13	41195.240	-67767.807	18.992	1-46-38	88-11-43	18.000	-1219820.526000
108-33	41214.223	-67767.218	15.721	271-46-04	89-59-26	19.468	-1319292.200024
108-45	41214.708	-67782.932	18.494	181-47-28	90-01-24	-18.000	1220092.776000
						倍面積	589.422656
						面積	294.7113280

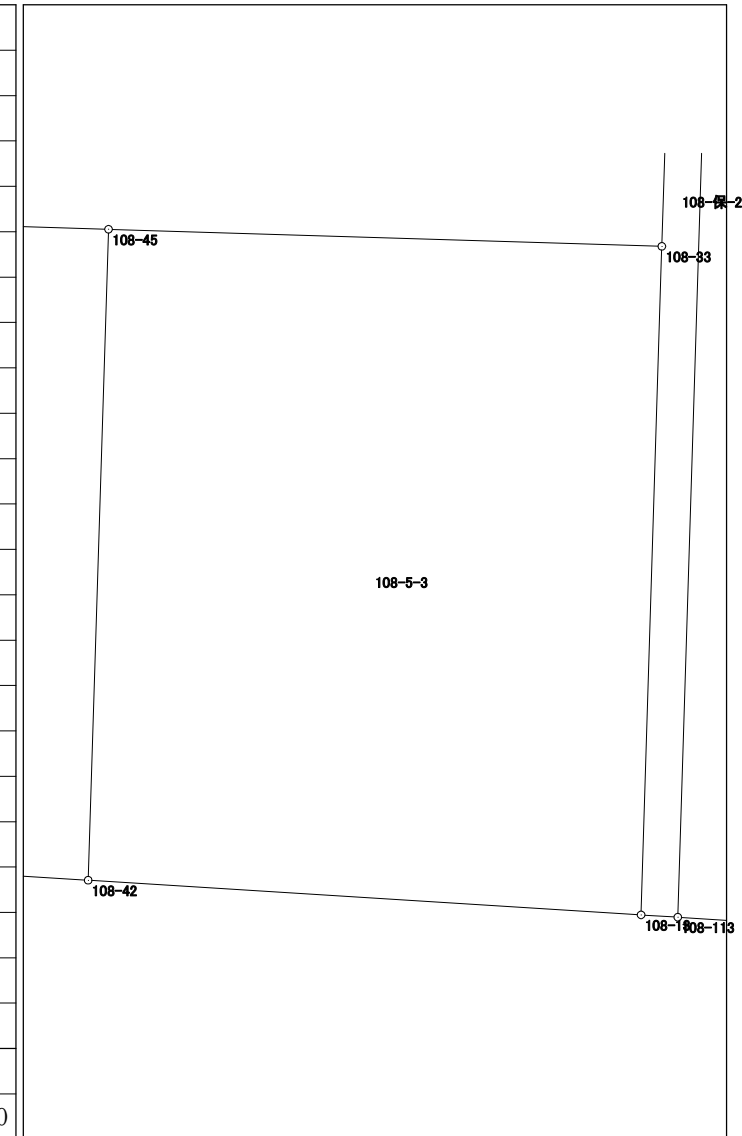




# 面積計算書（座標法）

世界測地系（測地成果2011）

所 在	地 番	公簿地目	現況地目	地 積	所 有 者
前橋市六供町四丁目	108-6			101.75 m <sup>2</sup>	

点 名	X 座 標	Y 座 標	辺 長	方 向 角	測 角	DX	倍 積 (Y×DX)
108-108	41212.155	-67823.330	13.419	181-40-57	89-50-27	-13.171	893301.079430
108-107	41198.742	-67823.724	7.511	93-36-11	91-55-14	-13.885	941732.407740
108-102	41198.270	-67816.228	13.650	1-46-48	88-10-37	13.171	-893207.538988
108-103	41211.913	-67815.804	7.530	271-50-30	90-03-42	13.885	-941622.438540

倍面積	203.509642
面 積	101.7548210

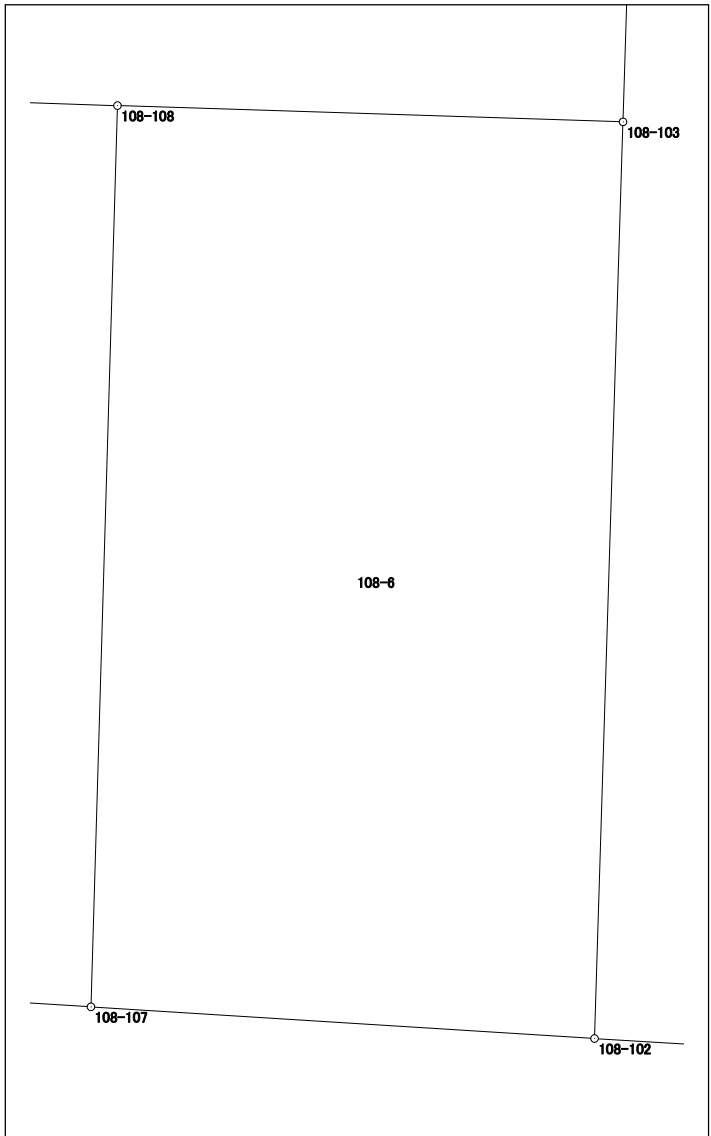


# 面積計算書 (座標法)

世界測地系 (測地成果2011)

所在	地番	公簿地目	現況地目	地積	所有者
前橋市六供町四丁目	108-7			100.96 m <sup>2</sup>	

点名	X座標	Y座標	辺長	方向角	測角	DX	倍積(Y×DX)
108-106	41199.119	-67829.794	13.237	1-40-47	88-11-19	13.098	-888434.641812
108-105	41212.350	-67829.406	9.940	271-50-21	90-09-34	13.550	-919088.451300
108-38	41212.669	-67839.341	6.336	176-57-04	85-06-43	-6.008	407578.760728
108-6	41206.342	-67839.004	9.984	135-14-36	138-17-32	-13.417	910195.916668
108-5	41199.252	-67831.974	2.184	93-29-28	138-14-52	-7.223	489950.348202

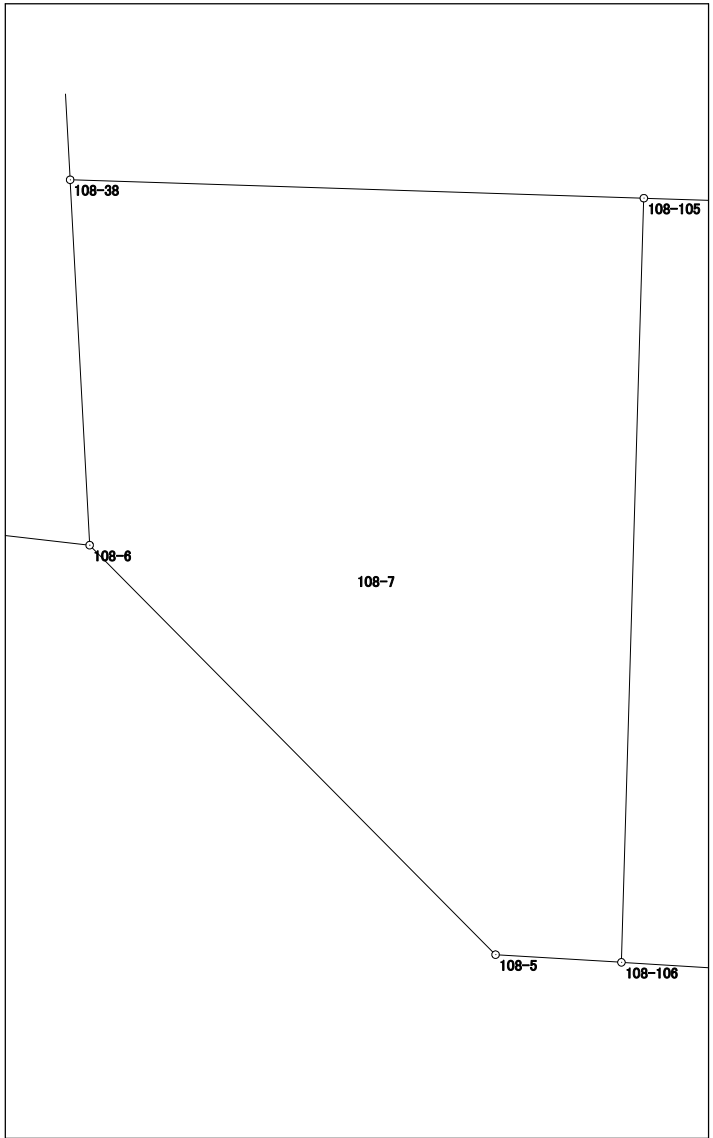


倍面積	201.932486
面積	100.9662430

# 面積計算書（座標法）

世界測地系（測地成果2011）

所在	地番	公簿地目	現況地目	地積	所有者
前橋市六供町四丁目	108-8			90.17 m <sup>2</sup>	

点名	X座標	Y座標	辺長	方向角	測角	DX	倍積 (Y×DX)
108-101	41215.726	-67815.685	23.875	271-47-00	89-59-45	4.556	-308968.260860
108-32	41216.469	-67839.548	3.806	176-52-55	85-05-55	-3.057	207385.498236
108-38	41212.669	-67839.341	9.940	91-50-21	94-57-26	-4.119	279430.245579
108-105	41212.350	-67829.406	3.088	91-50-15	179-59-54	-0.418	28352.691708
108-104	41212.251	-67826.320	2.992	91-50-20	180-00-05	-0.195	13226.132400
108-108	41212.155	-67823.330	7.530	91-50-30	180-00-10	-0.338	22924.285540
108-103	41211.913	-67815.804	3.815	1-47-15	89-56-45	3.571	-242170.236084

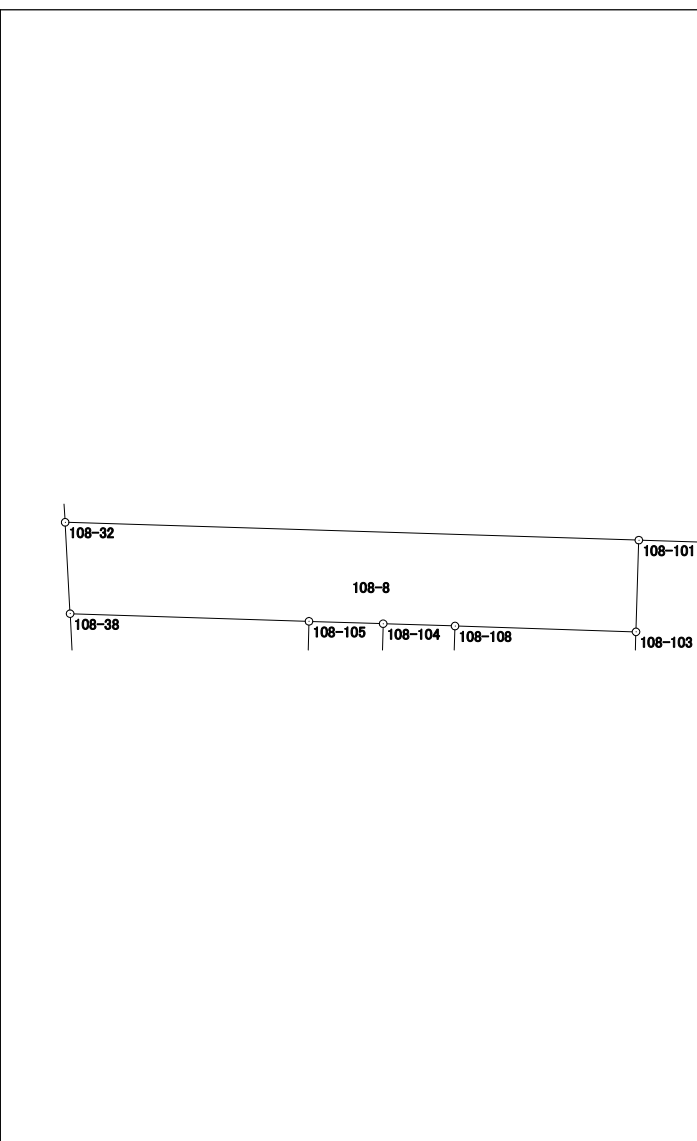


倍面積	180.356519
面積	90.1782595

# 面積計算書（座標法）

世界測地系（測地成果2011）

所 在	地 番	公簿地目	現況地目	地 積	所 有 者
前橋市六供町四丁目	108-保-2			43.00 m <sup>2</sup>	

点 名	X 座標	Y 座標	辺 長	方 向 角	測 角	D <sub>X</sub>	倍 積 (Y×D <sub>X</sub> )
108-113	41195.174	-67766.765	41.202	1-46-54	88-09-27	41.116	-2786298.309740
108-114	41236.356	-67765.484	1.043	271-45-26	89-58-32	41.214	-2792886.657576
108-10	41236.388	-67766.527	22.176	181-47-08	90-01-42	-22.133	1499876.542091
108-33	41214.223	-67767.218	18.992	181-46-38	179-59-30	-41.148	2788485.486264
108-13	41195.240	-67767.807	1.044	93-37-27	91-50-49	-19.049	1290908.955543
						倍面積	86.016582
						面 積	43.0082910

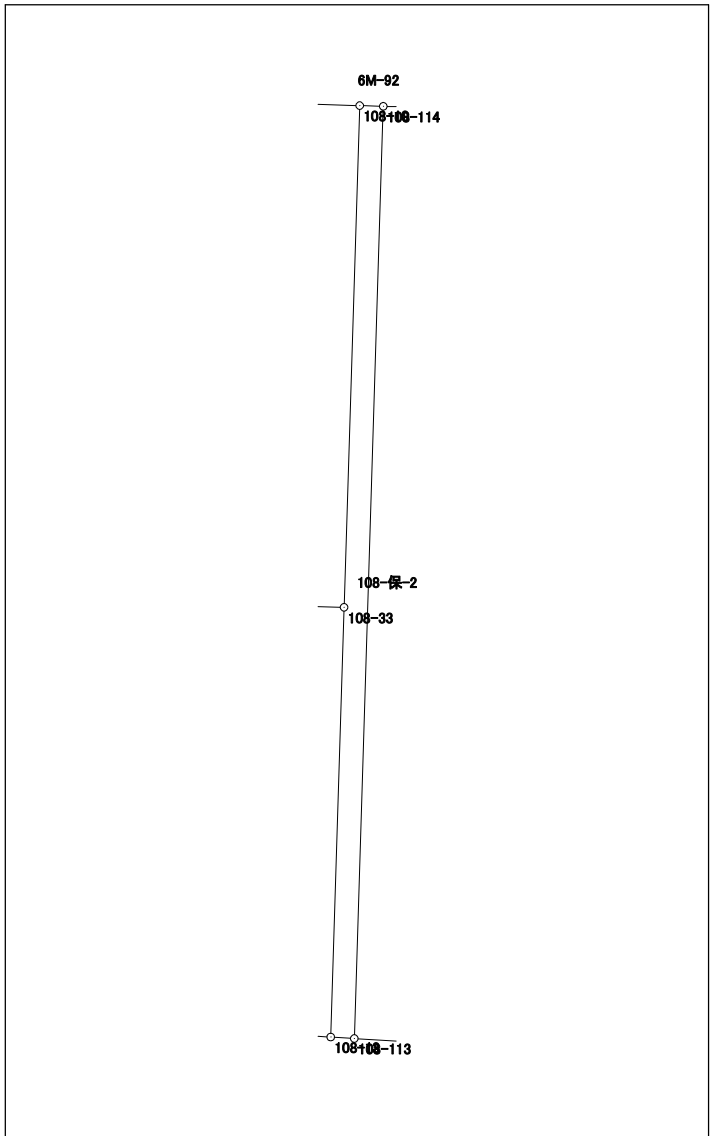


# 面積計算書 (座標法)

世界測地系 (測地成果2011)

所在	地番	公簿地目	現況地目	地積	所有者
前橋市六供町四丁目	108-保-3			453.00 m <sup>2</sup>	

点名	X座標	Y座標	辺長	方向角	測角	DX	倍積 (Y×DX)
108-112	41235.906	-67750.925	10.917	271-46-08	89-59-12	41.987	-2844658.087975
108-110	41236.243	-67761.837	41.319	181-46-56	90-00-48	-40.962	2775660.367194
108-109	41194.944	-67763.122	10.923	93-36-41	91-49-45	-41.987	2845170.203414
108-111	41194.256	-67752.221	41.670	1-46-56	88-10-15	40.962	-2775266.476602

倍面積	906.006031
面積	453.0030155

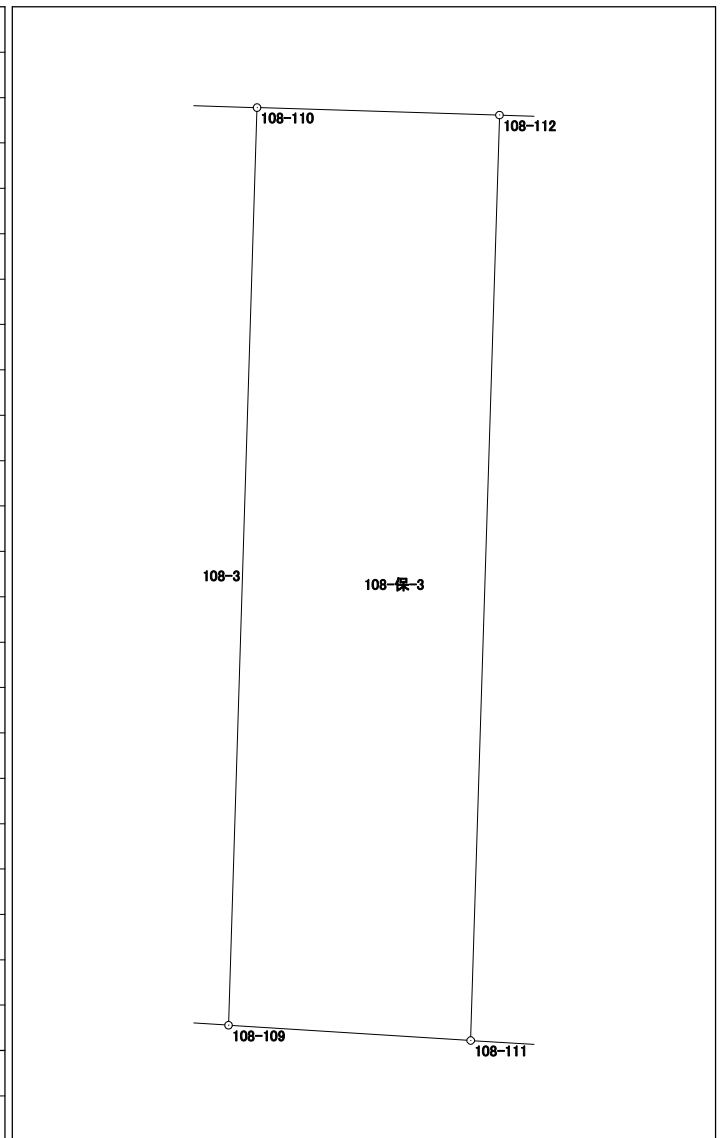


# 面積計算書 (座標法)

世界測地系 (測地成果2011)

所在	地番	公簿地目	現況地目	地積	所有者
前橋市六供町四丁目	108-保-4			41.00 m <sup>2</sup>	

点名	X座標	Y座標	辺長	方向角	測角	DX	倍積 (Y×DX)
108-105	41212.350	-67829.406	13.237	181-40-47	89-50-32	-13.132	890735.759592
108-106	41199.119	-67829.794	3.089	93-30-29	91-49-42	-13.420	910275.835480
108-40	41198.930	-67826.711	13.327	1-40-53	88-10-24	13.132	-890700.368852
108-104	41212.251	-67826.320	3.088	271-50-15	90-09-22	13.420	-910229.214400
						倍面積	82.011820
						面積	41.0059100

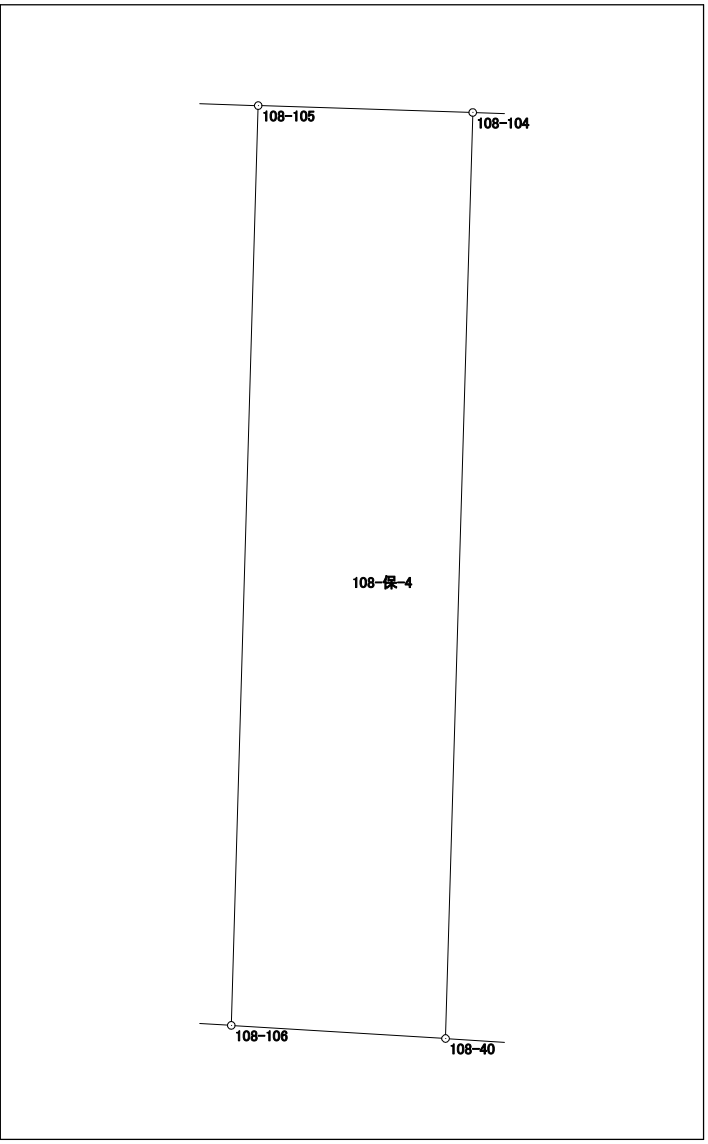

# 面積計算書 (座標法)

世界測地系 (測地成果2011)

所在	地番	公簿地目	現況地目	地積	所有者
前橋市六供町四丁目	108-保-5			40.00 m <sup>2</sup>	

点名	X座標	Y座標	辺長	方向角	測角	DX	倍積 (Y×DX)
108-107	41198.742	-67823.724	13.419	1-40-57	88-04-52	13.225	-896968.749900
108-108	41212.155	-67823.330	2.992	271-50-20	90-09-23	13.509	-916225.364970
108-104	41212.251	-67826.320	13.327	181-40-53	89-50-33	-13.225	897003.082000
108-40	41198.930	-67826.711	2.993	93-36-05	91-55-12	-13.509	916271.038899
						倍面積	80.006029
						面積	40.0030145

