



110街区 画地出来形確認図 (3973.83m²)

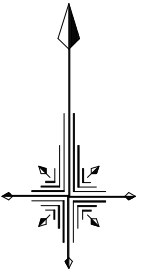

S=1/500

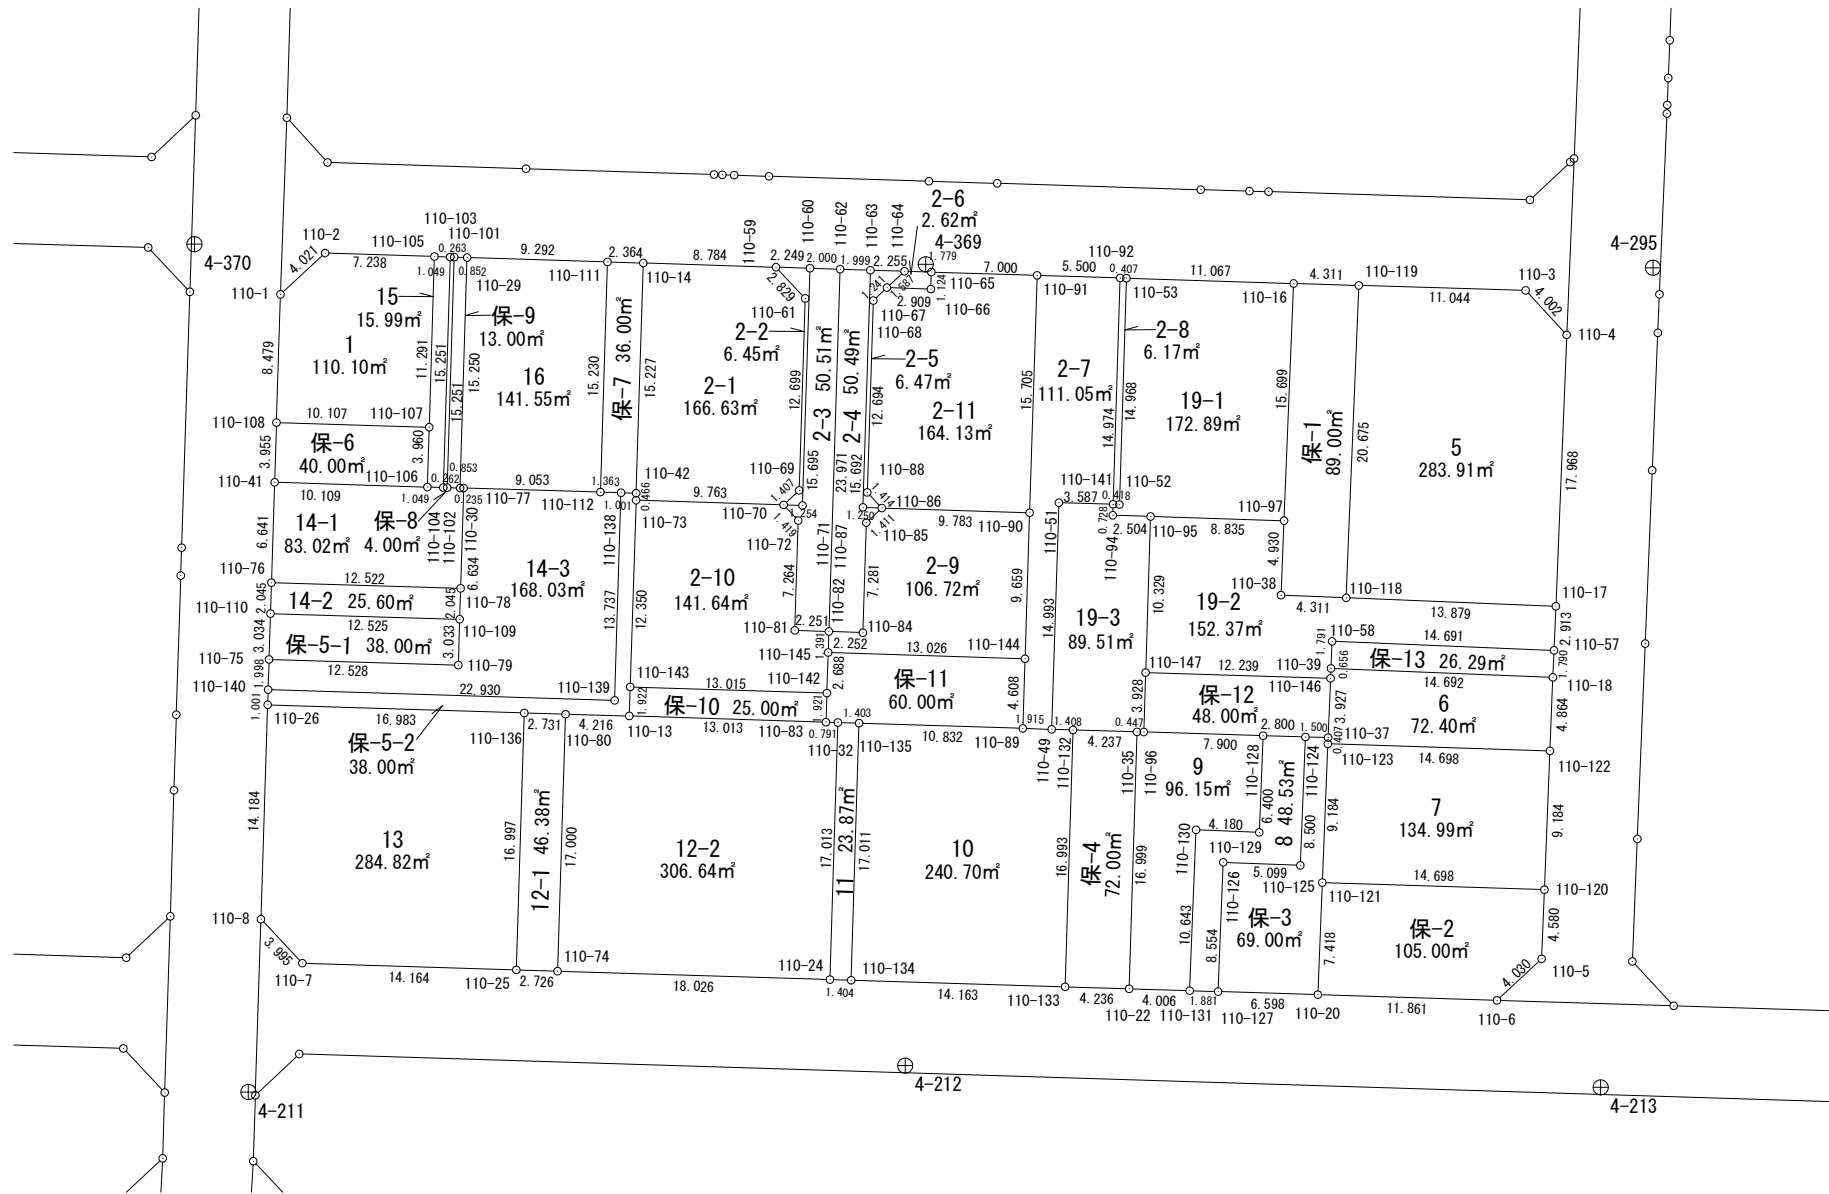


面積計算書（座標法）

世界測地系（測地成果2011）

所 在	地 番	公簿地目	現況地目	地 積	所 有 者
前橋市六供町四丁目	110-1			110.10 m ²	

点 名	X 座標	Y 座標	辺 長	方 向 角	測 角	DX	倍 積 (Y×DX)
110-107	41291.277	-67674.495	11.291	1-45-03	89-59-56	10.977	-742862.931615
110-105	41302.563	-67674.150	7.238	271-49-44	90-04-41	11.517	-779403.185550
110-2	41302.794	-67681.384	4.021	227-10-37	135-20-53	-2.502	169338.822768
110-1	41300.061	-67684.333	8.479	181-47-03	134-36-26	-11.208	758606.004264
110-108	41291.586	-67684.597	10.107	91-45-07	89-58-04	-8.784	594541.500048

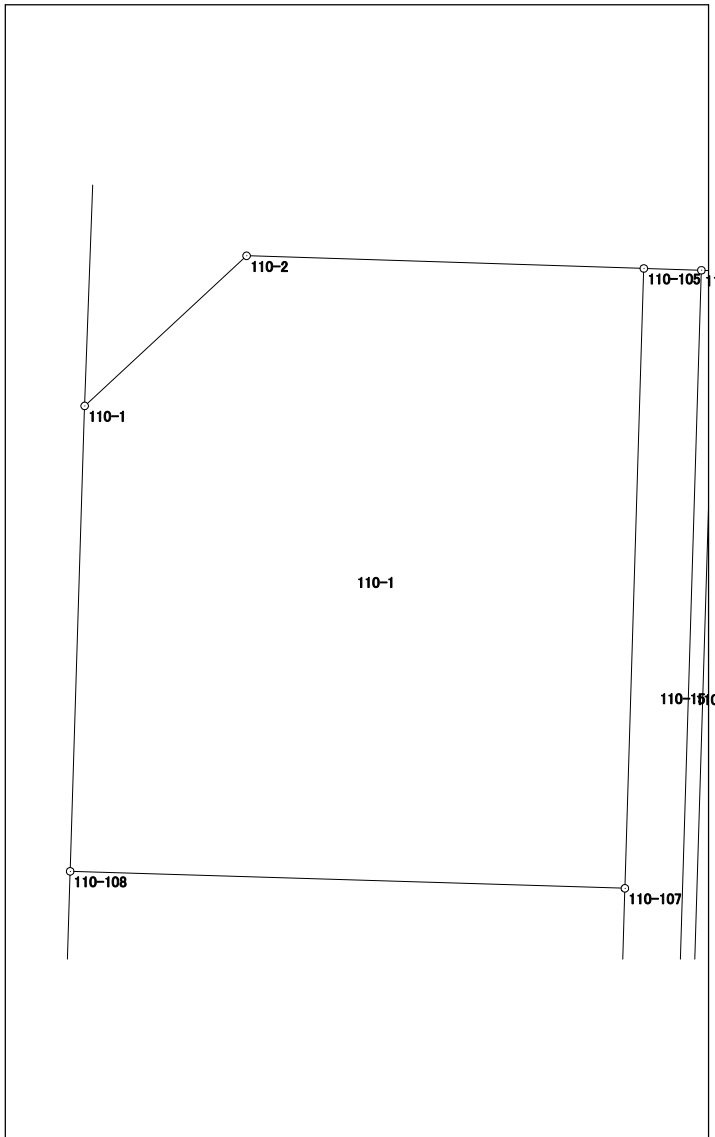


倍面積	220.209915
面 積	110.1049575

面積計算書 (座標法)

世界測地系 (測地成果2011)

所 在	地 番	公簿地目	現況地目	地 積	所 有 者
前橋市六供町四丁目	110-2-1			166.63 m ²	

点 名	X 座標	Y 座標	辺 長	方 向 角	測 角	DX	倍 積 (Y×DX)
110-14	41302.134	-67660.336	15.227	181-46-08	89-58-06	-14.944	1011116.061184
110-42	41286.914	-67660.806	0.466	180-29-30	178-43-22	-15.686	1061327.402916
110-73	41286.448	-67660.810	9.763	91-47-46	91-18-16	-0.772	52234.145320
110-70	41286.142	-67651.052	1.407	47-02-40	135-14-54	0.653	-44176.136956
110-69	41287.101	-67650.022	12.699	1-48-34	134-45-54	13.652	-923558.100344
110-61	41299.794	-67649.621	2.829	316-50-51	135-02-17	14.757	-998305.457097
110-59	41301.858	-67651.556	8.784	271-48-02	134-57-11	2.340	-158304.641040
						倍面積	333.273983
						面 積	166.6369915

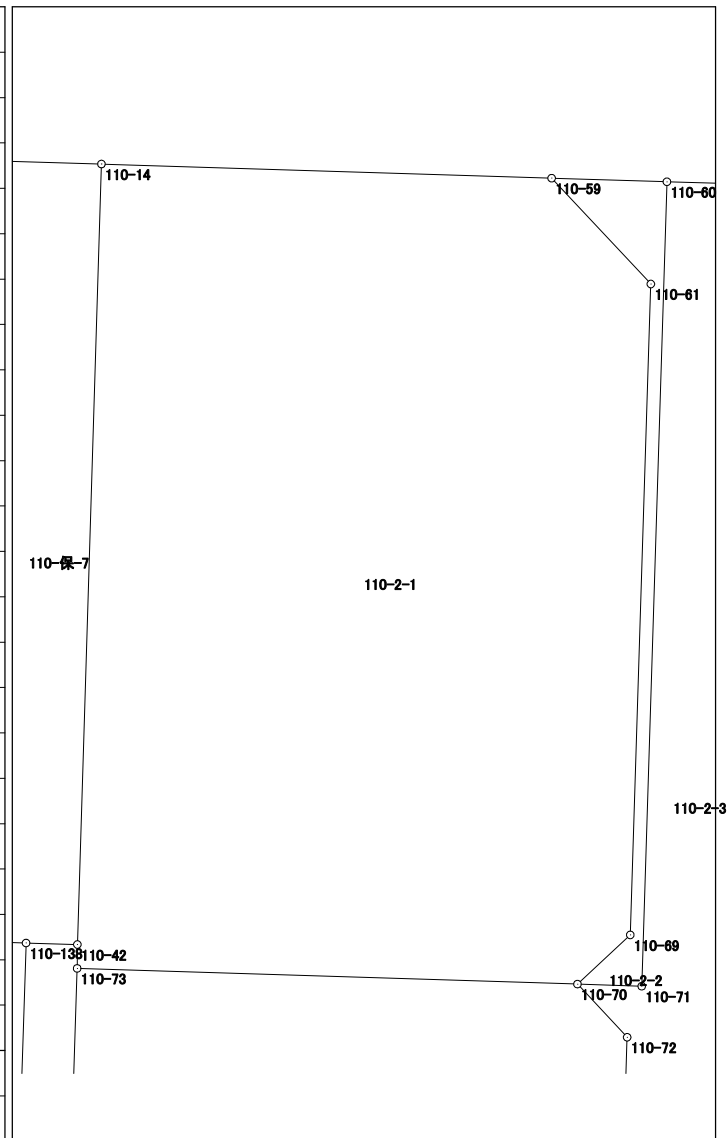


面積計算書 (座標法)

世界測地系 (測地成果2011)

所在	地番	公簿地目	現況地目	地積	所有者
前橋市六供町四丁目	110-2-2			6.45 m ²	


点名	X座標	Y座標	辺長	方向角	測角	Dx	倍積 (Y×Dx)
110-59	41301.858	-67651.556	2.829	136-50-51	45-03-50	-1.994	134897.202664
110-61	41299.794	-67649.621	12.699	181-48-34	224-57-43	-14.757	998305.457097
110-69	41287.101	-67650.022	1.407	227-02-40	225-14-06	-13.652	923558.100344
110-70	41286.142	-67651.052	1.254	91-52-27	44-49-47	-1.000	67651.052000
110-71	41286.101	-67649.799	15.695	1-47-34	89-55-07	15.646	-1058448.755154
110-60	41301.788	-67649.308	2.249	271-47-01	89-59-27	15.757	-1065950.146156
						倍面積	12.910795
						面積	6.4553975

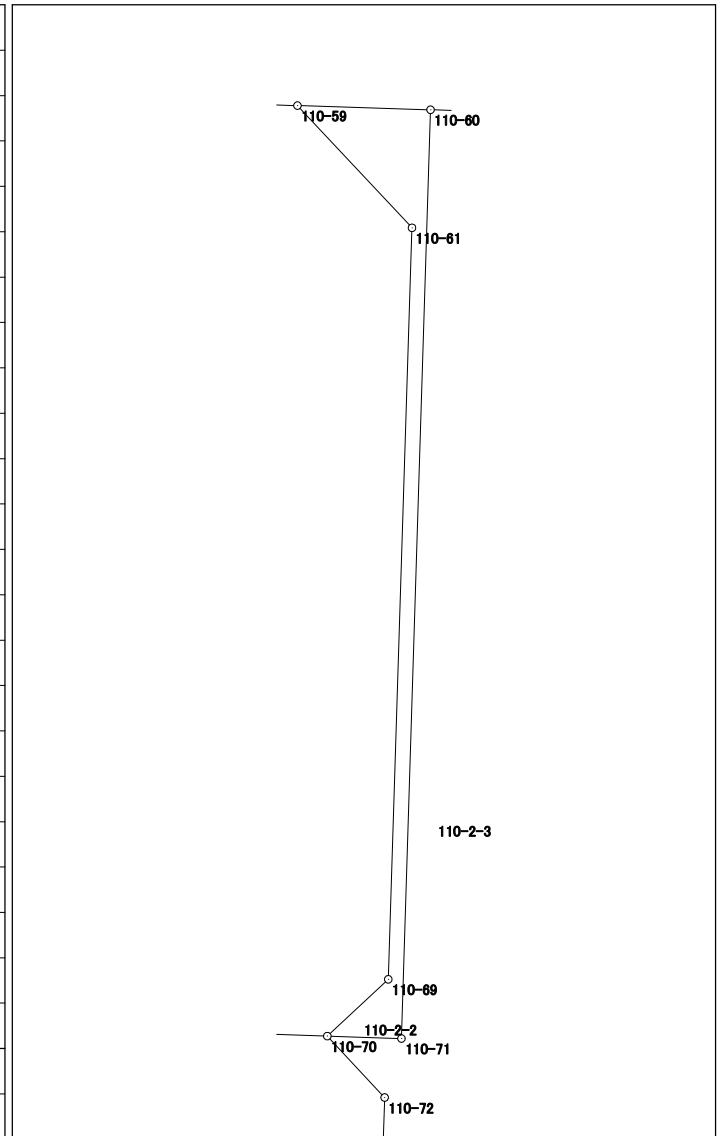

面積計算書（座標法）

所 在	地 番	公簿地目	現況地目	地 積	所 有 者
前橋市六供町四丁目	110-2-3			50.51 m ²	

点 名	X 座 標	Y 座 標	辺 長	方 向 角	測 角	D X	倍 積 (Y×DX)
110-60	41301.788	-67649.308	15.695	181-47-34	90-04-25	-15.627	1057155.736116
110-71	41286.101	-67649.799	1.254	271-52-27	270-04-53	-15.646	1058448.755154
110-70	41286.142	-67651.052	1.419	136-56-29	45-04-02	-0.996	67380.447792
110-72	41285.105	-67650.083	7.264	181-47-27	224-50-58	-8.297	561292.738651
110-81	41277.845	-67650.310	2.251	91-56-05	90-08-38	-7.336	496282.674160
110-82	41277.769	-67648.060	23.971	1-47-43	89-51-38	23.883	-1615638.616980
110-62	41301.728	-67647.309	2.000	271-43-09	89-55-26	24.019	-1624820.714871
倍面積							101.020022
面 積							50.5100110

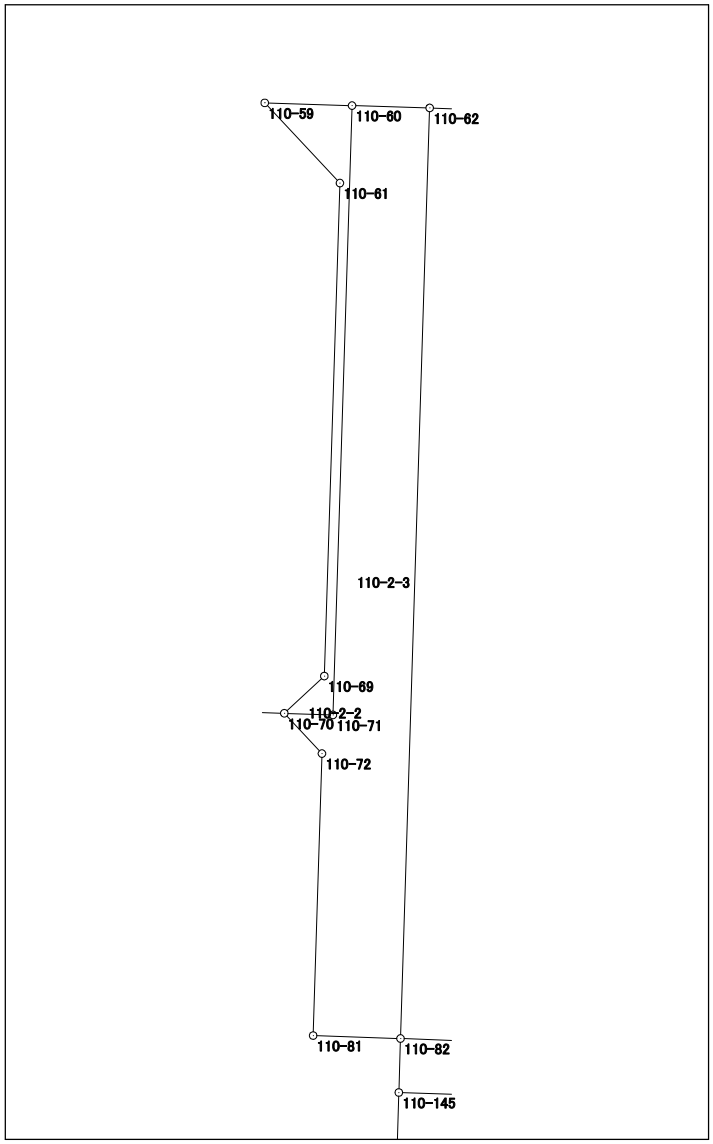


面積計算書 (座標法)

世界測地系 (測地成果2011)

所 在	地 番	公簿地目	現況地目	地 積	所 有 者
前橋市六供町四丁目	110-2-4			50.49 m ²	

点 名	X 座標	Y 座標	辺 長	方 向 角	測 角	DX	倍 積 (Y×DX)
110-62	41301.728	-67647.309	23.971	181-47-43	89-52-29	-23.892	1616229.506628
110-82	41277.769	-67648.060	2.252	92-03-39	90-15-56	-24.040	1626259.362400
110-84	41277.688	-67645.809	7.281	1-45-46	89-42-07	7.197	-486846.887373
110-85	41284.966	-67645.585	1.411	46-51-58	225-06-12	8.243	-557602.557155
110-86	41285.931	-67644.555	1.250	272-06-33	45-14-35	1.011	-68388.645105
110-87	41285.977	-67645.804	15.692	1-48-01	269-41-28	15.730	-1064068.496920
110-63	41301.661	-67645.311	1.999	271-55-14	90-07-13	15.751	-1065481.293561
						倍面積	100.988914
						面 積	50.4944570

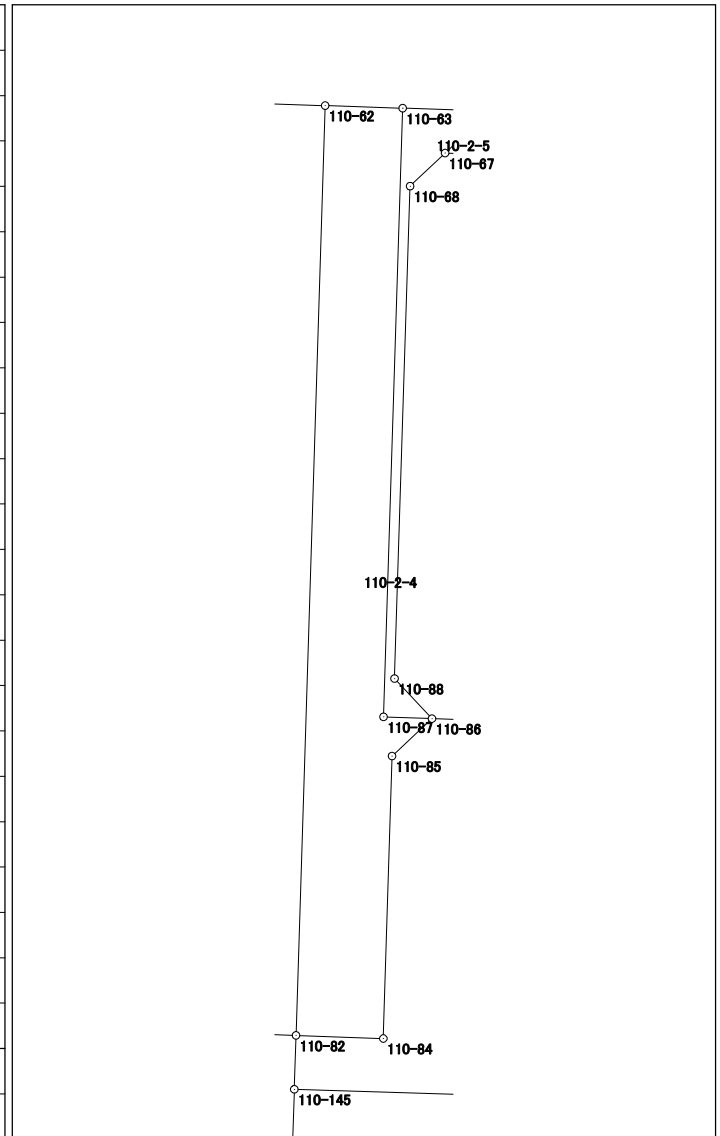


面積計算書（座標法）

世界測地系（測地成果2011）

所在	地番	公簿地目	現況地目	地積	所有者
前橋市六供町四丁目	110-2-5			6.47 m ²	

点名	X座標	Y座標	辺長	方向角	測角	DX	倍積 (Y×DX)
110-63	41301.661	-67645.311	15.692	181-48-01	89-56-43	-15.611	1056010.950021
110-87	41285.977	-67645.804	1.250	92-06-33	90-18-32	-15.730	1064068.496920
110-86	41285.931	-67644.555	1.414	316-55-11	44-48-38	0.987	-66765.175785
110-88	41286.964	-67645.521	12.694	1-48-53	224-53-42	13.721	-928164.193641
110-68	41299.652	-67645.119	1.241	46-35-57	224-47-04	13.541	-915982.556379
110-67	41300.505	-67644.217	1.587	46-57-58	180-22-01	1.936	-130959.204112
110-64	41301.588	-67643.057	2.255	271-51-18	44-53-20	1.156	-78195.373892

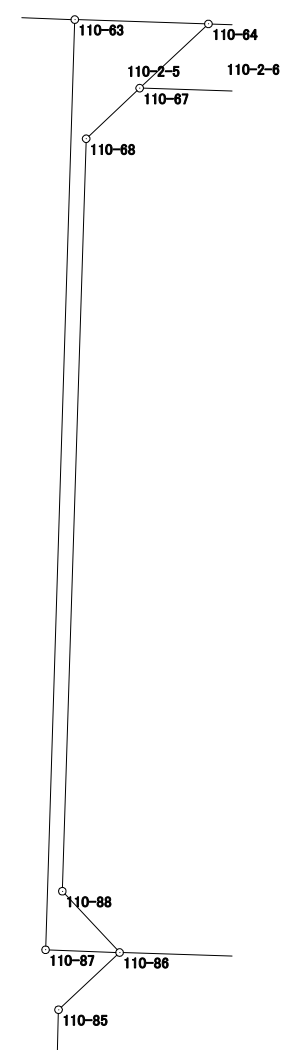


倍面積	12.943132
面積	6.4715660

面積計算書（座標法）

世界測地系（測地成果2011）

所在	地番	公簿地目	現況地目	地積	所有者
前橋市六供町四丁目	110-2-6			2.62 m ²	

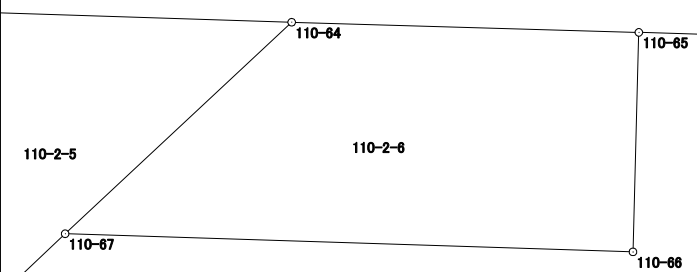
点名	X座標	Y座標	辺長	方向角	測角	DX	倍積 (Y×DX)	
110-64	41301.588	-67643.057	1.587	226-57-58	135-17-27	-1.031	69739.991767	
110-67	41300.505	-67644.217	2.909	91-49-54	44-51-56	-1.176	79549.599192	
110-66	41300.412	-67641.309	1.124	1-31-44	89-41-50	1.031	-69738.189579	
110-65	41301.536	-67641.279	1.779	271-40-31	90-08-47	1.176	-79546.144104	
						倍面積	5.257276	
						面積	2.6286380	

面積計算書 (座標法)

世界測地系 (測地成果2011)

所在	地番	公簿地目	現況地目	地積	所有者
前橋市六供町四丁目	110-2-7			111.05 m ²	

点名	X座標	Y座標	辺長	方向角	測角	DX	倍積 (Y×DX)
110-91	41301.316	-67634.282	15.705	181-48-22	90-02-05	-15.527	1050157.496614
110-90	41285.619	-67634.777	9.659	181-49-38	180-01-16	-25.351	1714609.231727
110-144	41275.965	-67635.085	4.608	181-49-41	180-00-03	-14.260	964476.312100
110-89	41271.359	-67635.232	1.915	91-54-54	90-05-13	-4.670	315856.533440
110-49	41271.295	-67633.318	14.993	1-48-42	89-53-48	14.922	-1009224.371196
110-51	41286.281	-67632.844	3.587	91-37-45	269-49-03	14.884	-1006647.250096
110-141	41286.179	-67629.258	14.974	1-48-36	90-10-51	14.865	-1005308.920170
110-92	41301.146	-67628.785	5.500	271-46-17	89-57-41	15.137	-1023696.918545

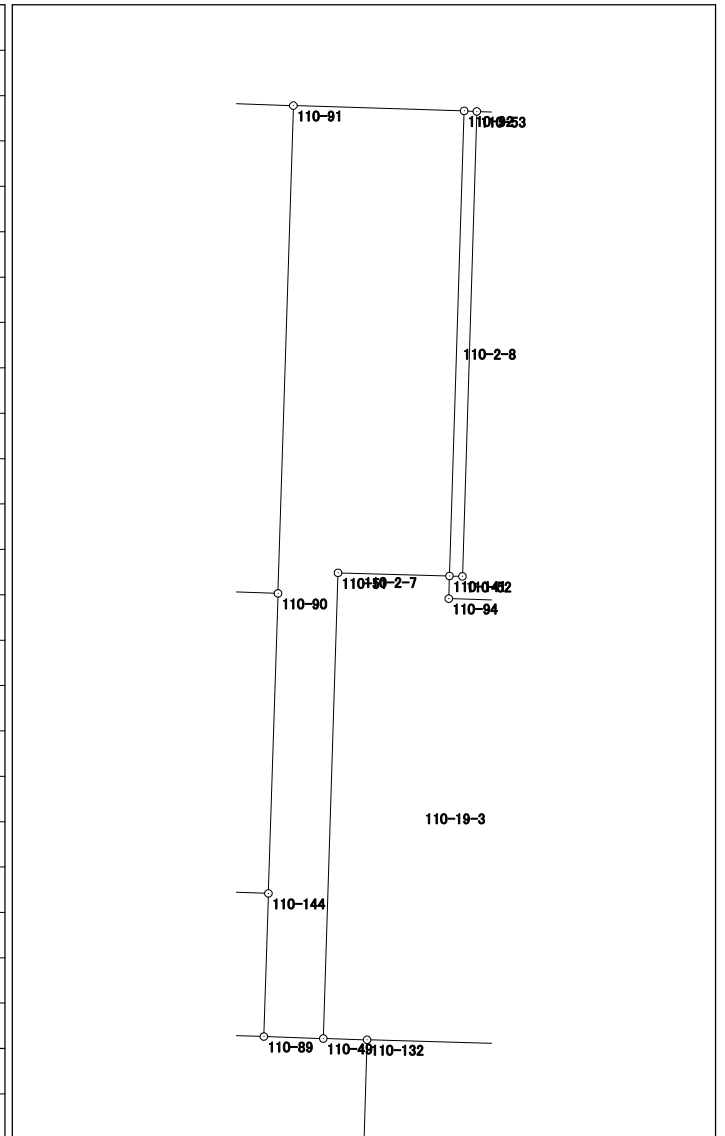


倍面積	222.113874
面積	111.0569370

面積計算書 (座標法)

世界測地系 (測地成果2011)

所在	地番	公簿地目	現況地目	地積	所有者
前橋市六供町四丁目	110-2-8			6.17 m ²	

点名	X座標	Y座標	辺長	方向角	測角	DX	倍積 (Y×DX)
110-92	41301.146	-67628.785	14.974	181-48-36	89-16-40	-14.949	1010982.706965
110-141	41286.179	-67629.258	0.418	91-38-40	89-50-04	-14.979	1013018.655582
110-52	41286.167	-67628.840	14.968	1-46-07	90-07-27	14.949	-1010983.529160
110-53	41301.128	-67628.378	0.407	272-31-56	90-45-49	14.979	-1013005.474062
倍面積							12.359325
面積							6.1796625

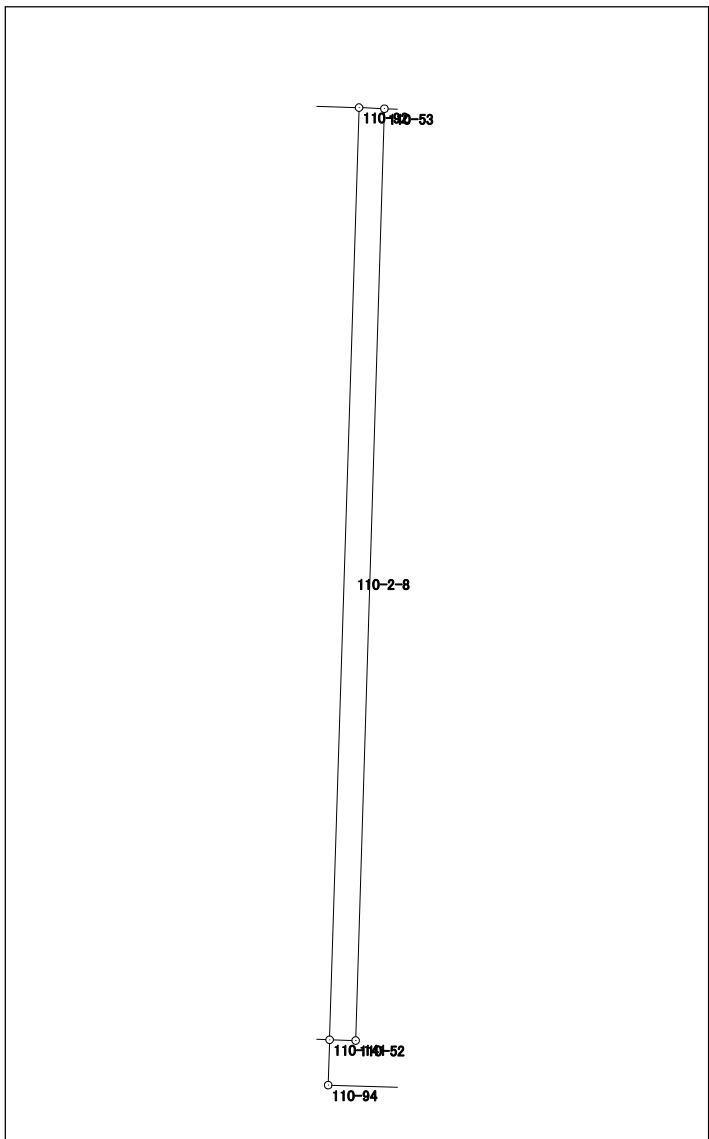


面積計算書（座標法）

世界測地系（測地成果2011）

所在	地番	公簿地目	現況地目	地積	所有者
前橋市六供町四丁目	110-2-9			106.72 m ²	

点名	X座標	Y座標	辺長	方向角	測角	DX	倍積 (Y×DX)
110-82	41277.769	-67648.060	1.391	181-48-47	89-45-08	-1.309	88551.310540
110-145	41276.379	-67648.104	13.026	91-49-17	90-00-30	-1.804	122037.179616
110-144	41275.965	-67635.085	9.659	1-49-38	90-00-21	9.240	-624948.185400
110-90	41285.619	-67634.777	9.783	271-49-39	90-00-01	9.966	-674048.187582
110-86	41285.931	-67644.555	1.411	226-51-58	135-02-19	-0.653	44171.894415
110-85	41284.966	-67645.585	7.281	181-45-46	134-53-48	-8.243	557602.557155
110-84	41277.688	-67645.809	2.252	272-03-39	270-17-53	-7.197	486846.887373

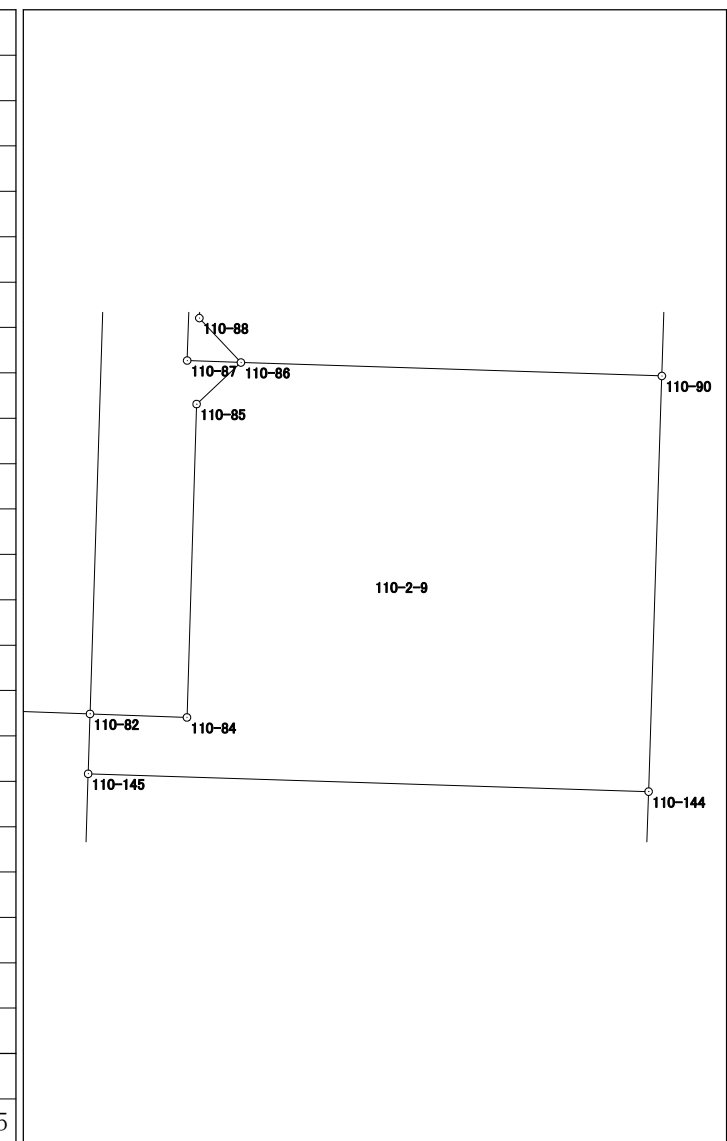

倍面積	213.456117
面積	106.7280585


面積計算書（座標法）

世界測地系（測地成果2011）

所在	地番	公簿地目	現況地目	地積	所有者
前橋市六供町四丁目	110-2-11			164.13 m ²	

点名	X座標	Y座標	辺長	方向角	測角	DX	倍積 (Y×DX)
110-65	41301.536	-67641.279	1.124	181-31-44	89-43-41	-0.904	61147.716216
110-66	41300.412	-67641.309	2.909	271-49-54	270-18-10	-1.031	69738.189579
110-67	41300.505	-67644.217	1.241	226-35-57	134-46-03	-0.760	51409.604920
110-68	41299.652	-67645.119	12.694	181-48-53	135-12-56	-13.541	915982.556379
110-88	41286.964	-67645.521	1.414	136-55-11	135-06-18	-13.721	928164.193641
110-86	41285.931	-67644.555	9.783	91-49-39	134-54-28	-1.345	90981.926475
110-90	41285.619	-67634.777	15.705	1-48-22	89-58-43	15.385	-1040561.044145
110-91	41301.316	-67634.282	7.000	271-48-03	89-59-41	15.917	-1076534.866594

倍面積	328.276471
面積	164.1382355

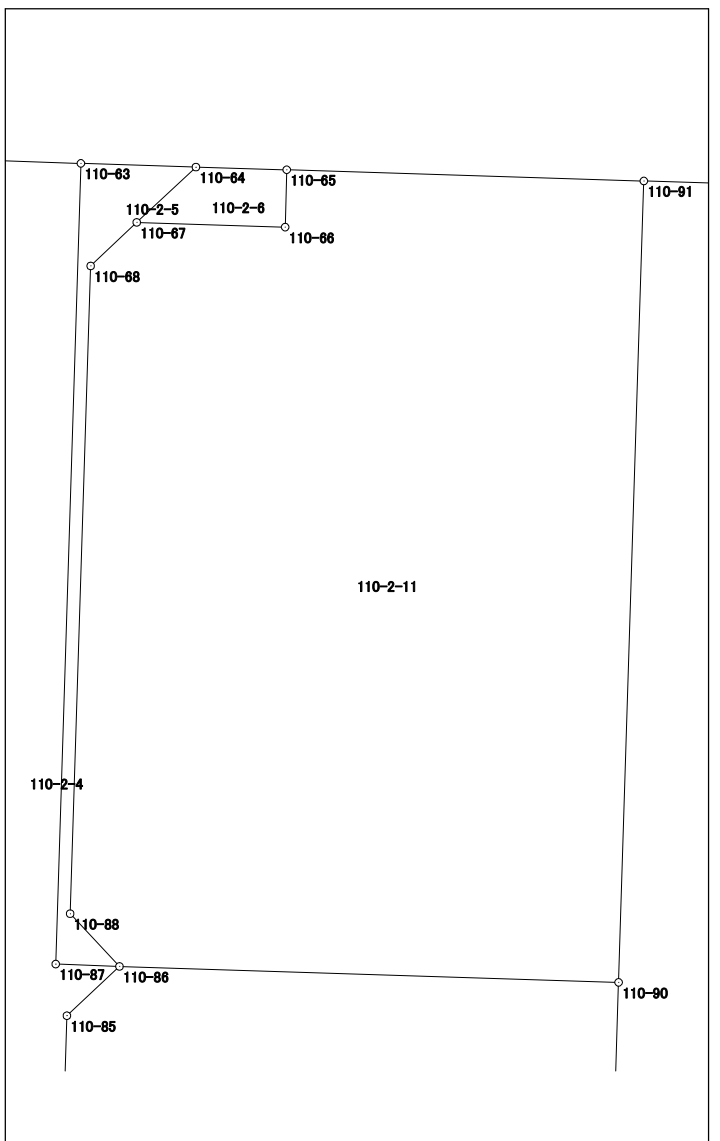

面積計算書（座標法）

世界測地系（測地成果2011）


所在	地番	公簿地目	現況地目	地積	所有者
前橋市六供町四丁目	110-6			72.40 m ²	

点名	X座標	Y座標	辺長	方向角	測角	DX	倍積 (Y×DX)	
110-122	41269.873	-67600.360	4.864	2-17-52	90-28-37	4.393	-296968.381480	
110-18	41274.733	-67600.165	14.692	272-18-48	90-00-56	5.453	-368623.699745	
110-39	41275.326	-67614.845	0.656	182-21-38	90-02-50	-0.062	4192.120390	
110-146	41274.671	-67614.872	3.927	182-22-43	180-01-05	-4.579	309608.498888	
110-37	41270.747	-67615.035	0.407	182-15-05	179-52-22	-4.331	292840.716585	
110-123	41270.340	-67615.051	14.698	91-49-15	89-34-10	-0.874	59095.554574	
							倍面積	144.809212
							面積	72.4046060

面積計算書 (座標法)

世界測地系 (測地成果2011)

所在	地番	公簿地目	現況地目	地積	所有者
前橋市六供町四丁目	110-7			134.99 m ²	

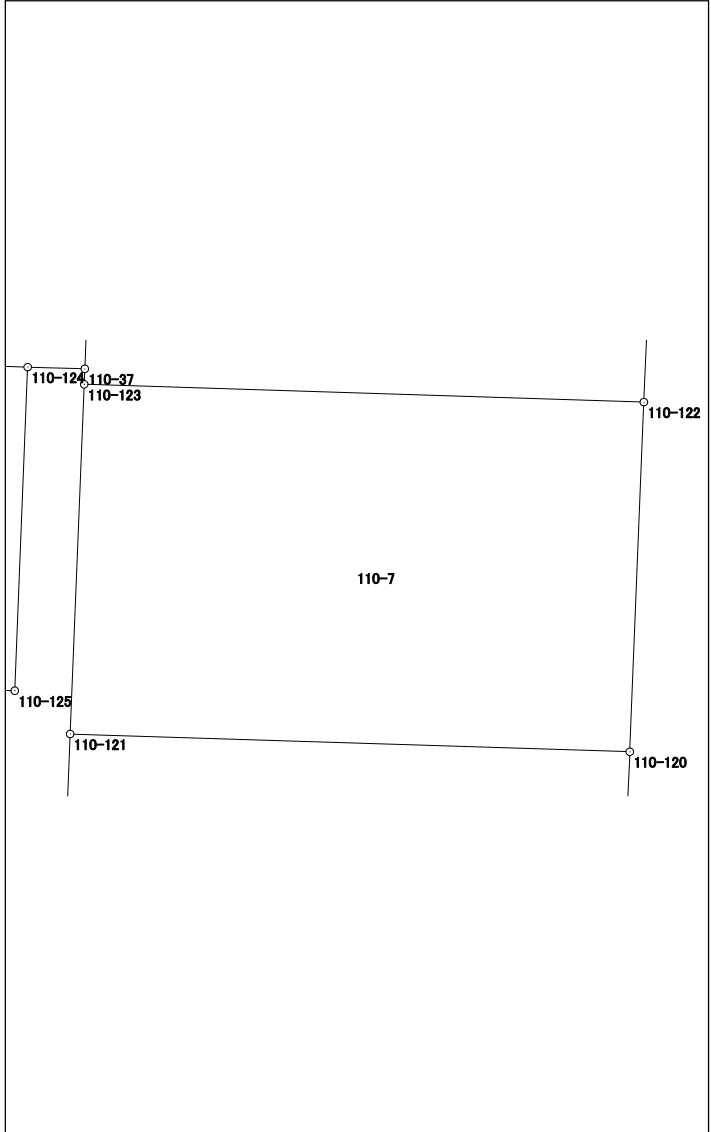点名	X座標	Y座標	辺長	方向角	測角	DX	倍積 (Y×DX)	
110-121	41261.163	-67615.419	14.698	91-49-15	89-31-28	-9.644	652083.100836	
110-120	41260.696	-67600.728	9.184	2-17-47	90-28-32	8.710	-588802.340880	
110-122	41269.873	-67600.360	14.698	271-49-15	89-31-28	9.644	-651937.871840	
110-123	41270.340	-67615.051	9.184	182-17-47	90-28-32	-8.710	588927.094210	
							倍面積	
							面積	134.9911630


面積計算書 (座標法)

世界測地系 (測地成果2011)

所 在	地 番	公簿地目	現況地目	地 積	所 有 者
前橋市六供町四丁目	110-8			48.53 m ²	

点 名	X 座 標	Y 座 標	辺 長	方 向 角	測 角	DX	倍 積 (Y×DX)
110-124	41270.792	-67616.534	2.800	271-44-22	89-26-49	8.578	-580014.628652
110-128	41270.877	-67619.333	6.400	182-17-33	90-33-11	-6.310	426677.991230
110-129	41264.482	-67619.589	4.180	272-17-22	269-59-49	-6.228	421134.800292
110-130	41264.649	-67623.766	10.643	182-17-18	89-59-56	-10.468	707885.582488
110-131	41254.014	-67624.191	1.881	91-46-01	89-28-43	-10.693	723105.474363
110-127	41253.956	-67622.311	8.554	2-17-29	90-31-28	8.489	-574045.798079
110-126	41262.503	-67621.969	5.099	92-17-34	270-00-05	8.343	-564170.087367
110-125	41262.299	-67616.874	8.500	2-17-33	89-59-59	8.289	-560476.268586

倍面積	97.065689
面 積	48.5328445

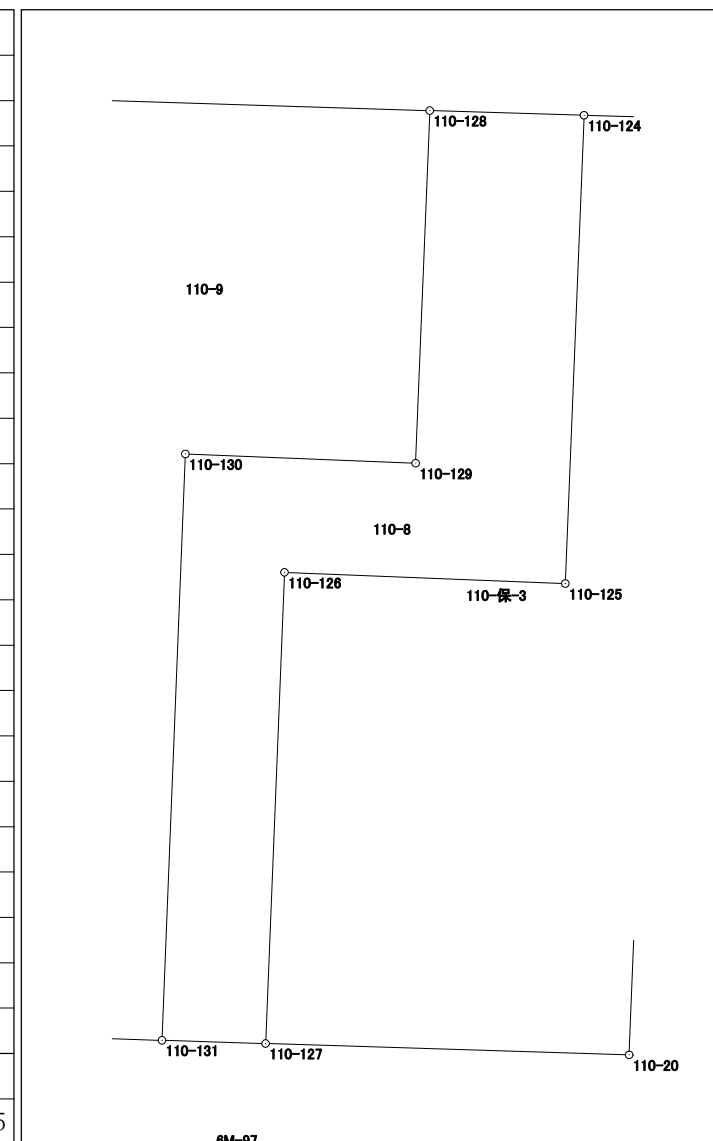


GM-97

面積計算書（座標法）

所 在	地 番	公簿地目	現況地目	地 積	所 有 者
前橋市六供町四丁目	110-9			96.15 m ²	

点 名	X 座標	Y 座標	辺 長	方 向 角	測 角	DX	倍 積 (Y×DX)
110-35	41271.130	-67627.676	16.999	181-44-59	90-43-28	-16.983	1148520.821508
110-22	41254.139	-67628.195	4.006	91-47-17	90-02-18	-17.116	1157524.185620
110-131	41254.014	-67624.191	10.643	2-17-18	90-30-01	10.510	-710730.247410
110-130	41264.649	-67623.766	4.180	92-17-22	270-00-04	10.468	-707885.582488
110-129	41264.482	-67619.589	6.400	2-17-33	90-00-11	6.228	-421134.800292
110-128	41270.877	-67619.333	7.900	271-46-38	89-29-05	6.640	-448992.371120
110-96	41271.122	-67627.229	0.447	271-01-31	179-14-53	0.253	-17109.688937
						倍面積	192.316881
						面 積	96.1584405

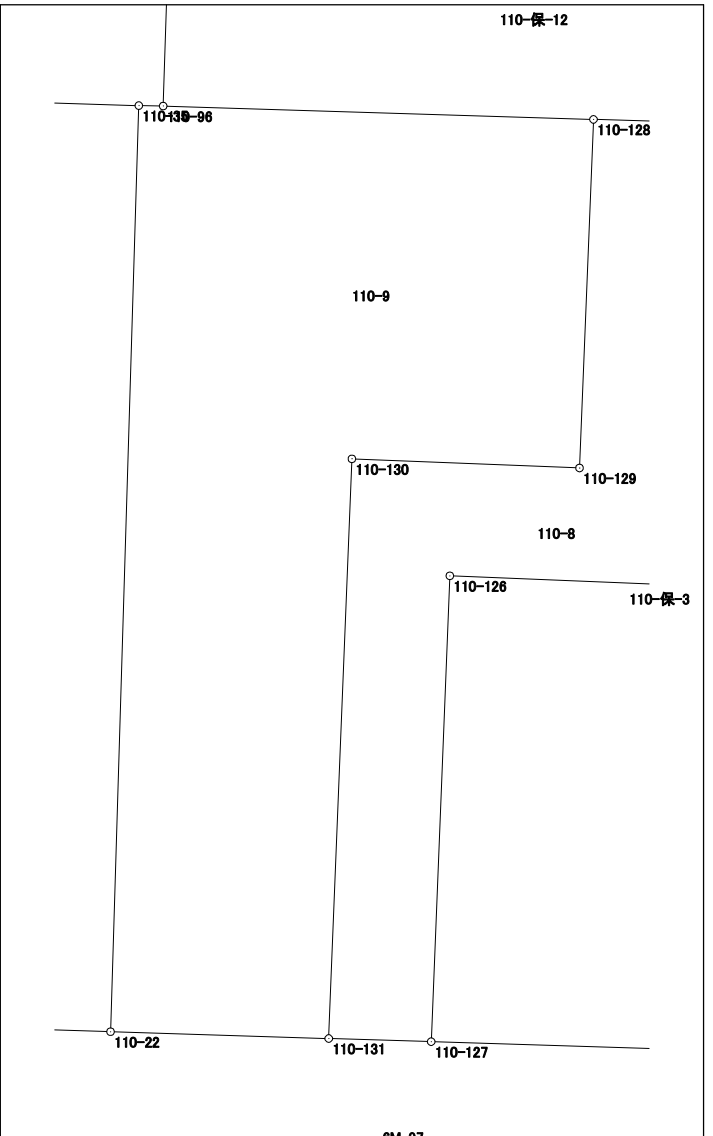


面積計算書（座標法）

世界測地系（測地成果2011）

所在	地番	公簿地目	現況地目	地積	所有者
前橋市六供町四丁目	110-10			240.70 m ²	

点名	X座標	Y座標	辺長	方向角	測角	DX	倍積 (Y×DX)
110-134	41254.703	-67646.585	14.163	91-45-22	89-58-51	-17.437	1179553.502645
110-133	41254.269	-67632.429	16.993	1-44-49	89-59-27	16.551	-1119384.332379
110-132	41271.254	-67631.911	1.408	271-40-09	89-55-20	17.026	-1151500.916686
110-49	41271.295	-67633.318	1.915	271-54-54	180-14-45	0.105	-7101.498390
110-89	41271.359	-67635.232	10.832	271-50-09	179-55-15	0.411	-27798.080352
110-135	41271.706	-67646.058	17.011	181-46-31	89-56-22	-16.656	1126712.742048

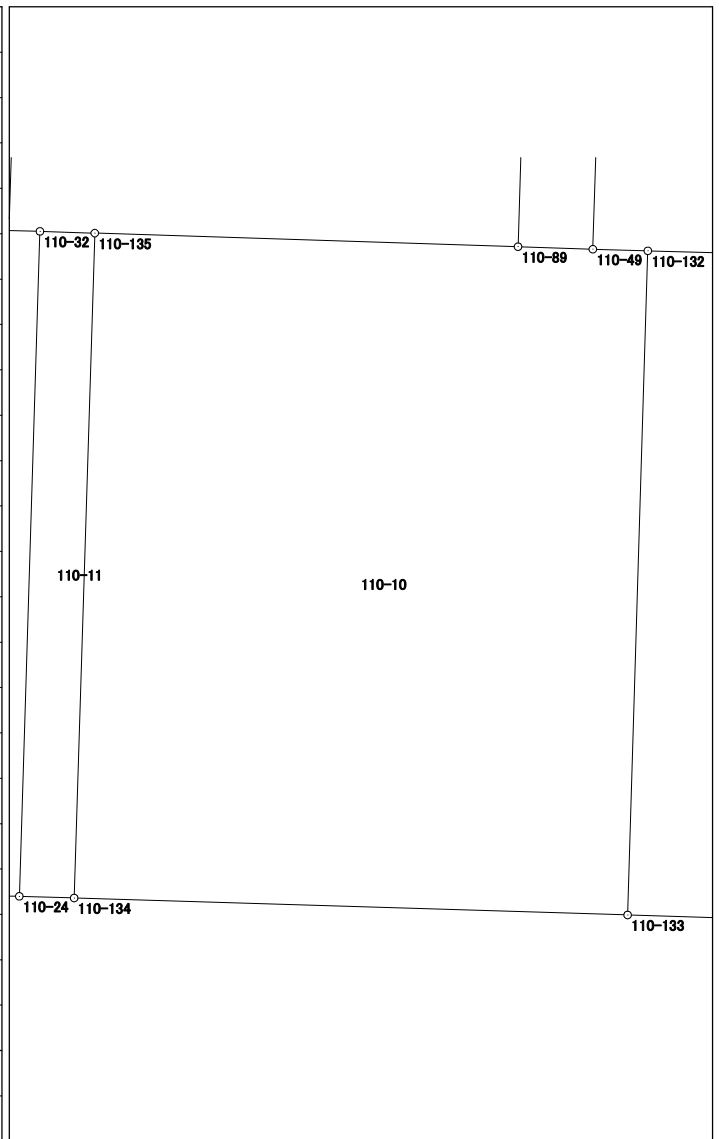


面積計算書（座標法）

世界測地系（測地成果2011）

所在	地番	公簿地目	現況地目	地積	所有者
前橋市六供町四丁目	110-11			23.87 m ²	

点名	X座標	Y座標	辺長	方向角	測角	DX	倍積 (Y×DX)
110-32	41271.751	-67647.460	17.013	181-46-42	89-56-24	-16.960	1147300.921600
110-24	41254.746	-67647.988	1.404	91-45-20	89-58-38	-17.048	1153262.899424
110-134	41254.703	-67646.585	17.011	1-46-31	90-01-11	16.960	-1147286.081600
110-135	41271.706	-67646.058	1.403	271-50-18	90-03-47	17.048	-1153229.996784
倍面積							47.742640
面積							23.8713200

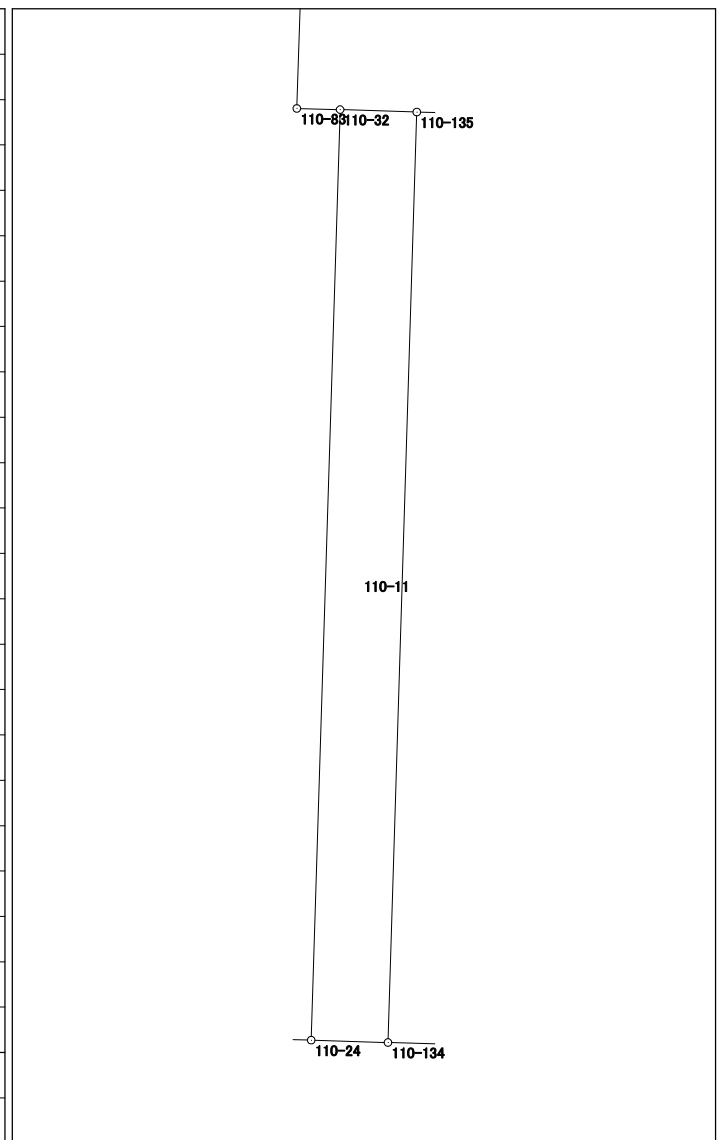


面積計算書（座標法）

世界測地系（測地成果2011）

所 在	地 番	公簿地目	現況地目	地 積	所 有 者
前橋市六供町四丁目	110-12-1			46.38 m ²	

点 名	X 座標	Y 座標	辺 長	方 向 角	測 角	DX	倍 積 (Y×DX)
110-25	41255.391	-67668.730	2.726	91-53-30	90-06-54	-17.079	1155714.239670
110-74	41255.301	-67666.005	17.000	1-47-36	89-54-06	16.902	-1143690.816510
110-80	41272.293	-67665.473	2.731	271-49-31	90-01-55	17.079	-1155658.613367
110-136	41272.380	-67668.203	16.997	181-46-36	89-57-05	-16.902	1143727.967106
						倍面積	92.776899
						面 積	46.3884495

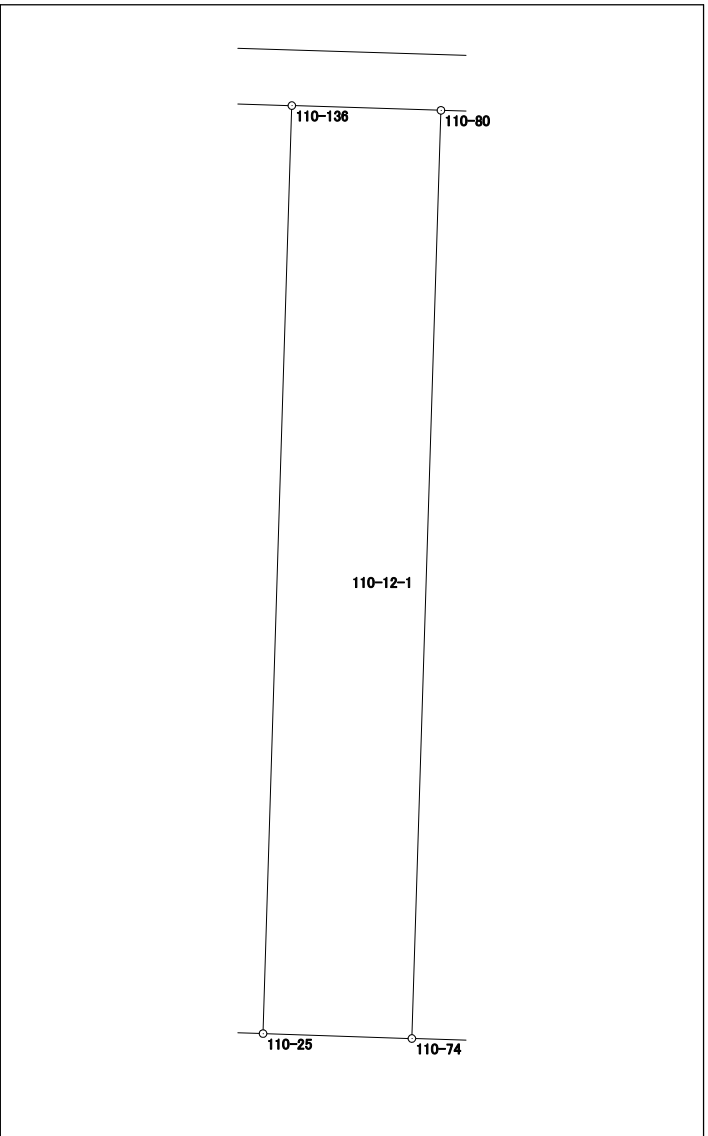


面積計算書（座標法）

世界測地系（測地成果2011）

所 在	地 番	公簿地目	現況地目	地 積	所 有 者
前橋市六供町四丁目	110-14-1			83.02 m ²	

点 名	X 座標	Y 座標	辺 長	方 向 角	測 角	DX	倍 積 (Y×DX)
110-41	41287.633	-67684.720	6.641	181-49-45	90-02-57	-6.324	428038.169280
110-76	41280.995	-67684.932	12.522	91-42-58	89-53-13	-7.013	474674.428116
110-78	41280.620	-67672.416	6.634	1-42-37	89-59-39	6.256	-423358.634496
110-77	41287.251	-67672.218	0.235	270-14-38	88-32-01	6.632	-448802.149776
110-30	41287.252	-67672.453	0.853	271-44-45	181-30-07	0.027	-1827.156231
110-102	41287.278	-67673.306	0.262	271-44-56	180-00-11	0.034	-2300.892404
110-104	41287.286	-67673.568	1.049	271-48-13	180-03-17	0.041	-2774.616288
110-106	41287.319	-67674.616	10.109	271-46-48	179-58-35	0.347	-23483.091752
						倍面積	166.056449
						面 積	83.0282245

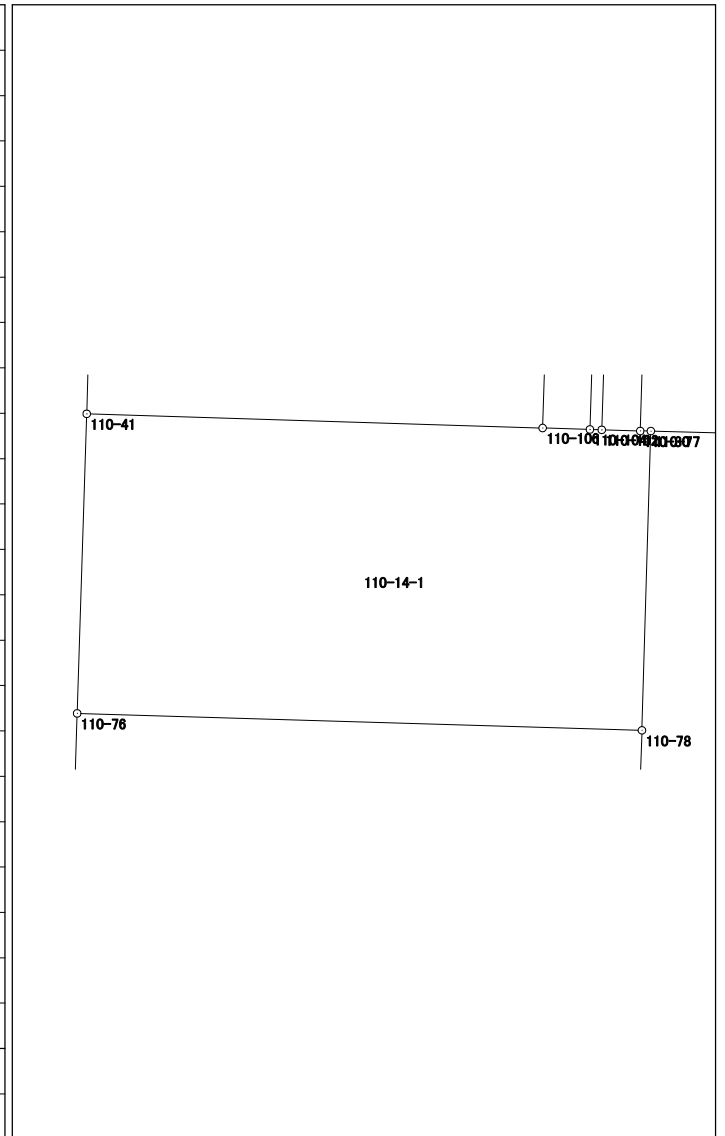


面積計算書（座標法）

世界測地系（測地成果2011）

所在	地番	公簿地目	現況地目	地積	所有者
前橋市六供町四丁目	110-14-2			25.60 m ²	

点名	X座標	Y座標	辺長	方向角	測角	Dx	倍積 (Y×Dx)
110-109	41278.576	-67672.476	2.045	1-40-53	89-57-56	1.669	-112945.362444
110-78	41280.620	-67672.416	12.522	271-42-58	90-02-05	2.419	-163699.574304
110-76	41280.995	-67684.932	2.045	181-45-55	90-02-57	-1.669	112966.151508
110-110	41278.951	-67684.995	12.525	91-42-57	89-57-02	-2.419	163730.002905
倍面積							51.217665
面積							25.6088325

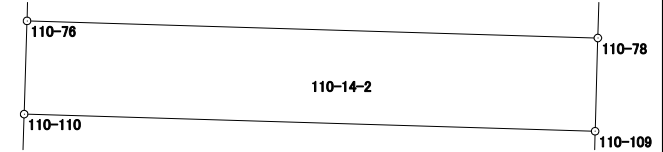


面積計算書（座標法）

世界測地系（測地成果2011）

所 在	地 番	公簿地目	現況地目	地 積	所 有 者
前橋市六供町四丁目	110-14-3			168.03 m ²	

点 名	X 座標	Y 座標	辺 長	方 向 角	測 角	DX	倍 積 (Y×DX)
110-75	41275.918	-67685.088	1.998	181-41-32	89-58-53	-1.623	109852.897824
110-140	41273.921	-67685.147	22.930	91-46-10	90-04-38	-2.705	183088.322635
110-139	41273.213	-67662.228	13.737	1-45-22	89-59-12	13.023	-881165.195244
110-138	41286.944	-67661.807	1.363	271-40-56	89-55-34	13.771	-931770.744197
110-112	41286.984	-67663.169	9.053	271-41-24	180-00-28	0.307	-20772.592883
110-77	41287.251	-67672.218	6.634	181-42-37	90-01-13	-6.364	430665.995352
110-78	41280.620	-67672.416	2.045	181-40-53	179-58-16	-8.675	587058.208800
110-109	41278.576	-67672.476	3.033	181-42-01	180-01-08	-5.076	343505.488176
110-79	41275.544	-67672.566	12.528	271-42-39	270-00-38	-2.658	179873.680428

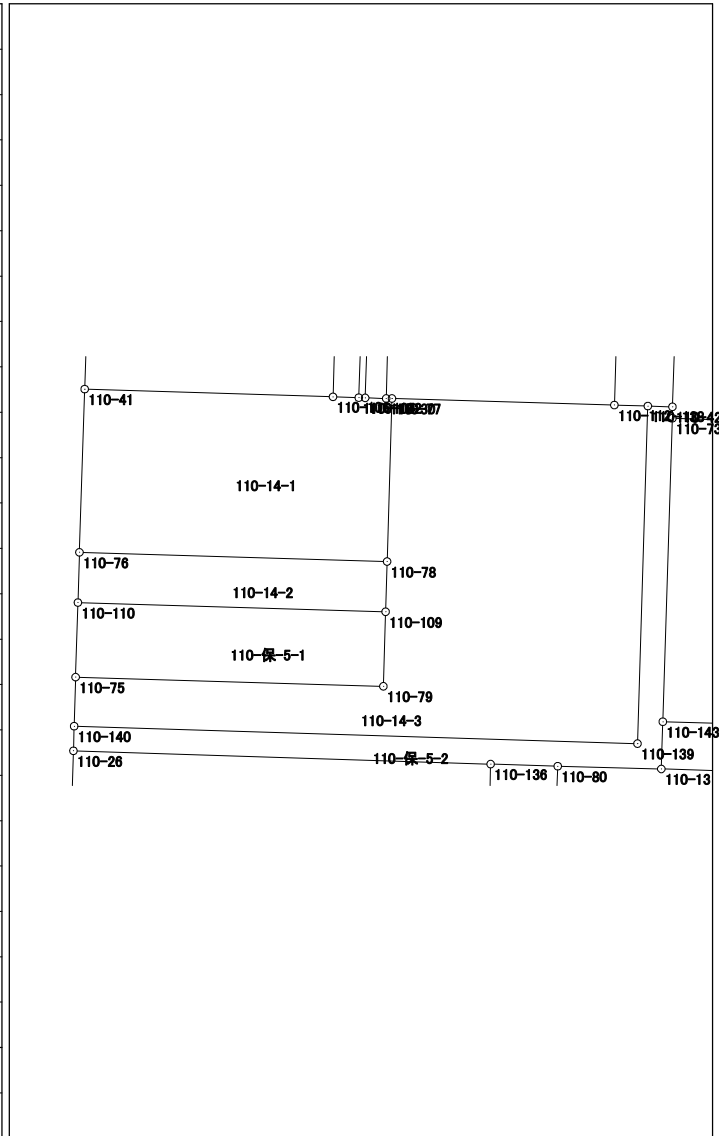


倍面積	336.060891
面 積	168.0304455

面積計算書（座標法）

世界測地系（測地成果2011）

所在	地番	公簿地目	現況地目	地積	所有者
前橋市六供町四丁目	110-15			15.99 m ²	

点名	X座標	Y座標	辺長	方向角	測角	DX	倍積 (Y×DX)
110-104	41287.286	-67673.568	15.251	1-45-03	89-56-50	15.211	-1029382.642848
110-103	41302.530	-67673.102	1.049	271-48-13	90-03-10	15.277	-1033841.979254
110-105	41302.563	-67674.150	11.291	181-45-03	89-56-50	-11.253	761537.209950
110-107	41291.277	-67674.495	3.960	181-45-04	180-00-01	-15.244	1031630.001780
110-106	41287.319	-67674.616	1.049	91-48-13	90-03-09	-3.991	270089.392456
倍面積							31.982084
面積							15.9910420

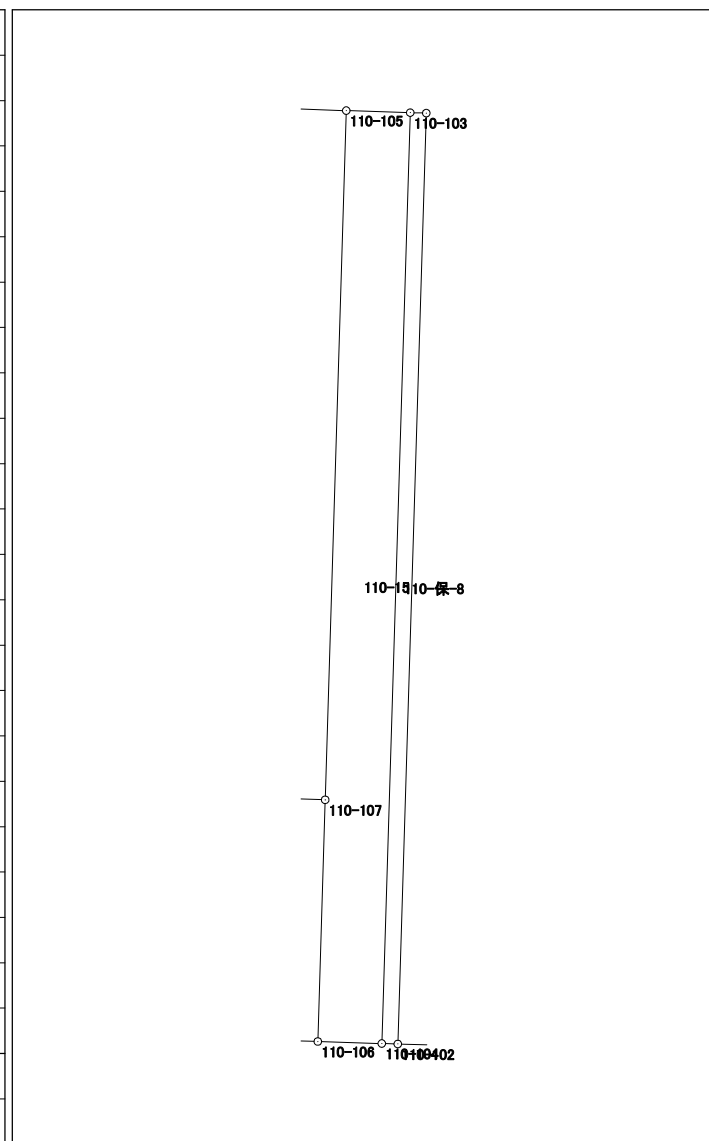


面積計算書 (座標法)

世界測地系 (測地成果2011)

所在	地番	公簿地目	現況地目	地積	所有者
前橋市六供町四丁目	110-16			141.55 m ²	

点名	X座標	Y座標	辺長	方向角	測角	D _X	倍積 (Y×D _X)
110-111	41302.207	-67662.699	9.292	271-46-34	90-00-28	15.511	-1049516.124189
110-29	41302.495	-67671.987	15.250	181-45-04	89-58-30	-14.955	1012034.565585
110-30	41287.252	-67672.453	0.235	90-14-38	88-29-34	-15.244	1031598.873532
110-77	41287.251	-67672.218	9.053	91-41-24	181-26-46	-0.268	18136.154424
110-112	41286.984	-67663.169	15.230	1-46-06	90-04-42	14.956	-1011970.355564
						倍面積	283.113788
						面積	141.5568940

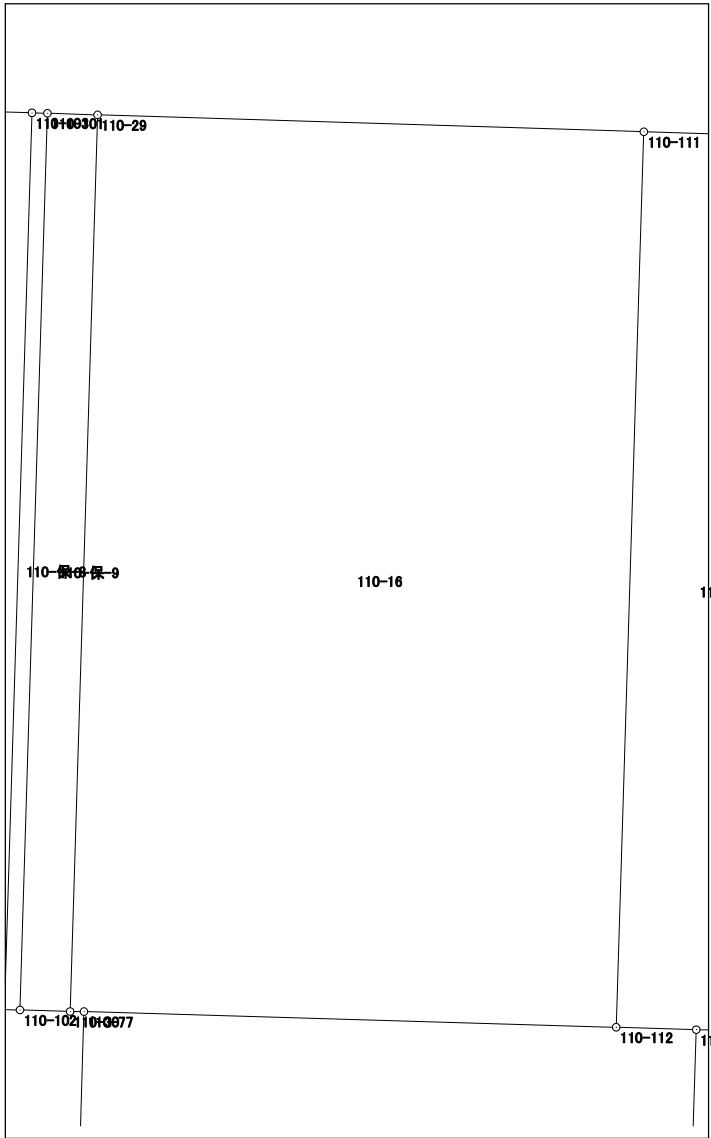


面積計算書 (座標法)

世界測地系 (測地成果2011)

所在	地番	公簿地目	現況地目	地積	所有者
前橋市六供町四丁目	110-19-1			172.89 m ²	

点名	X座標	Y座標	辺長	方向角	測角	DX	倍積 (Y×DX)
110-53	41301.128	-67628.378	14.968	181-46-07	89-58-00	-14.613	988253.487714
110-52	41286.167	-67628.840	0.418	271-38-40	269-52-33	-14.949	1010983.529160
110-141	41286.179	-67629.258	0.728	181-48-34	90-09-54	-0.716	48422.548728
110-94	41285.451	-67629.281	2.504	91-48-28	89-59-54	-0.807	54576.829767
110-95	41285.372	-67626.778	8.835	91-48-11	179-59-43	-0.357	24142.759746
110-97	41285.094	-67617.947	15.699	2-18-13	90-30-02	15.408	-1041857.327376
110-16	41300.780	-67617.316	11.067	271-48-07	89-29-54	16.034	-1084176.044744

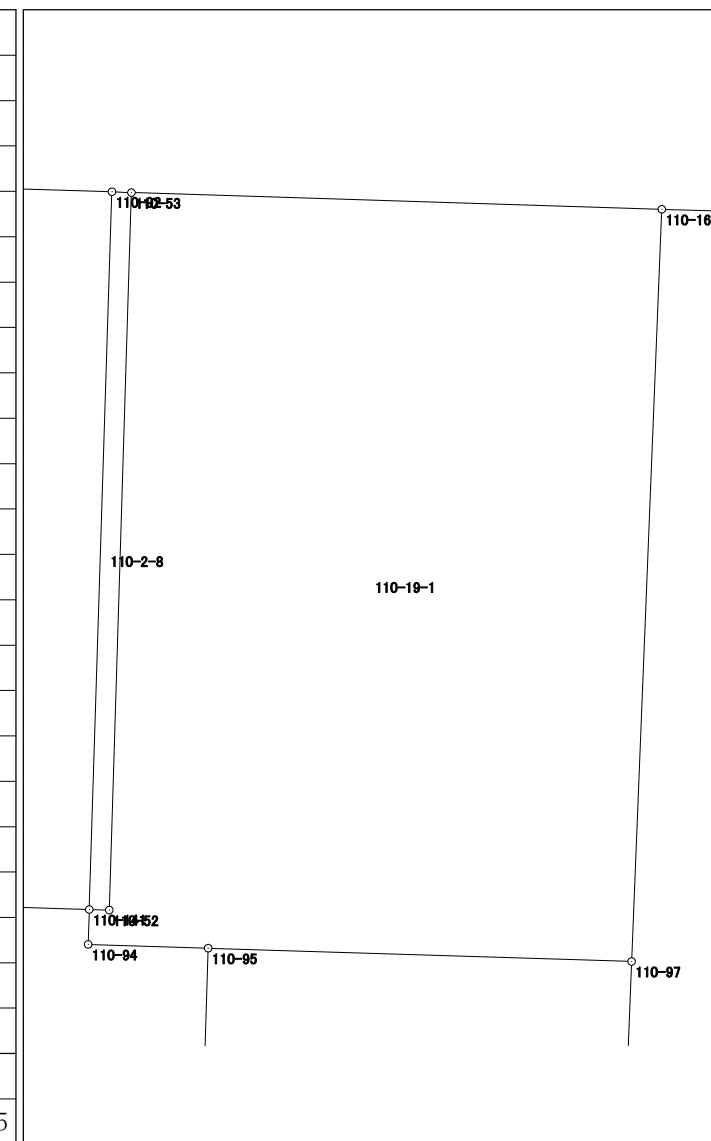


倍面積	345.782995
面積	172.8914975

面積計算書（座標法）

世界測地系（測地成果2011）

所 在	地 番	公簿地目	現況地目	地 積	所 有 者
前橋市六供町四丁目	110-19-2			152.37 m ²	

点 名	X 座標	Y 座標	辺 長	方 向 角	測 角	DX	倍 積 (Y×DX)
110-95	41285.372	-67626.778	10.329	181-48-51	90-00-40	-10.046	679378.611788
110-147	41275.048	-67627.105	12.239	91-45-55	89-57-04	-10.701	723677.650605
110-146	41274.671	-67614.872	0.656	2-21-38	90-35-43	0.278	-18796.934416
110-39	41275.326	-67614.845	1.791	2-24-02	180-02-24	2.444	-165250.681180
110-58	41277.115	-67614.770	14.691	92-19-02	269-55-00	1.195	-80799.650150
110-57	41276.521	-67600.091	2.913	2-20-27	90-01-25	2.317	-156629.410847
110-17	41279.432	-67599.972	13.879	272-19-14	89-58-47	3.473	-234774.702756
110-118	41279.994	-67613.840	4.311	272-18-48	179-59-34	0.736	-49763.786240
110-38	41280.168	-67618.147	4.930	2-19-30	270-00-42	5.100	-344852.549700
110-97	41285.094	-67617.947	8.835	271-48-11	89-28-41	5.204	-351883.796188
						倍面積	304.750916
						面 積	152.3754580

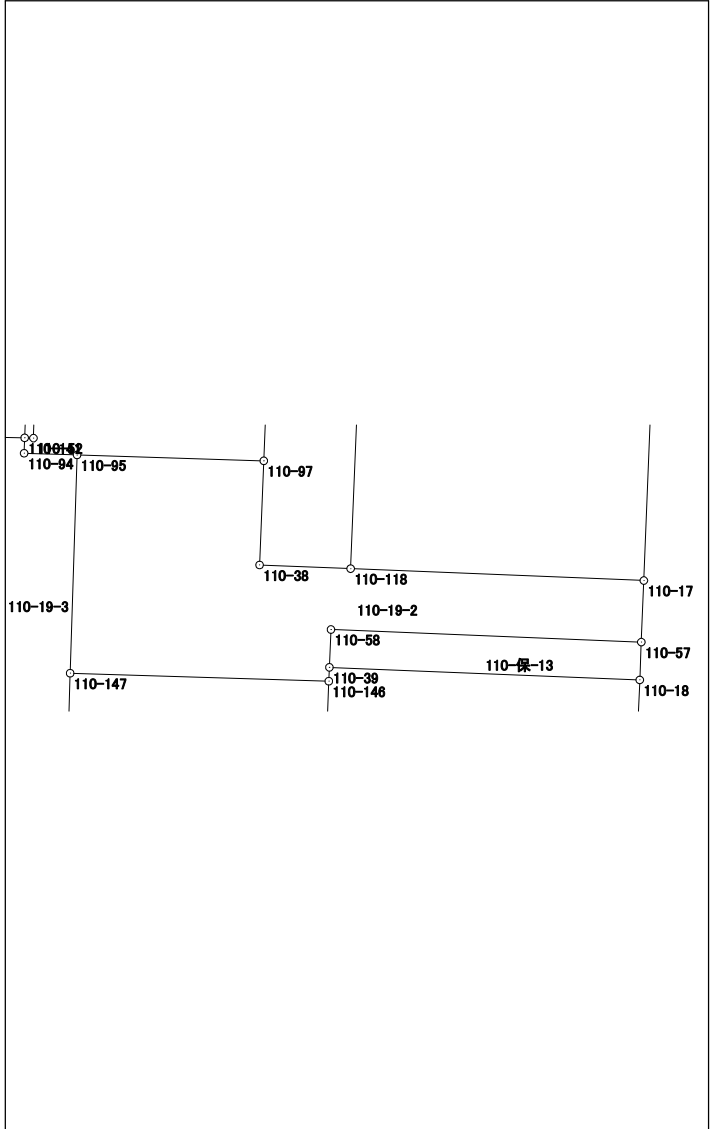


面積計算書 (座標法)

所在	地番	公簿地目	現況地目	地積	所有者
前橋市六供町四丁目	110-19-3			89.51 m ²	

点名	X座標	Y座標	辺長	方向角	測角	DX	倍積 (Y×DX)
110-51	41286.281	-67632.844	14.993	181-48-42	90-10-57	-14.884	1006647.250096
110-49	41271.295	-67633.318	1.408	91-40-09	89-51-27	-15.027	1016325.869586
110-132	41271.254	-67631.911	4.237	91-40-38	180-00-29	-0.165	11159.265315
110-35	41271.130	-67627.676	0.447	91-01-31	179-20-53	-0.132	8926.853232
110-96	41271.122	-67627.229	3.928	1-48-33	90-47-02	3.918	-264963.483222
110-147	41275.048	-67627.105	10.329	1-48-51	180-00-18	14.250	-963686.246250
110-95	41285.372	-67626.778	2.504	271-48-28	89-59-37	10.403	-703521.371534
110-94	41285.451	-67629.281	0.728	1-48-34	270-00-06	0.807	-54576.829767
110-141	41286.179	-67629.258	3.587	271-37-45	89-49-11	0.830	-56132.284140

倍面積	179.023316
面積	89.5116580

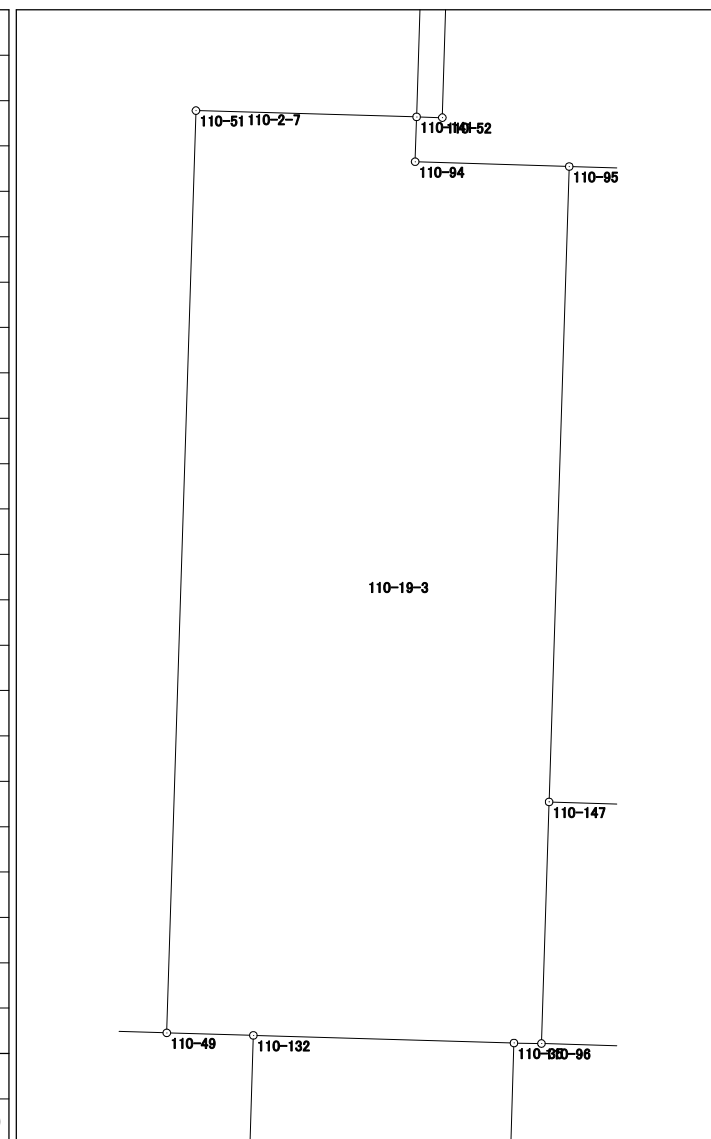


面積計算書 (座標法)

世界測地系 (測地成果2011)

所在	地番	公簿地目	現況地目	地積	所有者
前橋市六供町四丁目	110-保-1			89.00 m ²	

点名	X座標	Y座標	辺長	方向角	測角	DX	倍積 (Y×DX)
110-16	41300.780	-67617.316	15.699	182-18-13	90-36-08	-15.558	1051990.202328
110-97	41285.094	-67617.947	4.930	182-19-30	180-01-17	-20.612	1393741.123564
110-38	41280.168	-67618.147	4.311	92-18-48	89-59-18	-5.100	344852.549700
110-118	41279.994	-67613.840	20.675	2-18-33	89-59-45	20.484	-1385001.898560
110-119	41300.652	-67613.007	4.311	271-42-05	89-23-32	20.786	-1405403.963502
						倍面積	178.013530
						面積	89.0067650

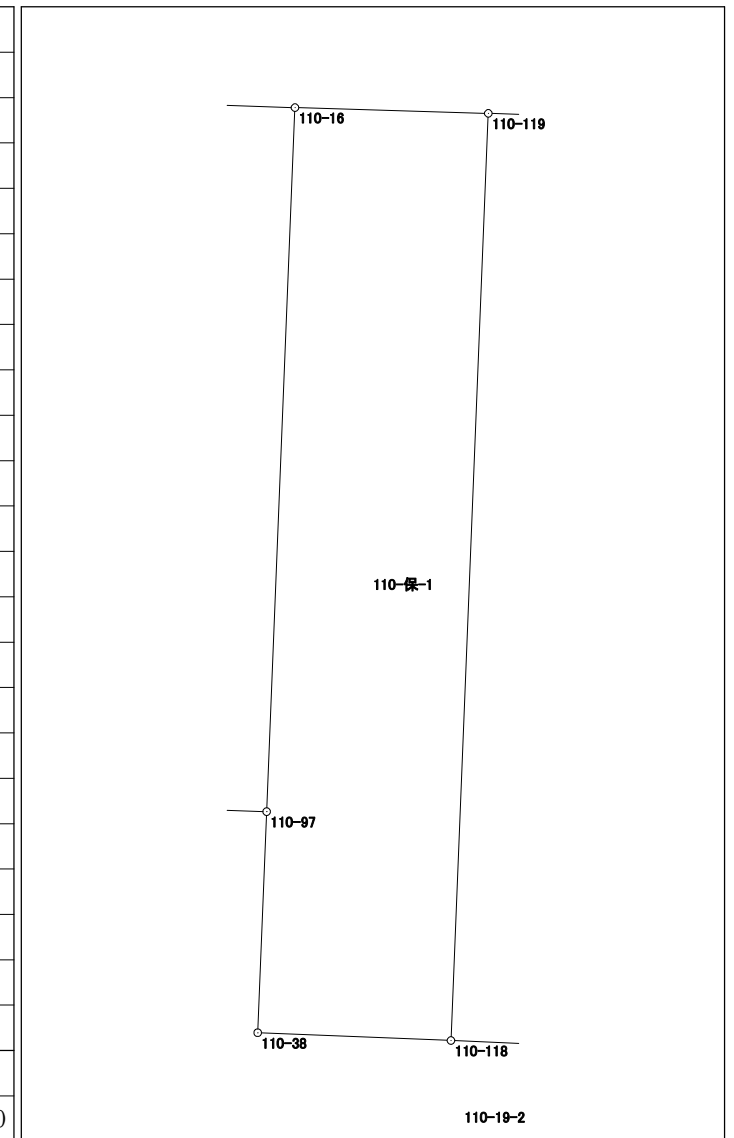

面積計算書 (座標法)

世界測地系 (測地成果2011)

所 在	地 番	公簿地目	現況地目	地 積	所 有 者
前橋市六供町四丁目	110-保-2			105.00 m ²	


点 名	X 座標	Y 座標	辺 長	方 向 角	測 角	DX	倍 積 (Y×DX)				
110-20	41253.751	-67615.716	11.861	91-49-17	89-31-36	-7.789	526658.811924				
110-6	41253.374	-67603.861	4.030	47-03-04	135-13-47	2.369	-160153.546709				
110-5	41256.120	-67600.911	4.580	2-17-24	135-14-20	7.322	-494973.870342				
110-120	41260.696	-67600.728	14.698	271-49-15	89-31-51	5.043	-340910.471304				
110-121	41261.163	-67615.419	7.418	182-17-41	90-28-26	-6.945	469589.084955				
										倍面積	210.008524
										面 積	105.0042620

面積計算書 (座標法)

世界測地系 (測地成果2011)

所 在	地 番	公簿地目	現況地目	地 積	所 有 者
前橋市六供町四丁目	110-保-3			69.00 m ²	

点 名	X 座標	Y 座標	辺 長	方 向 角	測 角	DX	倍 積 (Y×DX)
110-123	41270.340	-67615.051	0.407	2-15-05	179-57-18	9.584	-648022.648784
110-37	41270.747	-67615.035	1.500	271-43-10	89-28-05	0.452	-30561.995820
110-124	41270.792	-67616.534	8.500	182-17-33	90-34-23	-8.448	571224.479232
110-125	41262.299	-67616.874	5.099	272-17-34	270-00-01	-8.289	560476.268586
110-126	41262.503	-67621.969	8.554	182-17-29	89-59-55	-8.343	564170.087367
110-127	41253.956	-67622.311	6.598	91-46-50	89-29-21	-8.752	591830.465872
110-20	41253.751	-67615.716	7.418	2-17-41	90-30-51	7.207	-487306.465212
110-121	41261.163	-67615.419	9.184	2-17-47	180-00-06	16.589	-1121672.185791
倍面積							138.005450
面 積							69.0027250

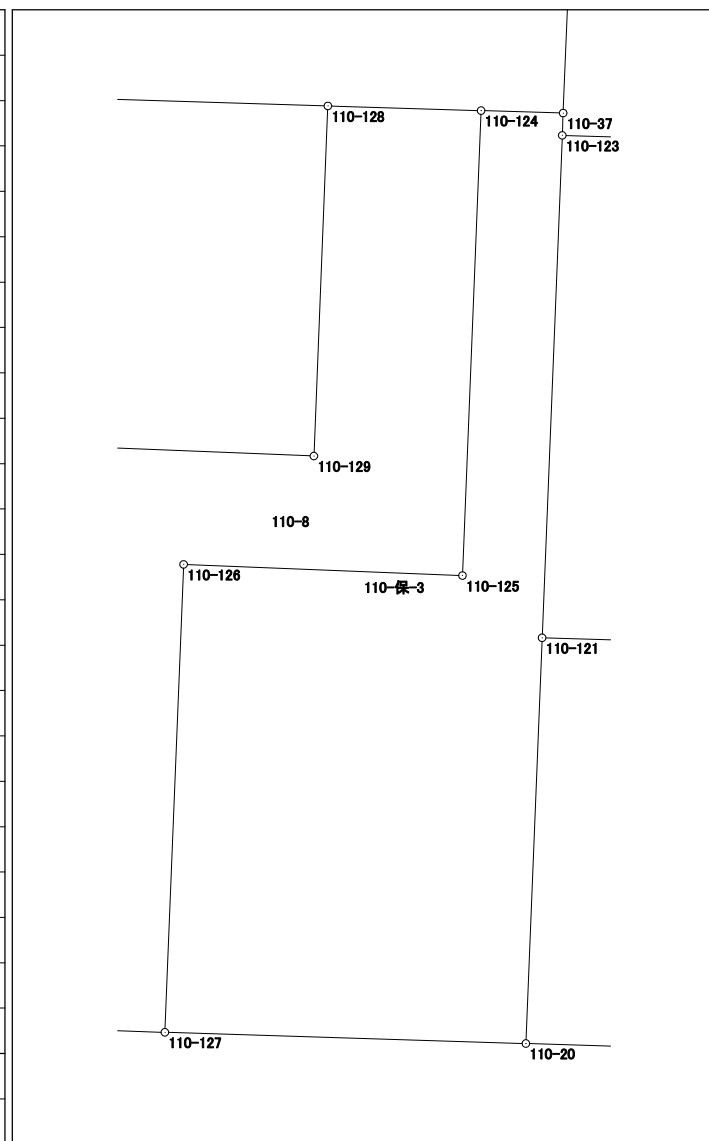


面積計算書（座標法）

世界測地系（測地成果2011）

所 在	地 番	公簿地目	現況地目	地 積	所 有 者
前橋市六供町四丁目	110-保-4			72.00 m ²	

点 名	X 座標	Y 座標	辺 長	方 向 角	測 角	DX	倍 積 (Y×DX)
110-22	41254.139	-67628.195	16.999	1-44-59	89-59-28	16.861	-1140278.995895
110-35	41271.130	-67627.676	4.237	271-40-38	89-55-39	17.115	-1157447.674740
110-132	41271.254	-67631.911	16.993	181-44-49	90-04-11	-16.861	1140341.651371
110-133	41254.269	-67632.429	4.236	91-45-31	90-00-42	-17.115	1157529.022335

倍面積	144.003071
面 積	72.0015355

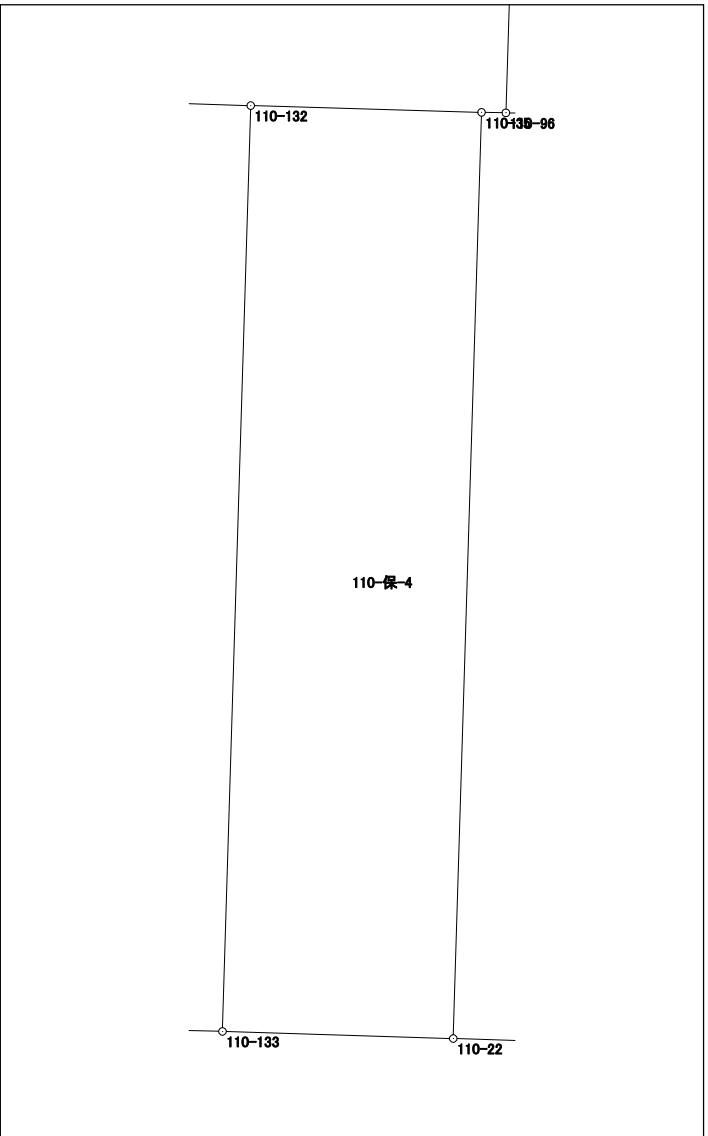


面積計算書（座標法）

世界測地系（測地成果2011）

所在	地番	公簿地目	現況地目	地積	所有者
前橋市六供町四丁目	110-保-5-1			38.00 m ²	

点名	X座標	Y座標	辺長	方向角	測角	DX	倍積(Y×DX)
110-75	41275.918	-67685.088	12.528	91-42-39	89-57-16	-3.407	230603.094816
110-79	41275.544	-67672.566	3.033	1-42-01	89-59-22	2.658	-179873.680428
110-109	41278.576	-67672.476	12.525	271-42-57	90-00-56	3.407	-230560.125732
110-110	41278.951	-67684.995	3.034	181-45-23	90-02-26	-2.658	179906.716710

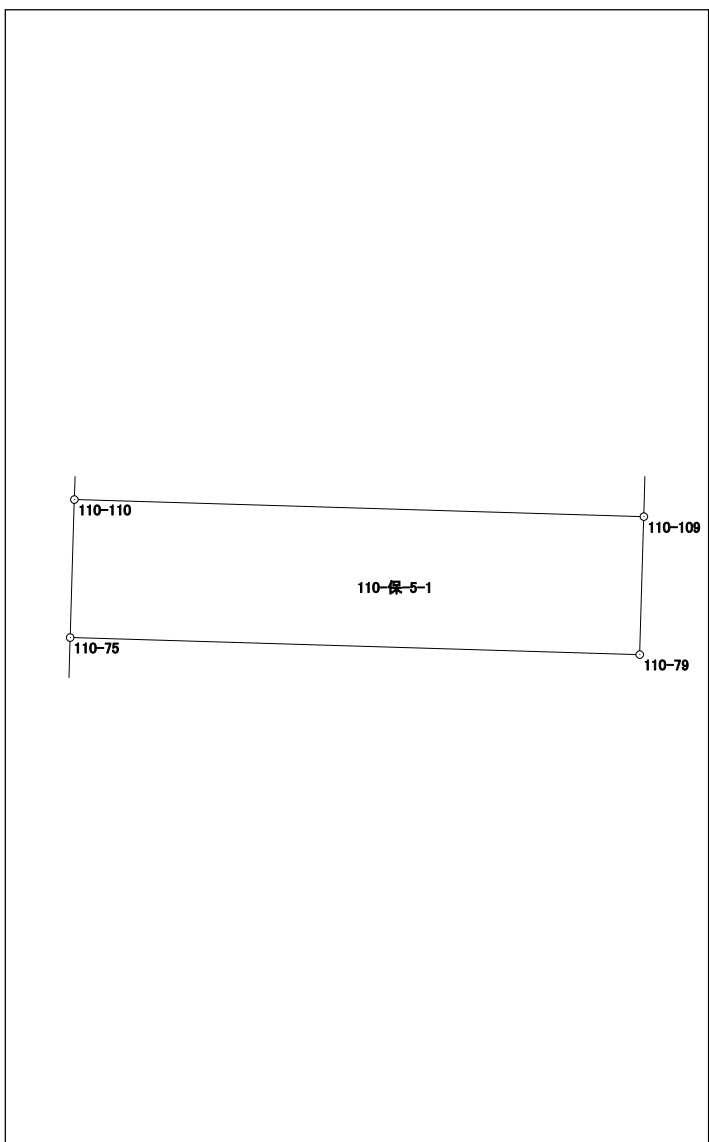


倍面積	76.005366
面積	38.0026830

面積計算書 (座標法)

世界測地系 (測地成果2011)

所在	地番	公簿地目	現況地目	地積	所有者
前橋市六供町四丁目	110-保-5-2			38.00 m ²	

点名	X座標	Y座標	辺長	方向角	測角	DX	倍積 (Y×DX)
110-140	41273.921	-67685.147	1.001	181-43-00	89-56-50	-0.293	19831.748071
110-26	41272.920	-67685.177	16.983	91-49-20	90-06-20	-1.541	104302.857757
110-136	41272.380	-67668.203	2.731	91-49-31	180-00-11	-0.627	42427.963281
110-80	41272.293	-67665.473	4.216	91-29-42	179-40-11	-0.197	13330.098181
110-13	41272.183	-67661.258	1.922	1-47-20	90-17-38	1.811	-122534.538238
110-143	41274.104	-67661.198	12.350	1-48-01	180-00-41	14.265	-965186.989470
110-73	41286.448	-67660.810	0.466	0-29-30	178-41-29	12.810	-866734.976100
110-42	41286.914	-67660.806	1.001	271-43-00	91-13-30	0.496	-33559.759776
110-138	41286.944	-67661.807	13.737	181-45-22	90-02-22	-13.701	927034.417707
110-139	41273.213	-67662.228	22.930	271-46-10	270-00-48	-13.023	881165.195244

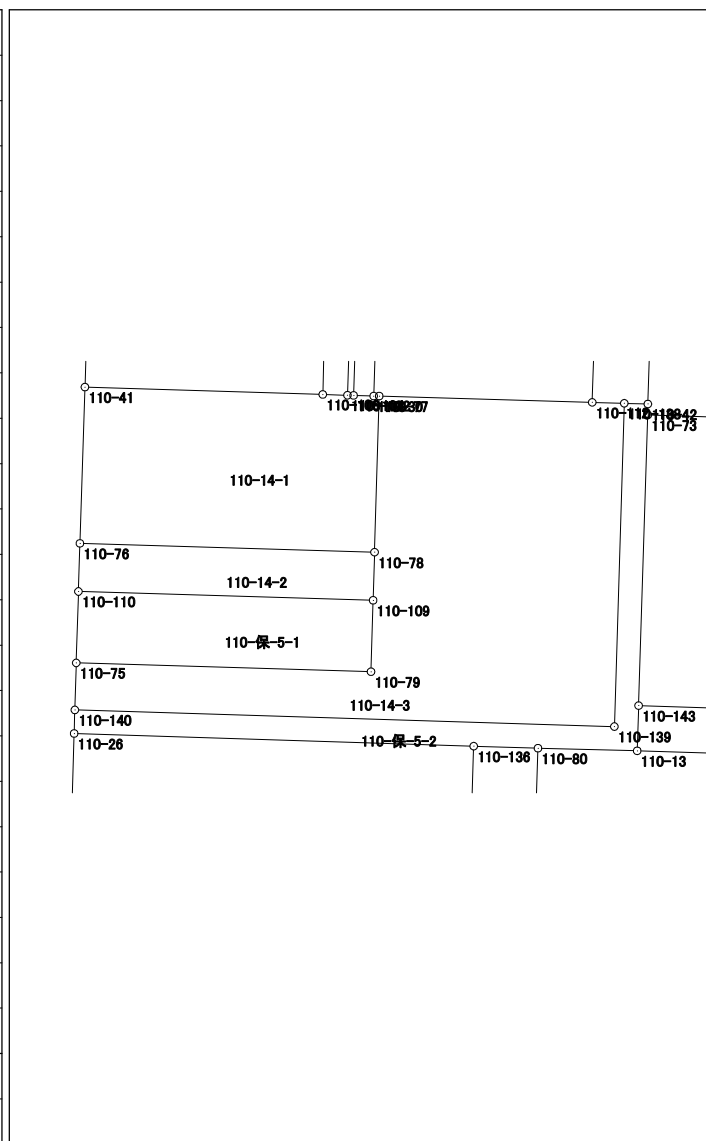

倍面積	76.016657
面積	38.0083285

面積計算書 (座標法)

世界測地系 (測地成果2011)

所在	地番	公簿地目	現況地目	地積	所有者
前橋市六供町四丁目	110-保-6			40.00 m ²	

点名	X座標	Y座標	辺長	方向角	測角	DX	倍積 (Y×DX)	<p>The diagram shows a closed polygon representing the land plot. The vertices are labeled as follows: 110-106 (top-left), 110-107 (top-right), 110-108 (bottom-left), 110-41 (bottom-right), 110-104 (bottom-right), 110-106 (bottom-right), 110-107 (bottom-right), 110-108 (bottom-right), 110-41 (bottom-right). The plot is labeled '110-保-6' in the center.</p>
110-106	41287.319	-67674.616	3.960	1-45-04	89-58-16	3.644	-246606.300704	
110-107	41291.277	-67674.495	10.107	271-45-07	90-00-03	4.267	-288767.070165	
110-108	41291.586	-67684.597	3.955	181-46-56	90-01-49	-3.644	246642.671468	
110-41	41287.633	-67684.720	10.109	91-46-48	89-59-52	-4.267	288810.700240	
						倍面積	80.000839	
						面積	40.0004195	


面積計算書 (座標法)

世界測地系 (測地成果2011)

所 在	地 番	公簿地目	現況地目	地 積	所 有 者
前橋市六供町四丁目	110-保-7			36.00 m ²	

点 名	X 座標	Y 座標	辺 長	方 向 角	測 角	DX	倍 積 (Y×DX)
110-42	41286.914	-67660.806	15.227	1-46-08	90-03-08	15.190	-1027767.643140
110-14	41302.134	-67660.336	2.364	271-46-10	90-00-02	15.293	-1034729.518448
110-111	41302.207	-67662.699	15.230	181-46-06	89-59-56	-15.150	1025089.889850
110-112	41286.984	-67663.169	1.363	91-40-56	89-54-50	-15.263	1032742.948447
110-138	41286.944	-67661.807	1.001	91-43-00	180-02-04	-0.070	4736.326490

倍面積	72.003199
面 積	36.0015995

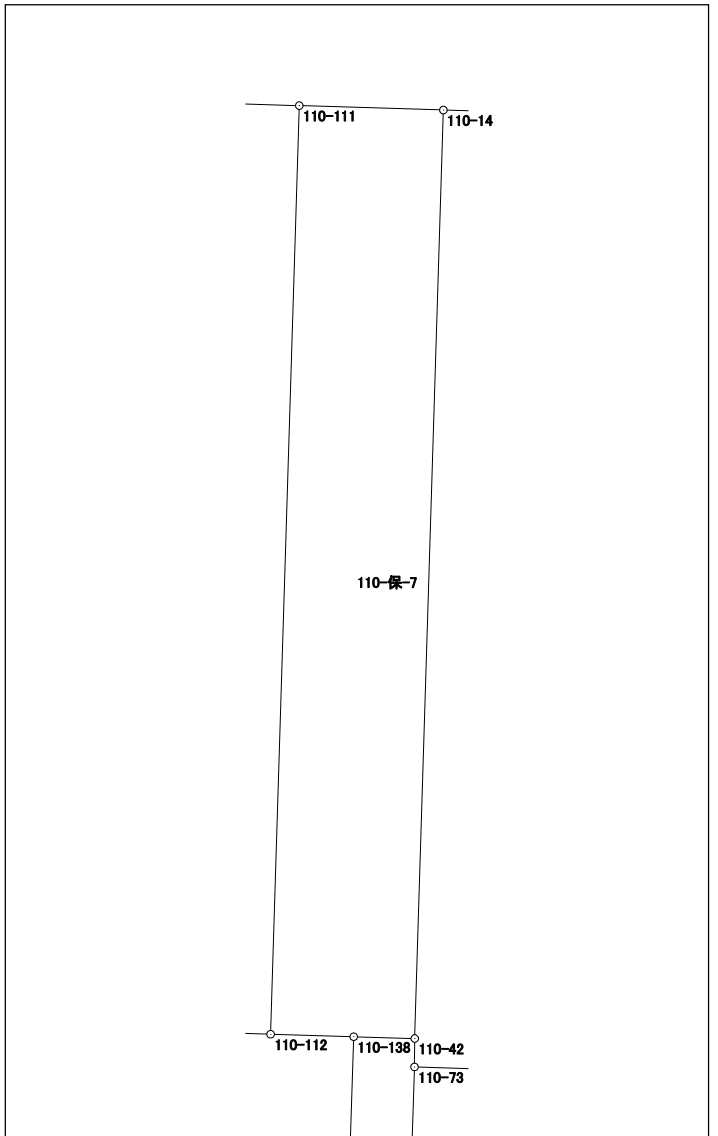


面積計算書 (座標法)

世界測地系 (測地成果2011)

所 在	地 番	公簿地目	現況地目	地 積	所 有 者
前橋市六供町四丁目	110-保-8			4.00 m ²	

点 名	X 座標	Y 座標	辺 長	方 向 角	測 角	DX	倍 積 (Y×DX)
110-101	41302.522	-67672.839	0.263	271-44-32	89-59-15	15.252	-1032146.140428
110-103	41302.530	-67673.102	15.251	181-45-03	90-00-31	-15.236	1031067.382072
110-104	41287.286	-67673.568	0.262	91-44-56	89-59-53	-15.252	1032157.259136
110-102	41287.278	-67673.306	15.251	1-45-17	90-00-21	15.236	-1031070.490216
						倍面積	8.010564
						面 積	4.0052820

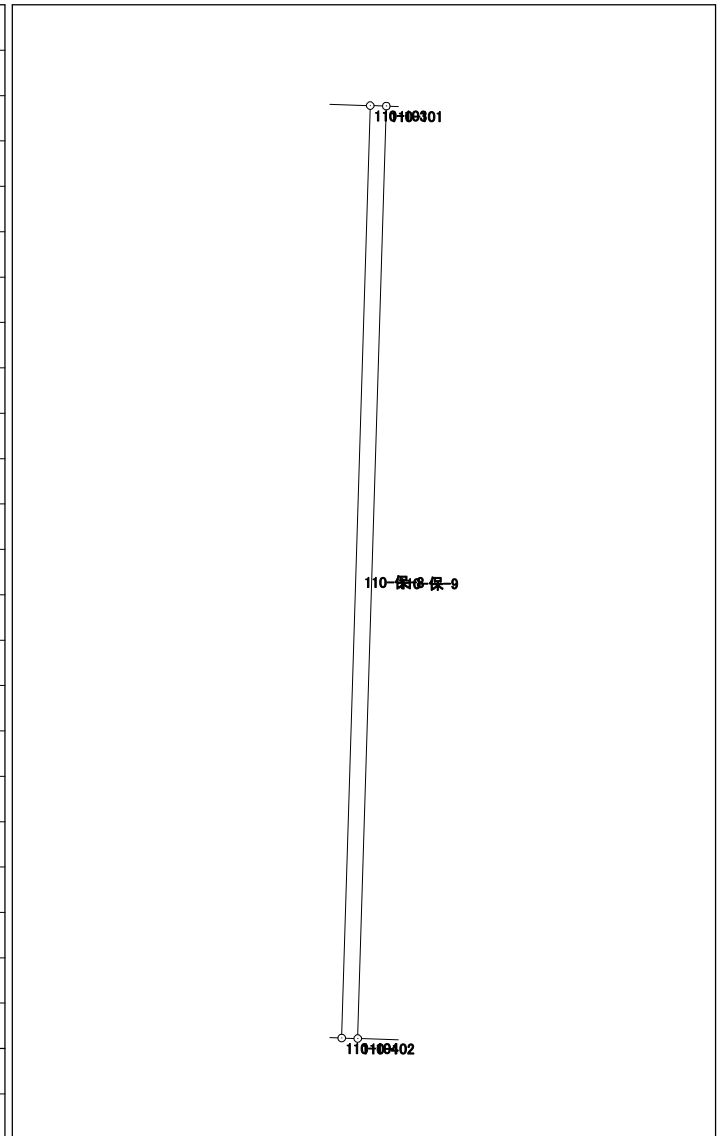


面積計算書（座標法）

世界測地系（測地成果2011）

所在	地番	公簿地目	現況地目	地積	所有者
前橋市六供町四丁目	110-保-9			13.00 m ²	

点名	X座標	Y座標	辺長	方向角	測角	DX	倍積 (Y×DX)
110-30	41287.252	-67672.453	15.250	1-45-04	90-00-19	15.217	-1029771.717301
110-29	41302.495	-67671.987	0.852	271-48-54	90-03-50	15.270	-1033351.241490
110-101	41302.522	-67672.839	15.251	181-45-17	89-56-23	-15.217	1029777.591063
110-102	41287.278	-67673.306	0.853	91-44-45	89-59-28	-15.270	1033371.382620
						倍面積	26.014892
						面積	13.0074460

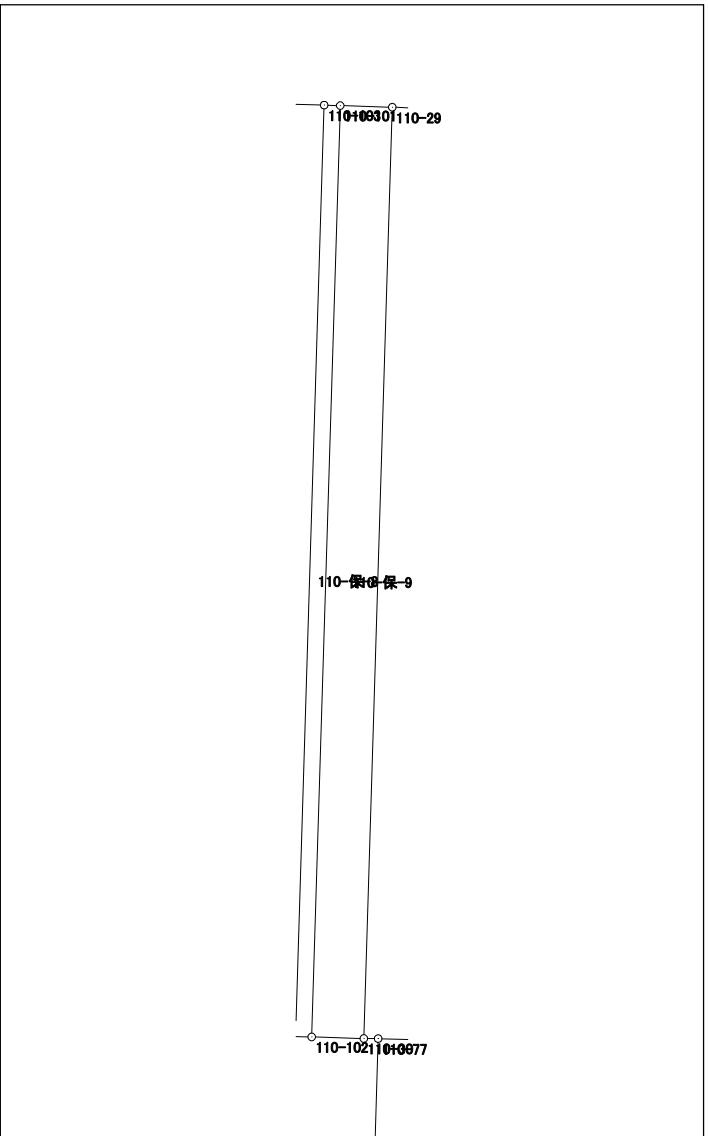

面積計算書（座標法）

世界測地系（測地成果2011）

所 在	地 番	公簿地目	現況地目	地 積	所 有 者
前橋市六供町四丁目	110-保-10			25.00 m ²	

点 名	X 座標	Y 座標	辺 長	方 向 角	測 角	DX	倍 積 (Y×DX)	
110-13	41272.183	-67661.258	13.013	91-48-35	90-01-15	-2.332	157786.053656	<p style="font-size: small;">Diagram showing the land plot with vertices 110-13, 110-142, 110-143, and 110-139. The plot is labeled '110-保-10'.</p>
110-83	41271.772	-67648.251	1.921	1-49-11	90-00-36	1.509	-102081.210759	
110-142	41273.692	-67648.190	13.015	271-48-51	89-59-40	2.332	-157755.579080	
110-143	41274.104	-67661.198	1.922	181-47-20	89-58-29	-1.509	102100.747782	
						倍面積	50.011599	
						面 積	25.0057995	

面積計算書（座標法）

世界測地系（測地成果2011）

所 在	地 番	公簿地目	現況地目	地 積	所 有 者
前橋市六供町四丁目	110-保-13			26.29 m ²	

点 名	X 座標	Y 座標	辺 長	方 向 角	測 角	DX	倍 積 (Y×DX)	
110-58	41277.115	-67614.770	1.791	182-24-02	90-05-00	-1.195	80799.650150	
110-39	41275.326	-67614.845	14.692	92-18-48	89-54-46	-2.382	161058.560790	
110-18	41274.733	-67600.165	1.790	2-22-12	90-03-24	1.195	-80782.197175	
110-57	41276.521	-67600.091	14.691	272-19-02	89-56-50	2.382	-161023.416762	
						倍面積	52.597003	
						面 積	26.2985015	