



111-1街区 画地出来形確認図 (3028.63m²)

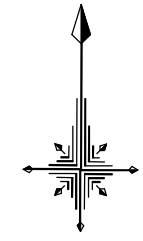

S=1/500

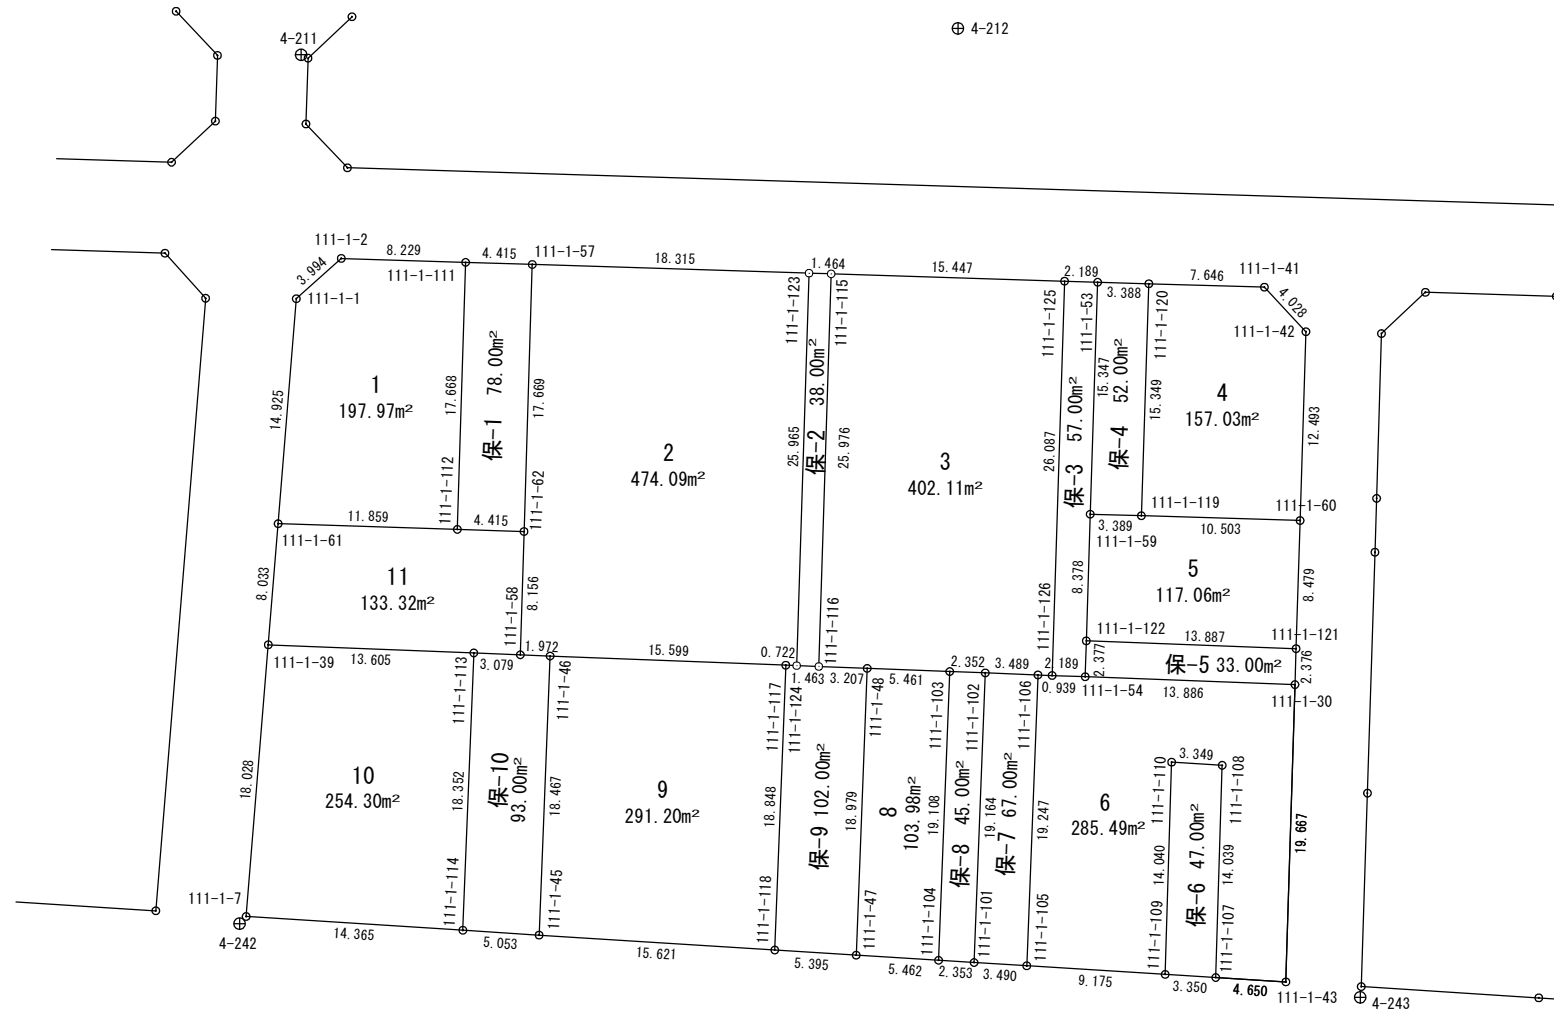


3. 3. 10江田天川大島線

面積計算書 (座標法)

世界測地系 (測地成果2011)

| 所在 | 地番 | 公簿地目 | 現況地目 | 地積 | 所有者 |
|-----------|---------|------|------|-----------------------|-----|
| 前橋市六供町四丁目 | 111-1-1 | | | 197.97 m ² | |

| 点名 | X座標 | Y座標 | 辺長 | 方向角 | 測角 | DX | 倍積 (Y×DX) |
|-----------|-----------|------------|--------|-----------|-----------|---------|-----------------|
| 111-1-112 | 41215.930 | -67676.123 | 17.668 | 1-46-39 | 89-57-21 | 17.282 | -1169578.757686 |
| 111-1-111 | 41233.589 | -67675.575 | 8.229 | 271-48-38 | 90-01-59 | 17.919 | -1212678.628425 |
| 111-1-2 | 41233.849 | -67683.800 | 3.994 | 228-08-46 | 136-20-08 | -2.405 | 162779.539000 |
| 111-1-1 | 41231.184 | -67686.775 | 14.925 | 184-36-55 | 136-28-09 | -17.542 | 1187361.407050 |
| 111-1-61 | 41216.307 | -67687.976 | 11.859 | 91-49-18 | 87-12-23 | -15.254 | 1032512.385904 |
| | | | | | | | |
| | | | | | | | |
| | | | | | | 倍面積 | 395.945843 |
| | | | | | | 面積 | 197.9729215 |

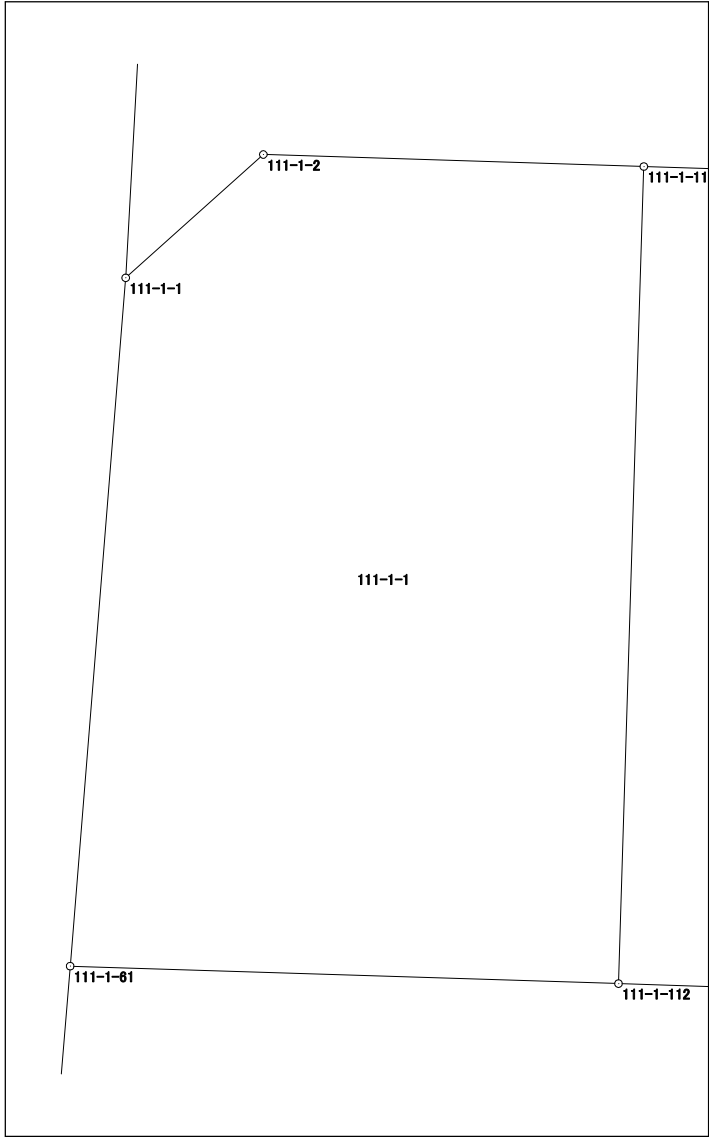


面積計算書 (座標法)

世界測地系 (測地成果2011)

| 所在 | 地番 | 公簿地目 | 現況地目 | 地積 | 所有者 |
|-----------|---------|------|------|-----------------------|-----|
| 前橋市六供町四丁目 | 111-1-2 | | | 474.09 m ² | |

| 点名 | X座標 | Y座標 | 辺長 | 方向角 | 測角 | DX | 倍積 (Y×DX) |
|-----------|-----------|------------|--------|-----------|-----------|---------|-----------------|
| 111-1-57 | 41233.450 | -67671.162 | 17.669 | 181-46-38 | 89-58-30 | -17.084 | 1156094.131608 |
| 111-1-62 | 41215.790 | -67671.710 | 8.156 | 181-43-17 | 179-56-39 | -25.812 | 1746742.178520 |
| 111-1-58 | 41207.638 | -67671.955 | 1.972 | 92-24-45 | 90-41-28 | -8.235 | 557278.549425 |
| 111-1-46 | 41207.555 | -67669.985 | 15.599 | 92-13-22 | 179-48-37 | -0.688 | 46556.949680 |
| 111-1-117 | 41206.950 | -67654.398 | 0.723 | 92-13-15 | 179-59-53 | -0.633 | 42825.233934 |
| 111-1-124 | 41206.922 | -67653.676 | 25.965 | 1-48-35 | 89-35-20 | 25.924 | -1753853.896624 |
| 111-1-123 | 41232.874 | -67652.856 | 18.315 | 271-48-08 | 89-59-33 | 26.528 | -1794694.963968 |
| | | | | | | | |
| | | | | | | | |
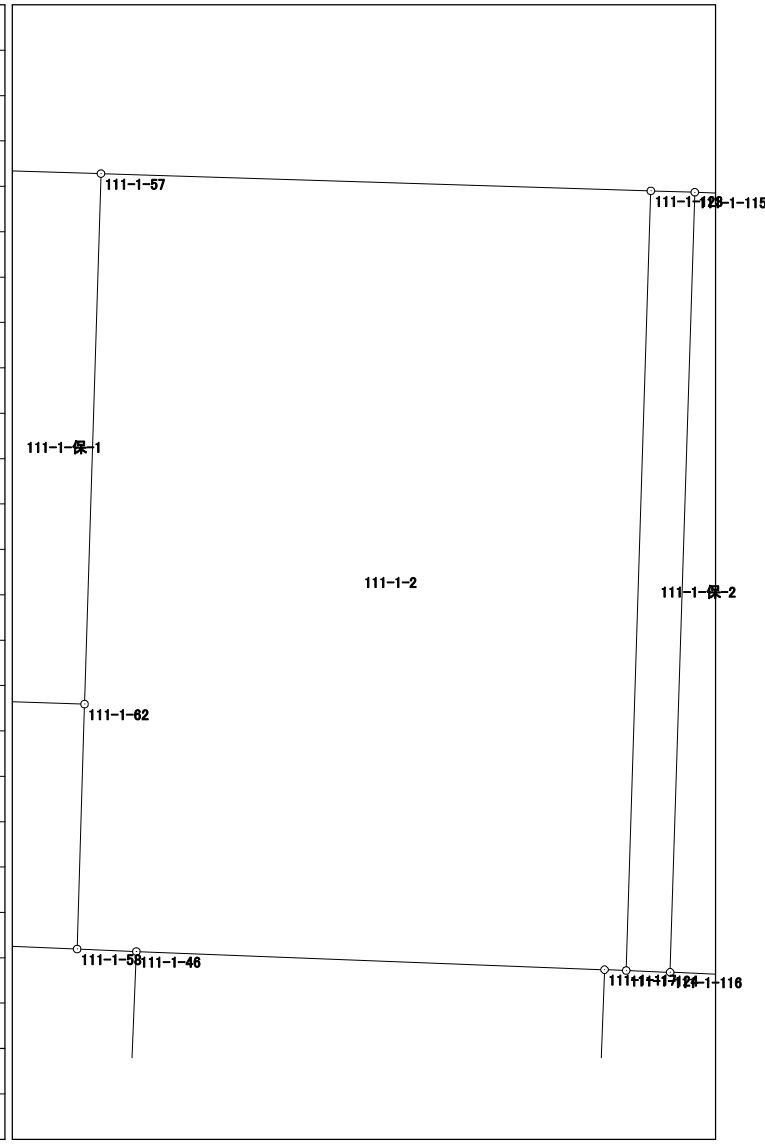

| | |
|-----|-------------|
| 倍面積 | 948.182575 |
| 面積 | 474.0912875 |

面積計算書 (座標法)

世界測地系 (測地成果2011)

| | | | | | |
|-----------|---------|------|------|-----------------------|-----|
| 所在 | 地番 | 公簿地目 | 現況地目 | 地積 | 所有者 |
| 前橋市六供町四丁目 | 111-1-3 | | | 402.11 m ² | |


| 点名 | X座標 | Y座標 | 辺長 | 方向角 | 測角 | DX | 倍積 (Y×DX) | |
|-----------|-----------|------------|--------|-----------|-----------|---------|-----------------|---|
| 111-1-125 | 41232.343 | -67635.954 | 15.447 | 271-47-57 | 89-59-21 | 26.559 | -1796343.302286 | |
| 111-1-115 | 41232.828 | -67651.393 | 25.976 | 181-48-40 | 90-00-43 | -25.478 | 1723622.190854 | |
| 111-1-116 | 41206.865 | -67652.214 | 3.207 | 92-14-01 | 90-25-21 | -26.088 | 1764910.958832 | |
| 111-1-48 | 41206.740 | -67649.009 | 5.461 | 92-12-14 | 179-58-13 | -0.335 | 22662.418015 | |
| 111-1-103 | 41206.530 | -67643.552 | 2.352 | 92-11-36 | 179-59-22 | -0.300 | 20293.065600 | |
| 111-1-102 | 41206.440 | -67641.202 | 3.489 | 92-12-05 | 180-00-29 | -0.224 | 15151.629248 | |
| 111-1-106 | 41206.306 | -67637.716 | 0.939 | 92-15-32 | 180-03-27 | -0.171 | 11566.049436 | |
| 111-1-126 | 41206.269 | -67636.778 | 26.087 | 1-48-36 | 89-33-04 | 26.037 | -1761058.788786 | |
| | | | | | | | | <div style="display: flex; justify-content: space-between; padding: 0 10px;"> 111-1-保-2 111-1-3 111-1-保-3 </div> |
| | | | | | | | | |
| | | | | | | | | |
| 倍面積 | | | | | | | 804.220913 | |
| 面積 | | | | | | | 402.1104565 | |

面積計算書 (座標法)

世界測地系 (測地成果2011)

| | | | | | |
|-----------|---------|------|------|-----------------------|-----|
| 所在 | 地番 | 公簿地目 | 現況地目 | 地積 | 所有者 |
| 前橋市六供町四丁目 | 111-1-4 | | | 157.03 m ² | |

| 点名 | X座標 | Y座標 | 辺長 | 方向角 | 測角 | DX | 倍積 (Y×DX) |
|-----------|-----------|------------|--------|-----------|-----------|---------|-----------------|
| 111-1-120 | 41232.174 | -67630.379 | 15.349 | 181-50-40 | 90-09-03 | -15.115 | 1022233.178585 |
| 111-1-119 | 41216.833 | -67630.873 | 10.503 | 91-43-47 | 89-53-07 | -15.658 | 1058964.209434 |
| 111-1-60 | 41216.516 | -67620.375 | 12.493 | 1-46-31 | 90-02-44 | 12.170 | -822939.963750 |
| 111-1-42 | 41229.003 | -67619.988 | 4.028 | 316-58-55 | 135-12-24 | 15.432 | -1043511.654816 |
| 111-1-41 | 41231.948 | -67622.736 | 7.646 | 271-41-37 | 134-42-42 | 3.171 | -214431.695856 |
| | | | | | | | |
| | | | | | | | |
| | | | | | | 倍面積 | 314.073597 |
| | | | | | | 面積 | 157.0367985 |

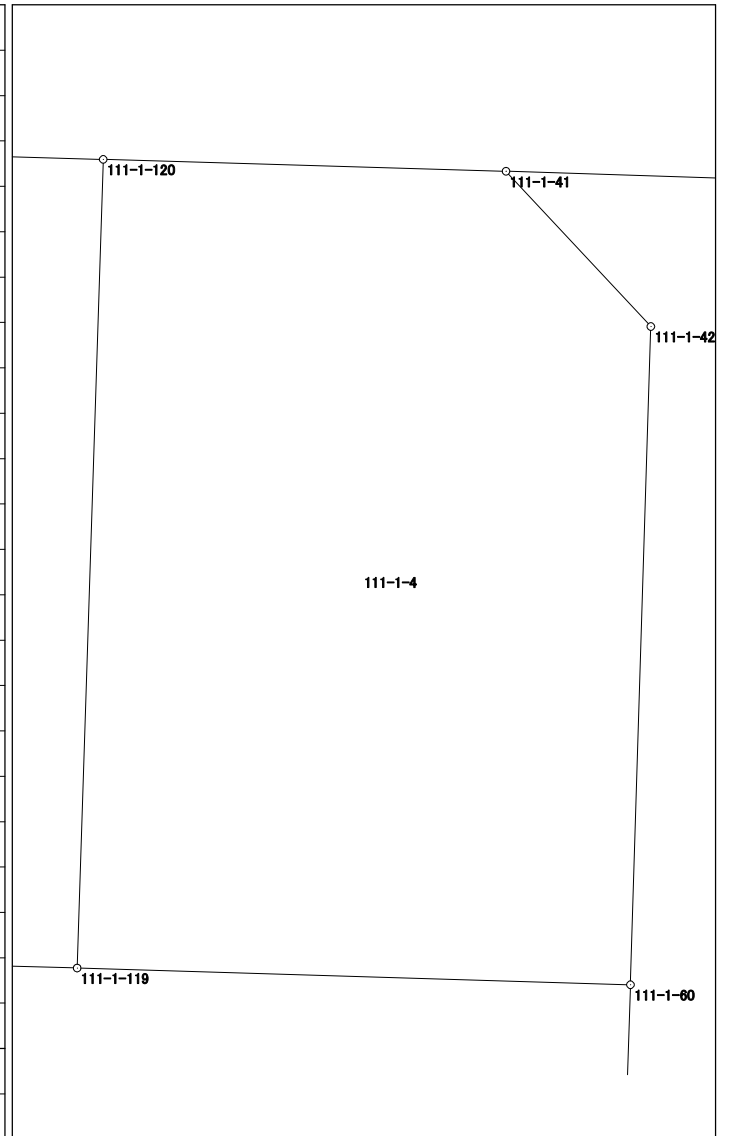


面積計算書 (座標法)

世界測地系 (測地成果2011)

| 所在 | 地番 | 公簿地目 | 現況地目 | 地積 | 所有者 |
|-----------|---------|------|------|-----------------------|-----|
| 前橋市六供町四丁目 | 111-1-5 | | | 117.06 m ² | |

| 点名 | X座標 | Y座標 | 辺長 | 方向角 | 測角 | DX | 倍積 (Y×DX) |
|-----------|-----------|------------|--------|-----------|-----------|--------|----------------|
| 111-1-122 | 41208.561 | -67634.517 | 13.887 | 92-08-46 | 90-23-18 | -8.894 | 601541.394198 |
| 111-1-121 | 41208.041 | -67620.640 | 8.479 | 1-47-27 | 89-38-41 | 7.955 | -537922.191200 |
| 111-1-60 | 41216.516 | -67620.375 | 10.503 | 271-43-47 | 89-56-20 | 8.792 | -594518.337000 |
| 111-1-119 | 41216.833 | -67630.873 | 3.389 | 271-43-30 | 179-59-43 | 0.419 | -28337.335787 |
| 111-1-59 | 41216.935 | -67634.260 | 8.378 | 181-45-28 | 90-01-58 | -8.272 | 559470.598720 |
| | | | | | | | |
| | | | | | | | |
| 倍面積 | | | | | | | 234.128931 |
| 面積 | | | | | | | 117.0644655 |

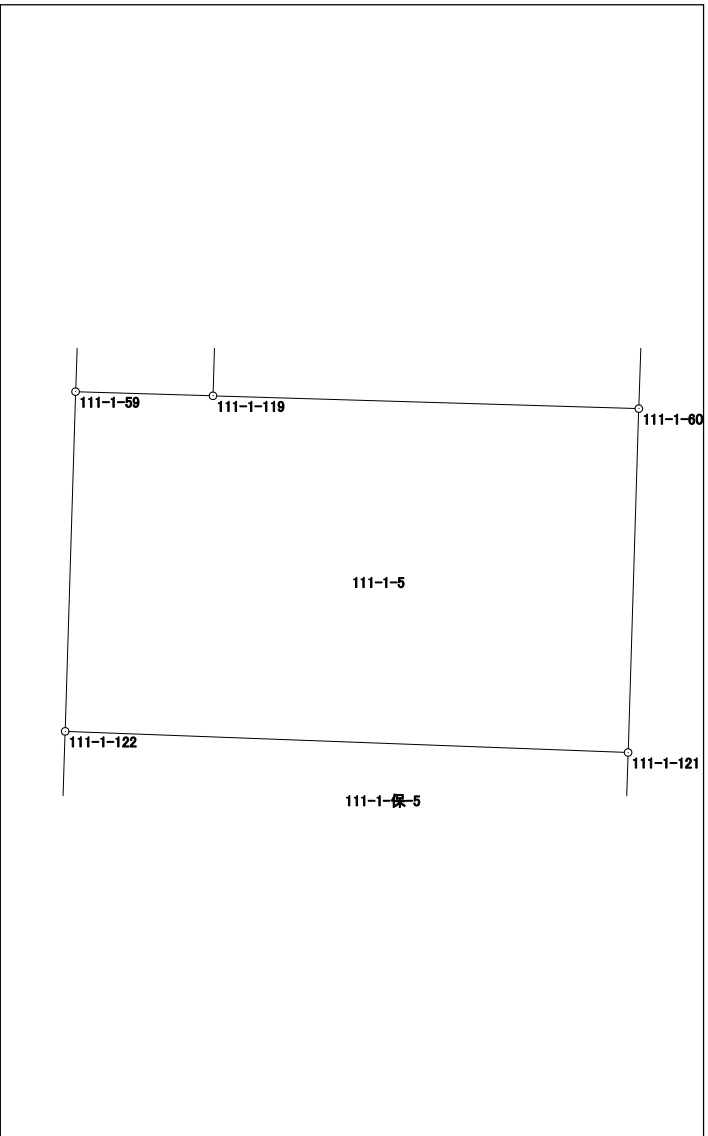


面積計算書（座標法）

世界測地系（測地成果2011）

| 所在 | 地番 | 公簿地目 | 現況地目 | 地積 | 所有者 |
|-----------|---------|------|------|-----------------------|-----|
| 前橋市六供町四丁目 | 111-1-6 | | | 285.49 m ² | |

| 点名 | X座標 | Y座標 | 辺長 | 方向角 | 測角 | DX | 倍積(Y×DX) |
|-----------|-----------|------------|--------|-----------|-----------|---------|-----------------|
| 111-1-107 | 41186.296 | -67625.956 | 4.650 | 93-33-03 | 91-48-29 | -14.321 | 968471.315876 |
| 111-1-43 | 41186.008 | -67621.315 | 19.667 | 1-44-54 | 88-11-51 | 19.370 | -1309824.871550 |
| 111-1-30 | 41205.666 | -67620.715 | 13.886 | 272-08-31 | 90-23-37 | 20.177 | -1364383.166555 |
| 111-1-54 | 41206.185 | -67634.591 | 2.189 | 272-11-58 | 180-03-27 | 0.603 | -40783.658373 |
| 111-1-126 | 41206.269 | -67636.778 | 0.939 | 272-15-32 | 180-03-34 | 0.121 | -8184.050138 |
| 111-1-106 | 41206.306 | -67637.716 | 19.247 | 182-12-23 | 89-56-51 | -19.196 | 1298373.596336 |
| 111-1-105 | 41187.073 | -67638.457 | 9.175 | 93-33-20 | 91-20-57 | -19.802 | 1339376.725514 |
| 111-1-109 | 41186.504 | -67629.300 | 14.040 | 1-44-49 | 88-11-29 | 13.464 | -910560.895200 |
| 111-1-110 | 41200.537 | -67628.872 | 3.349 | 93-33-37 | 271-48-48 | 13.825 | -934969.155400 |
| 111-1-108 | 41200.329 | -67625.529 | 14.039 | 181-44-34 | 268-10-57 | -14.241 | 963055.158489 |
| | | | | | | | |
| | | | | | | | |
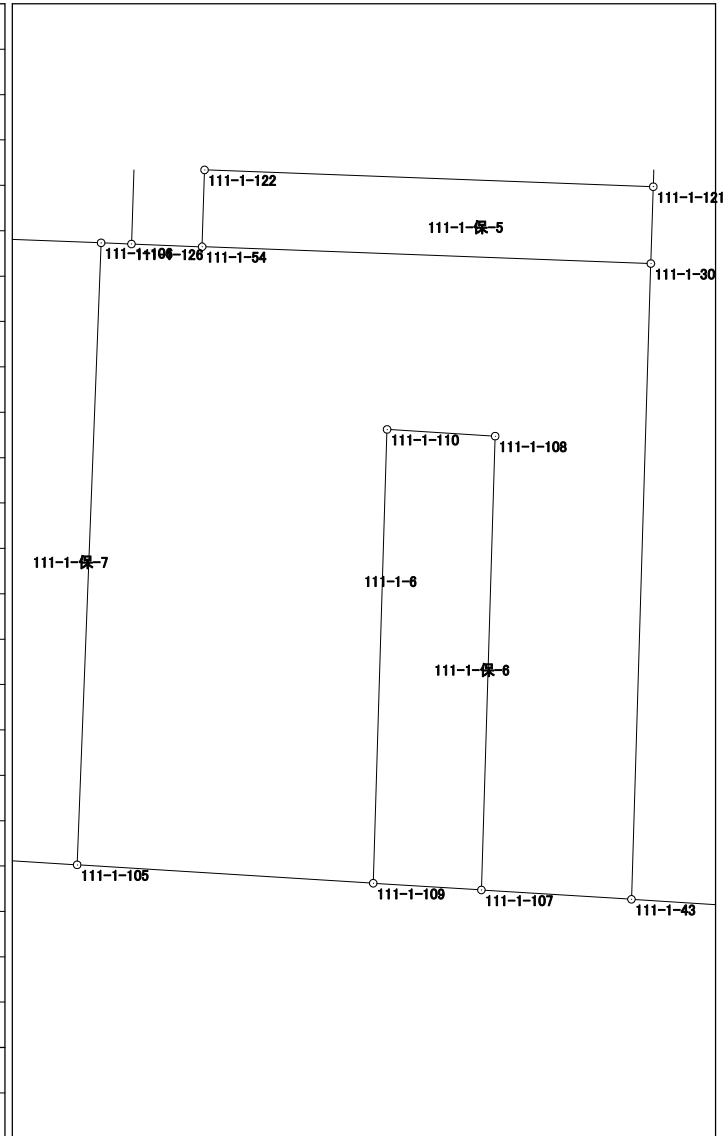


| | |
|-----|-------------|
| 倍面積 | 570.998999 |
| 面積 | 285.4994995 |

面積計算書（座標法）

世界測地系（測地成果2011）

| | | | | | |
|-----------|---------|------|------|-----------------------|-------|
| 所 在 | 地 番 | 公簿地目 | 現況地目 | 地 積 | 所 有 者 |
| 前橋市六供町四丁目 | 111-1-8 | | | 103.98 m ² | |

| 点 名 | X 座標 | Y 座標 | 辺 長 | 方 向 角 | 測 角 | DX | 倍 積 (Y×DX) |
|-----------|-----------|------------|--------|-----------|----------|---------|-----------------|
| 111-1-104 | 41187.436 | -67644.288 | 19.108 | 2-12-27 | 88-38-56 | 18.755 | -1268668.621440 |
| 111-1-103 | 41206.530 | -67643.552 | 5.461 | 272-12-14 | 89-59-47 | 19.304 | -1305791.127808 |
| 111-1-48 | 41206.740 | -67649.009 | 18.979 | 182-12-16 | 90-00-02 | -18.755 | 1268757.163795 |
| 111-1-47 | 41187.775 | -67649.739 | 5.462 | 93-33-31 | 91-21-15 | -19.304 | 1305910.561656 |
| | | | | | | | |
| | | | | | | | |
| | | | | | | 倍面積 | 207.976203 |
| | | | | | | 面 積 | 103.9881015 |

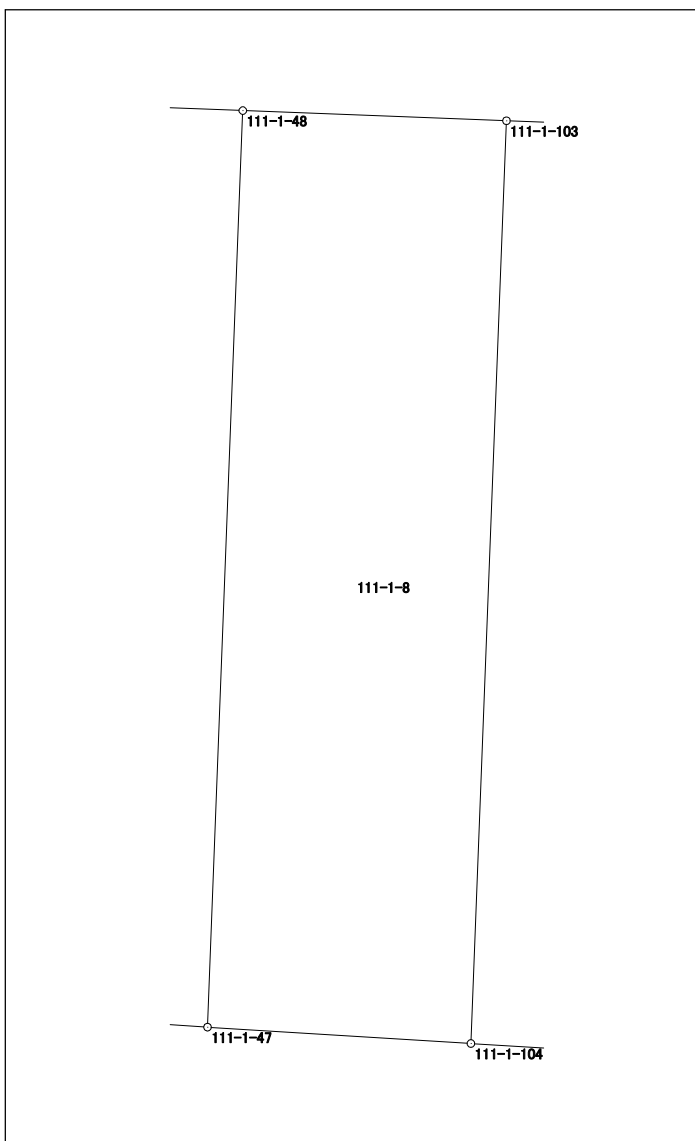

面積計算書（座標法）

世界測地系（測地成果2011）

| | | | | | |
|-----------|---------|------|------|-----------------------|-------|
| 所 在 | 地 番 | 公簿地目 | 現況地目 | 地 積 | 所 有 者 |
| 前橋市六供町四丁目 | 111-1-9 | | | 291.20 m ² | |


| 点 名 | X 座標 | Y 座標 | 辺 長 | 方 向 角 | 測 角 | DX | 倍 積 (Y×DX) | |
|-----------|-----------|------------|--------|-----------|----------|---------|-----------------|-------------|
| 111-1-118 | 41188.116 | -67655.123 | 18.848 | 2-12-16 | 88-35-08 | 17.848 | -1207508.635304 | |
| 111-1-117 | 41206.950 | -67654.398 | 15.599 | 272-13-22 | 90-01-06 | 19.439 | -1315133.842722 | |
| 111-1-46 | 41207.555 | -67669.985 | 18.467 | 182-15-33 | 90-02-11 | -17.848 | 1207773.892280 | |
| 111-1-45 | 41189.102 | -67670.713 | 15.621 | 93-37-08 | 91-21-35 | -19.439 | 1315450.990007 | |
| | | | | | | | | |
| | | | | | | | | |
| | | | | | | | 倍面積 | 582.404261 |
| | | | | | | | 面 積 | 291.2021305 |

面積計算書 (座標法)

世界測地系 (測地成果2011)

| 所在 | 地番 | 公簿地目 | 現況地目 | 地積 | 所有者 |
|-----------|-----------|------|------|----------------------|-----|
| 前橋市六供町四丁目 | 111-1-保-1 | | | 78.00 m ² | |

| 点名 | X座標 | Y座標 | 辺長 | 方向角 | 測角 | DX | 倍積 (Y×DX) |
|-----------|-----------|------------|--------|-----------|----------|---------|-----------------|
| 111-1-111 | 41233.589 | -67675.575 | 17.668 | 181-46-39 | 89-58-24 | -17.520 | 1185676.074000 |
| 111-1-112 | 41215.930 | -67676.123 | 4.415 | 91-49-01 | 90-02-22 | -17.799 | 1204567.313277 |
| 111-1-62 | 41215.790 | -67671.710 | 17.669 | 1-46-38 | 89-57-37 | 17.520 | -1185608.359200 |
| 111-1-57 | 41233.450 | -67671.162 | 4.415 | 271-48-15 | 90-01-37 | 17.799 | -1204479.012438 |
| | | | | | | | |
| | | | | | | | |
| | | | | | | 倍面積 | 156.015639 |
| | | | | | | 面積 | 78.0078195 |

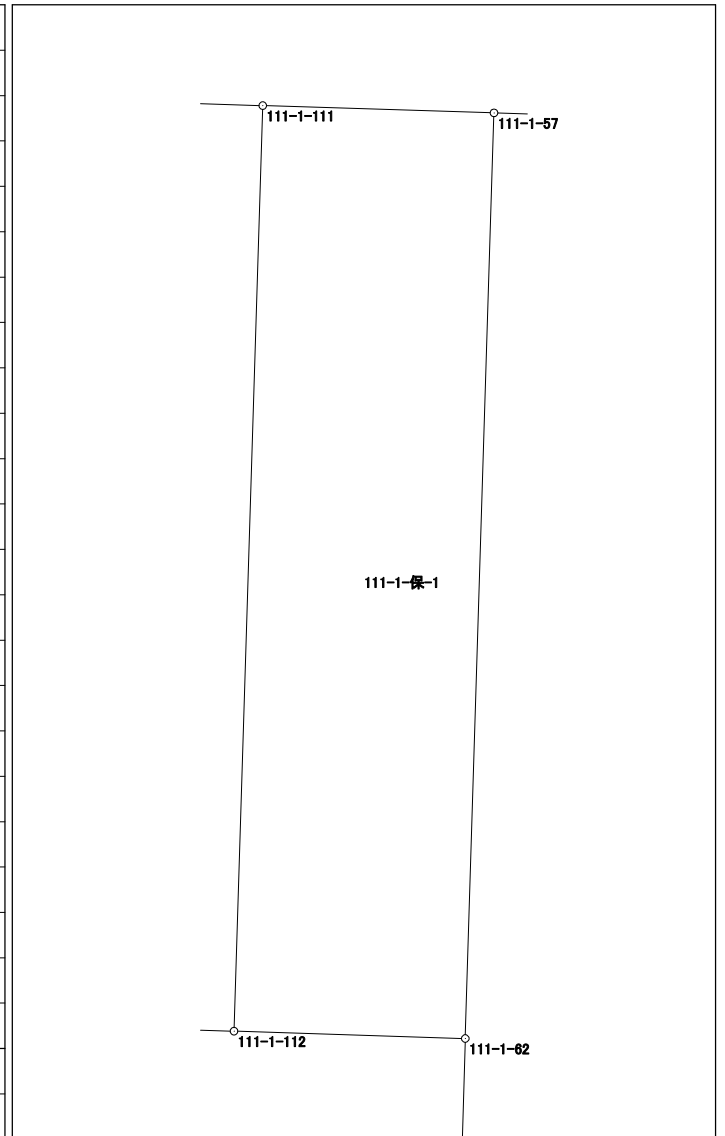


面積計算書 (座標法)

世界測地系 (測地成果2011)

| 所 在 | 地 番 | 公簿地目 | 現況地目 | 地 積 | 所 有 者 |
|-----------|-----------|------|------|----------------------|-------|
| 前橋市六供町四丁目 | 111-1-保-2 | | | 38.00 m ² | |

| 点 名 | X 座標 | Y 座標 | 辺 長 | 方 向 角 | 測 角 | DX | 倍 積 (Y×DX) |
|-----------|-----------|------------|--------|-----------|----------|---------|-----------------|
| 111-1-123 | 41232.874 | -67652.856 | 25.965 | 181-48-35 | 90-00-32 | -25.906 | 1752614.887536 |
| 111-1-124 | 41206.922 | -67653.676 | 1.463 | 92-13-58 | 90-25-23 | -26.009 | 1759604.459084 |
| 111-1-116 | 41206.865 | -67652.214 | 25.976 | 1-48-40 | 89-34-42 | 25.906 | -1752598.255884 |
| 111-1-115 | 41232.828 | -67651.393 | 1.464 | 271-48-03 | 89-59-23 | 26.009 | -1759545.080537 |
| | | | | | | | |
| | | | | | | | |
| | |
|-----|------------|
| 倍面積 | 76.010199 |
| 面 積 | 38.0050995 |

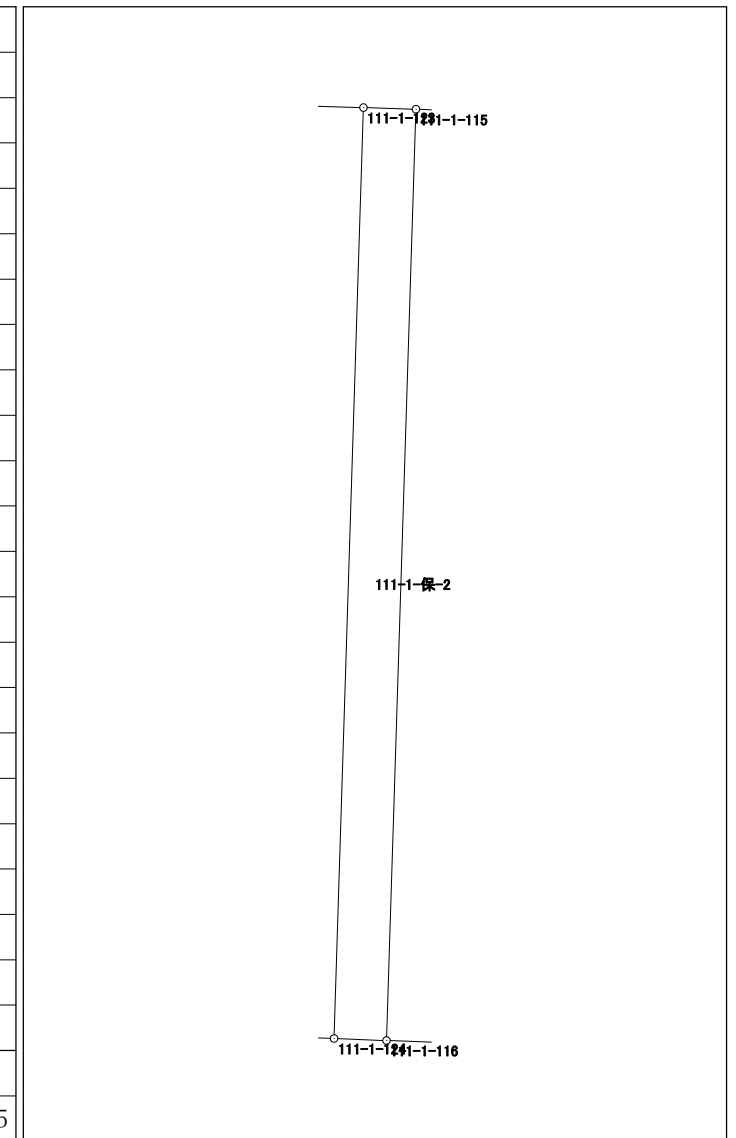


面積計算書 (座標法)

世界測地系 (測地成果2011)

| 所在 | 地番 | 公簿地目 | 現況地目 | 地積 | 所有者 |
|-----------|-----------|------|------|----------------------|-----|
| 前橋市六供町四丁目 | 111-1-保-3 | | | 57.00 m ² | |

| 点名 | X座標 | Y座標 | 辺長 | 方向角 | 測角 | DX | 倍積 (Y×DX) |
|-----------|-----------|------------|--------|-----------|-----------|---------|-----------------|
| 111-1-125 | 41232.343 | -67635.954 | 26.087 | 181-48-36 | 90-00-13 | -26.005 | 1758872.983770 |
| 111-1-126 | 41206.269 | -67636.778 | 2.189 | 92-11-58 | 90-23-22 | -26.158 | 1769242.838924 |
| 111-1-54 | 41206.185 | -67634.591 | 2.377 | 1-47-02 | 89-35-04 | 2.292 | -155018.482572 |
| 111-1-122 | 41208.561 | -67634.517 | 8.378 | 1-45-28 | 179-58-26 | 10.750 | -727071.057750 |
| 111-1-59 | 41216.935 | -67634.260 | 15.347 | 1-50-41 | 180-05-13 | 23.713 | -1603811.207380 |
| 111-1-53 | 41232.274 | -67633.766 | 2.189 | 271-48-23 | 89-57-42 | 15.408 | -1042101.066528 |
| | | | | | | | |
| | | | | | | | |
| | |
|-----|------------|
| 倍面積 | 114.008464 |
| 面積 | 57.0042320 |

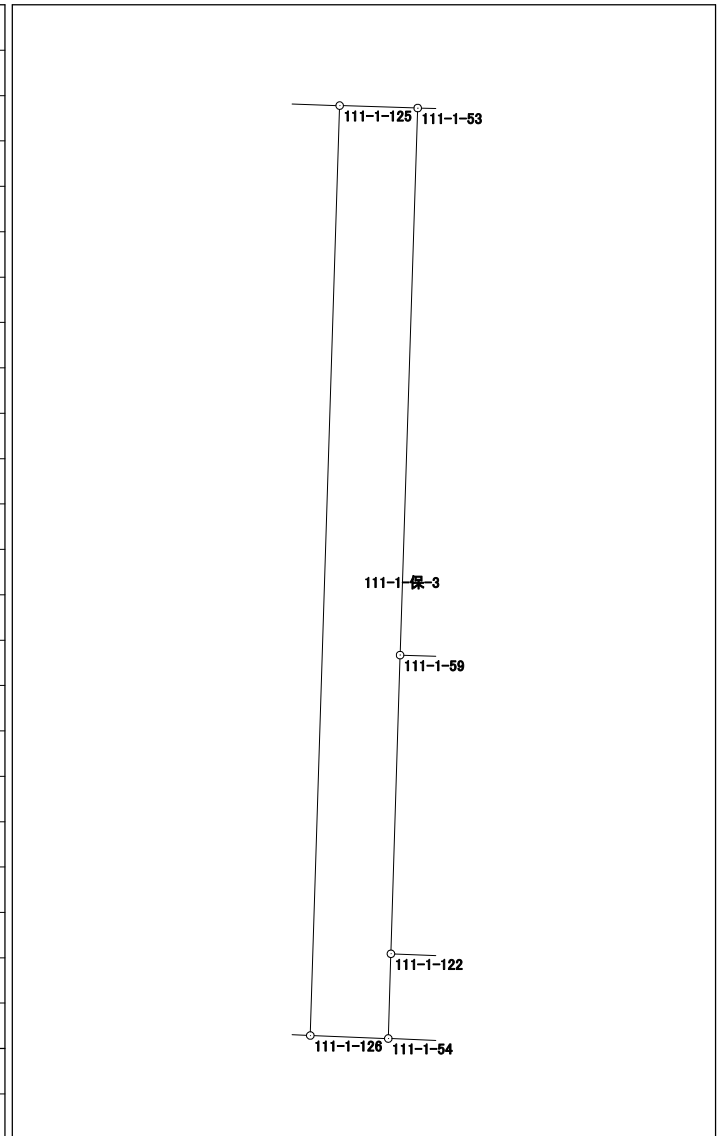


面積計算書（座標法）

世界測地系（測地成果2011）

| | | | | | |
|-----------|-----------|------|------|----------------------|-------|
| 所 在 | 地 番 | 公簿地目 | 現況地目 | 地 積 | 所 有 者 |
| 前橋市六供町四丁目 | 111-1-保-4 | | | 52.00 m ² | |


| 点 名 | X 座標 | Y 座標 | 辺 長 | 方 向 角 | 測 角 | DX | 倍 積 (Y×DX) |
|-----------|-----------|------------|--------|-----------|----------|---------|-----------------|
| 111-1-119 | 41216.833 | -67630.873 | 15.349 | 1-50-40 | 90-07-10 | 15.239 | -1030626.873647 |
| 111-1-120 | 41232.174 | -67630.379 | 3.388 | 271-41-28 | 89-50-48 | 15.441 | -1044280.682139 |
| 111-1-53 | 41232.274 | -67633.766 | 15.347 | 181-50-41 | 90-09-13 | -15.239 | 1030670.960074 |
| 111-1-59 | 41216.935 | -67634.260 | 3.389 | 91-43-30 | 89-52-49 | -15.441 | 1044340.608660 |
| | | | | | | | |
| | | | | | | | |
| | | | | | | 倍面積 | 104.012948 |
| | | | | | | 面 積 | 52.0064740 |

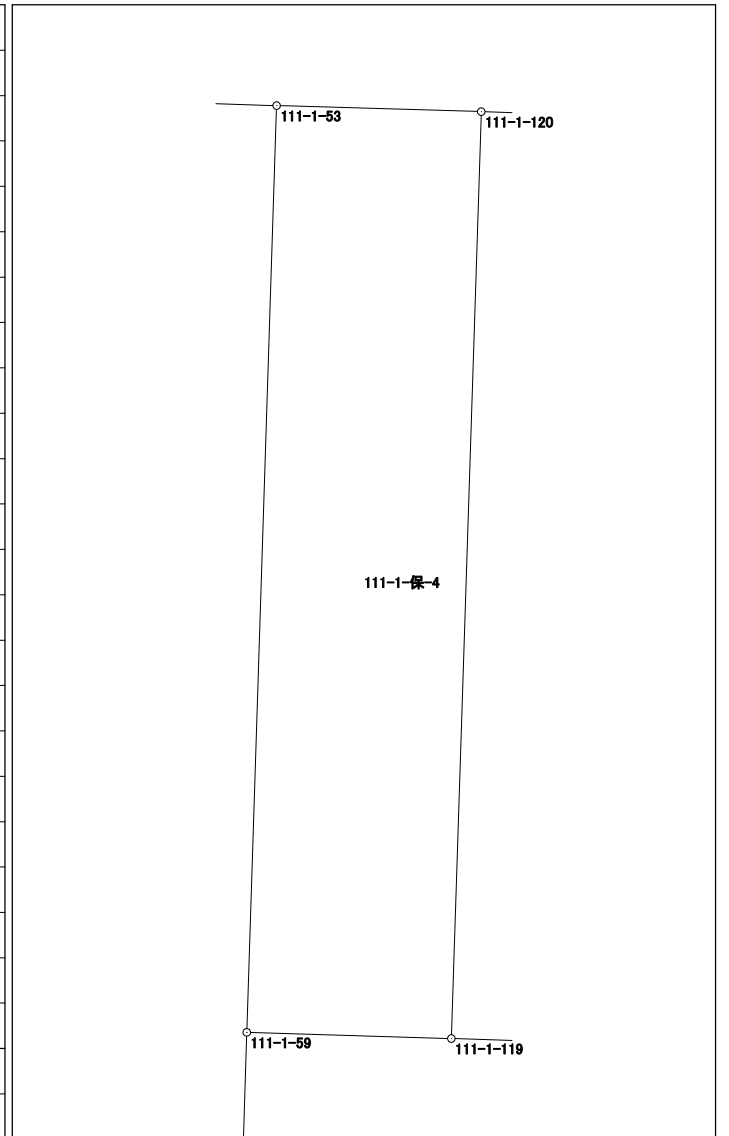

面積計算書（座標法）

世界測地系（測地成果2011）

| | | | | | |
|-----------|-----------|------|------|----------------------|-----|
| 所在 | 地番 | 公簿地目 | 現況地目 | 地積 | 所有者 |
| 前橋市六供町四丁目 | 111-1-保-5 | | | 33.00 m ² | |

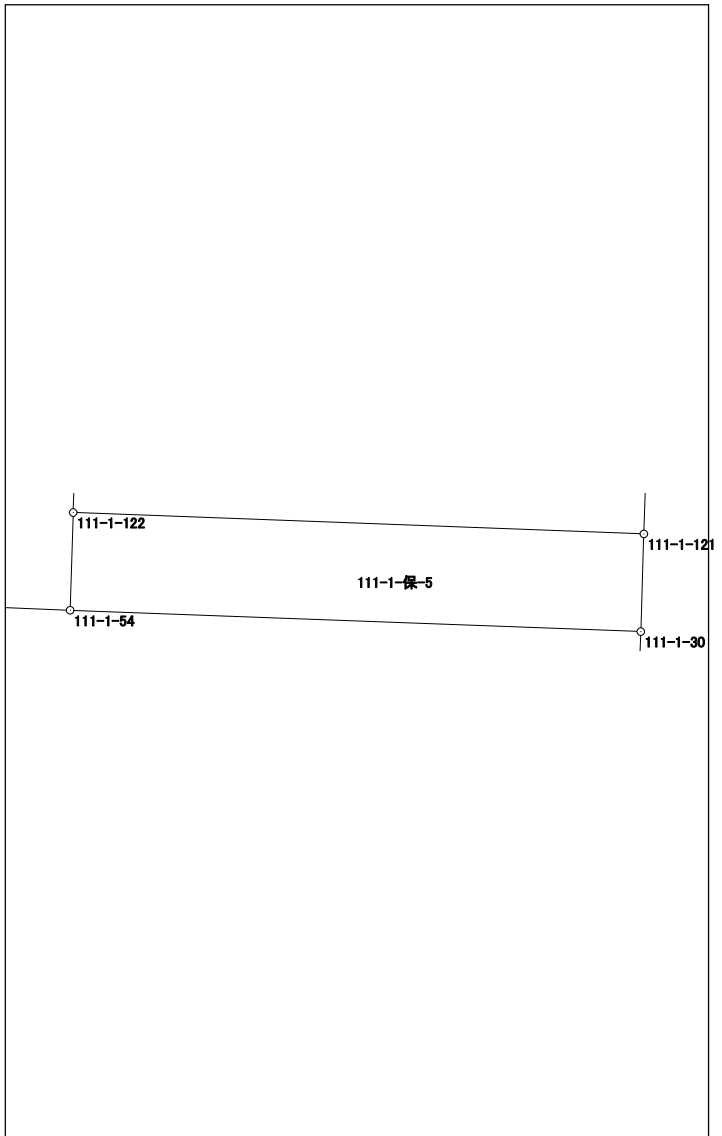
| 点名 | X座標 | Y座標 | 辺長 | 方向角 | 測角 | DX | 倍積 (Y×DX) |  |
|-----------|-----------|------------|--------|-----------|----------|--------|----------------|--|
| 111-1-121 | 41208.041 | -67620.640 | 13.887 | 272-08-46 | 90-20-15 | 2.895 | -195761.752800 | |
| 111-1-122 | 41208.561 | -67634.517 | 2.377 | 181-47-02 | 89-38-16 | -1.856 | 125529.663552 | |
| 111-1-54 | 41206.185 | -67634.591 | 13.886 | 92-08-31 | 90-21-29 | -2.895 | 195802.140945 | |
| 111-1-30 | 41205.666 | -67620.715 | 2.376 | 1-48-31 | 89-40-00 | 1.856 | -125504.047040 | |
| | | | | | | | | |
| | | | | | | | | |
| | | | | | | 倍面積 | 66.004657 | |
| | | | | | | 面積 | 33.0023285 | |

面積計算書（座標法）

世界測地系（測地成果2011）

| | | | | | |
|-----------|-----------|------|------|----------------------|-------|
| 所 在 | 地 番 | 公簿地目 | 現況地目 | 地 積 | 所 有 者 |
| 前橋市六供町四丁目 | 111-1-保-6 | | | 47.00 m ² | |

| 点 名 | X 座標 | Y 座標 | 辺 長 | 方 向 角 | 測 角 | DX | 倍 積 (Y×DX) |
|-----------|-----------|------------|--------|-----------|----------|---------|----------------|
| 111-1-109 | 41186.504 | -67629.300 | 3.350 | 93-33-33 | 91-48-44 | -14.241 | 963108.861300 |
| 111-1-107 | 41186.296 | -67625.956 | 14.039 | 1-44-34 | 88-11-01 | 13.825 | -934928.841700 |
| 111-1-108 | 41200.329 | -67625.529 | 3.349 | 273-33-37 | 91-49-03 | 14.241 | -963055.158489 |
| 111-1-110 | 41200.537 | -67628.872 | 14.040 | 181-44-49 | 88-11-12 | -13.825 | 934969.155400 |
| | | | | | | | |
| | | | | | | | |
| | | | | | | 倍面積 | 94.016511 |
| | | | | | | 面 積 | 47.0082555 |

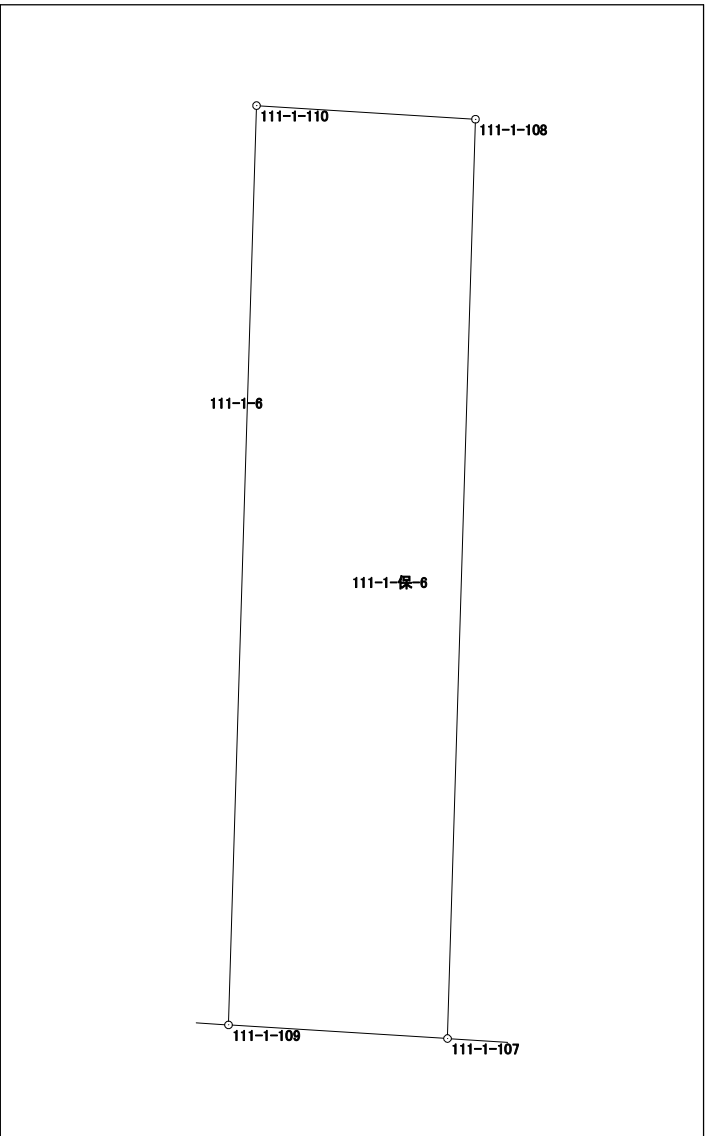


面積計算書 (座標法)

世界測地系 (測地成果2011)

| 所 在 | 地 番 | 公簿地目 | 現況地目 | 地 積 | 所 有 者 |
|-----------|-----------|------|------|----------------------|-------|
| 前橋市六供町四丁目 | 111-1-保-7 | | | 67.00 m ² | |

| 点 名 | X 座 標 | Y 座 標 | 辺 長 | 方 向 角 | 測 角 | DX | 倍 積 (Y×DX) |
|-----------|-----------|------------|--------|-----------|----------|---------|-----------------|
| 111-1-105 | 41187.073 | -67638.457 | 19.247 | 2-12-23 | 88-38-29 | 19.016 | -1286212.898312 |
| 111-1-106 | 41206.306 | -67637.716 | 3.489 | 272-12-05 | 89-59-42 | 19.367 | -1309939.645772 |
| 111-1-102 | 41206.440 | -67641.202 | 19.164 | 182-12-25 | 90-00-20 | -19.016 | 1286265.097232 |
| 111-1-101 | 41187.290 | -67641.940 | 3.490 | 93-33-54 | 91-21-29 | -19.367 | 1310021.451980 |
| | | | | | | | |
| | | | | | | | |
| | |
|-----|------------|
| 倍面積 | 134.005128 |
| 面 積 | 67.0025640 |

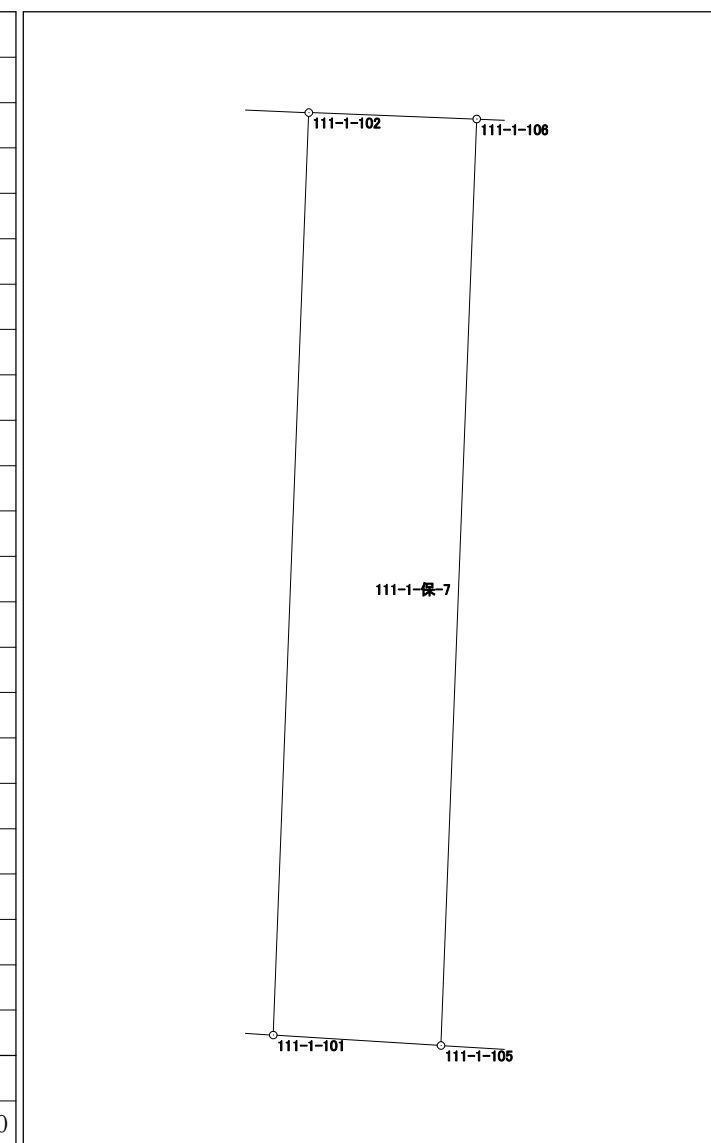


面積計算書（座標法）

世界測地系（測地成果2011）

| 所 在 | 地 番 | 公簿地目 | 現況地目 | 地 積 | 所 有 者 |
|-----------|-----------|------|------|----------------------|-------|
| 前橋市六供町四丁目 | 111-1-保-8 | | | 45.00 m ² | |

| 点 名 | X 座 標 | Y 座 標 | 辺 長 | 方 向 角 | 測 角 | DX | 倍 積 (Y×DX) |
|-----------|-----------|------------|--------|-----------|----------|------------|-----------------|
| 111-1-103 | 41206.530 | -67643.552 | 19.108 | 182-12-27 | 90-00-51 | -19.004 | 1285498.062208 |
| 111-1-104 | 41187.436 | -67644.288 | 2.353 | 93-33-29 | 91-21-02 | -19.240 | 1301476.101120 |
| 111-1-101 | 41187.290 | -67641.940 | 19.164 | 2-12-25 | 88-38-56 | 19.004 | -1285467.427760 |
| 111-1-102 | 41206.440 | -67641.202 | 2.352 | 272-11-36 | 89-59-11 | 19.240 | -1301416.726480 |
| | | | | | | | |
| | | | | | | | |
| 倍面積 | | | | | | 90.009088 | |
| 面 積 | | | | | | 45.0045440 | |

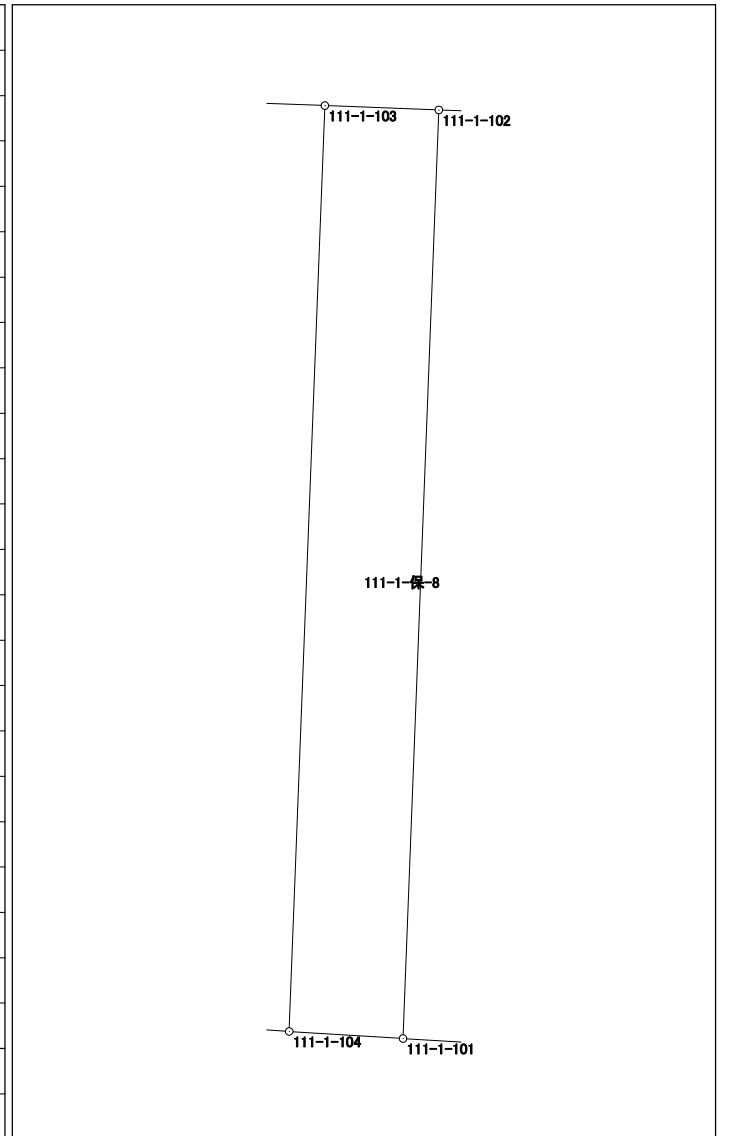

面積計算書（座標法）

世界測地系（測地成果2011）

| | | | | | |
|-----------|-----------|------|------|-----------------------|-------|
| 所 在 | 地 番 | 公簿地目 | 現況地目 | 地 積 | 所 有 者 |
| 前橋市六供町四丁目 | 111-1-保-9 | | | 102.00 m ² | |

| 点 名 | X 座標 | Y 座標 | 辺 長 | 方 向 角 | 測 角 | DX | 倍 積 (Y×DX) |
|-----------|-----------|------------|--------|-----------|-----------|-------------|-----------------|
| 111-1-118 | 41188.116 | -67655.123 | 5.395 | 93-37-27 | 91-25-11 | -19.175 | 1297286.983525 |
| 111-1-47 | 41187.775 | -67649.739 | 18.979 | 2-12-16 | 88-34-49 | 18.624 | -1259908.739136 |
| 111-1-48 | 41206.740 | -67649.009 | 3.207 | 272-14-01 | 90-01-45 | 19.090 | -1291419.581810 |
| 111-1-116 | 41206.865 | -67652.214 | 1.463 | 272-13-58 | 179-59-57 | 0.182 | -12312.702948 |
| 111-1-124 | 41206.922 | -67653.676 | 0.723 | 272-13-15 | 179-59-17 | 0.085 | -5750.562460 |
| 111-1-117 | 41206.950 | -67654.398 | 18.848 | 182-12-16 | 89-59-01 | -18.806 | 1272308.608788 |
| | | | | | | | |
| | | | | | | | |
| 倍面積 | | | | | | 204.005959 | |
| 面 積 | | | | | | 102.0029795 | |

