



113街区 画地出来形確認図 (3321.75m²)

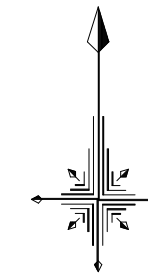

S=1/500

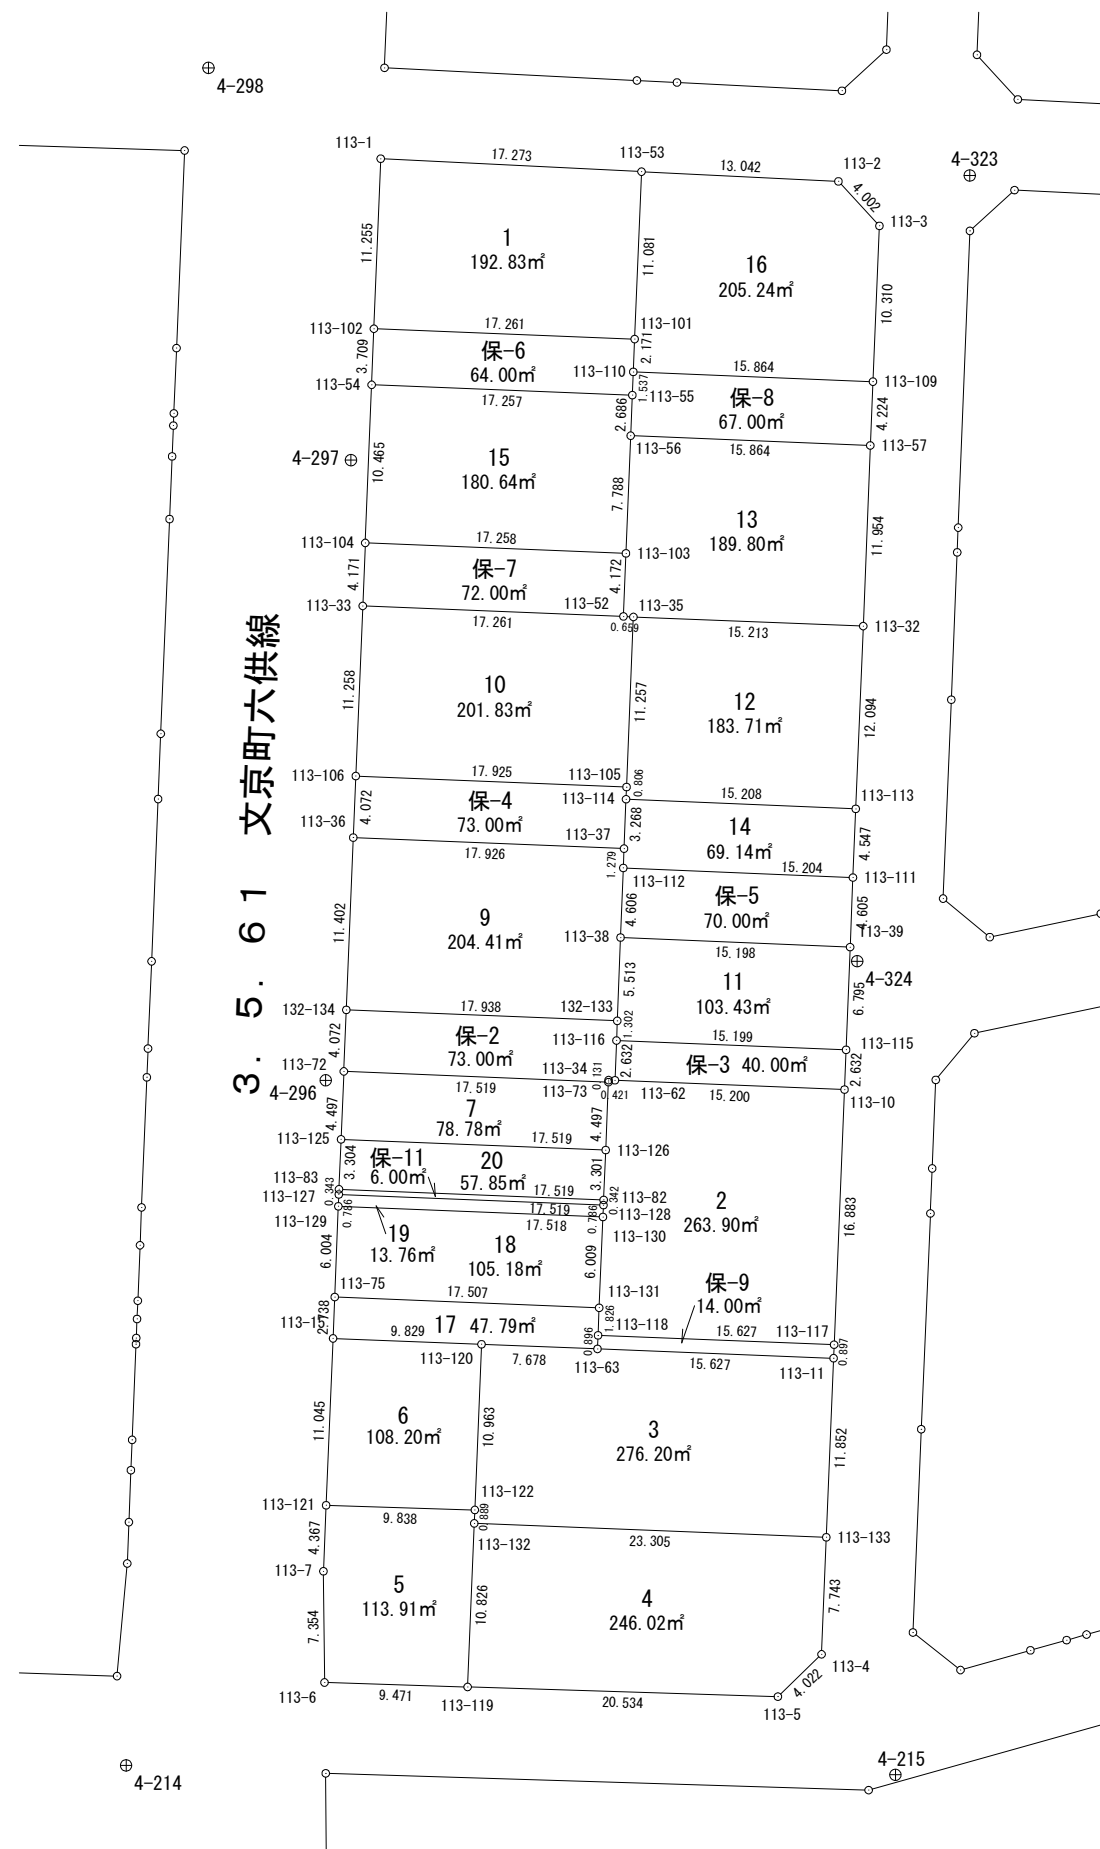


面積計算書 (座標法)

世界測地系 (測地成果2011)

所在	地番	公簿地目	現況地目	地積	所有者
前橋市六供町四丁目	113-1			192.83 m ²	

点名	X座標	Y座標	辺長	方向角	測角	DX	倍積 (Y×DX)
113-101	41340.419	-67526.180	11.081	2-20-53	90-04-37	10.388	-701461.957840
113-53	41351.491	-67525.726	17.273	272-50-50	90-29-57	11.930	-805581.911180
113-1	41352.349	-67542.978	11.255	182-17-11	89-26-21	-10.388	701636.455464
113-102	41341.103	-67543.427	17.261	92-16-16	89-59-05	-11.930	805793.084110
						倍面積	385.670554
						面積	192.8352770

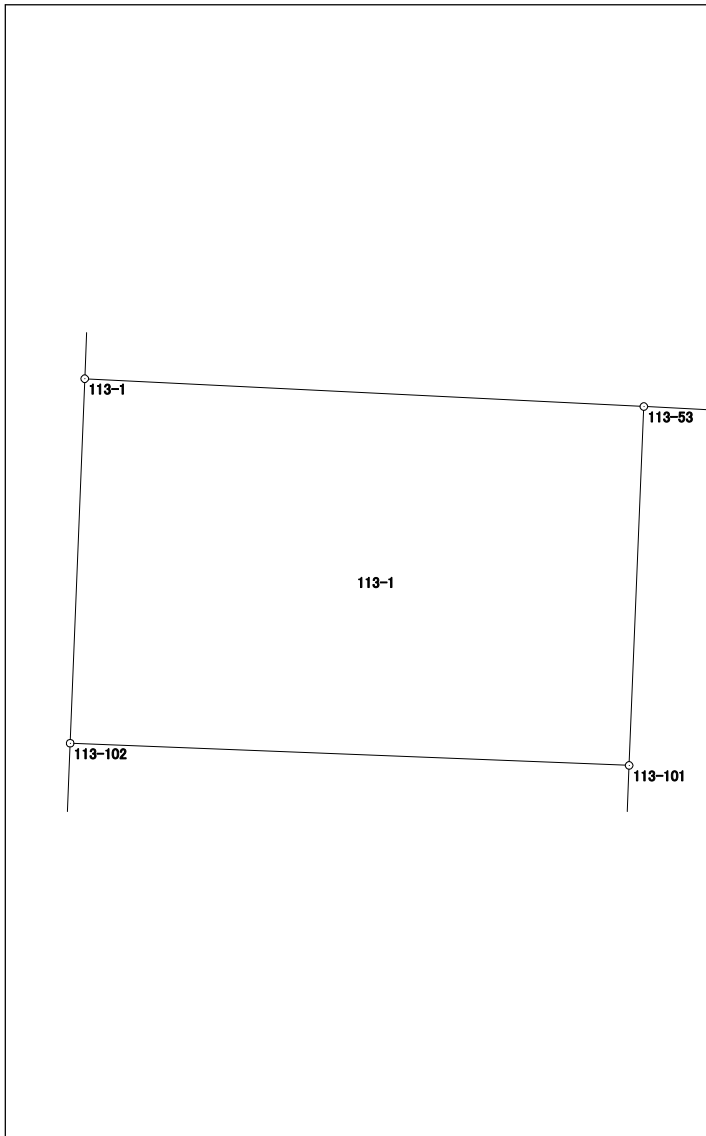


面積計算書 (座標法)

世界測地系 (測地成果2011)

所在	地番	公簿地目	現況地目	地積	所有者
前橋市六供町四丁目	113-3			276.20 m ²	

点名	X座標	Y座標	辺長	方向角	測角	DX	倍積 (Y×DX)
113-11	41273.026	-67513.022	15.627	272-15-46	89-56-30	12.459	-841144.741098
113-63	41273.643	-67528.637	7.678	272-16-09	180-00-23	0.921	-62193.874677
113-120	41273.947	-67536.309	10.963	182-19-16	90-03-07	-10.650	719261.690850
113-122	41262.993	-67536.753	0.889	182-19-18	180-00-02	-11.842	799770.229026
113-132	41262.105	-67536.789	23.305	92-15-54	89-56-36	-1.809	122174.051301
113-133	41261.184	-67513.502	11.852	2-19-16	90-03-22	10.921	-737314.955342
						倍面積	552.400060
						面積	276.2000300

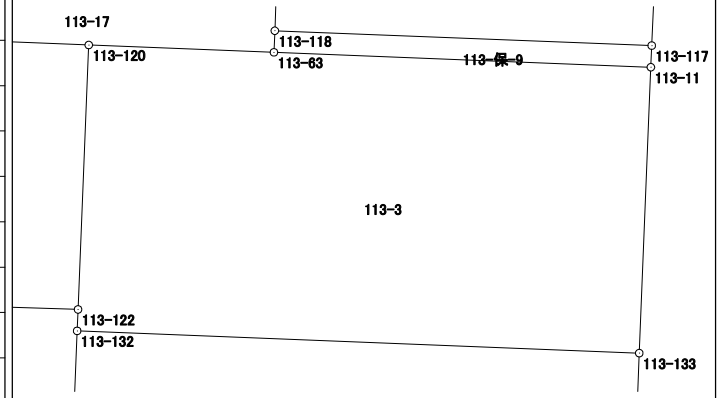

面積計算書（座標法）

世界測地系（測地成果2011）

所 在	地 番	公簿地目	現況地目	地 積	所 有 者
前橋市六供町四丁目	113-4			246.02 m ²	

点 名	X 座標	Y 座標	辺 長	方 向 角	測 角	DX	倍 積 (Y×DX)	
113-132	41262.105	-67536.789	10.826	182-19-27	90-03-33	-9.896	668344.063944	
113-119	41251.288	-67537.228	20.534	91-47-10	89-27-43	-11.457	773774.021196	
113-5	41250.648	-67516.704	4.022	45-53-48	134-06-38	2.159	-145768.563936	
113-4	41253.447	-67513.816	7.743	2-19-27	136-25-39	10.536	-711325.565376	
113-133	41261.184	-67513.502	23.305	272-15-54	89-56-27	8.658	-584531.900316	
倍面積							492.055512	
面 積							246.0277560	

面積計算書（座標法）

世界測地系（測地成果2011）


所 在	地 番	公簿地目	現況地目	地 積	所 有 者
前橋市六供町四丁目	113-6			108.20 m ²	

点 名	X 座標	Y 座標	辺 長	方 向 角	測 角	DX	倍 積 (Y×DX)	
113-15	41274.336	-67546.130	11.045	182-21-58	90-05-52	-10.647	719163.646110	
113-121	41263.300	-67546.586	9.838	91-47-18	89-25-20	-11.343	766180.924998	
113-122	41262.993	-67536.753	10.963	2-19-16	90-31-58	10.647	-719063.809191	
113-120	41273.947	-67536.309	9.829	272-16-06	89-56-50	11.343	-766064.352987	
							倍面積	
							面 積	108.2044650

面積計算書（座標法）

世界測地系（測地成果2011）

所 在	地 番	公簿地目	現況地目	地 積	所 有 者
前橋市六供町四丁目	113-7			78.78 m ²	

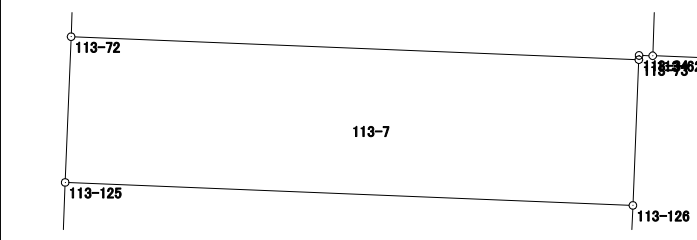
点 名	X 座標	Y 座標	辺 長	方 向 角	測 角	DX	倍 積 (Y×DX)	
113-72	41291.993	-67545.416	4.497	182-20-42	90-01-32	-3.784	255591.854144	
113-125	41287.500	-67545.600	17.519	92-19-10	89-58-28	-5.202	351372.211200	
113-126	41286.791	-67528.095	4.497	2-20-42	90-01-32	3.784	-255526.311480	
113-73	41291.284	-67527.911	17.519	272-19-10	89-58-28	5.202	-351280.193022	
						倍面積	157.560842	
						面 積	78.7804210	

面積計算書 (座標法)

世界測地系 (測地成果2011)

所在	地番	公簿地目	現況地目	地積	所有者
前橋市六供町四丁目	113-9			204.41 m ²	

点名	X座標	Y座標	辺長	方向角	測角	DX	倍積 (Y×DX)
132-133	41295.337	-67527.329	5.513	2-14-43	89-55-44	4.784	-323050.741936
113-38	41300.846	-67527.113	4.606	2-15-53	180-01-10	10.111	-682766.639543
113-112	41305.448	-67526.931	1.279	2-14-26	179-58-33	5.880	-397058.354280
113-37	41306.726	-67526.881	17.926	272-19-51	90-05-25	2.007	-135526.450167
113-36	41307.455	-67544.792	11.402	182-18-44	89-58-53	-10.664	720297.661888
132-134	41296.062	-67545.252	17.938	92-18-59	90-00-15	-12.118	818513.363736

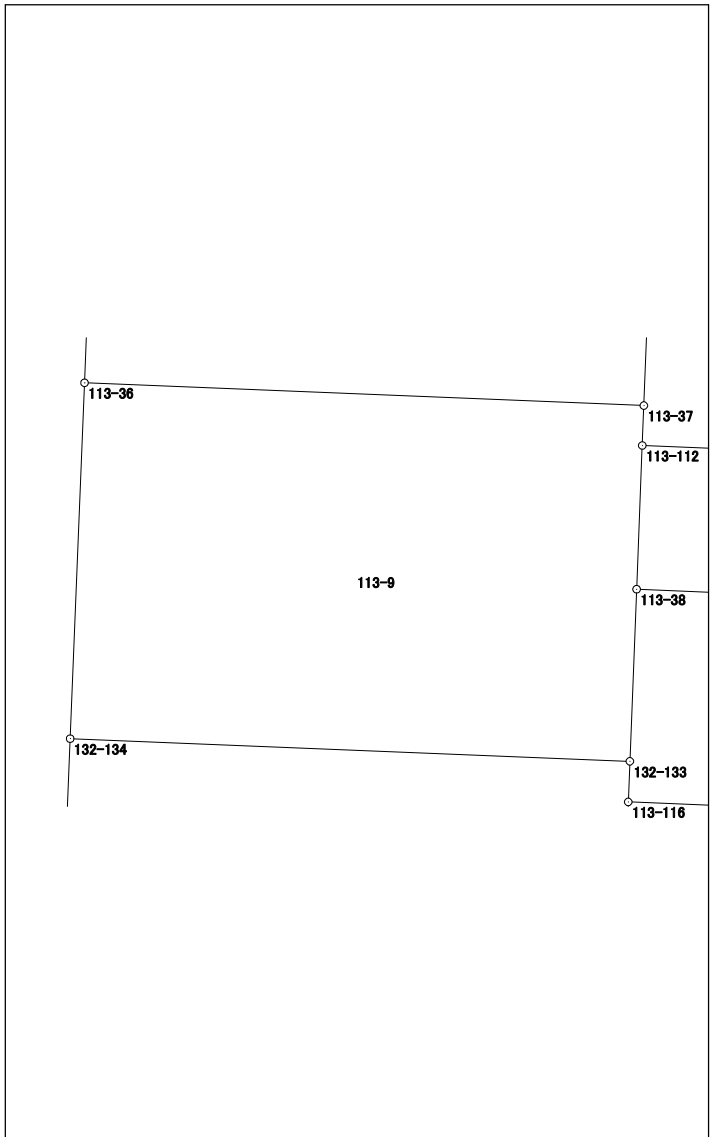


倍面積	408.839698
面積	204.4198490

面積計算書（座標法）

世界測地系（測地成果2011）

所在	地番	公簿地目	現況地目	地積	所有者
前橋市六供町四丁目	113-10			201.83 m ²	

点名	X座標	Y座標	辺長	方向角	測角	DX	倍積 (Y×DX)
113-105	41310.796	-67526.716	11.257	2-18-59	89-59-19	10.520	-710381.052320
113-35	41322.044	-67526.261	0.659	273-02-41	90-43-42	11.283	-761898.802863
113-52	41322.079	-67526.919	17.261	272-18-15	179-15-34	0.729	-49227.123951
113-33	41322.773	-67544.166	11.258	182-20-30	90-02-15	-10.555	712928.672130
113-106	41311.524	-67544.626	17.925	92-19-40	89-59-10	-11.977	808981.985602
						倍面積	403.678598
						面積	201.8392990

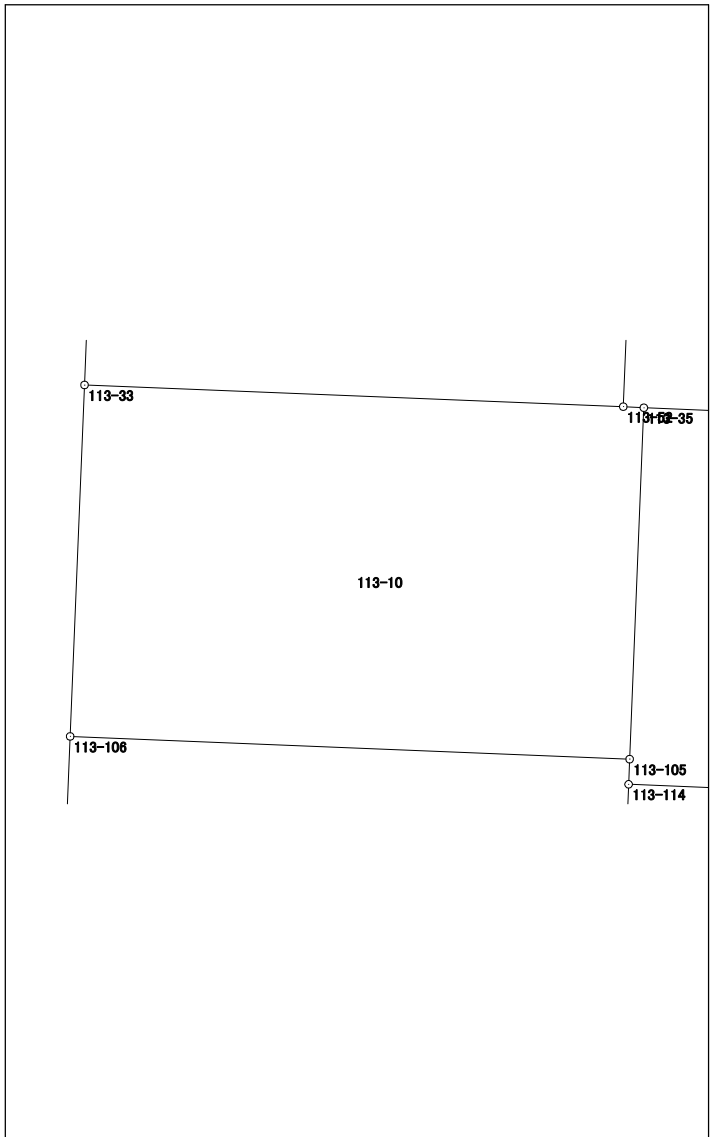


面積計算書（座標法）

世界測地系（測地成果2011）

所在	地番	公簿地目	現況地目	地積	所有者
前橋市六供町四丁目	113-12			183.71 m ²	

点名	X座標	Y座標	辺長	方向角	測角	DX	倍積 (Y×DX)
113-113	41309.355	-67511.554	12.094	2-20-28	89-56-40	11.448	-772872.270192
113-32	41321.439	-67511.060	15.213	272-16-45	89-56-17	12.689	-856647.840340
113-35	41322.044	-67526.261	11.257	182-18-59	90-02-14	-10.643	718681.995823
113-105	41310.796	-67526.716	0.806	182-20-51	180-01-52	-12.053	813899.507948
113-114	41309.991	-67526.749	15.208	92-23-48	90-02-57	-1.441	97306.045309
						倍面積	367.438548
						面積	183.7192740

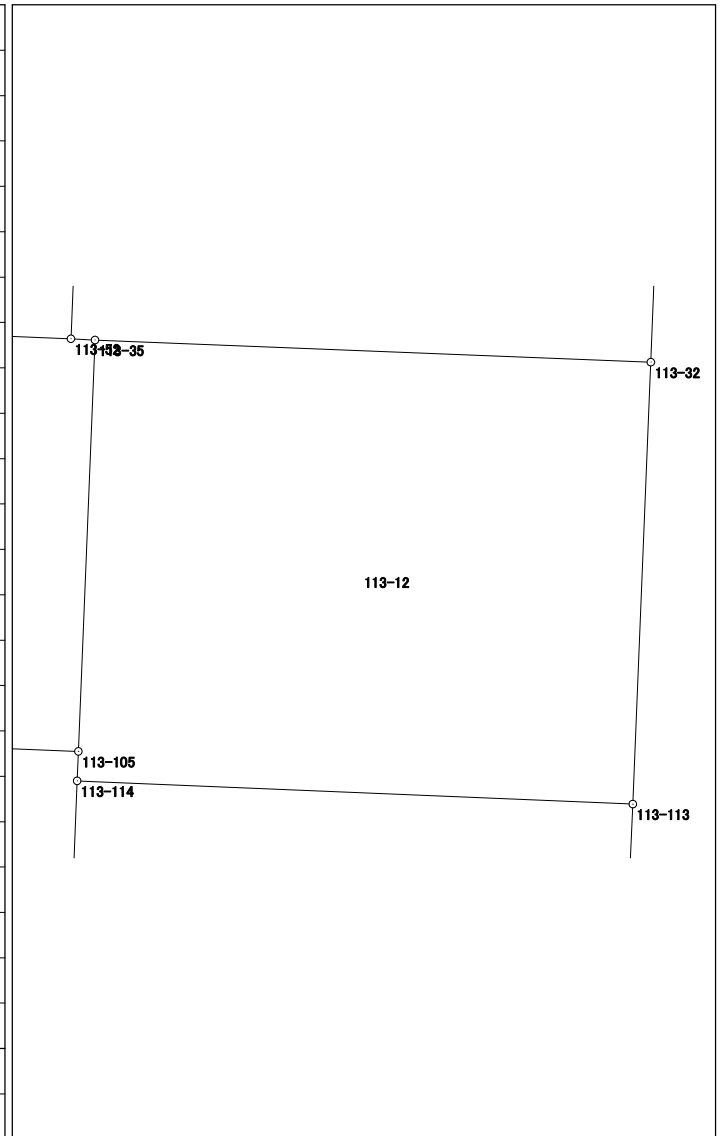


面積計算書（座標法）

世界測地系（測地成果2011）

所 在	地 番	公簿地目	現況地目	地 積	所 有 者
前橋市六供町四丁目	113-13			189.80 m ²	

点 名	X 座標	Y 座標	辺 長	方 向 角	測 角	DX	倍 積 (Y×DX)
113-56	41334.030	-67526.445	7.788	182-16-26	89-56-24	-7.136	481868.711520
113-103	41326.248	-67526.754	4.172	182-15-59	179-59-33	-11.951	807012.237054
113-52	41322.079	-67526.919	0.659	93-02-41	90-46-42	-4.204	283883.167476
113-35	41322.044	-67526.261	15.213	92-16-45	179-14-04	-0.640	43216.807040
113-32	41321.439	-67511.060	11.954	2-14-03	89-57-18	11.340	-765575.420400
113-57	41333.384	-67510.594	15.864	272-20-02	90-05-59	12.591	-850025.889054
						倍面積	379.613636
						面 積	189.8068180

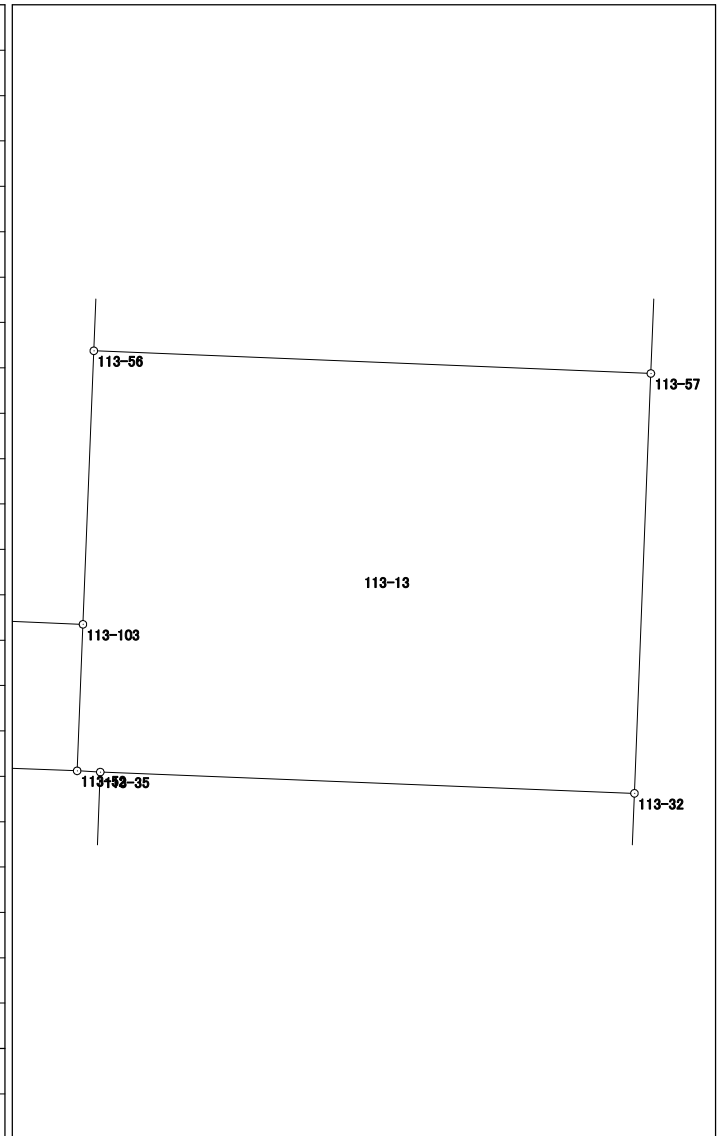


面積計算書 (座標法)

世界測地系 (測地成果2011)

所在	地番	公簿地目	現況地目	地積	所有者
前橋市六供町四丁目	113-14			69.14 m ²	

点名	X座標	Y座標	辺長	方向角	測角	DX	倍積 (Y×DX)
113-111	41304.812	-67511.740	4.547	2-20-40	89-56-49	3.907	-263768.368180
113-113	41309.355	-67511.554	15.208	272-23-48	90-03-08	5.179	-349642.338166
113-114	41309.991	-67526.749	3.268	182-18-54	89-55-06	-2.629	177527.823121
113-37	41306.726	-67526.881	1.279	182-14-26	179-55-32	-4.543	306774.620383
113-112	41305.448	-67526.931	15.204	92-23-51	90-09-25	-1.914	129246.545934
						倍面積	138.283092
						面積	69.1415460

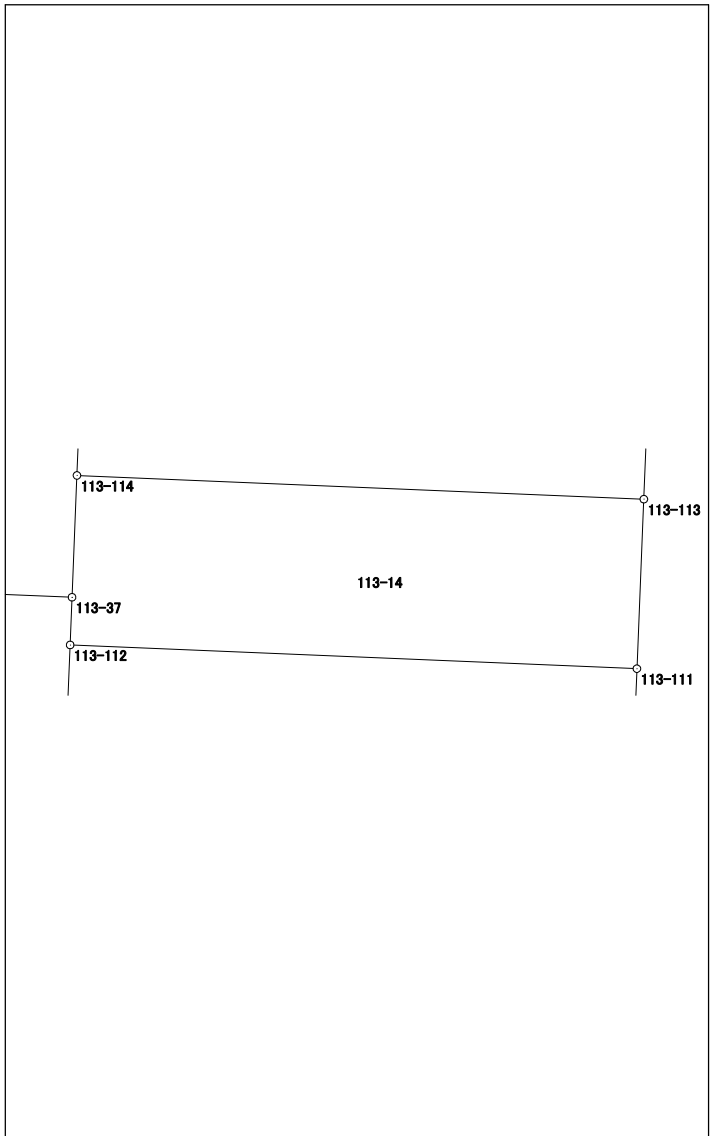


面積計算書（座標法）

世界測地系（測地成果2011）

所在	地番	公簿地目	現況地目	地積	所有者
前橋市六供町四丁目	113-15			180.64 m ²	

点名	X座標	Y座標	辺長	方向角	測角	DX	倍積 (Y×DX)
113-103	41326.248	-67526.754	7.788	2-16-26	89-58-21	7.089	-478697.159106
113-56	41334.030	-67526.445	2.686	2-24-39	180-08-13	10.466	-706731.773370
113-55	41336.714	-67526.332	17.257	272-16-06	89-51-27	3.367	-227361.159844
113-54	41337.397	-67543.575	10.465	182-19-00	90-02-54	-9.773	660103.358475
113-104	41326.941	-67543.998	17.258	92-18-05	89-59-05	-11.149	753048.033702

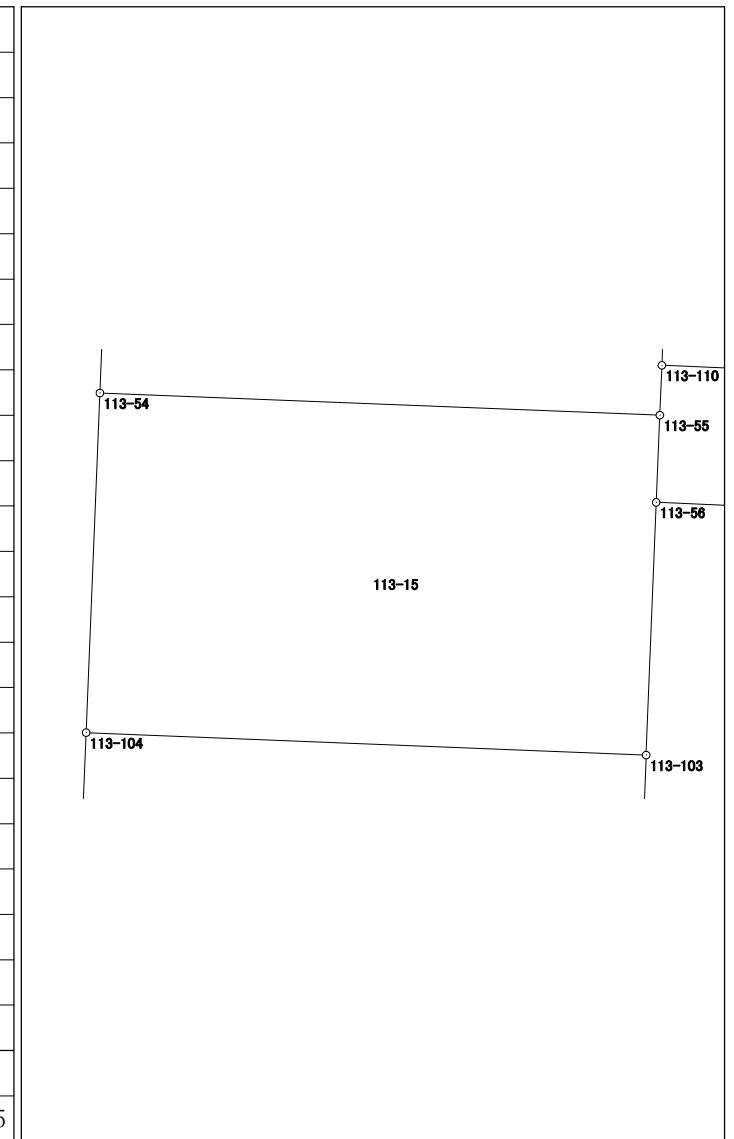


倍面積	361.299857
面積	180.6499285

面積計算書（座標法）

世界測地系（測地成果2011）

所在	地番	公簿地目	現況地目	地積	所有者
前橋市六供町四丁目	113-17			47.79 m ²	

点名	X座標	Y座標	辺長	方向角	測角	DX	倍積 (Y×DX)
113-75	41277.072	-67546.018	2.738	182-20-39	90-01-12	-2.026	136848.232468
113-15	41274.336	-67546.130	9.829	92-16-06	89-55-27	-3.125	211081.656250
113-120	41273.947	-67536.309	7.678	92-16-09	180-00-03	-0.693	46802.662137
113-63	41273.643	-67528.637	0.896	2-22-02	90-05-53	0.591	-39909.424467
113-118	41274.538	-67528.600	1.826	2-21-17	179-59-15	2.719	-183610.263400
113-131	41276.362	-67528.525	17.507	272-19-27	89-58-10	2.534	-171117.282350
						倍面積	95.580638
						面積	47.7903190

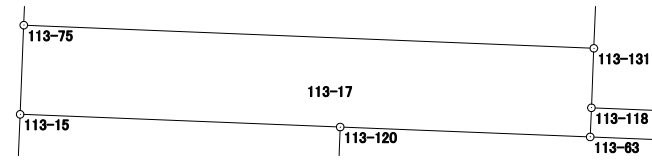

面積計算書（座標法）

世界測地系（測地成果2011）

所 在	地 番	公簿地目	現況地目	地 積	所 有 者
前橋市六供町四丁目	113-19			13.76 m ²	


点 名	X 座標	Y 座標	辺 長	方 向 角	測 角	DX	倍 積 (Y×DX)				
113-128	41283.151	-67528.244	17.519	272-18-23	89-58-19	1.490	-100617.083560				
113-127	41283.856	-67545.749	0.786	182-15-41	89-57-18	-0.080	5403.659920				
113-129	41283.071	-67545.780	17.518	92-18-23	90-02-42	-1.490	100643.212200				
113-130	41282.366	-67528.276	0.786	2-20-04	90-01-41	0.080	-5402.262080				
						倍面積	27.526480				
						面 積	13.7632400				

面積計算書 (座標法)

世界測地系 (測地成果2011)

所在	地番	公簿地目	現況地目	地積	所有者
前橋市六供町四丁目	113-保-2			73.00 m ²	

点名	X 座標	Y 座標	辺長	方向角	測角	DX	倍積 (Y×DX)
113-72	41291.993	-67545.416	17.519	92-19-10	90-00-41	-4.778	322731.997648
113-73	41291.284	-67527.911	0.131	2-37-21	90-18-11	-0.578	39031.132558
113-34	41291.415	-67527.905	0.421	91-13-29	268-36-08	0.122	-8238.404410
113-62	41291.406	-67527.484	2.632	2-15-52	91-02-23	2.621	-176989.535564
113-116	41294.036	-67527.380	1.302	2-14-42	179-58-50	3.931	-265450.130780
132-133	41295.337	-67527.329	17.938	272-18-59	90-04-17	2.026	-136810.368554
132-134	41296.062	-67545.252	4.072	182-18-29	89-59-30	-3.344	225871.322688

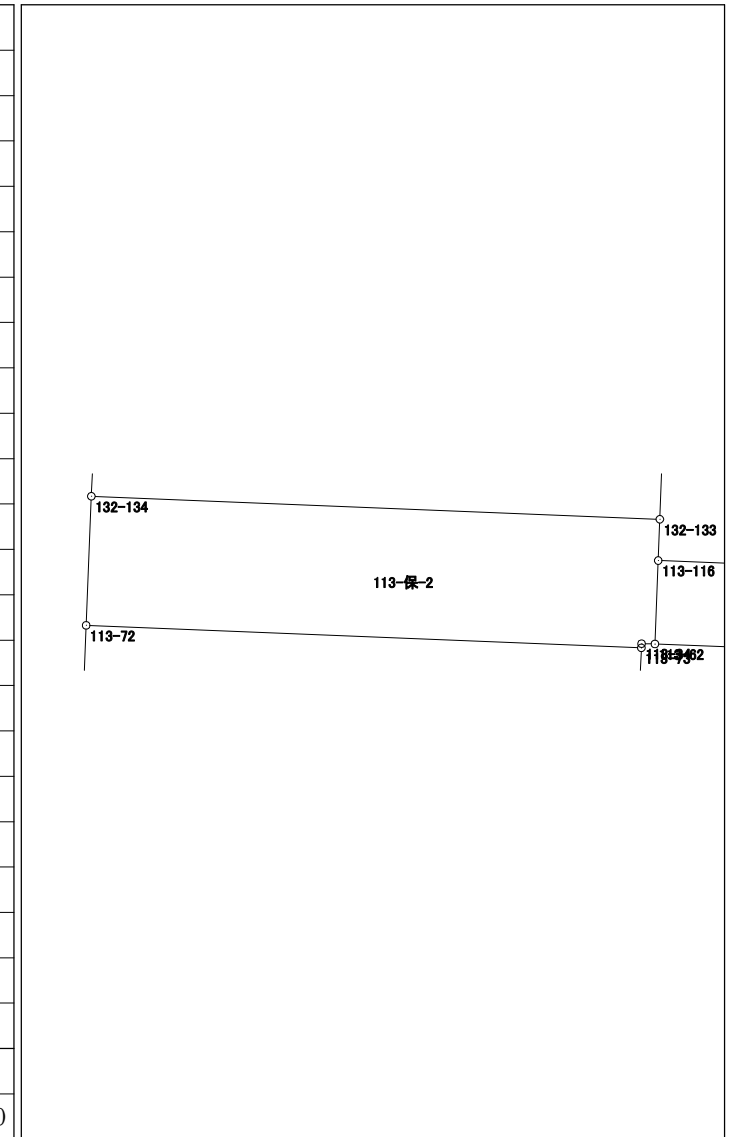


倍面積	146.013586
面積	73.0067930

面積計算書（座標法）

世界測地系（測地成果2011）

所 在	地 番	公簿地目	現況地目	地 積	所 有 者
前橋市六供町四丁目	113-保-3			40.00 m ²	

点 名	X 座標	Y 座標	辺 長	方 向 角	測 角	D _X	倍 積 (Y×D _X)
113-62	41291.406	-67527.484	15.200	92-19-08	90-03-16	-3.245	219126.685580
113-10	41290.791	-67512.296	2.632	2-14-34	89-55-26	2.015	-136037.276440
113-115	41293.421	-67512.193	15.199	272-19-08	90-04-34	3.245	-219077.066285
113-116	41294.036	-67527.380	2.632	182-15-52	89-56-44	-2.015	136067.670700

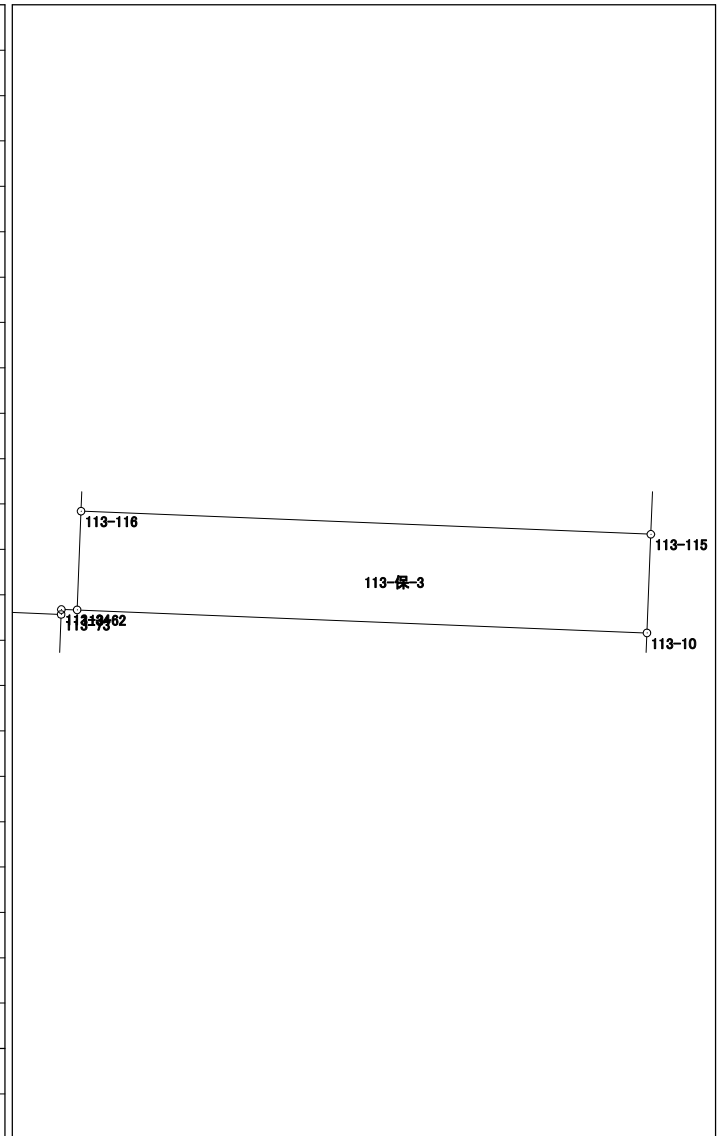


倍面積	80.013555
面 積	40.0067775

面積計算書（座標法）

世界測地系（測地成果2011）

所 在	地 番	公簿地目	現況地目	地 積	所 有 者
前橋市六供町四丁目	113-保-4			73.00 m ²	

点 名	X 座標	Y 座標	辺 長	方 向 角	測 角	DX	倍 積 (Y×DX)
113-36	41307.455	-67544.792	17.926	92-19-51	89-59-41	-4.798	324079.912016
113-37	41306.726	-67526.881	3.268	2-18-54	89-59-03	2.536	-171248.170216
113-114	41309.991	-67526.749	0.806	2-20-51	180-01-57	4.070	-274833.868430
113-105	41310.796	-67526.716	17.925	272-19-40	89-58-49	1.533	-103518.455628
113-106	41311.524	-67544.626	4.072	182-20-10	90-00-30	-3.341	225666.595466
						倍面積	146.013208
						面 積	73.0066040

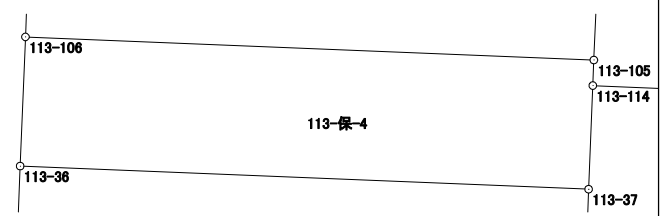


面積計算書（座標法）

世界測地系（測地成果2011）

所在	地番	公簿地目	現況地目	地積	所有者
前橋市六供町四丁目	113-保-6			64.00 m ²	

点名	X座標	Y座標	辺長	方向角	測角	DX	倍積 (Y×DX)
113-54	41337.397	-67543.575	17.257	92-16-06	89-58-53	-4.389	296448.750675
113-55	41336.714	-67526.332	1.537	2-20-55	90-04-49	0.853	-57599.961196
113-110	41338.250	-67526.269	2.171	2-20-59	180-00-04	3.705	-250184.826645
113-101	41340.419	-67526.180	17.261	272-16-16	89-55-17	2.853	-192652.191540
113-102	41341.103	-67543.427	3.709	182-17-13	90-00-57	-3.022	204116.236394
倍面積							128.007688
面積							64.0038440

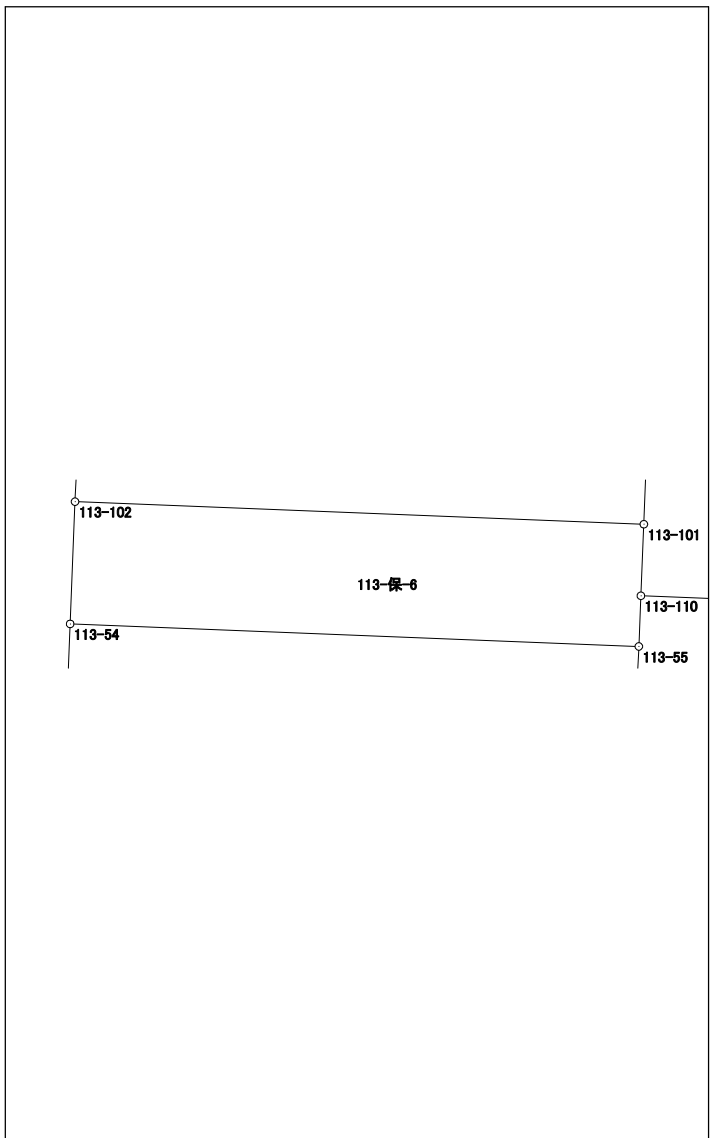


面積計算書 (座標法)

世界測地系 (測地成果2011)

所在	地番	公簿地目	現況地目	地積	所有者
前橋市六供町四丁目	113-保-7			72.00 m ²	

点名	X座標	Y座標	辺長	方向角	測角	DX	倍積 (Y×DX)
113-33	41322.773	-67544.166	17.261	92-18-15	89-59-46	-4.862	328399.735092
113-52	41322.079	-67526.919	4.172	2-15-59	89-57-44	3.475	-234656.043525
113-103	41326.248	-67526.754	17.258	272-18-05	90-02-06	4.862	-328315.077948
113-104	41326.941	-67543.998	4.171	182-18-29	90-00-24	-3.475	234715.393050
						倍面積	144.006669
						面積	72.0033345

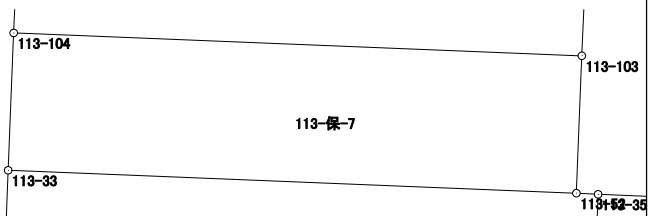


面積計算書 (座標法)

世界測地系 (測地成果2011)

所 在	地 番	公簿地目	現況地目	地 積	所 有 者
前橋市六供町四丁目	113-保-8			67.00 m ²	

点 名	X 座標	Y 座標	辺 長	方 向 角	測 角	DX	倍 積 (Y×DX)
113-57	41333.384	-67510.594	4.224	2-23-18	90-03-16	3.574	-241282.862956
113-109	41337.604	-67510.418	15.864	272-20-02	89-56-44	4.866	-328505.693988
113-110	41338.250	-67526.269	1.537	182-20-55	90-00-53	-0.890	60098.379410
113-55	41336.714	-67526.332	2.686	182-24-39	180-03-44	-4.220	284961.121040
113-56	41334.030	-67526.445	15.864	92-20-02	89-55-23	-3.330	224863.061850

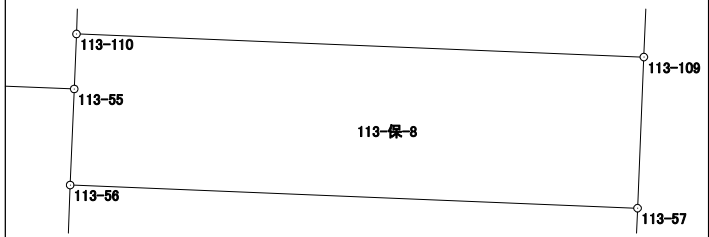


倍面積	134.005356
面 積	67.0026780

面積計算書（座標法）

世界測地系（測地成果2011）

所 在	地 番	公簿地目	現況地目	地 積	所 有 者
前橋市六供町四丁目	113-保-9			14.00 m ²	

点 名	X 座標	Y 座標	辺 長	方 向 角	測 角	DX	倍 積 (Y×DX)
113-63	41273.643	-67528.637	15.627	92-15-46	89-53-44	-1.512	102103.299144
113-11	41273.026	-67513.022	0.897	2-21-53	90-06-07	0.279	-18836.133138
113-117	41273.922	-67512.985	15.627	272-15-33	89-53-40	1.512	-102079.633320
113-118	41274.538	-67528.600	0.896	182-22-02	90-06-29	-0.279	18840.479400

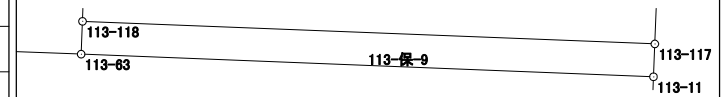


倍面積	28.012086
面 積	14.0060430

面積計算書 (座標法)

世界測地系 (測地成果2011)

所在	地番	公簿地目	現況地目	地積	所有者
前橋市六供町四丁目	113-保-11			6.00 m ²	

点名	X座標	Y座標	辺長	方向角	測角	DX	倍積 (Y×DX)
113-83	41284.199	-67545.735	0.343	182-20-14	90-01-40	0.363	-24519.101805
113-127	41283.856	-67545.749	17.519	92-18-23	89-58-09	-1.048	70787.944952
113-128	41283.151	-67528.244	0.342	2-20-39	90-02-16	-0.363	24512.752572
113-82	41283.493	-67528.230	17.519	272-18-34	89-57-55	1.048	-70769.585040

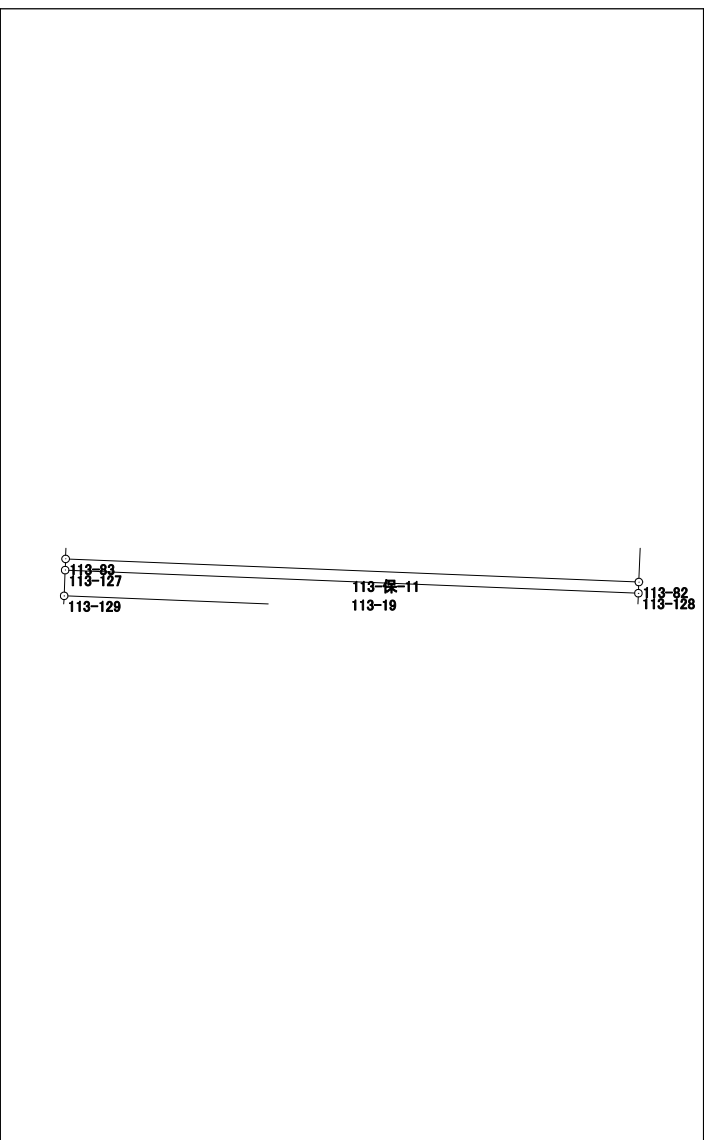

倍面積	12.010679
面積	6.0053395