



# 116街区 画地出来形確認図 (6097.38m<sup>2</sup>)

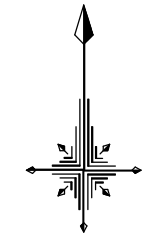

S=1/500

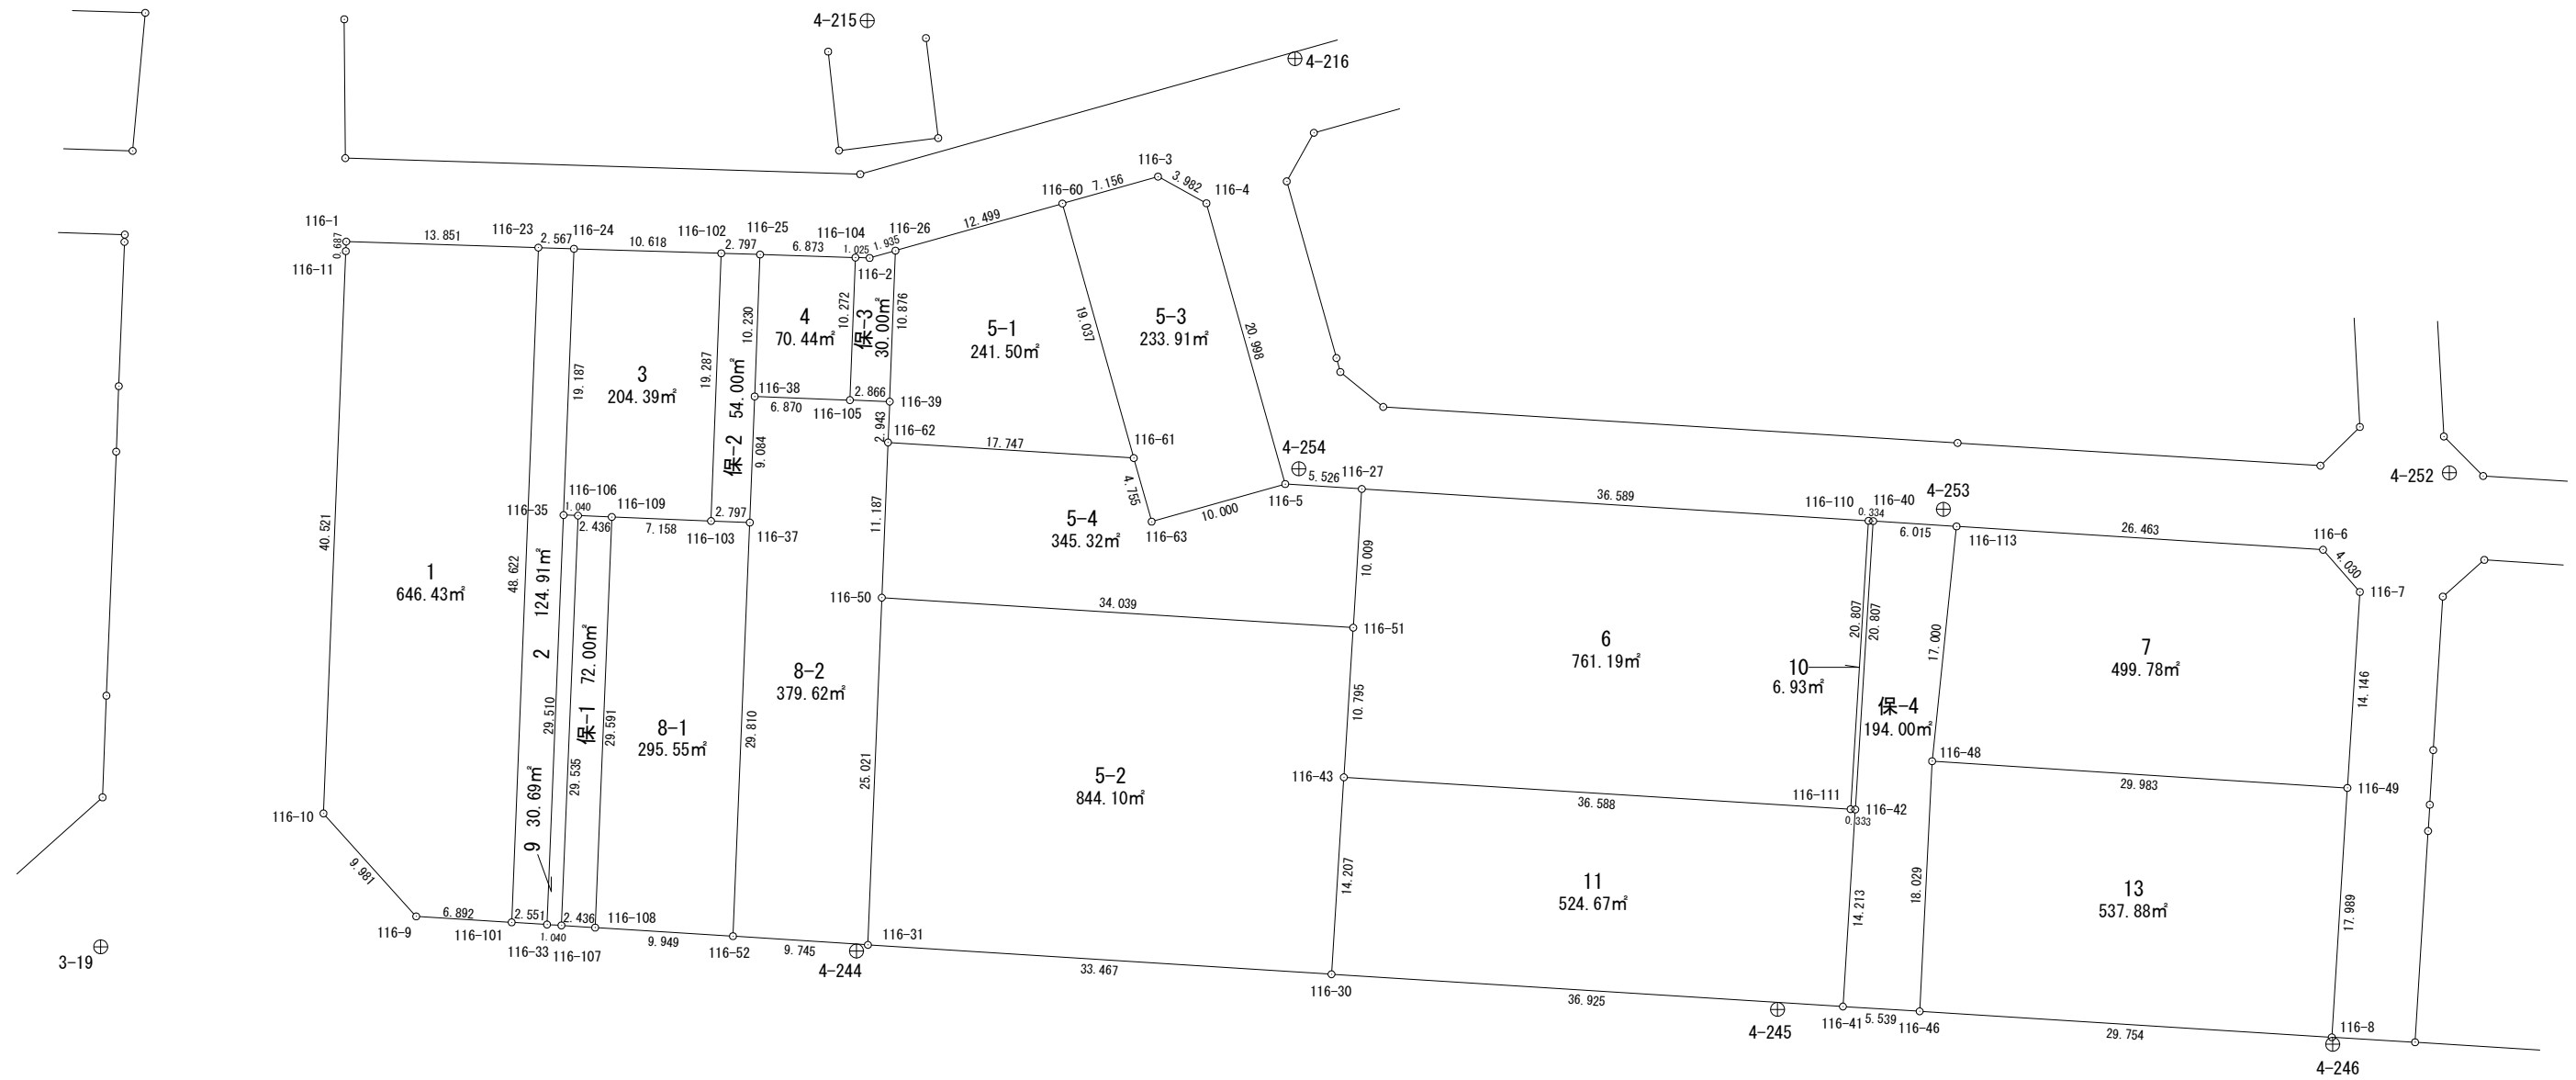


3. 3. 10江田天川大島線

# 面積計算書（座標法）

世界測地系（測地成果2011）

所 在	地 番	公簿地目	現況地目	地 積	所 有 者
前橋市六供町四丁目	116-1			646.43 m <sup>2</sup>	

点 名	X 座標	Y 座標	辺 長	方 向 角	測 角	DX	倍 積 (Y×DX)
116-101	41180.550	-67534.552	48.622	2-16-00	88-42-23	48.156	-3252193.886112
116-23	41229.134	-67532.629	13.851	271-47-29	89-31-29	49.017	-3310246.875693
116-1	41229.567	-67546.473	0.687	182-25-14	90-37-45	-0.253	17089.257669
116-11	41228.881	-67546.502	40.521	182-16-43	179-51-29	-41.175	2781227.219850
116-10	41188.392	-67548.113	9.981	137-58-22	135-41-39	-47.903	3235757.257039
116-9	41180.978	-67541.431	6.892	93-33-37	135-35-15	-7.842	529659.901902
						倍面積	1292.874655
						面 積	646.4373275

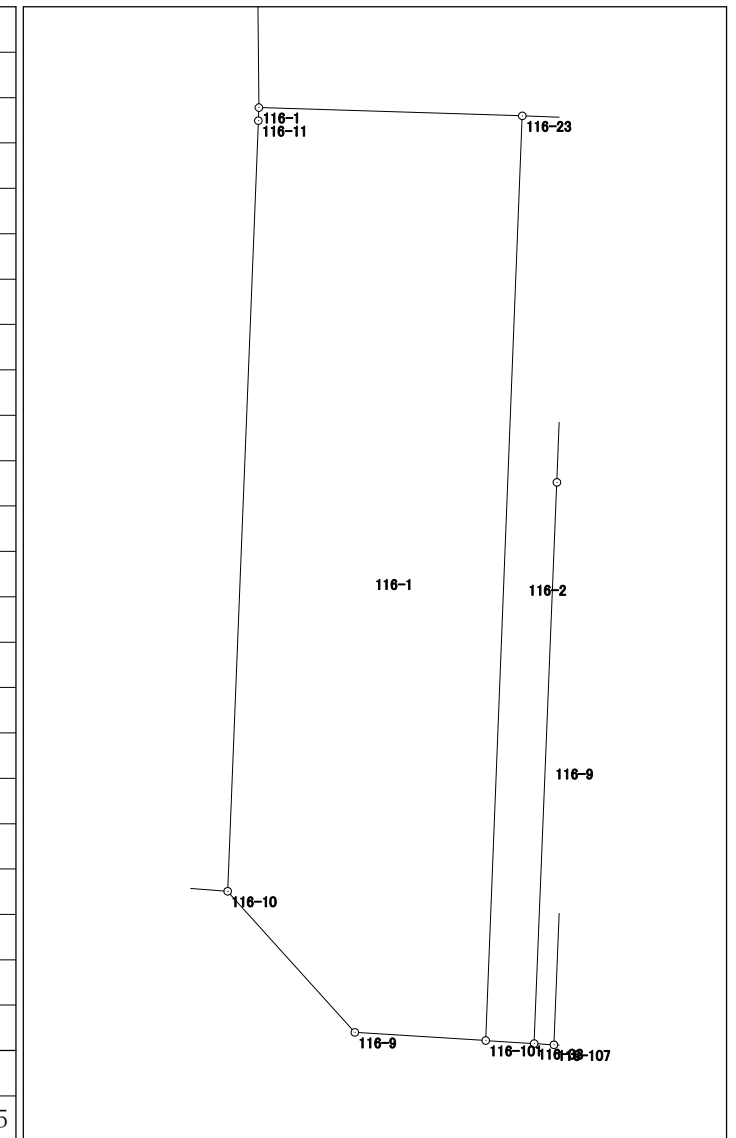


# 面積計算書 (座標法)

世界測地系 (測地成果2011)

所 在	地 番	公簿地目	現況地目	地 積	所 有 者
前橋市六供町四丁目	116-2			124.91 m <sup>2</sup>	

点 名	X 座標	Y 座標	辺 長	方 向 角	測 角	DX	倍 積 (Y×DX)
116-23	41229.134	-67532.629	48.622	182-16-00	90-22-10	-48.499	3275264.973871
116-101	41180.550	-67534.552	2.551	93-34-25	91-18-25	-48.743	3291836.668136
116-33	41180.391	-67532.006	29.510	2-19-08	88-44-43	29.327	-1980511.139962
116-35	41209.877	-67530.812	19.187	2-14-14	179-55-06	48.658	-3285914.250296
116-24	41229.049	-67530.063	2.567	271-53-50	89-39-36	19.257	-1300426.423191

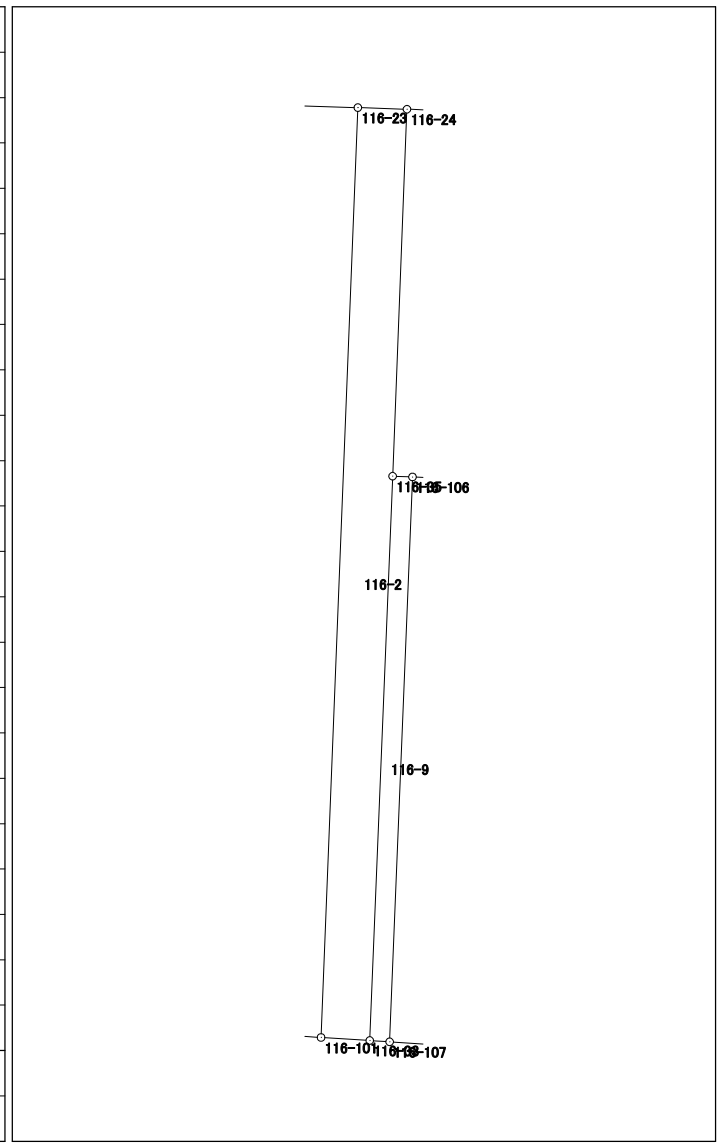

倍面積	249.828558
面積	124.9142790






# 面積計算書（座標法）

世界測地系（測地成果2011）

所 在	地 番	公簿地目	現況地目	地 積	所 有 者
前橋市六供町四丁目	116-5-1			241.50 m <sup>2</sup>	

点 名	X 座標	Y 座標	辺 長	方 向 角	測 角	DX	倍 積 (Y×DX)
116-26	41228.913	-67506.897	10.876	182-11-50	107-57-29	-14.263	962850.871911
116-39	41218.045	-67507.314	2.943	182-22-34	180-10-44	-13.808	932140.991712
116-62	41215.105	-67507.436	17.747	93-38-16	91-15-42	-4.066	274485.234776
116-61	41213.979	-67489.725	19.037	344-19-34	70-41-18	17.203	-1161025.739175
116-60	41232.308	-67494.868	12.499	254-14-21	89-54-47	14.934	-1007968.358712

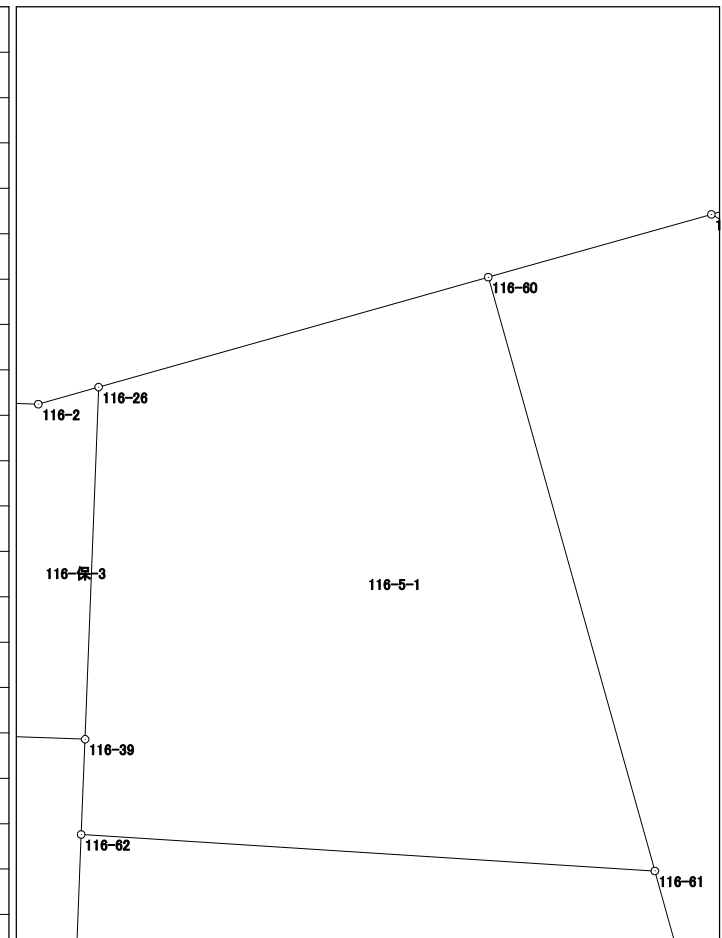


倍面積	483.000512
面 積	241.5002560

面積計算書 (座標法)

所在	地番	公簿地目	現況地目	地積	所有者
前橋市六供町四丁目	116-5-2			844.10 m <sup>2</sup>	

点名	X 座標	Y 座標	辺長	方向角	測角	DX	倍積 (Y×DX)
116-50	41203.927	-67507.884	25.021	182-17-09	88-38-45	-22.840	1541880.070560
116-31	41178.926	-67508.882	33.467	93-37-12	91-20-03	-27.114	1830435.826548
116-30	41176.813	-67475.482	14.207	3-35-59	89-58-47	12.066	-814159.165812
116-43	41190.992	-67474.590	10.795	3-35-25	179-59-26	24.953	-1683693.444270
116-51	41201.766	-67473.914	34.039	273-38-24	90-02-59	12.935	-872775.077590

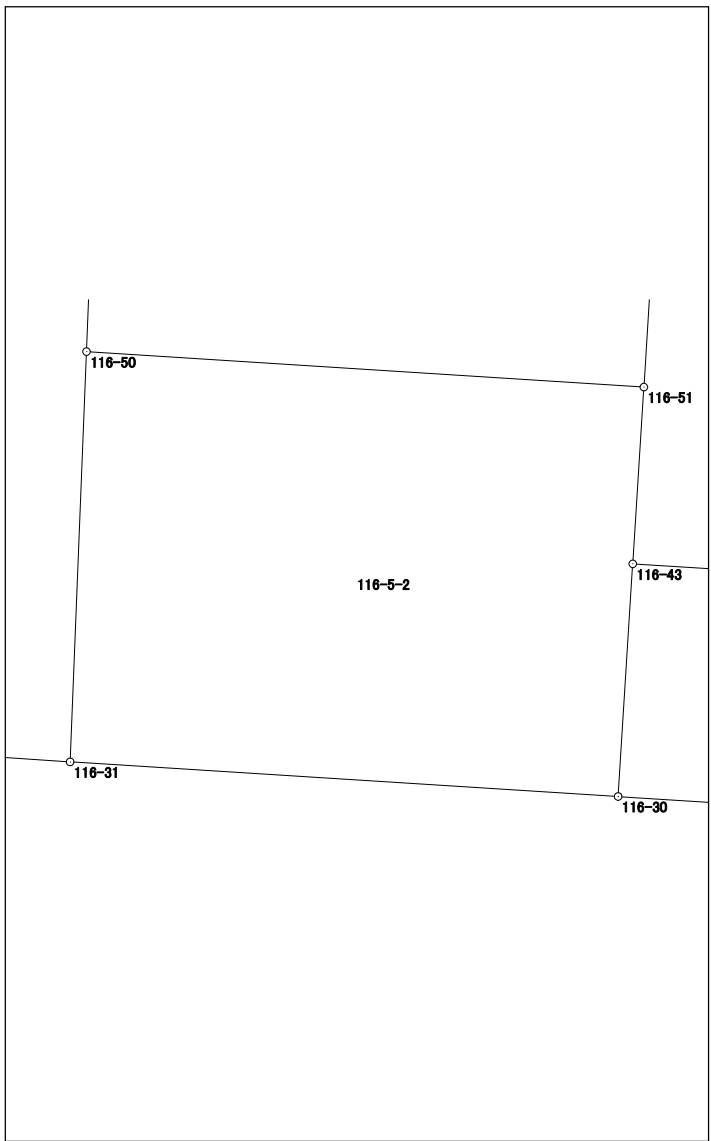


# 面積計算書 (座標法)

世界測地系 (測地成果2011)

所在	地番	公簿地目	現況地目	地積	所有者
前橋市六供町四丁目	116-5-3			233.91 m <sup>2</sup>	

点名	X座標	Y座標	辺長	方向角	測角	D <sub>X</sub>	倍積 (Y×D <sub>X</sub> )
116-60	41232.308	-67494.868	19.037	164-19-34	90-01-50	-20.266	1367850.994888
116-61	41213.979	-67489.725	4.755	164-18-34	179-59-00	-22.907	1545987.130575
116-63	41209.401	-67488.439	10.000	74-17-15	89-58-41	-1.870	126203.380930
116-5	41212.109	-67478.813	20.998	344-18-52	90-01-37	22.924	-1546884.309212
116-4	41232.325	-67484.490	3.982	298-49-27	134-30-35	22.136	-1493836.670640
116-3	41234.245	-67487.979	7.156	254-17-44	135-28-17	-0.017	1147.295643
						倍面積	467.822184
						面積	233.9110920

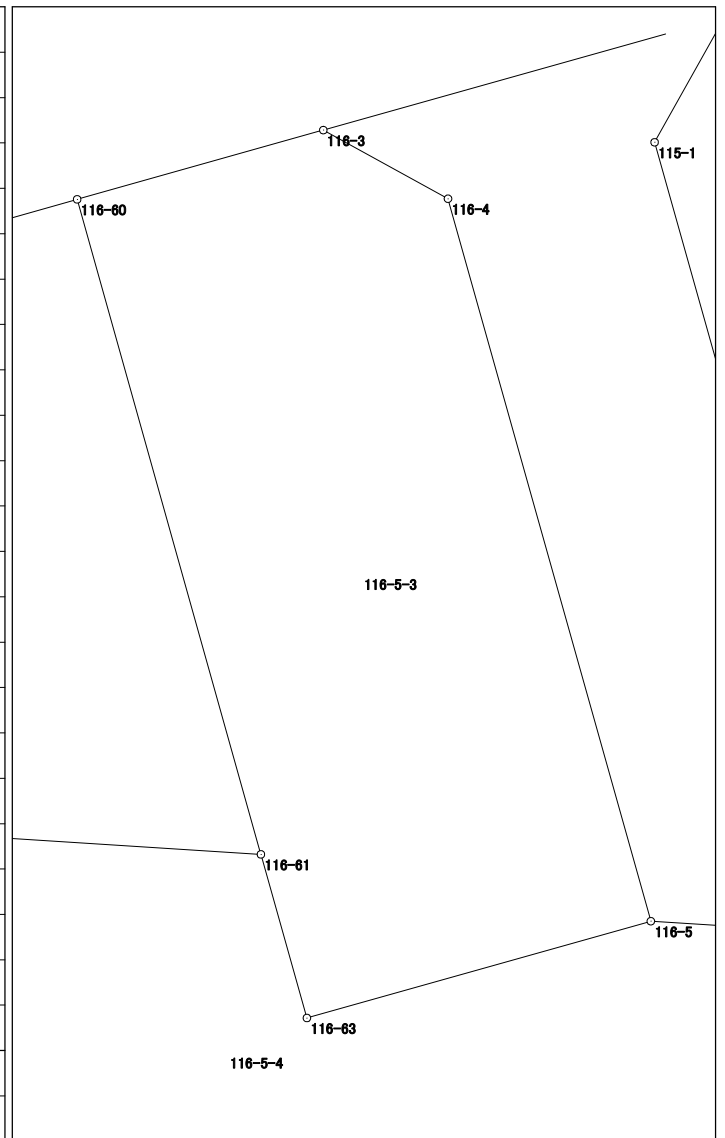




# 面積計算書 (座標法)

世界測地系 (測地成果2011)

所在	地番	公簿地目	現況地目	地積	所有者
前橋市六供町四丁目	116-5-4			345.32 m <sup>2</sup>	

点名	X座標	Y座標	辺長	方向角	測角	DX	倍積 (Y×DX)
116-62	41215.105	-67507.436	11.187	182-17-42	88-39-26	-10.052	678584.746672
116-50	41203.927	-67507.884	34.039	93-38-24	91-20-42	-13.339	900487.664676
116-51	41201.766	-67473.914	10.009	3-31-43	89-53-19	7.829	-528253.272706
116-27	41211.756	-67473.298	5.526	273-39-44	90-08-01	10.343	-697876.321214
116-5	41212.109	-67478.813	10.000	254-17-15	160-37-31	-2.355	158912.604615
116-63	41209.401	-67488.439	4.755	344-18-34	270-01-19	1.870	-126203.380930
116-61	41213.979	-67489.725	17.747	273-38-16	109-19-42	5.704	-384961.391400

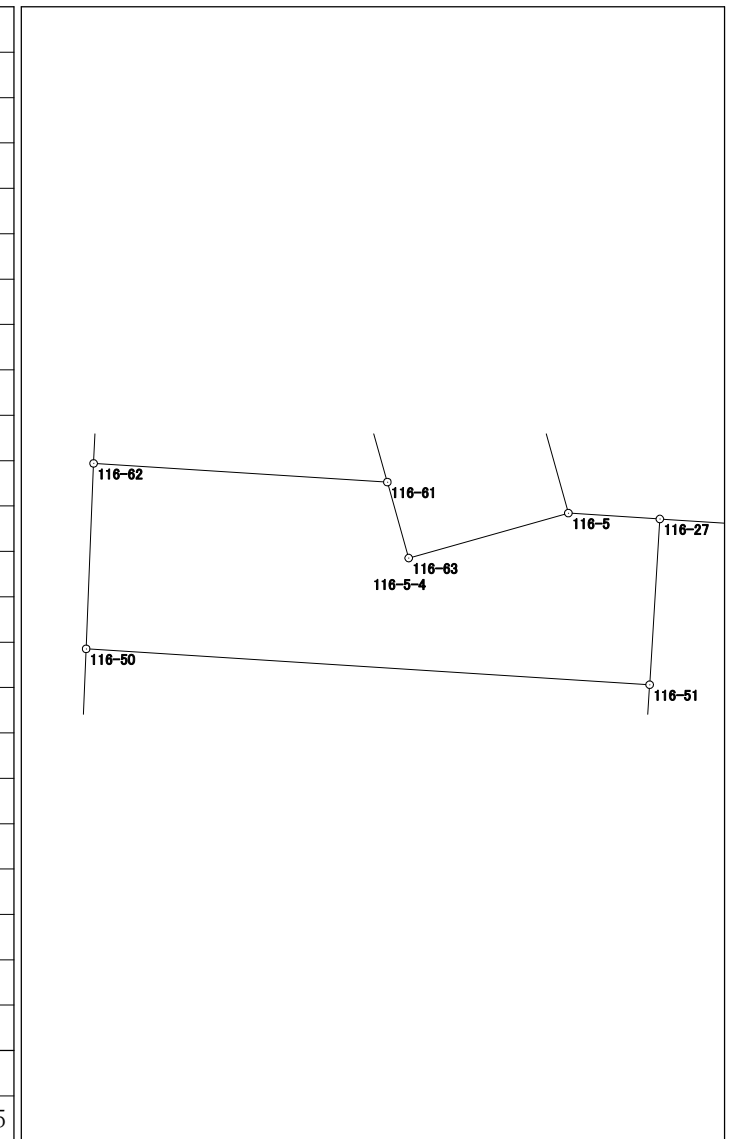

倍面積	690.649713
面積	345.3248565


# 面積計算書 (座標法)

世界測地系 (測地成果2011)

所在	地番	公簿地目	現況地目	地積	所有者
前橋市六供町四丁目	116-6			761.19 m <sup>2</sup>	

点名	X座標	Y座標	辺長	方向角	測角	DX	倍積 (Y×DX)
116-111	41188.694	-67438.074	20.807	3-33-46	89-57-43	18.469	-1245513.788706
116-110	41209.461	-67436.781	36.589	273-35-46	90-02-00	23.062	-1555227.043422
116-27	41211.756	-67473.298	10.009	183-31-43	89-55-57	-7.695	519207.028110
116-51	41201.766	-67473.914	10.795	183-35-25	180-03-42	-20.764	1401028.350296
116-43	41190.992	-67474.590	36.588	93-36-03	90-00-38	-13.072	882027.840480

倍面積	1522.386758
面積	761.1933790

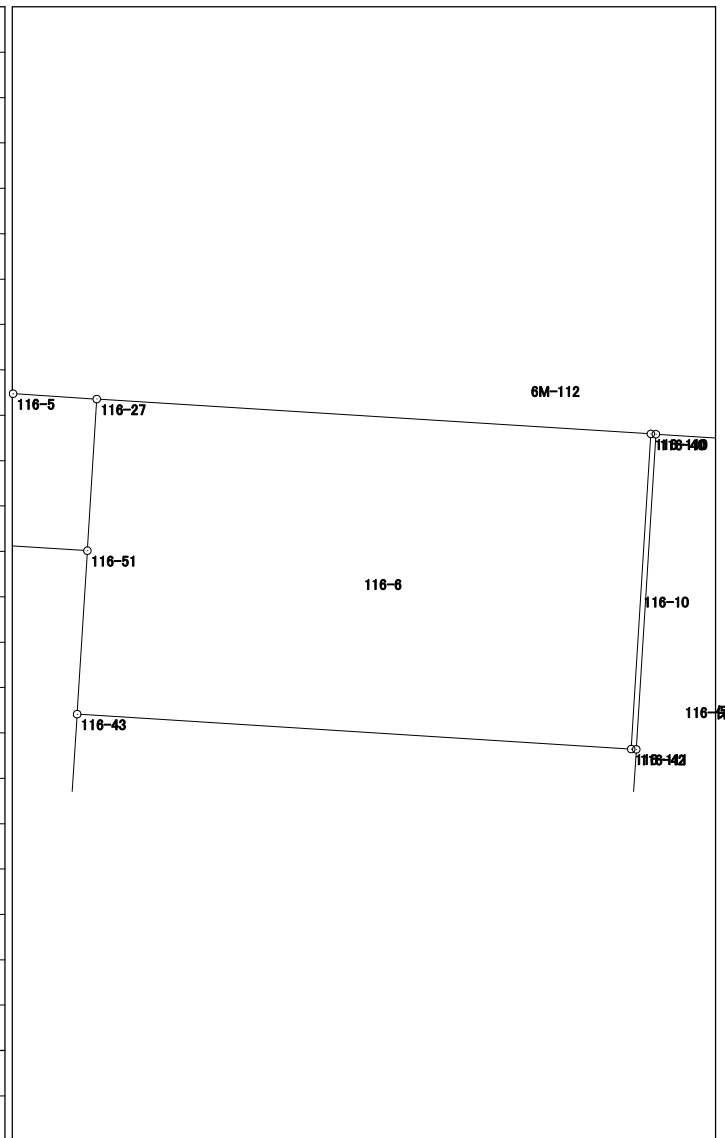


# 面積計算書 (座標法)

世界測地系 (測地成果2011)

所 在	地 番	公簿地目	現況地目	地 積	所 有 者
前橋市六供町四丁目	116-7			499.78 m <sup>2</sup>	

点 名	X 座標	Y 座標	辺 長	方 向 角	測 角	DX	倍 積 (Y×DX)
116-113	41209.059	-67430.445	17.000	185-56-20	92-17-57	-15.229	1026898.246905
116-48	41192.150	-67432.204	29.983	93-40-59	87-44-39	-18.835	1270085.562340
116-49	41190.224	-67402.283	14.146	3-38-08	89-57-09	12.192	-821768.634336
116-7	41204.342	-67401.386	4.030	318-54-13	135-16-05	17.155	-1156270.776830
116-6	41207.379	-67404.035	26.463	273-38-23	134-44-10	4.717	-317944.833095
倍面積						999.564984	
面 積						499.7824920	

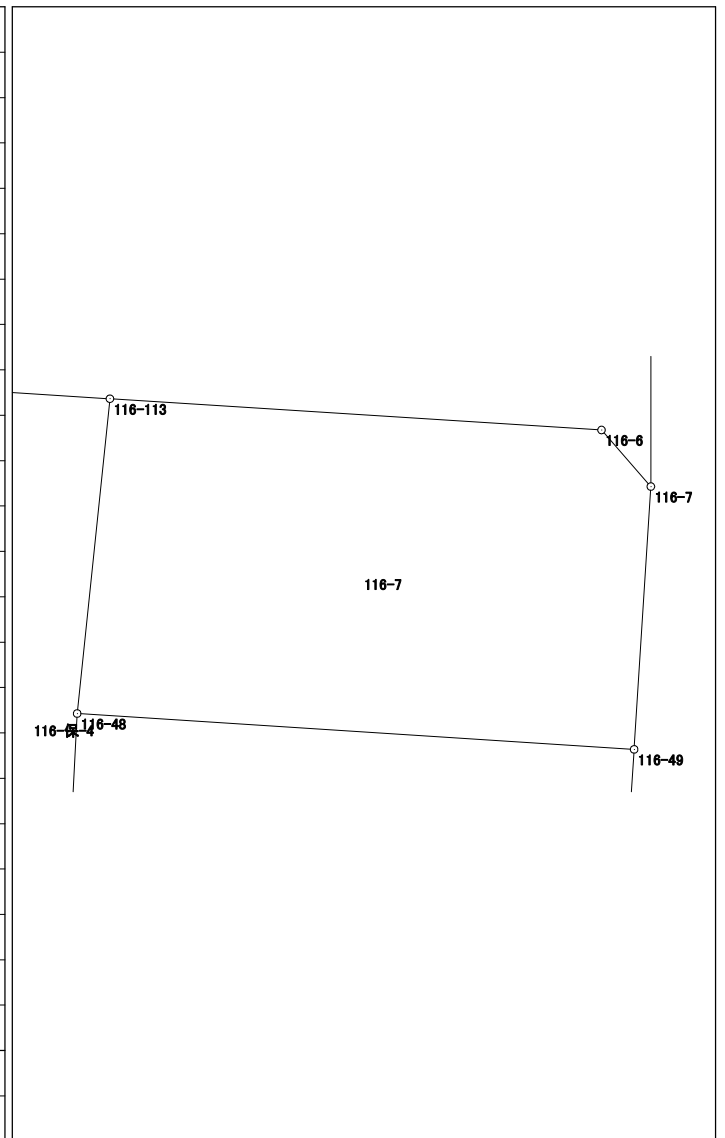

# 面積計算書 (座標法)

世界測地系 (測地成果2011)

所 在	地 番	公簿地目	現況地目	地 積	所 有 者
前橋市六供町四丁目	116-8-1			295.55 m <sup>2</sup>	

点 名	X 座 標	Y 座 標	辺 長	方 向 角	測 角	DX	倍 積 (Y×DX)
116-109	41209.738	-67527.339	29.591	182-19-13	90-00-52	-29.279	1977132.958581
116-108	41180.171	-67528.537	9.949	93-34-01	91-14-48	-30.186	2038416.417882
116-52	41179.552	-67518.607	29.810	2-20-09	88-46-08	29.166	-1969247.691762
116-37	41209.337	-67517.392	2.797	272-18-55	89-58-46	29.898	-2018634.986016
116-103	41209.450	-67520.187	7.158	272-18-21	179-59-26	0.401	-27075.594987
倍面積							591.103698
面 積							295.5518490


# 面積計算書 (座標法)

世界測地系 (測地成果2011)

所在	地番	公簿地目	現況地目	地積	所有者
前橋市六供町四丁目	116-8-2			379.62 m <sup>2</sup>	

点名	X座標	Y座標	辺長	方向角	測角	DX	倍積 (Y×DX)
116-38	41218.414	-67517.043	9.084	182-12-07	90-01-59	-8.817	595297.768131
116-37	41209.337	-67517.392	29.810	182-20-09	180-08-02	-38.862	2623860.887904
116-52	41179.552	-67518.607	9.745	93-40-59	91-20-50	-30.411	2053308.357477
116-31	41178.926	-67508.882	25.021	2-17-09	88-36-10	24.375	-1645528.998750
116-50	41203.927	-67507.884	11.187	2-17-42	180-00-33	36.179	-2442367.735236
116-62	41215.105	-67507.436	2.943	2-22-34	180-04-52	14.118	-953069.981448
116-39	41218.045	-67507.314	2.866	272-10-46	89-48-12	3.049	-205829.800386
116-105	41218.154	-67510.178	6.870	272-10-08	179-59-22	0.369	-24911.255682

倍面積	759.242010
面積	379.6210050

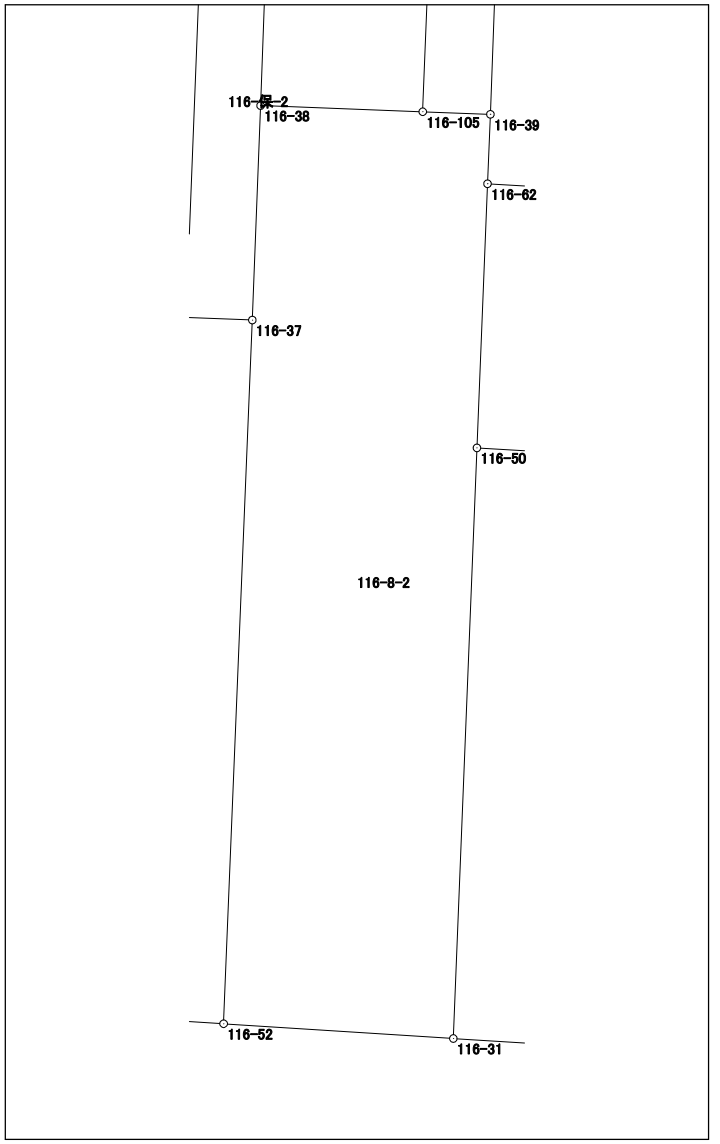


# 面積計算書（座標法）

世界測地系（測地成果2011）

所在	地番	公簿地目	現況地目	地積	所有者
前橋市六供町四丁目	116-9			30.69 m <sup>2</sup>	

点名	X座標	Y座標	辺長	方向角	測角	Dx	倍積 (Y×Dx)
116-107	41180.325	-67530.968	29.535	2-19-08	88-40-51	29.445	-1988449.352760
116-106	41209.836	-67529.773	1.040	272-15-35	89-56-27	29.552	-1995639.851696
116-35	41209.877	-67530.812	29.510	182-19-08	90-03-33	-29.445	1988444.759340
116-33	41180.391	-67532.006	1.040	93-38-17	91-19-09	-29.552	1995705.841312
						倍面積	61.396196
						面積	30.6980980

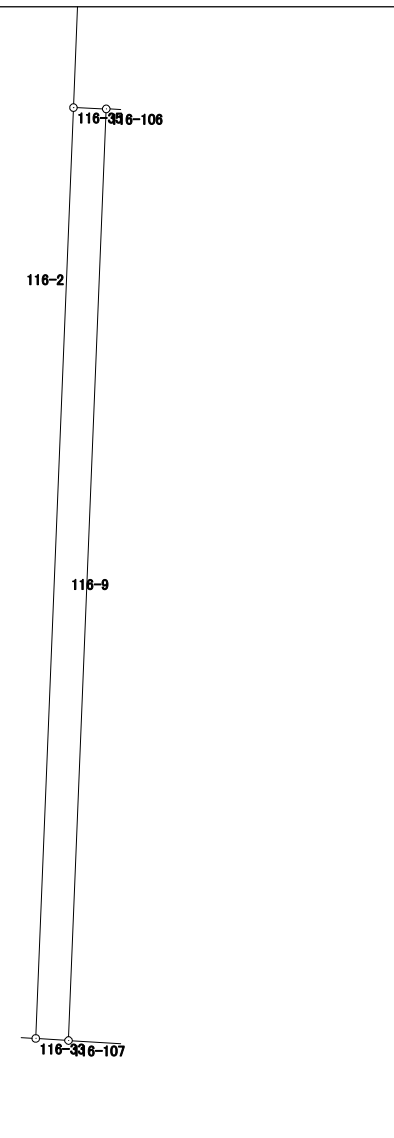

# 面積計算書（座標法）

世界測地系（測地成果2011）

所 在	地 番	公簿地目	現況地目	地 積	所 有 者
前橋市六供町四丁目	116-10			6.93 m <sup>2</sup>	

点 名	X 座標	Y 座標	辺 長	方 向 角	測 角	DX	倍 積 (Y×DX)
116-110	41209.461	-67436.781	20.807	183-33-46	89-57-16	-20.746	1399043.458626
116-111	41188.694	-67438.074	0.333	93-37-10	90-03-24	-20.788	1401902.682312
116-42	41188.673	-67437.742	20.807	3-33-56	89-56-46	20.746	-1399063.395532
116-40	41209.440	-67436.448	0.334	273-36-30	90-02-34	20.788	-1401868.881024
倍面積						13.864382	
面 積						6.9321910	

116-110


116-10

116-42

# 面積計算書（座標法）

所 在	地 番	公簿地目	現況地目	地 積	所 有 者
前橋市六供町四丁目	116-11			524.67 m <sup>2</sup>	

点 名	X 座標	Y 座標	辺 長	方 向 角	測 角	DX	倍 積 (Y×DX)
116-30	41176.813	-67475.482	36.925	93-36-36	90-00-37	-16.504	1113615.354928
116-41	41174.488	-67438.630	14.213	3-34-56	89-58-20	11.860	-799822.151800
116-42	41188.673	-67437.742	0.333	273-37-10	90-02-14	14.206	-958020.562852
116-111	41188.694	-67438.074	36.588	273-36-03	179-58-53	2.319	-156388.893606
116-43	41190.992	-67474.590	14.207	183-35-59	89-59-56	-11.881	801665.603790
						倍面積	1049.350460
						面 積	524.6752300

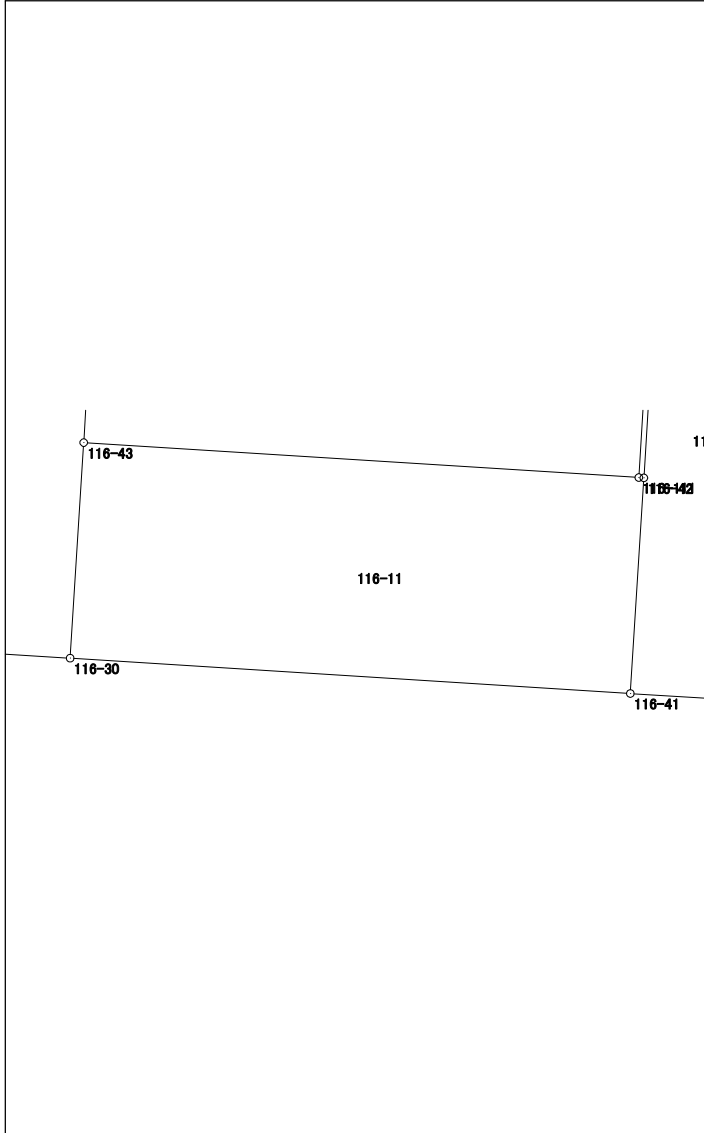




# 面積計算書（座標法）

世界測地系（測地成果2011）

所在	地番	公簿地目	現況地目	地積	所有者
前橋市六供町四丁目	116-13			537.88 m <sup>2</sup>	

点名	X座標	Y座標	辺長	方向角	測角	DX	倍積 (Y×DX)
116-48	41192.150	-67432.204	18.029	182-51-18	89-10-19	-16.081	1084377.272524
116-46	41174.143	-67433.102	29.754	93-36-33	90-45-15	-19.880	1340570.067760
116-8	41172.270	-67403.407	17.989	3-34-56	89-58-23	16.081	-1083914.187967
116-49	41190.224	-67402.283	29.983	273-40-59	90-06-03	19.880	-1339957.386040
倍面積							1075.766277
面積							537.8831385

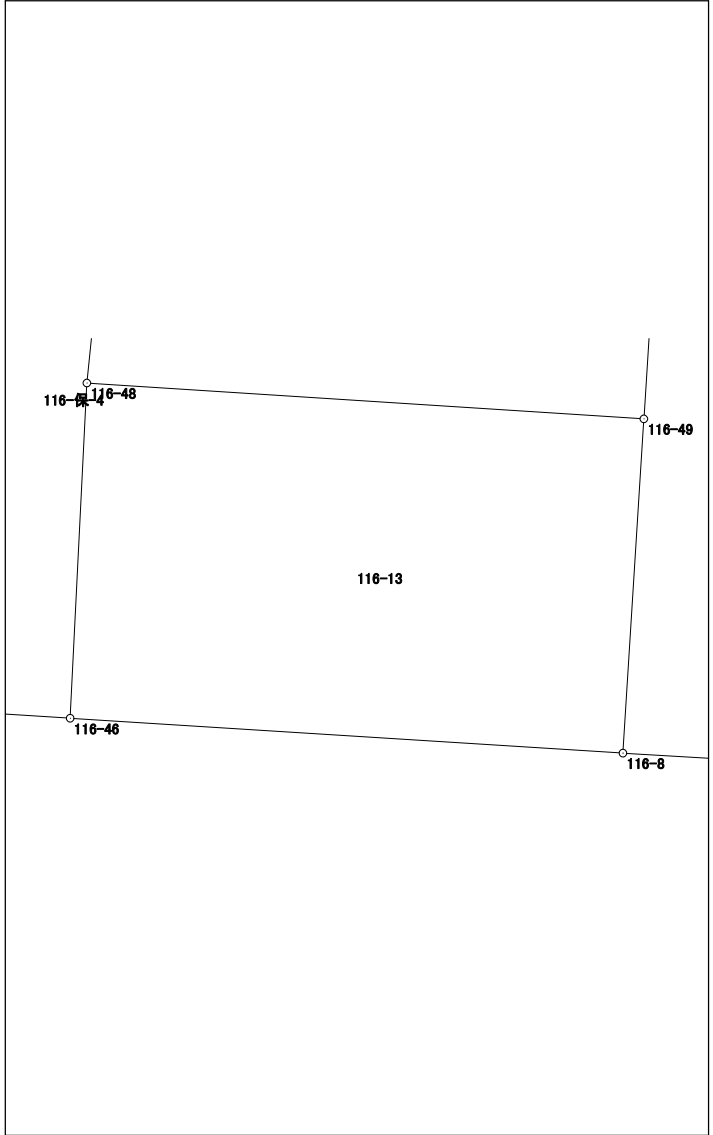


# 面積計算書（座標法）

世界測地系（測地成果2011）

所 在	地 番	公簿地目	現況地目	地 積	所 有 者
前橋市六供町四丁目	116-保-1			72.00 m <sup>2</sup>	

点 名	X 座標	Y 座標	辺 長	方 向 角	測 角	D X	倍 積 (Y×DX)
116-108	41180.171	-67528.537	29.591	2-19-13	88-41-44	29.413	-1986216.858781
116-109	41209.738	-67527.339	2.436	272-18-20	89-59-07	29.665	-2003198.511435
116-106	41209.836	-67529.773	29.535	182-19-08	90-00-48	-29.413	1986253.213249
116-107	41180.325	-67530.968	2.436	93-37-29	91-18-21	-29.665	2003306.165720

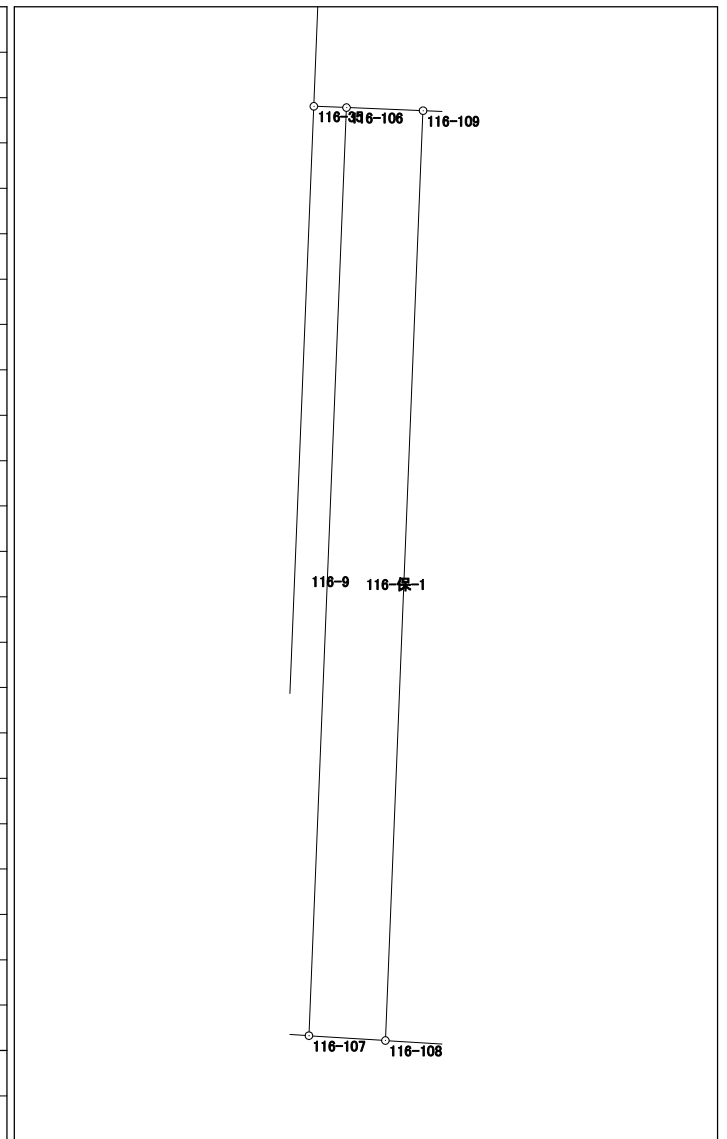

倍面積	144.008753
面 積	72.0043765


# 面積計算書（座標法）

世界測地系（測地成果2011）

所在	地番	公簿地目	現況地目	地積	所有者
前橋市六供町四丁目	116-保-2			54.00 m <sup>2</sup>	

点名	X座標	Y座標	辺長	方向角	測角	DX	倍積 (Y×DX)
116-102	41228.723	-67519.450	19.287	182-11-24	90-25-42	-19.187	1295495.687150
116-103	41209.450	-67520.187	2.797	92-18-55	90-07-31	-19.386	1308946.345182
116-37	41209.337	-67517.392	9.084	2-12-07	89-53-12	8.964	-605225.901888
116-38	41218.414	-67517.043	10.230	2-10-45	179-58-38	19.300	-1303078.929900
116-25	41228.637	-67516.654	2.797	271-45-42	89-34-57	10.309	-696029.186086

倍面積	108.014458
面積	54.0072290

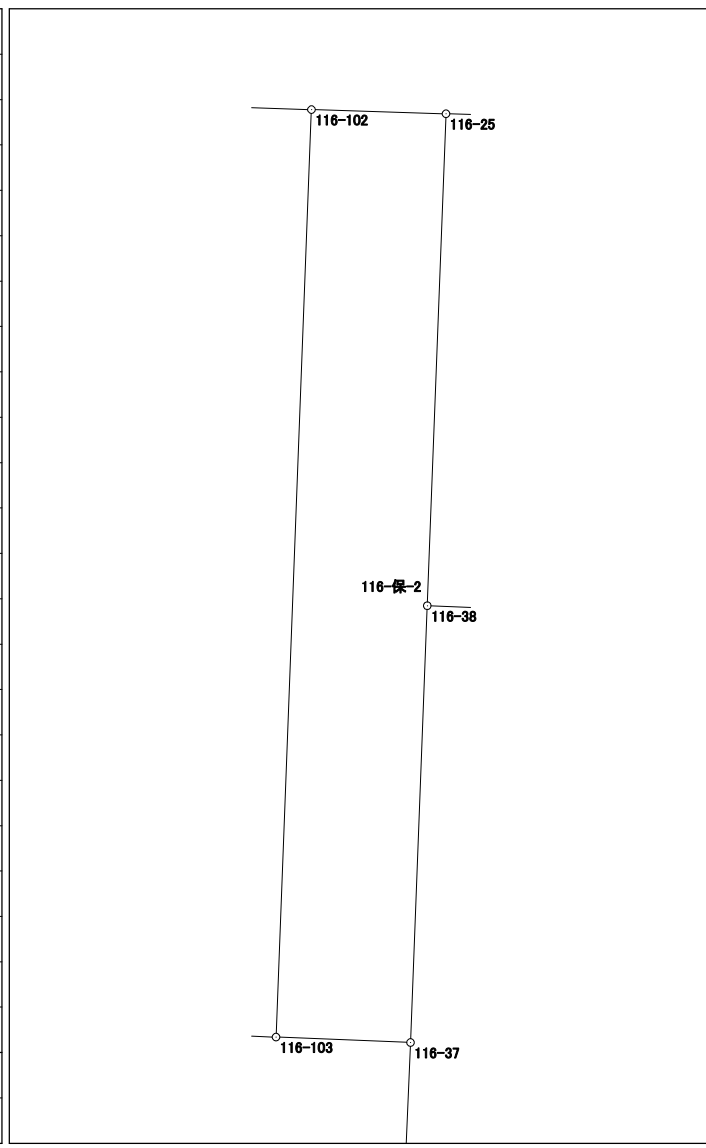


# 面積計算書 (座標法)

世界測地系 (測地成果2011)

所在	地番	公簿地目	現況地目	地積	所有者
前橋市六供町四丁目	116-保-3			30.00 m <sup>2</sup>	

点名	X座標	Y座標	辺長	方向角	測角	DX	倍積 (Y×DX)
116-104	41228.418	-67509.784	10.272	182-11-54	90-24-37	-10.232	690760.109888
116-105	41218.154	-67510.178	2.866	92-10-46	89-58-52	-10.373	700283.076394
116-39	41218.045	-67507.314	10.876	2-11-50	90-01-04	10.759	-726311.191326
116-26	41228.913	-67506.897	1.935	254-11-49	71-59-59	10.341	-698088.821877
116-2	41228.386	-67508.759	1.025	271-47-17	197-35-28	-0.495	33416.835705
						倍面積	60.008784
						面積	30.0043920

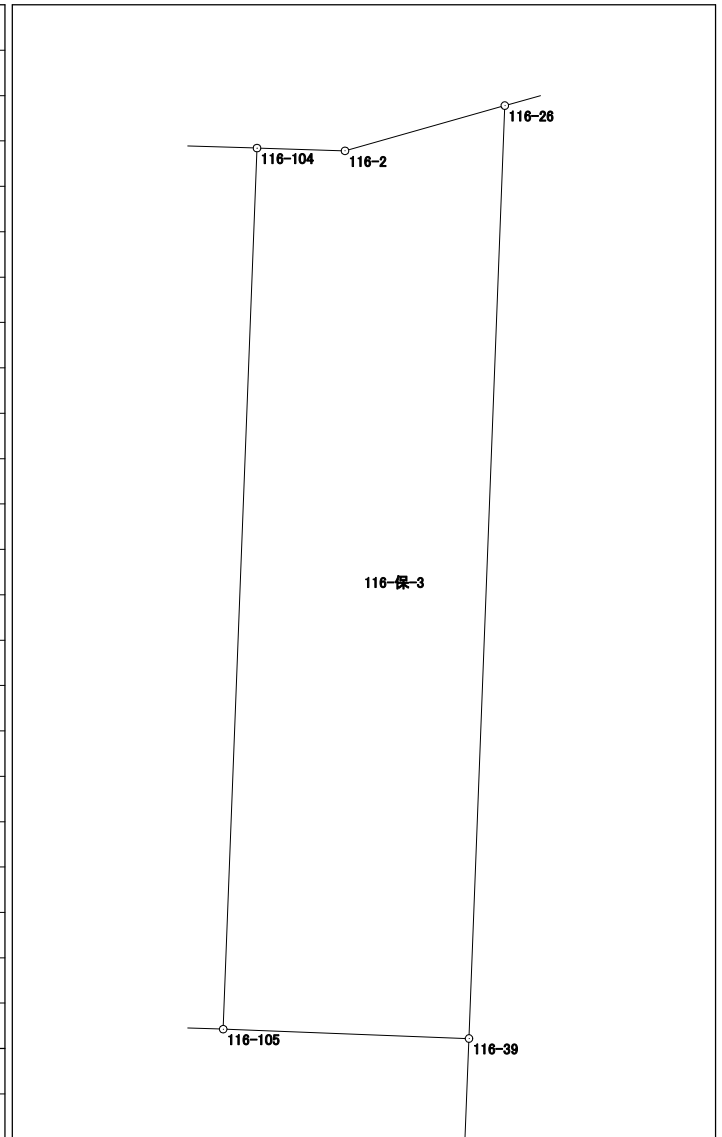

# 面積計算書（座標法）

世界測地系（測地成果2011）

所 在	地 番	公簿地目	現況地目	地 積	所 有 者
前橋市六供町四丁目	116-保-4			194.00 m <sup>2</sup>	

点 名	X 座標	Y 座標	辺 長	方 向 角	測 角	DX	倍 積 (Y×DX)
116-48	41192.150	-67432.204	17.000	5-56-20	183-05-02	34.916	-2354462.834864
116-113	41209.059	-67430.445	6.015	273-37-54	87-41-34	17.290	-1165872.394050
116-40	41209.440	-67436.448	20.807	183-33-56	89-56-02	-20.386	1374759.428928
116-42	41188.673	-67437.742	14.213	183-34-56	180-01-00	-34.952	2357083.958384
116-41	41174.488	-67438.630	5.539	93-34-16	89-59-20	-14.530	979883.293900
116-46	41174.143	-67433.102	18.029	2-51-18	89-17-02	17.662	-1191003.447524
倍面積						388.004774	
面 積						194.0023870	

