



118街区 画地出来形確認図 (4556.92m²)

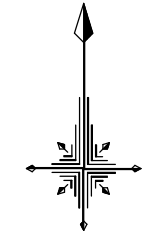

S=1/500

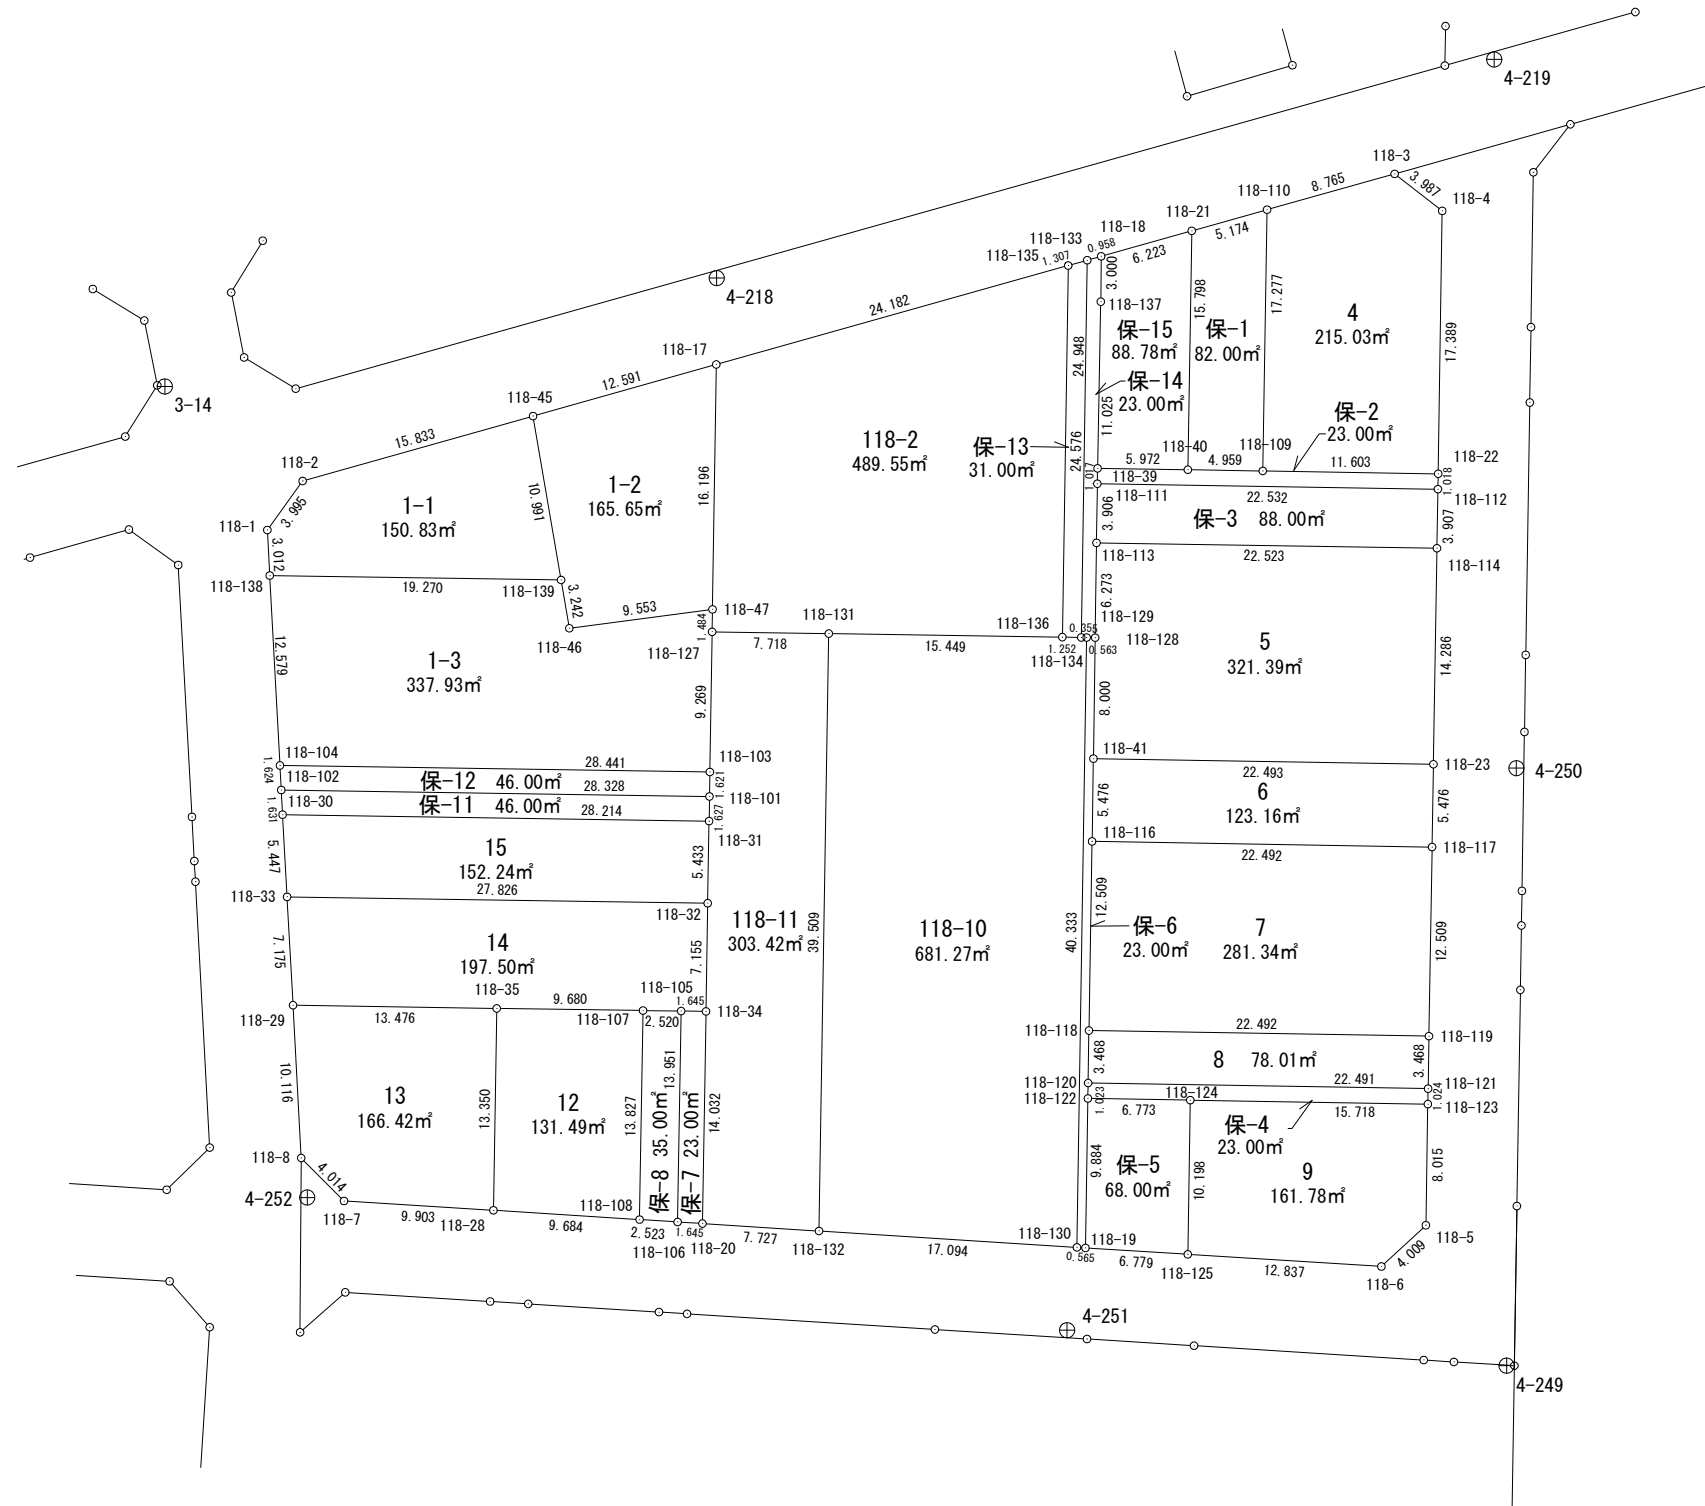


面積計算書（座標法）

世界測地系（測地成果2011）

所在	地番	公簿地目	現況地目	地積	所有者
前橋市六供町四丁目	118-1-1			150.83 m ²	

点名	X座標	Y座標	辺長	方向角	測角	DX	倍積 (Y×DX)
118-45	41264.593	-67379.997	15.833	254-16-04	83-58-43	6.541	-440732.560377
118-2	41260.300	-67395.237	3.995	215-45-46	141-29-42	-7.535	507823.110795
118-1	41257.058	-67397.572	3.012	176-56-10	141-10-24	-6.250	421234.825000
118-138	41254.050	-67397.411	19.270	90-51-55	93-55-45	-3.299	222344.058889
118-139	41253.759	-67378.143	10.991	350-17-21	79-25-26	10.543	-710367.761649
						倍面積	301.672658
						面積	150.8363290

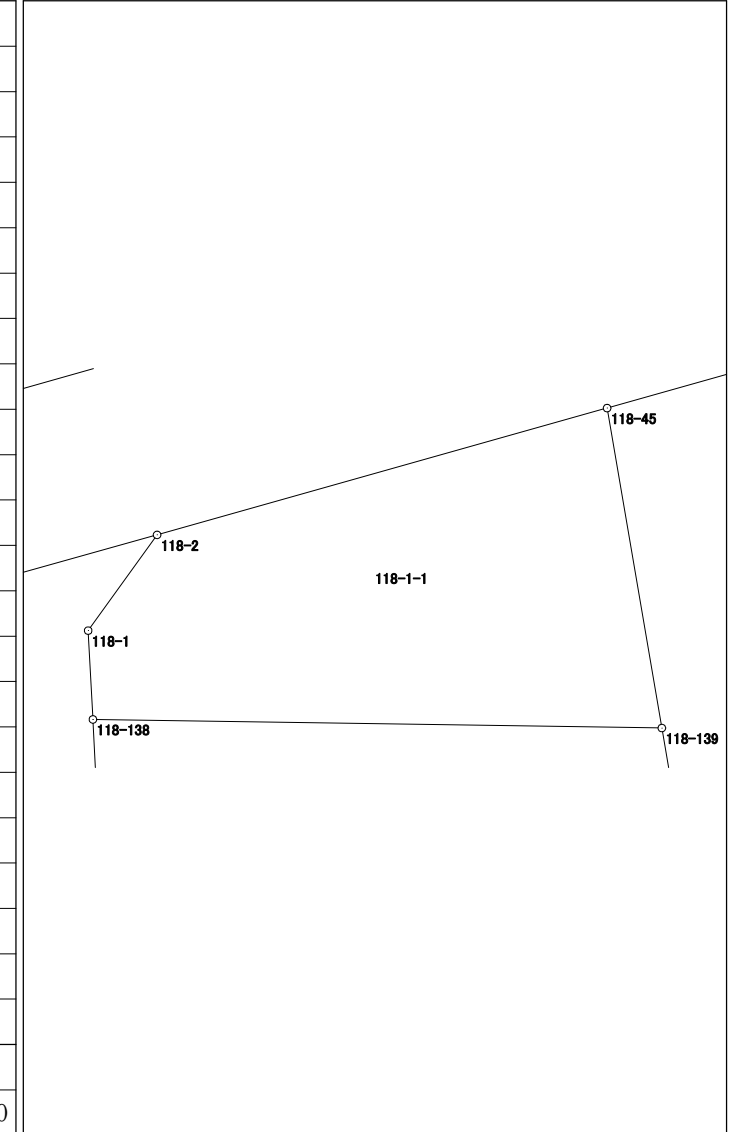


面積計算書 (座標法)

世界測地系 (測地成果2011)

所在	地番	公簿地目	現況地目	地積	所有者
前橋市六供町四丁目	118-1-2			165.65 m ²	

点名	X座標	Y座標	辺長	方向角	測角	DX	倍積 (Y×DX)
118-45	41264.593	-67379.997	10.991	170-17-21	96-00-43	-14.246	959895.437262
118-139	41253.759	-67378.143	3.242	170-17-16	179-59-55	-14.030	945315.346290
118-46	41250.563	-67377.596	9.553	82-29-36	92-12-20	-1.948	131251.557008
118-47	41251.811	-67368.125	16.196	0-52-39	98-23-03	17.442	-1175034.836250
118-17	41268.005	-67367.877	12.591	254-16-38	73-23-59	12.782	-861096.203814
						倍面積	331.300496
						面積	165.6502480

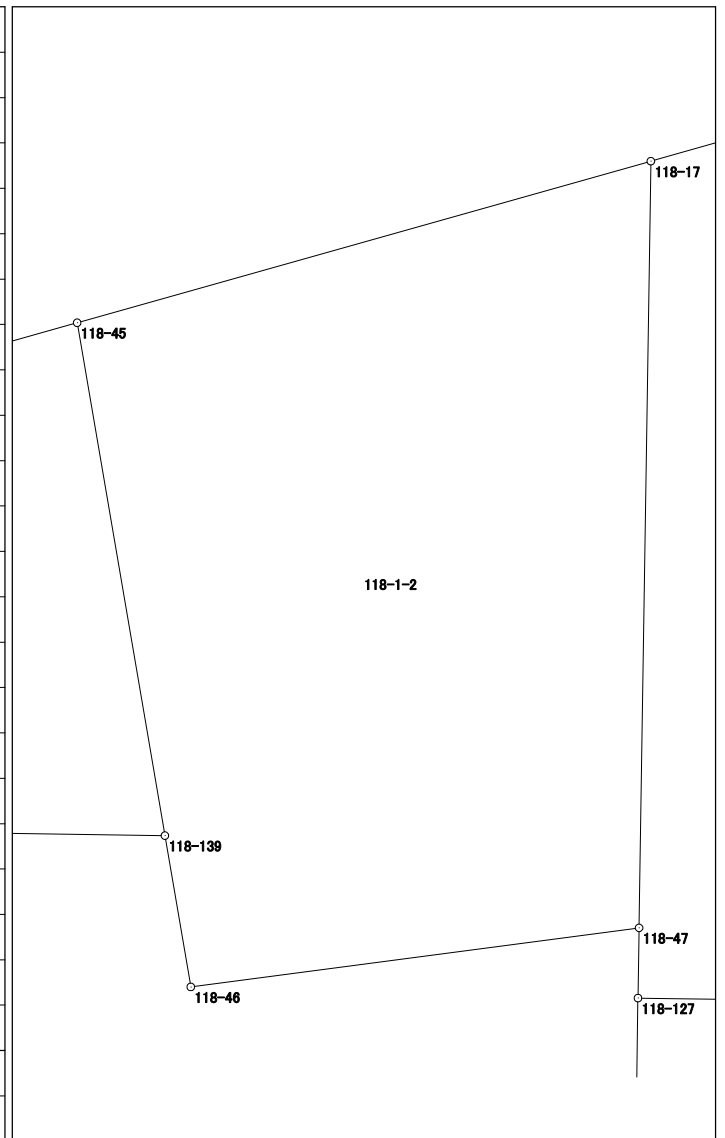


面積計算書（座標法）

世界測地系（測地成果2011）

所在	地番	公簿地目	現況地目	地積	所有者
前橋市六供町四丁目	118-1-3			337.93 m ²	

点名	X座標	Y座標	辺長	方向角	測角	DX	倍積 (Y×DX)
118-138	41254.050	-67397.411	12.579	176-55-59	86-04-04	-12.270	826966.232970
118-104	41241.489	-67396.738	28.441	90-51-59	93-56-00	-12.991	875551.023358
118-103	41241.059	-67368.300	9.269	0-56-00	90-04-01	8.838	-595401.035400
118-127	41250.327	-67368.149	1.484	0-55-36	179-59-36	10.752	-724342.338048
118-47	41251.811	-67368.125	9.553	262-29-36	81-34-00	0.236	-15898.877500
118-46	41250.563	-67377.596	3.242	350-17-16	267-47-40	1.948	-131251.557008
118-139	41253.759	-67378.143	19.270	270-51-55	100-34-39	3.487	-234947.584641
						倍面積	675.863731
						面積	337.9318655

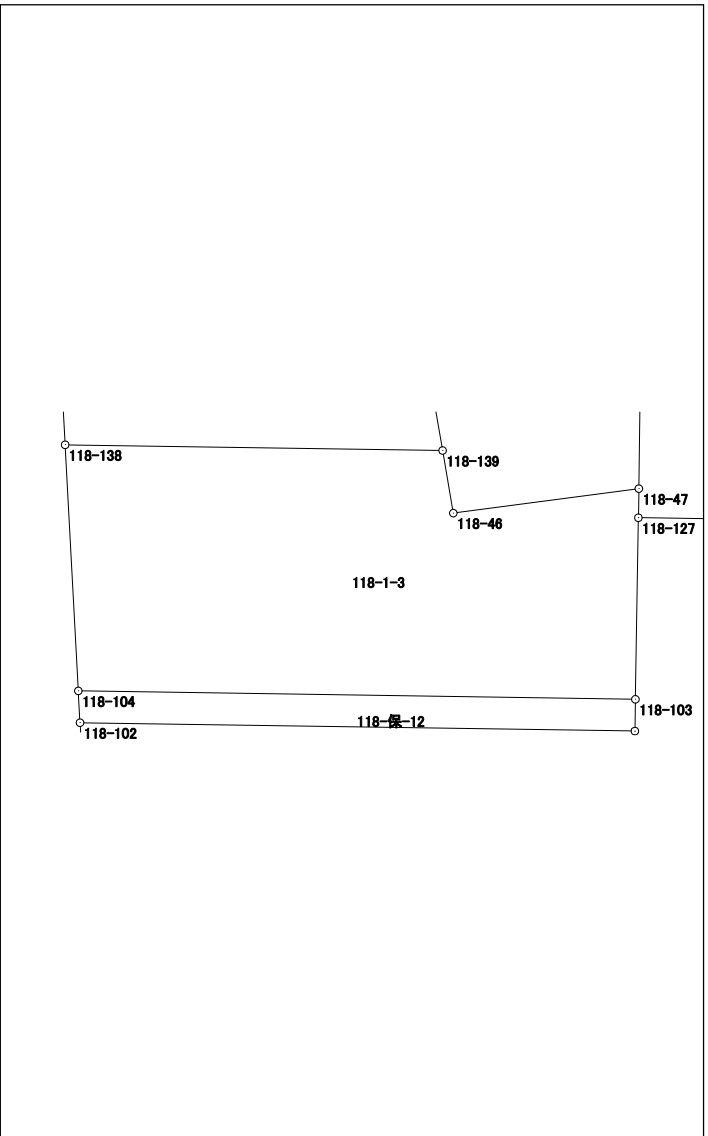


面積計算書 (座標法)

世界測地系 (測地成果2011)

所 在	地 番	公簿地目	現況地目	地 積	所 有 者
前橋市六供町四丁目	118-2			489.55 m ²	

点 名	X 座標	Y 座標	辺 長	方 向 角	測 角	DX	倍 積 (Y×DX)			
118-135	41274.546	-67344.596	24.182	254-18-25	73-24-00	18.032	-1214357.755072			
118-17	41268.005	-67367.877	16.196	180-52-39	106-34-14	-22.735	1531608.683595			
118-47	41251.811	-67368.125	1.484	180-55-36	180-02-57	-17.678	1190933.713750			
118-127	41250.327	-67368.149	7.718	90-52-34	89-56-58	-1.602	107923.774698			
118-131	41250.209	-67360.432	15.449	90-52-31	179-59-57	-0.354	23845.592928			
118-136	41249.973	-67344.985	24.576	0-54-25	90-01-54	24.337	-1638974.899945			
							倍面積	979.109954		
							面 積	489.5549770		

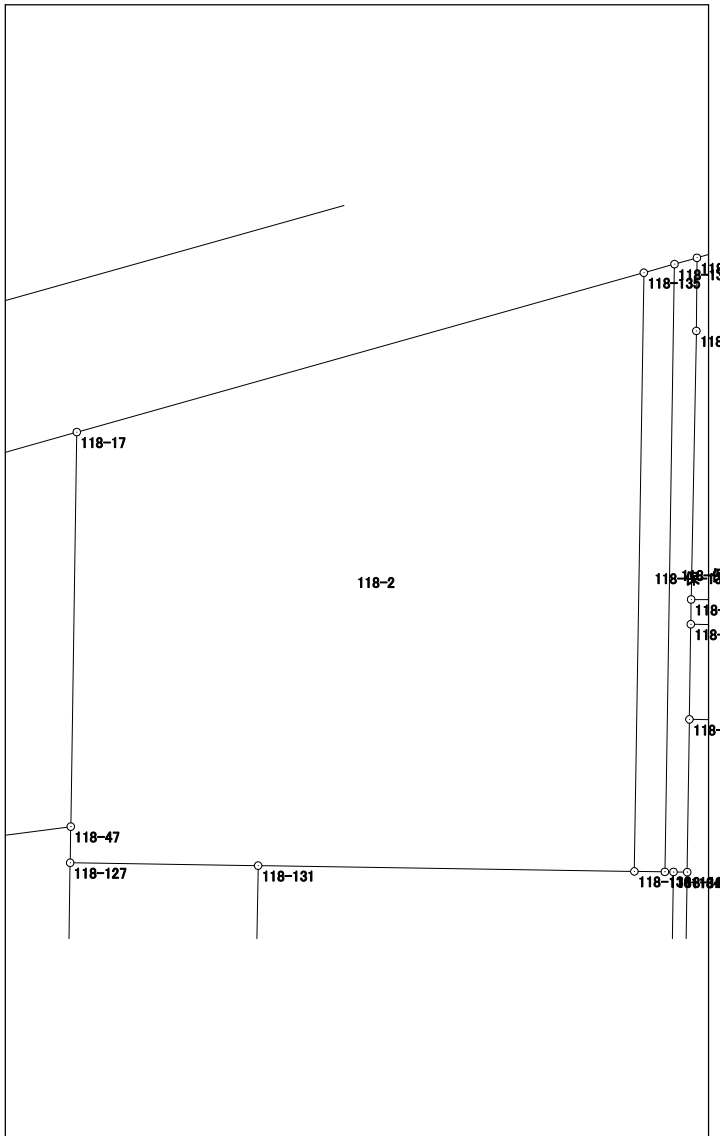


面積計算書（座標法）

世界測地系（測地成果2011）

所 在	地 番	公簿地目	現況地目	地 積	所 有 者
前橋市六供町四丁目	118-4			215.03 m ²	

点 名	X 座標	Y 座標	辺 長	方 向 角	測 角	DX	倍 積 (Y×DX)
118-110	41278.241	-67331.443	17.277	180-56-07	106-36-57	-19.644	1322658.866292
118-109	41260.966	-67331.725	11.603	90-56-00	89-59-53	-17.464	1175881.245400
118-22	41260.777	-67320.124	17.389	0-53-11	89-57-11	17.198	-1157771.492552
118-4	41278.164	-67319.855	3.987	307-50-18	126-57-07	19.833	-1335154.684215
118-3	41280.610	-67323.004	8.765	254-19-10	126-28-52	0.077	-5183.871308
						倍面積	430.063617
						面積	215.0318085

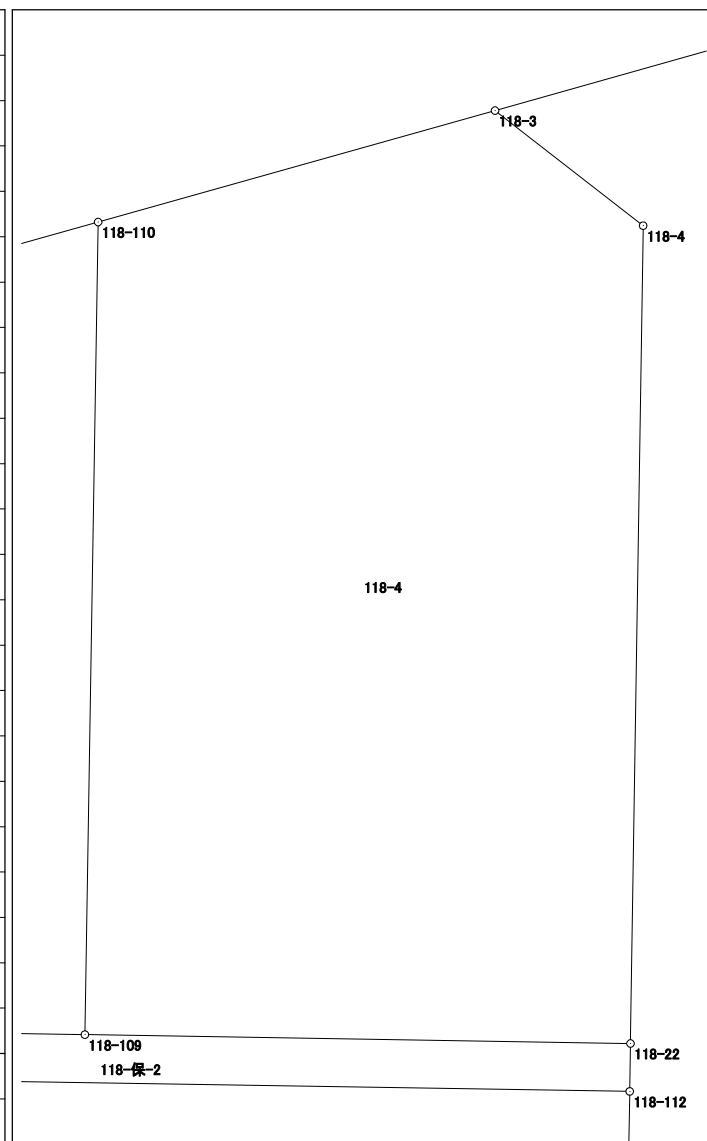


面積計算書 (座標法)

世界測地系 (測地成果2011)

所 在	地 番	公簿地目	現況地目	地 積	所 有 者
前橋市六供町四丁目	118-5			321.39 m ²	

点 名	X 座標	Y 座標	辺 長	方 向 角	測 角	DX	倍 積 (Y×DX)
118-113	41256.212	-67342.725	6.273	180-49-20	89-54-32	-5.913	398197.532925
118-128	41249.940	-67342.815	8.000	180-48-59	179-59-39	-14.271	961049.312865
118-41	41241.941	-67342.929	22.493	90-56-51	90-07-52	-8.371	563727.658659
118-23	41241.569	-67320.439	14.286	0-56-19	89-59-28	13.912	-936561.947368
118-114	41255.853	-67320.205	22.523	270-54-48	89-58-29	14.643	-985769.761815

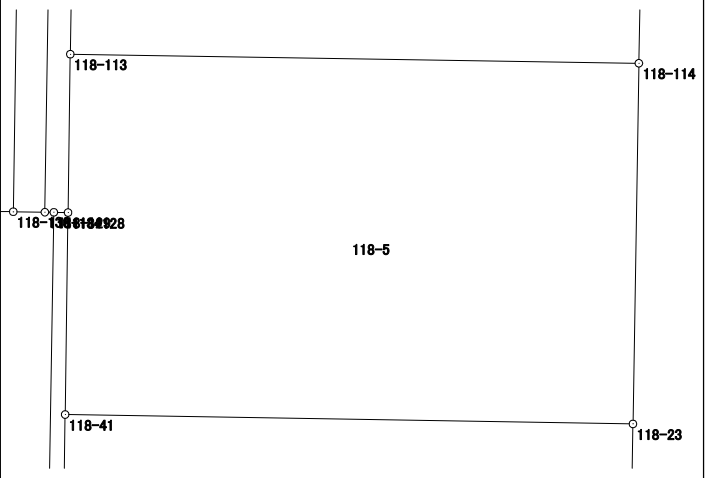

倍面積	642.795266
面 積	321.3976330

面積計算書（座標法）

世界測地系（測地成果2011）

所 在	地 番	公簿地目	現況地目	地 積	所 有 者
前橋市六供町四丁目	118-6			123.16 m ²	


点 名	X 座標	Y 座標	辺 長	方 向 角	測 角	DX	倍 積 (Y×DX)	
118-116	41236.466	-67343.018	22.492	90-56-52	90-00-59	-5.847	393754.626246	
118-117	41236.094	-67320.529	5.476	0-56-30	89-59-38	5.103	-343536.659487	
118-23	41241.569	-67320.439	22.493	270-56-51	90-00-21	5.847	-393622.606833	
118-41	41241.941	-67342.929	5.476	180-55-53	89-59-02	-5.103	343650.966687	
倍面積							246.326613	
面 積							123.1633065	

面積計算書（座標法）

世界測地系（測地成果2011）

所 在	地 番	公簿地目	現況地目	地 積	所 有 者
前橋市六供町四丁目	118-10			681.27 m ²	

点 名	X 座 標	Y 座 標	辺 長	方 向 角	測 角	DX	倍 積 (Y×DX)
118-130	41209.621	-67344.019	40.333	0-54-38	87-16-29	39.244	-2642848.681636
118-129	41249.949	-67343.378	0.355	270-48-25	89-53-47	40.333	-2716160.464874
118-134	41249.954	-67343.733	1.252	270-52-10	180-03-45	0.024	-1616.249592
118-136	41249.973	-67344.985	15.449	270-52-31	180-00-21	0.255	-17172.971175
118-131	41250.209	-67360.432	39.509	180-56-18	90-03-47	-39.268	2645109.443776
118-132	41210.705	-67361.079	17.094	93-38-09	92-41-51	-40.588	2734051.474452
						倍面積	1362.550951
						面 積	681.2754755

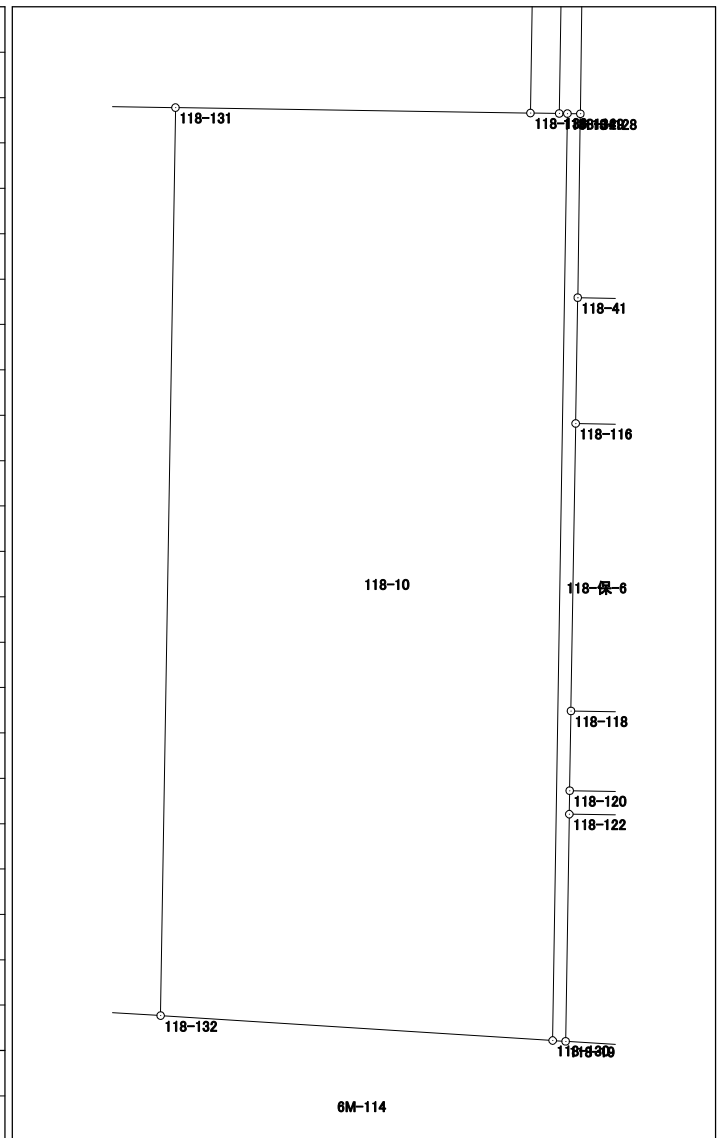


面積計算書（座標法）

世界測地系（測地成果2011）

所 在	地 番	公簿地目	現況地目	地 積	所 有 者
前橋市六供町四丁目	118-11			303.42 m ²	

点 名	X 座標	Y 座標	辺 長	方 向 角	測 角	DX	倍 積 (Y×DX)
118-132	41210.705	-67361.079	39.509	0-56-18	87-18-08	39.014	-2628025.136106
118-131	41250.209	-67360.432	7.718	270-52-34	89-56-16	39.622	-2668955.036704
118-127	41250.327	-67368.149	9.269	180-56-00	90-03-26	-9.150	616418.563350
118-103	41241.059	-67368.300	1.621	180-55-08	179-59-08	-10.889	733573.418700
118-101	41239.438	-67368.326	1.627	180-57-03	180-01-55	-3.248	218812.322848
118-31	41237.811	-67368.353	5.433	180-56-19	179-59-16	-7.059	475553.203827
118-32	41232.379	-67368.442	7.155	180-54-18	179-57-59	-12.586	847899.211012
118-34	41225.225	-67368.555	14.032	180-57-35	180-03-17	-21.184	1427135.469120
118-20	41211.195	-67368.790	7.727	93-38-10	92-40-35	-14.520	978194.830800
						倍面積	606.846847
						面 積	303.4234235

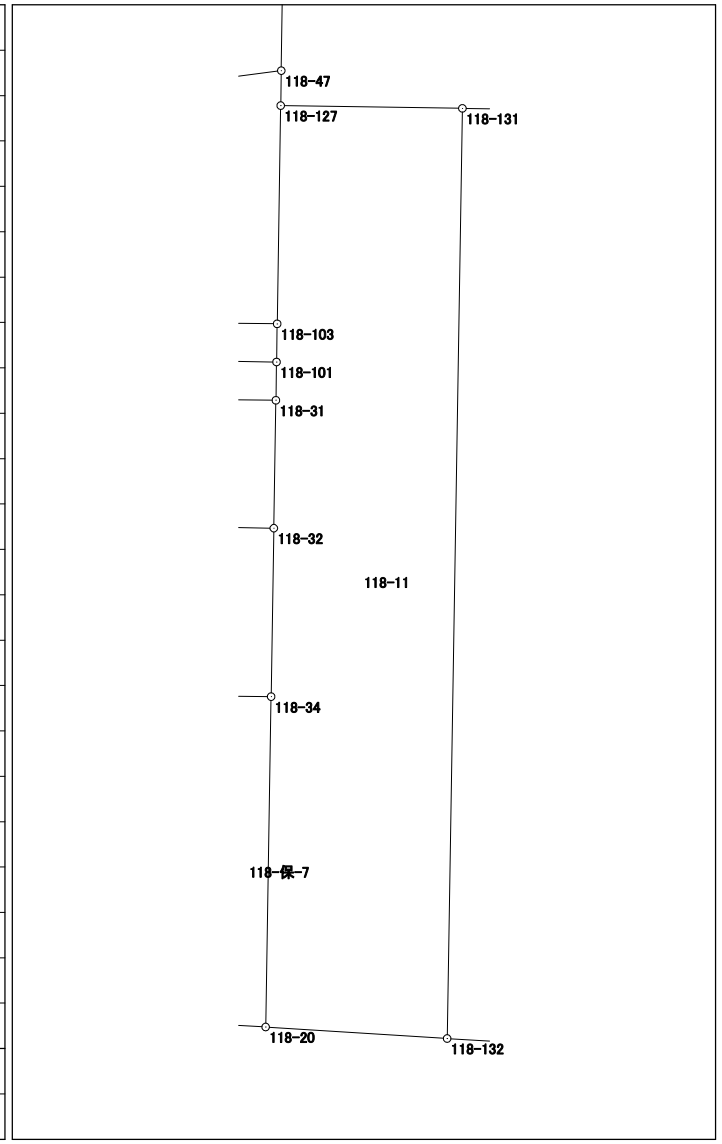


面積計算書（座標法）

世界測地系（測地成果2011）

所 在	地 番	公簿地目	現況地目	地 積	所 有 者
前橋市六供町四丁目	118-15			152.24 m ²	

点 名	X 座標	Y 座標	辺 長	方 向 角	測 角	DX	倍 積 (Y×DX)
118-30	41238.238	-67396.564	5.447	176-51-12	85-59-10	-5.012	337791.578768
118-33	41232.799	-67396.265	27.826	90-51-53	94-00-41	-5.859	394874.716635
118-32	41232.379	-67368.442	5.433	0-56-19	90-04-26	5.012	-337650.631304
118-31	41237.811	-67368.353	28.214	270-52-02	89-55-43	5.859	-394711.180227
						倍面積	304.483872
						面 積	152.2419360

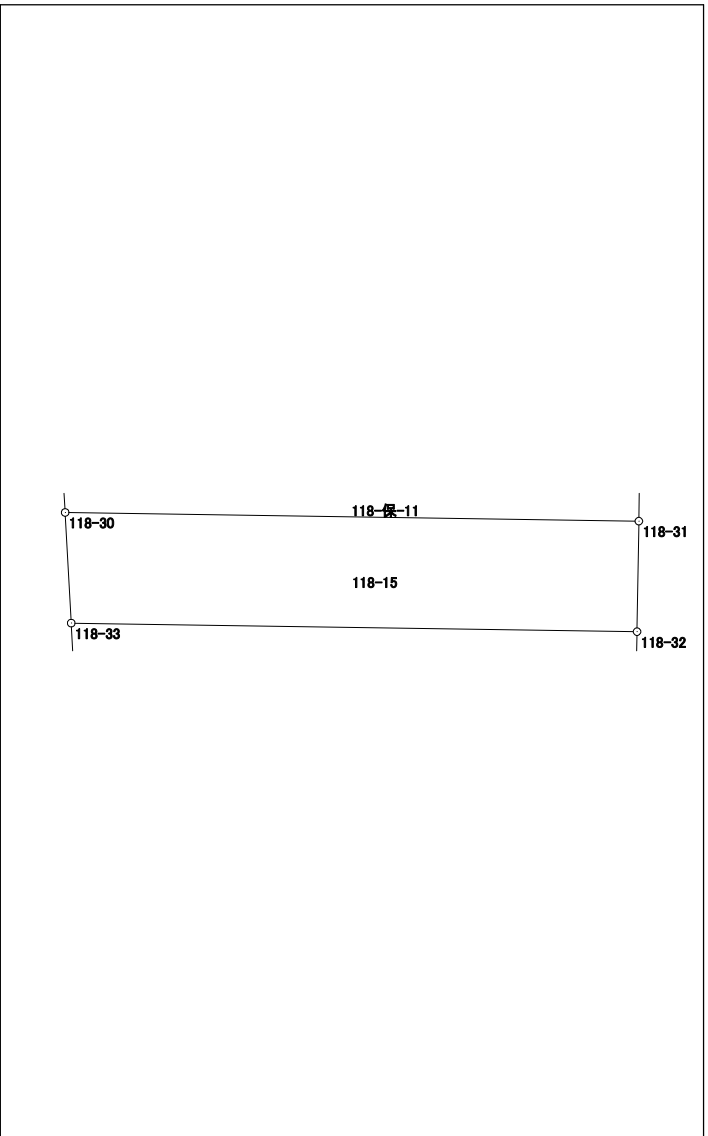


面積計算書（座標法）

世界測地系（測地成果2011）

所在	地番	公簿地目	現況地目	地積	所有者
前橋市六供町四丁目	118-保-7			23.00 m ²	

点名	X 座標	Y 座標	辺長	方向角	測角	DX	倍積 (Y×DX)
118-105	41225.248	-67370.200	13.951	180-57-10	90-09-06	-13.926	938197.405200
118-106	41211.299	-67370.432	1.645	93-37-27	92-40-17	-14.053	946756.680896
118-20	41211.195	-67368.790	14.032	0-57-35	87-20-08	13.926	-938177.769540
118-34	41225.225	-67368.555	1.645	270-48-04	89-50-29	14.053	-946730.303415
倍面積						46.013141	
面積						23.0065705	

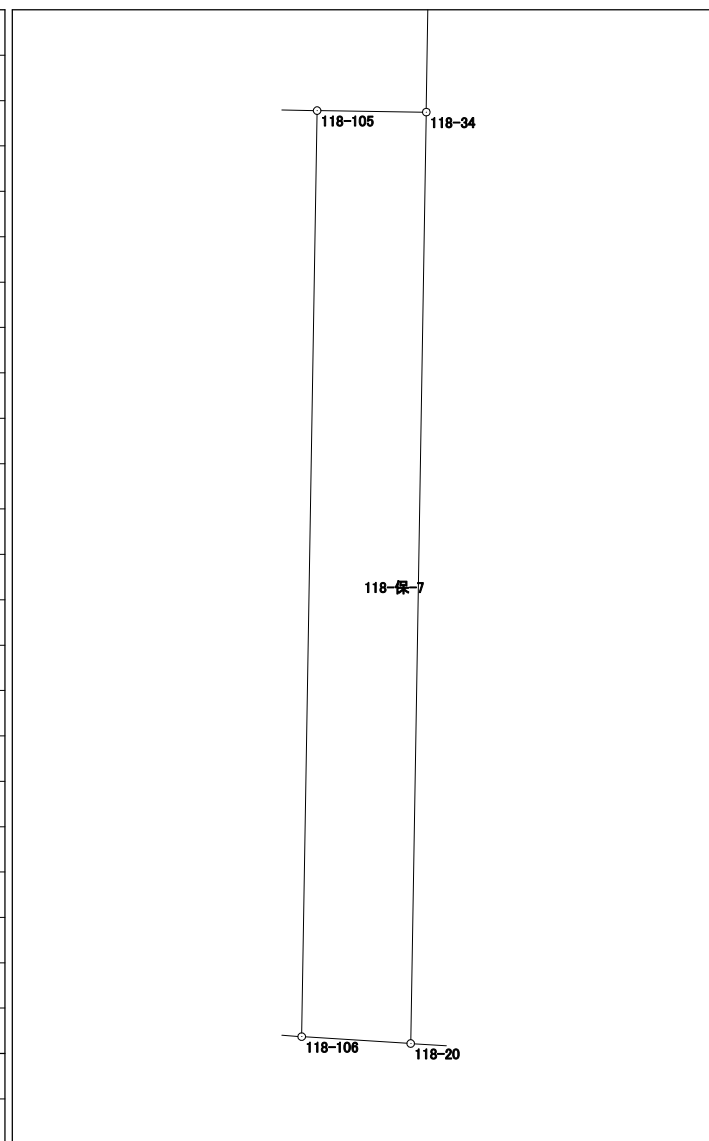


面積計算書（座標法）

世界測地系（測地成果2011）

所 在	地 番	公簿地目	現況地目	地 積	所 有 者
前橋市六供町四丁目	118-保-8			35.00 m ²	

点 名	X 座標	Y 座標	辺 長	方 向 角	測 角	DX	倍 積 (Y×DX)
118-107	41225.283	-67372.720	13.827	180-57-11	90-09-26	-13.790	929069.808800
118-108	41211.458	-67372.950	2.523	93-36-47	92-39-36	-13.984	942143.332800
118-106	41211.299	-67370.432	13.951	0-57-10	87-20-23	13.790	-929038.257280
118-105	41225.248	-67370.200	2.520	270-47-45	89-50-35	13.984	-942104.876800
						倍面積	70.007520
						面 積	35.0037600

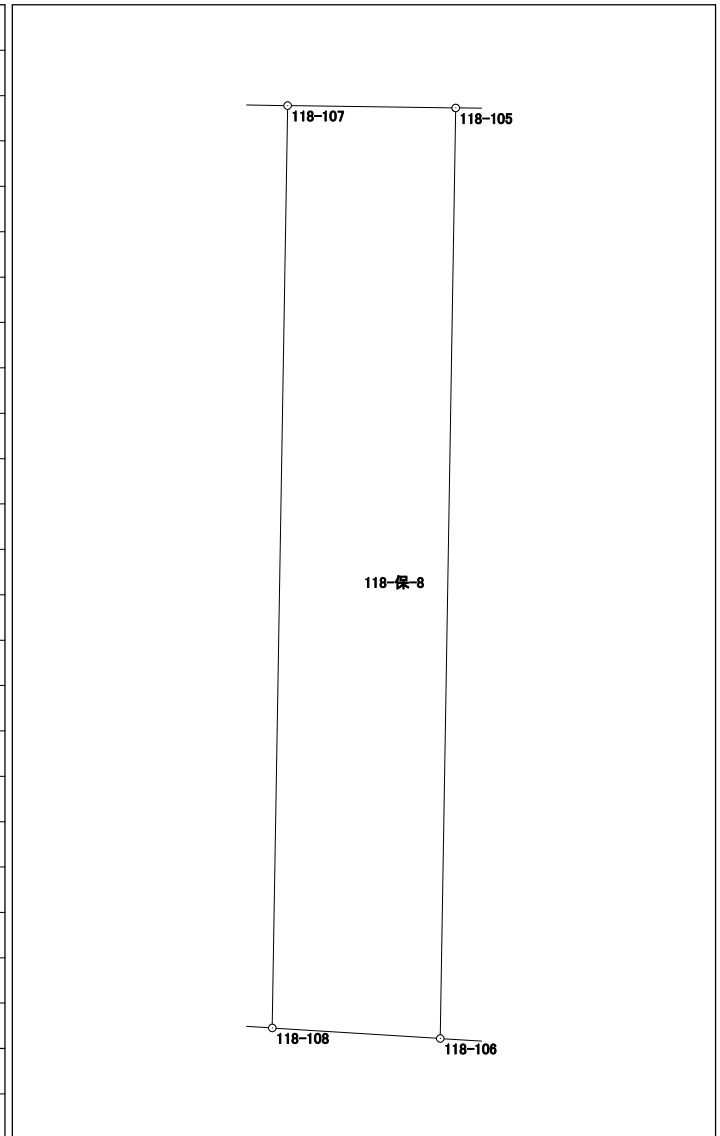


面積計算書 (座標法)

世界測地系 (測地成果2011)

所在	地番	公簿地目	現況地目	地積	所有者
前橋市六供町四丁目	118-保-11			46.00 m ²	

点名	X座標	Y座標	辺長	方向角	測角	DX	倍積 (Y×DX)
118-101	41239.438	-67368.326	28.328	270-52-04	89-55-01	2.056	-138509.278256
118-102	41239.867	-67396.651	1.631	176-56-34	86-04-30	-1.200	80875.981200
118-30	41238.238	-67396.564	28.214	90-52-02	93-55-28	-2.056	138567.335584
118-31	41237.811	-67368.353	1.627	0-57-03	90-05-01	1.200	-80842.023600
						倍面積	92.014928
						面積	46.0074640

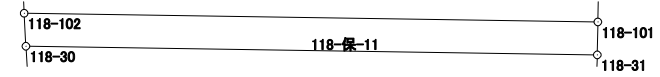


面積計算書 (座標法)

世界測地系 (測地成果2011)

所在	地番	公簿地目	現況地目	地積	所有者
前橋市六供町四丁目	118-保-13			31.00 m ²	

点名	X座標	Y座標	辺長	方向角	測角	DX	倍積 (Y×DX)
118-135	41274.546	-67344.596	24.576	180-54-25	106-34-53	-24.926	1678631.399896
118-136	41249.973	-67344.985	1.252	90-52-10	89-57-45	-24.592	1656147.871120
118-134	41249.954	-67343.733	24.948	0-54-26	90-02-16	24.926	-1678609.888758
118-133	41274.899	-67343.338	1.307	254-19-32	73-25-06	24.592	-1656107.368096

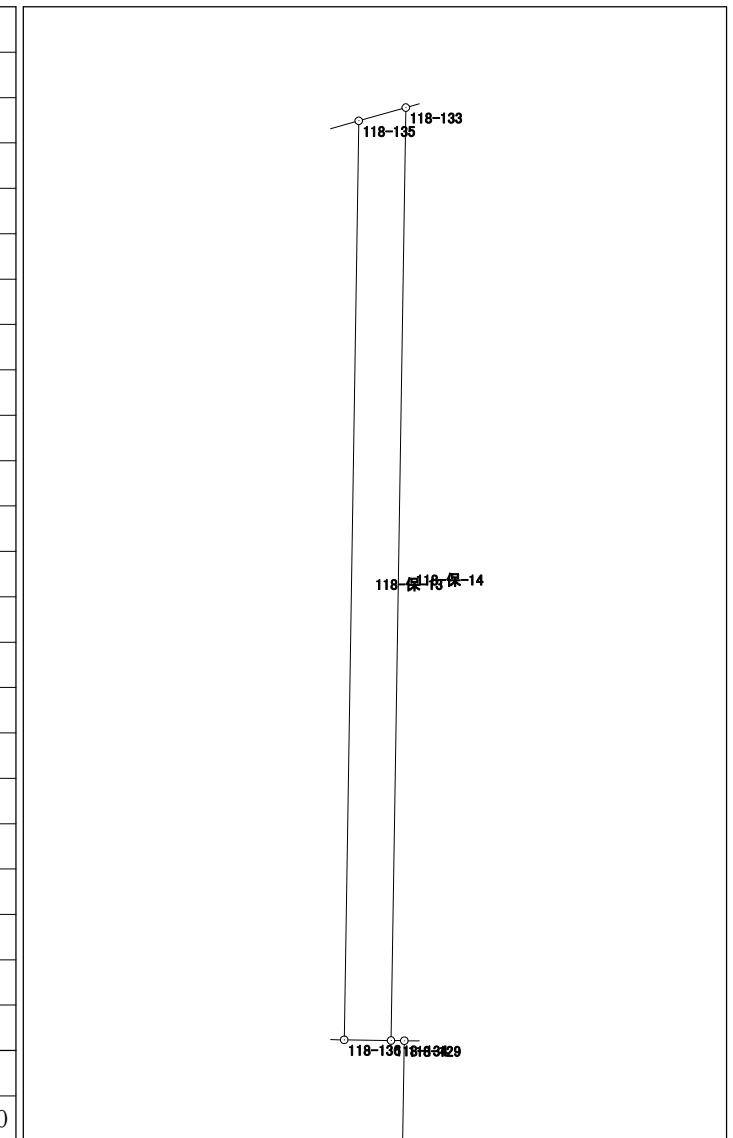


倍面積	62.014162
面積	31.0070810

面積計算書（座標法）

世界測地系（測地成果2011）

所 在	地 番	公簿地目	現況地目	地 積	所 有 者
前橋市六供町四丁目	118-保-14			23.00 m ²	

点 名	X 座標	Y 座標	辺 長	方 向 角	測 角	DX	倍 積 (Y×DX)
118-133	41274.899	-67343.338	24.948	180-54-26	106-35-52	-25.204	1697321.490952
118-134	41249.954	-67343.733	0.355	90-48-25	89-53-59	-24.950	1680226.138350
118-129	41249.949	-67343.378	0.563	90-54-57	180-06-32	-0.014	942.807292
118-128	41249.940	-67342.815	6.273	0-49-20	89-54-23	6.263	-421768.050345
118-113	41256.212	-67342.725	3.906	0-49-17	179-59-57	10.178	-685414.255050
118-111	41260.118	-67342.669	1.017	0-50-42	180-01-25	4.923	-331527.959487
118-39	41261.135	-67342.654	11.025	1-06-44	180-16-02	12.040	-810805.554160
118-137	41272.158	-67342.440	3.000	0-27-30	179-20-46	14.023	-944343.036120
118-18	41275.158	-67342.416	0.958	254-18-34	73-51-04	2.741	-184585.562256
						倍面積	46.019176
						面 積	23.0095880

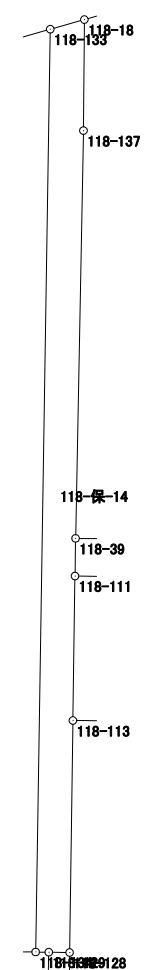

面積計算書（座標法）

世界測地系（測地成果2011）

所 在	地 番	公簿地目	現況地目	地 積	所 有 者
前橋市六供町四丁目	118-保-15			88.78 m ²	

点 名	X 座標	Y 座標	辺 長	方 向 角	測 角	DX	倍 積 (Y×DX)
118-18	41275.158	-67342.416	3.000	180-27-30	106-10-02	-4.685	315499.218960
118-137	41272.158	-67342.440	11.025	181-06-44	180-39-14	-14.023	944343.036120
118-39	41261.135	-67342.654	5.972	90-50-40	89-43-56	-11.111	748244.228594
118-40	41261.047	-67336.683	15.798	0-56-09	90-05-29	15.708	-1057724.616564
118-21	41276.843	-67336.425	6.223	254-17-28	73-21-19	14.111	-950184.293175
						倍面積	177.573935
						面積	88.7869675

