



124街区 画地出来形確認図

(1705.83m²)

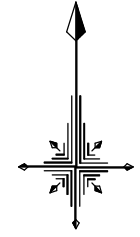

S=1/500

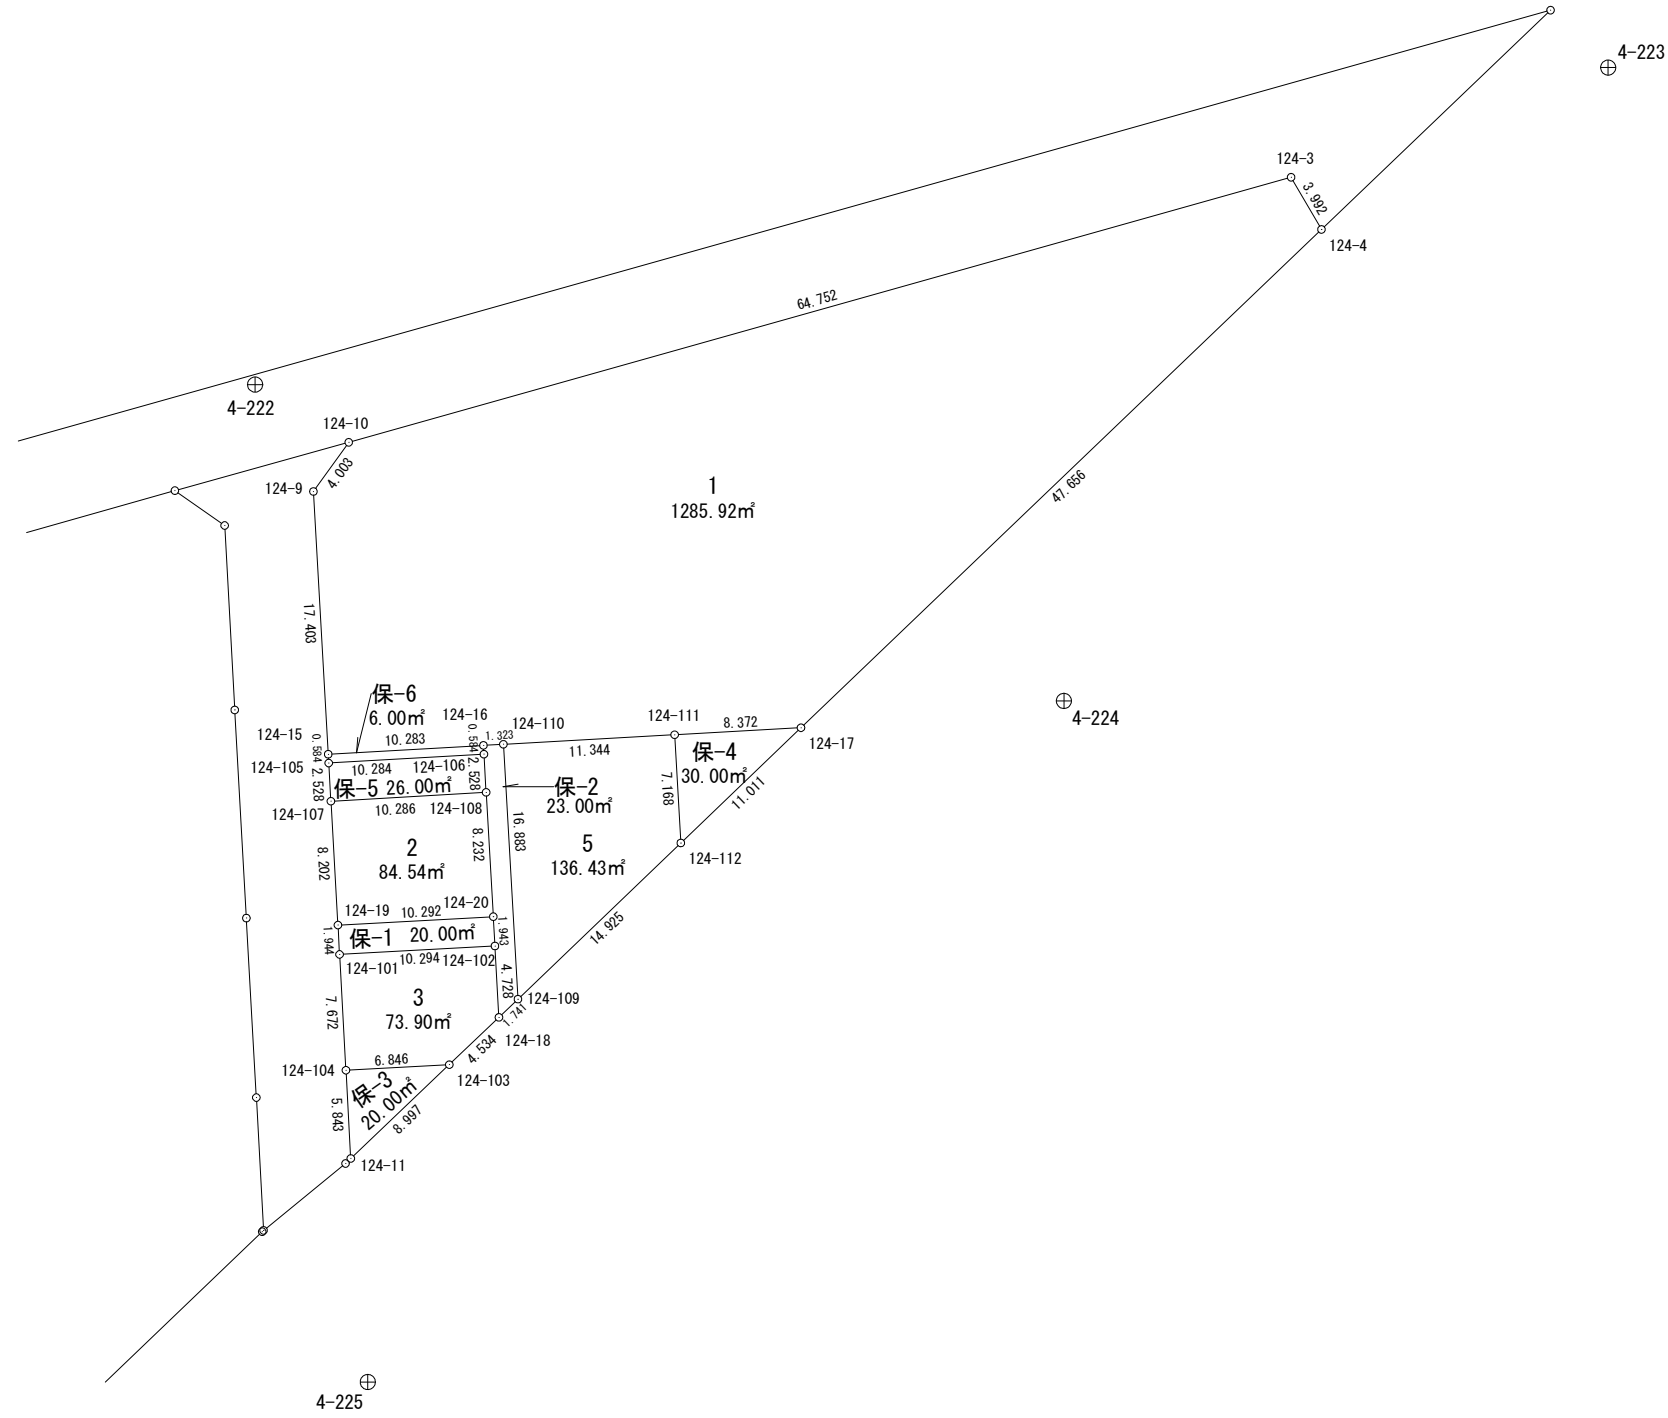

面積計算書（座標法）

世界測地系（測地成果2011）

所 在	地 番	公簿地目	現況地目	地 積	所 有 者
前橋市天川原町二丁目	124-1			1285.92 m ²	

点 名	X 座標	Y 座標	辺 長	方 向 角	測 角	DX	倍 積 (Y×DX)	
124-15	41313.095	-67135.381	10.283	86-43-59	89-57-17	-16.789	1127135.911609	
124-16	41313.681	-67125.115	1.323	86-47-37	180-03-38	0.660	-44302.575900	
124-110	41313.755	-67123.794	11.344	86-49-36	180-01-59	0.702	-47120.903388	
124-111	41314.383	-67112.467	8.372	86-49-22	179-59-46	1.092	-73286.813964	
124-17	41314.847	-67104.108	47.656	46-15-27	139-26-05	33.414	-2242216.664712	
124-4	41347.797	-67069.679	3.992	329-47-13	103-31-46	36.400	-2441336.315600	
124-3	41351.247	-67071.688	64.752	254-17-46	104-30-33	-14.076	944101.080288	
124-10	41333.721	-67134.023	4.003	215-41-57	141-24-11	-20.777	1394843.595871	
124-9	41330.470	-67136.359	17.403	176-46-42	141-04-45	-20.626	1384754.540734	
						倍面積	2571.854938	
						面積	1285.9274690	


面積計算書 (座標法)

世界測地系 (測地成果2011)

所在	地番	公簿地目	現況地目	地積	所有者
前橋市天川原町二丁目	124-2			84.54 m ²	

点名	X座標	Y座標	辺長	方向角	測角	DX	倍積 (Y×DX)
124-107	41309.988	-67135.204	8.202	176-43-45	89-59-43	-8.775	589111.415100
124-19	41301.799	-67134.736	10.292	86-53-52	90-10-07	-7.632	512372.305152
124-20	41302.356	-67124.459	8.232	356-41-06	89-47-14	8.775	-589017.127725
124-108	41310.574	-67124.935	10.286	266-44-02	90-02-56	7.632	-512297.503920

倍面積	169.088607
面積	84.5443035

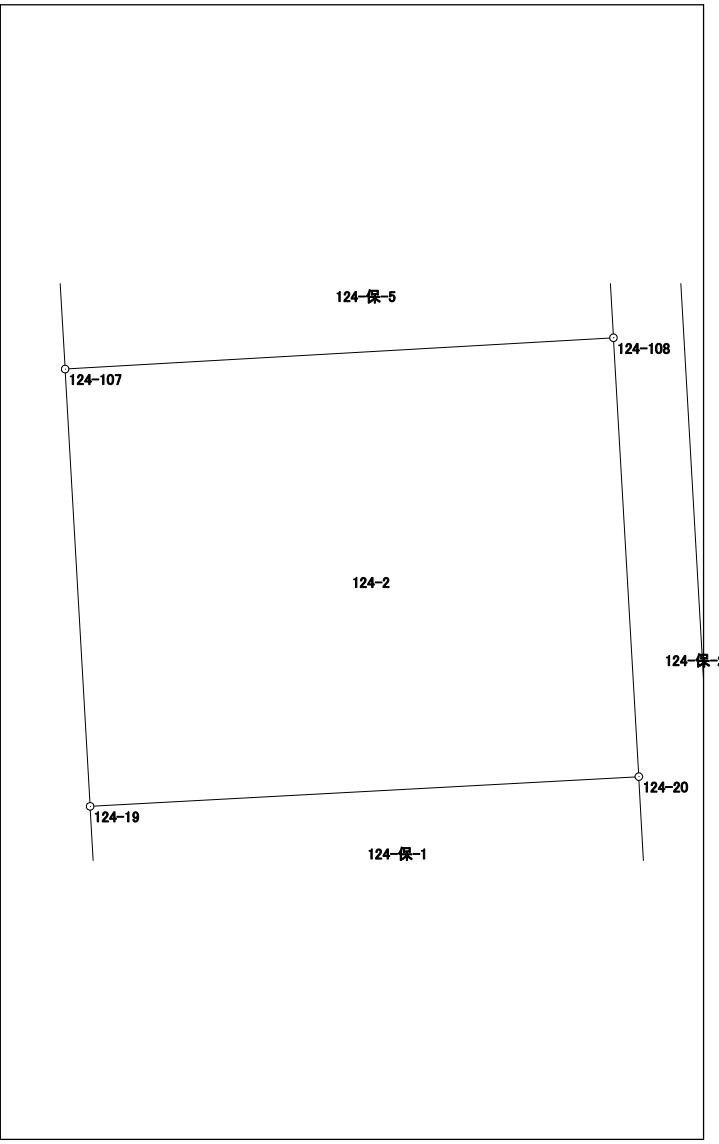


面積計算書（座標法）

世界測地系（測地成果2011）

所在	地番	公簿地目	現況地目	地積	所有者
前橋市天川原町二丁目	124-3			73.90 m ²	

点名	X座標	Y座標	辺長	方向角	測角	DX	倍積 (Y×DX)
124-104	41292.198	-67134.208	6.846	86-53-37	90-02-49	-7.289	489341.242112
124-103	41292.569	-67127.372	4.534	46-24-43	139-31-06	3.497	-234744.419884
124-18	41295.695	-67124.088	4.728	356-48-41	130-23-58	7.847	-526722.718536
124-102	41300.416	-67124.351	10.294	266-53-34	90-04-53	4.163	-279438.673213
124-101	41299.858	-67134.630	7.672	176-50-48	89-57-14	-8.218	551712.389340
倍面積							147.819819
面積							73.9099095

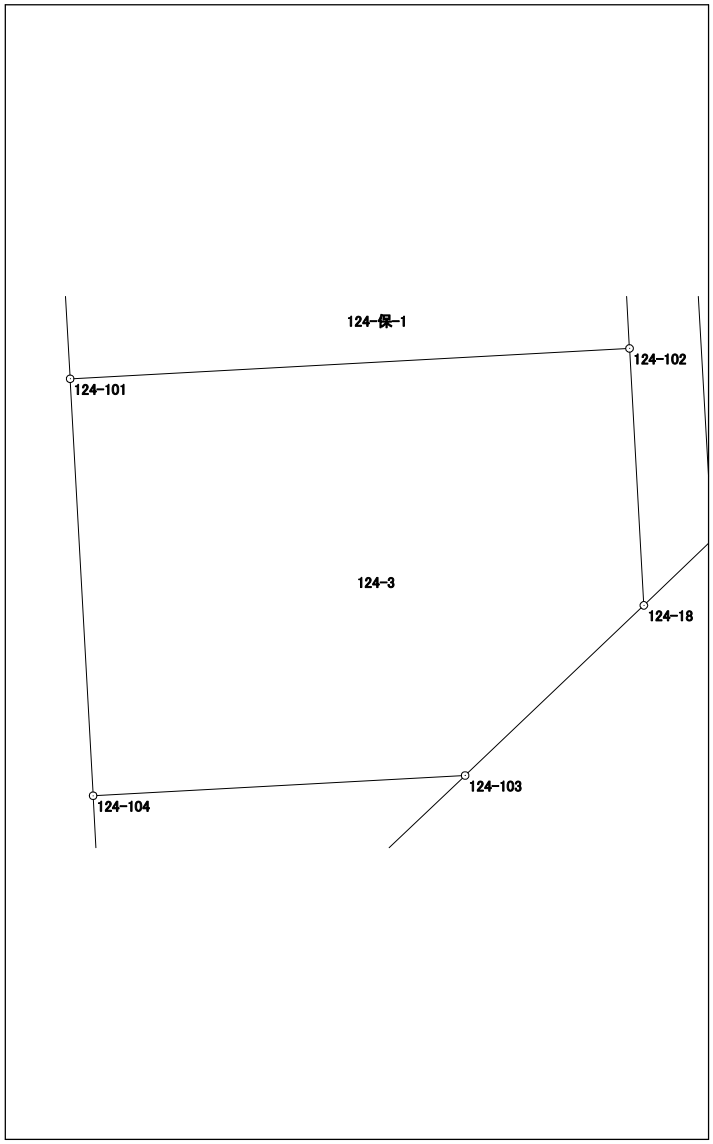

面積計算書 (座標法)

世界測地系 (測地成果2011)

所在	地番	公簿地目	現況地目	地積	所有者
前橋市天川原町二丁目	124-5			136.43 m ²	


点名	X座標	Y座標	辺長	方向角	測角	DX	倍積 (Y×DX)
124-111	41314.383	-67112.467	11.344	266-49-36	90-06-21	6.528	-438110.184576
124-110	41313.755	-67123.794	16.883	176-43-49	89-54-13	-17.484	1173592.414296
124-109	41296.899	-67122.831	14.925	46-12-39	49-28-50	-6.528	438177.840768
124-112	41307.227	-67112.057	7.168	356-43-15	130-30-36	17.484	-1173387.204588
						倍面積	272.865900
						面積	136.4329500

面積計算書 (座標法)

世界測地系 (測地成果2011)

所在	地番	公簿地目	現況地目	地積	所有者
前橋市天川原町二丁目	124-保-1			20.00 m ²	

点名	X座標	Y座標	辺長	方向角	測角	DX	倍積 (Y×DX)
124-101	41299.858	-67134.630	10.294	86-53-34	90-01-07	-1.383	92847.193290
124-102	41300.416	-67124.351	1.943	356-48-49	89-55-15	2.498	-167676.628798
124-20	41302.356	-67124.459	10.292	266-53-52	90-05-03	1.383	-92833.126797
124-19	41301.799	-67134.736	1.944	176-52-27	89-58-35	-2.498	167702.570528

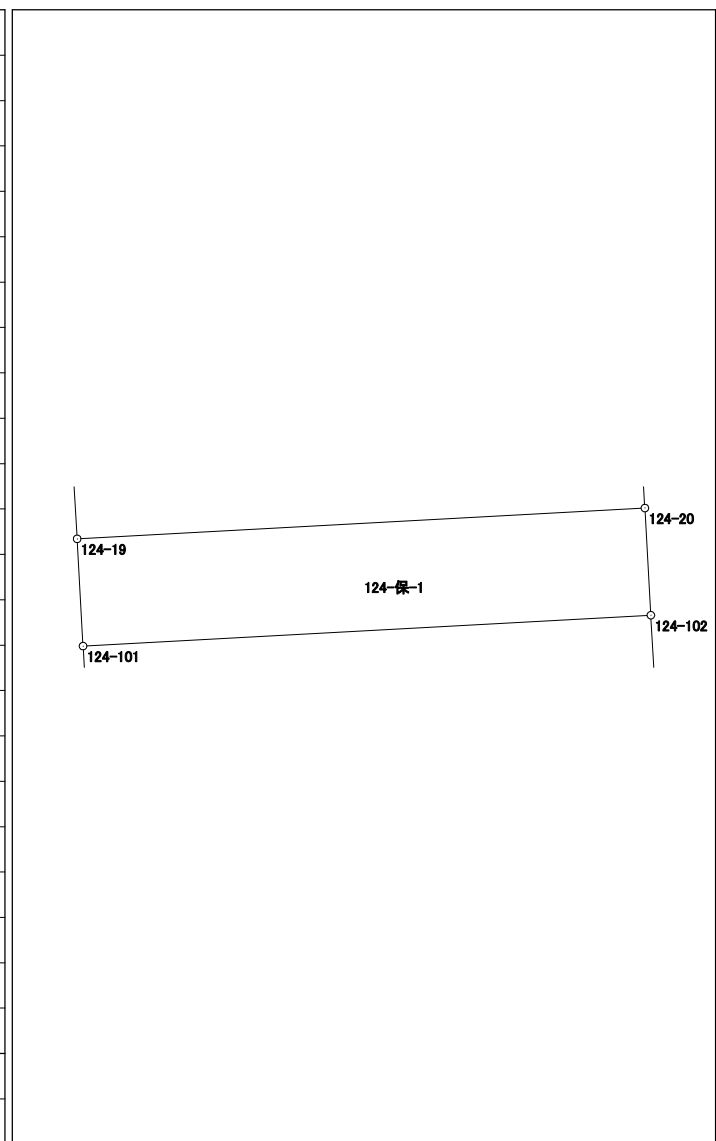

倍面積	40.008223
面積	20.0041115


面積計算書 (座標法)

世界測地系 (測地成果2011)

所在	地番	公簿地目	現況地目	地積	所有者
前橋市天川原町二丁目	124-保-2			23.00 m ²	

点名	X座標	Y座標	辺長	方向角	測角	DX	倍積 (Y×DX)
124-109	41296.899	-67122.831	16.883	356-43-49	130-29-48	18.060	-1212238.327860
124-110	41313.755	-67123.794	1.323	266-47-37	90-03-48	16.782	-1126471.510908
124-16	41313.681	-67125.115	0.584	176-39-44	89-52-07	-0.657	44101.200555
124-106	41313.098	-67125.081	2.528	176-41-22	180-01-38	-3.107	208557.626667
124-108	41310.574	-67124.935	8.232	176-41-06	179-59-44	-10.742	721056.051770
124-20	41302.356	-67124.459	1.943	176-48-49	180-07-43	-10.158	681850.254522
124-102	41300.416	-67124.351	4.728	176-48-41	179-59-52	-6.661	447115.302011
124-18	41295.695	-67124.088	1.741	46-14-01	49-25-20	-3.517	236075.417496

倍面積	46.014253
面積	23.0071265

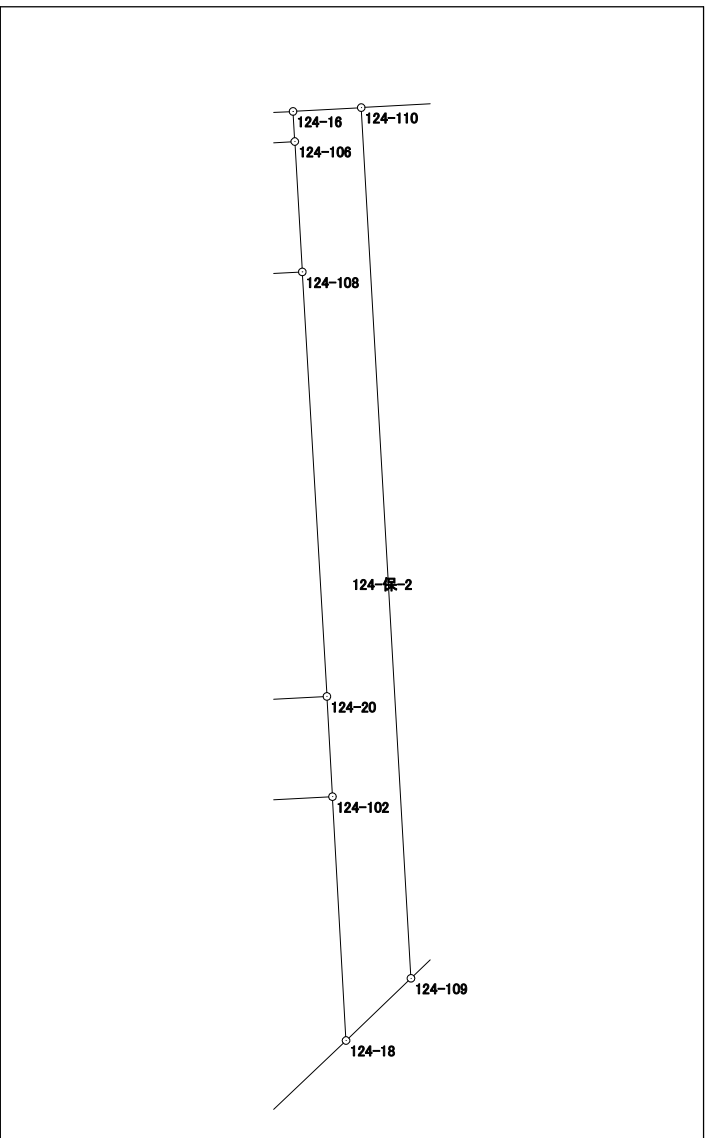


面積計算書 (座標法)

世界測地系 (測地成果2011)

所在	地番	公簿地目	現況地目	地積	所有者
前橋市天川原町二丁目	124-保-3			20.00 m ²	

点名	X座標	Y座標	辺長	方向角	測角	DX	倍積 (Y×DX)
124-103	41292.569	-67127.372	6.846	266-53-37	40-29-51	5.834	-391621.088248
124-104	41292.198	-67134.208	5.843	176-51-02	89-57-25	-6.205	416567.760640
124-11	41286.364	-67133.887	8.997	46-23-46	49-32-44	0.371	-24906.672077

倍面積	40.000315
面積	20.0001575

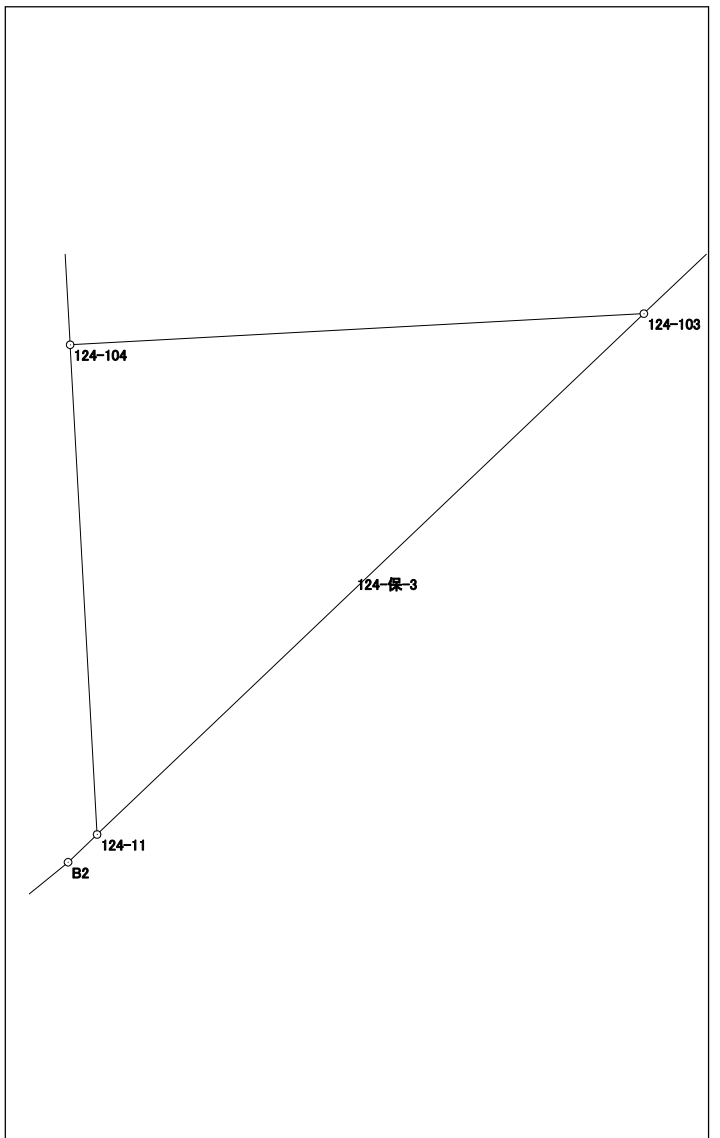


面積計算書（座標法）

世界測地系（測地成果2011）

所在	地番	公簿地目	現況地目	地積	所有者
前橋市天川原町二丁目	124-保-4			30.00 m ²	

点名	X座標	Y座標	辺長	方向角	測角	DX	倍積 (Y×DX)
124-17	41314.847	-67104.108	8.372	266-49-22	40-36-44	7.156	-480196.996848
124-111	41314.383	-67112.467	7.168	176-43-15	89-53-53	-7.620	511396.998540
124-112	41307.227	-67112.057	11.011	46-12-38	49-29-23	0.464	-31139.994448

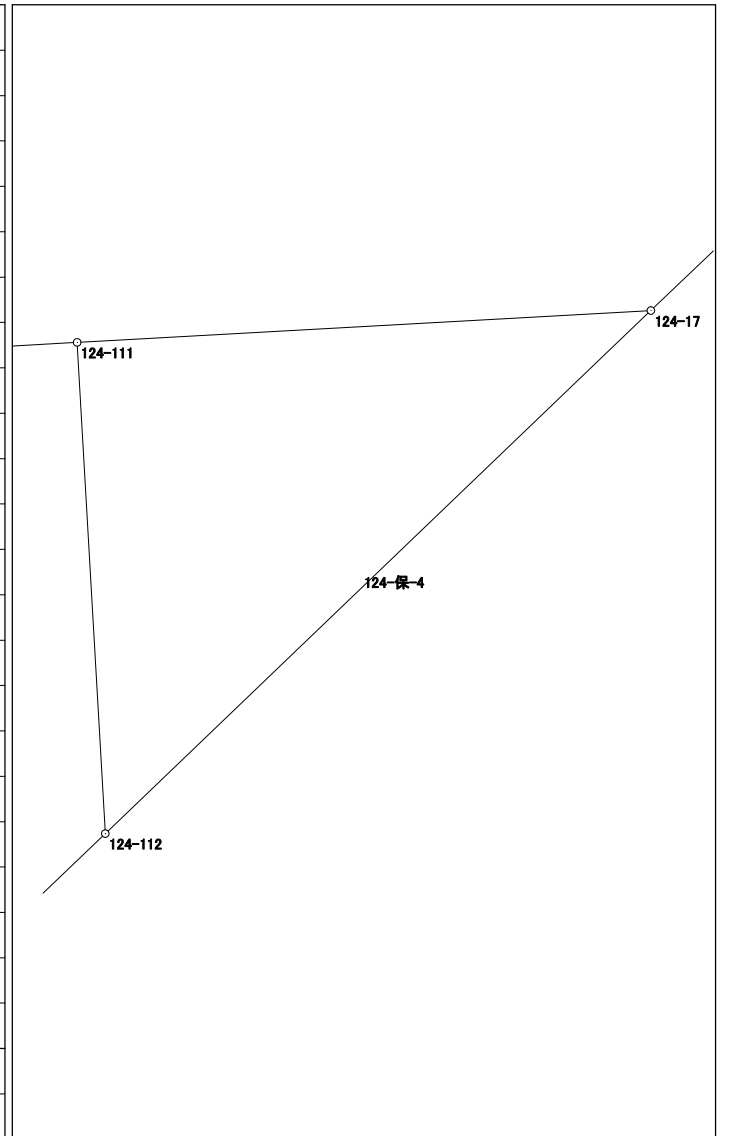


倍面積	60.007244
面積	30.0036220

面積計算書 (座標法)

世界測地系 (測地成果2011)

所在	地番	公簿地目	現況地目	地積	所有者
前橋市天川原町二丁目	124-保-5			26.00 m ²	

点名	X座標	Y座標	辺長	方向角	測角	DX	倍積 (Y×DX)
124-105	41312.512	-67135.348	2.528	176-44-05	90-00-05	-3.110	208790.932280
124-107	41309.988	-67135.204	10.286	86-44-02	89-59-57	-1.938	130108.025352
124-108	41310.574	-67124.935	2.528	356-41-22	89-57-20	3.110	-208758.547850
124-106	41313.098	-67125.081	10.284	266-44-00	90-02-38	1.938	-130088.406978

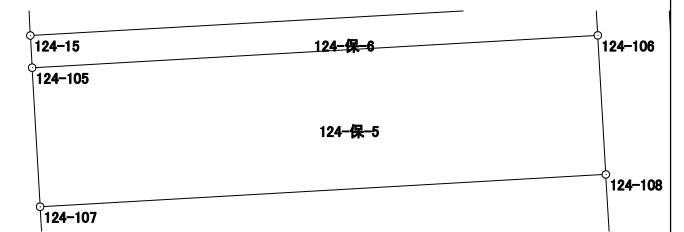

倍面積	52.002804
面積	26.0014020

面積計算書（座標法）

世界測地系（測地成果2011）

所在	地番	公簿地目	現況地目	地積	所有者
前橋市天川原町二丁目	124-保-6			6.00 m ²	

点名	X 座標	Y 座標	辺長	方向角	測角	DX	倍積 (Y×DX)
124-15	41313.095	-67135.381	0.584	176-45-37	90-01-38	-1.169	78481.260389
124-105	41312.512	-67135.348	10.284	86-44-00	89-58-23	0.003	-201.406044
124-106	41313.098	-67125.081	0.584	356-39-44	89-55-44	1.169	-78469.219689
124-16	41313.681	-67125.115	10.283	266-43-59	90-04-15	-0.003	201.375345
						倍面積	12.010001
						面積	6.0050005

