



134街区 画地出来形確認図 (2160.16m²)

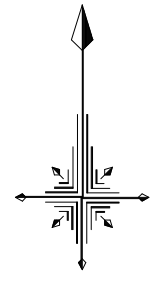

S=1/500

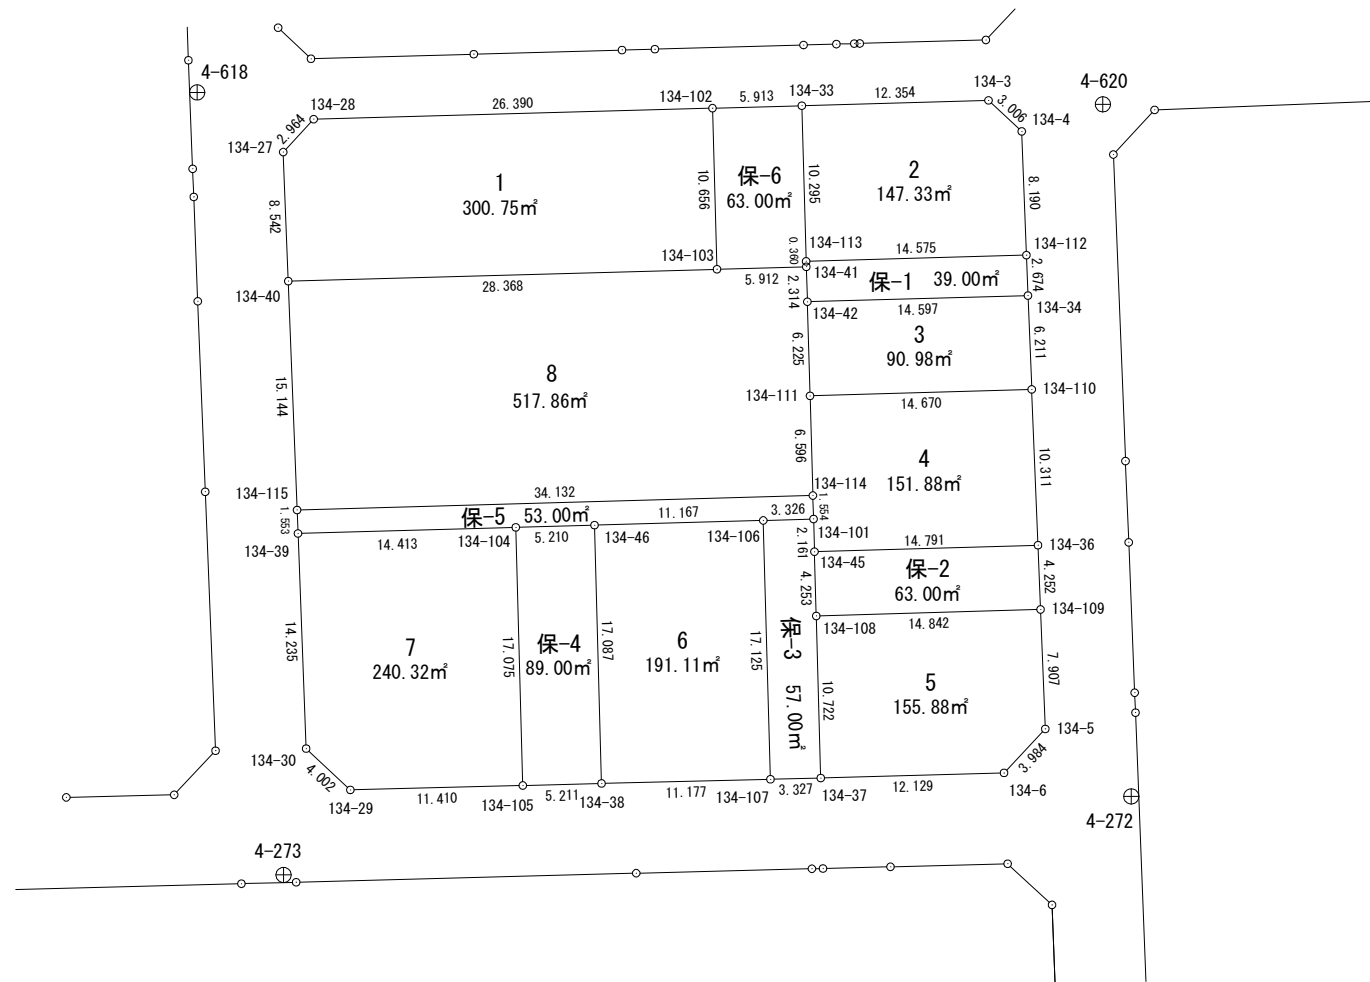

面積計算書 (座標法)

世界測地系 (測地成果2011)

所在	地番	公簿地目	現況地目	地積	所有者
前橋市六供町五丁目	134-2			147.33 m ²	

点名	X座標	Y座標	辺長	方向角	測角	DX	倍積 (Y×DX)	
134-112	41020.930	-67504.315	8.190	357-50-16	89-26-31	8.592	-579997.074480	
134-4	41029.114	-67504.624	3.006	313-00-17	135-10-01	10.234	-690842.322016	
134-3	41031.164	-67506.822	12.354	268-22-19	135-22-02	1.699	-114694.090578	
134-33	41030.813	-67519.171	10.295	178-24-09	90-01-50	-10.642	718539.017782	
134-113	41020.522	-67518.884	14.575	88-23-45	89-59-36	-9.883	667289.130572	
						倍面積	294.661280	
						面積	147.3306400	

面積計算書（座標法）

世界測地系（測地成果2011）

所 在	地 番	公簿地目	現況地目	地 積	所 有 者
前橋市六供町五丁目	134-4			151.88 m ²	


点 名	X 座標	Y 座標	辺 長	方 向 角	測 角	DX	倍 積 (Y×DX)	
134-45	41001.321	-67518.334	14.791	88-20-31	89-59-10	-1.732	116941.754488	<p style="text-align: center; font-weight: bold;">134-4</p>
134-36	41001.749	-67503.549	10.311	357-41-36	89-21-05	10.731	-724380.584319	
134-110	41012.052	-67503.964	14.670	268-20-24	90-38-48	9.878	-666804.156392	
134-111	41011.627	-67518.628	6.596	178-22-00	90-01-36	-7.018	473845.731304	
134-114	41005.034	-67518.440	1.554	178-22-38	180-00-38	-8.146	550005.212240	
134-101	41003.481	-67518.396	2.161	178-21-21	179-58-43	-3.713	250695.804348	
							倍面積	
							面 積	151.8808345

面積計算書 (座標法)

世界測地系 (測地成果2011)

所 在	地 番	公簿地目	現況地目	地 積	所 有 者
前橋市六供町五丁目	134-5			155.88 m ²	

点 名	X 座標	Y 座標	辺 長	方 向 角	測 角	DX	倍 積 (Y×DX)
134-108	40997.070	-67518.216	10.722	178-24-46	90-04-23	-11.148	752693.071968
134-37	40986.352	-67517.919	12.129	88-22-46	89-58-00	-10.375	700498.409625
134-6	40986.695	-67505.795	3.984	43-12-36	134-49-50	3.247	-219191.316365
134-5	40989.599	-67503.067	7.907	357-43-53	134-31-17	10.805	-729370.638935
134-109	40997.500	-67503.380	14.842	268-20-23	90-36-30	7.471	-504317.751980
						倍面積	311.774313
						面 積	155.8871565

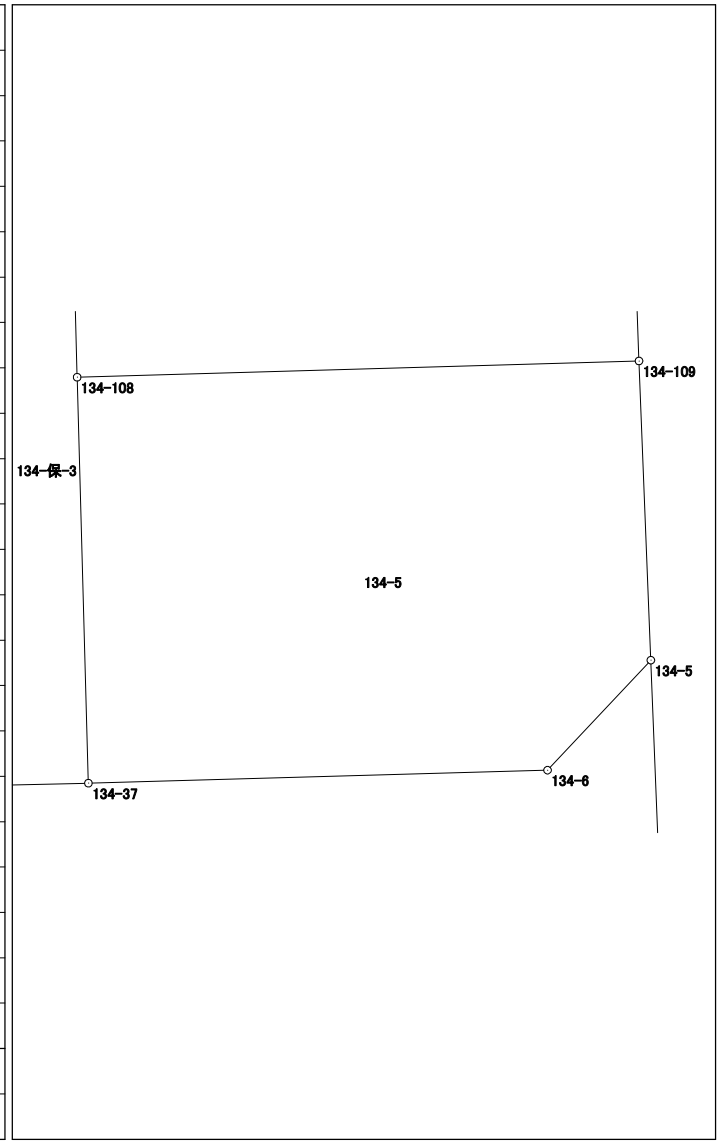


面積計算書 (座標法)

世界測地系 (測地成果2011)

所在	地番	公簿地目	現況地目	地積	所有者
前橋市六供町五丁目	134-7			240.32 m ²	

点名	X座標	Y座標	辺長	方向角	測角	DX	倍積 (Y×DX)
134-104	41002.929	-67538.092	14.413	268-23-37	89-57-03	16.665	-1125522.303180
134-39	41002.525	-67552.499	14.235	177-49-34	89-25-57	-14.629	988225.507871
134-30	40988.300	-67551.959	4.002	133-02-46	135-13-12	-16.957	1145478.568763
134-29	40985.568	-67549.034	11.410	88-32-01	135-29-15	-2.440	164819.642960
134-105	40985.860	-67537.628	17.075	358-26-34	89-54-33	17.361	-1172520.759708

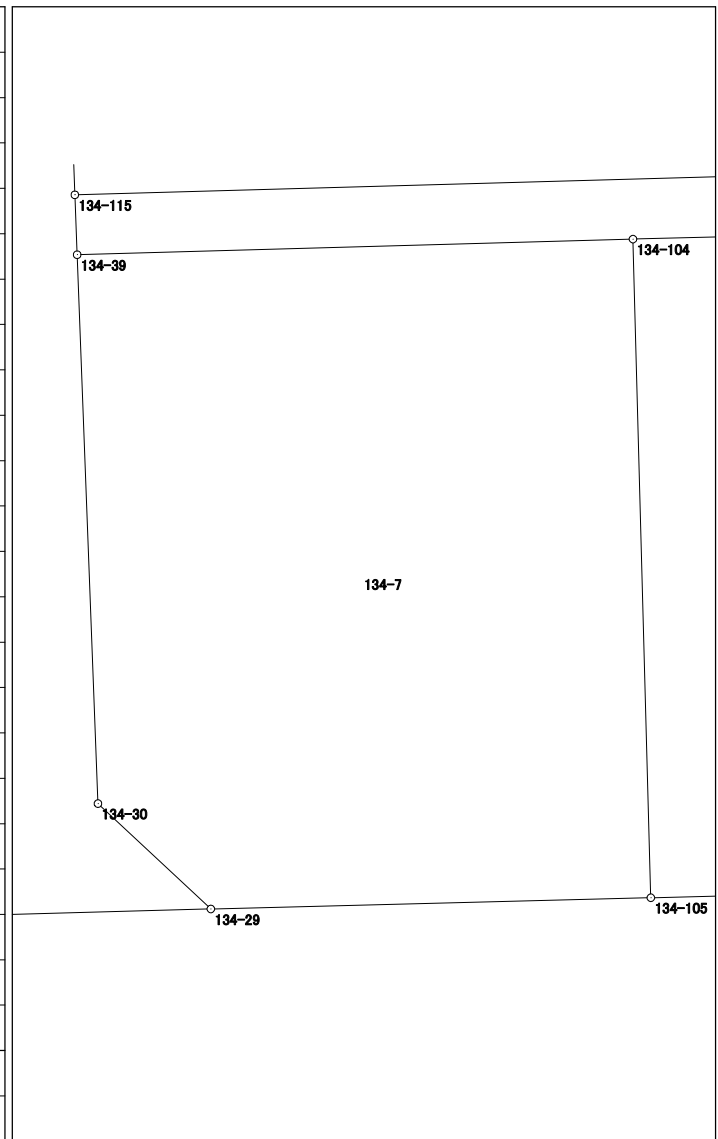


倍面積	480.656706
面積	240.3283530

面積計算書（座標法）

世界測地系（測地成果2011）

所 在	地 番	公簿地目	現況地目	地 積	所 有 者
前橋市六供町五丁目	134-8			517.86 m ²	

点 名	X 座標	Y 座標	辺 長	方 向 角	測 角	DX	倍 積 (Y×DX)
134-114	41005.034	-67518.440	6.596	358-22-00	89-58-24	7.550	-509764.222000
134-111	41011.627	-67518.628	6.225	358-22-14	180-00-14	12.815	-865251.217820
134-42	41017.849	-67518.805	2.314	358-17-29	179-55-15	8.535	-576273.000675
134-41	41020.162	-67518.874	5.912	268-24-38	90-07-09	2.149	-145098.060226
134-103	41019.998	-67524.784	28.368	268-24-30	179-59-52	-0.952	64283.594368
134-40	41019.210	-67553.141	15.144	177-47-51	89-23-21	-15.921	1075513.557861
134-115	41004.077	-67552.559	34.132	88-23-36	90-35-45	-14.176	957625.076384
						倍面積	1035.727892
						面 積	517.8639460

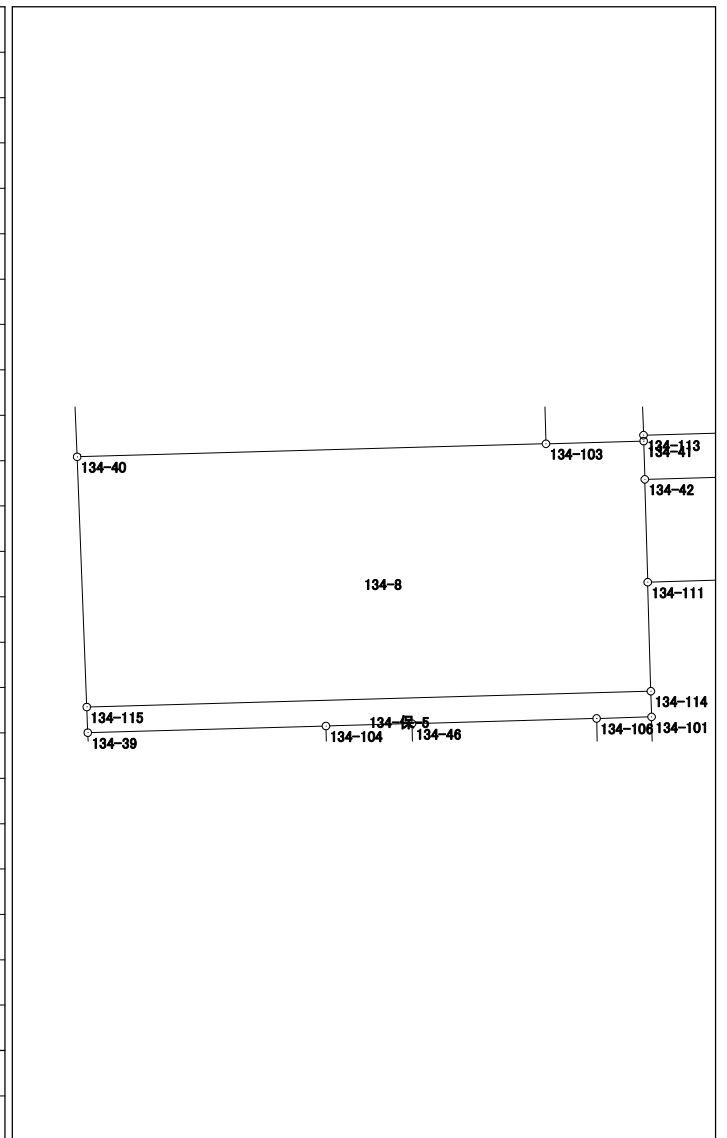


面積計算書（座標法）

世界測地系（測地成果2011）

所 在	地 番	公簿地目	現況地目	地 積	所 有 者
前橋市六供町五丁目	134-保-1			39.00 m ²	

点 名	X 座標	Y 座標	辺 長	方 向 角	測 角	DX	倍 積 (Y×DX)
134-42	41017.849	-67518.805	14.597	88-23-40	90-06-11	-1.904	128555.804720
134-34	41018.258	-67504.214	2.674	357-50-07	89-26-27	3.081	-207980.483334
134-112	41020.930	-67504.315	14.575	268-23-45	90-33-38	2.264	-152829.769160
134-113	41020.522	-67518.884	0.360	178-24-32	90-00-47	-0.768	51854.502912
134-41	41020.162	-67518.874	2.314	178-17-29	179-52-57	-2.673	180477.950202
						倍面積	78.005340
						面 積	39.0026700

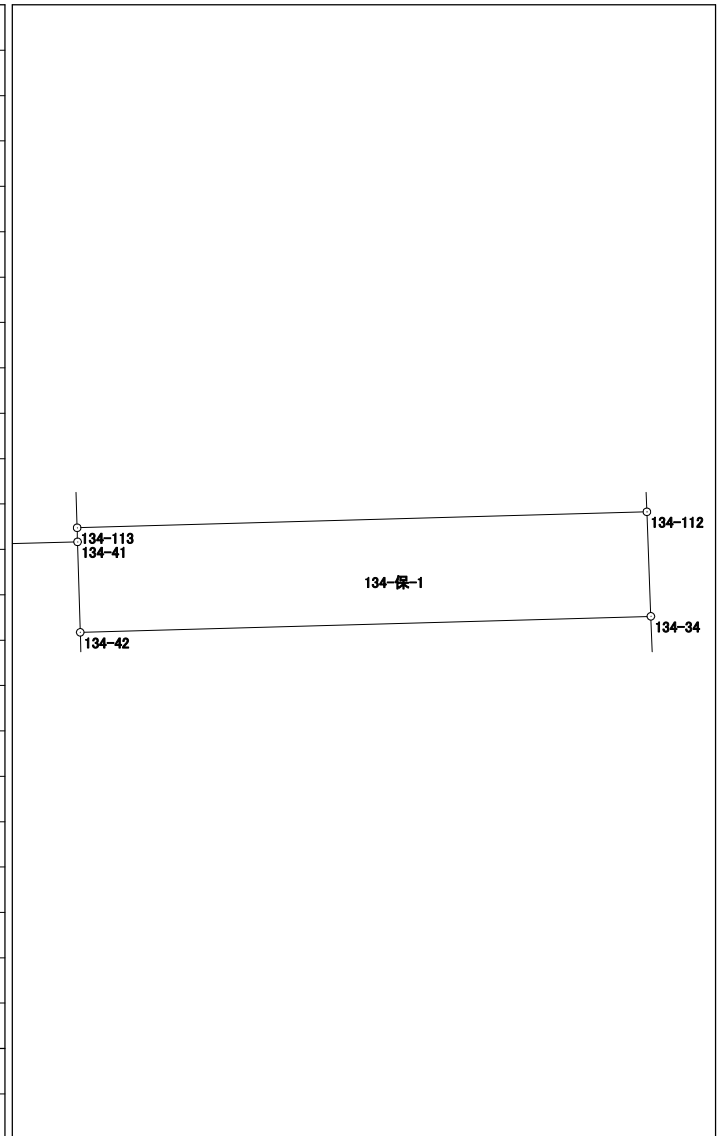


面積計算書 (座標法)

世界測地系 (測地成果2011)

所在	地番	公簿地目	現況地目	地積	所有者
前橋市六供町五丁目	134-保-2			63.00 m ²	

点名	X座標	Y座標	辺長	方向角	測角	DX	倍積 (Y×DX)
134-45	41001.321	-67518.334	4.253	178-24-36	90-04-05	-4.679	315918.284786
134-108	40997.070	-67518.216	14.842	88-20-23	89-55-47	-3.821	257987.103336
134-109	40997.500	-67503.380	4.252	357-43-20	89-22-57	4.679	-315848.315020
134-36	41001.749	-67503.549	14.791	268-20-31	90-37-11	3.821	-257931.060729
						倍面積	126.012373
						面積	63.0061865

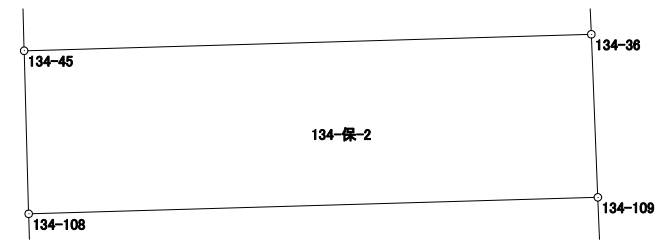


面積計算書（座標法）

世界測地系（測地成果2011）

所 在	地 番	公簿地目	現況地目	地 積	所 有 者
前橋市六供町五丁目	134-保-3			57.00 m ²	

点 名	X 座標	Y 座標	辺 長	方 向 角	測 角	DX	倍 積 (Y×DX)
134-45	41001.321	-67518.334	2.161	358-21-21	179-56-45	6.411	-432860.039274
134-101	41003.481	-67518.396	3.326	268-23-52	90-02-31	2.067	-139560.524532
134-106	41003.388	-67521.721	17.125	178-24-26	90-00-34	-17.211	1162116.340131
134-107	40986.270	-67521.245	3.327	88-35-16	90-10-50	-17.036	1150291.929820
134-37	40986.352	-67517.919	10.722	358-24-46	89-49-30	10.800	-729193.525200
134-108	40997.070	-67518.216	4.253	358-24-36	179-59-50	14.969	-1010680.175304
						倍面積	114.005641
						面 積	57.0028205

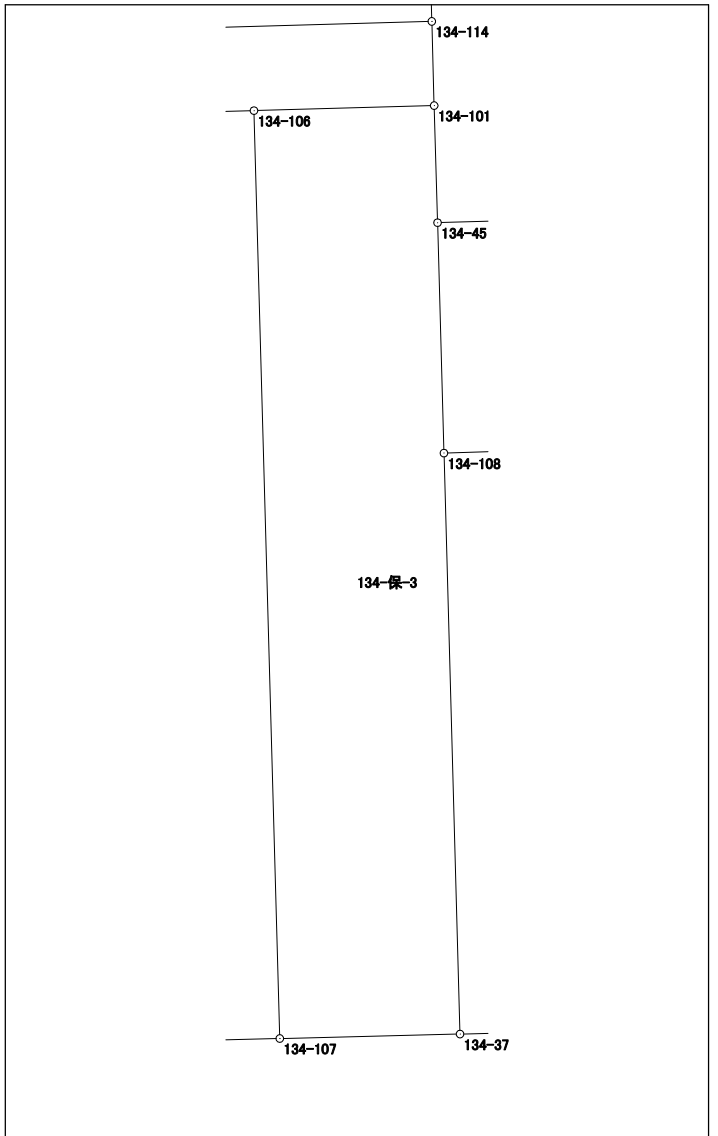


面積計算書 (座標法)

世界測地系 (測地成果2011)

所在	地番	公簿地目	現況地目	地積	所有者
前橋市六供町五丁目	134-保-4			89.00 m ²	


点名	X座標	Y座標	辺長	方向角	測角	DX	倍積 (Y×DX)
134-38	40985.994	-67532.419	17.087	358-26-26	89-54-51	17.215	-1162570.593085
134-46	41003.075	-67532.884	5.210	268-23-39	89-57-13	16.935	-1143669.390540
134-104	41002.929	-67538.092	17.075	178-26-34	90-02-55	-17.215	1162668.253780
134-105	40985.860	-67537.628	5.211	88-31-35	90-05-01	-16.935	1143749.730180
						倍面積	178.000335
						面積	89.0001675

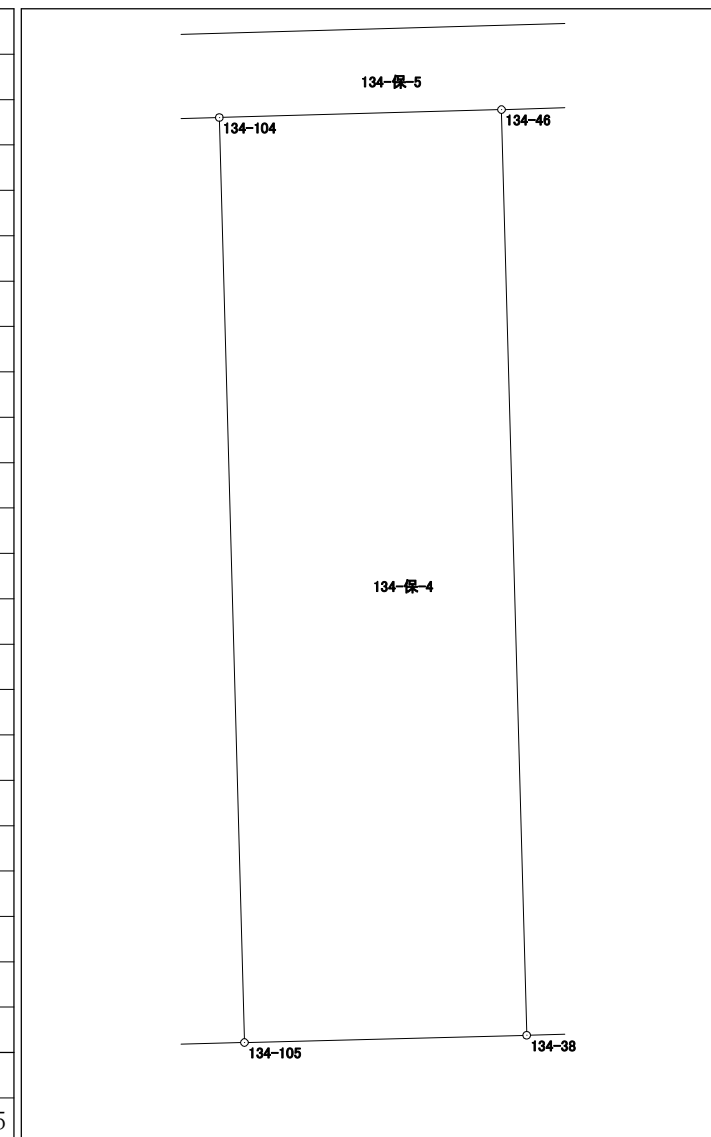

面積計算書 (座標法)

世界測地系 (測地成果2011)

所 在	地 番	公簿地目	現況地目	地 積	所 有 者
前橋市六供町五丁目	134-保-5			53.00 m ²	

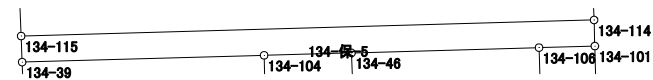点 名	X 座標	Y 座標	辺 長	方 向 角	測 角	DX	倍 積 (Y×DX)	
134-39	41002.525	-67552.499	14.413	88-23-37	90-36-27	-1.148	77550.268852	
134-104	41002.929	-67538.092	5.210	88-23-39	180-00-02	0.550	-37145.950600	
134-46	41003.075	-67532.884	11.167	88-23-38	179-59-59	0.459	-30997.593756	
134-106	41003.388	-67521.721	3.326	88-23-52	180-00-14	0.406	-27413.818726	
134-101	41003.481	-67518.396	1.554	358-22-38	89-58-46	1.646	-111135.279816	
134-114	41005.034	-67518.440	34.132	268-23-36	90-00-58	0.596	-40240.990240	
134-115	41004.077	-67552.559	1.553	177-47-10	89-23-34	-2.509	169489.370531	
倍面積						106.006245		
面 積						53.0031225		

面積計算書 (座標法)

世界測地系 (測地成果2011)

所在	地番	公簿地目	現況地目	地積	所有者
前橋市六供町五丁目	134-保-6			63.00 m ²	

点名	X座標	Y座標	辺長	方向角	測角	DX	倍積 (Y×DX)
134-41	41020.162	-67518.874	0.360	358-24-32	89-59-54	0.524	-35379.889976
134-113	41020.522	-67518.884	10.295	358-24-09	179-59-37	10.651	-719143.633484
134-33	41030.813	-67519.171	5.913	268-25-14	90-01-05	10.128	-683834.163888
134-102	41030.650	-67525.082	10.656	178-23-51	89-58-37	-10.815	730283.761830
134-103	41019.998	-67524.784	5.912	88-24-38	90-00-47	-10.488	708199.934592
						倍面積	126.009074
						面積	63.0045370

