


135-2街区 画地出来形確認図 (1819.77m²)

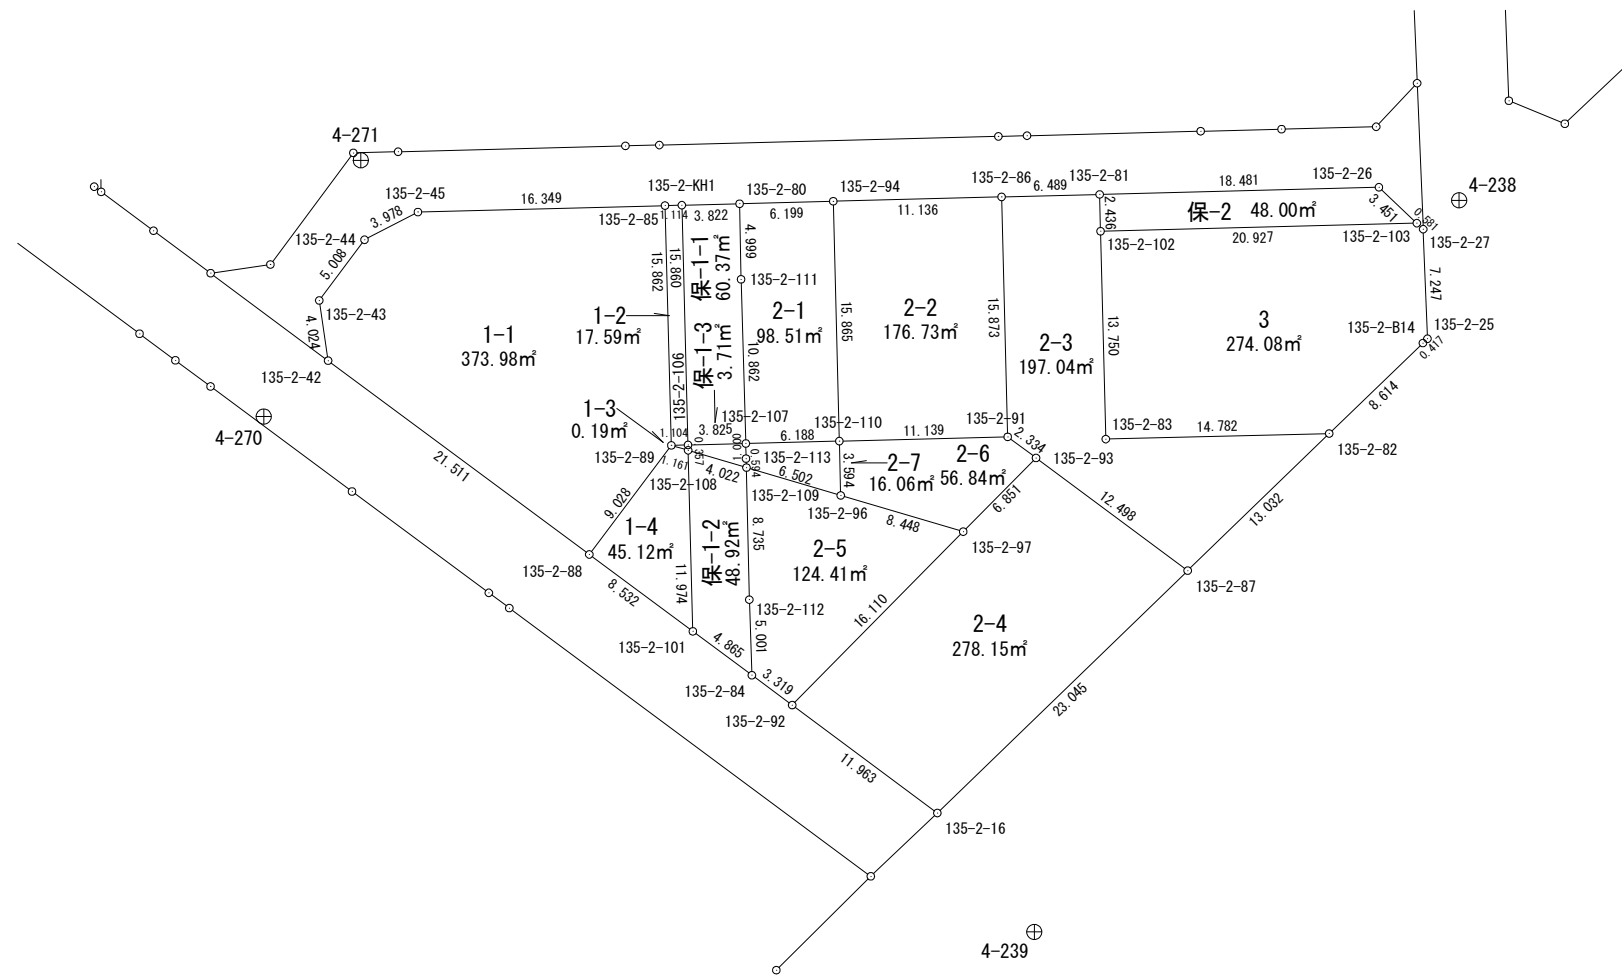

1/500




面積計算書 (座標法)

世界測地系 (測地成果2011)

所在	地番	公簿地目	現況地目	地積	所有者
前橋市六供町五丁目	135-2-1-1			373.98 m ²	

点名	X座標	Y座標	辺長	方向角	測角	Dx	倍積 (Y×Dx)
135-2-88	40922.427	-67556.437	9.028	36-57-31	90-23-13	-5.603	378518.716511
135-2-89	40929.641	-67551.009	15.862	358-28-58	141-31-27	23.070	-1558401.777630
135-2-85	40945.497	-67551.429	16.349	268-29-59	90-01-01	15.428	-1042183.446612
135-2-45	40945.069	-67567.772	3.978	242-36-38	154-06-39	-2.258	152568.029176
135-2-44	40943.239	-67571.304	5.008	216-43-41	154-07-03	-5.844	394886.700576
135-2-43	40939.225	-67574.299	4.024	171-37-34	134-53-53	-7.995	540256.520505
135-2-42	40935.244	-67573.713	21.511	126-34-18	134-56-44	-16.798	1135103.230974

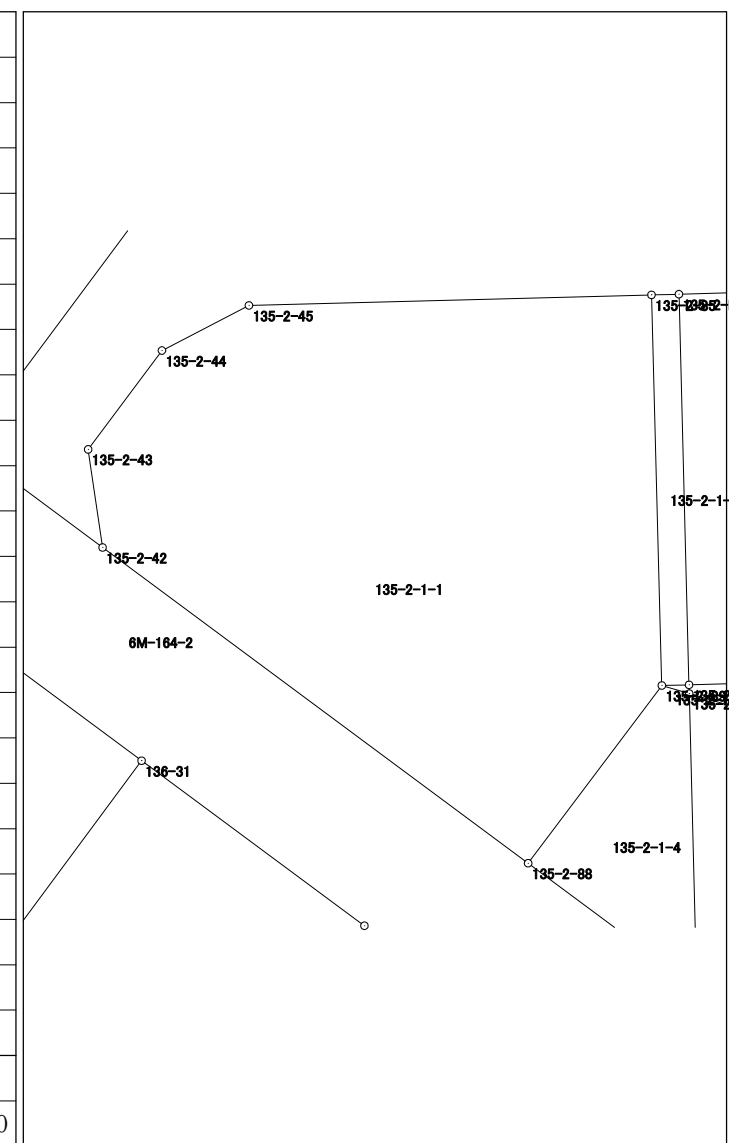


倍面積	747.973500
面積	373.9867500

面積計算書（座標法）

所 在	地 番	公簿地目	現況地目	地 積	所 有 者
前橋市六供町五丁目	135-2-1-2			17.59 m ²	

点 名	X 座標	Y 座標	辺 長	方 向 角	測 角	DX	倍 積 (Y×DX)
135-2-85	40945.497	-67551.429	15.862	178-28-58	89-52-16	-15.883	1072919.346807
135-2-89	40929.641	-67551.009	1.104	88-32-50	90-03-52	-15.828	1069197.370452
135-2-106	40929.669	-67549.905	15.860	358-31-07	89-58-17	15.883	-1072895.141115
135-2-KH1	40945.524	-67550.315	1.114	268-36-42	90-05-35	15.828	-1069186.385820
倍面積							35.190324
面 積							17.5951620

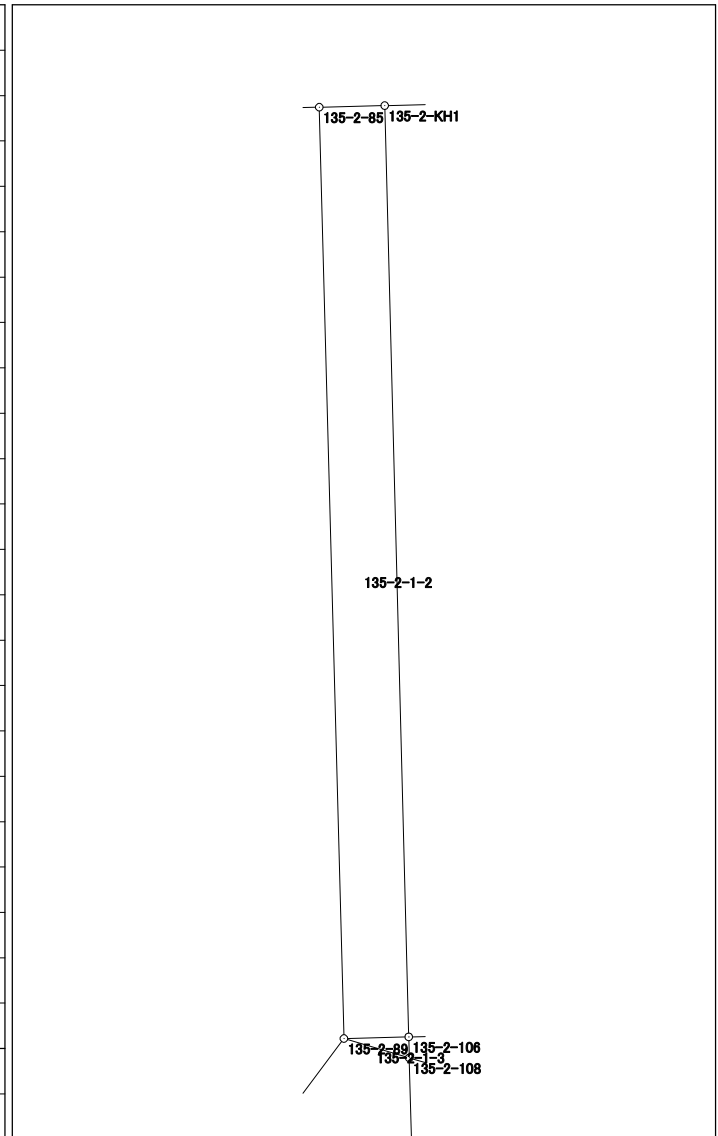


面積計算書（座標法）

世界測地系（測地成果2011）

所在	地番	公簿地目	現況地目	地積	所有者
前橋市六供町五丁目	135-2-1-3			0.19 m ²	

点名	X座標	Y座標	辺長	方向角	測角	DX	倍積 (Y×DX)
135-2-89	40929.641	-67551.009	1.161	106-28-03	17-55-13	-0.357	24115.710213
135-2-108	40929.312	-67549.896	0.357	358-33-21	72-05-18	0.028	-1891.397088
135-2-106	40929.669	-67549.905	1.104	268-32-50	89-59-29	0.329	-22223.918745

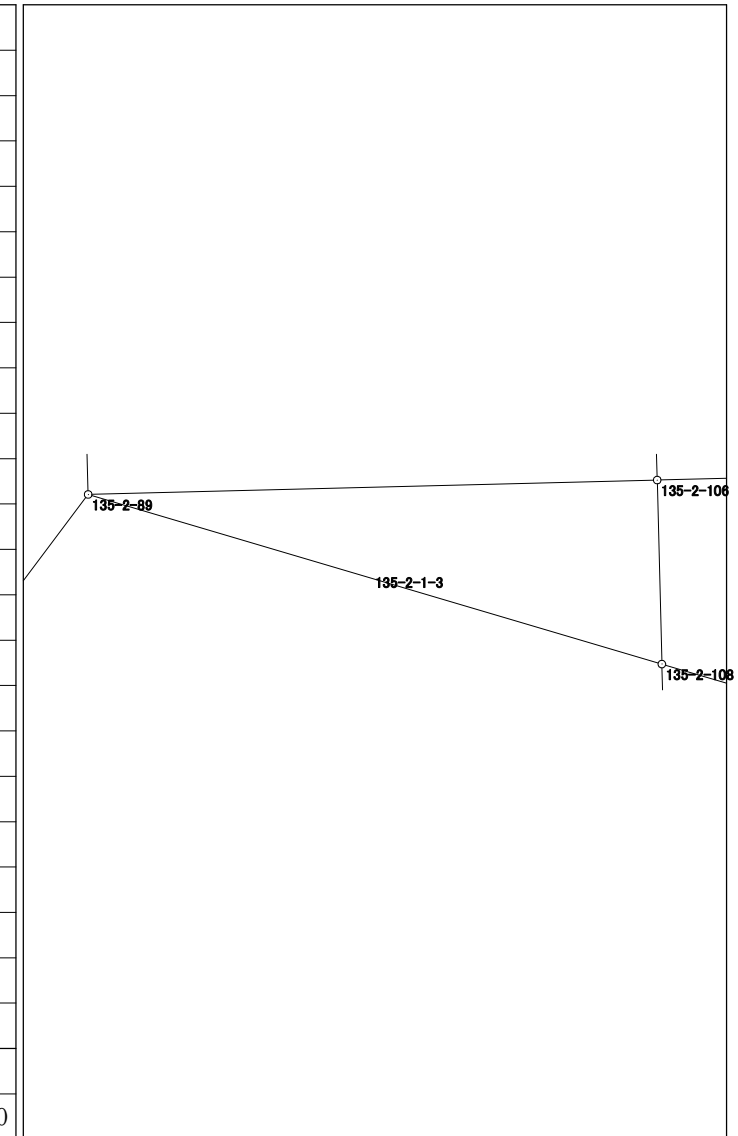


倍面積	0.394380
面積	0.1971900

面積計算書 (座標法)

世界測地系 (測地成果2011)

所在	地番	公簿地目	現況地目	地積	所有者
前橋市六供町五丁目	135-2-2-2			176.73 m ²	

点名	X座標	Y座標	辺長	方向角	測角	DX	倍積 (Y×DX)
135-2-94	40945.782	-67540.297	15.865	178-32-53	90-02-07	-16.149	1090708.256253
135-2-110	40929.922	-67539.895	11.139	88-33-16	90-00-23	-15.579	1052204.024205
135-2-91	40930.203	-67528.760	15.873	358-32-17	89-59-01	16.149	-1090521.945240
135-2-86	40946.071	-67529.165	11.136	268-30-46	89-58-29	15.579	-1052036.861535

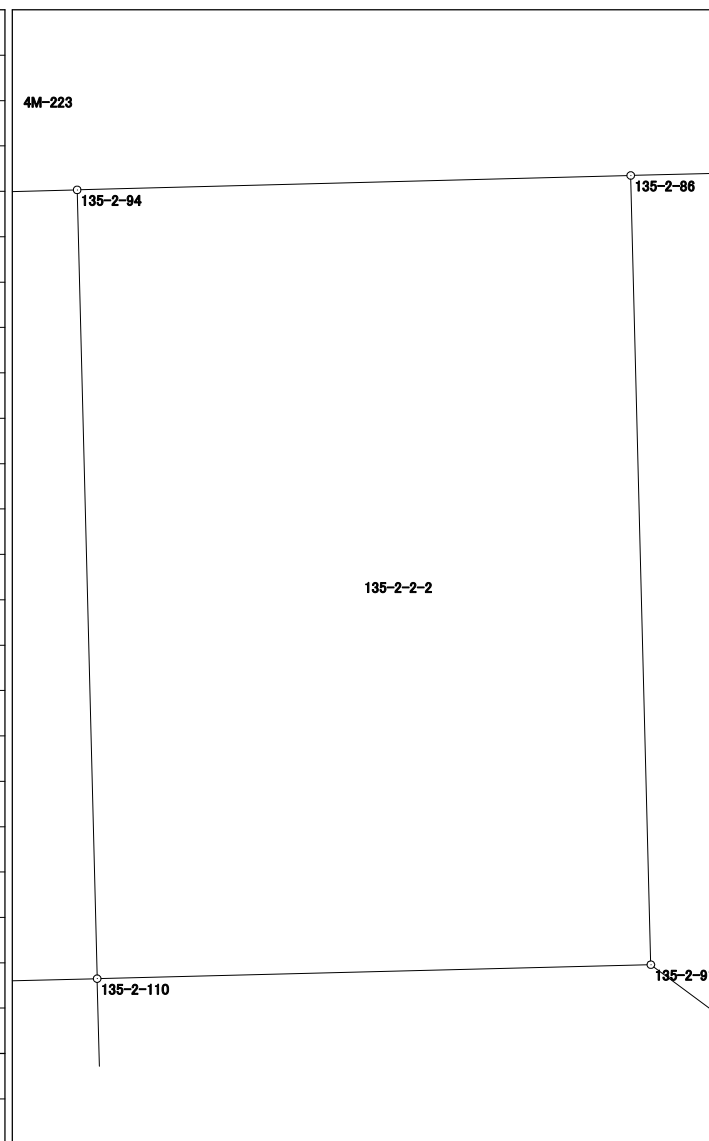


倍面積	353.473683
面積	176.7368415

面積計算書（座標法）

世界測地系（測地成果2011）

所在	地番	公簿地目	現況地目	地積	所有者
前橋市六供町五丁目	135-2-2-3			197.04 m ²	

点名	X座標	Y座標	辺長	方向角	測角	DX	倍積 (Y×DX)
135-2-86	40946.071	-67529.165	15.873	178-32-17	89-59-11	-16.032	1082627.573280
135-2-91	40930.203	-67528.760	2.334	126-38-21	128-06-04	-17.261	1165613.926360
135-2-93	40928.810	-67526.887	12.498	126-36-11	179-57-50	-8.845	597275.315515
135-2-87	40921.358	-67516.854	13.032	45-54-39	99-18-28	1.615	-109039.719210
135-2-82	40930.425	-67507.494	14.782	268-33-42	42-39-03	8.696	-587045.167824
135-2-83	40930.054	-67522.271	13.750	358-33-29	269-59-47	13.375	-903110.374625
135-2-102	40943.800	-67522.617	2.436	358-33-54	180-00-25	16.181	-1092583.465677
135-2-81	40946.235	-67522.678	6.489	268-33-06	89-59-12	2.271	-153344.001738
						倍面積	394.086081
						面積	197.0430405

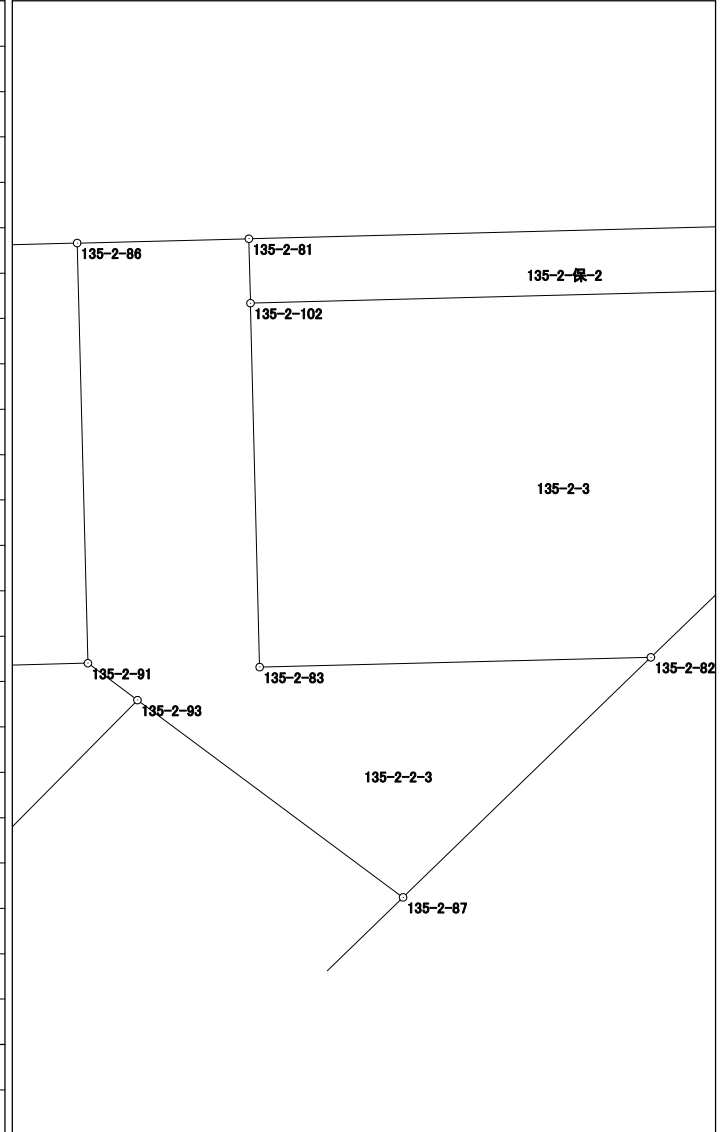

面積計算書（座標法）

世界測地系（測地成果2011）

所在	地番	公簿地目	現況地目	地積	所有者
前橋市六供町五丁目	135-2-2-4			278.15 m ²	


点名	X座標	Y座標	辺長	方向角	測角	DX	倍積 (Y×DX)	
135-2-93	40928.810	-67526.887	6.851	224-39-04	98-02-53	2.578	-174084.314686	
135-2-97	40923.936	-67531.702	16.110	224-36-01	179-56-57	-16.345	1103805.669190	
135-2-92	40912.465	-67543.014	11.963	126-36-54	82-00-53	-18.606	1256705.318484	
135-2-16	40905.330	-67533.412	23.045	45-55-55	99-19-01	8.893	-600574.632916	
135-2-87	40921.358	-67516.854	12.498	306-36-11	80-40-16	23.480	-1585295.731920	
倍面積							556.308152	
面積							278.1540760	

面積計算書（座標法）

世界測地系（測地成果2011）

所在	地番	公簿地目	現況地目	地積	所有者
前橋市六供町五丁目	135-2-2-5			124.41 m ²	

点名	X座標	Y座標	辺長	方向角	測角	DX	倍積 (Y×DX)
135-2-109	40928.172	-67546.039	8.735	178-46-00	72-17-58	-6.890	465392.208710
135-2-112	40919.439	-67545.851	5.001	178-03-07	179-17-07	-13.731	927472.080081
135-2-84	40914.441	-67545.681	3.319	126-32-06	128-28-59	-6.974	471063.579294
135-2-92	40912.465	-67543.014	16.110	44-36-01	98-03-55	9.495	-641320.917930
135-2-97	40923.936	-67531.702	8.448	286-27-18	61-51-17	13.864	-936259.516528
135-2-96	40926.329	-67539.804	6.502	286-28-02	180-00-44	4.236	-286098.609744
						倍面積	248.823883
						面積	124.4119415

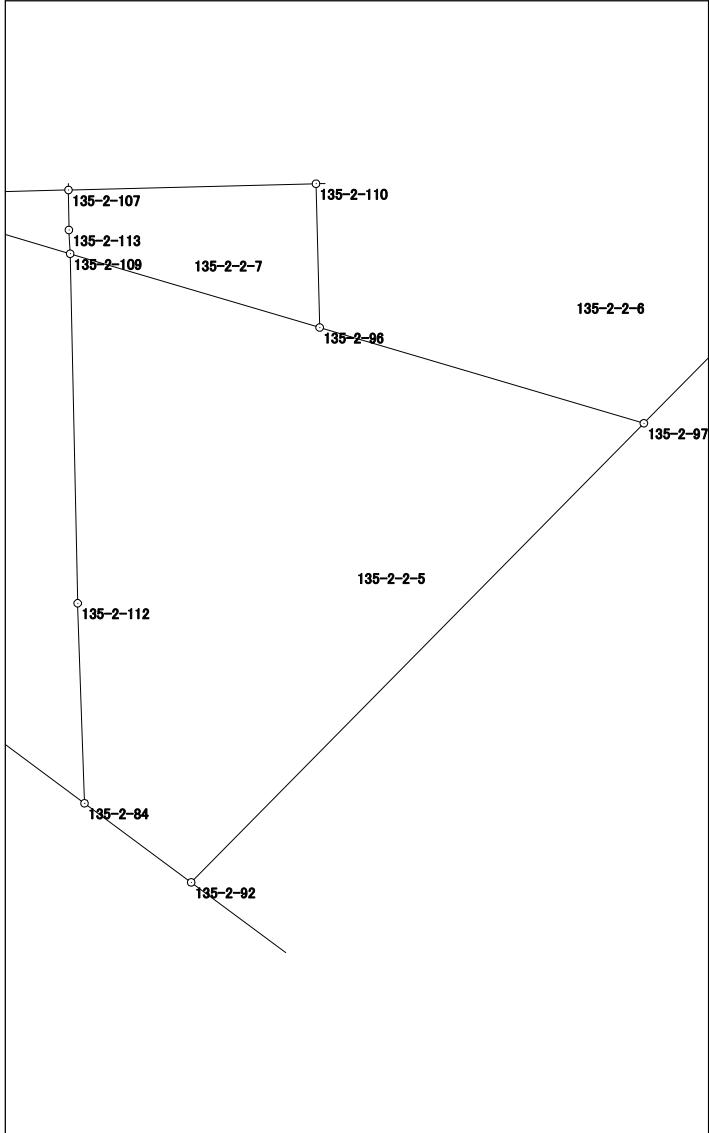


面積計算書 (座標法)

世界測地系 (測地成果2011)

所在	地番	公簿地目	現況地目	地積	所有者
前橋市六供町五丁目	135-2-2-6			56.84 m ²	

点名	X座標	Y座標	辺長	方向角	測角	DX	倍積 (Y×DX)
135-2-110	40929.922	-67539.895	3.594	178-32-57	89-59-41	-3.874	261649.553230
135-2-96	40926.329	-67539.804	8.448	106-27-18	107-54-21	-5.986	404293.266744
135-2-97	40923.936	-67531.702	6.851	44-39-04	118-11-46	2.481	-167546.152662
135-2-93	40928.810	-67526.887	2.334	306-38-21	81-59-17	6.267	-423191.000829
135-2-91	40930.203	-67528.760	11.139	268-33-16	141-54-55	1.112	-75091.981120

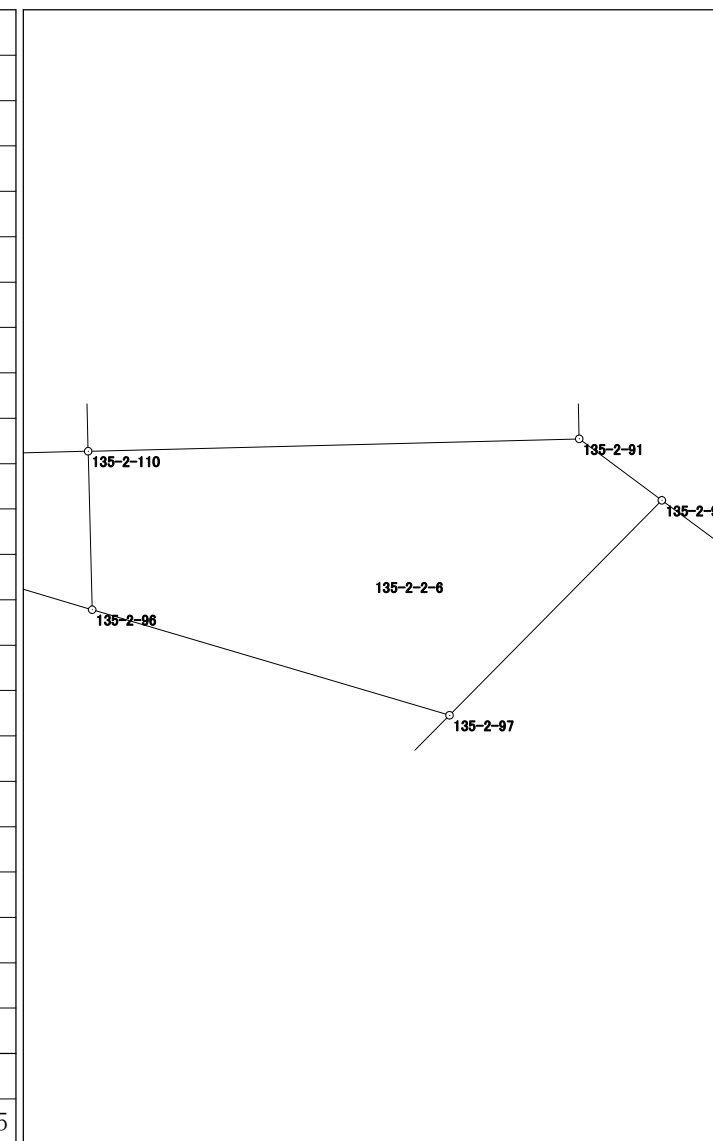


倍面積	113.685363
面積	56.8426815

面積計算書（座標法）

世界測地系（測地成果2011）

所 在	地 番	公簿地目	現況地目	地 積	所 有 者
前橋市六供町五丁目	135-2-2-7			16.06 m ²	

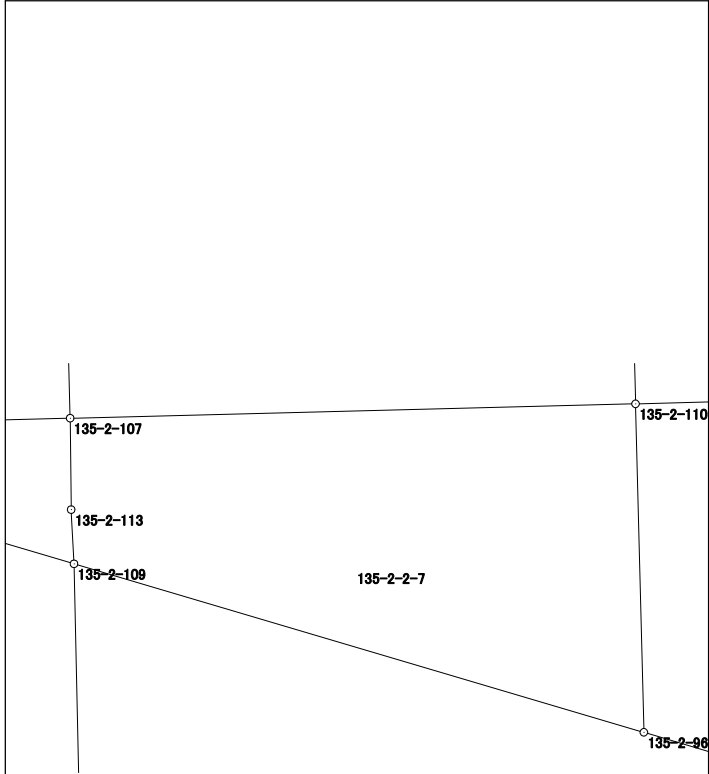
点 名	X 座標	Y 座標	辺 長	方 向 角	測 角	DX	倍 積 (Y×DX)	
135-2-107	40929.765	-67546.081	1.000	179-22-11	90-49-25	-1.157	78150.815717	
135-2-113	40928.765	-67546.070	0.594	177-00-27	177-38-16	-1.593	107600.889510	
135-2-109	40928.172	-67546.039	6.502	106-28-02	109-27-35	-2.436	164542.151004	
135-2-96	40926.329	-67539.804	3.594	358-32-57	72-04-55	1.750	-118194.657000	
135-2-110	40929.922	-67539.895	6.188	268-32-46	89-59-49	3.436	-232067.079220	
								
							倍面積	32.120011
							面 積	16.0600055

面積計算書 (座標法)

世界測地系 (測地成果2011)

所在	地番	公簿地目	現況地目	地積	所有者
前橋市六供町五丁目	135-2-保-1-1			60.37 m ²	

点名	X座標	Y座標	辺長	方向角	測角	DX	倍積 (Y×DX)
135-2-KH1	40945.524	-67550.315	15.860	178-31-07	89-57-28	-15.951	1077495.074565
135-2-106	40929.669	-67549.905	3.825	88-33-43	90-02-36	-15.759	1064518.952895
135-2-107	40929.765	-67546.081	10.862	358-19-39	89-45-56	10.953	-739832.225193
135-2-111	40940.622	-67546.398	4.999	358-53-59	180-34-20	15.855	-1070948.140290
135-2-80	40945.620	-67546.494	3.822	268-33-39	89-39-40	4.902	-331112.913588
倍面積							120.748389
面積							60.3741945

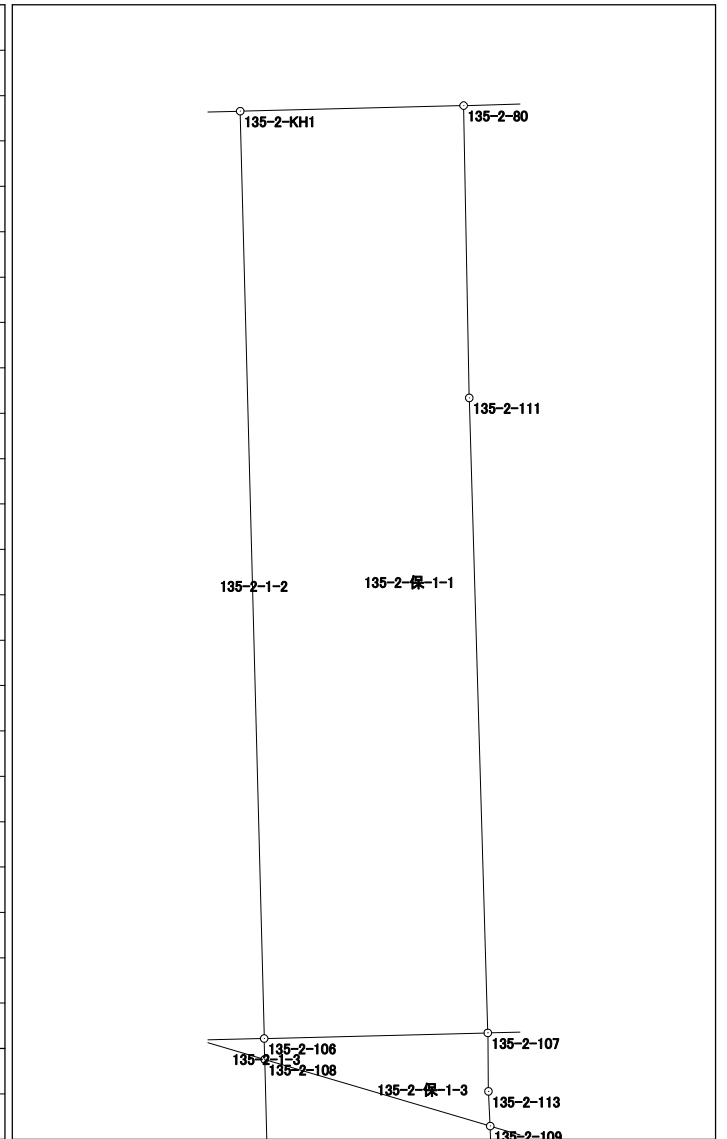


面積計算書（座標法）

世界測地系（測地成果2011）

所在	地番	公簿地目	現況地目	地積	所有者
前橋市六供町五丁目	135-2-保-1-2			48.92 m ²	

点名	X座標	Y座標	辺長	方向角	測角	DX	倍積 (Y×DX)
135-2-108	40929.312	-67549.896	11.974	178-30-59	72-03-02	-10.830	731565.373680
135-2-101	40917.342	-67549.586	4.865	126-36-30	128-05-31	-14.871	1004529.893406
135-2-84	40914.441	-67545.681	5.001	358-03-07	51-26-37	2.097	-141643.293057
135-2-112	40919.439	-67545.851	8.735	358-46-00	180-42-53	13.731	-927472.080081
135-2-109	40928.172	-67546.039	4.022	286-27-57	107-41-57	9.873	-666882.043047

倍面積	97.850901
面積	48.9254505

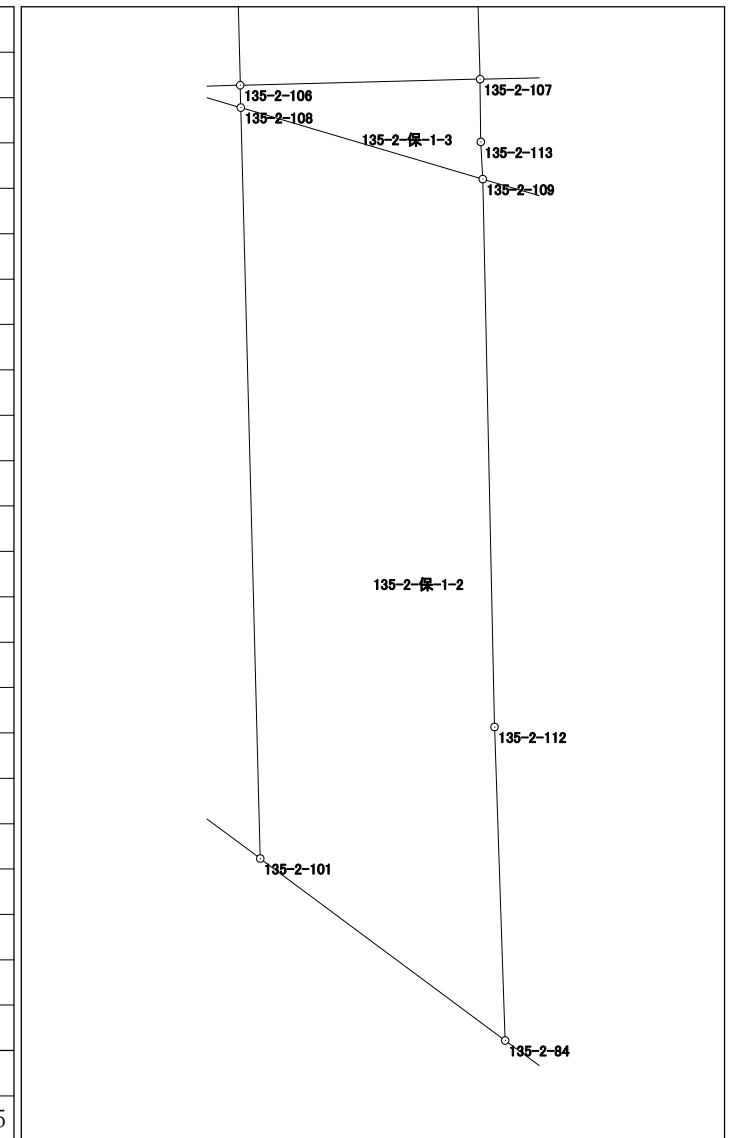


面積計算書 (座標法)

世界測地系 (測地成果2011)

所在	地番	公簿地目	現況地目	地積	所有者
前橋市六供町五丁目	135-2-保-1-3			3.71 m ²	

点名	X座標	Y座標	辺長	方向角	測角	DX	倍積 (Y×DX)
135-2-106	40929.669	-67549.905	0.357	178-33-21	89-59-38	-0.453	30600.106965
135-2-108	40929.312	-67549.896	4.022	106-27-57	107-54-36	-1.497	101122.194312
135-2-109	40928.172	-67546.039	0.594	357-00-27	70-32-30	-0.547	36947.683333
135-2-113	40928.765	-67546.070	1.000	359-22-11	182-21-44	1.593	-107600.889510
135-2-107	40929.765	-67546.081	3.825	268-33-43	89-11-32	0.904	-61061.657224
						倍面積	7.437876
						面積	3.7189380

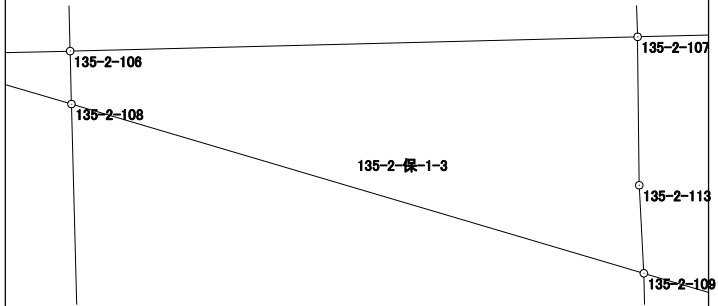


面積計算書（座標法）

世界測地系（測地成果2011）

所在	地番	公簿地目	現況地目	地積	所有者
前橋市六供町五丁目	135-2-保-2			48.00 m ²	

点名	X座標	Y座標	辺長	方向角	測角	D _X	倍積 (Y×D _X)
135-2-102	40943.800	-67522.617	20.927	88-31-56	89-58-02	-1.899	128225.449683
135-2-103	40944.336	-67501.697	3.451	313-26-19	44-54-23	2.909	-196362.436573
135-2-26	40946.709	-67504.203	18.481	268-31-49	135-05-30	1.899	-128190.481497
135-2-81	40946.235	-67522.678	2.436	178-33-54	90-02-05	-2.909	196423.470302

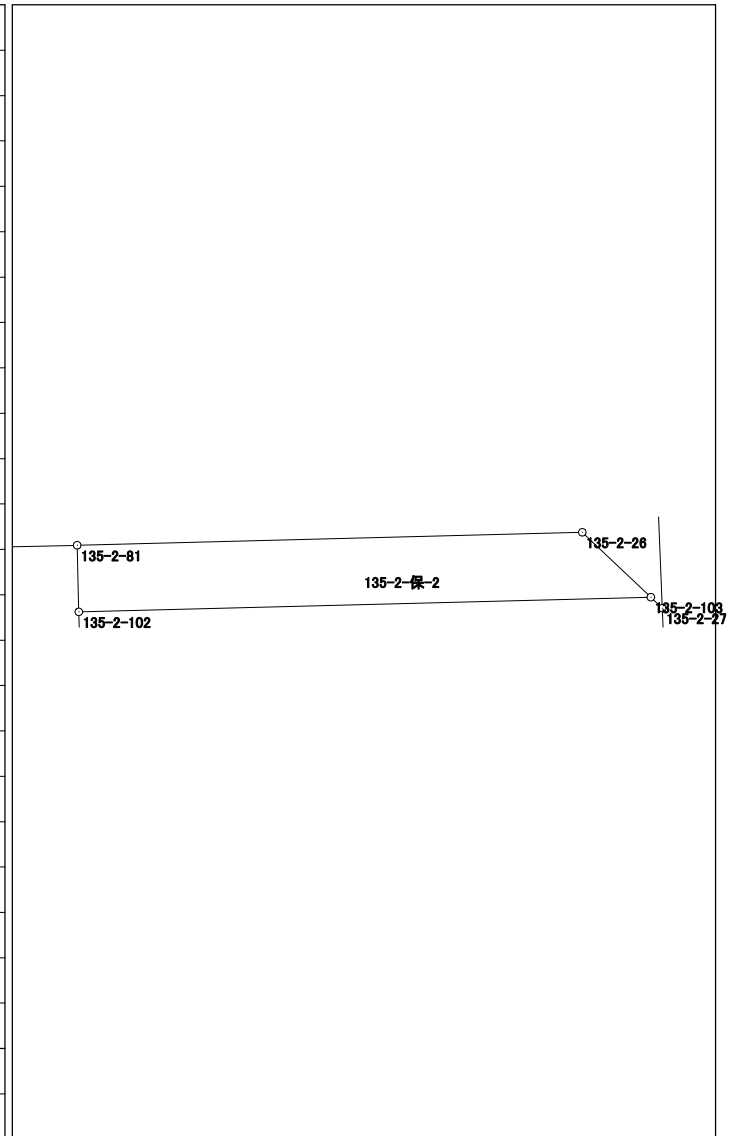

倍面積	96.001915
面積	48.0009575