



136街区 画地出来形確認図 (3076.31m²)

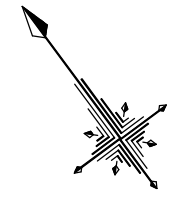

1/500

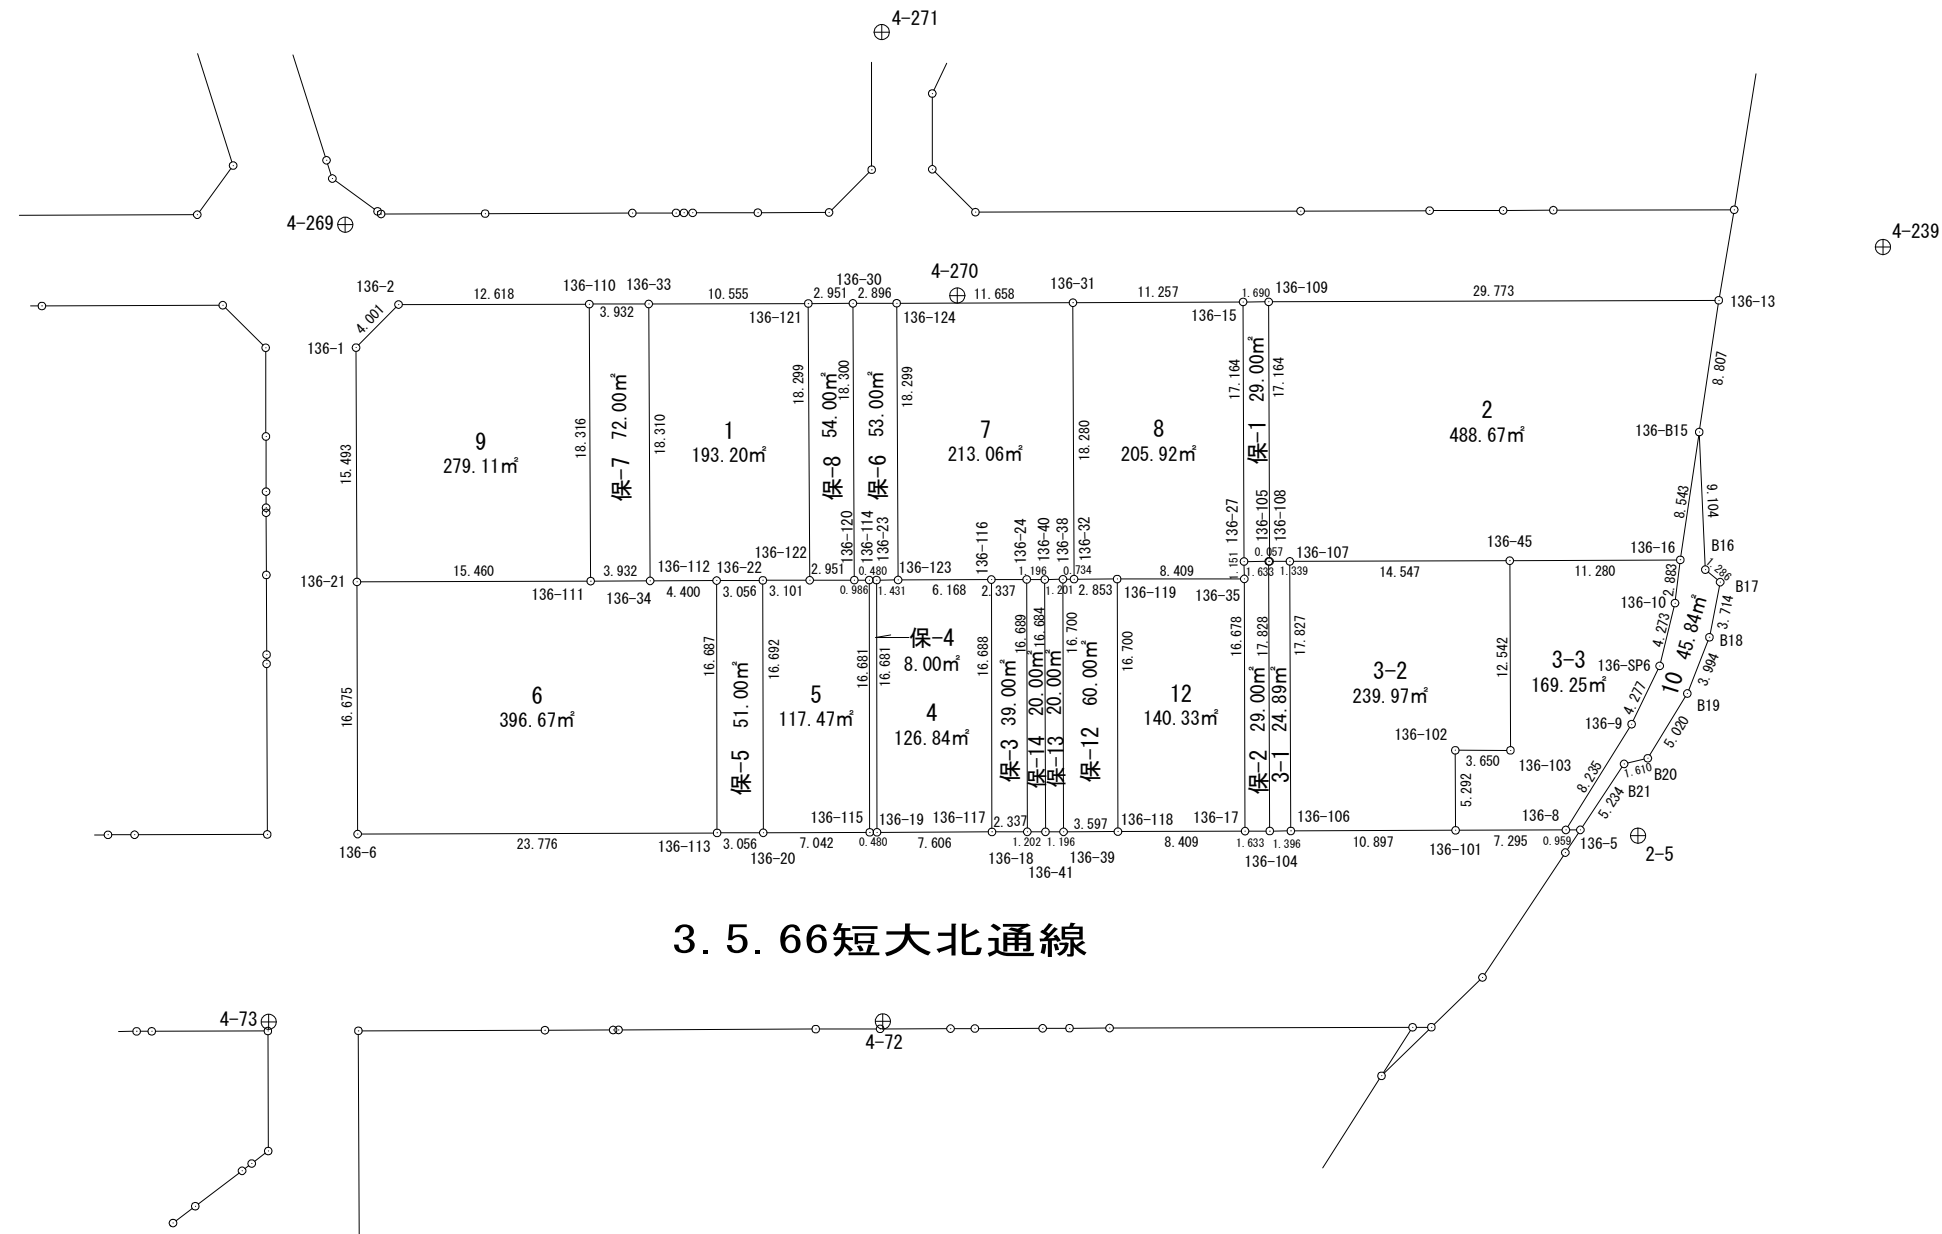


3. 5. 66短大北通線

面積計算書 (座標法)

世界測地系 (測地成果2011)

所 在	地 番	公簿地目	現況地目	地 積	所 有 者
前橋市六供町五丁目	136-6			396.67 m ²	

点 名	X 座標	Y 座標	辺 長	方 向 角	測 角	DX	倍 積 (Y×DX)
136-112	40925.976	-67602.009	4.400	306-29-51	89-50-06	16.003	-1081834.950027
136-34	40928.593	-67605.546	3.932	306-33-39	180-03-48	4.959	-335255.902614
136-111	40930.935	-67608.704	15.460	306-34-24	180-00-45	11.554	-781150.966016
136-21	40940.147	-67621.120	16.675	216-36-34	90-02-10	-4.173	282182.933760
136-6	40926.762	-67631.064	23.776	126-35-17	89-58-43	-27.557	1863709.230648
136-113	40912.590	-67611.973	16.687	36-39-45	90-04-28	-0.786	53143.010778
倍面積						793.356529	
面 積						396.6782645	

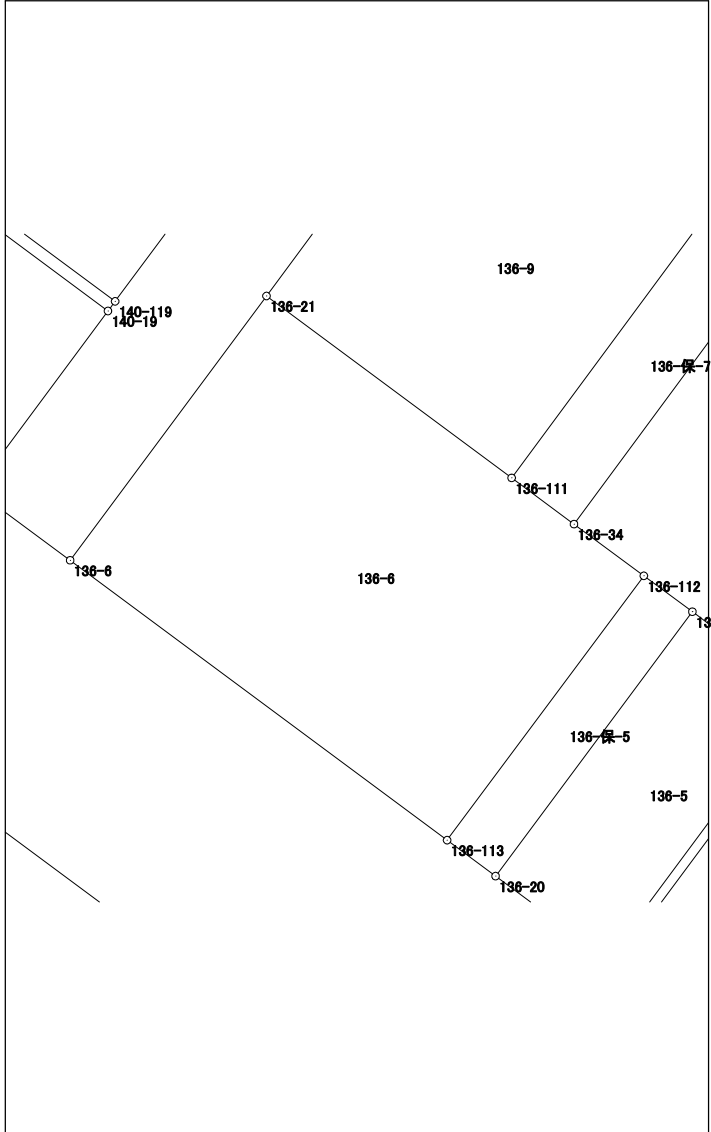


面積計算書 (座標法)

世界測地系 (測地成果2011)

所在	地番	公簿地目	現況地目	地積	所有者
前橋市六供町五丁目	136-7			213.06 m ²	

点名	X座標	Y座標	辺長	方向角	測角	DX	倍積 (Y×DX)
136-124	40933.538	-67581.491	18.299	216-28-00	89-52-44	-7.767	524905.440597
136-123	40918.822	-67592.367	6.168	126-31-41	90-03-41	-18.387	1242820.852029
136-116	40915.151	-67587.411	2.337	126-31-36	179-59-55	-5.062	342127.474482
136-24	40913.760	-67585.533	1.196	127-04-51	180-33-15	-2.112	142740.645696
136-40	40913.039	-67584.579	1.201	125-59-32	178-54-41	-1.427	96443.194233
136-38	40912.333	-67583.607	0.734	125-57-51	179-58-19	-1.137	76842.561159
136-32	40911.902	-67583.013	18.280	36-32-18	90-34-27	14.256	-963463.433328
136-31	40926.589	-67572.130	11.658	306-35-16	90-02-58	21.636	-1461990.604680

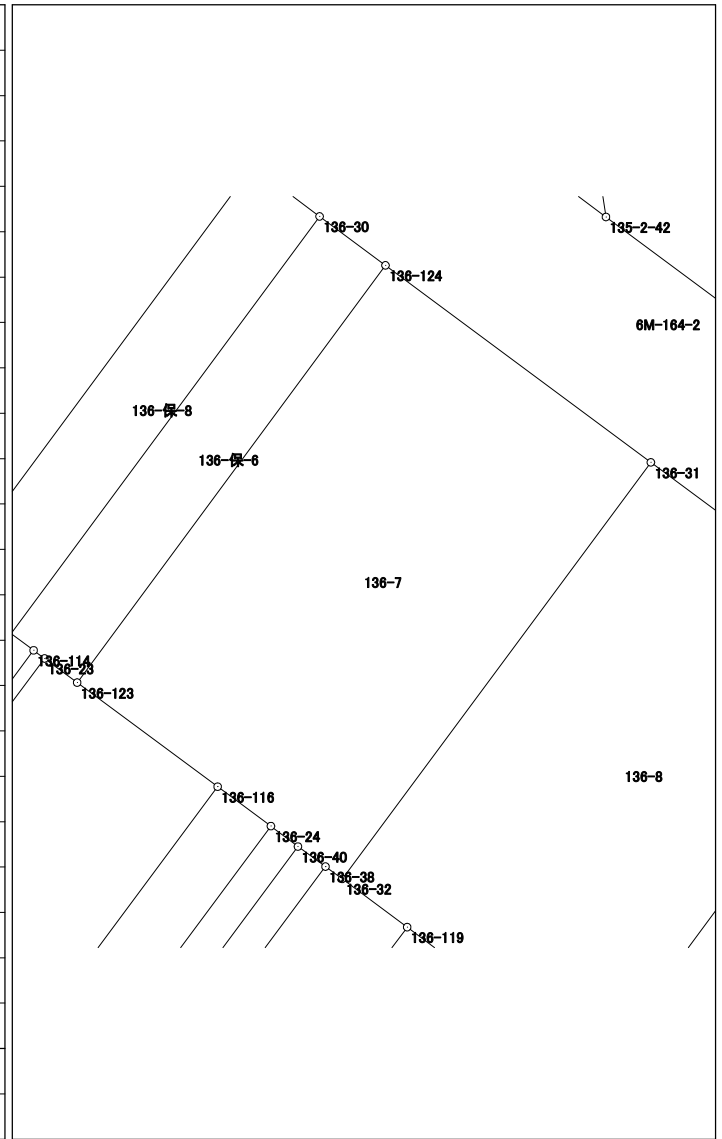

倍面積	426.130188
面積	213.0650940


面積計算書 (座標法)

世界測地系 (測地成果2011)

所在	地番	公簿地目	現況地目	地積	所有者
前橋市六供町五丁目	136-8			205.92 m ²	

点名	X座標	Y座標	辺長	方向角	測角	DX	倍積 (Y×DX)
136-32	40911.902	-67583.013	2.853	126-41-36	90-09-18	-16.392	1107820.749096
136-119	40910.197	-67580.725	8.409	126-42-13	180-00-37	-6.731	454885.859975
136-35	40905.171	-67573.983	1.151	35-57-15	89-15-02	-4.094	276647.886402
136-27	40906.103	-67573.307	17.164	36-33-34	180-36-19	14.719	-994611.505733
136-15	40919.890	-67563.083	11.257	306-31-07	89-57-33	20.486	-1384097.318338
136-31	40926.589	-67572.130	18.280	216-32-18	90-01-11	-7.988	539766.174440


倍面積	411.845842
面積	205.9229210

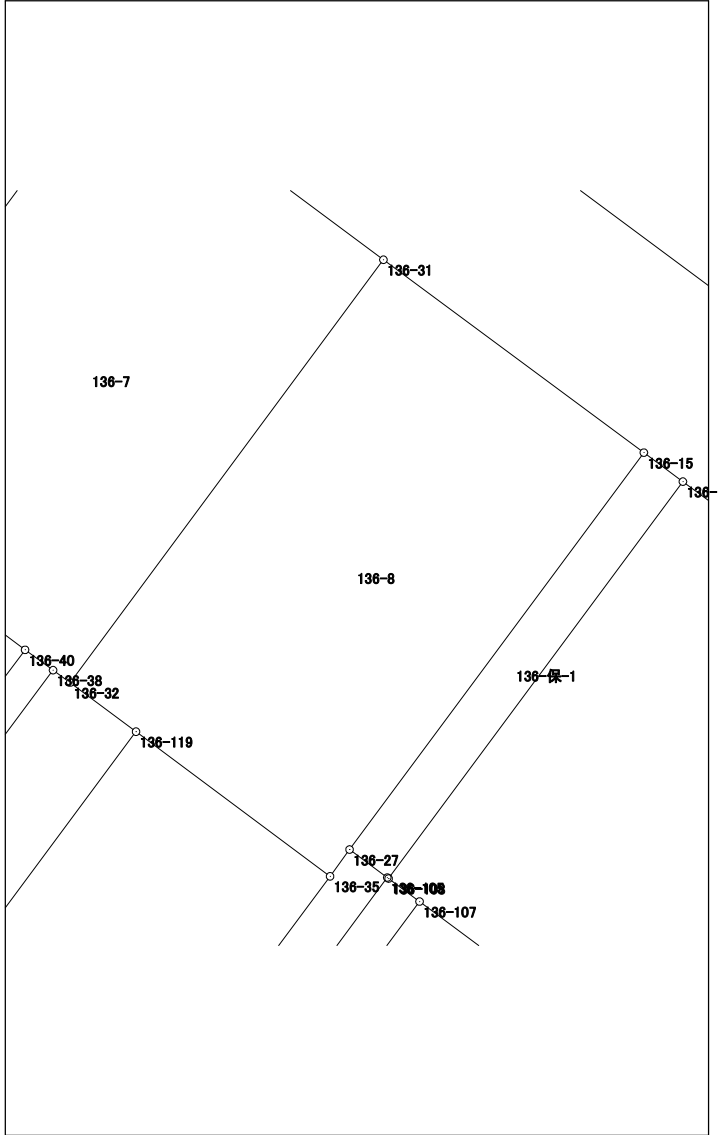

面積計算書（座標法）

所 在	地 番	公簿地目	現況地目	地 積	所 有 者
前橋市六供町五丁目	136-9			279.11 m ²	

点 名	X 座標	Y 座標	辺 長	方 向 角	測 角	DX	倍 積 (Y×DX)
136-111	40930.935	-67608.704	18.316	36-28-53	89-54-29	5.515	-372862.002560
136-110	40945.662	-67597.814	12.618	306-38-41	90-09-48	22.258	-1504592.144012
136-2	40953.193	-67607.938	4.001	261-22-33	134-43-52	6.931	-468590.618278
136-1	40952.593	-67611.894	15.493	216-32-56	135-10-23	-13.046	882064.769124
136-21	40940.147	-67621.120	15.460	126-34-24	90-01-28	-21.658	1464538.216960

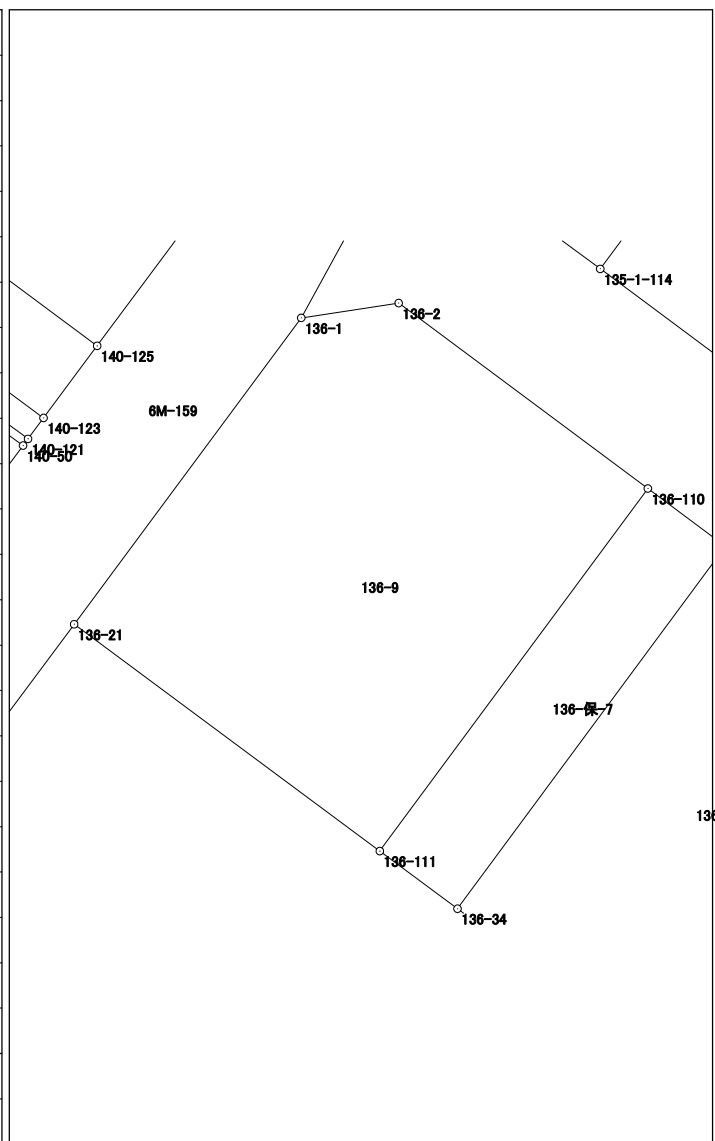


倍面積	558.221234
面積	279.1106170

面積計算書 (座標法)

世界測地系 (測地成果2011)

所在	地番	公簿地目	現況地目	地積	所有者
前橋市六供町五丁目	136-10			45.84 m ²	

点名	X座標	Y座標	辺長	方向角	測角	Dx	倍積 (Y×Dx)
136-8	40879.142	-67566.879	0.959	126-33-33	57-54-53	-3.570	241213.758030
136-5	40878.571	-67566.109	5.234	70-20-22	123-46-49	1.190	-80403.669710
B21	40880.332	-67561.180	1.610	113-20-53	223-00-31	1.123	-75871.205140
B20	40879.694	-67559.702	5.020	68-09-07	134-48-14	1.230	-83098.433460
B19	40881.562	-67555.043	3.994	58-15-50	170-06-43	3.969	-268125.965667
B18	40883.663	-67551.646	3.714	47-47-38	169-31-48	4.596	-310467.365016
B17	40886.158	-67548.895	1.286	346-55-31	119-07-53	3.748	-253173.258460
B16	40887.411	-67549.186	9.104	34-14-05	227-18-34	8.780	-593081.853080
136-B15	40894.938	-67544.064	8.543	225-11-57	10-57-52	1.507	-101788.904448
136-16	40888.918	-67550.126	2.883	223-45-47	178-33-50	-8.102	547291.120852
136-10	40886.836	-67552.120	4.273	230-27-38	186-41-51	-4.802	324385.280240
136-SP6	40884.116	-67555.415	4.277	242-30-01	192-02-23	-4.695	317172.673425
136-9	40882.141	-67559.209	8.235	248-38-40	186-08-39	-4.974	336039.505566

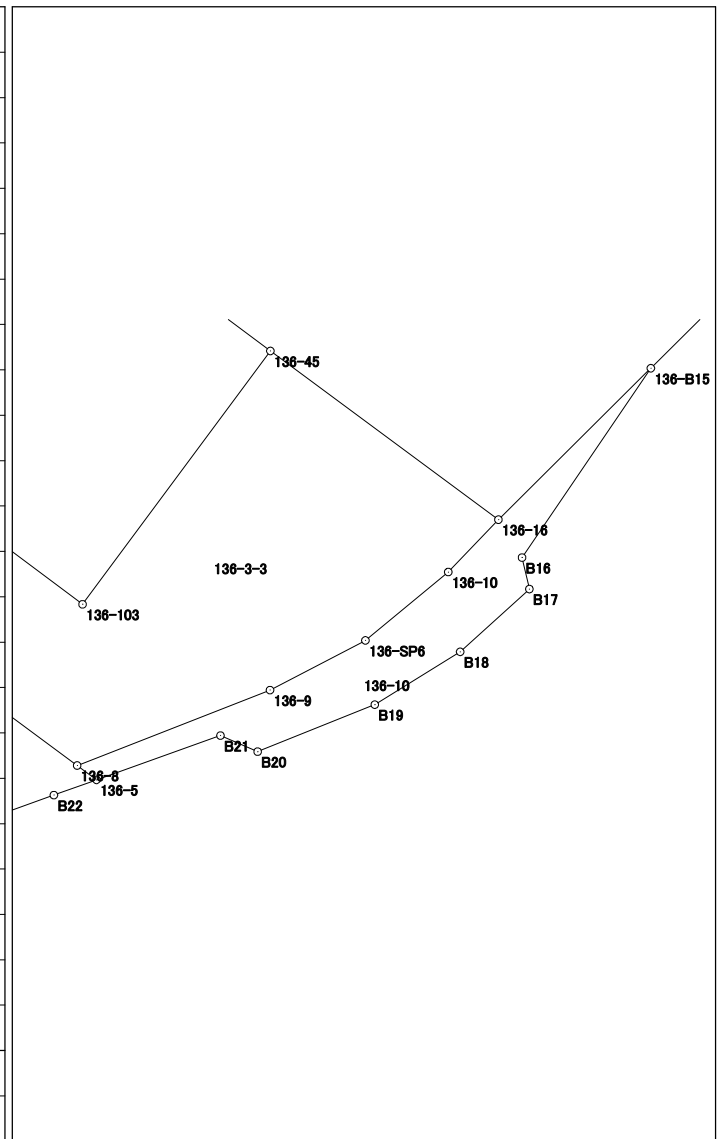


倍面積	91.683132
面積	45.8415660

面積計算書（座標法）

世界測地系（測地成果2011）

所 在	地 番	公簿地目	現況地目	地 積	所 有 者
前橋市六供町五丁目	136-12			140.33 m ²	

点 名	X 座標	Y 座標	辺 長	方 向 角	測 角	DX	倍 積 (Y×DX)
136-119	40910.197	-67580.725	16.700	216-35-44	89-53-31	-8.382	566461.636950
136-118	40896.789	-67590.681	8.409	126-33-09	89-57-25	-18.416	1244749.981296
136-17	40891.781	-67583.926	16.678	36-35-47	90-02-38	8.382	-566488.467732
136-35	40905.171	-67573.983	8.409	306-42-13	90-06-26	18.416	-1244442.470928
倍面積							280.679586
面 積							140.3397930

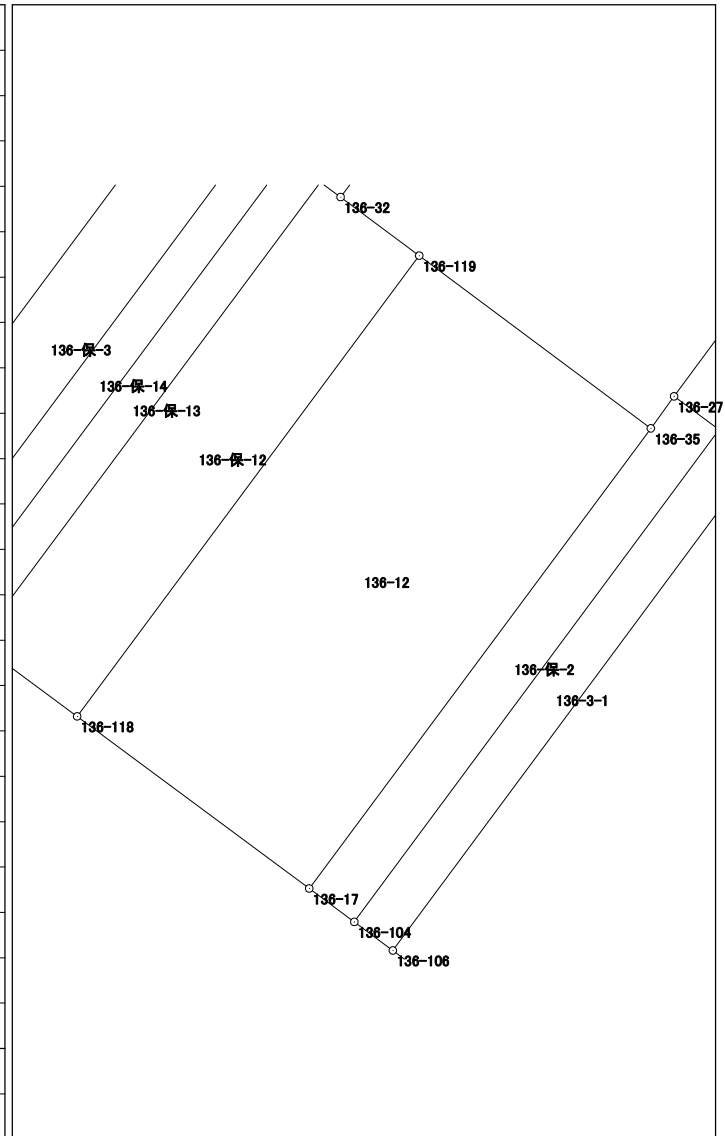


面積計算書 (座標法)

世界測地系 (測地成果2011)

所在	地番	公簿地目	現況地目	地積	所有者
前橋市六供町五丁目	136-保-2			29.00 m ²	

点名	X座標	Y座標	辺長	方向角	測角	D _X	倍積 (Y×D _X)
136-104	40890.809	-67582.614	17.828	36-33-15	90-01-16	13.349	-902160.314286
136-105	40905.130	-67571.996	1.633	306-34-56	90-01-41	15.294	-1033446.106824
136-27	40906.103	-67573.307	1.151	215-57-15	89-22-19	0.041	-2770.505587
136-35	40905.171	-67573.983	16.678	216-35-47	180-38-32	-14.322	967794.584526
136-17	40891.781	-67583.926	1.633	126-31-59	89-56-12	-14.362	970640.345212
						倍面積	58.003041
						面積	29.0015205

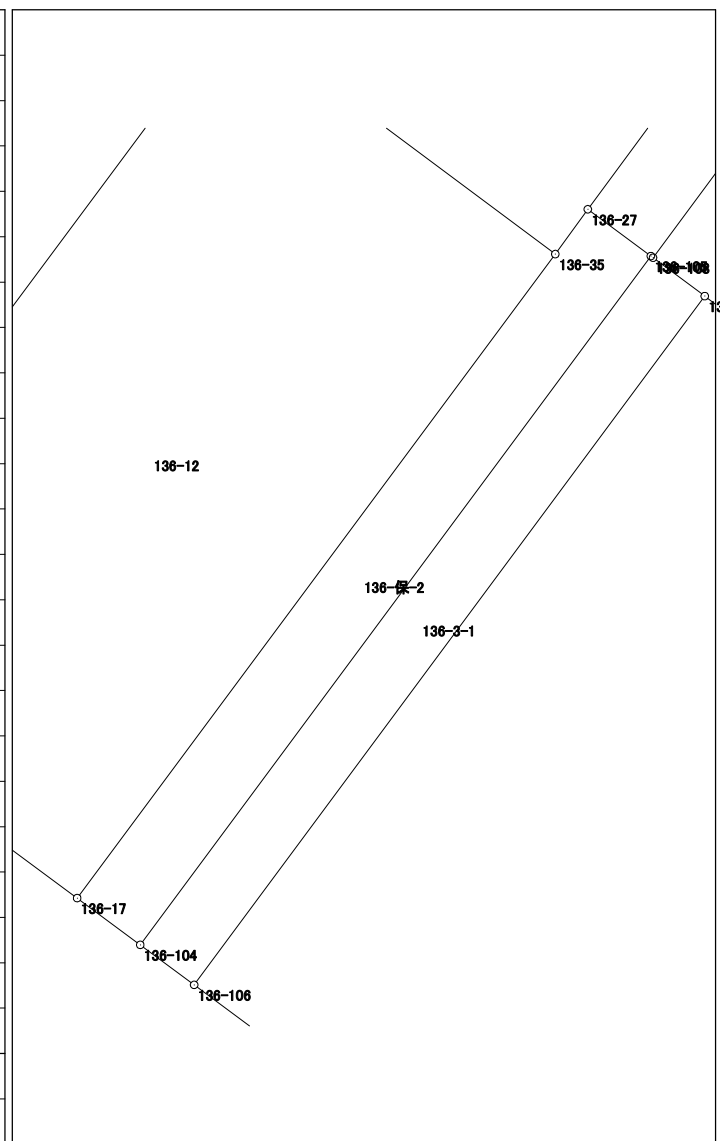


面積計算書 (座標法)

世界測地系 (測地成果2011)

所在	地番	公簿地目	現況地目	地積	所有者
前橋市六供町五丁目	136-保-3			39.00 m ²	

点名	X座標	Y座標	辺長	方向角	測角	Dx	倍積 (Y×Dx)
136-116	40915.151	-67587.411	16.688	216-37-51	90-06-15	-12.001	811116.519411
136-117	40901.759	-67597.368	2.337	126-33-39	89-55-48	-14.784	999359.488512
136-18	40900.367	-67595.491	16.689	36-37-54	90-04-15	12.001	-811213.487491
136-24	40913.760	-67585.533	2.337	306-31-36	89-53-42	14.784	-999184.519872
						倍面積	78.000560
						面積	39.0002800

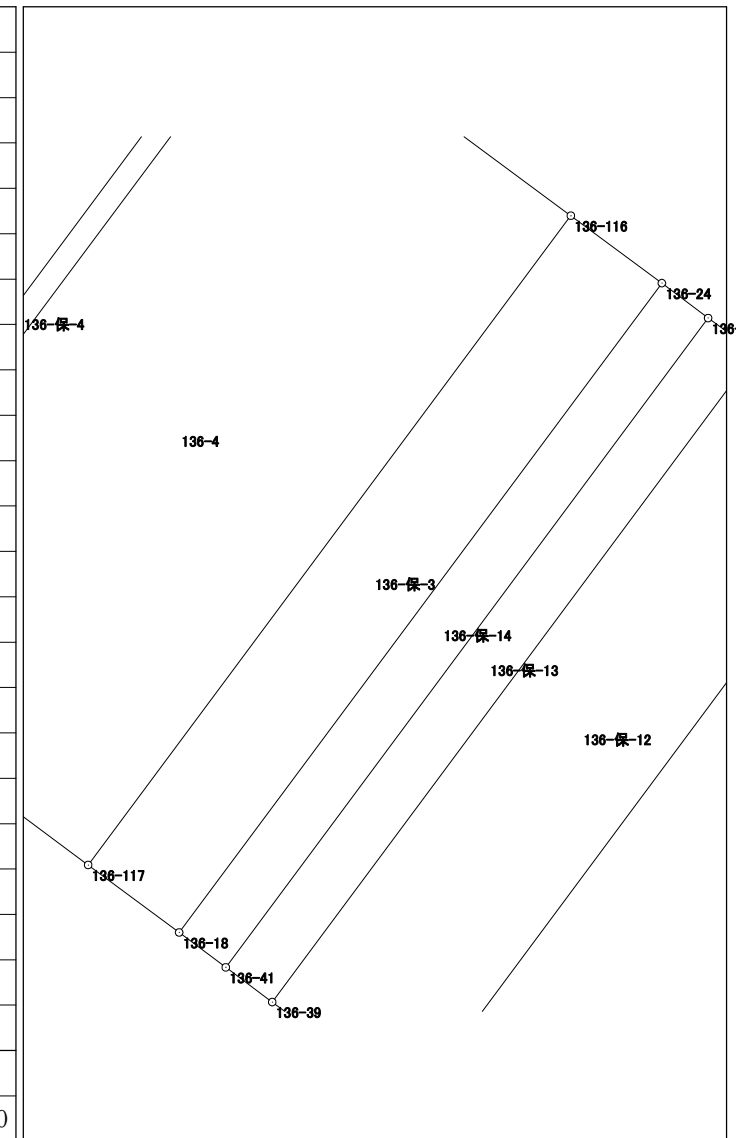


面積計算書 (座標法)

世界測地系 (測地成果2011)

所在	地番	公簿地目	現況地目	地積	所有者
前橋市六供町五丁目	136-保-4			8.00 m ²	

点名	X座標	Y座標	辺長	方向角	測角	DX	倍積 (Y×DX)
136-114	40919.959	-67593.903	16.681	216-39-15	90-02-50	-13.096	885209.753688
136-115	40906.577	-67603.861	0.480	126-36-25	89-57-10	-13.668	924009.572148
136-19	40906.291	-67603.476	16.681	36-39-15	90-02-50	13.096	-885335.121696
136-23	40919.673	-67593.518	0.480	306-36-25	89-57-10	13.668	-923868.204024
						倍面積	16.000116
						面積	8.0000580

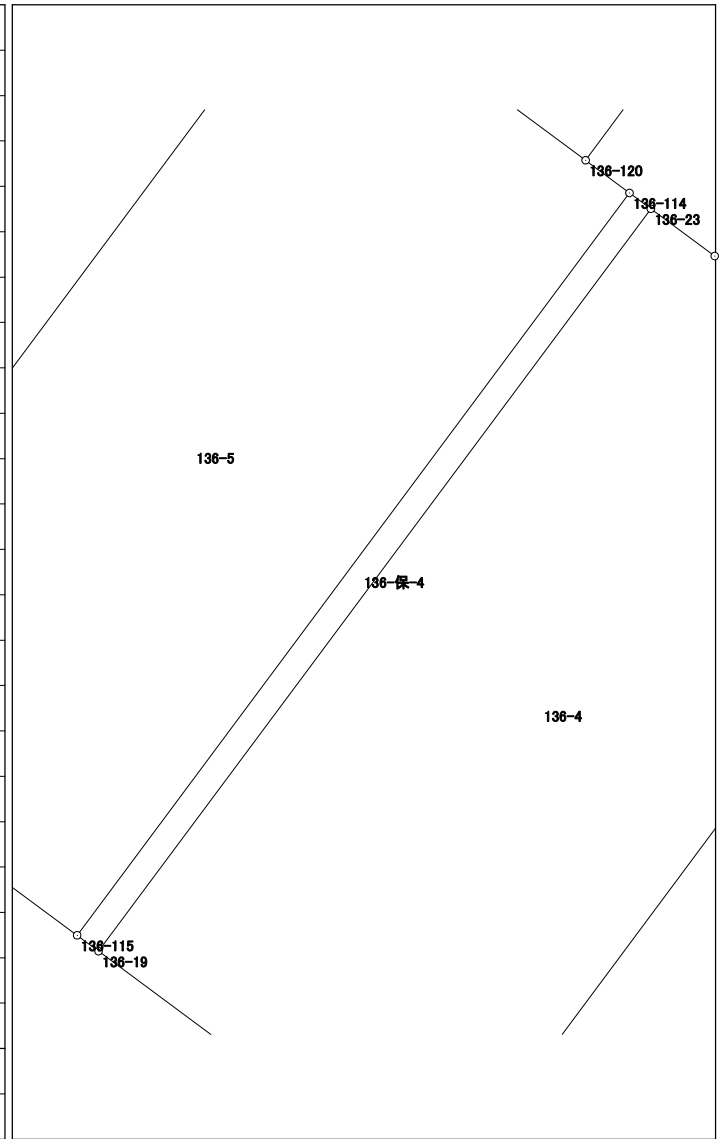


面積計算書（座標法）

世界測地系（測地成果2011）

所在	地番	公簿地目	現況地目	地積	所有者
前橋市六供町五丁目	136-保-5			51.00 m ²	

点名	X座標	Y座標	辺長	方向角	測角	DX	倍積 (Y×DX)
136-112	40925.976	-67602.009	16.687	216-39-45	90-09-50	-11.568	782020.040112
136-113	40912.590	-67611.973	3.056	126-34-39	89-54-54	-15.207	1028175.273411
136-20	40910.769	-67609.519	16.692	36-39-53	90-05-14	11.568	-782106.915792
136-22	40924.158	-67599.552	3.056	306-29-55	89-50-02	15.207	-1027986.387264

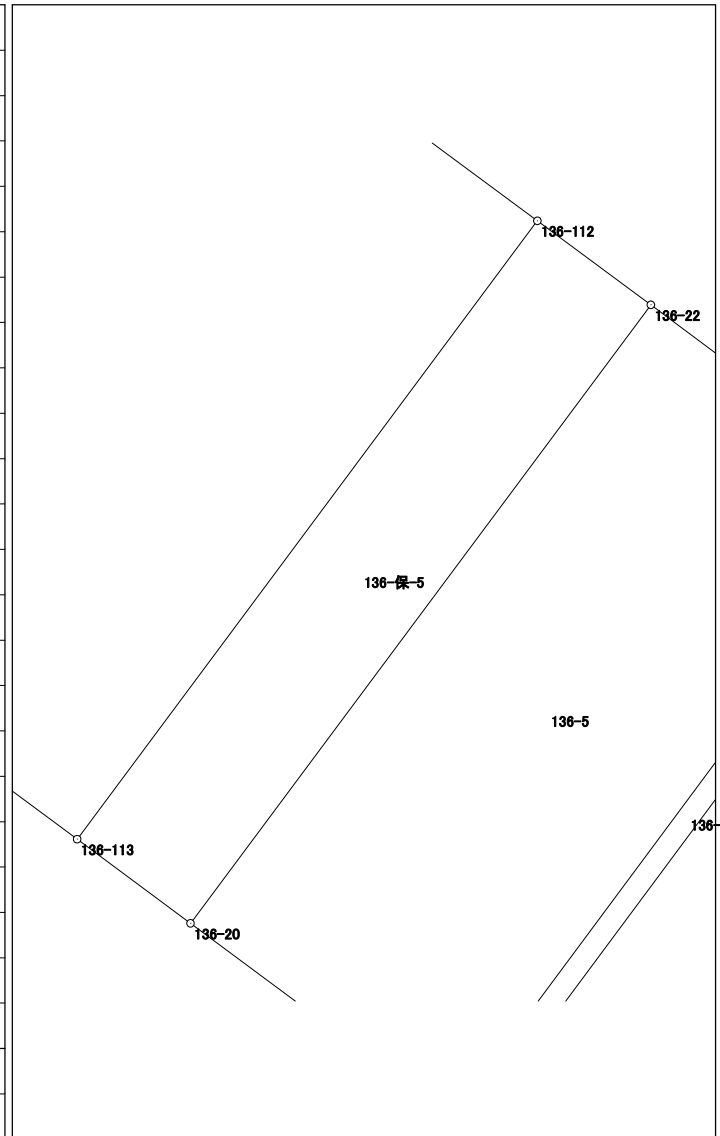


倍面積	102.010467
面積	51.0052335

面積計算書 (座標法)

世界測地系 (測地成果2011)

所在	地番	公簿地目	現況地目	地積	所有者
前橋市六供町五丁目	136-保-6			53.00 m ²	

点名	X座標	Y座標	辺長	方向角	測角	DX	倍積 (Y×DX)
136-123	40918.822	-67592.367	18.299	36-28-00	89-59-21	13.865	-937168.168455
136-124	40933.538	-67581.491	2.896	306-35-20	90-07-20	16.442	-1111174.875022
136-30	40935.264	-67583.816	18.300	216-28-18	89-52-58	-12.990	877913.769840
136-120	40920.548	-67594.694	0.986	126-40-21	90-12-03	-15.305	1034536.791670
136-114	40919.959	-67593.903	0.480	126-36-25	179-56-04	-0.875	59144.665125
136-23	40919.673	-67593.518	1.431	126-28-39	179-52-14	-1.137	76853.829966
						倍面積	106.013124
						面積	53.0065620

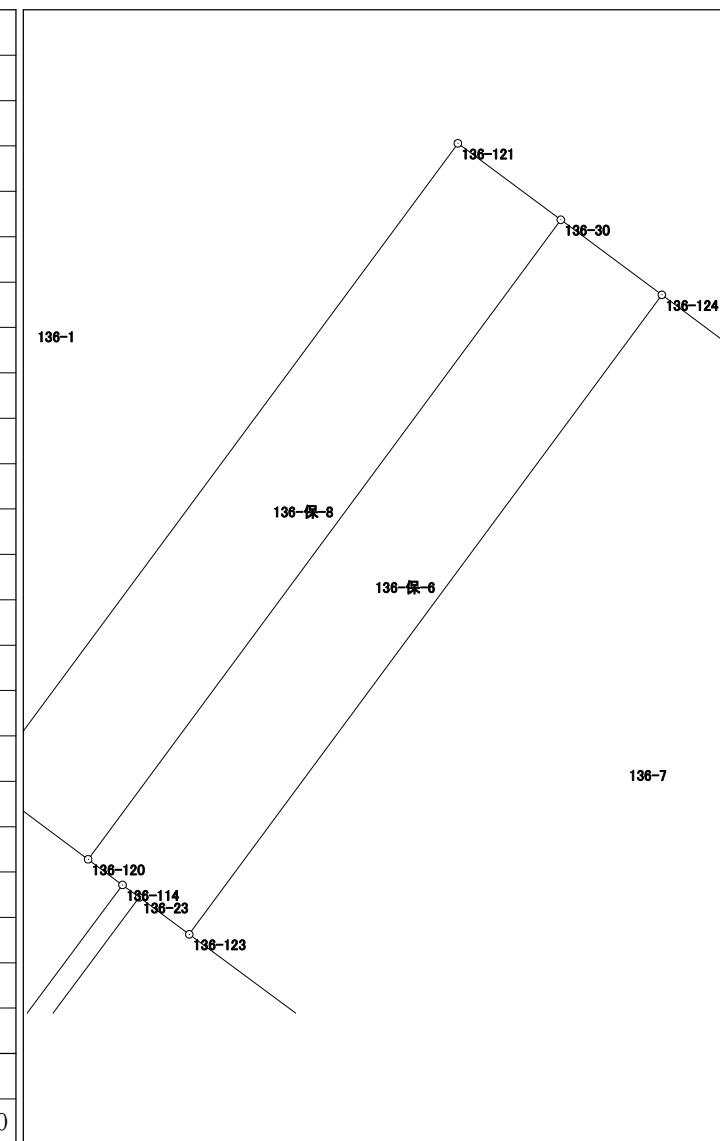


面積計算書 (座標法)

世界測地系 (測地成果2011)

所在	地番	公簿地目	現況地目	地積	所有者
前橋市六供町五丁目	136-保-7			72.00 m ²	


点名	X座標	Y座標	辺長	方向角	測角	DX	倍積 (Y×DX)
136-110	40945.662	-67597.814	18.316	216-28-53	89-50-09	-12.380	836860.937320
136-111	40930.935	-67608.704	3.932	126-33-39	90-04-46	-17.069	1154012.968576
136-34	40928.593	-67605.546	18.310	36-28-59	89-55-20	12.380	-836956.659480
136-33	40943.315	-67594.659	3.932	306-38-44	90-09-45	17.069	-1153773.234471
						倍面積	144.011945
						面積	72.0059725

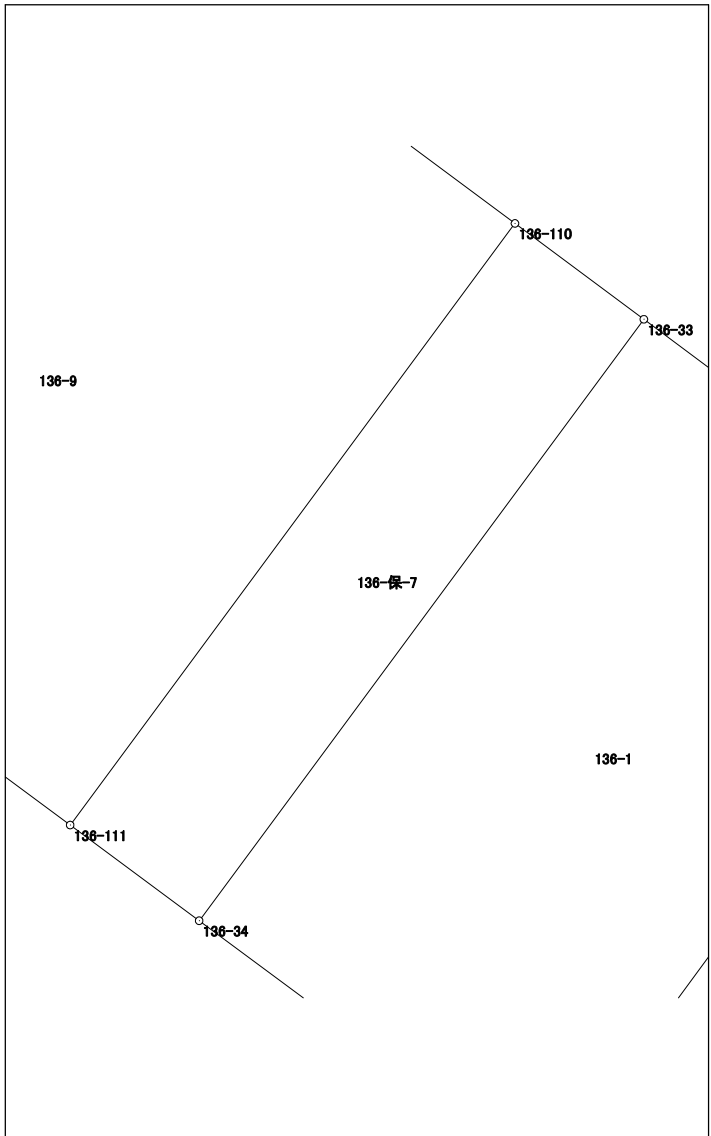

面積計算書 (座標法)

所在	地番	公簿地目	現況地目	地積	所有者
前橋市六供町五丁目	136-保-8			54.00 m ²	

点名	X座標	Y座標	辺長	方向角	測角	DX	倍積 (Y×DX)
136-121	40937.023	-67586.185	18.299	216-28-25	89-52-46	-12.956	875646.612860
136-122	40922.308	-67597.063	2.951	126-36-35	90-08-10	-16.475	1113661.612925
136-120	40920.548	-67594.694	18.300	36-28-18	89-51-43	12.956	-875756.855464
136-30	40935.264	-67583.816	2.951	306-35-39	90-07-21	16.475	-1113443.368600
						倍面積	108.001721
						面積	54.0008605

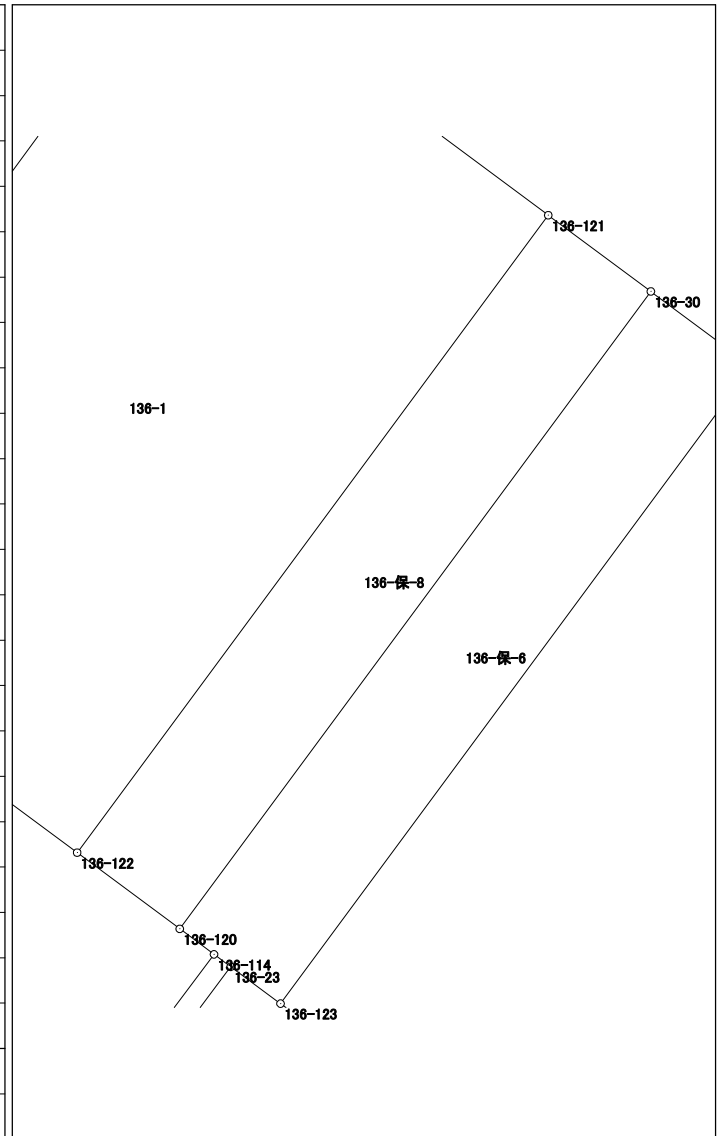


面積計算書（座標法）

世界測地系（測地成果2011）

所 在	地 番	公簿地目	現況地目	地 積	所 有 者
前橋市六供町五丁目	136-保-12			60.00 m ²	

点 名	X 座標	Y 座標	辺 長	方 向 角	測 角	DX	倍 積 (Y×DX)
136-118	40896.789	-67590.681	16.700	36-35-44	90-03-02	11.266	-761476.612146
136-119	40910.197	-67580.725	2.853	306-41-36	90-05-52	15.113	-1021347.496925
136-32	40911.902	-67583.013	0.734	305-57-51	179-16-15	2.136	-144357.315768
136-38	40912.333	-67583.607	16.700	216-37-47	90-39-56	-12.971	876626.966397
136-39	40898.931	-67593.571	3.597	126-32-42	89-54-55	-15.544	1050674.467624

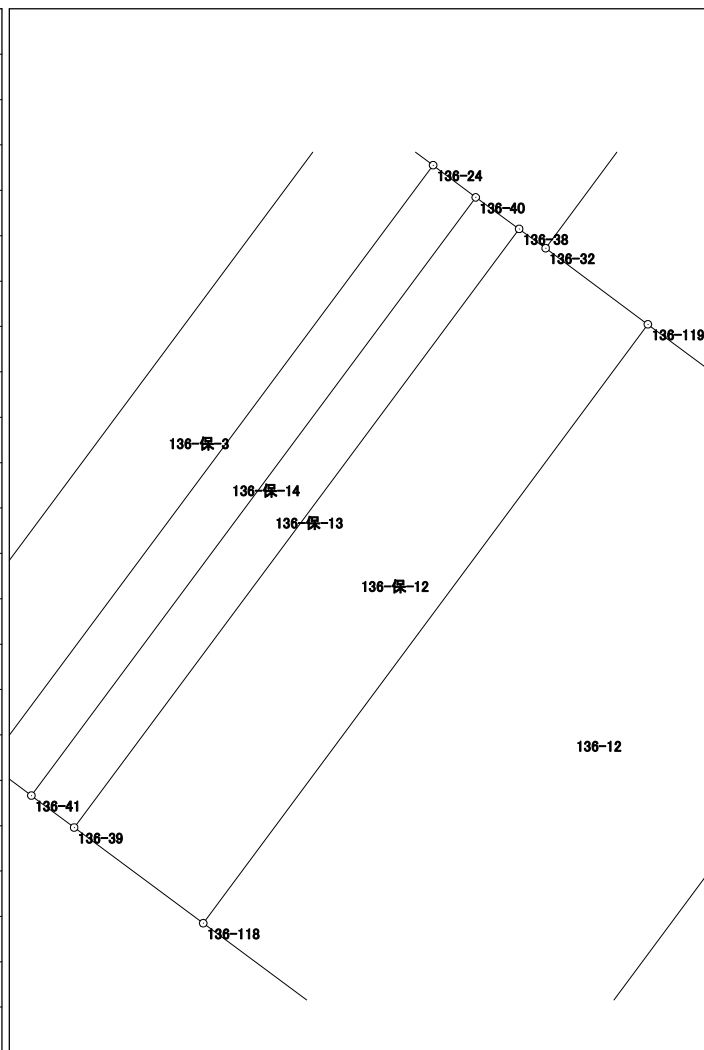

倍面積	120.009182
面 積	60.0045910

面積計算書 (座標法)

世界測地系 (測地成果2011)

所在	地番	公簿地目	現況地目	地積	所有者
前橋市六供町五丁目	136-保-13			20.00 m ²	

点名	X座標	Y座標	辺長	方向角	測角	DX	倍積 (Y×DX)
136-40	40913.039	-67584.579	16.684	216-36-42	90-37-10	-12.686	857377.969194
136-41	40899.647	-67594.529	1.196	126-46-27	90-09-45	-14.108	953623.615132
136-39	40898.931	-67593.571	16.700	36-37-47	89-51-20	12.686	-857492.041706
136-38	40912.333	-67583.607	1.201	305-59-32	89-21-45	14.108	-953469.527556
						倍面積	40.015064
						面積	20.0075320

