



137-1街区 画地出来形確認図 (2079.04m²)

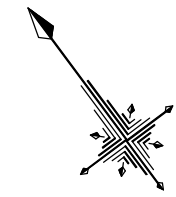

1/500

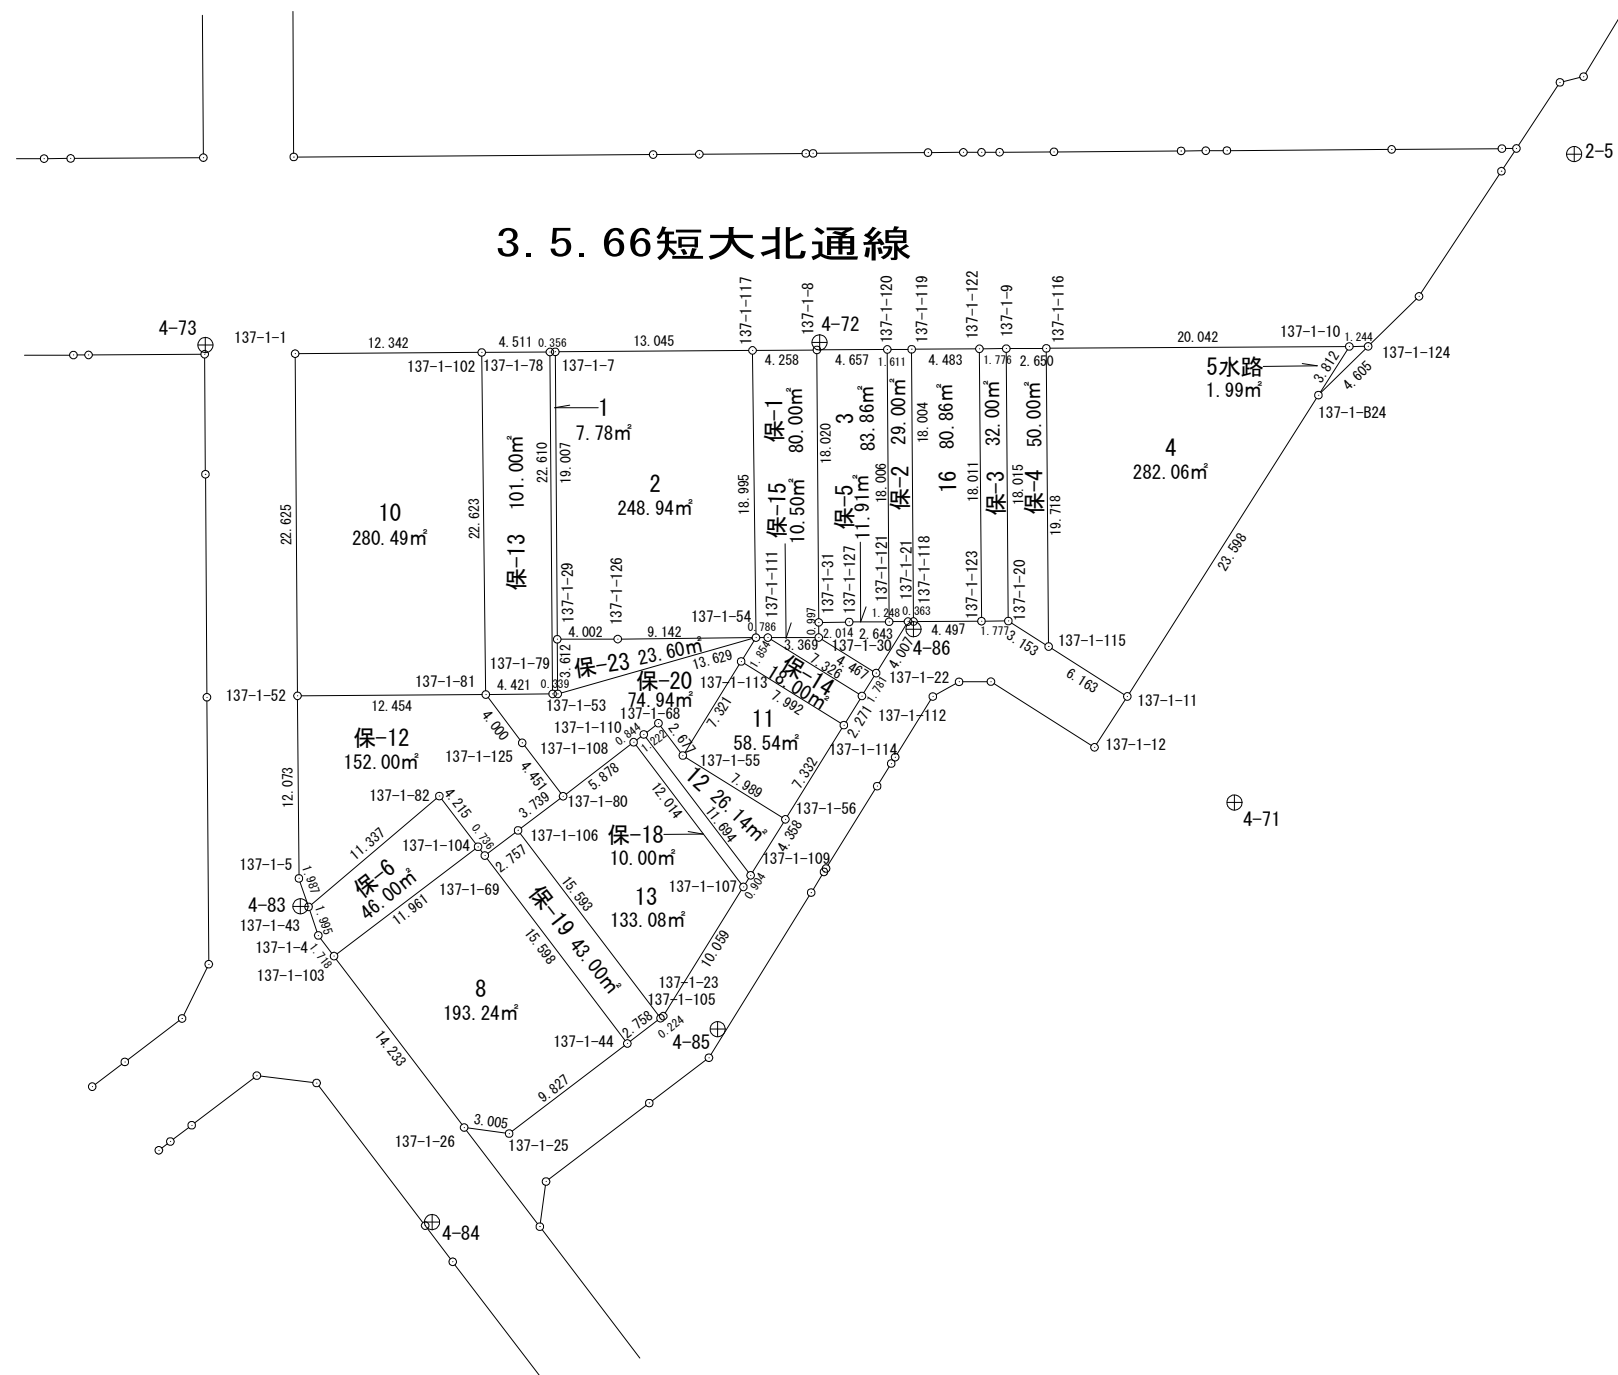


面積計算書 (座標法)

世界測地系 (測地成果2011)

所在	地番	公簿地目	現況地目	地積	所有者
前橋市六供町五丁目	137-1-1			7.78 m ²	

点名	X座標	Y座標	辺長	方向角	測角	DX	倍積 (Y×DX)
137-1-79	40888.095	-67638.736	0.339	126-58-16	90-27-09	-18.375	1242861.774000
137-1-53	40887.891	-67638.465	3.612	36-27-15	89-28-59	2.701	-182691.493965
137-1-29	40890.796	-67636.319	19.007	36-34-56	180-07-41	18.168	-1228816.643592
137-1-7	40906.059	-67624.991	0.356	305-31-08	88-56-12	15.470	-1046158.610770
137-1-78	40906.266	-67625.281	22.610	216-31-07	90-59-59	-17.964	1214820.547884
						倍面積	15.573557
						面積	7.7867785

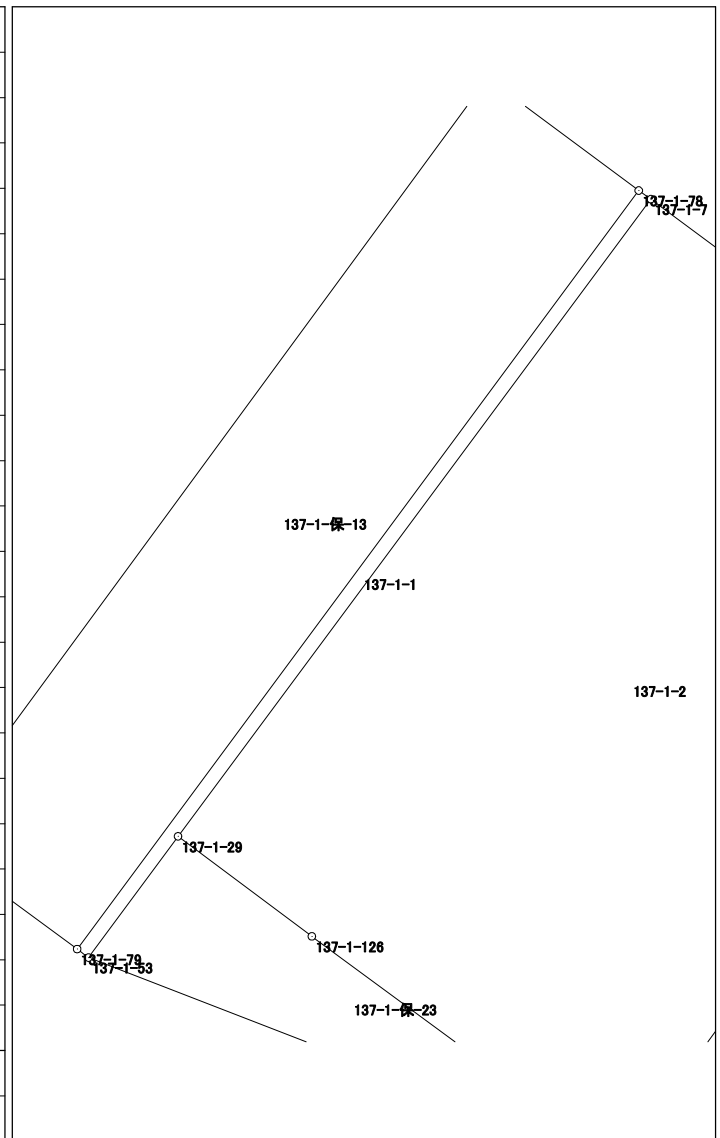


面積計算書 (座標法)

世界測地系 (測地成果2011)

所在	地番	公簿地目	現況地目	地積	所有者
前橋市六供町五丁目	137-1-2			248.94 m ²	


点名	X座標	Y座標	辺長	方向角	測角	DX	倍積 (Y×DX)
137-1-54	40882.979	-67625.752	18.995	36-17-01	89-54-50	9.891	-668886.313032
137-1-117	40898.291	-67614.511	13.045	306-32-48	90-15-47	23.080	-1560542.913880
137-1-7	40906.059	-67624.991	19.007	216-34-56	90-02-08	-7.495	506849.307545
137-1-29	40890.796	-67636.319	4.002	126-46-21	90-11-25	-17.659	1194389.757221
137-1-126	40888.400	-67633.113	9.142	126-22-11	179-35-50	-7.817	528688.044321
						倍面積	497.882175
						面積	248.9410875

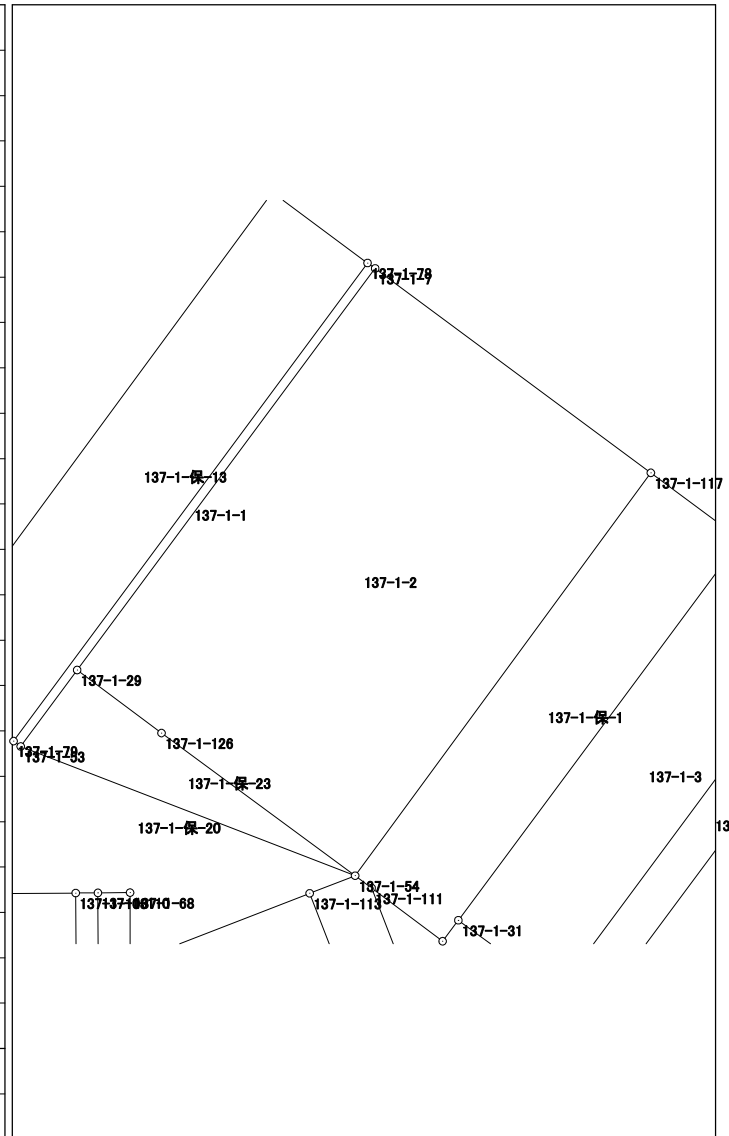

面積計算書（座標法）

所在	地番	公簿地目	現況地目	地積	所有者
前橋市六供町五丁目	137-1-3			83.86 m ²	

点名	X座標	Y座標	辺長	方向角	測角	DX	倍積 (Y×DX)
137-1-121	40878.520	-67618.080	18.006	36-34-38	89-58-34	12.884	-871191.342720
137-1-120	40892.980	-67607.350	4.657	306-34-29	89-59-51	17.235	-1165212.677250
137-1-8	40895.755	-67611.090	18.020	216-34-36	90-00-07	-11.696	790779.308640
137-1-31	40881.284	-67621.828	2.014	126-09-10	89-34-34	-15.659	1058890.204652
137-1-127	40880.096	-67620.202	2.643	126-36-04	180-26-54	-2.764	186902.238328

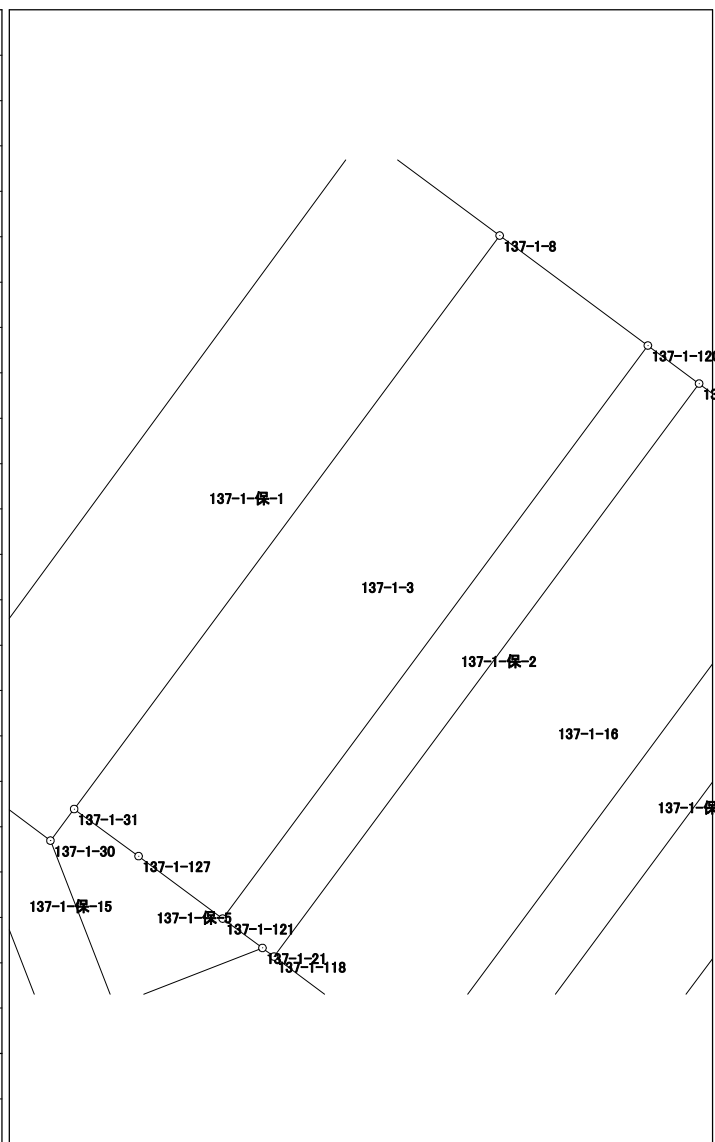


倍面積	167.731650
面積	83.8658250

面積計算書（座標法）

世界測地系（測地成果2011）

所 在	地 番	公簿地目	現況地目	地 積	所 有 者
前橋市六供町五丁目	137-1-4			282.06 m ²	

点 名	X 座標	Y 座標	辺 長	方 向 角	測 角	DX	倍 積 (Y×DX)
137-1-116	40886.710	-67598.901	19.718	216-31-58	89-55-17	-3.891	263027.323791
137-1-115	40870.866	-67610.639	6.163	159-20-42	122-48-44	-21.611	1461133.519429
137-1-11	40865.099	-67608.465	23.598	69-22-04	90-01-22	2.548	-172266.368820
137-1-B24	40873.414	-67586.381	3.812	69-22-25	180-00-21	9.658	-652749.267698
137-1-10	40874.757	-67582.813	20.042	306-36-41	57-14-16	13.296	-898581.081648
						倍面積	564.125054
						面 積	282.0625270

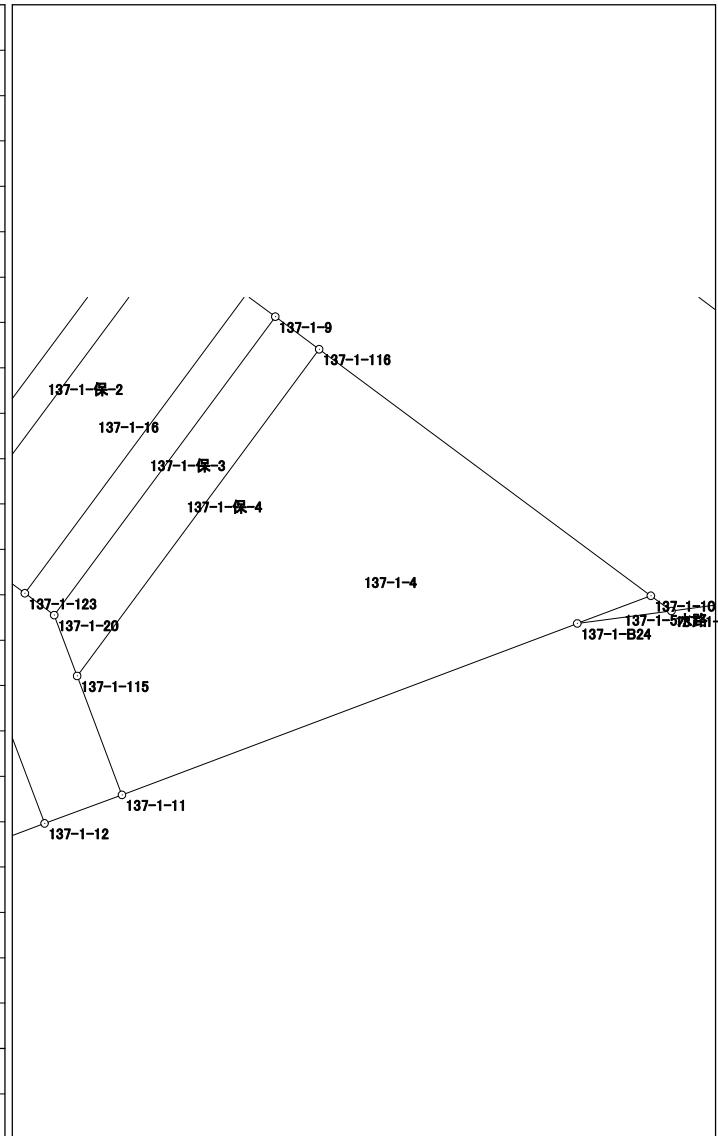


面積計算書（座標法）

世界測地系（測地成果2011）

所在	地番	公簿地目	現況地目	地積	所有者
前橋市六供町五丁目	137-1-5水路			1.99 m ²	

点名	X座標	Y座標	辺長	方向角	測角	DX	倍積 (Y×DX)
137-1-10	40874.757	-67582.813	3.812	249-22-25	122-44-36	-0.601	40617.270613
137-1-B24	40873.414	-67586.381	4.605	82-30-06	13-07-41	-0.742	50149.094702
137-1-124	40874.015	-67581.815	1.244	306-37-49	44-07-43	1.343	-90762.377545
						倍面積	3.987770
						面積	1.9938850

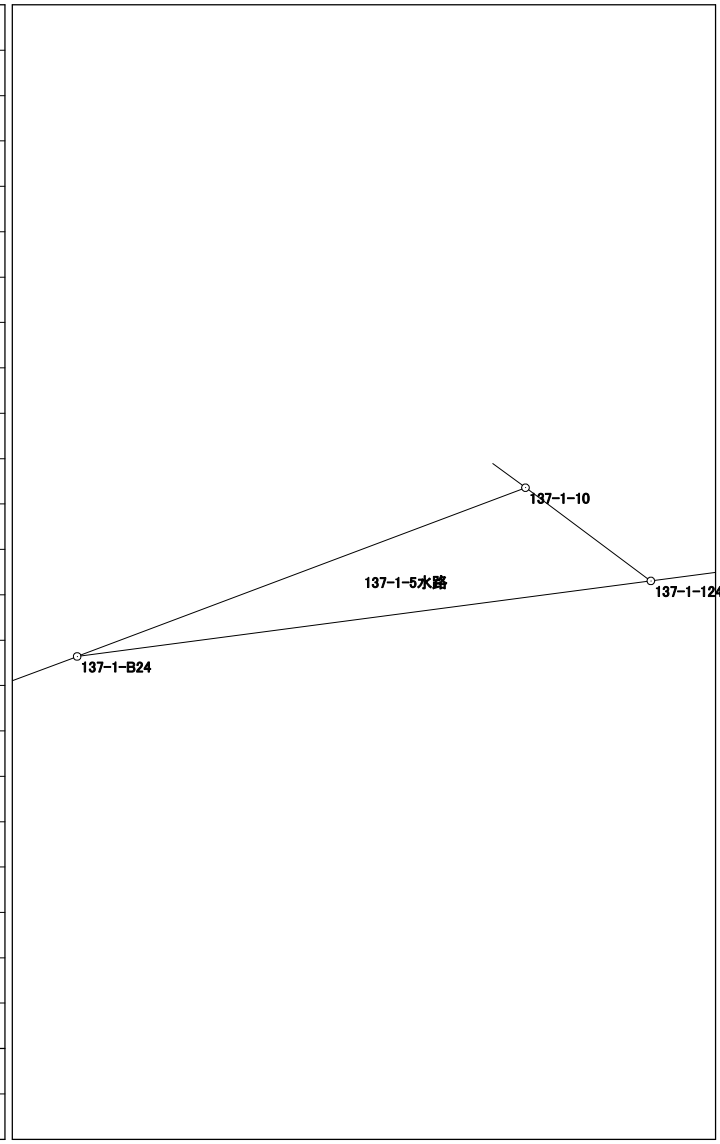


面積計算書（座標法）

世界測地系（測地成果2011）

所在	地番	公簿地目	現況地目	地積	所有者
前橋市六供町五丁目	137-1-8			193.24 m ²	

点名	X座標	Y座標	辺長	方向角	測角	DX	倍積 (Y×DX)
137-1-103	40882.937	-67660.715	14.233	179-45-45	89-59-50	-14.282	966330.331630
137-1-26	40868.704	-67660.656	3.005	134-34-07	134-48-22	-16.342	1105710.440352
137-1-25	40866.595	-67658.515	9.827	89-40-04	135-05-57	-2.052	138835.272780
137-1-44	40866.652	-67648.688	15.598	359-46-47	90-06-43	15.655	-1059040.210640
137-1-69	40882.250	-67648.748	0.736	359-31-59	179-45-12	16.334	-1104974.649832
137-1-104	40882.986	-67648.754	11.961	269-45-55	90-13-56	0.687	-46474.693998

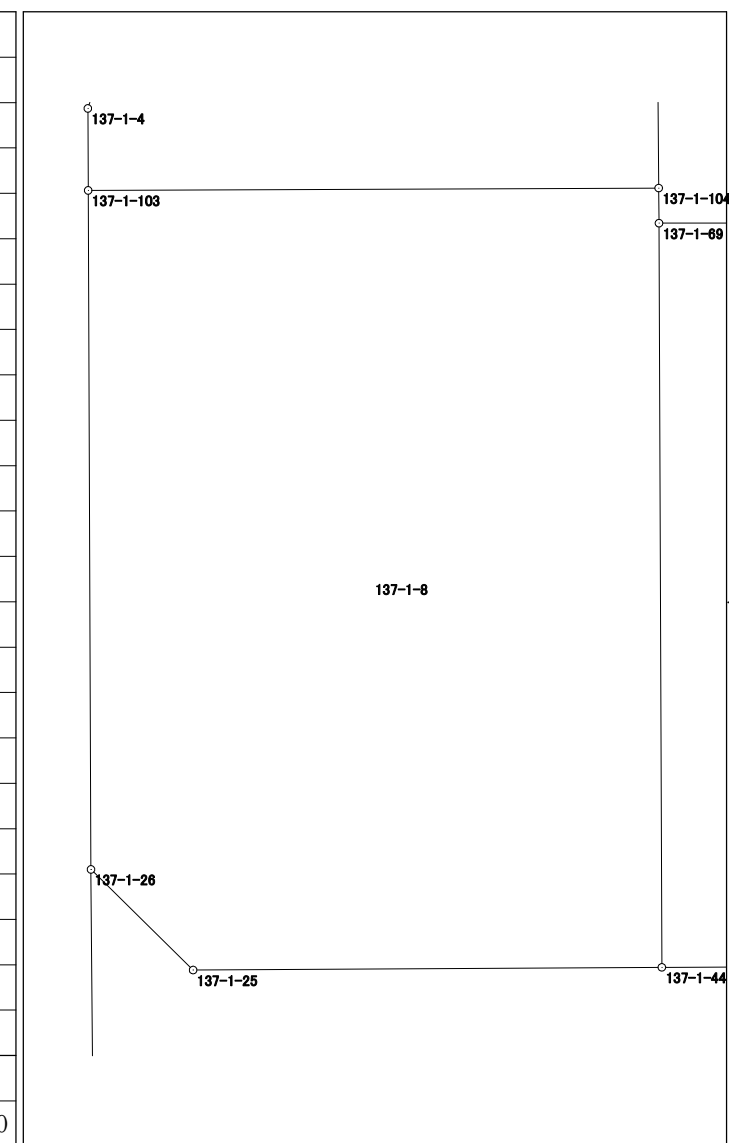


倍面積	386.490292
面積	193.2451460

面積計算書 (座標法)

所在	地番	公簿地目	現況地目	地積	所有者
前橋市六供町五丁目	137-1-10			280.49 m ²	

点名	X座標	Y座標	辺長	方向角	測角	DX	倍積 (Y×DX)
137-1-81	40890.720	-67642.293	22.623	36-17-24	89-42-59	10.814	-731483.756502
137-1-102	40908.955	-67628.903	12.342	306-35-09	90-17-45	25.591	-1730691.256673
137-1-1	40916.311	-67638.813	22.625	216-34-30	89-59-21	-10.814	731446.123782
137-1-52	40898.141	-67652.295	12.454	126-34-25	89-59-55	-25.591	1731289.881345
						倍面積	560.991952
						面積	280.4959760

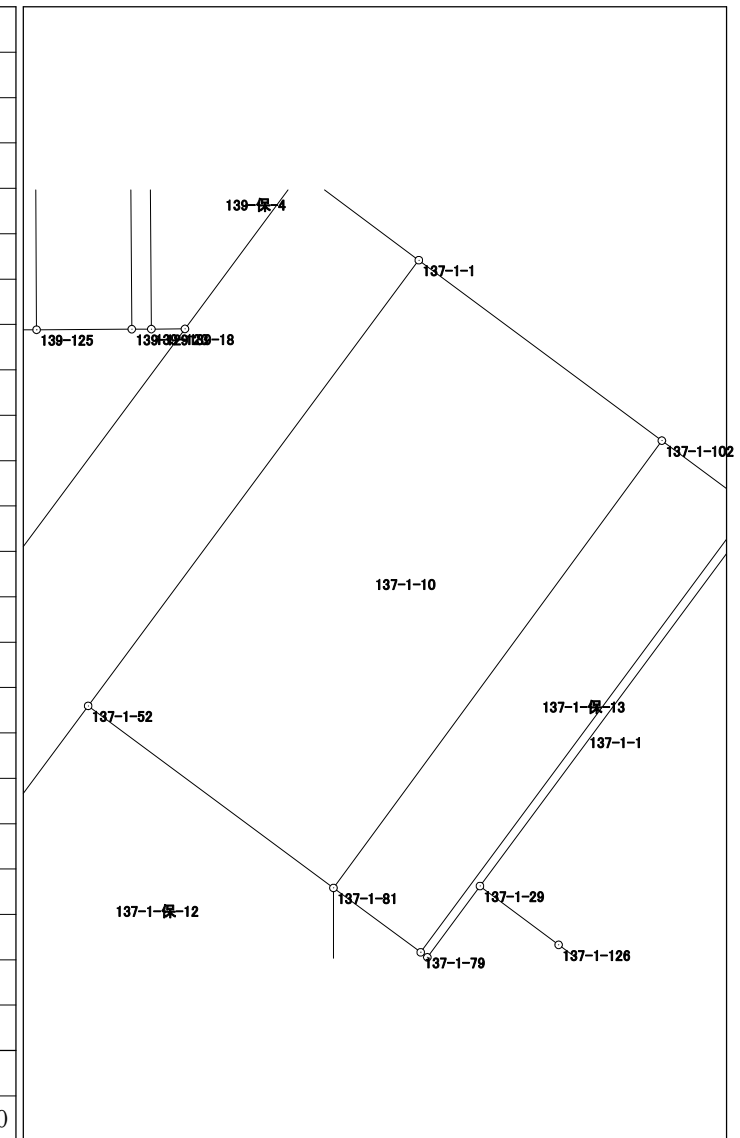


面積計算書 (座標法)

世界測地系 (測地成果2011)

所在	地番	公簿地目	現況地目	地積	所有者
前橋市六供町五丁目	137-1-11			58.54 m ²	

点名	X 座標	Y 座標	辺長	方向角	測角	DX	倍積 (Y×DX)
137-1-113	40882.308	-67627.480	7.321	248-47-14	90-00-58	4.801	-324679.531480
137-1-55	40879.659	-67634.305	7.989	158-50-50	90-03-36	-10.100	683106.480500
137-1-56	40872.208	-67631.422	7.332	68-48-40	89-57-50	-4.801	324698.457022
137-1-114	40874.858	-67624.586	7.992	338-46-16	89-57-36	10.100	-683008.318600

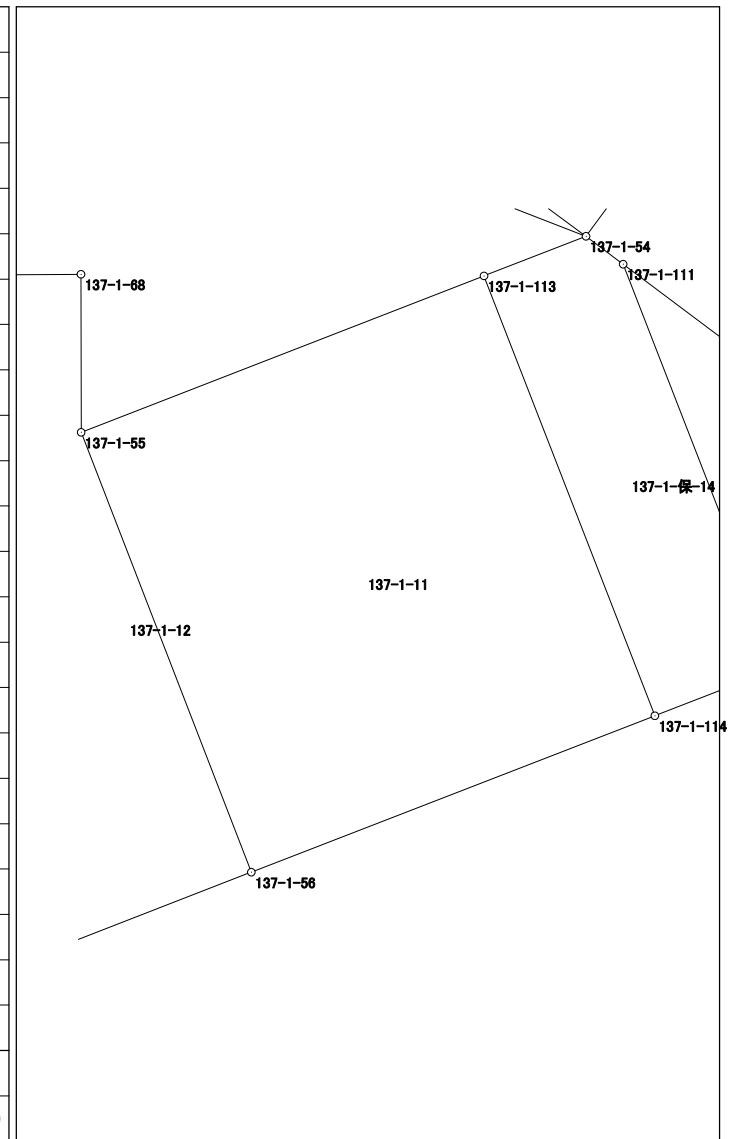


倍面積	117.087442
面積	58.5437210

面積計算書 (座標法)

世界測地系 (測地成果2011)

所 在	地 番	公簿地目	現況地目	地 積	所 有 者
前橋市六供町五丁目	137-1-12			26.14 m ²	

点 名	X 座標	Y 座標	辺 長	方 向 角	測 角	DX	倍 積 (Y×DX)
137-1-110	40882.326	-67635.530	11.694	179-46-46	90-14-54	-11.704	791606.243120
137-1-109	40870.632	-67635.485	4.358	68-47-57	69-01-11	-10.118	684335.837230
137-1-56	40872.208	-67631.422	7.989	338-50-50	90-02-53	9.027	-610508.846394
137-1-55	40879.659	-67634.305	2.677	359-56-09	201-05-19	10.128	-685000.241040
137-1-68	40882.336	-67634.308	1.222	269-31-52	89-35-43	2.667	-180380.699436
						倍面積	52.293480
						面 積	26.1467400

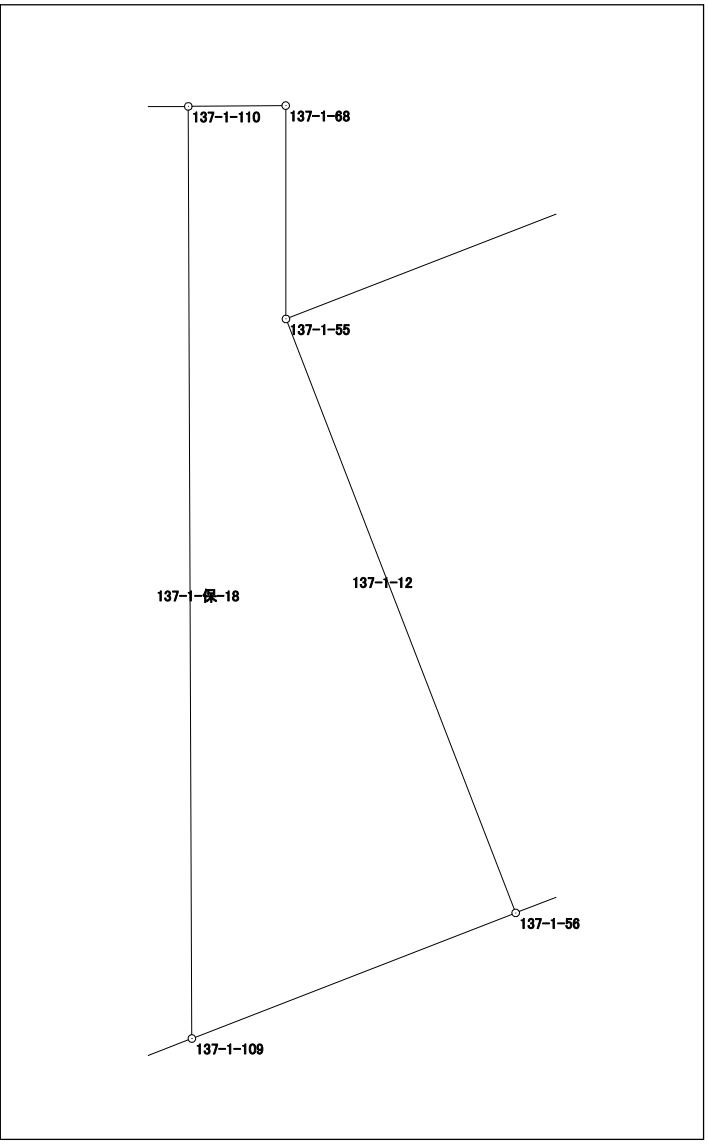


面積計算書 (座標法)

世界測地系 (測地成果2011)

所在	地番	公簿地目	現況地目	地積	所有者
前橋市六供町五丁目	137-1-13			133.08 m ²	

点名	X座標	Y座標	辺長	方向角	測角	DX	倍積 (Y×DX)
137-1-107	40870.305	-67636.328	12.014	359-46-50	110-59-19	15.653	-1058711.442184
137-1-108	40882.319	-67636.374	5.878	269-30-45	89-43-55	11.964	-809201.578536
137-1-80	40882.269	-67642.252	3.739	269-49-53	180-19-08	-0.061	4126.177372
137-1-106	40882.258	-67645.991	15.593	179-46-33	89-56-40	-15.604	1055548.043564
137-1-105	40866.665	-67645.930	0.224	89-44-39	89-58-06	-15.592	1054735.340560
137-1-23	40866.666	-67645.706	10.059	68-47-31	159-02-52	3.640	-246230.369840

倍面積	266.170936
面積	133.0854680

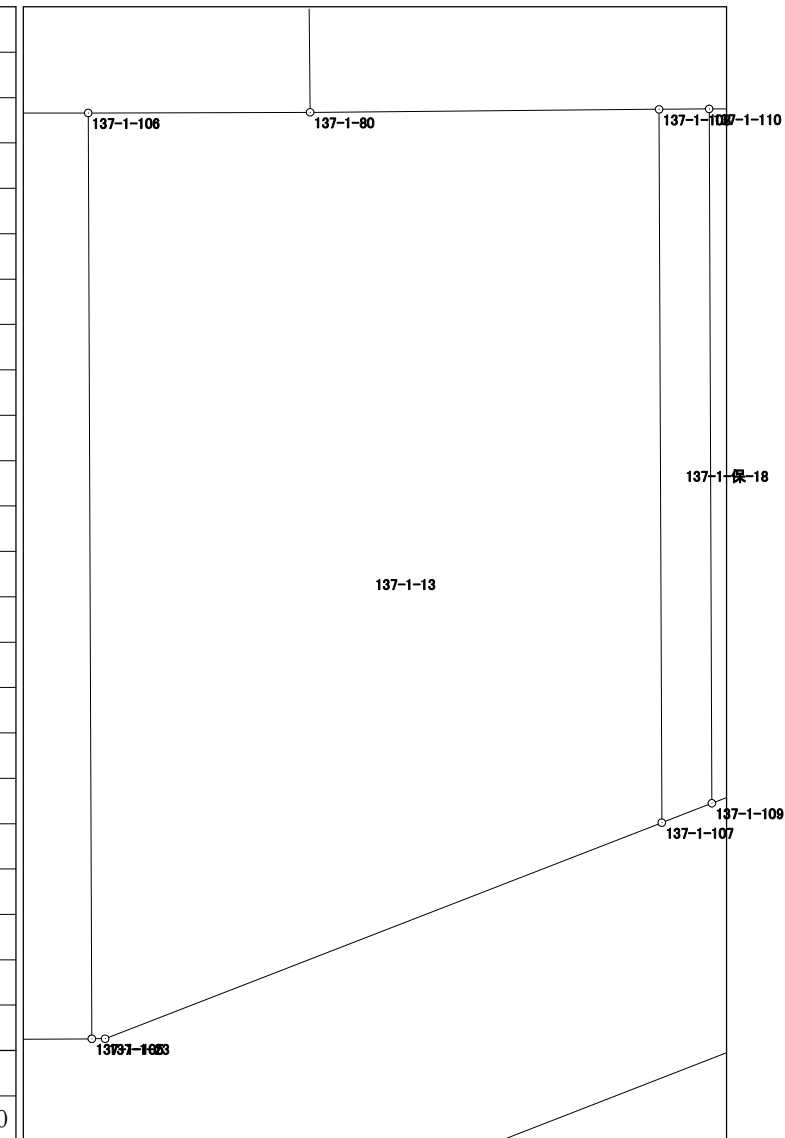


面積計算書 (座標法)

世界測地系 (測地成果2011)

所在	地番	公簿地目	現況地目	地積	所有者
前橋市六供町五丁目	137-1-保-1			80.00 m ²	

点名	X座標	Y座標	辺長	方向角	測角	DX	倍積 (Y×DX)
137-1-54	40882.979	-67625.752	0.786	126-53-04	90-36-03	-15.784	1067404.869568
137-1-111	40882.507	-67625.123	3.369	126-50-34	179-57-30	-2.492	168521.806516
137-1-30	40880.487	-67622.427	0.997	36-55-39	90-05-05	-1.223	82702.228221
137-1-31	40881.284	-67621.828	18.020	36-34-36	179-38-57	15.268	-1032450.069904
137-1-8	40895.755	-67611.090	4.258	306-32-59	89-58-23	17.007	-1149861.807630
137-1-117	40898.291	-67614.511	18.995	216-17-01	89-44-02	-12.776	863842.992536

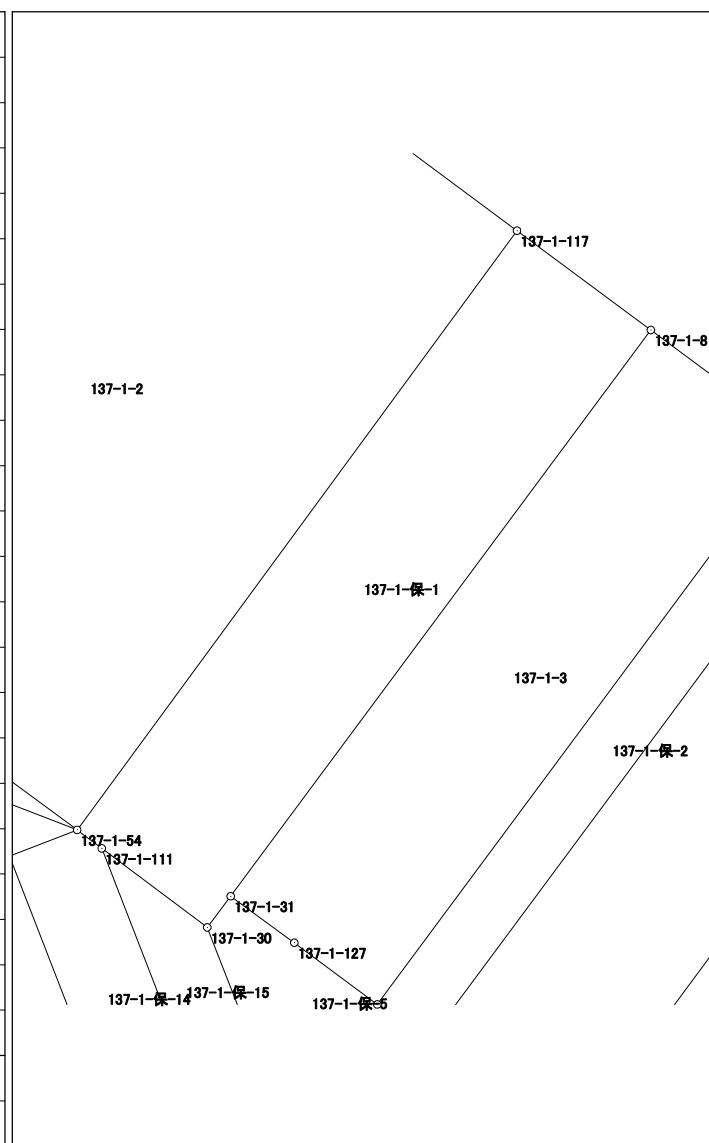


倍面積	160.019307
面積	80.0096535

面積計算書 (座標法)

所在	地番	公簿地目	現況地目	地積	所有者
前橋市六供町五丁目	137-1-保-2			29.00 m ²	

点名	X座標	Y座標	辺長	方向角	測角	Dx	倍積 (Y×DX)
137-1-120	40892.980	-67607.350	18.006	216-34-38	90-00-22	-13.500	912699.225000
137-1-121	40878.520	-67618.080	1.248	126-25-45	89-51-07	-15.201	1027862.434080
137-1-21	40877.779	-67617.076	0.363	126-42-43	180-16-58	-0.958	64777.158808
137-1-118	40877.562	-67616.785	18.004	36-34-42	89-51-59	14.241	-962930.635185
137-1-119	40892.020	-67606.056	1.611	306-34-16	89-59-34	15.418	-1042350.171408

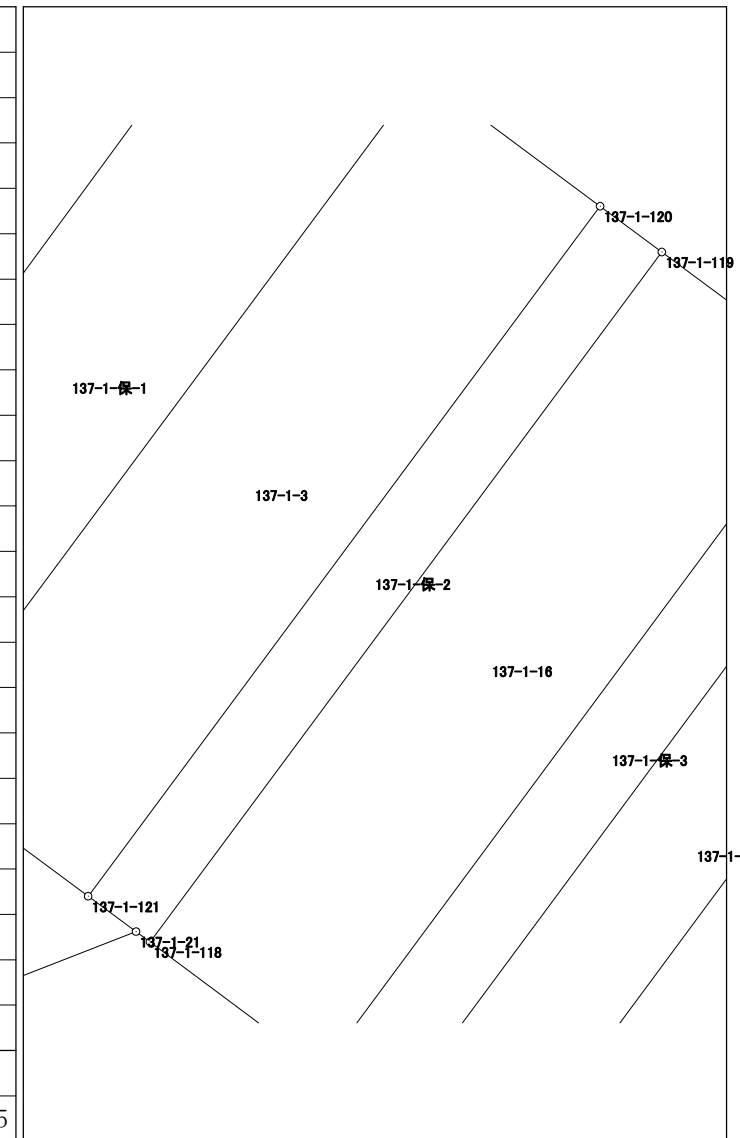


倍面積	58.011295
面積	29.0056475

面積計算書 (座標法)

世界測地系 (測地成果2011)

所在	地番	公簿地目	現況地目	地積	所有者
前橋市六供町五丁目	137-1-保-3			32.00 m ²	

点名	X座標	Y座標	辺長	方向角	測角	DX	倍積 (Y×DX)
137-1-122	40889.349	-67602.455	18.011	216-32-02	89-58-48	-13.414	906819.331370
137-1-123	40874.877	-67613.177	1.777	126-40-12	90-08-10	-15.533	1050235.478341
137-1-20	40873.816	-67611.752	18.015	36-32-00	89-51-48	13.414	-906944.041328
137-1-9	40888.291	-67601.028	1.776	306-33-14	90-01-14	15.533	-1050046.767924
						倍面積	64.000459
						面積	32.0002295

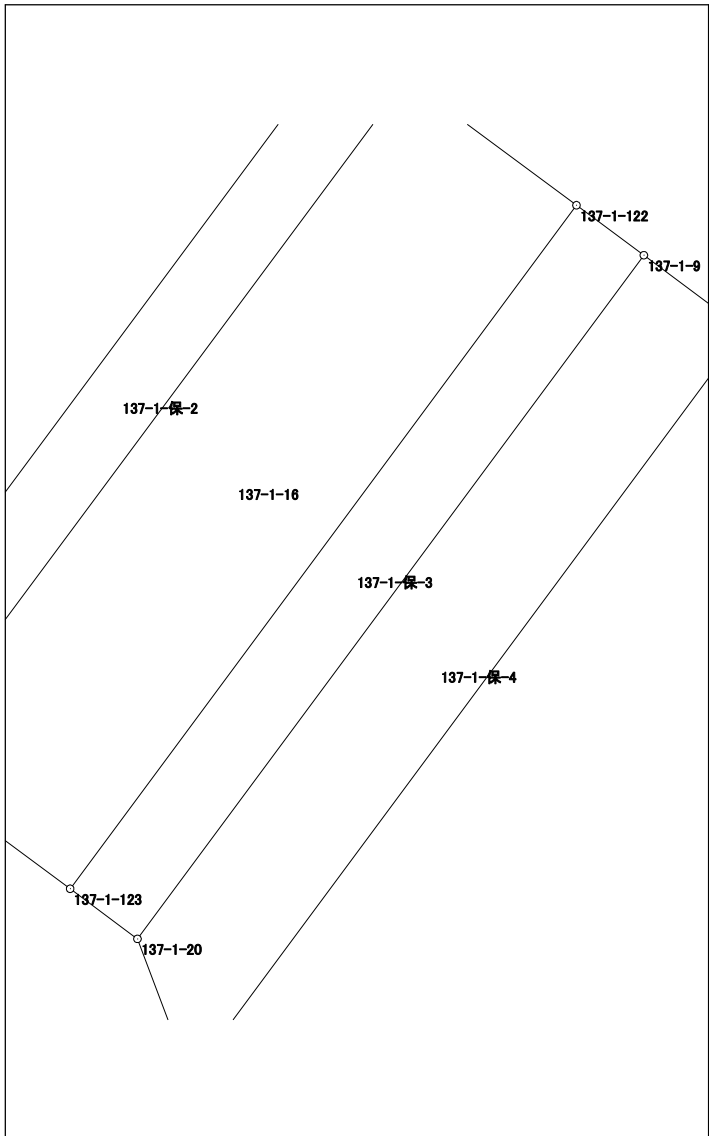


面積計算書（座標法）

世界測地系（測地成果2011）

所在	地番	公簿地目	現況地目	地積	所有者
前橋市六供町五丁目	137-1-保-4			50.00 m ²	

点名	X座標	Y座標	辺長	方向角	測角	DX	倍積 (Y×DX)
137-1-115	40870.866	-67610.639	19.718	36-31-58	57-12-13	12.894	-871771.579266
137-1-116	40886.710	-67598.901	2.650	306-37-24	90-05-26	17.425	-1177910.849925
137-1-9	40888.291	-67601.028	18.015	216-32-00	89-54-36	-12.894	871647.655032
137-1-20	40873.816	-67611.752	3.153	159-19-45	122-47-45	-17.425	1178134.778600

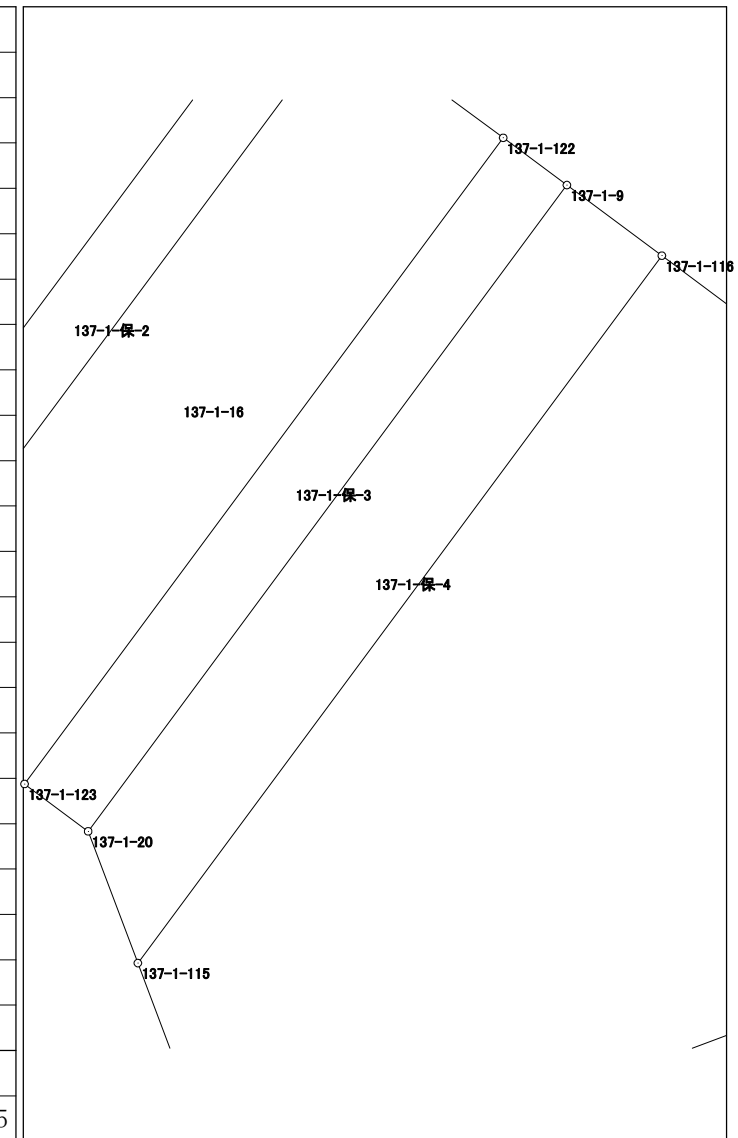


倍面積	100.004441
面積	50.0022205

面積計算書（座標法）

世界測地系（測地成果2011）

所在	地番	公簿地目	現況地目	地積	所有者
前橋市六供町五丁目	137-1-保-5			11.91 m ²	

点名	X座標	Y座標	辺長	方向角	測角	DX	倍積 (Y×DX)
137-1-30	40880.487	-67622.427	4.467	158-45-56	121-50-17	-4.961	335474.860347
137-1-22	40876.323	-67620.809	4.007	68-41-33	89-55-37	-2.708	183117.150772
137-1-21	40877.779	-67617.076	1.248	306-25-45	57-44-12	2.197	-148554.715972
137-1-121	40878.520	-67618.080	2.643	306-36-04	180-10-19	2.317	-156671.091360
137-1-127	40880.096	-67620.202	2.014	306-09-10	179-33-06	2.764	-186902.238328
137-1-31	40881.284	-67621.828	0.997	216-55-39	90-46-29	0.391	-26440.134748

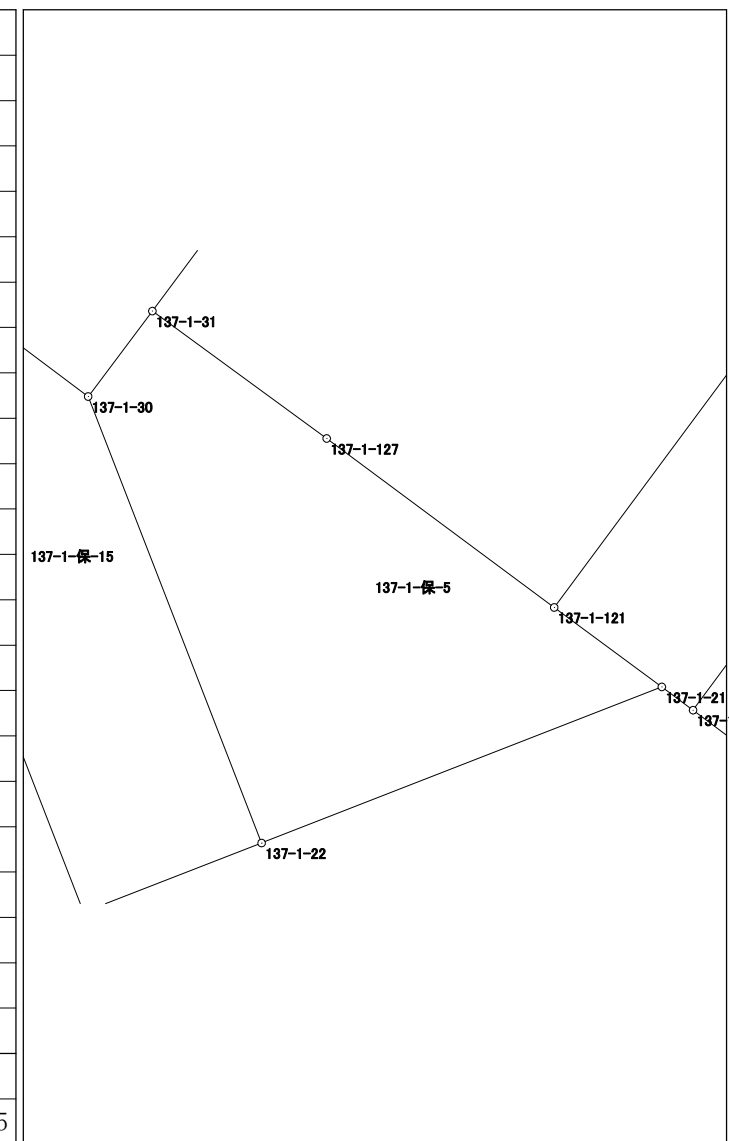


倍面積	23.830711
面積	11.9153555

面積計算書（座標法）

世界測地系（測地成果2011）

所 在	地 番	公簿地目	現況地目	地 積	所 有 者
前橋市六供町五丁目	137-1-保-12			152.00 m ²	

点 名	X 座標	Y 座標	辺 長	方 向 角	測 角	DX	倍 積 (Y×DX)
137-1-43	40886.552	-67660.103	11.337	86-43-05	68-24-39	-1.237	83695.547411
137-1-82	40887.201	-67648.785	4.215	179-34-43	272-51-38	-3.566	241235.567310
137-1-104	40882.986	-67648.754	0.736	179-31-59	179-57-16	-4.951	334928.981054
137-1-69	40882.250	-67648.748	2.757	89-50-01	90-18-02	-0.728	49248.288544
137-1-106	40882.258	-67645.991	3.739	89-49-53	179-59-52	0.019	-1285.273829
137-1-80	40882.269	-67642.252	4.451	359-31-25	89-41-32	4.462	-301819.728424
137-1-125	40886.720	-67642.289	4.000	359-56-34	180-25-09	8.451	-571644.984339
137-1-81	40890.720	-67642.293	12.454	306-34-25	126-37-51	11.421	-772542.628353
137-1-52	40898.141	-67652.295	12.073	216-30-57	89-56-32	-2.282	154382.537190
137-1-5	40888.438	-67659.479	1.987	198-18-26	161-47-29	-11.589	784105.702131
						倍面積	304.008695
						面 積	152.0043475

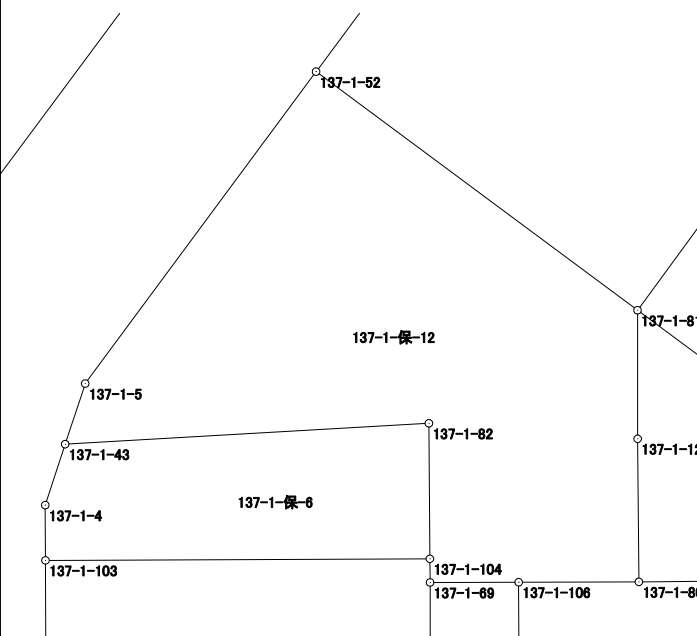


面積計算書 (座標法)

世界測地系 (測地成果2011)

所在	地番	公簿地目	現況地目	地積	所有者
前橋市六供町五丁目	137-1-保-14			18.00 m ²	

点名	X座標	Y座標	辺長	方向角	測角	DX	倍積 (Y×DX)			
137-1-112	40875.679	-67622.469	7.326	338-45-33	89-57-22	7.649	-517244.265381			
137-1-111	40882.507	-67625.123	0.786	306-53-04	148-07-31	7.300	-493663.397900			
137-1-54	40882.979	-67625.752	1.854	248-46-42	121-53-38	-0.199	13457.524648			
137-1-113	40882.308	-67627.480	7.992	158-46-16	89-59-34	-8.121	549202.765080			
137-1-114	40874.858	-67624.586	2.271	68-48-11	90-01-55	-6.629	448283.380594			
							倍面積	36.007041		
							面積	18.0035205		

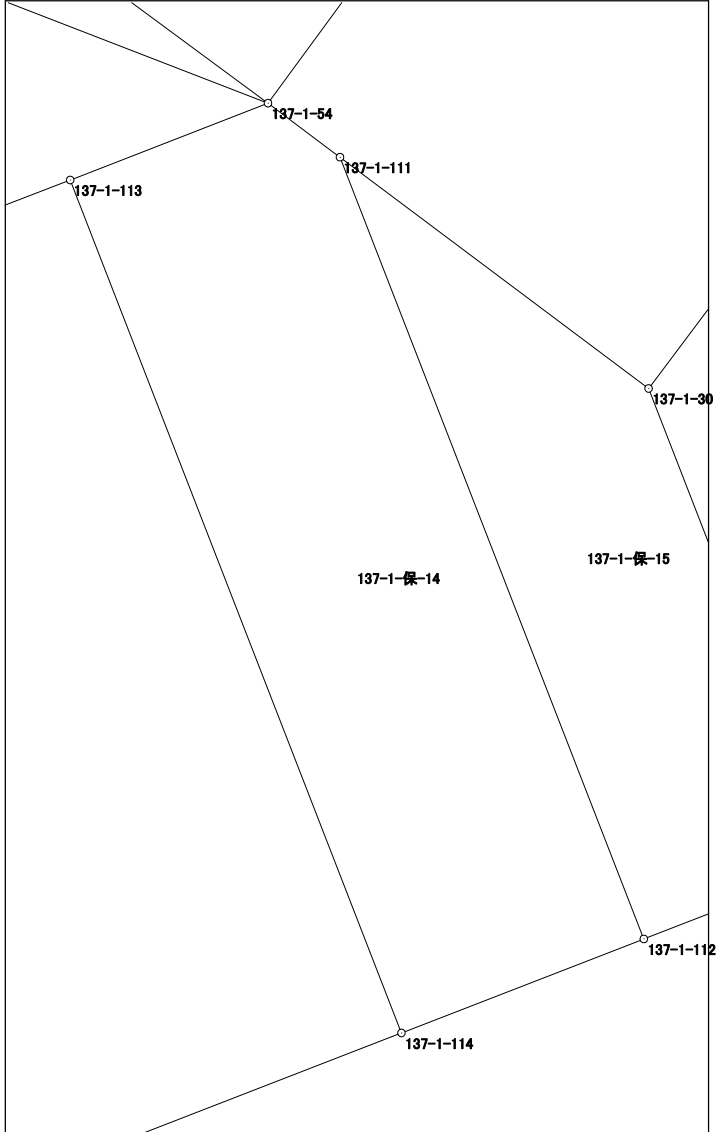


面積計算書（座標法）

世界測地系（測地成果2011）

所在	地番	公簿地目	現況地目	地積	所有者
前橋市六供町五丁目	137-1-保-15			10.50 m ²	

点名	X座標	Y座標	辺長	方向角	測角	DX	倍積 (Y×DX)
137-1-111	40882.507	-67625.123	7.326	158-45-33	31-54-59	-4.808	325141.591384
137-1-112	40875.679	-67622.469	1.781	68-47-46	90-02-13	-6.184	418177.348296
137-1-22	40876.323	-67620.809	4.467	338-45-56	89-58-10	4.808	-325120.849672
137-1-30	40880.487	-67622.427	3.369	306-50-34	148-04-38	6.184	-418177.088568

倍面積	21.001440
面積	10.5007200

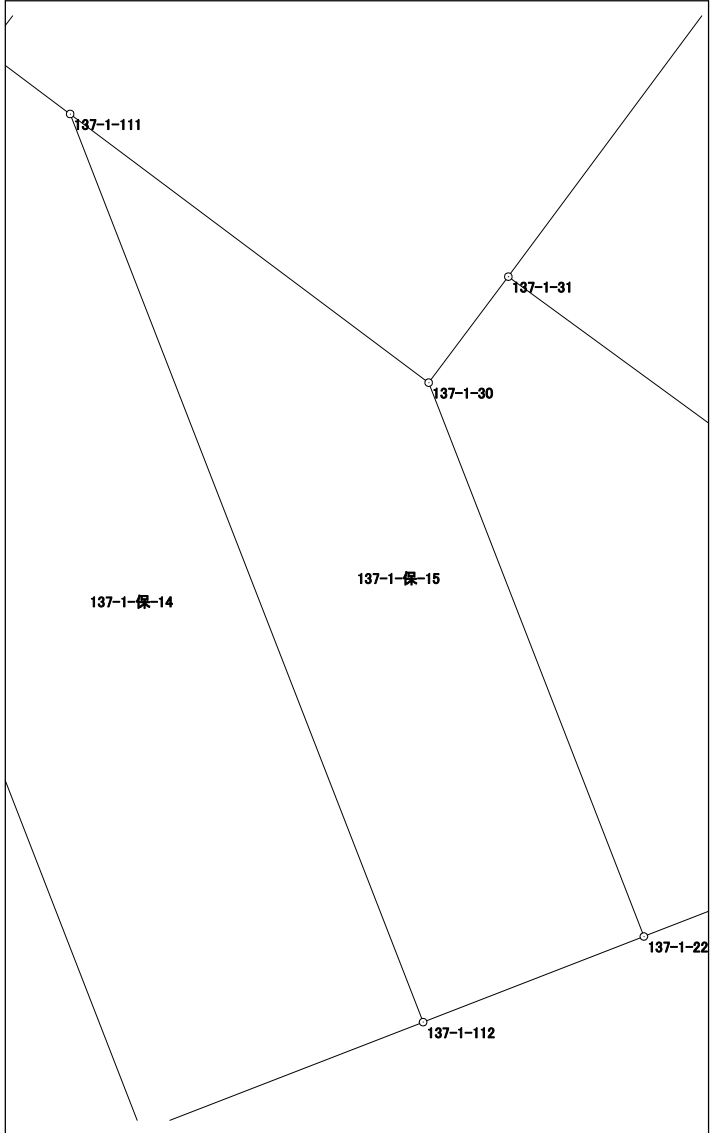


面積計算書（座標法）

世界測地系（測地成果2011）

所 在	地 番	公簿地目	現況地目	地 積	所 有 者
前橋市六供町五丁目	137-1-保-18			10.00 m ²	

点 名	X 座標	Y 座標	辺 長	方 向 角	測 角	DX	倍 積 (Y×DX)
137-1-109	40870.632	-67635.485	11.694	359-46-46	110-58-51	12.021	-813046.165185
137-1-110	40882.326	-67635.530	0.844	269-31-29	89-44-43	11.687	-790456.439110
137-1-108	40882.319	-67636.374	12.014	179-46-50	90-15-21	-12.021	813056.851854
137-1-107	40870.305	-67636.328	0.904	68-47-55	69-01-05	-11.687	790465.765336
						倍面積	20.012895
						面 積	10.0064475

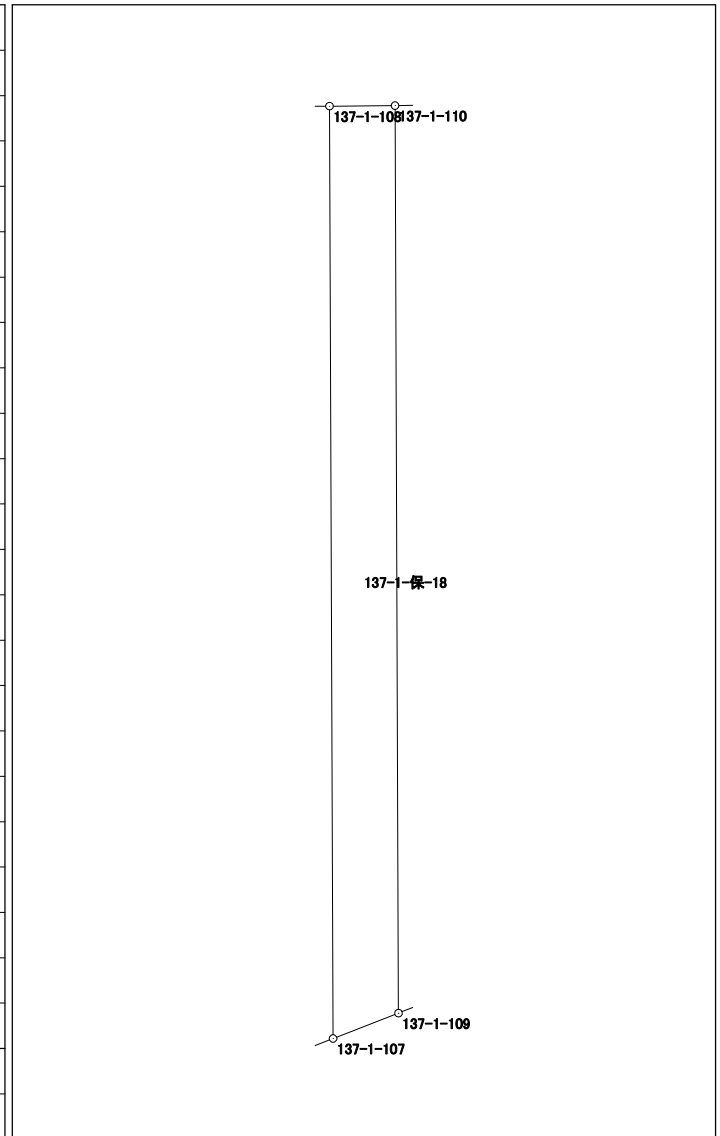


面積計算書 (座標法)

世界測地系 (測地成果2011)

所在	地番	公簿地目	現況地目	地積	所有者
前橋市六供町五丁目	137-1-保-19			43.00 m ²	

点名	X座標	Y座標	辺長	方向角	測角	DX	倍積 (Y×DX)
137-1-105	40866.665	-67645.930	15.593	359-46-33	90-02-45	15.606	-1055682.383580
137-1-106	40882.258	-67645.991	2.757	269-50-01	90-03-28	15.585	-1054262.769735
137-1-69	40882.250	-67648.748	15.598	179-46-47	89-56-46	-15.606	1055726.361288
137-1-44	40866.652	-67648.688	2.758	89-43-48	89-57-01	-15.585	1054304.802480
						倍面積	86.010453
						面積	43.0052265

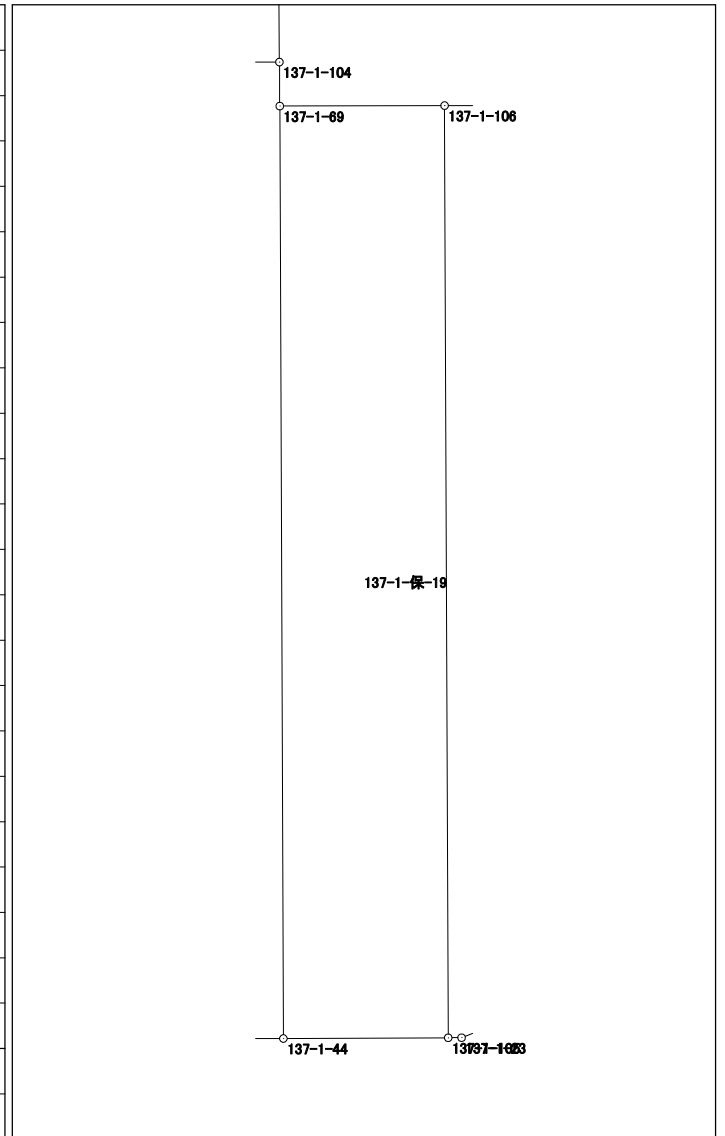


面積計算書（座標法）

世界測地系（測地成果2011）

所在	地番	公簿地目	現況地目	地積	所有者
前橋市六供町五丁目	137-1-保-20			74.94 m ²	

点名	X座標	Y座標	辺長	方向角	測角	D _X	倍積 (Y×D _X)
137-1-110	40882.326	-67635.530	1.222	89-31-52	180-00-23	0.017	-1149.804010
137-1-68	40882.336	-67634.308	2.677	179-56-09	270-24-17	-2.667	180380.699436
137-1-55	40879.659	-67634.305	7.321	68-47-14	68-51-05	-0.028	1893.760540
137-1-113	40882.308	-67627.480	1.854	68-46-42	179-59-28	3.320	-224523.233600
137-1-54	40882.979	-67625.752	13.629	291-07-31	42-20-49	5.583	-377554.573416
137-1-53	40887.891	-67638.465	0.339	306-58-16	195-50-45	5.116	-346038.386940
137-1-79	40888.095	-67638.736	4.421	306-25-36	179-27-20	2.829	-191349.984144
137-1-81	40890.720	-67642.293	4.000	179-56-34	53-30-58	-1.375	93008.152875
137-1-125	40886.720	-67642.289	4.451	179-31-25	179-34-51	-8.451	571644.984339
137-1-80	40882.269	-67642.252	5.878	89-30-45	89-59-20	-4.401	297693.551052
137-1-108	40882.319	-67636.374	0.844	89-31-29	180-00-44	0.057	-3855.273318

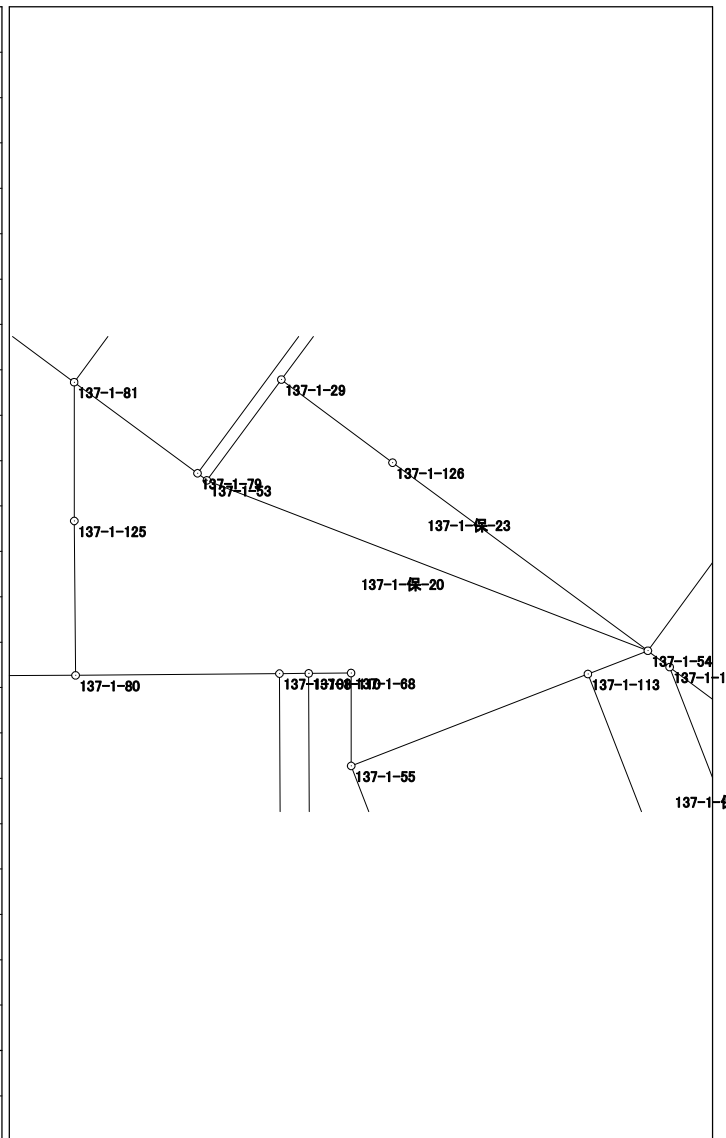

倍面積	149.892814
面積	74.9464070

