



# 140街区 画地出来形確認図 (6971.98m<sup>2</sup>)

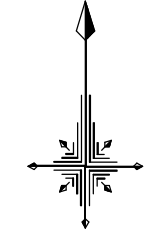

1/500

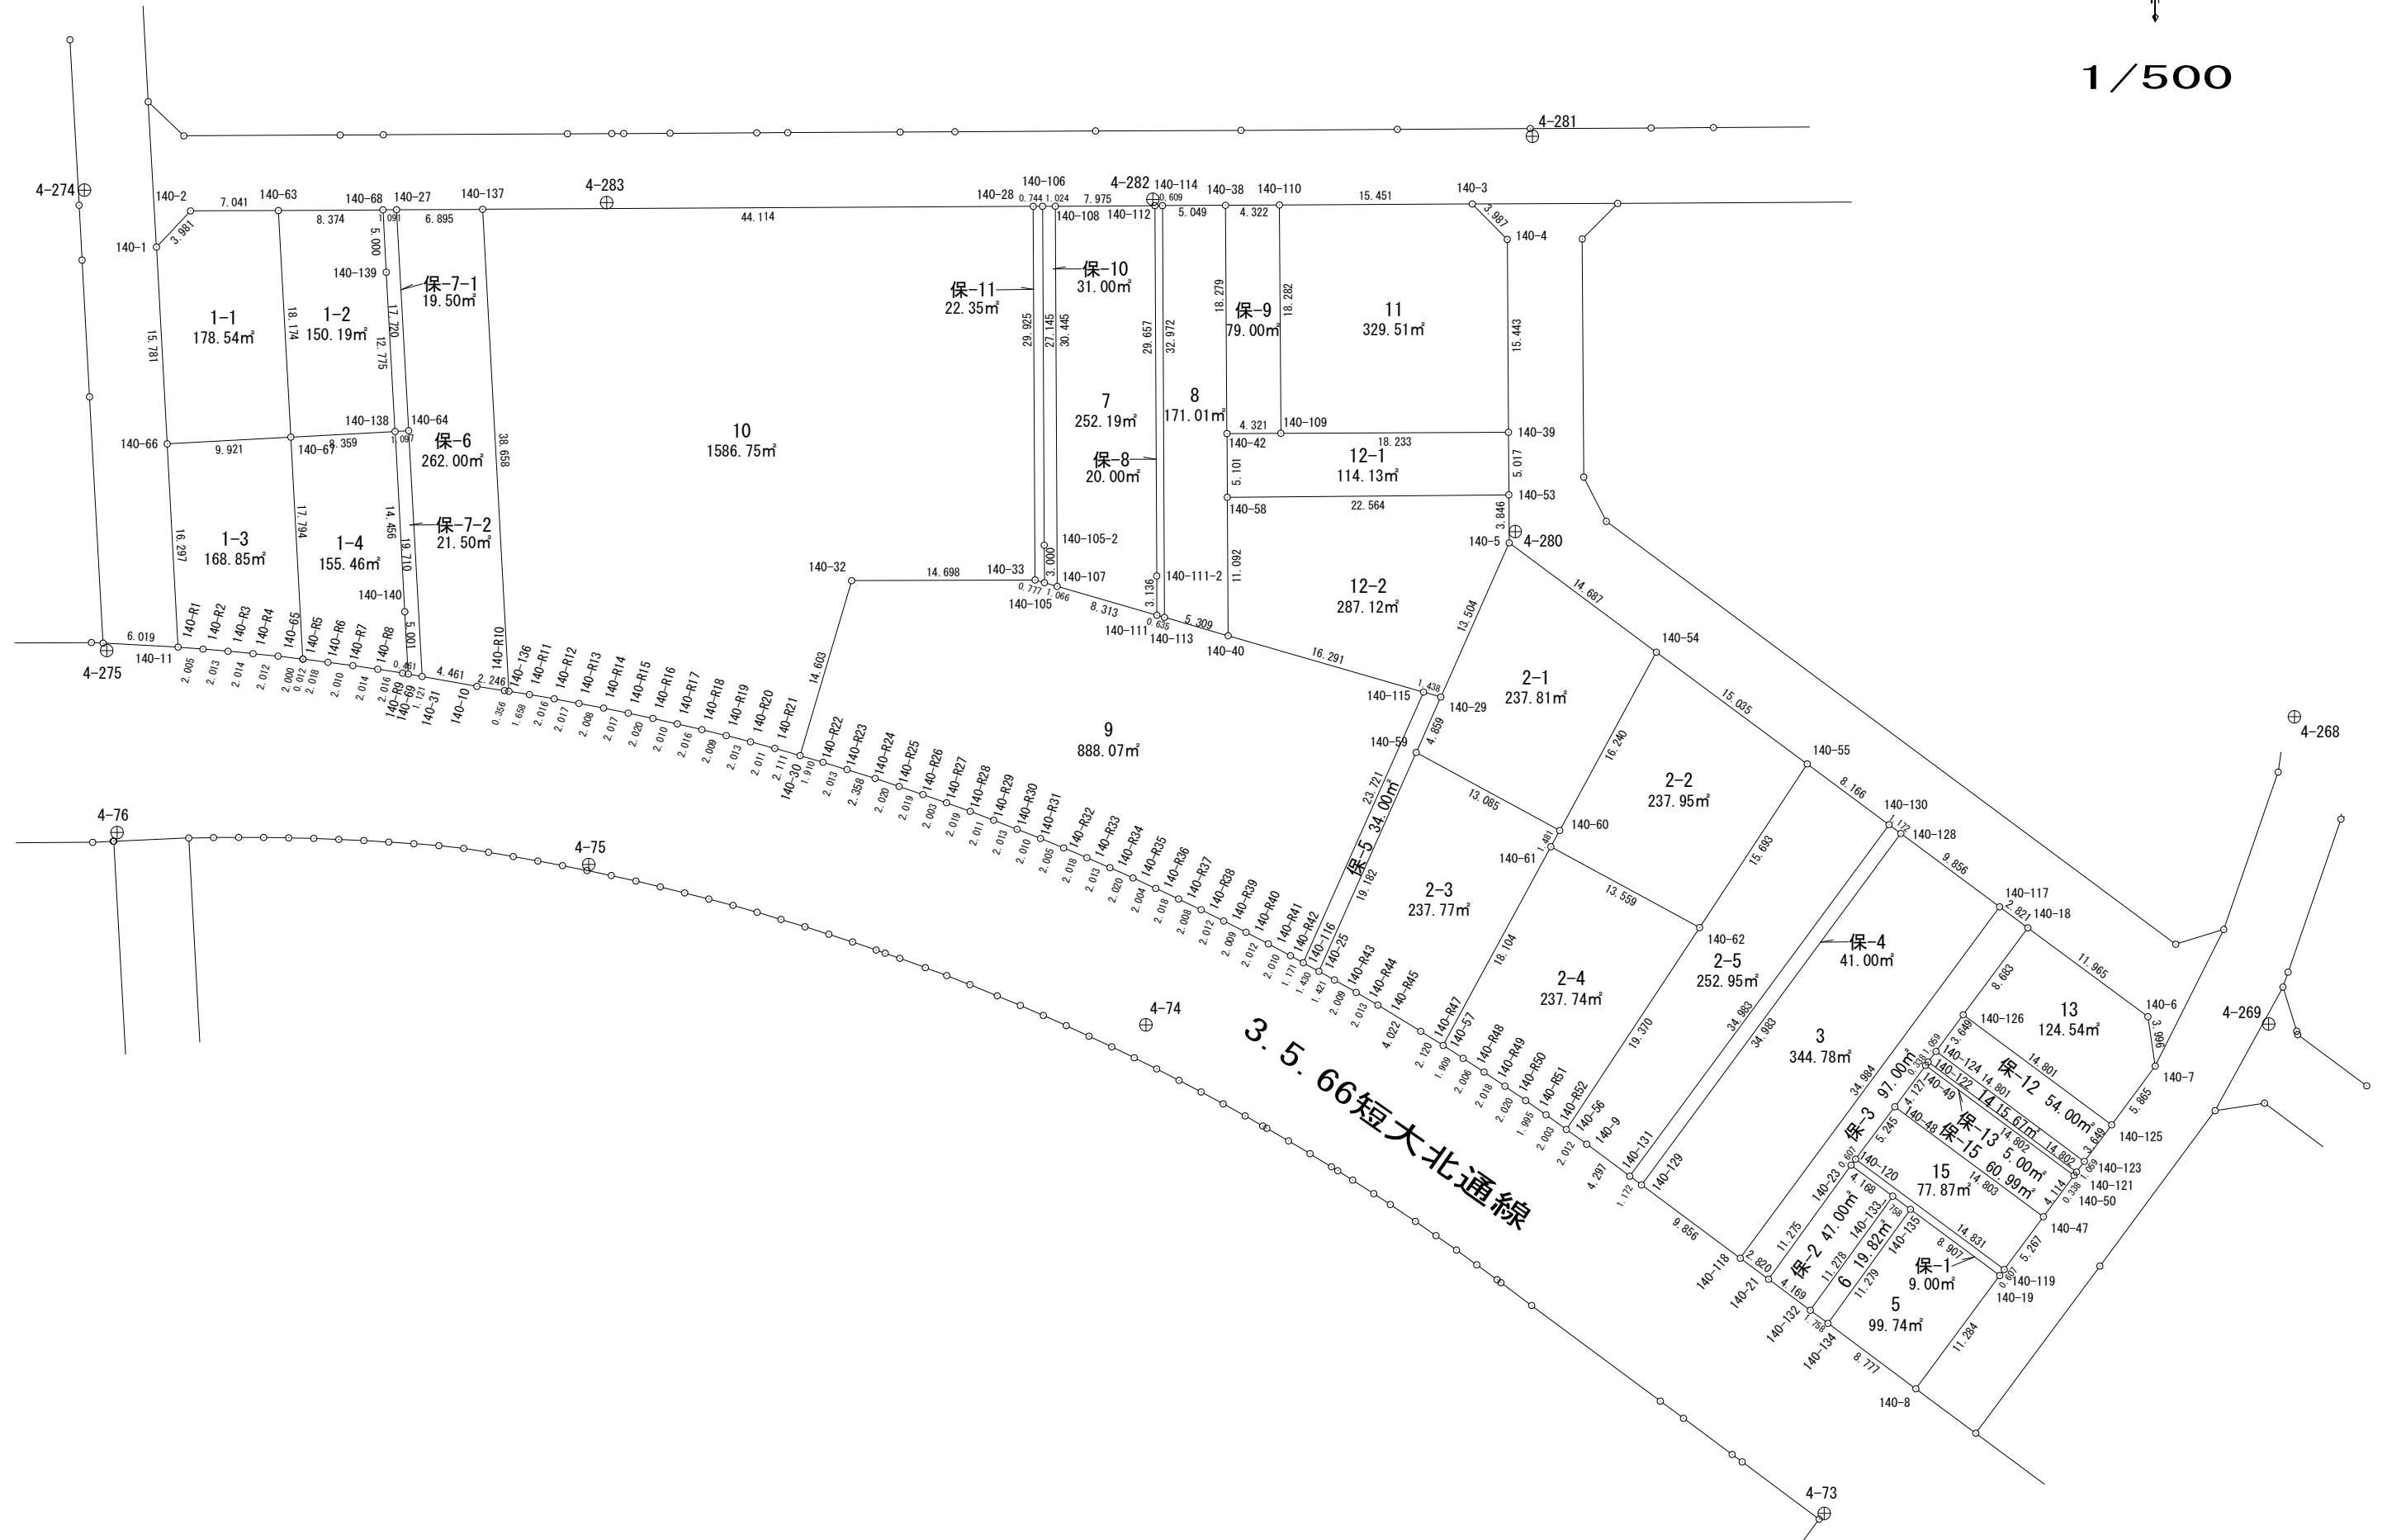


# 面積計算書 (座標法)

世界測地系 (測地成果2011)

所在	地番	公簿地目	現況地目	地積	所有者
前橋市六供町五丁目	140-1-1			178.54 m <sup>2</sup>	

点名	X座標	Y座標	辺長	方向角	測角	DX	倍積 (Y×DX)
140-1	41021.749	-67776.819	15.781	176-52-34	133-37-00	-18.657	1264512.112083
140-66	41005.991	-67775.959	9.921	86-53-49	90-01-15	-15.221	1031617.871939
140-67	41006.528	-67766.053	18.174	356-51-19	89-57-30	18.684	-1266140.934252
140-63	41024.675	-67767.050	7.041	269-46-49	92-55-30	18.120	-1227938.946000
140-2	41024.648	-67774.091	3.981	223-15-34	133-28-45	-2.926	198306.990266
						倍面積	357.094036
						面積	178.5470180

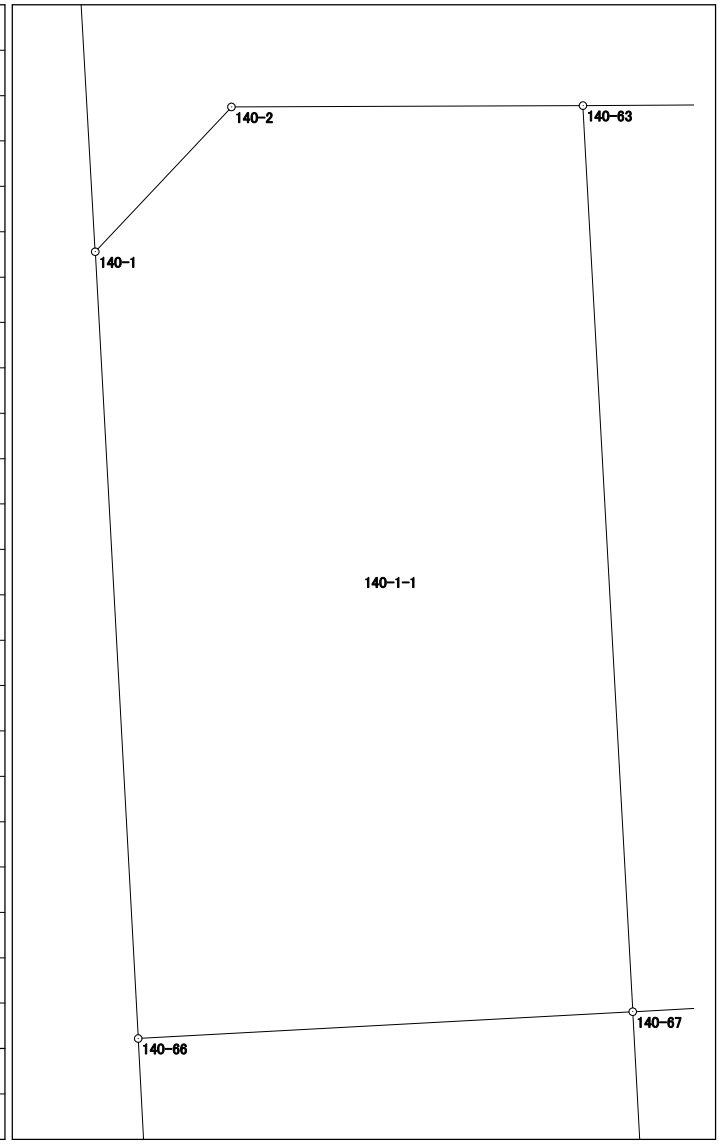




# 面積計算書 (座標法)

世界測地系 (測地成果2011)

所在	地番	公簿地目	現況地目	地積	所有者
前橋市六供町五丁目	140-1-3			168.85 m <sup>2</sup>	

点名	X座標	Y座標	辺長	方向角	測角	DX	倍積 (Y×DX)
140-66	41005.991	-67775.959	16.297	176-56-24	90-02-35	-16.811	1139381.646749
140-11	40989.717	-67775.089	2.005	94-39-50	97-43-26	-16.437	1114019.137893
140-R1	40989.554	-67773.091	2.013	94-48-56	180-09-06	-0.332	22500.666212
140-R2	40989.385	-67771.085	2.014	95-26-30	180-37-34	-0.360	24397.590600
140-R3	40989.194	-67769.080	2.012	95-45-42	180-19-12	-0.393	26633.248440
140-R4	40988.992	-67767.078	2.000	96-39-35	180-53-53	-0.434	29410.911852
140-65	40988.760	-67765.091	17.794	356-54-03	80-14-28	17.536	-1188328.635776
140-67	41006.528	-67766.053	9.921	266-53-49	89-59-46	17.231	-1167676.859243

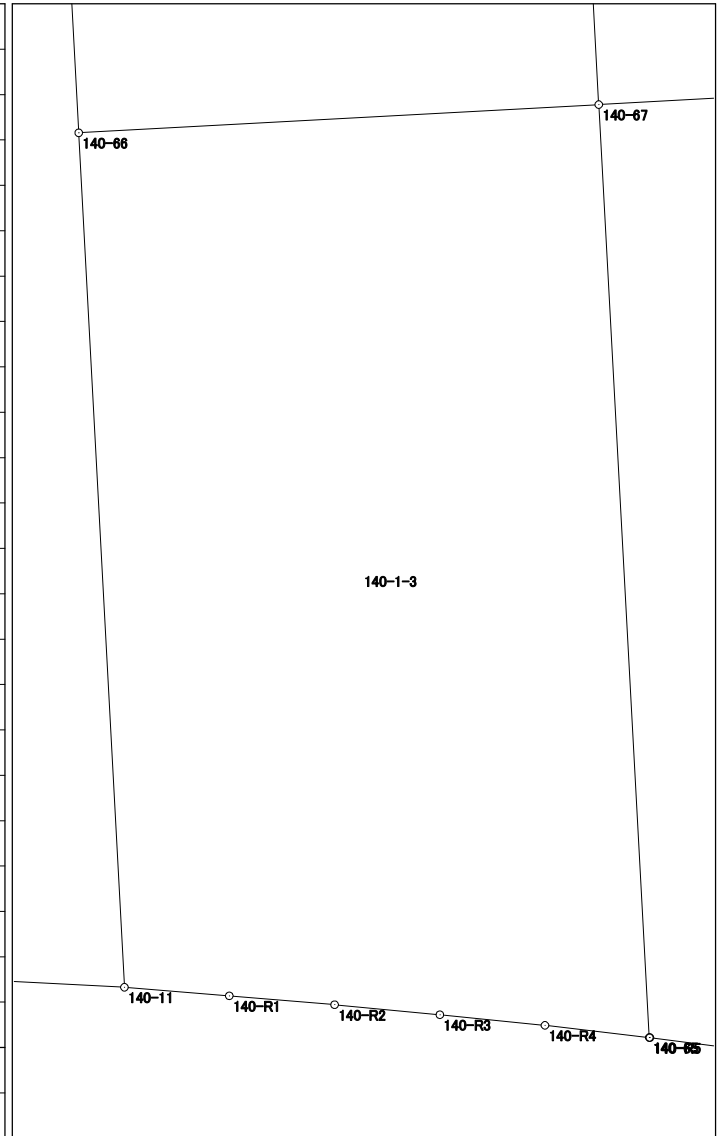


# 面積計算書（座標法）

世界測地系（測地成果2011）

所在	地番	公簿地目	現況地目	地積	所有者
前橋市六供町五丁目	140-1-4			155.46 m <sup>2</sup>	

点名	X座標	Y座標	辺長	方向角	測角	DX	倍積 (Y×DX)
140-69	40987.557	-67756.646	5.001	356-47-25	77-40-32	4.920	-333362.698320
140-140	40992.550	-67756.926	14.456	356-54-11	180-06-46	19.428	-1316381.558328
140-138	41006.985	-67757.707	8.359	266-51-57	89-57-46	13.978	-947117.228446
140-67	41006.528	-67766.053	17.794	176-54-03	90-02-06	-18.225	1235036.315925
140-65	40988.760	-67765.091	0.012	99-27-44	102-33-41	-17.770	1204185.667070
140-R5	40988.758	-67765.079	2.018	97-20-49	177-53-05	-0.260	17618.920540
140-R6	40988.500	-67763.078	2.010	97-38-03	180-17-14	-0.525	35575.615950
140-R7	40988.233	-67761.086	2.014	98-18-26	180-40-23	-0.558	37810.685988
140-R8	40987.942	-67759.093	2.016	98-54-06	180-35-40	-0.603	40858.733079
140-R9	40987.630	-67757.101	0.461	99-06-53	180-12-47	-0.385	26086.483885

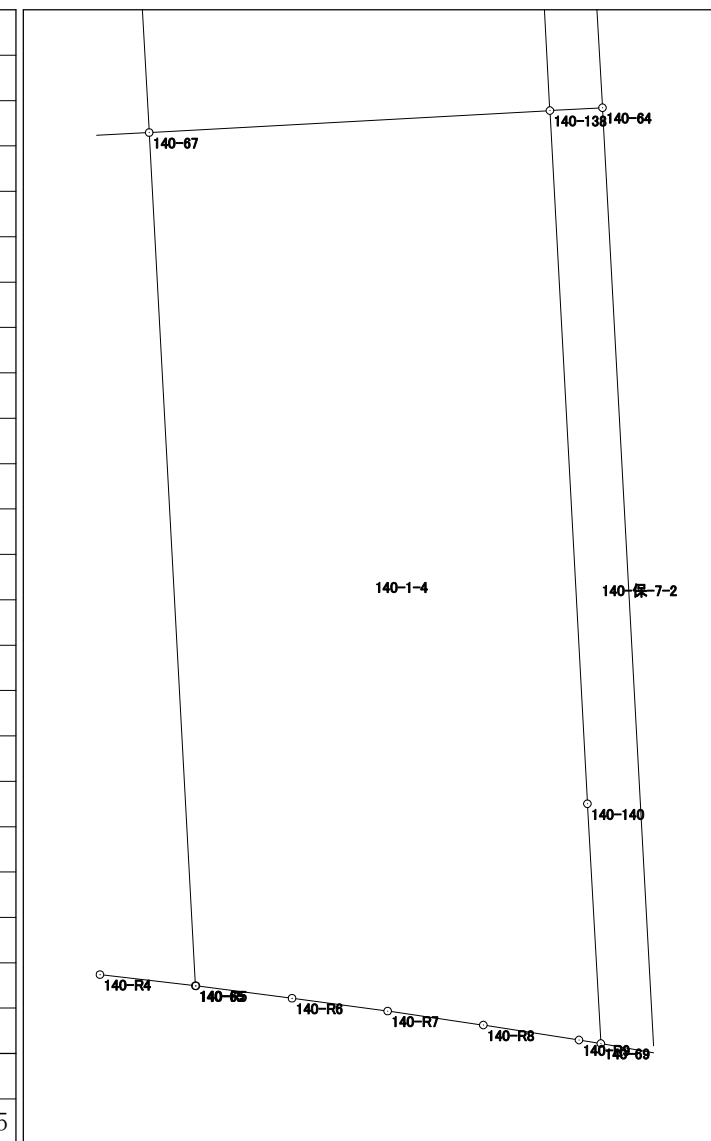


倍面積	310.937343
面積	155.4686715

## 面積計算書 (座標法)

世界測地系 (測地成果2011)

所 在	地 番	公簿地目	現況地目	地 積	所 有 者
前橋市六供町五丁目	140-2-1			237.81 m <sup>2</sup>	

点 名	X 座標	Y 座標	辺 長	方 向 角	測 角	DX	倍 積 (Y×DX)
140-5	40998.062	-67668.446	13.504	203-56-10	77-20-27	-3.587	242726.715802
140-29	40985.719	-67673.925	4.859	203-58-11	180-02-01	-16.783	1135771.483275
140-59	40981.279	-67675.899	13.085	118-30-43	94-32-32	-10.686	723184.656714
140-60	40975.033	-67664.401	16.240	28-29-31	89-58-48	8.027	-543142.146827
140-54	40989.306	-67656.654	14.687	306-35-43	98-06-12	23.029	-1558065.084966

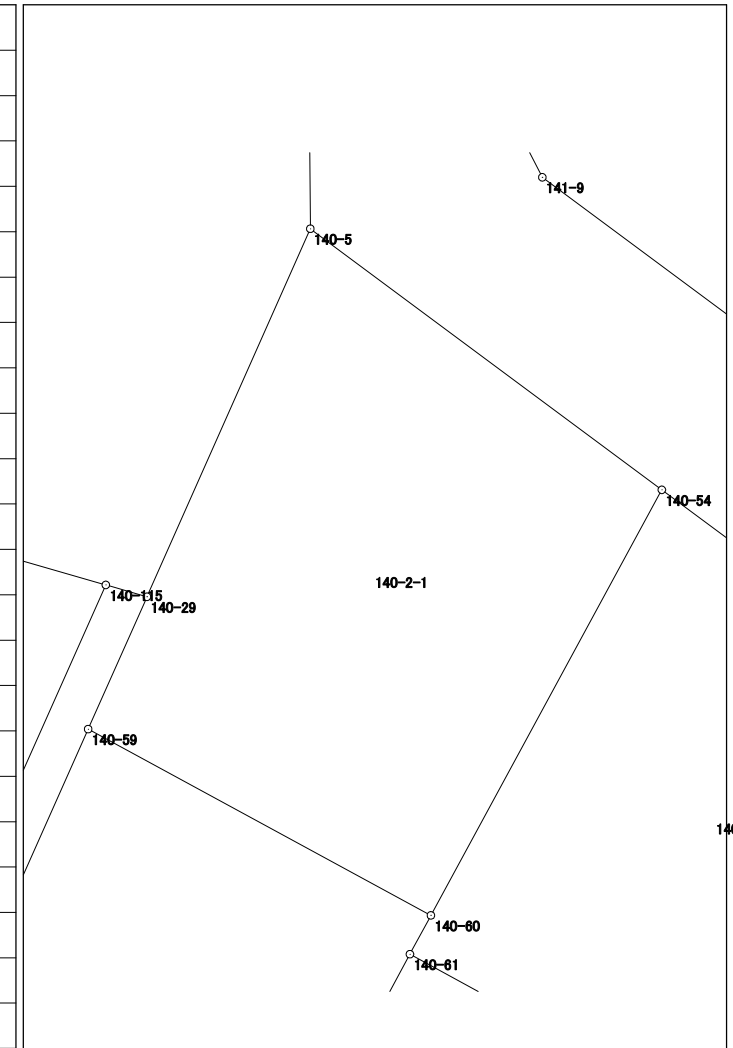


倍面積	475.623998
面 積	237.8119990

# 面積計算書（座標法）

世界測地系（測地成果2011）

所 在	地 番	公簿地目	現況地目	地 積	所 有 者
前橋市六供町五丁目	140-2-2			237.95 m <sup>2</sup>	

点 名	X 座標	Y 座標	辺 長	方 向 角	測 角	DX	倍 積 (Y×DX)
140-54	40989.306	-67656.654	16.240	208-29-31	81-59-03	-5.328	360474.652512
140-60	40975.033	-67664.401	1.481	208-22-55	179-53-24	-15.576	1053940.709976
140-61	40973.730	-67665.105	13.559	118-32-38	90-09-43	-7.782	526569.847110
140-62	40967.251	-67653.194	15.693	33-20-27	94-47-49	6.631	-448608.329414
140-55	40980.361	-67644.569	15.035	306-30-28	93-10-01	22.055	-1491900.969295

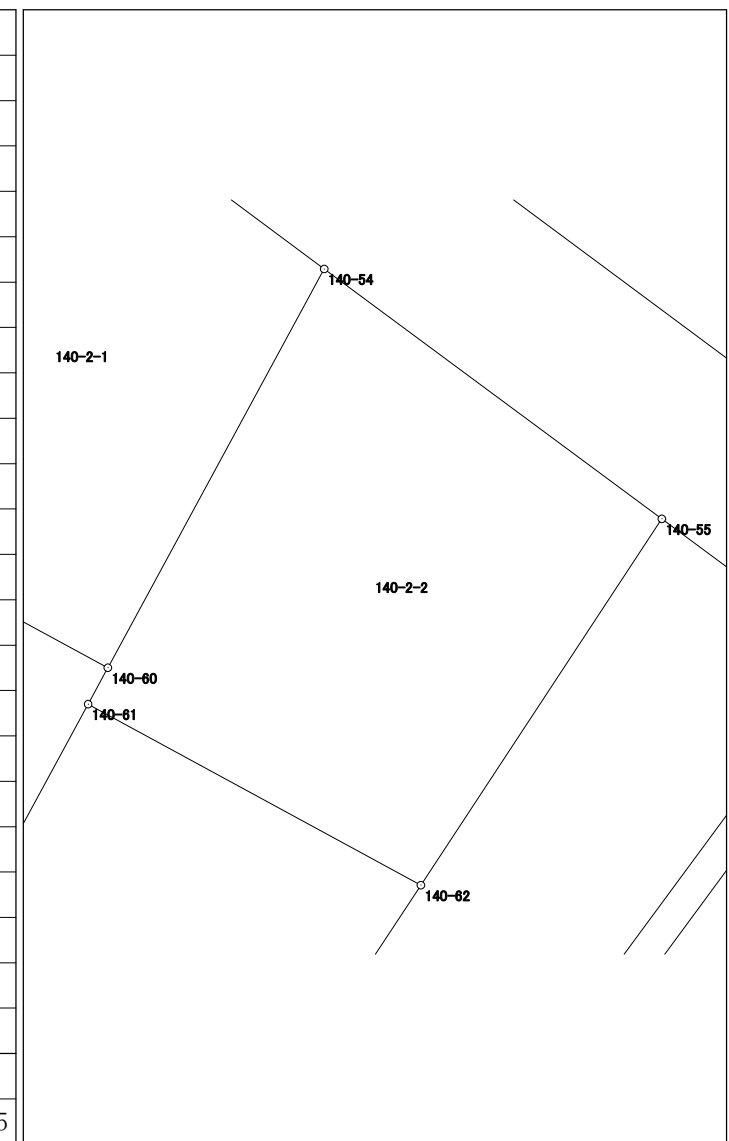


倍面積	475.910889
面 積	237.9554445

## 面積計算書 (座標法)

世界測地系 (測地成果2011)

所 在	地 番	公簿地目	現況地目	地 積	所 有 者
前橋市六供町五丁目	140-2-3			237.77 m <sup>2</sup>	

点 名	X 座標	Y 座標	辺 長	方 向 角	測 角	DX	倍 積 (Y×DX)
140-59	40981.279	-67675.899	19.182	203-57-48	85-27-05	-11.283	763587.168417
140-25	40963.750	-67683.690	1.421	119-03-17	95-05-29	-18.219	1233129.148110
140-R43	40963.060	-67682.448	2.009	119-43-00	180-39-43	-1.686	114112.607328
140-R44	40962.064	-67680.703	2.013	120-26-12	180-43-12	-2.016	136444.297248
140-R45	40961.044	-67678.967	4.022	121-22-27	180-56-15	-3.114	210752.303238
140-R47	40958.950	-67675.533	2.120	122-16-50	180-54-23	-3.226	218321.269458
140-57	40957.818	-67673.741	18.104	28-29-25	86-12-35	14.780	-1000217.891980
140-61	40973.730	-67665.105	1.481	28-22-55	179-53-30	17.215	-1164854.782575
140-60	40975.033	-67664.401	13.085	298-30-43	90-07-48	7.549	-510798.563149

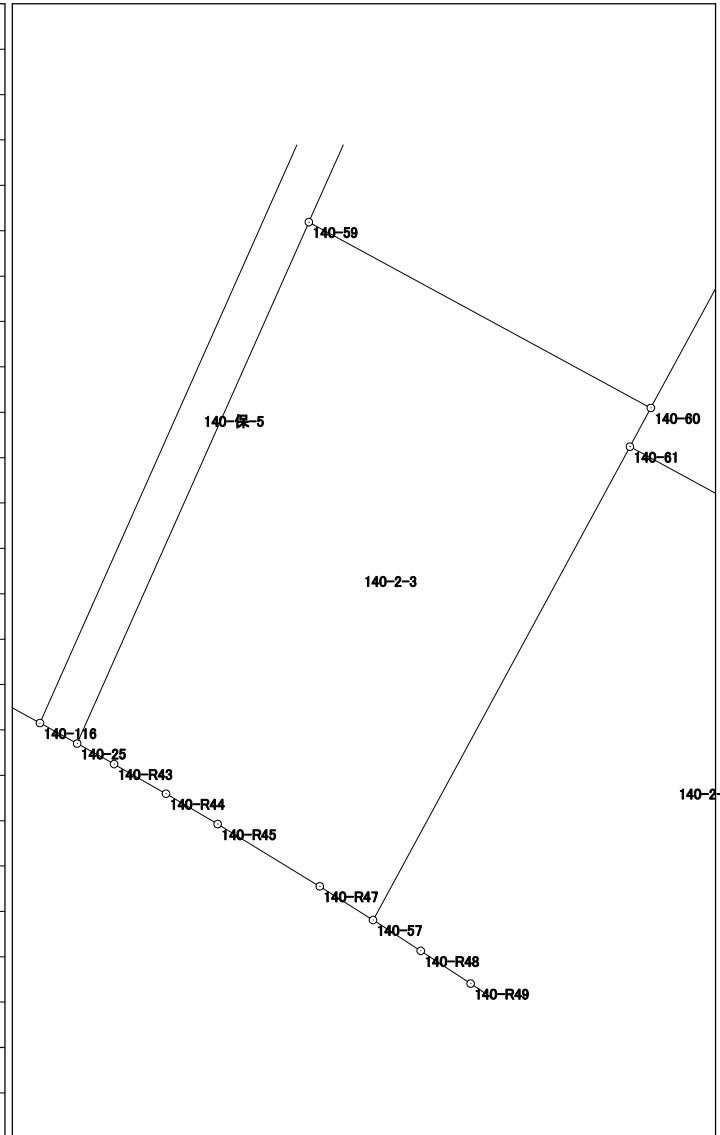

倍面積	475.556095
面積	237.7780475




# 面積計算書 (座標法)

世界測地系 (測地成果2011)

所在	地番	公簿地目	現況地目	地積	所有者
前橋市六供町五丁目	140-2-4			237.74 m <sup>2</sup>	

点名	X座標	Y座標	辺長	方向角	測角	DX	倍積 (Y×DX)
140-61	40973.730	-67665.105	18.104	208-29-25	89-56-47	-9.433	638284.935465
140-57	40957.818	-67673.741	1.909	122-51-28	94-22-03	-16.948	1146934.562468
140-R48	40956.782	-67672.137	2.006	123-17-10	180-25-42	-2.137	144615.356769
140-R49	40955.681	-67670.460	2.018	123-59-22	180-42-12	-2.229	150837.455340
140-R50	40954.553	-67668.787	2.020	124-38-03	180-38-41	-2.276	154014.159212
140-R51	40953.405	-67667.125	1.995	125-09-50	180-31-47	-2.297	155431.386125
140-R52	40952.256	-67665.494	2.003	125-42-50	180-33-00	-2.318	156848.615092
140-56	40951.087	-67663.868	19.370	33-26-21	87-43-31	14.995	-1014619.700660
140-62	40967.251	-67653.194	13.559	298-32-38	85-06-17	22.643	-1531871.271742

倍面積	475.498069
面積	237.7490345

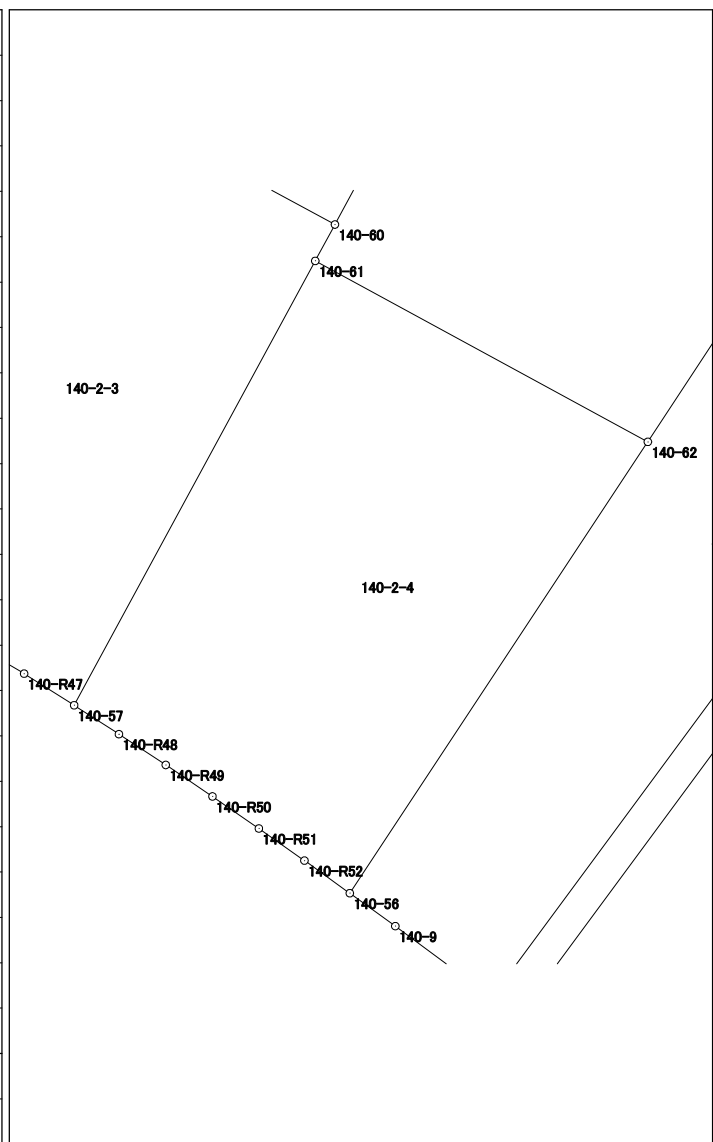


# 面積計算書 (座標法)

世界測地系 (測地成果2011)

所 在	地 番	公簿地目	現況地目	地 積	所 有 者
前橋市六供町五丁目	140-2-5			252.95 m <sup>2</sup>	

点 名	X 座標	Y 座標	辺 長	方 向 角	測 角	DX	倍 積 (Y×DX)
140-131	40947.347	-67658.788	34.983	36-25-54	89-50-40	25.585	-1731050.090980
140-130	40975.493	-67638.013	8.166	306-35-41	90-09-47	33.014	-2233001.361182
140-55	40980.361	-67644.569	15.693	213-20-27	86-44-46	-8.242	557526.537698
140-62	40967.251	-67653.194	19.370	213-26-21	180-05-54	-29.274	1980479.601156
140-56	40951.087	-67663.868	2.012	125-52-43	92-26-22	-17.343	1173494.462724
140-9	40949.908	-67662.238	4.297	126-35-14	180-42-31	-3.740	253056.770120
倍面積							505.919536
面 積							252.9597680

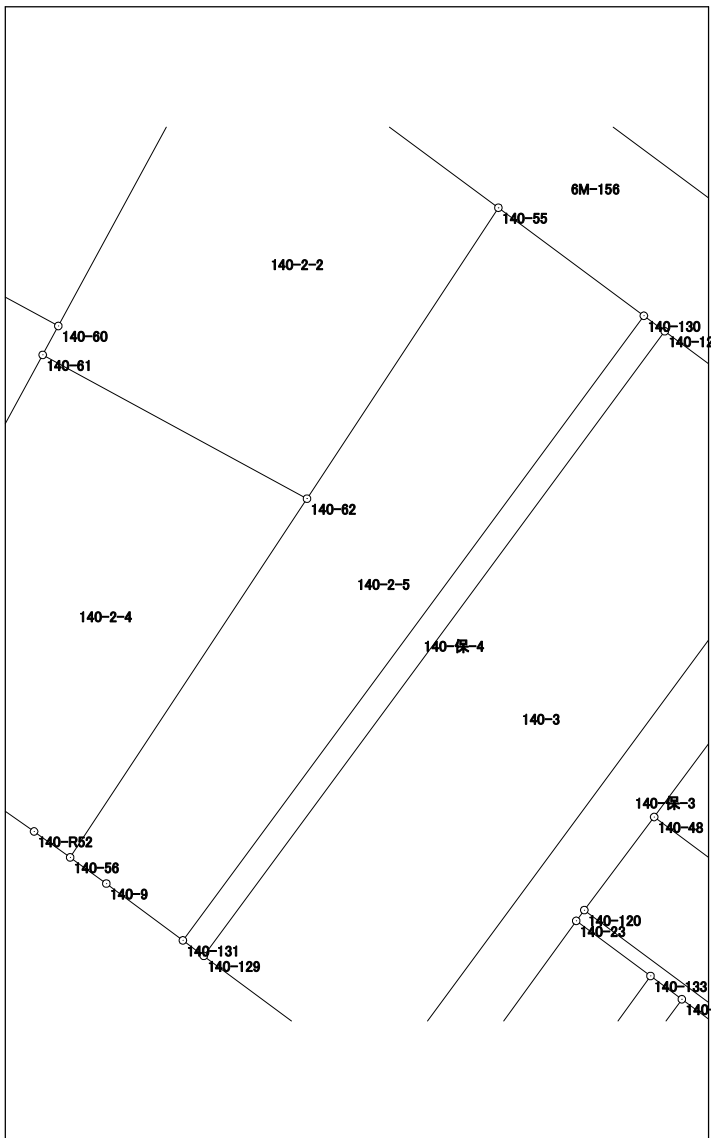


# 面積計算書（座標法）

世界測地系（測地成果2011）

所在	地番	公簿地目	現況地目	地積	所有者
前橋市六供町五丁目	140-3			344.78 m <sup>2</sup>	

点名	X座標	Y座標	辺長	方向角	測角	DX	倍積 (Y×DX)
140-128	40974.794	-67637.072	34.983	216-25-54	89-50-23	-22.271	1506345.230512
140-129	40946.648	-67657.847	9.856	126-35-48	90-09-54	-34.022	2301855.270634
140-118	40940.772	-67649.934	34.984	36-25-50	89-50-02	22.271	-1506631.680114
140-117	40968.919	-67629.159	9.856	306-35-31	90-09-41	34.022	-2300879.247498
						倍面積	689.573534
						面積	344.7867670

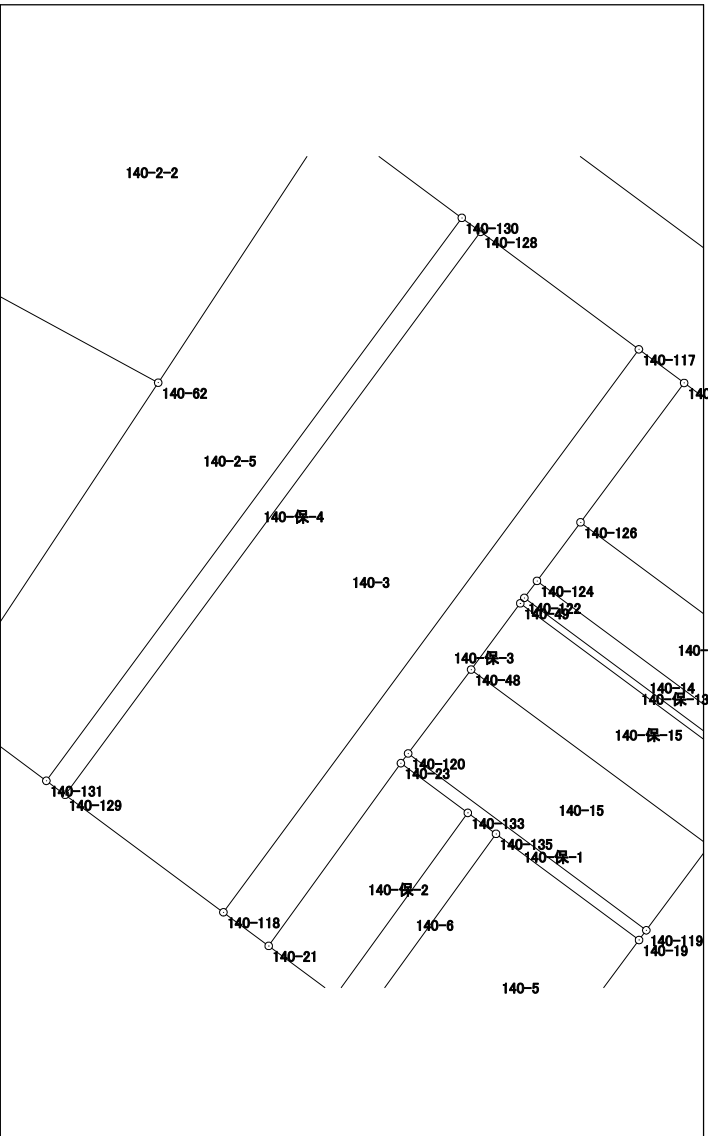


# 面積計算書 (座標法)

世界測地系 (測地成果2011)

所在	地番	公簿地目	現況地目	地積	所有者
前橋市六供町五丁目	140-5			99.74 m <sup>2</sup>	

点名	X座標	Y座標	辺長	方向角	測角	D <sub>X</sub>	倍積 (Y×D <sub>X</sub> )
140-135	40944.695	-67636.301	11.279	215-53-04	89-17-51	-3.829	258979.396529
140-134	40935.557	-67642.912	8.777	126-37-28	90-44-24	-14.374	972299.217088
140-8	40930.321	-67635.868	11.284	36-32-45	89-55-17	3.829	-258977.738572
140-19	40939.386	-67629.149	8.907	306-35-13	90-02-28	14.374	-972101.387726
倍面積						199.487319	
面積						99.7436595	

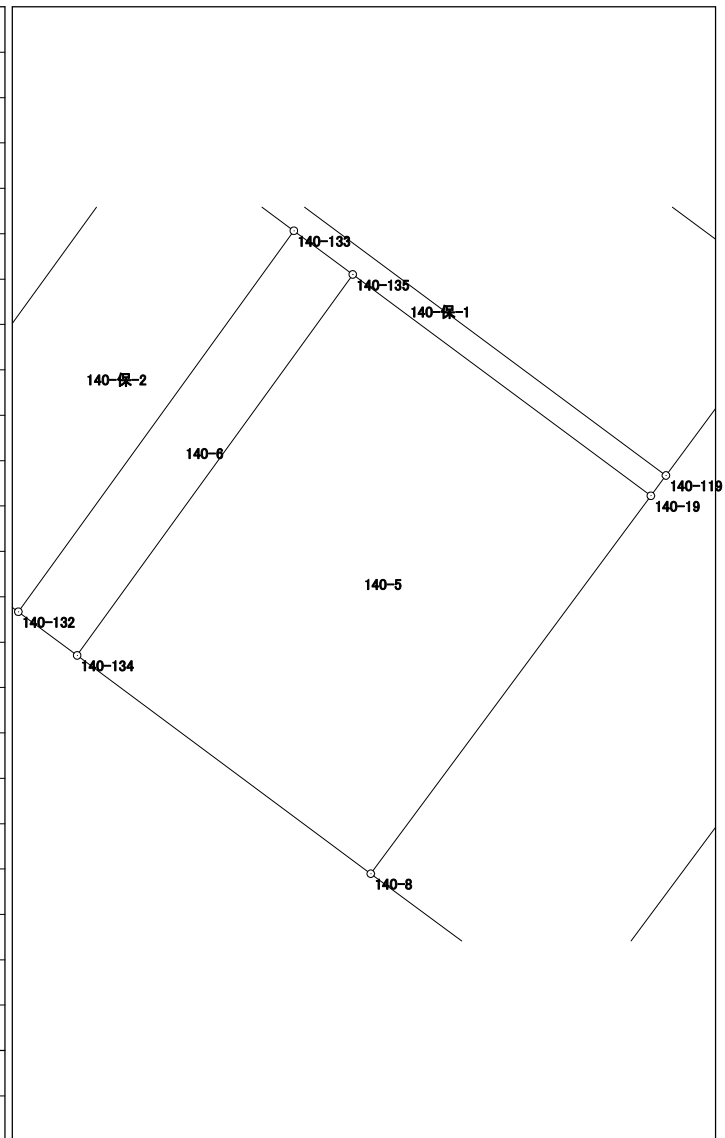

# 面積計算書（座標法）

世界測地系（測地成果2011）

所在	地番	公簿地目	現況地目	地積	所有者
前橋市六供町五丁目	140-6			19.82 m <sup>2</sup>	

点名	X座標	Y座標	辺長	方向角	測角	DX	倍積 (Y×DX)
140-134	40935.557	-67642.912	11.279	35-53-04	89-16-55	8.090	-547231.158080
140-135	40944.695	-67636.301	1.758	306-34-59	90-41-55	10.186	-688943.361986
140-133	40945.743	-67637.713	11.278	215-52-49	89-17-50	-8.090	547189.098170
140-132	40936.605	-67644.323	1.758	126-36-09	90-43-20	-10.186	689025.074078
倍面積						39.652182	
面積						19.8260910	




# 面積計算書（座標法）

世界測地系（測地成果2011）

所 在	地 番	公簿地目	現況地目	地 積	所 有 者
前橋市六供町五丁目	140-8			171.01 m <sup>2</sup>	

点 名	X 座標	Y 座標	辺 長	方 向 角	測 角	DX	倍 積 (Y×DX)
140-114	41025.070	-67696.225	32.972	179-43-07	90-01-30	-32.999	2233907.728775
140-113	40992.098	-67696.063	5.309	106-06-25	106-23-18	-34.445	2331790.890035
140-40	40990.625	-67690.962	11.092	359-37-23	73-30-58	9.619	-651119.363478
140-58	41001.717	-67691.035	5.101	359-43-50	180-06-27	16.193	-1096120.929755
140-42	41006.818	-67691.059	18.279	359-38-00	179-54-10	23.380	-1582616.959420
140-38	41025.097	-67691.176	5.049	269-41-37	90-03-37	18.252	-1235499.344352
						倍面積	342.021805
						面 積	171.0109025

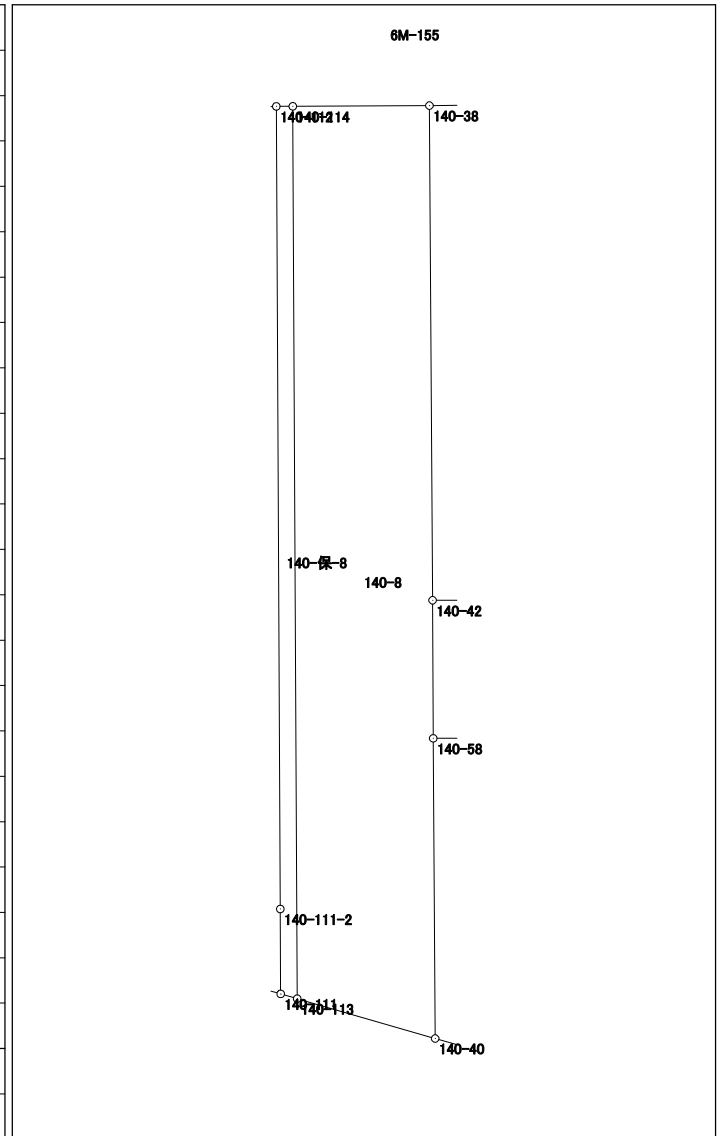


# 面積計算書 (座標法)

世界測地系 (測地成果2011)

所在	地番	公簿地目	現況地目	地積	所有者
前橋市六供町五丁目	140-9			888.07 m <sup>2</sup>	

点名	X座標	Y座標	辺長	方向角	測角	DX	倍積 (Y×DX)
140-107	40994.579	-67704.660	1.066	286-04-15	179-58-23	2.600	-176032.116000
140-105	40994.874	-67705.684	0.777	286-08-53	180-04-38	0.511	-34597.604524
140-33	40995.090	-67706.430	14.698	269-46-40	163-37-47	0.159	-10765.322370
140-32	40995.033	-67721.128	14.603	196-24-30	106-37-50	-14.065	952497.665320
140-30	40981.025	-67725.253	1.910	106-14-02	89-49-32	-14.542	984860.629126
140-R22	40980.491	-67723.419	2.013	106-49-58	180-35-56	-1.117	75647.059023
140-R23	40979.908	-67721.492	2.358	107-35-51	180-45-53	-1.296	87767.053632
140-R24	40979.195	-67719.244	2.020	108-21-15	180-45-24	-1.349	91353.260156
140-R25	40978.559	-67717.327	2.019	108-55-43	180-34-28	-1.291	87423.069157
140-R26	40977.904	-67715.417	2.003	109-03-33	180-07-50	-1.309	88639.480853
140-R27	40977.250	-67713.524	2.019	110-00-53	180-57-20	-1.345	91074.689780
140-R28	40976.559	-67711.627	2.011	110-40-10	180-39-17	-1.401	94863.989427
140-R29	40975.849	-67709.745	2.013	111-06-33	180-26-23	-1.435	97163.484075
140-R30	40975.124	-67707.867	2.010	111-25-13	180-18-40	-1.459	98785.777953
140-R31	40974.390	-67705.996	2.005	112-03-41	180-38-28	-1.487	100678.816052
140-R32	40973.637	-67704.138	2.018	112-57-22	180-53-41	-1.540	104264.372520
140-R33	40972.850	-67702.280	2.013	113-19-05	180-21-43	-1.584	107240.411520
140-R34	40972.053	-67700.431	2.020	114-08-28	180-49-23	-1.623	109877.799513
140-R35	40971.227	-67698.588	2.004	114-28-03	180-19-35	-1.656	112108.861728
140-R36	40970.397	-67696.764	2.018	115-04-00	180-35-57	-1.685	114069.047340
140-R37	40969.542	-67694.936	2.008	115-32-39	180-28-39	-1.721	116502.984856
140-R38	40968.676	-67693.124	2.012	116-20-55	180-48-16	-1.759	119072.205116

倍面積	
面積	

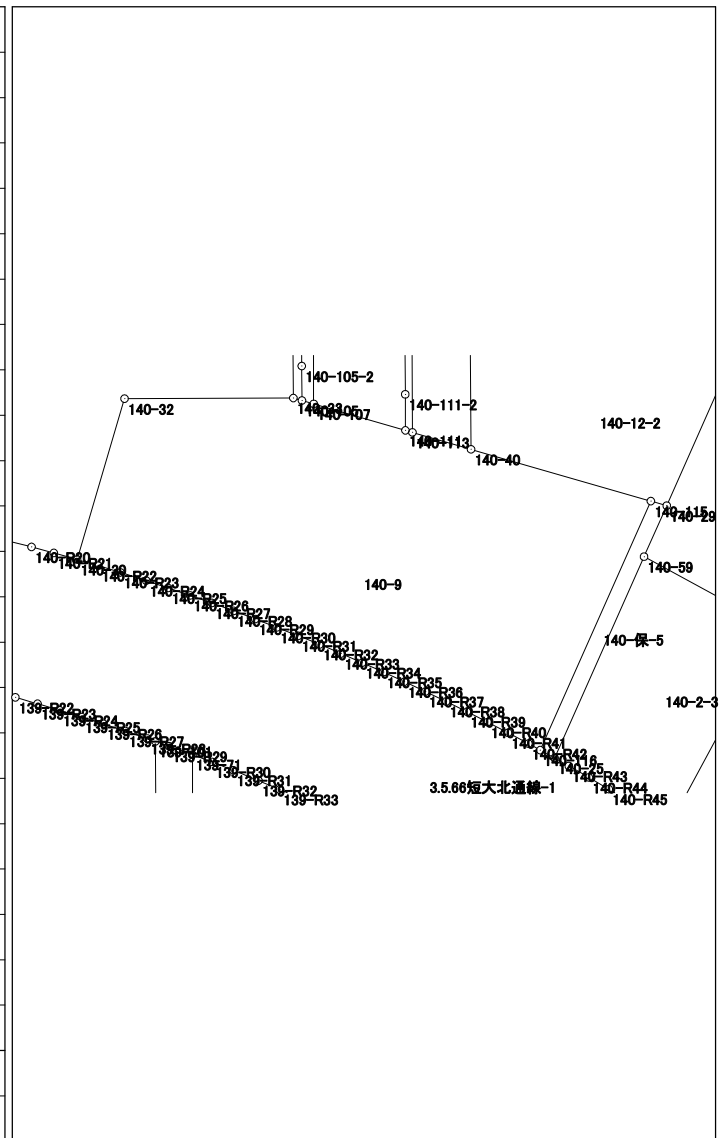




# 面積計算書 (座標法)

世界測地系 (測地成果2011)

所在	地番	公簿地目	現況地目	地積	所有者
前橋市六供町五丁目	140-9			888.07 m <sup>2</sup>	

点名	X座標	Y座標	辺長	方向角	測角	DX	倍積 (Y×DX)
140-R39	40967.783	-67691.321	2.009	116-48-27	180-27-32	-1.799	121776.686479
140-R40	40966.877	-67689.528	2.012	117-25-52	180-37-25	-1.833	124074.904824
140-R41	40965.950	-67687.742	2.010	118-00-20	180-34-28	-1.871	126643.765282
140-R42	40965.006	-67685.967	1.171	118-54-26	180-54-06	-1.510	102205.810170
140-116	40964.440	-67684.942	23.721	23-57-55	85-03-29	21.110	-1428829.125620
140-115	40986.116	-67675.307	16.291	286-04-03	82-06-08	26.185	-1772077.913795
140-40	40990.625	-67690.962	5.309	286-06-25	180-02-22	5.982	-404927.334684
140-113	40992.098	-67696.063	0.635	286-05-39	179-59-14	1.649	-111630.807887
140-111	40992.274	-67696.673	8.313	286-05-52	180-00-13	2.481	-167955.445713
						倍面積	1776.153309
						面積	888.0766545

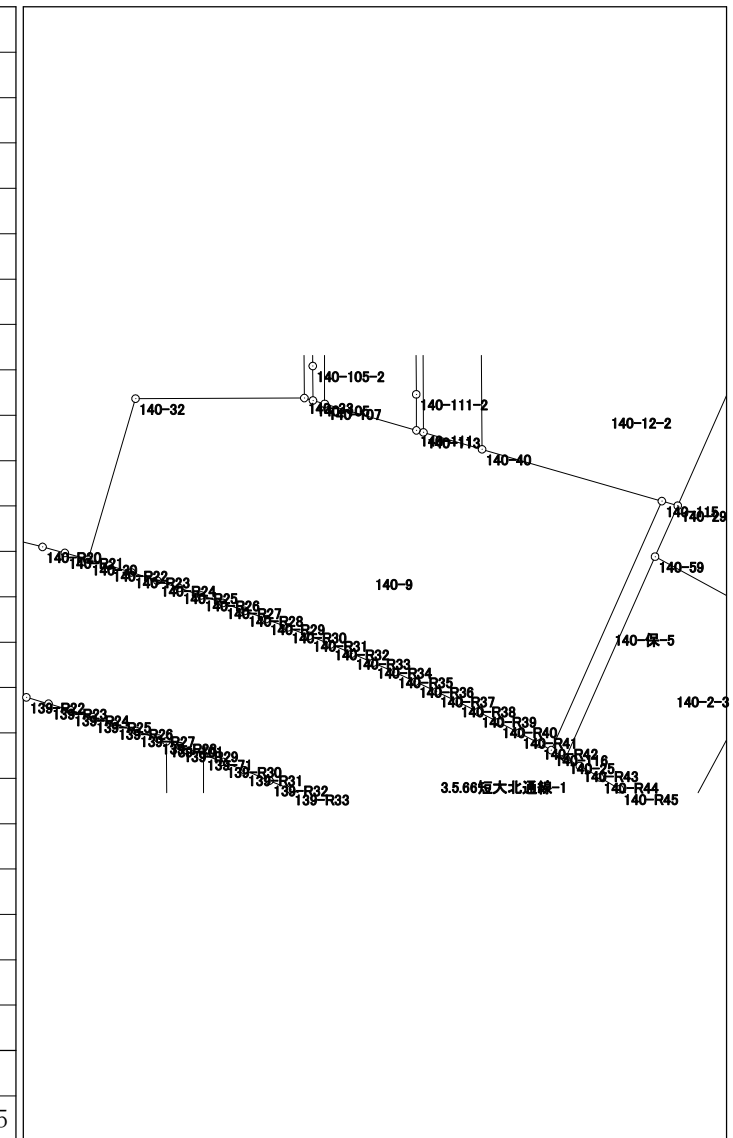


# 面積計算書（座標法）

世界測地系（測地成果2011）

所在	地番	公簿地目	現況地目	地積	所有者
前橋市六供町五丁目	140-10			1586.75 m <sup>2</sup>	

点名	X座標	Y座標	辺長	方向角	測角	Dx	倍積 (Y×Dx)
140-136	40986.175	-67748.581	1.658	98-59-07	102-06-46	-38.859	2632642.109079
140-R11	40985.916	-67746.943	2.016	99-47-38	180-48-31	-0.602	40783.659686
140-R12	40985.573	-67744.956	2.017	100-29-07	180-41-29	-0.710	48098.918760
140-R13	40985.206	-67742.973	2.008	100-38-58	180-09-51	-0.738	49994.314074
140-R14	40984.835	-67741.000	2.017	101-33-18	180-54-20	-0.775	52499.275000
140-R15	40984.431	-67739.024	2.020	102-08-39	180-35-21	-0.829	56155.650896
140-R16	40984.006	-67737.049	2.010	102-33-24	180-24-45	-0.862	58389.336238
140-R17	40983.569	-67735.087	2.016	103-20-00	180-46-36	-0.902	61097.048474
140-R18	40983.104	-67733.125	2.009	103-40-36	180-20-36	-0.940	63669.137500
140-R19	40982.629	-67731.173	2.013	104-26-37	180-46-01	-0.977	66173.356021
140-R20	40982.127	-67729.224	2.011	105-01-04	180-34-27	-1.023	69286.996152
140-R21	40981.606	-67727.282	2.111	105-58-44	180-57-40	-1.102	74635.464764
140-30	40981.025	-67725.253	14.603	16-24-30	90-25-46	13.427	-909346.972031
140-32	40995.033	-67721.128	14.698	89-46-40	253-22-10	14.065	-952497.665320
140-33	40995.090	-67706.430	29.925	359-43-07	89-56-27	29.982	-2029974.184260
140-28	41025.015	-67706.577	44.114	269-41-18	89-58-11	29.685	-2009869.738245
140-137	41024.775	-67750.690	38.658	176-52-21	87-11-03	-38.840	2631436.799600

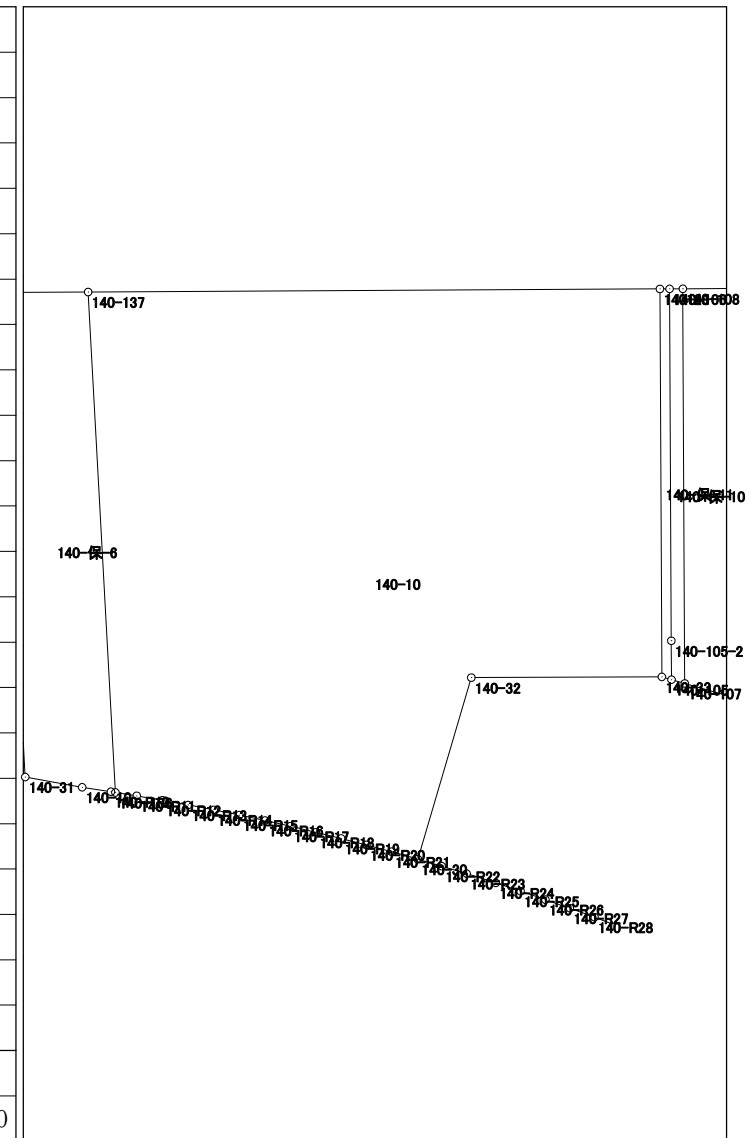


倍面積	3173.506388
面積	1586.7531940



# 面積計算書 (座標法)

世界測地系 (測地成果2011)

所 在	地 番	公簿地目	現況地目	地 積	所 有 者
前橋市六供町五丁目	140-12-1			114.13 m <sup>2</sup>	

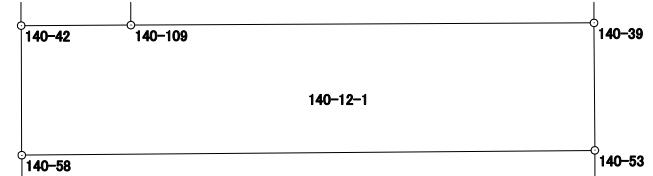
点 名	X 座標	Y 座標	辺 長	方 向 角	測 角	DX	倍 積 (Y×DX)		
140-58	41001.717	-67691.035	22.564	89-30-54	89-47-04	-4.910	332362.981850		
140-53	41001.908	-67668.472	5.017	359-37-23	90-06-29	5.208	-352417.402176		
140-39	41006.925	-67668.505	18.233	269-43-47	90-06-24	4.931	-333673.398155		
140-109	41006.839	-67686.738	4.321	269-43-18	179-59-31	-0.107	7242.480966		
140-42	41006.818	-67691.059	5.101	179-43-50	90-00-32	-5.122	346713.604198		
							倍面積		228.266683
							面 積		114.1333415

# 面積計算書 (座標法)

世界測地系 (測地成果2011)

所在	地番	公簿地目	現況地目	地積	所有者
前橋市六供町五丁目	140-12-2			287.12 m <sup>2</sup>	

点名	X座標	Y座標	辺長	方向角	測角	DX	倍積 (Y×DX)
140-115	40986.116	-67675.307	0.000	0-00-00	73-55-57	-4.509	305147.959263
140-115	40986.116	-67675.307	1.438	106-01-39	286-01-39	-0.397	26867.096879
140-29	40985.719	-67673.925	13.504	23-56-10	97-54-31	11.946	-808432.708050
140-5	40998.062	-67668.446	3.846	359-36-46	155-40-36	16.189	-1095484.472294
140-53	41001.908	-67668.472	22.564	269-30-54	89-54-08	3.655	-247328.265160
140-58	41001.717	-67691.035	11.092	179-37-23	90-06-29	-11.283	763757.947905
140-40	40990.625	-67690.962	16.291	106-04-03	106-26-40	-15.601	1056046.698162
倍面積							574.256705
面積							287.1283525

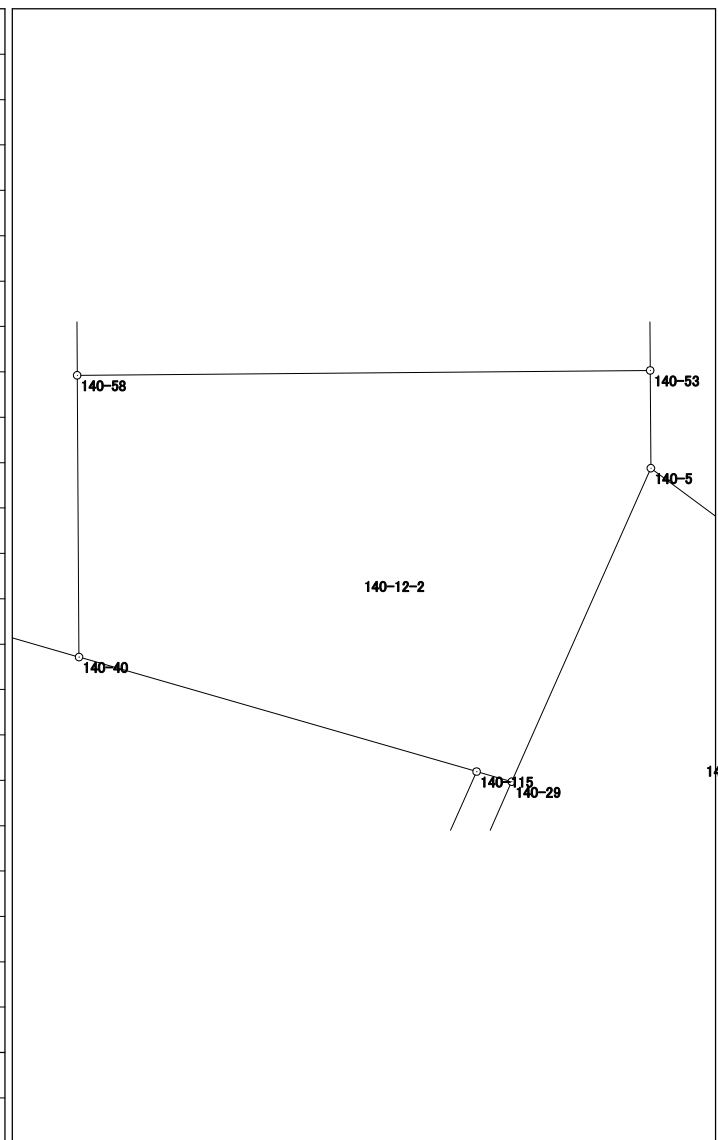


## 面積計算書 (座標法)

世界測地系 (測地成果2011)

所在	地番	公簿地目	現況地目	地積	所有者
前橋市六供町五丁目	140-13			124.54 m <sup>2</sup>	

点名	X座標	Y座標	辺長	方向角	測角	DX	倍積 (Y×DX)
140-126	40960.270	-67632.076	14.801	126-32-58	89-54-28	-15.781	1067301.791356
140-125	40951.456	-67620.186	5.865	36-36-43	90-03-45	-4.106	277648.483716
140-7	40956.164	-67616.688	3.996	351-29-41	134-52-58	8.660	-585560.518080
140-6	40960.116	-67617.279	11.965	306-31-27	135-01-46	11.073	-748726.130367
140-18	40967.237	-67626.894	8.683	216-38-30	90-07-03	0.154	-10414.541676
倍面積							249.084949
面積							124.5424745

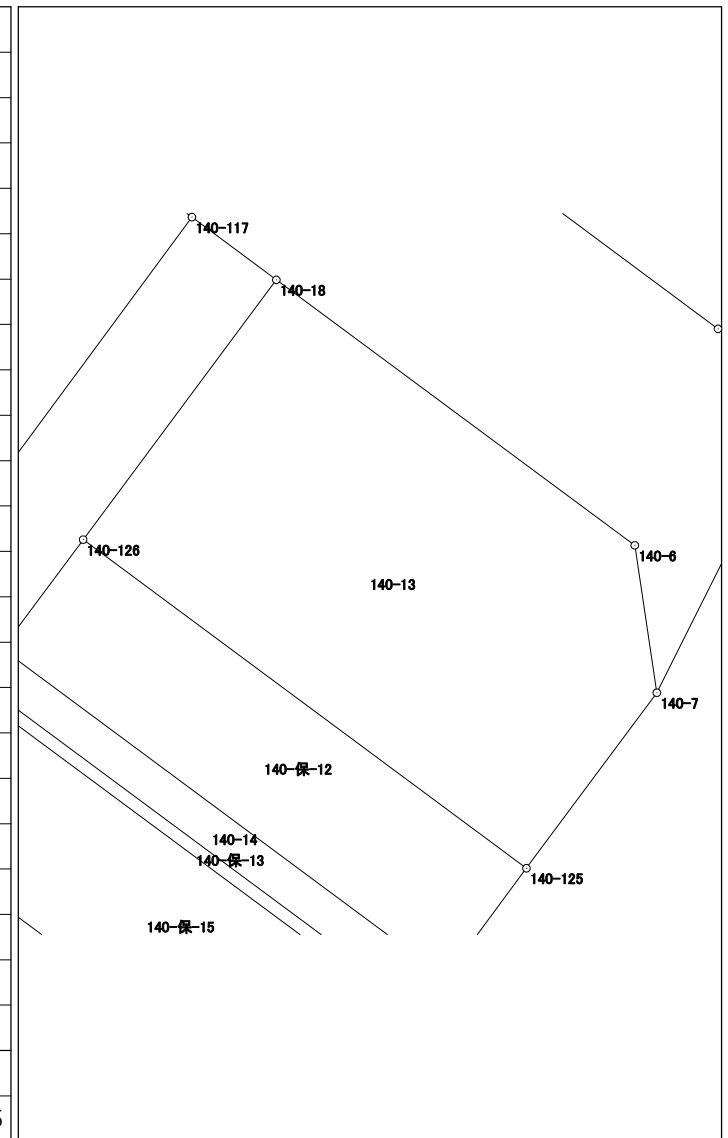


# 面積計算書 (座標法)

世界測地系 (測地成果2011)

所在	地番	公簿地目	現況地目	地積	所有者
前橋市六供町五丁目	140-14			15.67 m <sup>2</sup>	

点名	X座標	Y座標	辺長	方向角	測角	DX	倍積 (Y×DX)
140-123	40948.528	-67622.363	14.801	306-32-58	89-59-36	9.665	-653570.138395
140-124	40957.342	-67634.253	1.059	216-37-55	90-04-57	7.964	-538639.190892
140-122	40956.492	-67634.885	14.802	126-33-01	89-55-06	-9.665	653691.163525
140-121	40947.677	-67622.994	1.059	36-33-22	90-00-21	-7.964	538549.524216

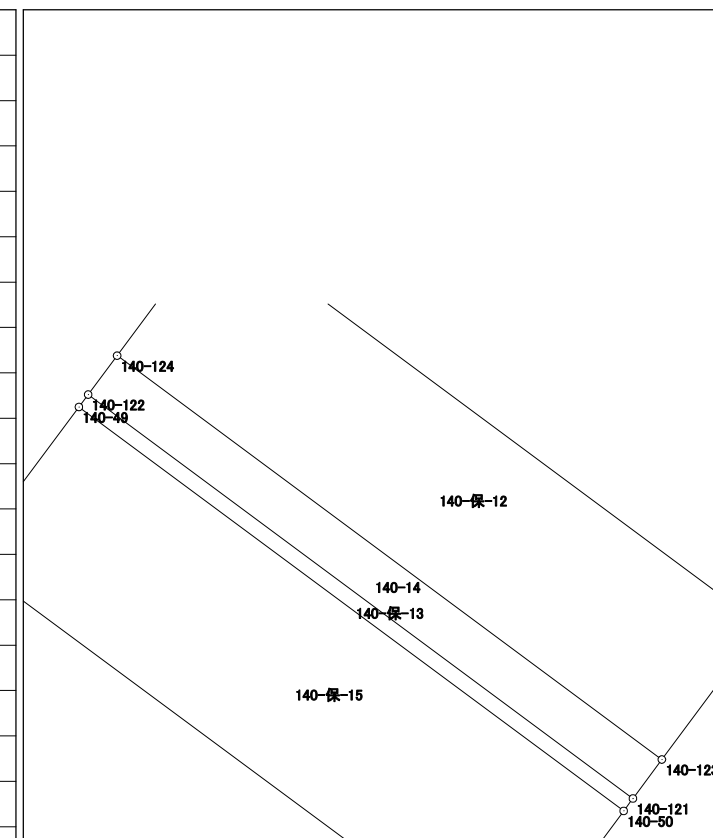

倍面積	31.358454
面積	15.6792270






# 面積計算書（座標法）

世界測地系（測地成果2011）

所 在	地 番	公簿地目	現況地目	地 積	所 有 者
前橋市六供町五丁目	140-保-1			9.00 m <sup>2</sup>	

点 名	X 座標	Y 座標	辺 長	方 向 角	測 角	D X	倍 積 (Y×DX)
140-23	40948.227	-67641.060	4.168	126-34-52	89-44-56	-2.970	200893.948200
140-133	40945.743	-67637.713	1.758	126-34-59	180-00-07	-3.532	238896.402316
140-135	40944.695	-67636.301	8.907	126-35-13	180-00-14	-6.357	429963.965457
140-19	40939.386	-67629.149	0.607	36-37-28	90-02-15	-4.822	326107.756478
140-119	40939.873	-67628.787	14.831	306-35-11	89-57-43	9.327	-630773.696349
140-120	40948.713	-67640.696	0.607	216-49-56	90-14-45	8.354	-565070.374384

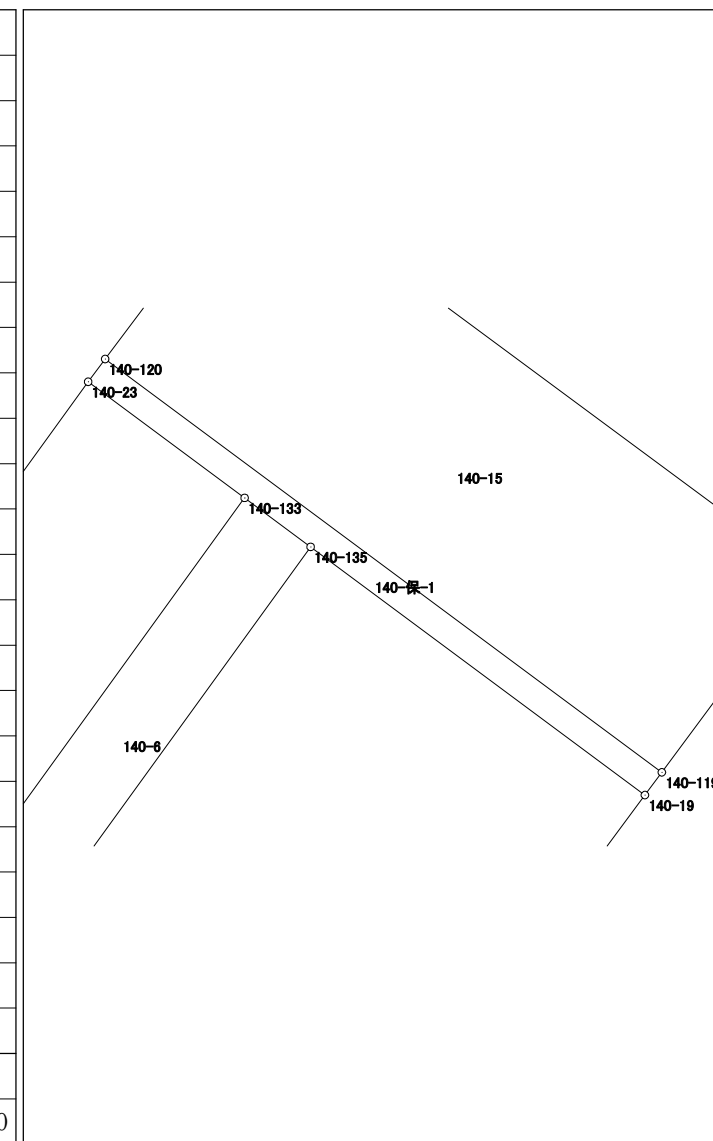

倍面積	18.001718
面 積	9.0008590


# 面積計算書（座標法）

世界測地系（測地成果2011）

所在	地番	公簿地目	現況地目	地積	所有者
前橋市六供町五丁目	140-保-2			47.00 m <sup>2</sup>	

点名	X座標	Y座標	辺長	方向角	測角	DX	倍積 (Y×DX)
140-132	40936.605	-67644.323	11.278	35-52-49	89-15-28	6.651	-449902.392273
140-133	40945.743	-67637.713	4.168	306-34-52	90-42-03	11.622	-786085.500486
140-23	40948.227	-67641.060	11.275	215-53-06	89-18-14	-6.651	449880.690060
140-21	40939.092	-67647.669	4.169	126-37-21	90-44-15	-11.622	786201.209118

倍面積	94.006419
面積	47.0032095

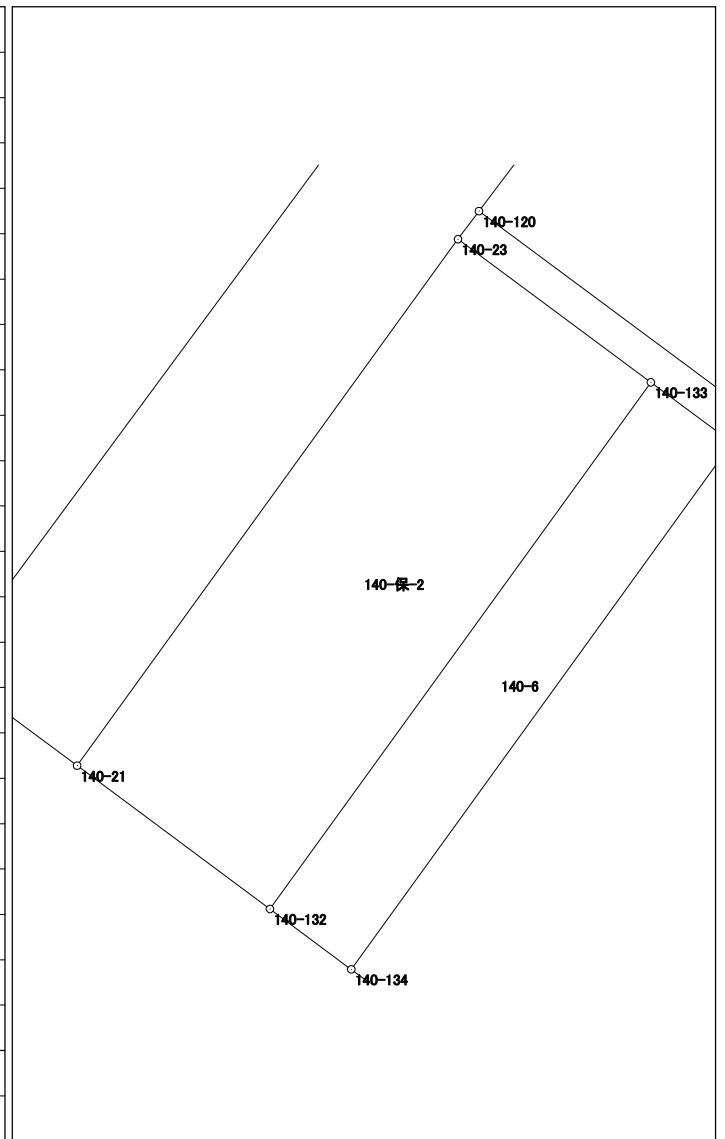


# 面積計算書（座標法）

世界測地系（測地成果2011）

所在	地番	公簿地目	現況地目	地積	所有者
前橋市六供町五丁目	140-保-3			97.00 m <sup>2</sup>	

点名	X座標	Y座標	辺長	方向角	測角	Dx	倍積 (Y×Dx)
140-120	40948.713	-67640.696	5.245	36-54-02	180-04-06	4.680	-316558.457280
140-48	40952.907	-67637.547	4.127	36-35-12	179-41-10	7.508	-507822.702876
140-49	40956.221	-67635.087	0.338	36-42-01	180-06-49	3.585	-242471.786895
140-122	40956.492	-67634.885	1.059	36-37-55	179-55-54	1.121	-75818.706085
140-124	40957.342	-67634.253	3.649	36-37-52	179-59-57	3.778	-255522.207834
140-126	40960.270	-67632.076	8.683	36-38-30	180-00-38	9.895	-669219.392020
140-18	40967.237	-67626.894	2.821	306-35-52	89-57-22	8.649	-584905.006206
140-117	40968.919	-67629.159	34.984	216-25-50	89-49-58	-26.465	1789805.692935
140-118	40940.772	-67649.934	2.820	126-33-54	90-08-04	-29.827	2017794.581418
140-21	40939.092	-67647.669	11.275	35-53-06	89-19-12	7.455	-504313.372395
140-23	40948.227	-67641.060	0.607	36-49-56	180-56-50	9.621	-650774.638260

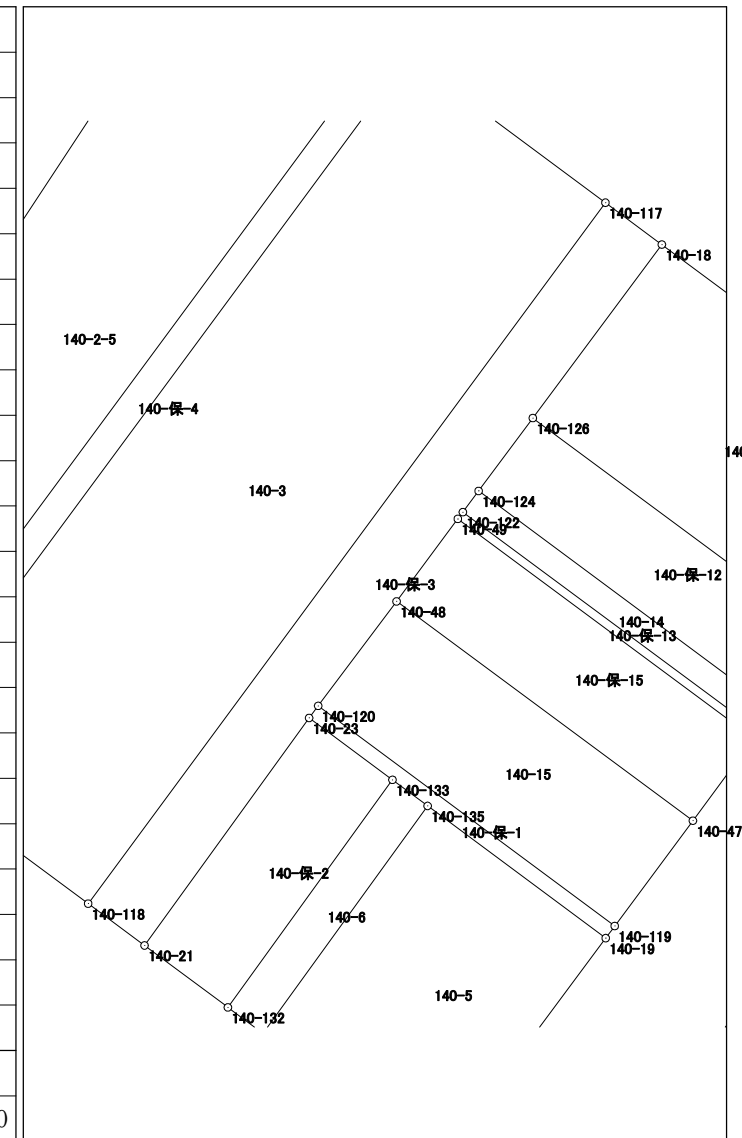


倍面積	194.004502
面積	97.0022510

# 面積計算書（座標法）

世界測地系（測地成果2011）

所 在	地 番	公簿地目	現況地目	地 積	所 有 者
前橋市六供町五丁目	140-保-4			41.00 m <sup>2</sup>	

点 名	X 座標	Y 座標	辺 長	方 向 角	測 角	DX	倍 積 (Y×DX)
140-130	40975.493	-67638.013	34.983	216-25-54	89-49-33	-27.447	1856460.542811
140-131	40947.347	-67658.788	1.172	126-36-21	90-10-27	-28.845	1951617.739860
140-129	40946.648	-67657.847	34.983	36-25-54	89-49-33	27.447	-1857004.926609
140-128	40974.794	-67637.072	1.172	306-36-21	90-10-27	28.845	-1950991.341840
						倍面積	82.014222
						面 積	41.0071110

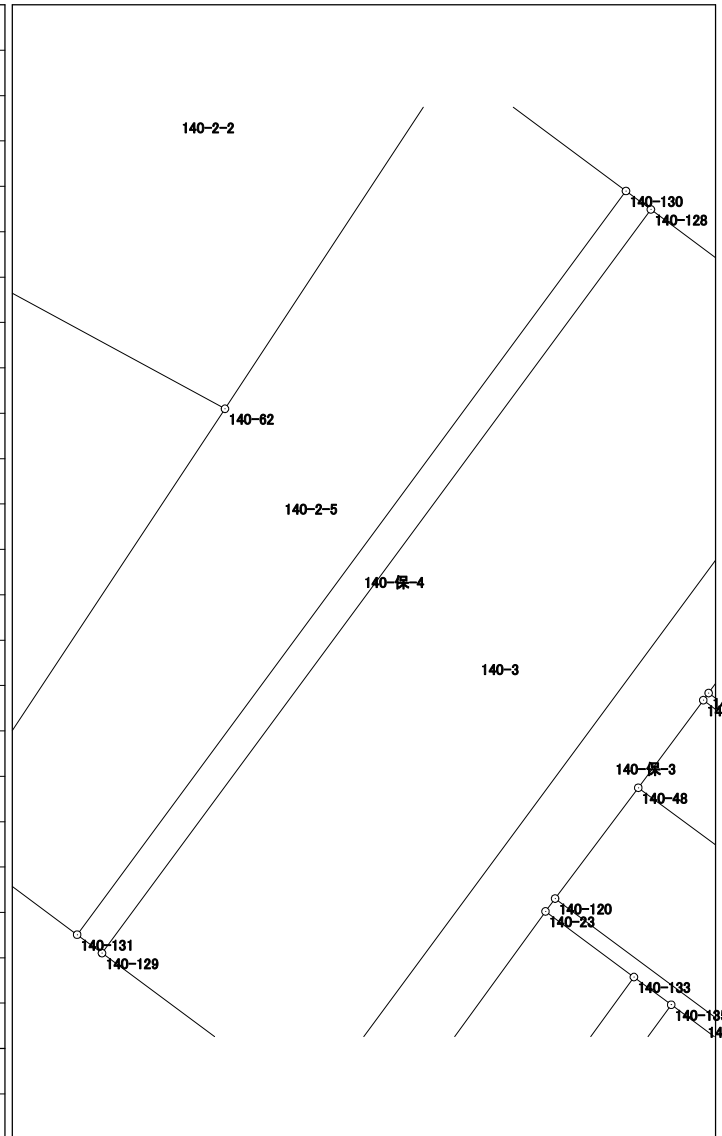


# 面積計算書（座標法）

世界測地系（測地成果2011）

所 在	地 番	公簿地目	現況地目	地 積	所 有 者
前橋市六供町五丁目	140-保-5			34.00 m <sup>2</sup>	

点 名	X 座 標	Y 座 標	辺 長	方 向 角	測 角	DX	倍 積 (Y×DX)
140-115	40986.116	-67675.307	23.721	203-57-55	97-56-16	-21.279	1440062.857653
140-116	40964.440	-67684.942	1.430	118-51-36	94-53-41	-22.366	1513841.412772
140-25	40963.750	-67683.690	19.182	23-57-48	85-06-12	16.839	-1139725.655910
140-59	40981.279	-67675.899	4.859	23-58-11	180-00-23	21.969	-1486771.825131
140-29	40985.719	-67673.925	1.438	286-01-39	82-03-28	4.837	-327338.775225
						倍面積	68.014159
						面 積	34.0070795

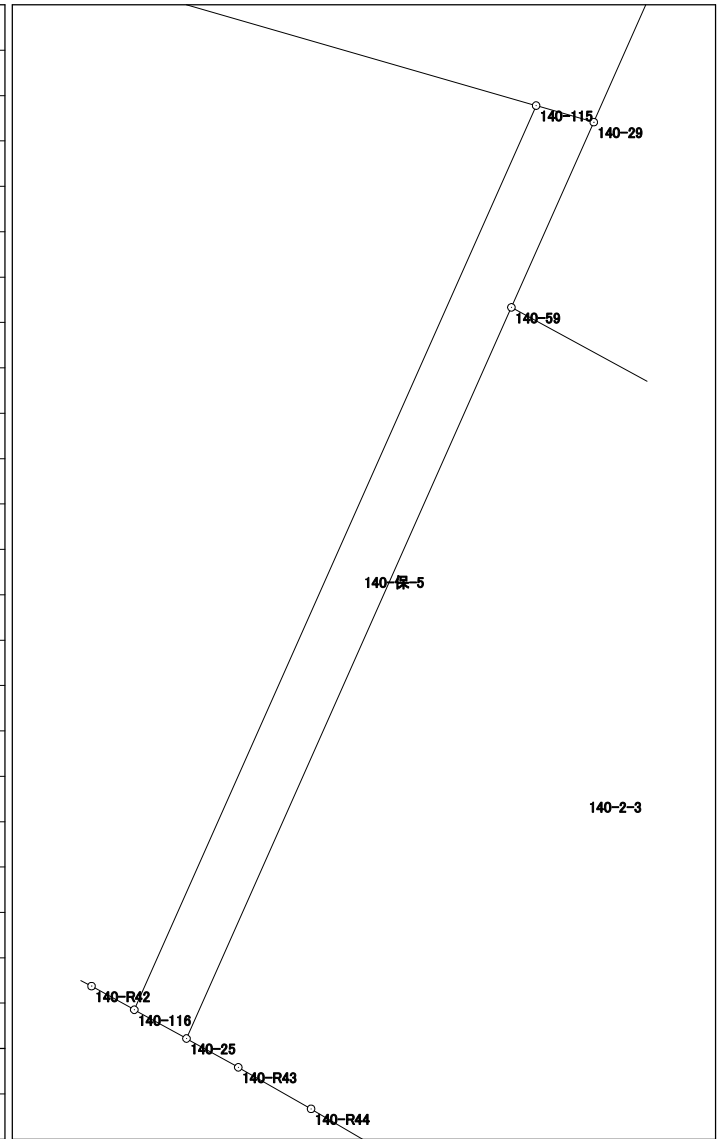


# 面積計算書 (座標法)

世界測地系 (測地成果2011)

所在	地番	公簿地目	現況地目	地積	所有者
前橋市六供町五丁目	140-保-6			262.00 m <sup>2</sup>	

点名	X座標	Y座標	辺長	方向角	測角	DX	倍積 (Y×DX)
140-27	41024.738	-67757.585	17.720	176-51-08	87-09-35	-17.730	1201341.982050
140-64	41007.045	-67756.612	19.710	176-53-17	180-02-09	-37.374	2532335.616888
140-31	40987.364	-67755.542	4.461	100-12-51	103-19-34	-20.472	1387091.455824
140-10	40986.573	-67751.152	2.246	98-43-57	178-31-06	-1.132	76694.304064
140-R10	40986.232	-67748.932	0.356	99-13-26	180-29-29	-0.398	26964.074936
140-136	40986.175	-67748.581	38.658	356-52-21	77-38-55	38.543	-2611233.557483
140-137	41024.775	-67750.690	6.895	269-41-33	92-49-12	38.563	-2612669.858470

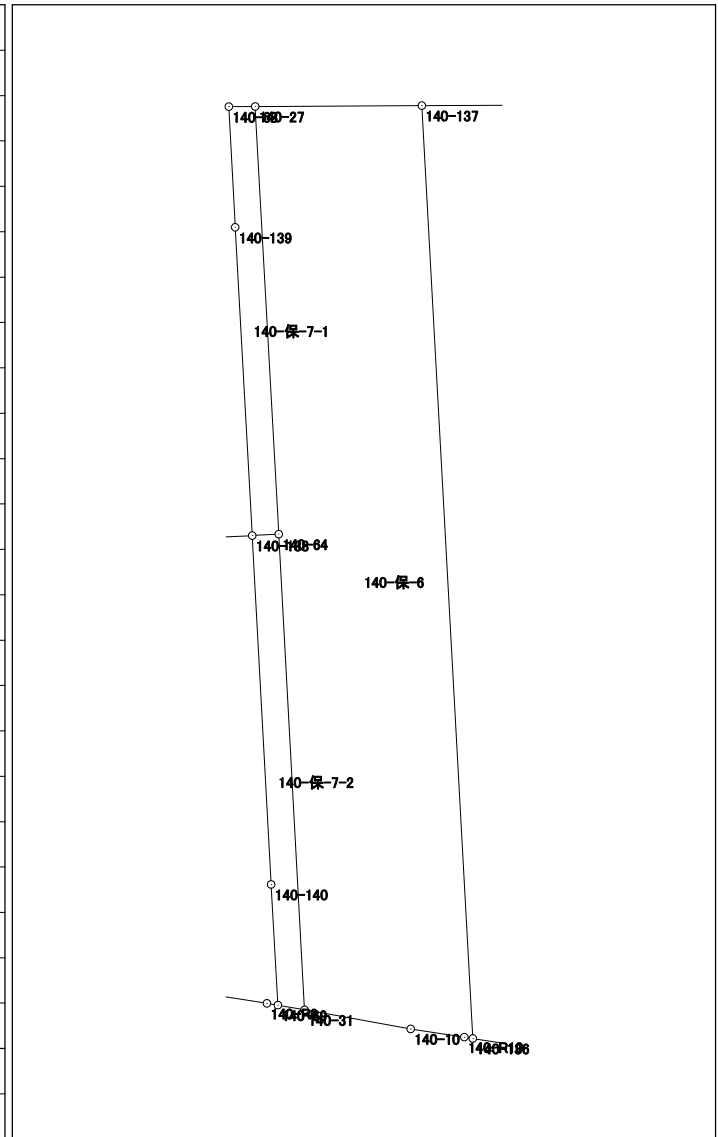


倍面積	524.017809
面積	262.0089045

# 面積計算書 (座標法)

世界測地系 (測地成果2011)

所 在	地 番	公簿地目	現況地目	地 積	所 有 者
前橋市六供町五丁目	140-保-7-1			19.50 m <sup>2</sup>	

点 名	X 座標	Y 座標	辺 長	方 向 角	測 角	DX	倍 積 (Y×DX)
140-68	41024.733	-67758.676	5.000	177-00-28	87-16-13	-4.998	338657.862648
140-139	41019.740	-67758.415	12.775	176-49-22	179-48-54	-17.748	1202576.349420
140-138	41006.985	-67757.707	1.097	86-51-49	90-02-27	-12.695	860184.090365
140-64	41007.045	-67756.612	17.720	356-51-08	89-59-19	17.753	-1202883.132836
140-27	41024.738	-67757.585	1.091	269-44-15	92-53-07	17.688	-1198496.163480
倍面積							39.006117
面 積							19.5030585

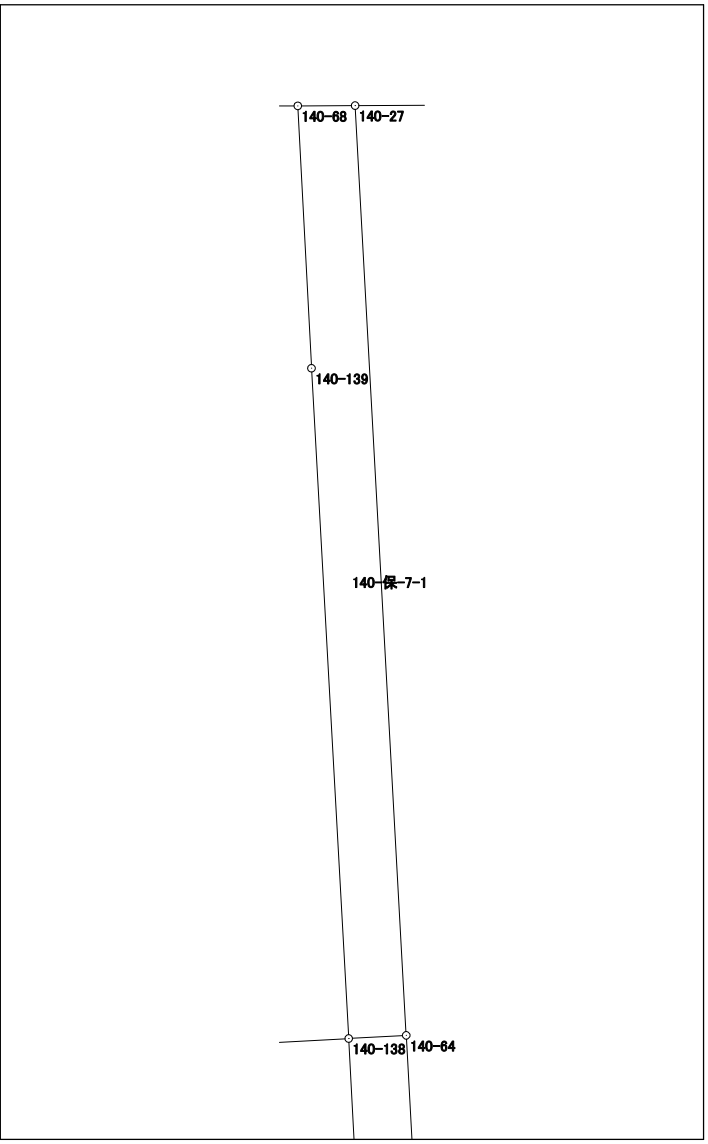


# 面積計算書 (座標法)

世界測地系 (測地成果2011)

所在	地番	公簿地目	現況地目	地積	所有者
前橋市六供町五丁目	140-保-7-2			21.50 m <sup>2</sup>	

点名	X 座標	Y 座標	辺長	方向角	測角	DX	倍積 (Y×DX)
140-69	40987.557	-67756.646	1.121	99-54-58	103-07-33	-5.186	351385.966156
140-31	40987.364	-67755.542	19.710	356-53-17	76-58-19	19.488	-1320420.002496
140-64	41007.045	-67756.612	1.097	266-51-49	89-58-32	19.621	-1329452.484052
140-138	41006.985	-67757.707	14.456	176-54-11	90-02-22	-14.495	982147.962965
140-140	40992.550	-67756.926	5.001	176-47-25	179-53-14	-19.428	1316381.558328

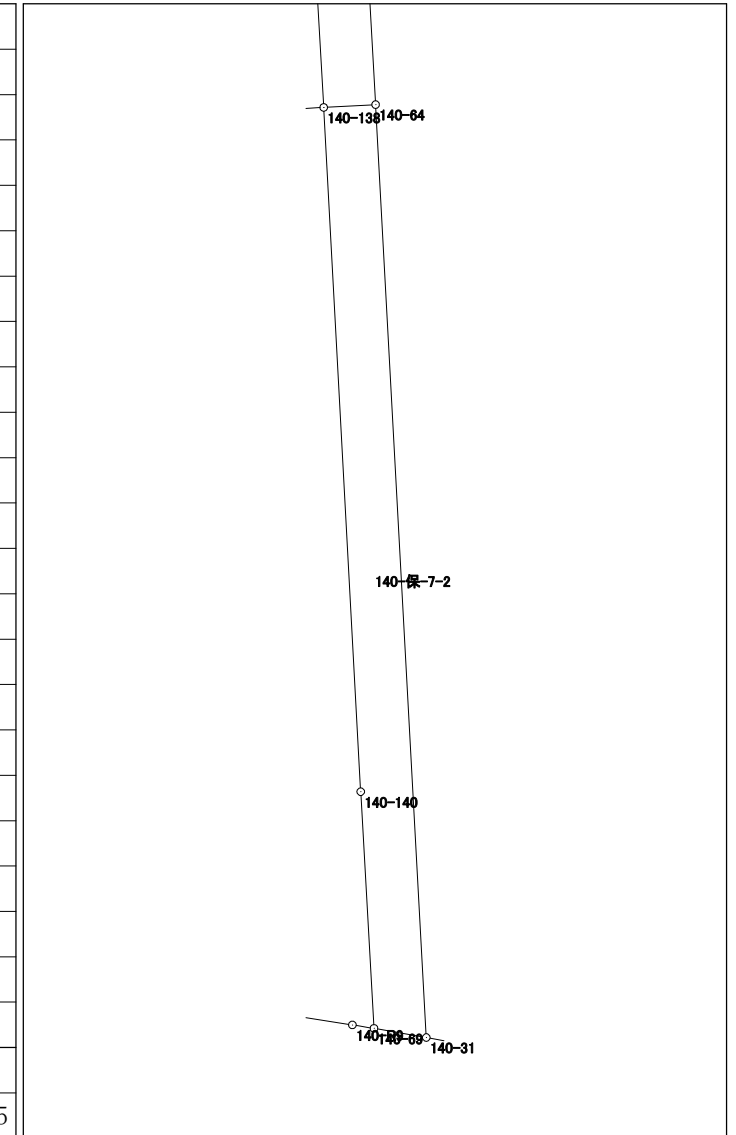

倍面積	43.000901
面積	21.5004505



# 面積計算書 (座標法)

世界測地系 (測地成果2011)

所在	地番	公簿地目	現況地目	地積	所有者
前橋市六供町五丁目	140-保-8			20.00 m <sup>2</sup>	


点名	X 座標	Y 座標	辺長	方向角	測角	DX	倍積 (Y×DX)		
140-114	41025.070	-67696.225	0.609	269-43-04	89-59-57	32.969	-2231876.842025		
140-112	41025.067	-67696.834	29.657	179-42-58	89-59-54	-29.660	2007888.096440		
140-111-2	40995.410	-67696.687	3.136	179-44-39	180-01-41	-32.793	2219977.456791		
140-111	40992.274	-67696.673	0.635	106-05-39	106-21-00	-3.312	224211.380976		
140-113	40992.098	-67696.063	32.972	359-43-07	73-37-28	32.796	-2220160.082148		
倍面積							40.010034		
面積							20.0050170		

# 面積計算書（座標法）

世界測地系（測地成果2011）

所在	地番	公簿地目	現況地目	地積	所有者
前橋市六供町五丁目	140-保-9			79.00 m <sup>2</sup>	

点名	X座標	Y座標	辺長	方向角	測角	DX	倍積 (Y×DX)
140-109	41006.839	-67686.738	18.282	359-38-11	89-54-53	18.303	-1238870.365614
140-110	41025.121	-67686.854	4.322	269-40-55	90-02-44	18.258	-1235826.580332
140-38	41025.097	-67691.176	18.279	179-38-00	89-57-05	-18.303	1238951.594328
140-42	41006.818	-67691.059	4.321	89-43-18	90-05-18	-18.258	1235903.355222

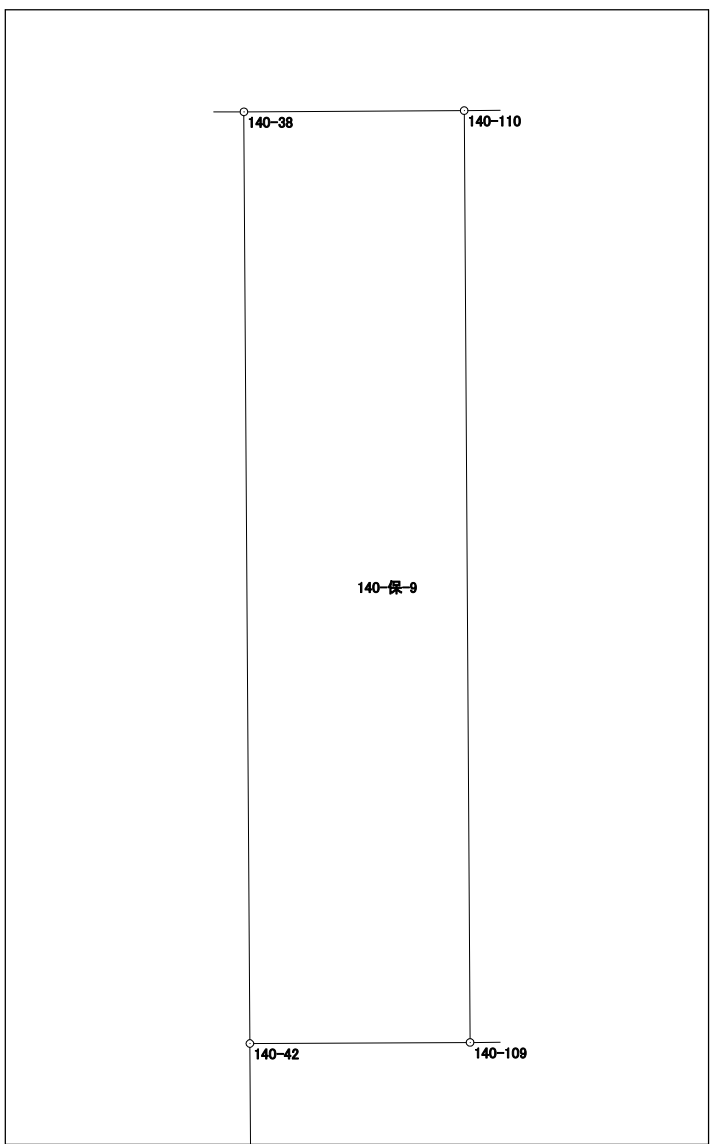

倍面積	158.003604
面積	79.0018020


# 面積計算書（座標法）

世界測地系（測地成果2011）

所在	地番	公簿地目	現況地目	地積	所有者
前橋市六供町五丁目	140-保-10			31.00 m <sup>2</sup>	

点名	X座標	Y座標	辺長	方向角	測角	DX	倍積 (Y×DX)
140-108	41025.024	-67704.809	1.024	269-43-13	90-00-02	30.440	-2060934.385960
140-106	41025.019	-67705.833	27.145	179-43-02	89-59-49	-27.150	1838213.365950
140-105-2	40997.874	-67705.699	3.000	179-42-49	179-59-47	-30.145	2040988.296355
140-105	40994.874	-67705.684	1.066	106-04-15	106-21-26	-3.295	223090.228780
140-107	40994.579	-67704.660	30.445	359-43-11	73-38-56	30.150	-2041295.499000

倍面積	62.006125
面積	31.0030625

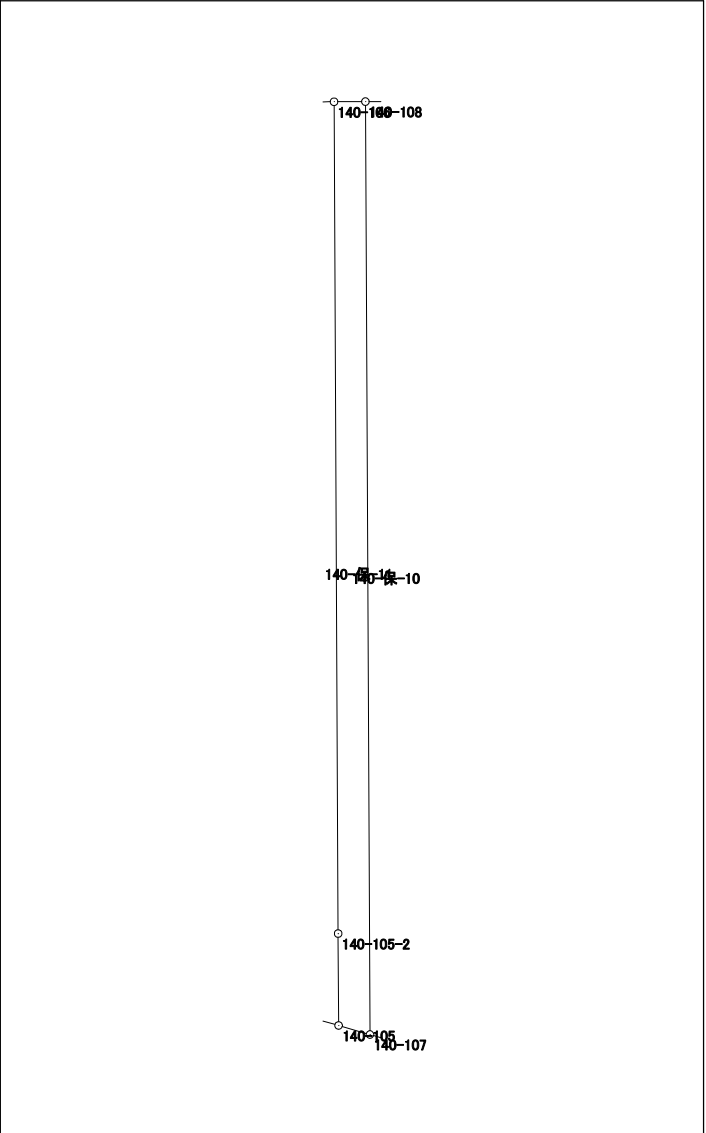


## 面積計算書 (座標法)

世界測地系 (測地成果2011)

所 在	地 番	公簿地目	現況地目	地 積	所 有 者
前橋市六供町五丁目	140-保-11			22.35 m <sup>2</sup>	

点 名	X 座標	Y 座標	辺 長	方 向 角	測 角	DX	倍 積 (Y×DX)
140-105-2	40997.874	-67705.699	27.145	359-43-02	180-00-13	30.145	-2040988.296355
140-106	41025.019	-67705.833	0.744	269-41-31	89-58-29	27.141	-1837604.013453
140-28	41025.015	-67706.577	29.925	179-43-07	90-01-36	-29.929	2026390.143033
140-33	40995.090	-67706.430	0.777	106-08-53	106-25-46	-30.141	2040739.506630
140-105	40994.874	-67705.684	3.000	359-42-49	73-33-56	2.784	-188492.624256

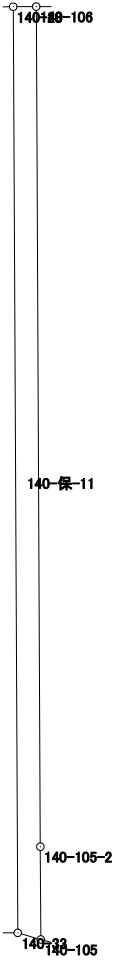


倍面積	44.715599
面積	22.3577995

# 面積計算書 (座標法)

世界測地系 (測地成果2011)

所在	地番	公簿地目	現況地目	地積	所有者
前橋市六供町五丁目	140-保-12			54.00 m <sup>2</sup>	

点名	X座標	Y座標	辺長	方向角	測角	DX	倍積 (Y×DX)
140-125	40951.456	-67620.186	14.801	306-32-58	89-55-06	11.742	-793996.224012
140-126	40960.270	-67632.076	3.649	216-37-52	90-04-54	5.886	-398082.399336
140-124	40957.342	-67634.253	14.801	126-32-58	89-55-06	-11.742	794161.398726
140-123	40948.528	-67622.363	3.649	36-37-52	90-04-54	-5.886	398025.228618

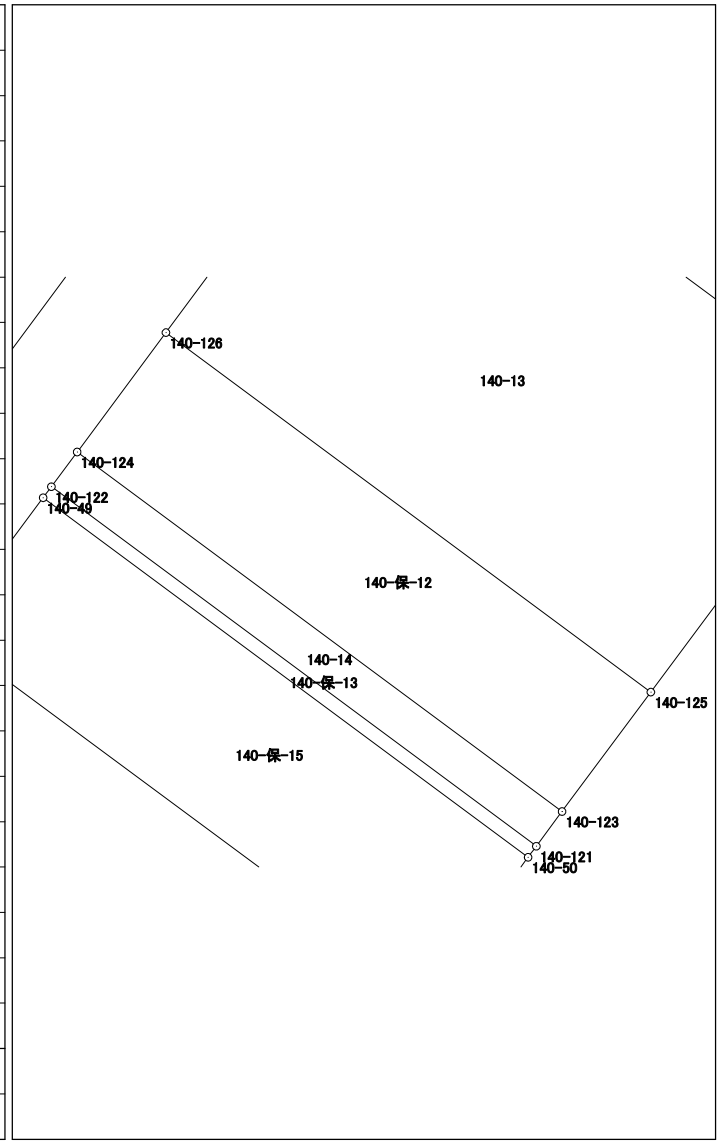


倍面積	108.003996
面積	54.0019980

# 面積計算書（座標法）

世界測地系（測地成果2011）

所 在	地 番	公簿地目	現況地目	地 積	所 有 者
前橋市六供町五丁目	140-保-13			5.00 m <sup>2</sup>	

点 名	X 座標	Y 座標	辺 長	方 向 角	測 角	DX	倍 積 (Y×DX)
140-121	40947.677	-67622.994	14.802	306-33-01	89-51-00	9.086	-614422.523484
140-122	40956.492	-67634.885	0.338	216-42-01	90-09-00	8.544	-577872.457440
140-49	40956.221	-67635.087	14.802	126-33-01	89-51-00	-9.086	614532.400482
140-50	40947.406	-67623.196	0.338	36-42-01	90-09-00	-8.544	577772.586624

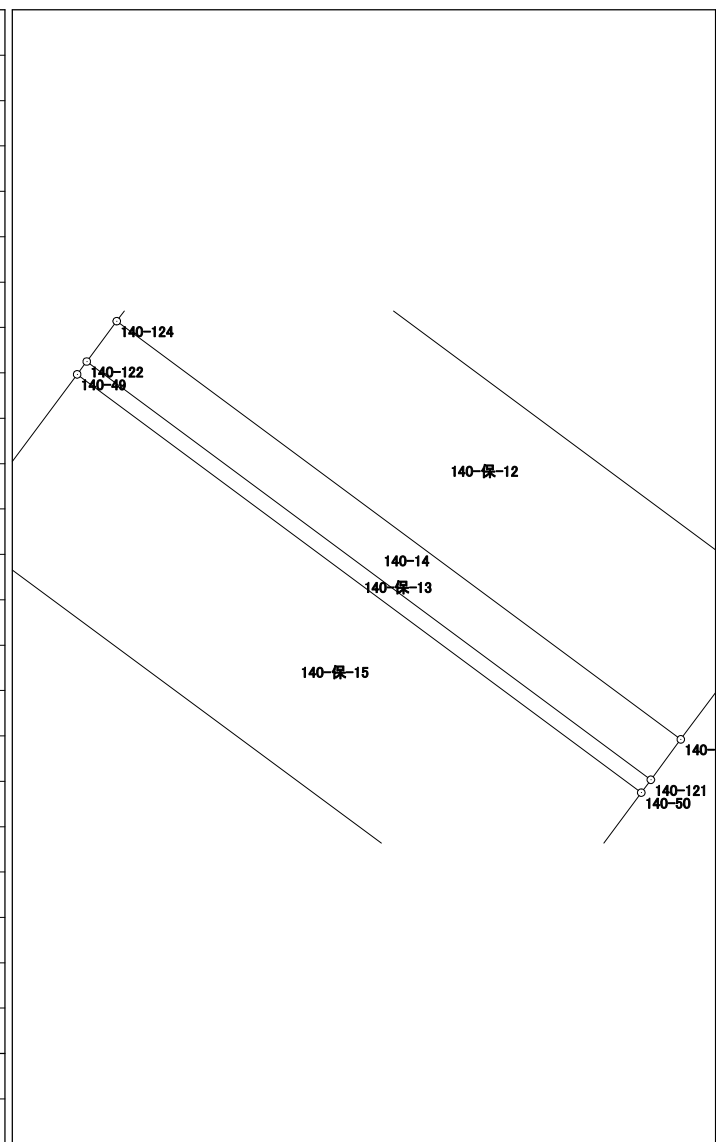


倍面積	10.006182
面 積	5.0030910

## 面積計算書（座標法）

世界測地系（測地成果2011）

所在	地番	公簿地目	現況地目	地積	所有者
前橋市六供町五丁目	140-保-15			60.99 m <sup>2</sup>	

点名	X座標	Y座標	辺長	方向角	測角	DX	倍積 (Y×DX)
140-49	40956.221	-67635.087	4.127	216-35-12	90-02-11	5.501	-372060.613587
140-48	40952.907	-67637.547	14.803	126-29-54	89-54-42	-12.119	819699.432093
140-47	40944.102	-67625.647	4.114	36-34-09	90-04-15	-5.501	372008.684147
140-50	40947.406	-67623.196	14.802	306-33-01	89-58-52	12.119	-819525.512324

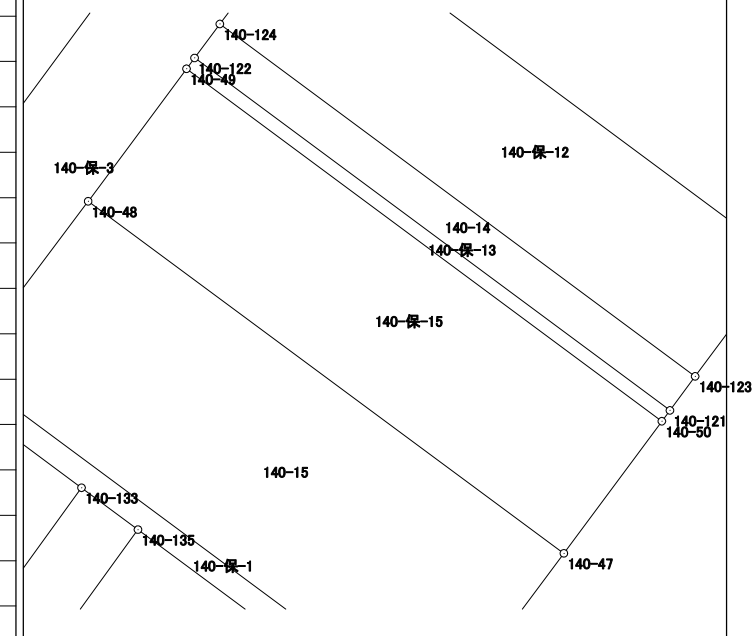

倍面積	121.990329
面積	60.9951645