




# 143街区 画地出来形確認図 (5458.58m<sup>2</sup>)

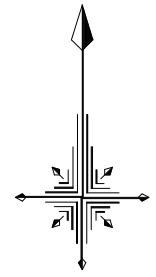

S=1/500

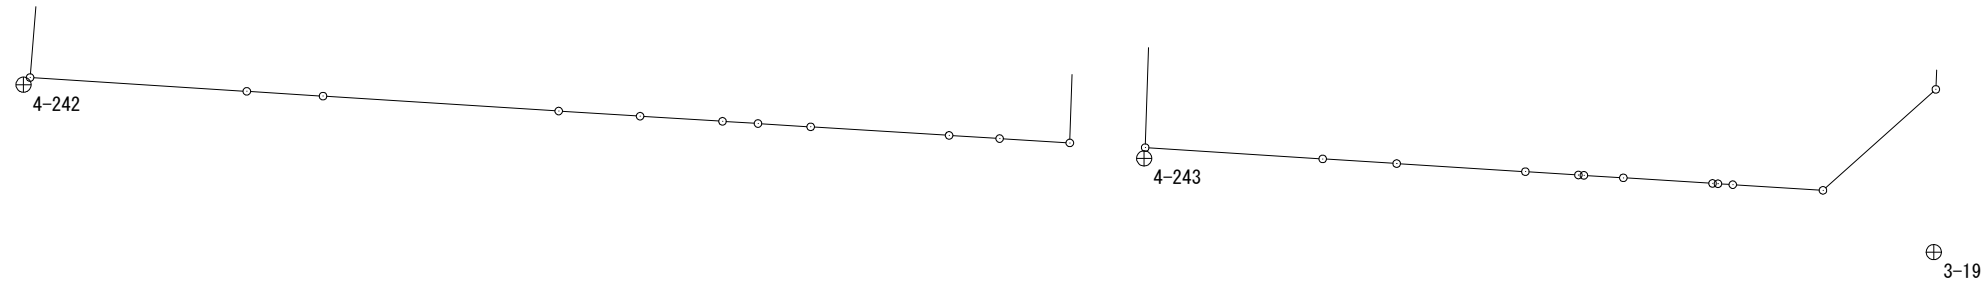

## 3. 3. 10 江田天川大島線

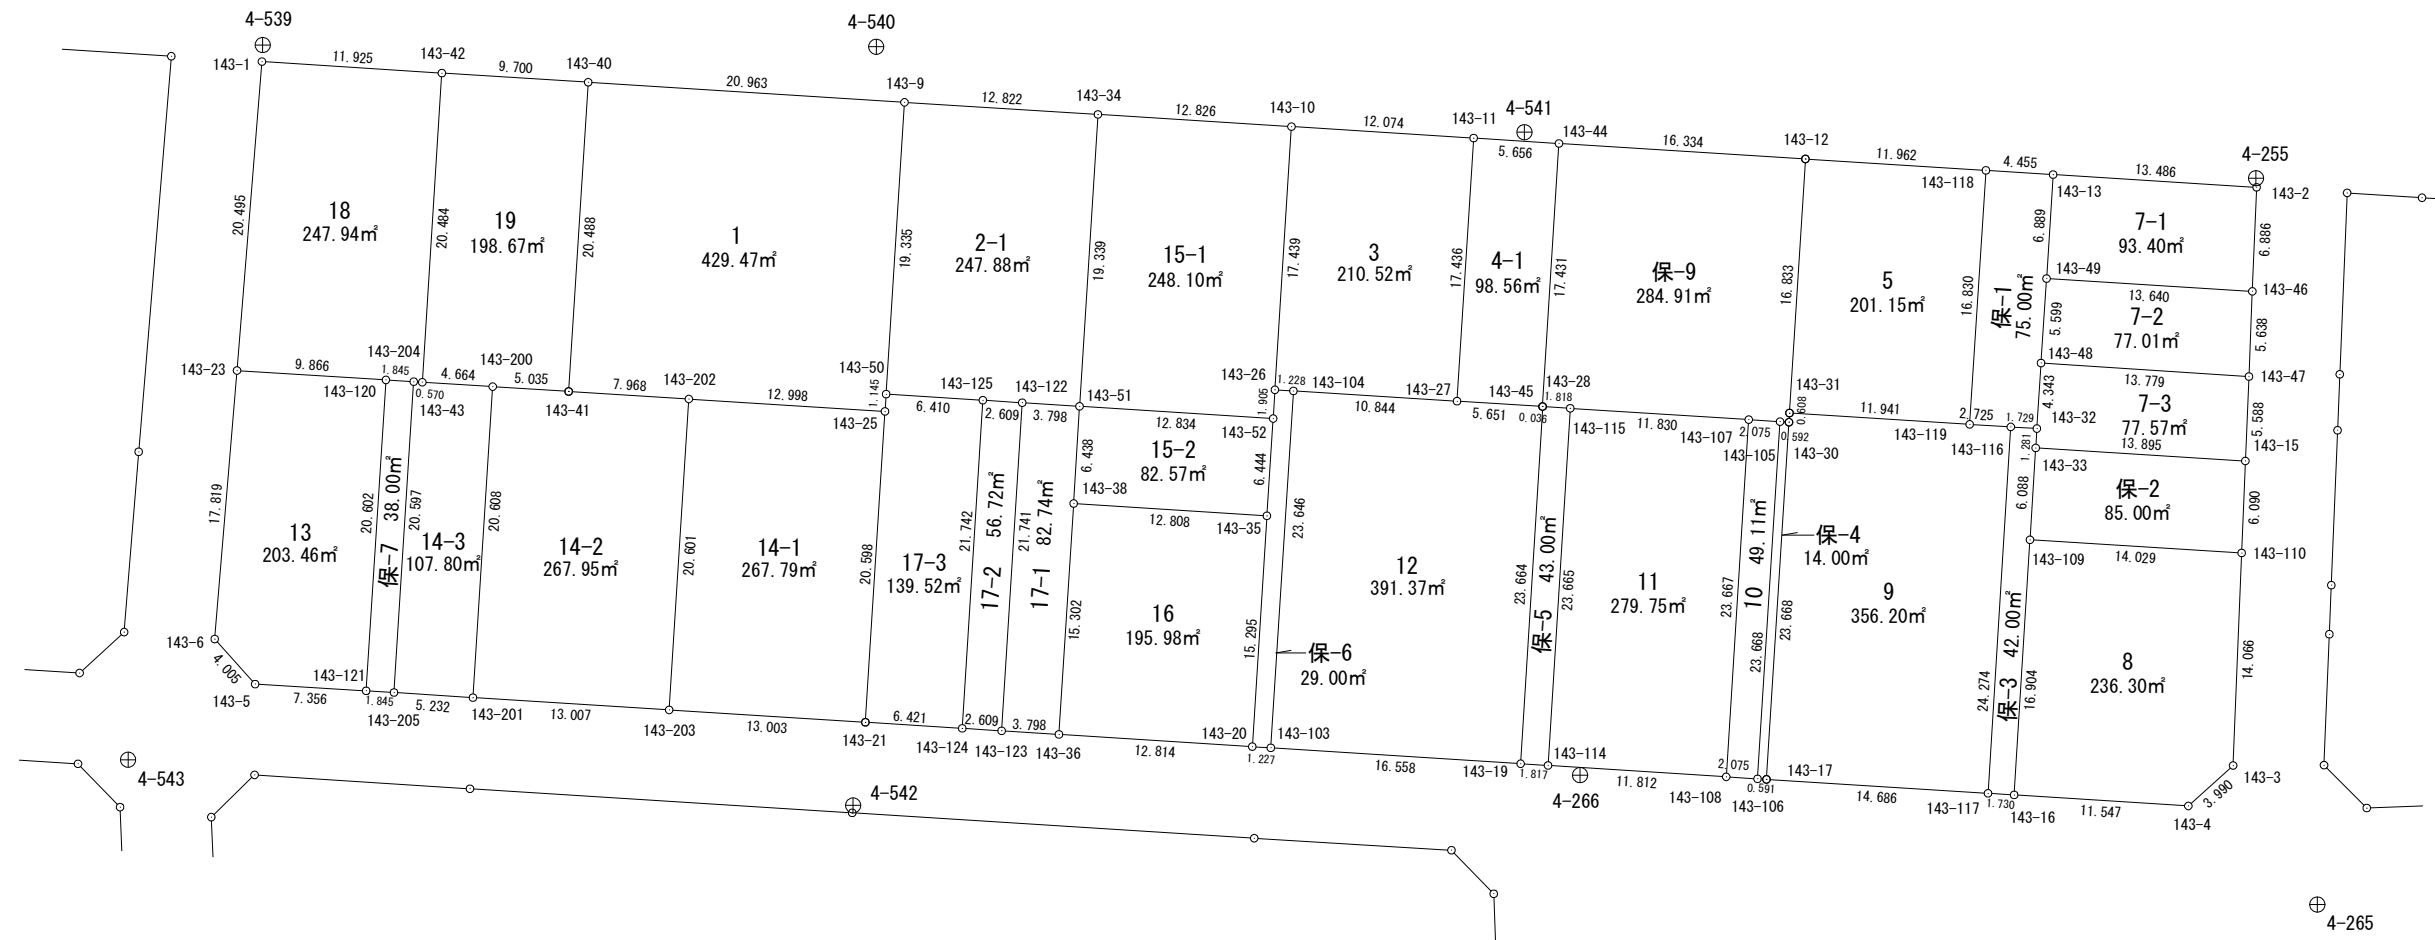


# 面積計算書（座標法）

世界測地系（測地成果2011）

所在	地番	公簿地目	現況地目	地積	所有者
前橋市六供町五丁目	143-1			429.47 m <sup>2</sup>	

点名	X座標	Y座標	辺長	方向角	測角	DX	倍積 (Y×DX)
143-40	41159.072	-67670.899	20.488	183-37-06	89-59-10	-19.119	1293799.917981
143-41	41138.625	-67672.192	7.968	93-36-18	89-59-12	-20.948	1417597.078016
143-202	41138.124	-67664.240	12.998	93-36-45	180-00-27	-1.320	89316.796800
143-25	41137.305	-67651.268	1.145	3-51-27	90-14-42	0.323	-21851.359564
143-50	41138.447	-67651.191	19.335	3-35-49	179-44-22	20.439	-1382722.692849
143-9	41157.744	-67649.978	20.963	273-37-56	90-02-07	20.625	-1395280.796250

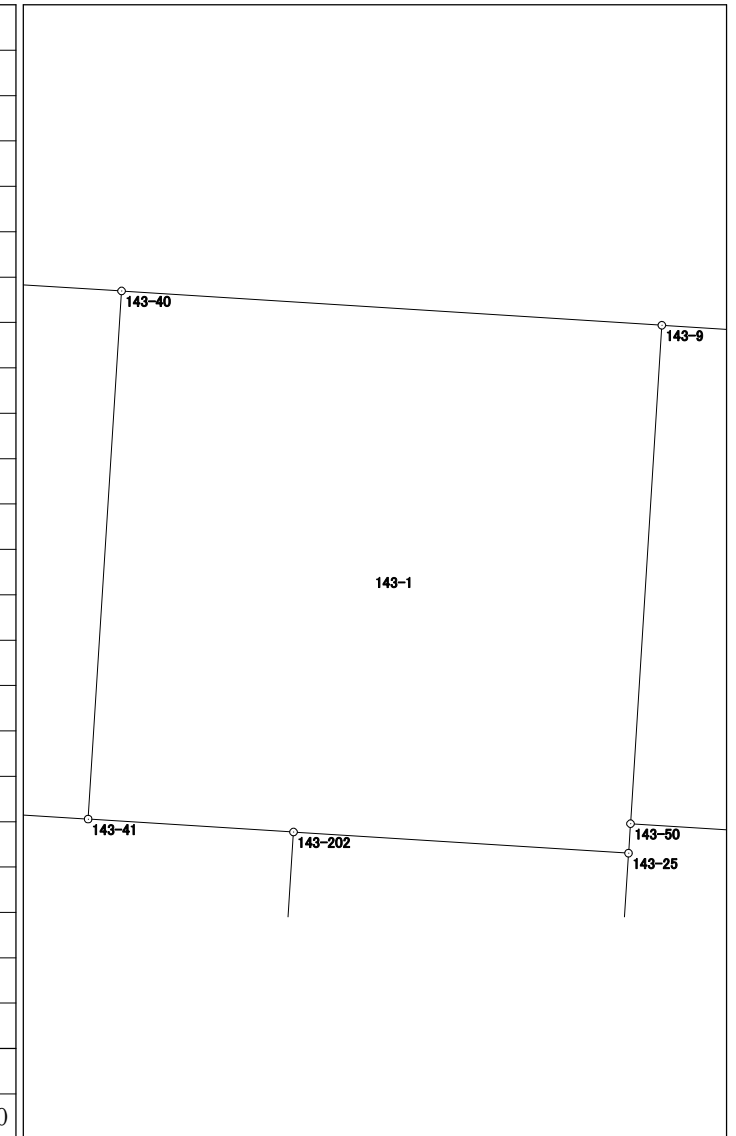


倍面積	858.944134
面積	429.4720670

# 面積計算書（座標法）

世界測地系（測地成果2011）

所在	地番	公簿地目	現況地目	地積	所有者
前橋市六供町五丁目	143-2-1			247.88 m <sup>2</sup>	

点名	X座標	Y座標	辺長	方向角	測角	DX	倍積 (Y×DX)
143-9	41157.744	-67649.978	19.335	183-35-49	90-00-55	-18.496	1251253.993088
143-50	41138.447	-67651.191	6.410	93-35-45	89-59-56	-19.699	1332660.811509
143-125	41138.045	-67644.794	2.609	93-36-13	180-00-28	-0.566	38286.953404
143-122	41137.881	-67642.190	3.798	93-36-30	180-00-17	-0.403	27259.802570
143-51	41137.642	-67638.400	19.339	3-36-50	90-00-20	19.062	-1289323.180800
143-34	41156.943	-67637.181	12.822	273-34-54	89-58-04	20.102	-1359642.612462
						倍面積	495.767309
						面積	247.8836545

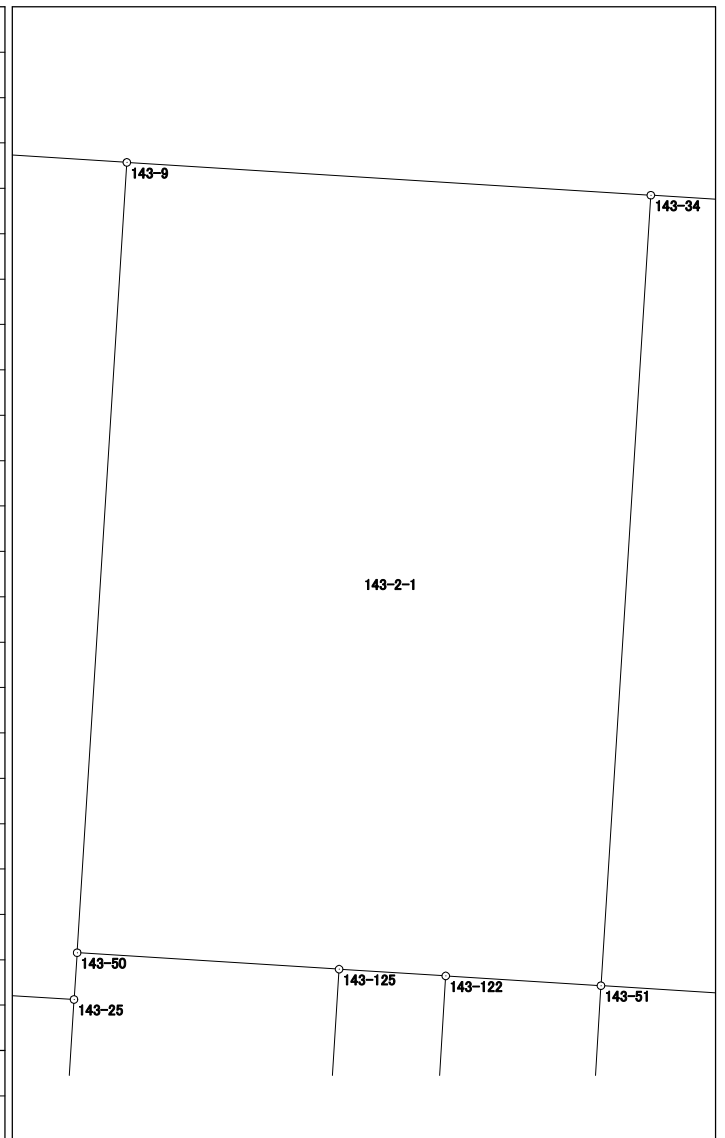


## 面積計算書 (座標法)

世界測地系 (測地成果2011)

所在	地番	公簿地目	現況地目	地積	所有者
前橋市六供町五丁目	143-3			210.52 m <sup>2</sup>	

点名	X座標	Y座標	辺長	方向角	測角	DX	倍積 (Y×DX)
143-10	41156.139	-67624.380	17.439	183-36-24	90-00-43	-16.647	1125743.053860
143-26	41138.735	-67625.477	1.228	93-35-38	89-59-14	-17.481	1182160.963437
143-104	41138.658	-67624.251	10.844	93-34-45	179-59-07	-0.754	50988.685254
143-27	41137.981	-67613.428	17.436	3-36-38	90-01-53	16.724	-1130766.969872
143-11	41155.382	-67612.330	12.074	273-35-41	89-59-03	18.158	-1227704.688140
						倍面積	421.044539
						面積	210.5222695

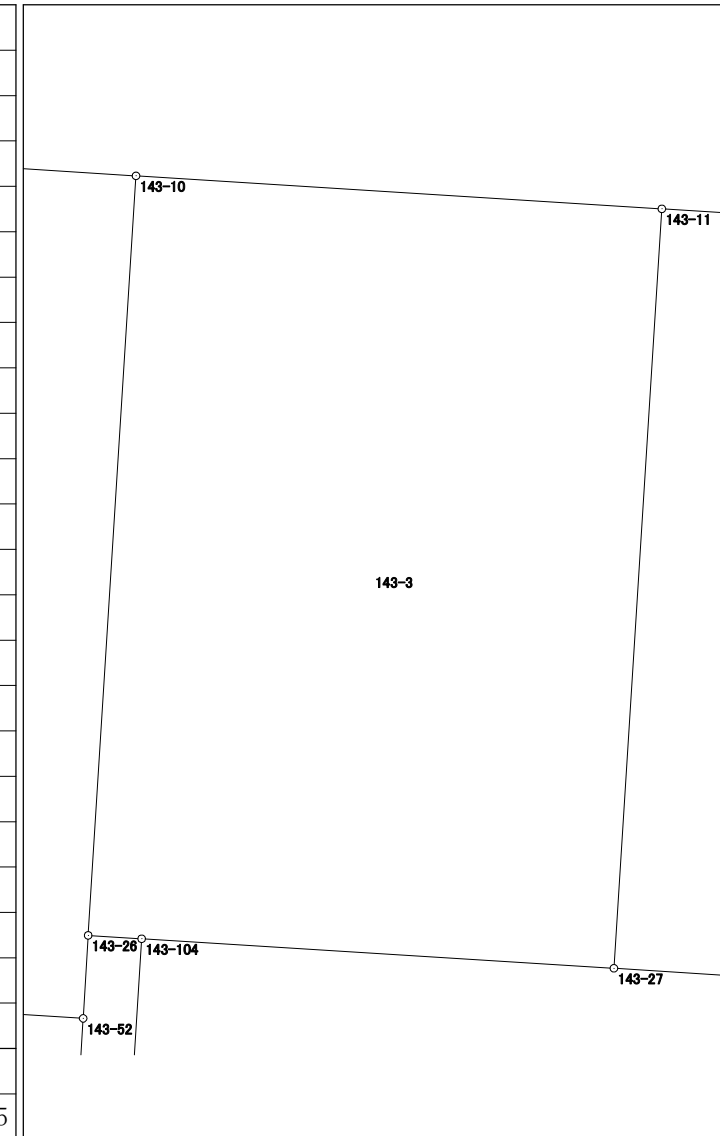


# 面積計算書 (座標法)

世界測地系 (測地成果2011)

所在	地番	公簿地目	現況地目	地積	所有者
前橋市六供町五丁目	143-4-1			98.56 m <sup>2</sup>	

点名	X座標	Y座標	辺長	方向角	測角	DX	倍積 (Y×DX)
143-11	41155.382	-67612.330	17.436	183-36-38	89-59-31	-17.044	1152384.552520
143-27	41137.981	-67613.428	5.651	93-34-17	89-57-39	-17.753	1200341.187284
143-45	41137.629	-67607.788	17.431	3-37-41	90-03-24	17.044	-1152307.138672
143-44	41155.025	-67606.685	5.656	273-37-07	89-59-26	17.753	-1200221.478805
						倍面積	197.122327
						面積	98.5611635

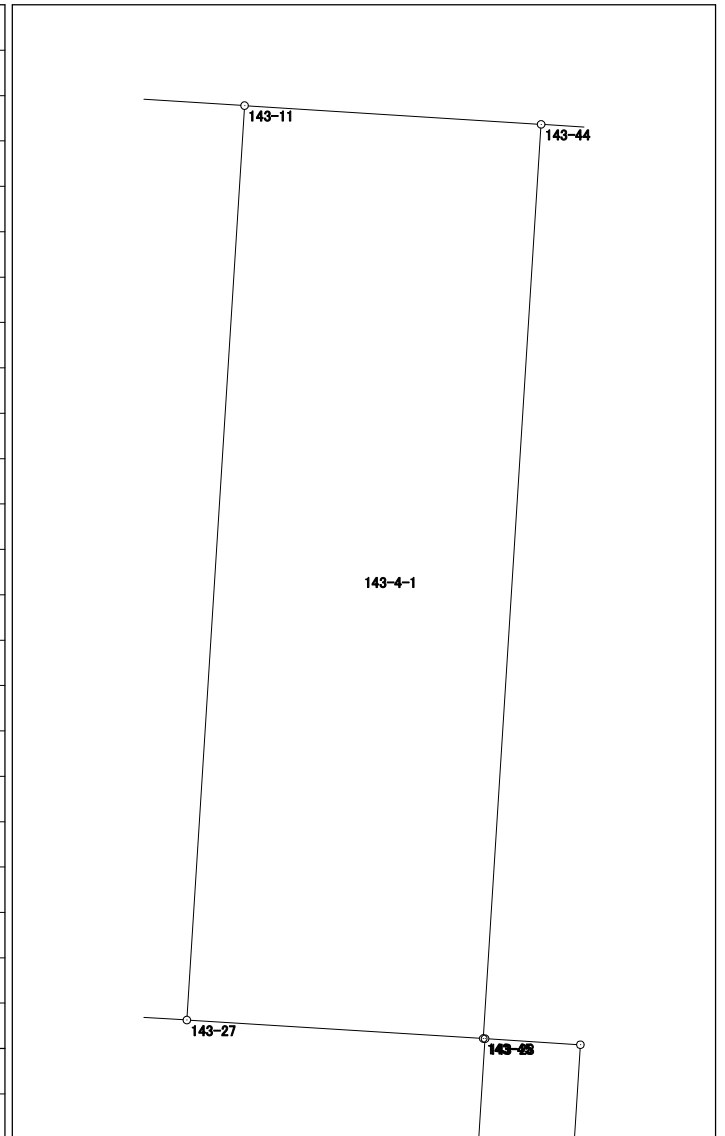

## 面積計算書（座標法）

世界測地系（測地成果2011）


所 在	地 番	公簿地目	現況地目	地 積	所 有 者
前橋市六供町五丁目	143-5			201.15 m <sup>2</sup>	

点 名	X 座標	Y 座標	辺 長	方 向 角	測 角	DX	倍 積 (Y×DX)	
143-118	41153.246	-67578.445	11.962	273-36-33	89-57-02	17.549	-1185934.131305	
143-12	41153.999	-67590.383	16.833	183-35-11	89-58-38	-16.047	1084622.876001	
143-31	41137.199	-67591.436	11.941	93-35-47	90-00-36	-17.549	1186162.110364	
143-119	41136.450	-67579.519	16.830	3-39-31	90-03-44	16.047	-1084448.541393	
						倍面積	402.313667	
						面 積	201.1568335	

# 面積計算書（座標法）

世界測地系（測地成果2011）

所在	地番	公簿地目	現況地目	地積	所有者
前橋市六供町五丁目	143-7-1			93.40 m <sup>2</sup>	

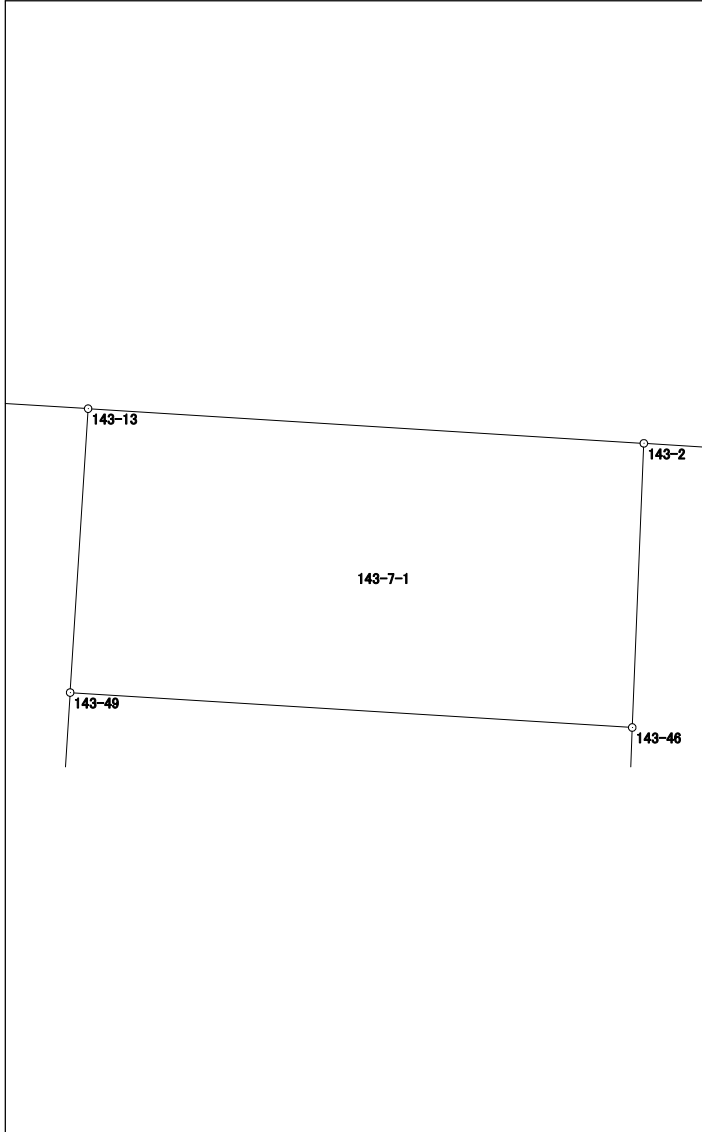
点名	X座標	Y座標	辺長	方向角	測角	DX	倍積(Y×DX)		
143-13	41152.966	-67573.999	6.889	183-37-14	90-02-43	-6.034	407741.509966		
143-49	41146.091	-67574.434	13.640	93-33-21	89-56-07	-7.721	521742.204914		
143-46	41145.245	-67560.820	6.886	2-20-20	88-46-59	6.034	-407661.987880		
143-2	41152.125	-67560.539	13.486	273-34-31	91-14-11	7.721	-521634.921619		
							倍面積		186.805381
							面積		93.4026905

# 面積計算書 (座標法)

世界測地系 (測地成果2011)

所在	地番	公簿地目	現況地目	地積	所有者
前橋市六供町五丁目	143-7-2			77.01 m <sup>2</sup>	

点名	X座標	Y座標	辺長	方向角	測角	Dx	倍積 (Y×Dx)
143-49	41146.091	-67574.434	5.599	183-42-26	90-09-05	-4.741	320370.391594
143-48	41140.504	-67574.796	13.779	93-42-42	90-00-16	-6.479	437817.103284
143-47	41139.612	-67561.046	5.638	2-17-51	88-35-09	4.741	-320306.919086
143-46	41145.245	-67560.820	13.640	273-33-21	91-15-30	6.479	-437726.552780

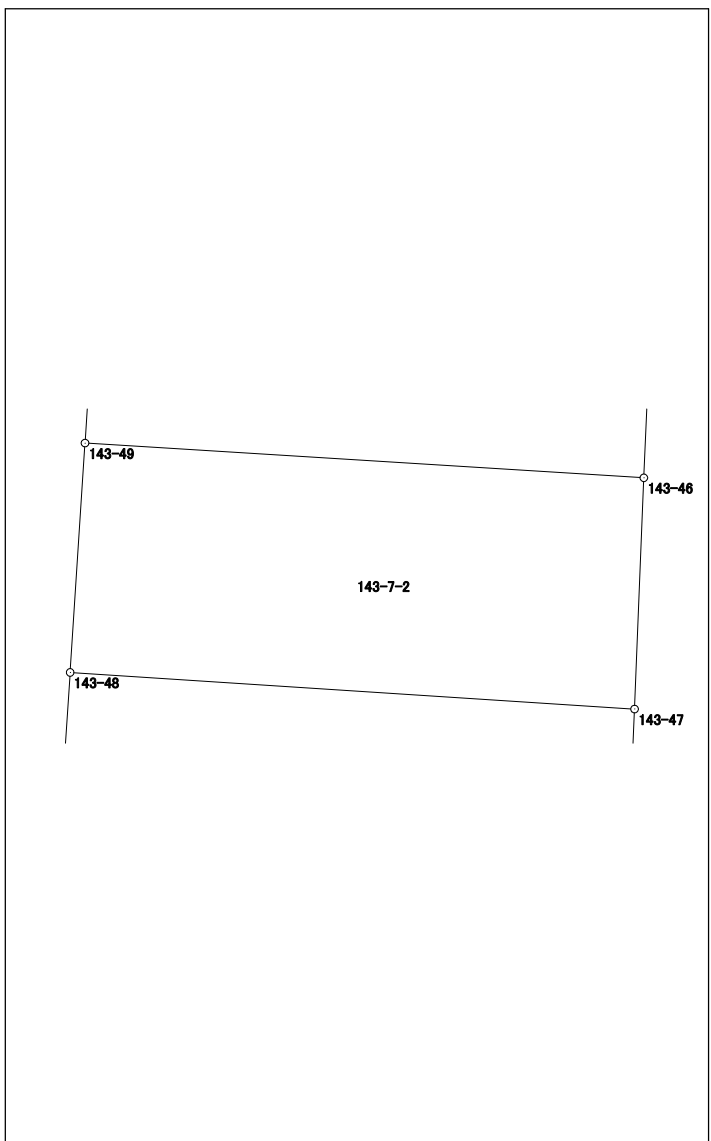

倍面積	154.023012
面積	77.0115060








# 面積計算書（座標法）

世界測地系（測地成果2011）

所在	地番	公簿地目	現況地目	地積	所有者
前橋市六供町五丁目	143-9			356.20 m <sup>2</sup>	

点名	X座標	Y座標	辺長	方向角	測角	DX	倍積 (Y×DX)
143-116	41136.279	-67576.799	2.725	273-35-50	90-02-33	24.398	-1648738.742002
143-119	41136.450	-67579.519	11.941	273-35-47	179-59-57	0.920	-62173.157480
143-31	41137.199	-67591.436	0.608	183-12-21	89-36-34	0.142	-9597.983912
143-30	41136.592	-67591.470	23.668	183-36-43	180-24-22	-24.228	1637606.135160
143-17	41112.971	-67592.961	14.686	93-35-16	89-58-33	-24.540	1658731.262940
143-117	41112.052	-67578.304	24.274	3-33-17	89-58-01	23.308	-1575115.109632
倍面積							712.405074
面積							356.2025370

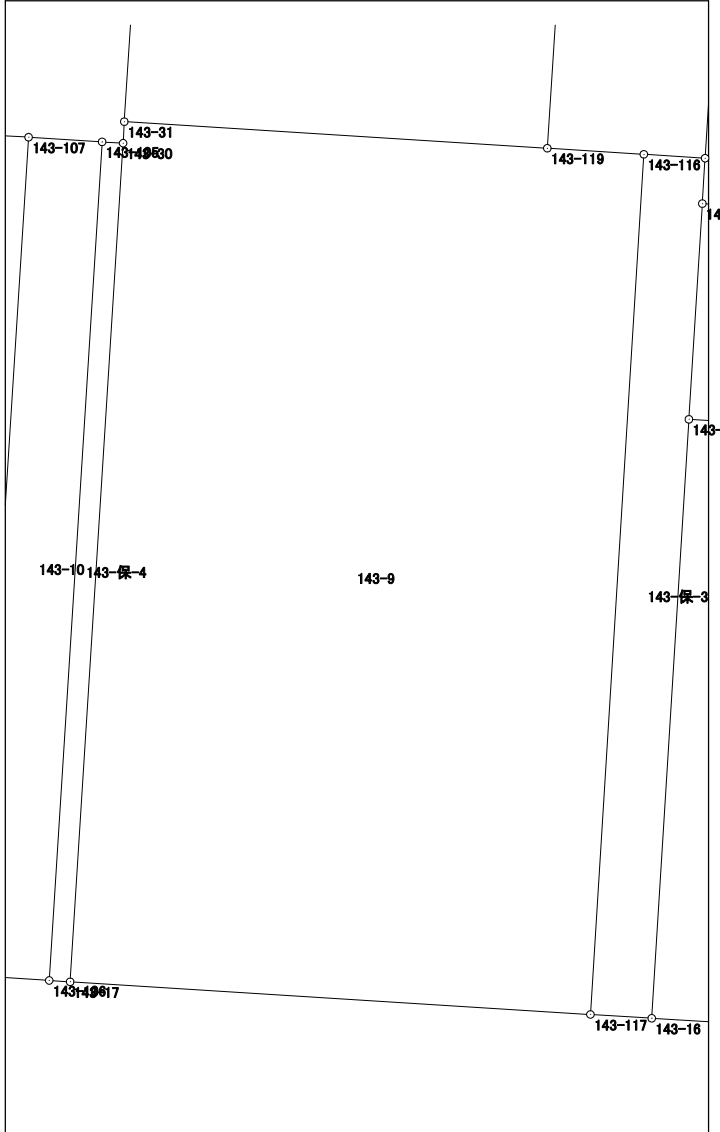














# 面積計算書 (座標法)

世界測地系 (測地成果2011)

所在	地番	公簿地目	現況地目	地積	所有者
前橋市六供町五丁目	143-14-2			267.95 m <sup>2</sup>	

点名	X座標	Y座標	辺長	方向角	測角	Dx	倍積 (Y×Dx)
143-200	41138.945	-67677.217	20.608	183-38-00	89-59-22	-20.247	1370260.612599
143-201	41118.378	-67678.523	13.007	93-35-16	89-57-16	-21.381	1447034.500263
143-203	41117.564	-67665.541	20.601	3-37-15	90-01-59	19.746	-1336123.772586
143-202	41138.124	-67664.240	7.968	273-36-18	89-59-03	21.061	-1425076.558640
143-41	41138.625	-67672.192	5.035	273-38-38	180-02-20	0.821	-55558.869632
倍面積							535.912004
面積							267.9560020

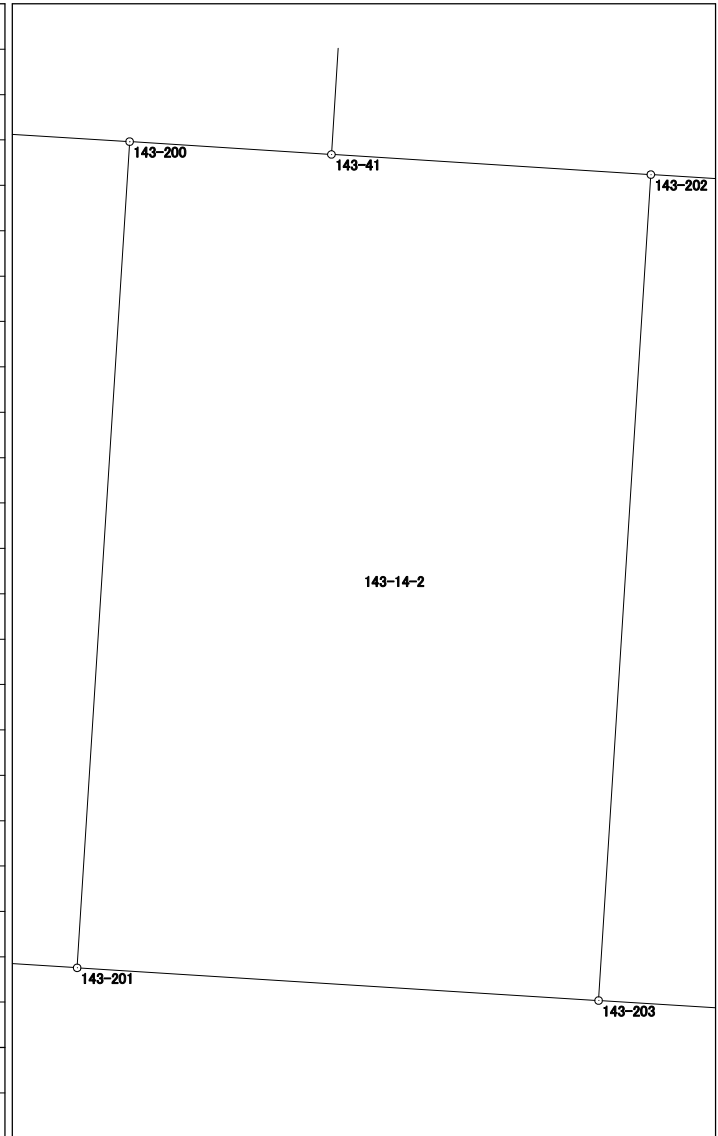


# 面積計算書 (座標法)

世界測地系 (測地成果2011)

所在	地番	公簿地目	現況地目	地積	所有者
前橋市六供町五丁目	143-14-3			107.80 m <sup>2</sup>	

点名	X座標	Y座標	辺長	方向角	測角	DX	倍積 (Y×DX)
143-204	41139.273	-67682.441	20.597	183-37-37	89-36-21	-20.516	1388572.959556
143-205	41118.717	-67683.744	5.232	93-42-54	90-05-17	-20.895	1414251.830880
143-201	41118.378	-67678.523	20.608	3-38-00	89-55-06	20.228	-1369001.163244
143-200	41138.945	-67677.217	4.664	273-32-25	89-54-25	20.855	-1411408.360535
143-43	41139.233	-67681.872	0.570	274-01-16	180-28-51	0.328	-22199.654016

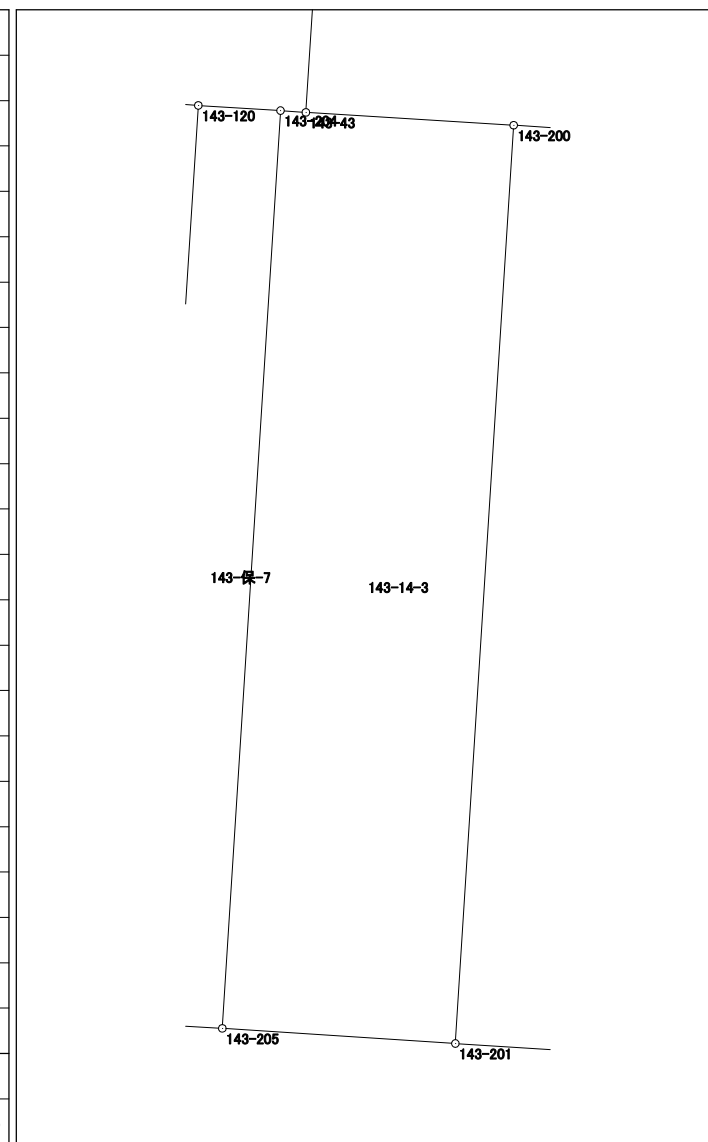


倍面積	215.612641
面積	107.8063205

## 面積計算書 (座標法)

世界測地系 (測地成果2011)

所 在	地 番	公簿地目	現況地目	地 積	所 有 者
前橋市六供町五丁目	143-15-1			248.10 m <sup>2</sup>	

点 名	X 座標	Y 座標	辺 長	方 向 角	測 角	DX	倍 積 (Y×DX)
143-34	41156.943	-67637.181	19.339	183-36-50	90-01-12	-18.497	1251084.936957
143-51	41137.642	-67638.400	12.834	93-36-51	90-00-01	-20.110	1360208.224000
143-52	41136.833	-67625.592	1.905	3-27-36	89-50-45	1.093	-73914.772056
143-26	41138.735	-67625.477	17.439	3-36-24	180-08-48	19.306	-1305577.458962
143-10	41156.139	-67624.380	12.826	273-35-38	89-59-14	18.208	-1231304.711040

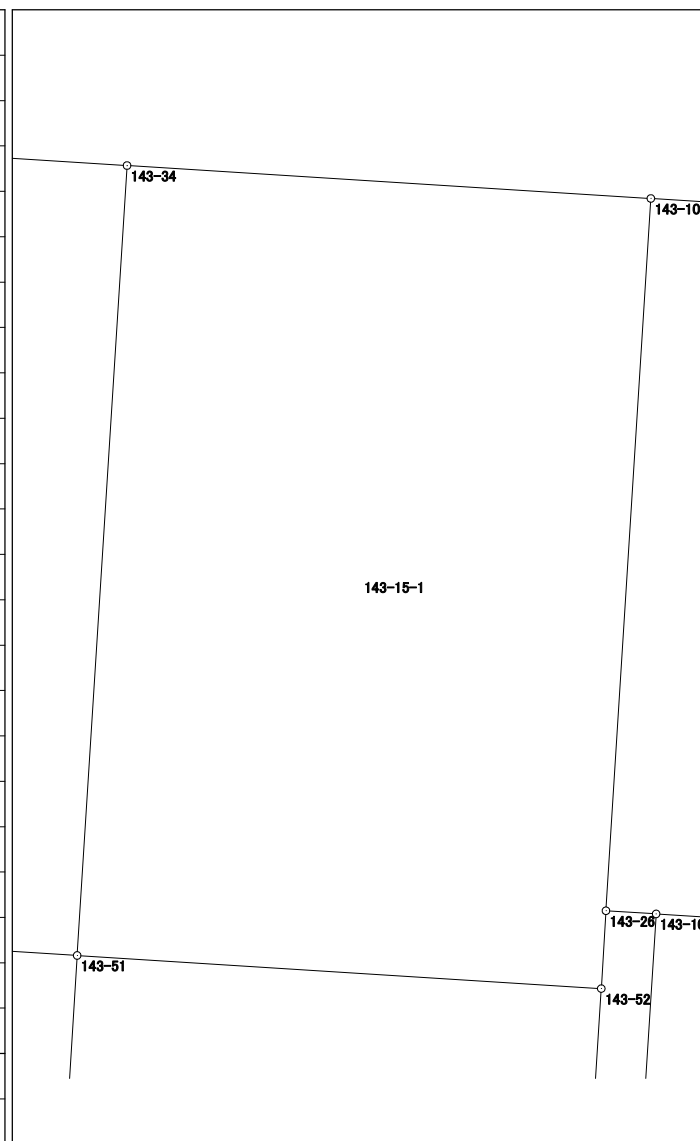


倍面積	496.218899
面 積	248.1094495

## 面積計算書 (座標法)

世界測地系 (測地成果2011)

所 在	地 番	公簿地目	現況地目	地 積	所 有 者
前橋市六供町五丁目	143-15-2			82.57 m <sup>2</sup>	

点 名	X 座標	Y 座標	辺 長	方 向 角	測 角	DX	倍 積 (Y×DX)
143-51	41137.642	-67638.400	6.438	183-26-47	89-49-56	-5.617	379924.892800
143-38	41131.216	-67638.787	12.808	93-38-38	90-11-51	-7.240	489704.817880
143-35	41130.402	-67626.005	6.444	3-40-28	90-01-50	5.617	-379855.270085
143-52	41136.833	-67625.592	12.834	273-36-51	89-56-23	7.240	-489609.286080
						倍面積	165.154515
						面 積	82.5772575

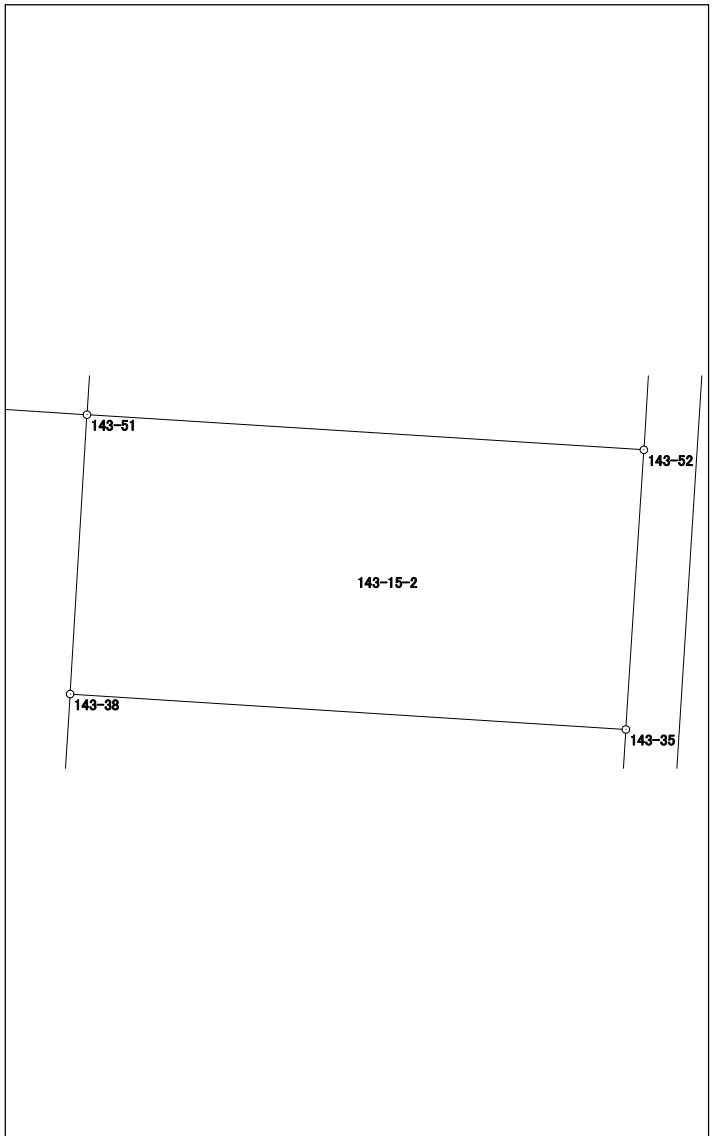




# 面積計算書（座標法）

世界測地系（測地成果2011）

所 在	地 番	公簿地目	現況地目	地 積	所 有 者
前橋市六供町五丁目	143-17-1			82.74 m <sup>2</sup>	

点 名	X 座標	Y 座標	辺 長	方 向 角	測 角	DX	倍 積 (Y×DX)
143-38	41131.216	-67638.787	6.438	3-26-47	179-47-49	21.697	-1467558.761539
143-51	41137.642	-67638.400	3.798	273-36-30	90-09-43	6.665	-450809.936000
143-122	41137.881	-67642.190	21.741	183-35-30	89-59-00	-21.459	1451533.755210
143-123	41116.183	-67643.552	3.798	93-35-32	90-00-02	-21.936	1483828.956672
143-36	41115.945	-67639.761	15.302	3-38-58	90-03-26	15.033	-1016828.527113
						倍面積	165.487230
						面 積	82.7436150

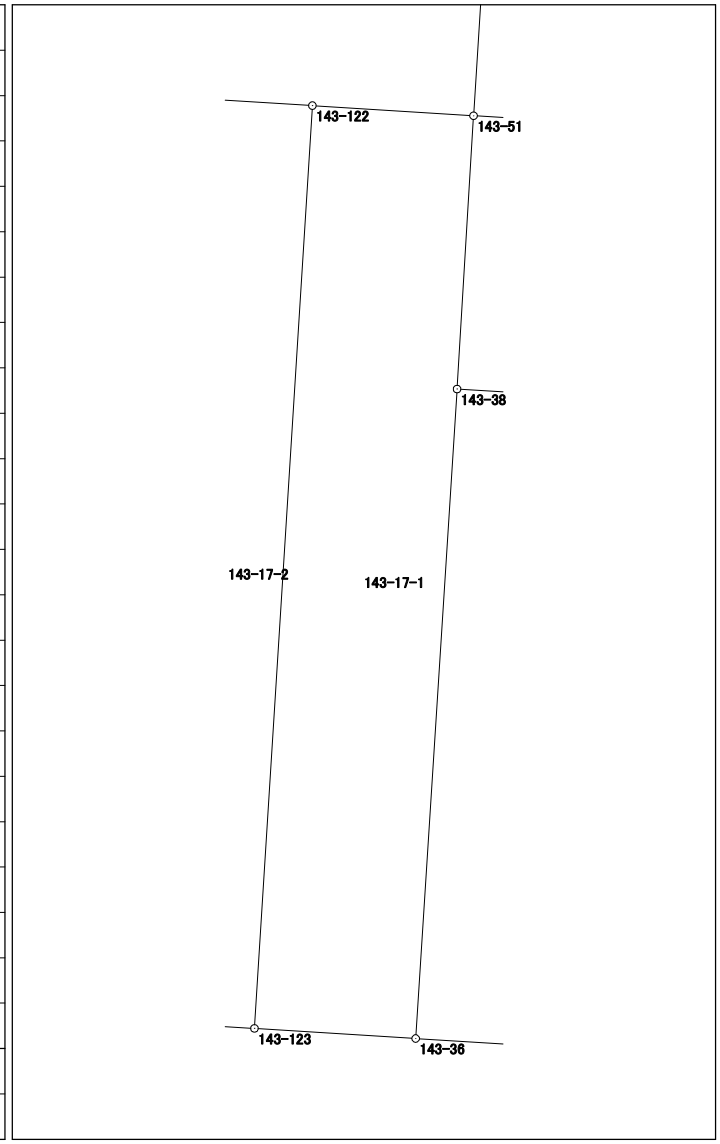


# 面積計算書 (座標法)

世界測地系 (測地成果2011)

所在	地番	公簿地目	現況地目	地積	所有者
前橋市六供町五丁目	143-17-2			56.72 m <sup>2</sup>	

点名	X座標	Y座標	辺長	方向角	測角	DX	倍積 (Y×DX)
143-124	41116.346	-67646.156	2.609	93-34-55	89-59-25	-21.862	1478880.262472
143-123	41116.183	-67643.552	21.741	3-35-30	90-00-35	21.535	-1456703.892320
143-122	41137.881	-67642.190	2.609	273-36-13	90-00-43	21.862	-1478793.557780
143-125	41138.045	-67644.794	21.742	183-35-30	89-59-17	-21.535	1456730.638790

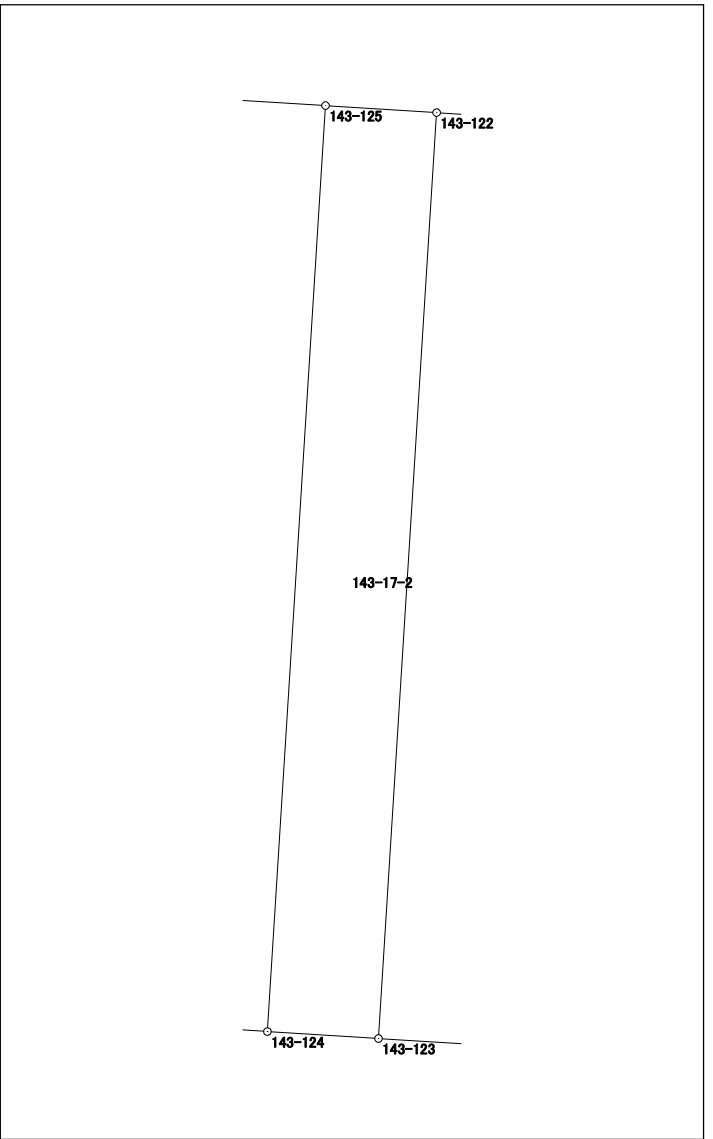


倍面積	113.451162
面積	56.7255810

# 面積計算書 (座標法)

世界測地系 (測地成果2011)

所 在	地 番	公簿地目	現況地目	地 積	所 有 者
前橋市六供町五丁目	143-17-3			139.52 m <sup>2</sup>	

点 名	X 座標	Y 座標	辺 長	方 向 角	測 角	DX	倍 積 (Y×DX)
143-21	41116.748	-67652.564	6.421	93-35-23	89-58-56	-20.959	1417930.088876
143-124	41116.346	-67646.156	21.742	3-35-30	90-00-07	21.297	-1440660.184332
143-125	41138.045	-67644.794	6.410	273-35-45	90-00-15	22.101	-1495017.592194
143-50	41138.447	-67651.191	1.145	183-51-27	90-15-42	-0.740	50061.881340
143-25	41137.305	-67651.268	20.598	183-36-27	179-45-00	-21.699	1467964.864332

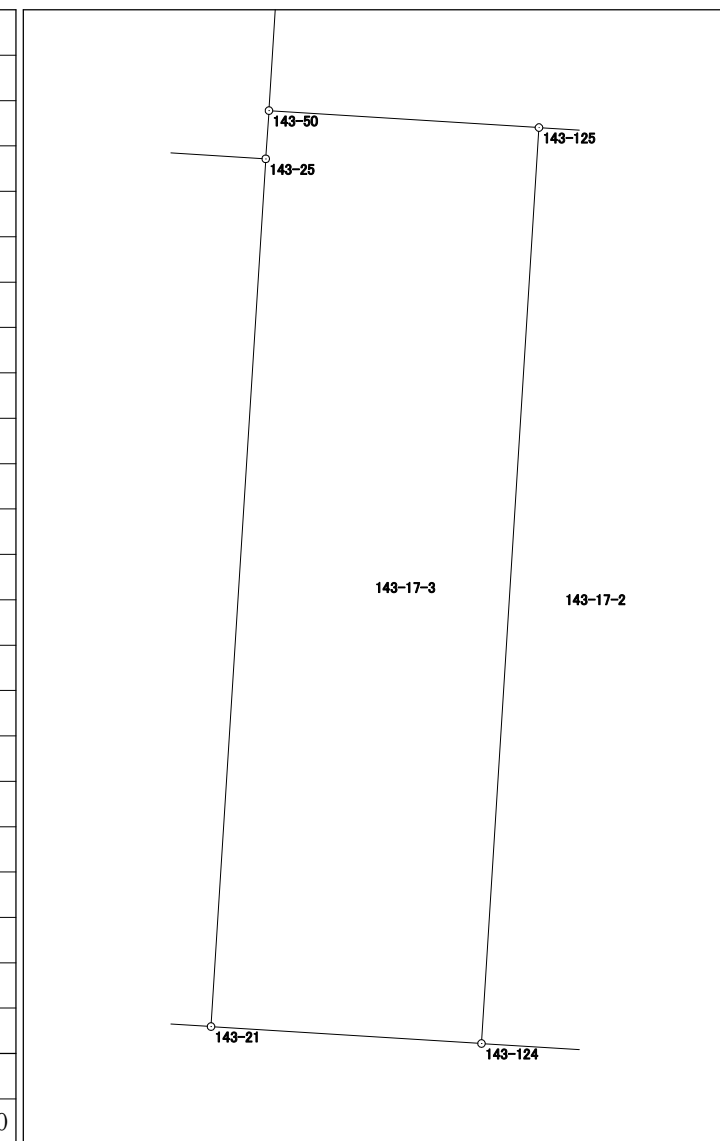

倍面積	279.058022
面 積	139.5290110




# 面積計算書 (座標法)

世界測地系 (測地成果2011)

所 在	地 番	公簿地目	現況地目	地 積	所 有 者
前橋市六供町五丁目	143-18			247.94 m <sup>2</sup>	

点 名	X 座標	Y 座標	辺 長	方 向 角	測 角	DX	倍 積 (Y×DX)
143-1	41160.438	-67692.481	20.495	184-36-33	90-56-44	-19.667	1331308.023827
143-23	41140.009	-67694.128	9.866	93-36-11	88-59-38	-21.049	1424893.700272
143-120	41139.389	-67684.282	1.845	93-36-19	180-00-08	-0.736	49815.631552
143-204	41139.273	-67682.441	0.570	94-01-16	180-24-57	-0.156	10558.460796
143-43	41139.233	-67681.872	20.484	3-36-59	89-35-43	20.403	-1380913.234416
143-42	41159.676	-67680.580	11.925	273-39-49	90-02-50	21.205	-1435166.698900
倍面積							495.883131
面 積							247.9415655

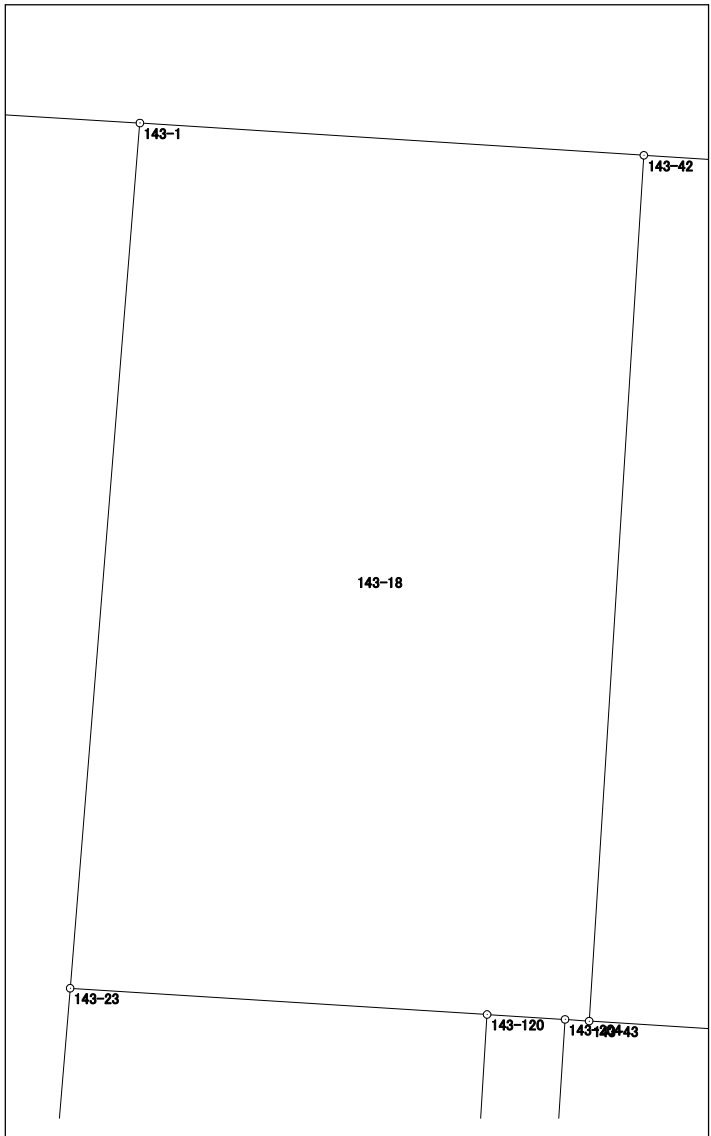


# 面積計算書（座標法）

世界測地系（測地成果2011）

所 在	地 番	公簿地目	現況地目	地 積	所 有 者
前橋市六供町五丁目	143-19			198.67 m <sup>2</sup>	

点 名	X 座標	Y 座標	辺 長	方 向 角	測 角	D <sub>X</sub>	倍 積 (Y×D <sub>X</sub> )
143-42	41159.676	-67680.580	20.484	183-36-59	90-02-47	-19.839	1342715.026620
143-43	41139.233	-67681.872	4.664	93-32-25	89-55-26	-20.731	1403112.888432
143-200	41138.945	-67677.217	5.035	93-38-38	180-06-13	-0.608	41147.747936
143-41	41138.625	-67672.192	20.488	3-37-06	89-58-28	20.127	-1362038.208384
143-40	41159.072	-67670.899	9.700	273-34-12	89-57-06	21.051	-1424540.094849

倍面積	397.359755
面 積	198.6798775

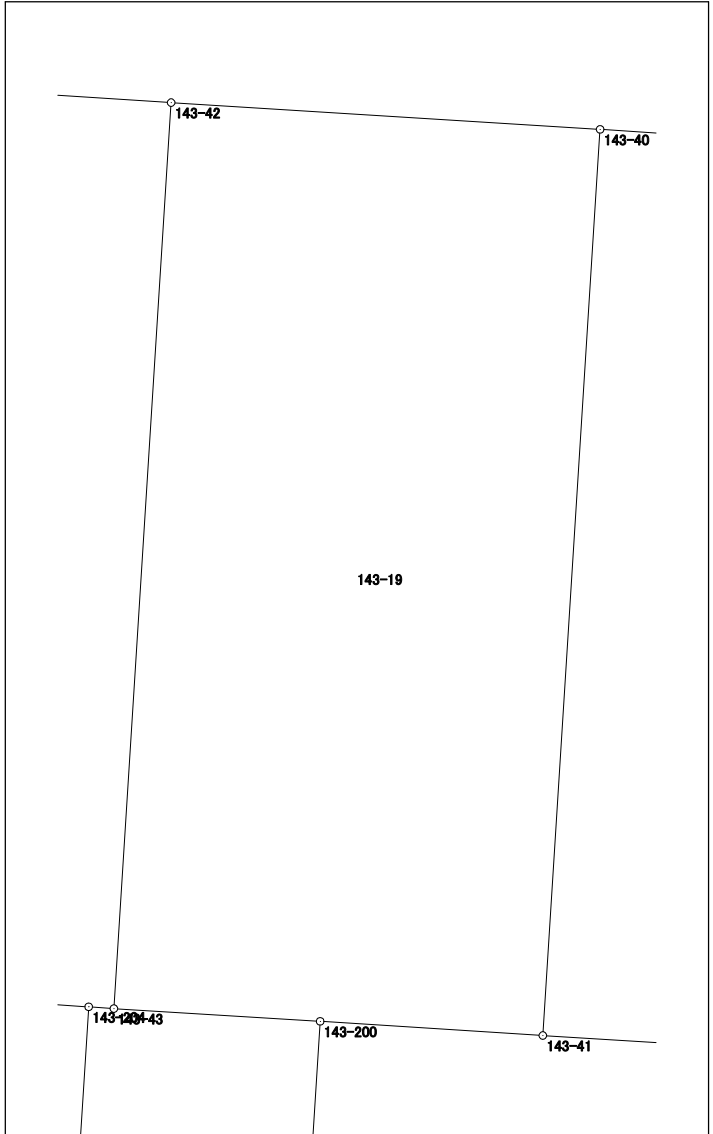


# 面積計算書 (座標法)

世界測地系 (測地成果2011)

所在	地番	公簿地目	現況地目	地積	所有者
前橋市六供町五丁目	143-保-1			75.00 m <sup>2</sup>	

点名	X座標	Y座標	辺長	方向角	測角	DX	倍積 (Y×DX)
143-49	41146.091	-67574.434	6.889	3-37-14	179-54-48	12.462	-842112.596508
143-13	41152.966	-67573.999	4.455	273-36-13	89-58-59	7.155	-483491.962845
143-118	41153.246	-67578.445	16.830	183-39-31	90-03-18	-16.516	1116125.597620
143-119	41136.450	-67579.519	2.725	93-35-50	89-56-19	-16.967	1146621.698873
143-116	41136.279	-67576.799	1.729	93-36-49	180-00-59	-0.280	18921.503720
143-32	41136.170	-67575.073	4.343	3-39-25	90-02-36	4.225	-285504.683425
143-48	41140.504	-67574.796	5.599	3-42-26	180-03-01	9.921	-670409.551116
						倍面積	150.006319
						面積	75.0031595

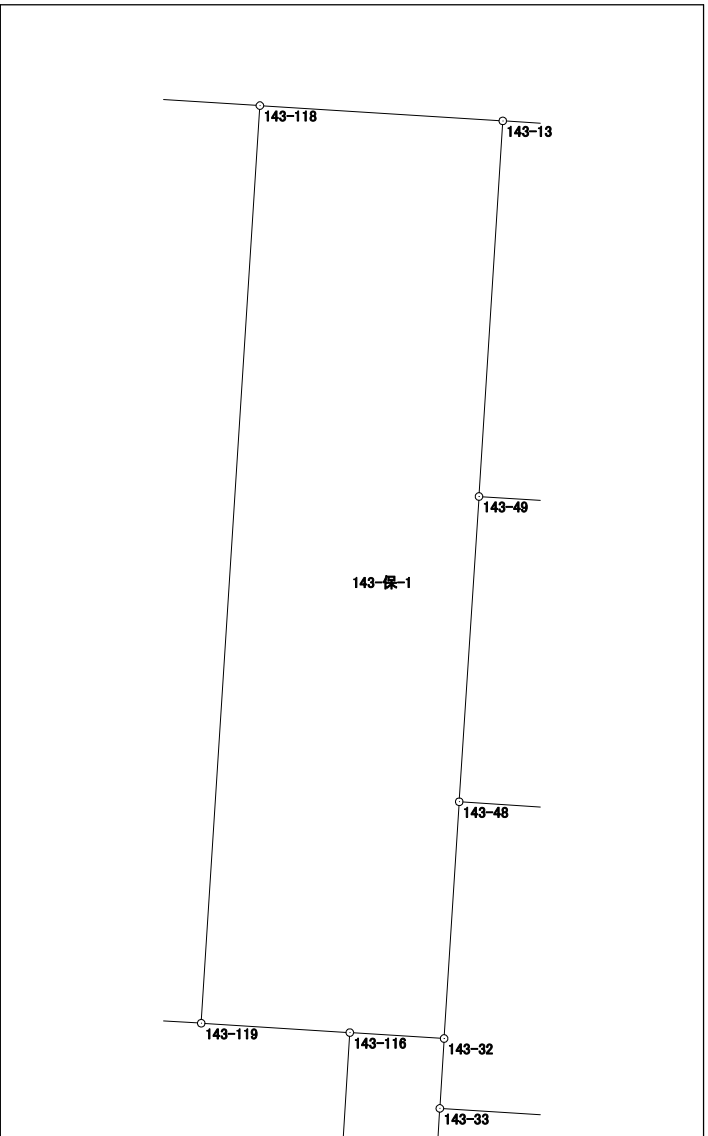


# 面積計算書 (座標法)

世界測地系 (測地成果2011)

所在	地番	公簿地目	現況地目	地積	所有者
前橋市六供町五丁目	143-保-2			85.00 m <sup>2</sup>	

点名	X座標	Y座標	辺長	方向角	測角	DX	倍積 (Y×DX)
143-33	41134.891	-67575.151	6.088	183-33-36	90-00-12	-5.214	352336.837314
143-109	41128.815	-67575.529	14.029	93-33-34	89-59-58	-6.947	469447.199963
143-110	41127.944	-67561.527	6.090	2-17-47	88-44-13	5.214	-352265.801778
143-15	41134.029	-67561.283	13.895	273-33-24	91-15-37	6.947	-469348.233001
						倍面積	170.002498
						面積	85.0012490

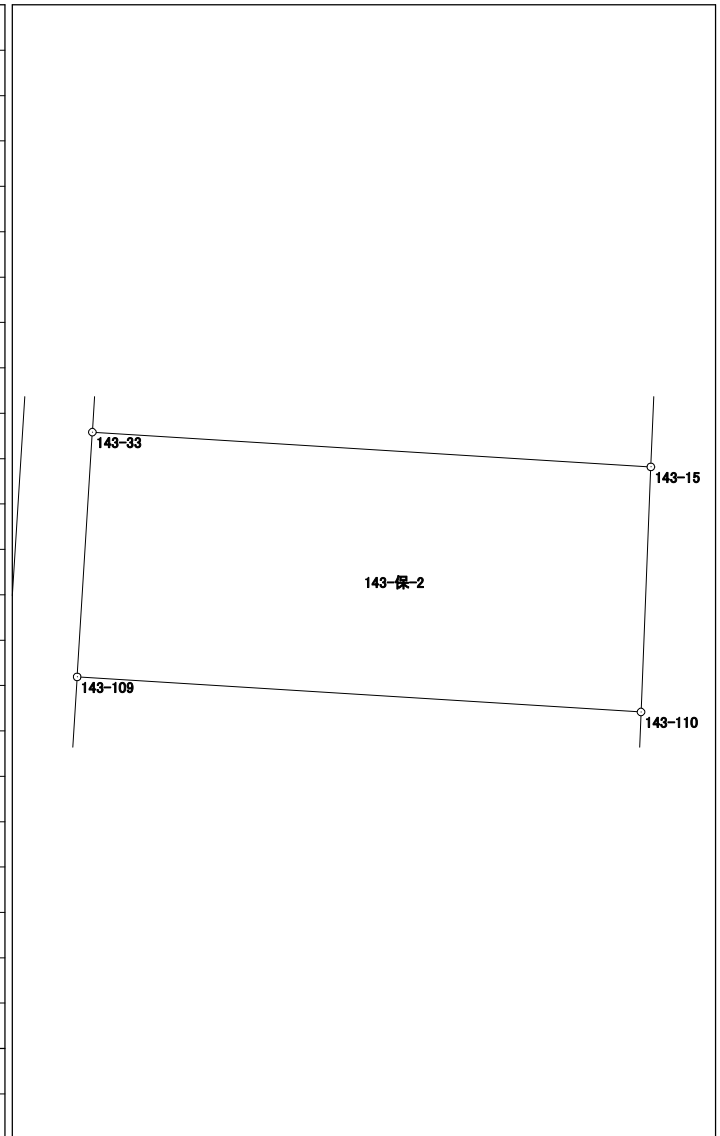


# 面積計算書 (座標法)

世界測地系 (測地成果2011)

所在	地番	公簿地目	現況地目	地積	所有者
前橋市六供町五丁目	143-保-3			42.00 m <sup>2</sup>	

点名	X座標	Y座標	辺長	方向角	測角	DX	倍積 (Y×DX)
143-33	41134.891	-67575.151	1.281	3-29-24	179-55-48	7.355	-497015.235605
143-32	41136.170	-67575.073	1.729	273-36-49	90-07-25	1.388	-93794.201324
143-116	41136.279	-67576.799	24.274	183-33-17	89-56-28	-24.118	1629817.238282
143-117	41112.052	-67578.304	1.730	93-34-42	90-01-25	-24.335	1644518.027840
143-16	41111.944	-67576.577	16.904	3-33-16	89-58-34	16.763	-1132786.160251
143-109	41128.815	-67575.529	6.088	3-33-36	180-00-20	22.947	-1550655.663963

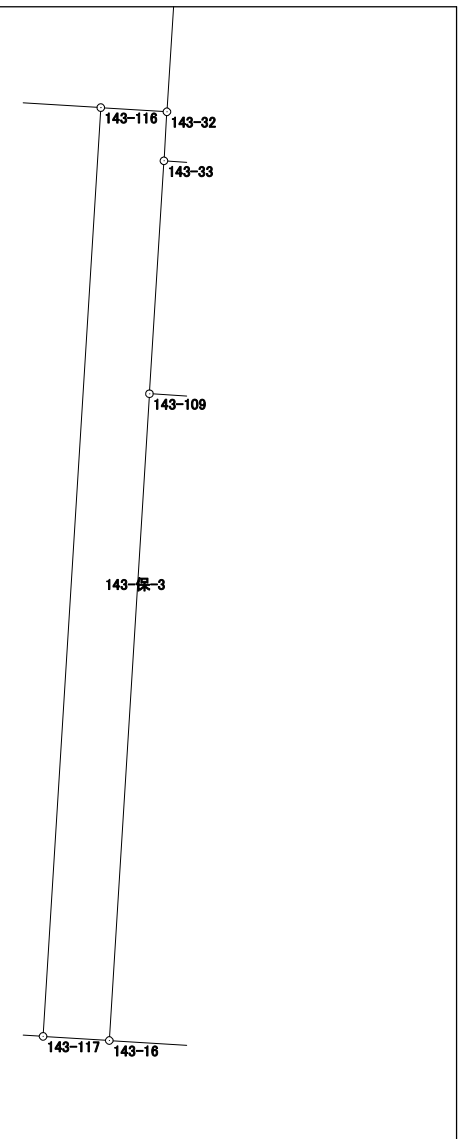


倍面積	84.004979
面積	42.0024895

# 面積計算書（座標法）

世界測地系（測地成果2011）

所 在	地 番	公簿地目	現況地目	地 積	所 有 者
前橋市六供町五丁目	143-保-4			14.00 m <sup>2</sup>	

点 名	X 座標	Y 座標	辺 長	方 向 角	測 角	DX	倍 積 (Y×DX)	
143-17	41112.971	-67592.961	23.668	3-36-43	89-55-36	23.583	-1594044.799263	
143-30	41136.592	-67591.470	0.592	273-40-44	90-04-01	23.659	-1599146.588730	
143-105	41136.630	-67592.061	23.668	183-36-34	89-55-50	-23.583	1594023.574563	
143-106	41113.009	-67593.551	0.591	93-41-07	90-04-33	-23.659	1599195.823109	
							倍面積	28.009679
							面 積	14.0048395

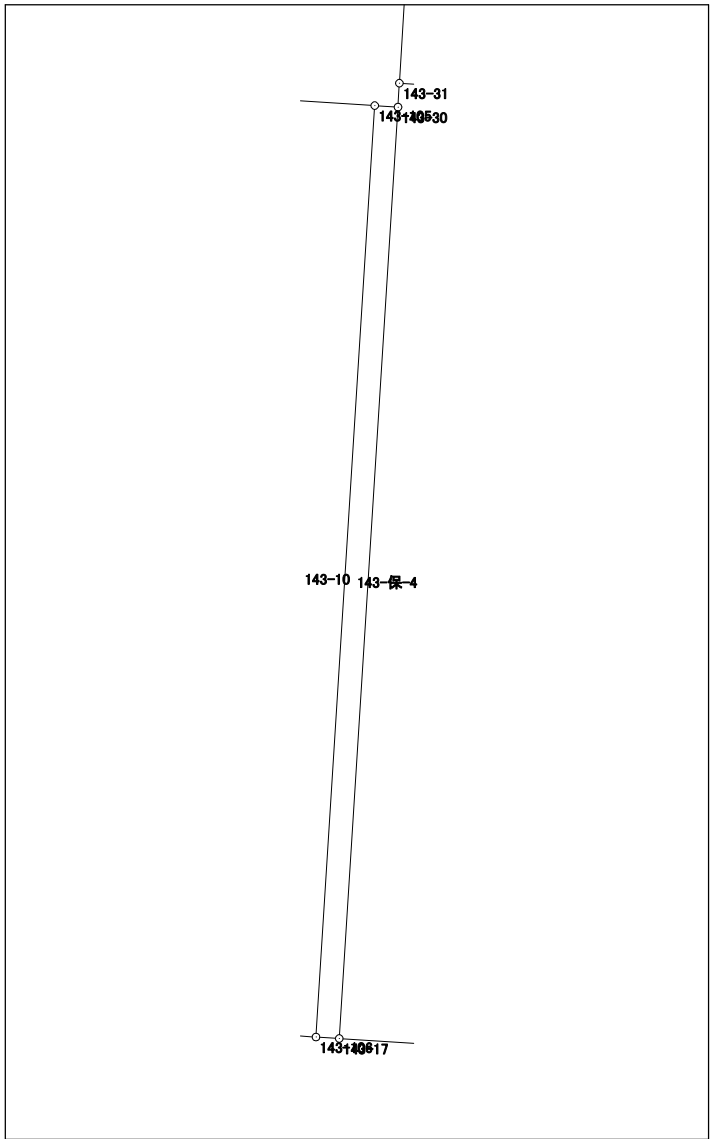


# 面積計算書（座標法）

世界測地系（測地成果2011）

所在	地番	公簿地目	現況地目	地積	所有者
前橋市六供町五丁目	143-保-5			43.00 m <sup>2</sup>	

点名	X座標	Y座標	辺長	方向角	測角	DX	倍積 (Y×DX)
143-28	41137.626	-67607.752	23.664	183-33-50	89-56-11	-23.503	1588984.995256
143-19	41114.008	-67609.223	1.817	93-39-39	90-05-49	-23.734	1604637.298682
143-114	41113.892	-67607.410	23.665	3-33-58	89-54-19	23.503	-1588976.957230
143-115	41137.511	-67605.938	1.818	273-37-39	90-03-41	23.734	-1604559.332492

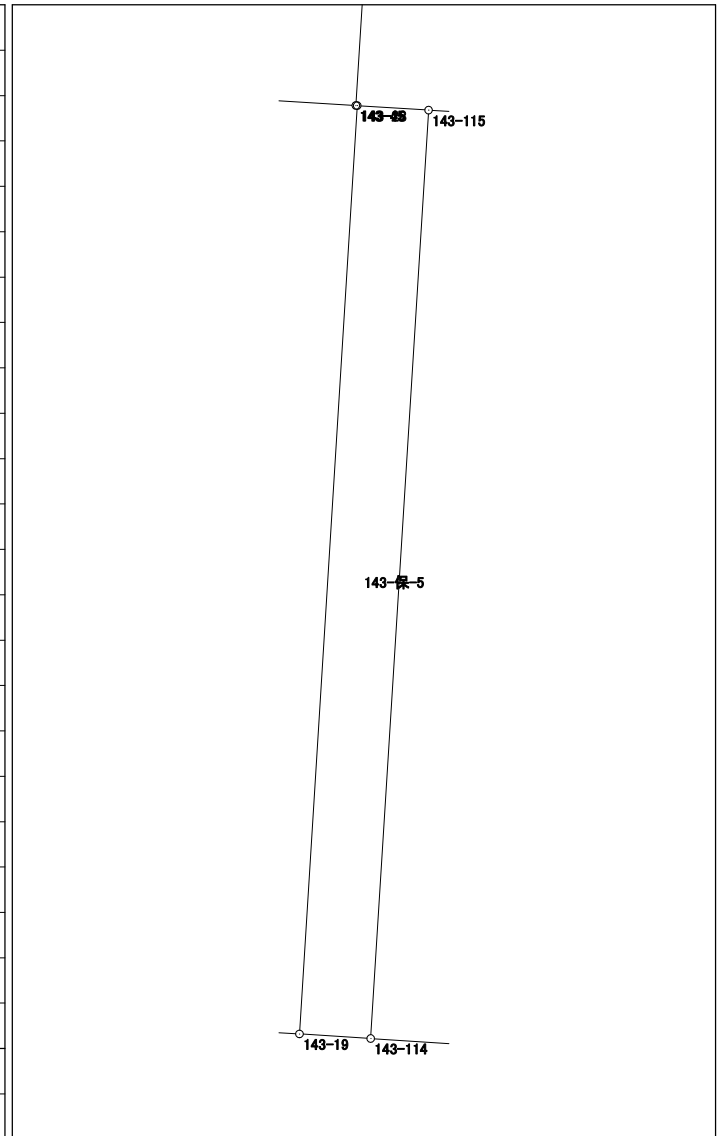


倍面積	86.004216
面積	43.0021080

# 面積計算書（座標法）

世界測地系（測地成果2011）

所 在	地 番	公簿地目	現況地目	地 積	所 有 者
前橋市六供町五丁目	143-保-6			29.00 m <sup>2</sup>	

点 名	X 座標	Y 座標	辺 長	方 向 角	測 角	DX	倍 積 (Y×DX)
143-35	41130.402	-67626.005	15.295	183-37-30	179-57-02	-21.695	1467146.178475
143-20	41115.138	-67626.972	1.227	93-41-34	90-04-04	-15.343	1037600.631396
143-103	41115.059	-67625.748	23.646	3-37-47	89-56-13	23.520	-1590557.592960
143-104	41138.658	-67624.251	1.228	273-35-38	89-57-51	23.676	-1601071.766676
143-26	41138.735	-67625.477	1.905	183-27-36	89-51-58	-1.825	123416.495525
143-52	41136.833	-67625.592	6.444	183-40-28	180-12-52	-8.333	563524.058136
						倍面積	58.003896
						面 積	29.0019480

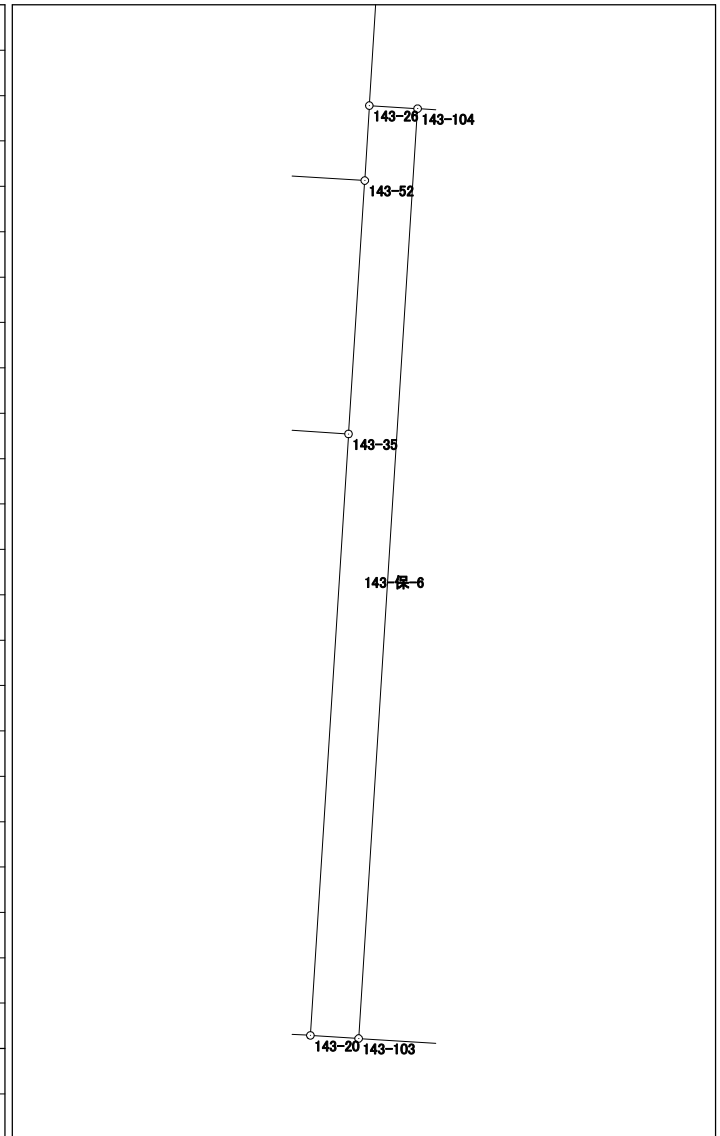




# 面積計算書 (座標法)

世界測地系 (測地成果2011)

所在	地番	公簿地目	現況地目	地積	所有者
前橋市六供町五丁目	143-保-7			38.00 m <sup>2</sup>	

点名	X座標	Y座標	辺長	方向角	測角	DX	倍積 (Y×DX)
143-205	41118.717	-67683.744	20.597	3-37-37	90-10-42	20.445	-1383794.146080
143-204	41139.273	-67682.441	1.845	273-36-19	89-58-42	20.672	-1399131.420352
143-120	41139.389	-67684.282	20.602	183-37-44	90-01-25	-20.445	1383805.145490
143-121	41118.828	-67685.586	1.845	93-26-55	89-49-11	-20.672	1399196.433792

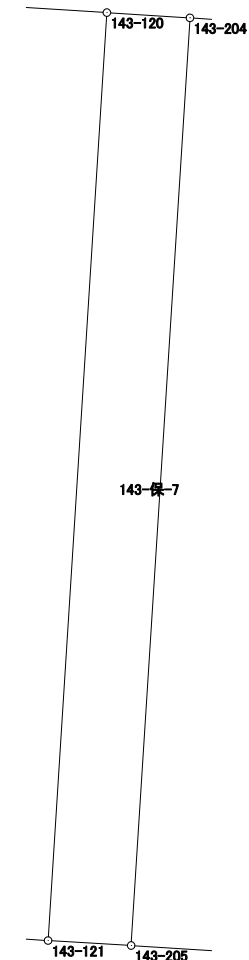

倍面積	76.012850
面積	38.0064250

# 面積計算書（座標法）

世界測地系（測地成果2011）

所在	地番	公簿地目	現況地目	地積	所有者
前橋市六供町五丁目	143-保-9			284.91 m <sup>2</sup>	

点名	X座標	Y座標	辺長	方向角	測角	DX	倍積 (Y×DX)
143-44	41155.025	-67606.685	17.431	183-37-41	90-01-36	-16.370	1106721.433450
143-45	41137.629	-67607.788	0.036	94-45-49	91-08-08	-17.399	1176307.903412
143-28	41137.626	-67607.752	1.818	93-37-39	178-51-50	-0.118	7977.714736
143-115	41137.511	-67605.938	11.830	93-38-06	180-00-27	-0.865	58479.136370
143-107	41136.761	-67594.132	2.075	93-37-10	179-59-04	-0.881	59550.430292
143-105	41136.630	-67592.061	0.592	93-40-44	180-03-34	-0.169	11423.058309
143-30	41136.592	-67591.470	0.608	3-12-21	89-31-37	0.569	-38459.546430
143-31	41137.199	-67591.436	16.833	3-35-11	180-22-50	17.407	-1176564.126452
143-12	41153.999	-67590.383	16.334	273-36-05	90-00-54	17.826	-1204866.167358
						倍面積	569.836329
						面積	284.9181645

