



# 145街区 画地出来形確認図 (3121.91m<sup>2</sup>)

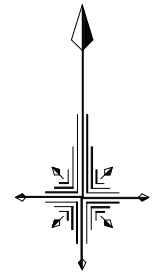

S=1/500

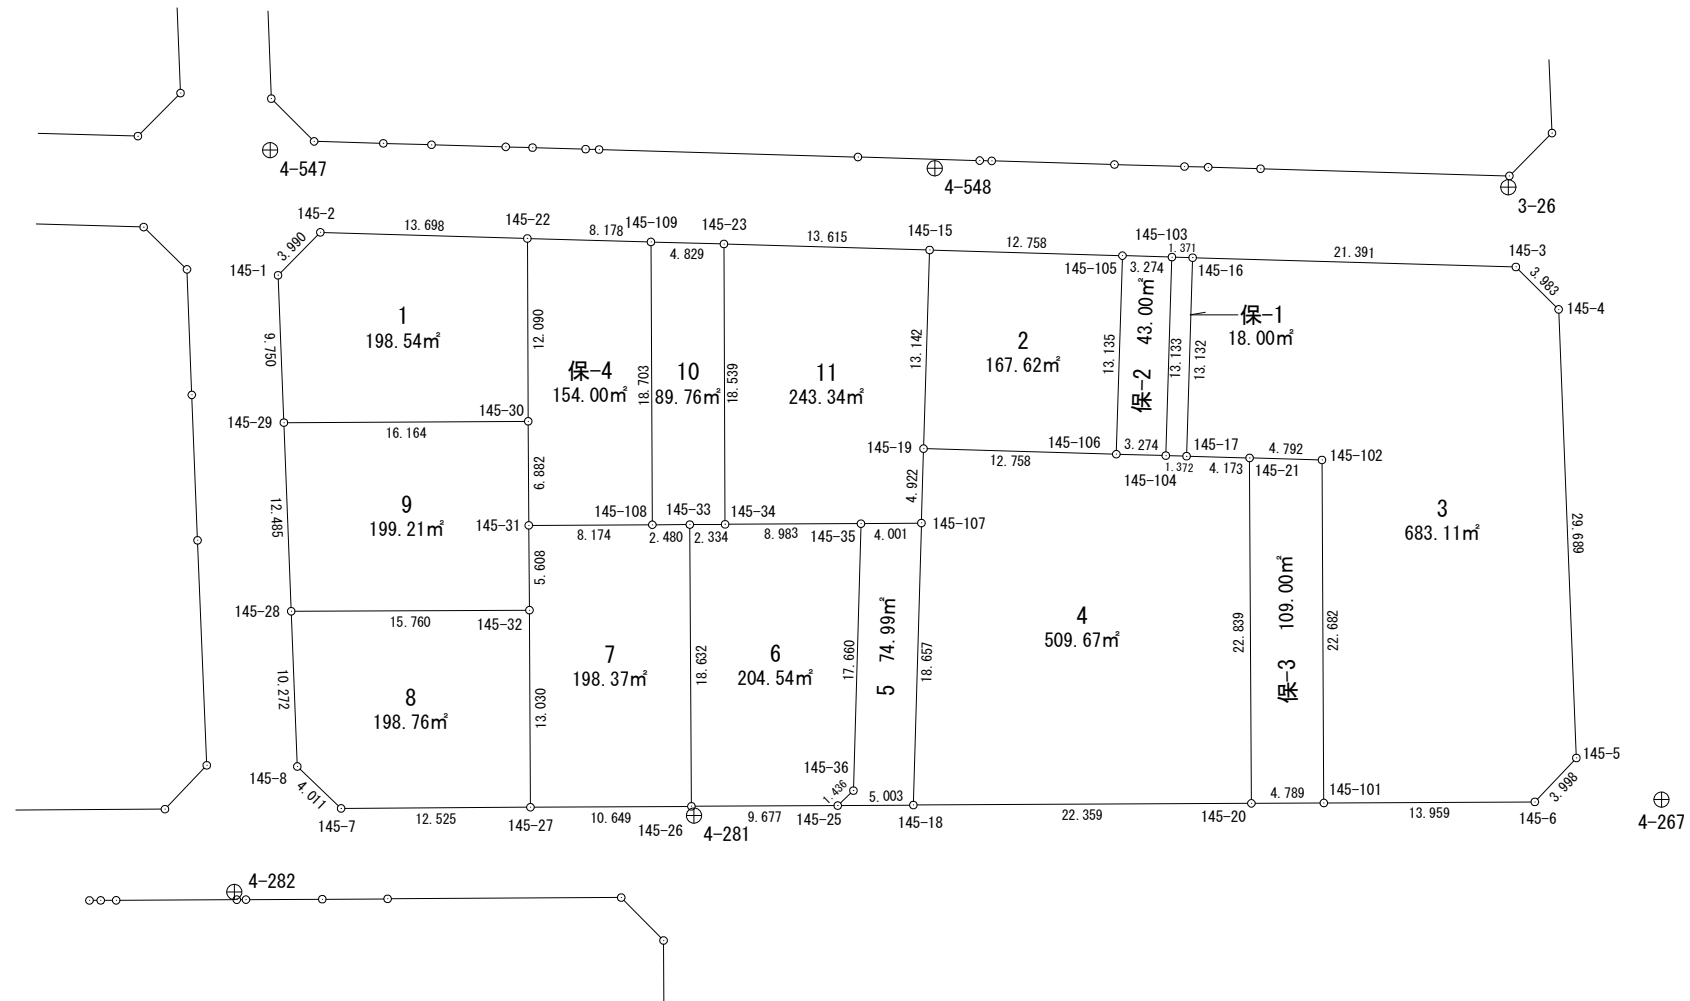


# 面積計算書 (座標法)

世界測地系 (測地成果2011)

所在	地番	公簿地目	現況地目	地積	所有者
前橋市六供町五丁目	145-1			198.54 m <sup>2</sup>	

点名	X座標	Y座標	辺長	方向角	測角	DX	倍積 (Y×DX)
145-2	41069.197	-67691.304	3.990	224-34-25	132-52-16	-2.435	164828.325240
145-1	41066.355	-67694.104	9.750	177-44-13	133-09-48	-12.584	851862.604736
145-29	41056.613	-67693.719	16.164	89-41-30	91-57-17	-9.655	653582.856945
145-30	41056.700	-67677.555	12.090	359-43-48	90-02-18	12.177	-824109.587235
145-22	41068.790	-67677.612	13.698	271-42-09	91-58-21	12.497	-845767.117164
						倍面積	397.082522
						面積	198.5412610

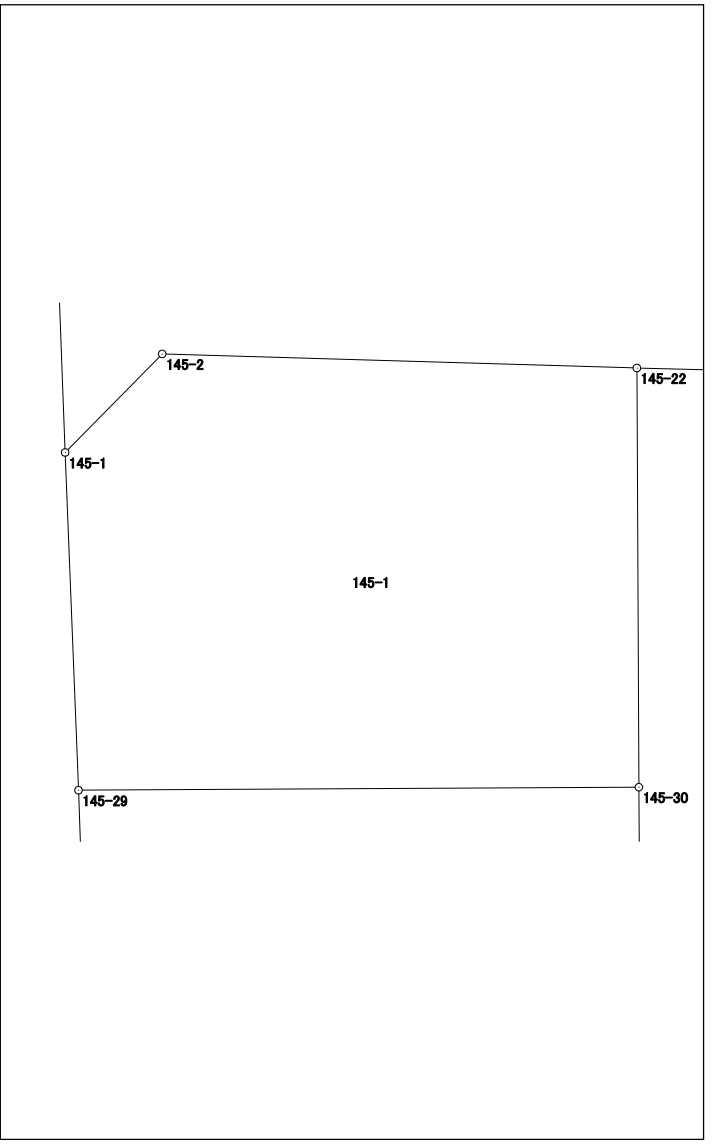


# 面積計算書（座標法）

世界測地系（測地成果2011）

所 在	地 番	公簿地目	現況地目	地 積	所 有 者
前橋市六供町五丁目	145-2			167.62 m <sup>2</sup>	

点 名	X 座標	Y 座標	辺 長	方 向 角	測 角	DX	倍 積 (Y×DX)
145-105	41067.655	-67638.248	12.758	271-40-31	89-54-30	13.502	-913251.624496
145-15	41068.028	-67651.001	13.142	181-45-57	90-05-26	-12.763	863429.725763
145-19	41054.892	-67651.406	12.758	91-38-38	89-52-41	-13.502	913429.283812
145-106	41054.526	-67638.653	13.135	1-46-01	90-07-23	12.763	-863272.128239

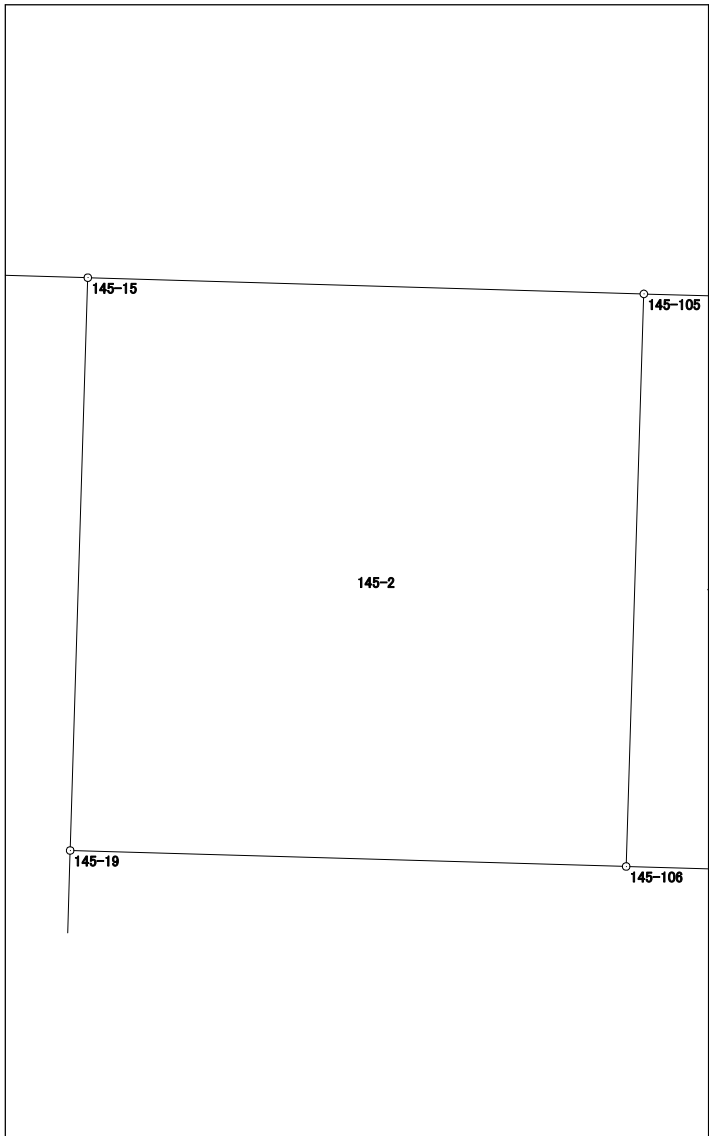


倍面積	335.256840
面 積	167.6284200

# 面積計算書（座標法）

世界測地系（測地成果2011）

所在	地番	公簿地目	現況地目	地積	所有者
前橋市六供町五丁目	145-3			683.11 m <sup>2</sup>	

点名	X座標	Y座標	辺長	方向角	測角	DX	倍積 (Y×DX)
145-16	41067.519	-67633.605	13.132	181-45-47	90-07-25	-12.514	846366.932970
145-17	41054.393	-67634.009	4.173	91-35-35	89-49-48	-13.242	895609.547178
145-21	41054.277	-67629.838	4.792	91-35-26	179-59-51	-0.249	16839.829662
145-102	41054.144	-67625.048	22.682	179-42-07	268-06-41	-22.815	1542865.470120
145-101	41031.462	-67624.930	13.959	89-42-31	90-00-24	-22.611	1529067.292230
145-6	41031.533	-67610.971	3.998	43-26-21	133-43-50	2.974	-201075.027754
145-5	41034.436	-67608.222	29.689	357-44-08	134-17-47	32.569	-2201932.182318
145-4	41064.102	-67609.395	3.983	314-45-58	137-01-50	32.471	-2195344.665045
145-3	41066.907	-67612.223	21.391	271-38-22	136-52-24	3.417	-231030.965991

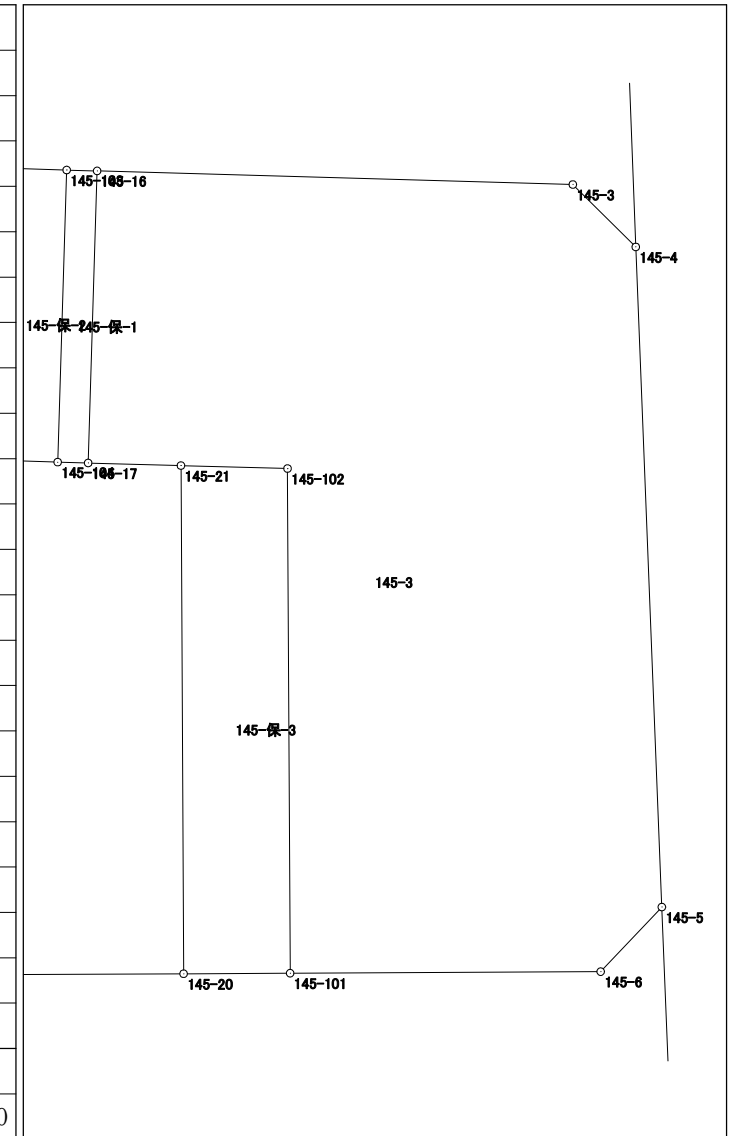


倍面積	1366.231052
面積	683.115260

# 面積計算書 (座標法)

世界測地系 (測地成果2011)

所 在	地 番	公簿地目	現況地目	地 積	所 有 者
前橋市六供町五丁目	145-4			509.67 m <sup>2</sup>	

点 名	X 座 標	Y 座 標	辺 長	方 向 角	測 角	DX	倍 積 (Y×DX)
145-19	41054.892	-67651.406	4.922	181-37-48	89-59-10	-4.554	308084.502924
145-107	41049.972	-67651.546	18.657	181-38-03	180-00-15	-23.569	1594479.287674
145-18	41031.323	-67652.078	22.359	89-42-19	88-04-16	-18.534	1253863.613652
145-20	41031.438	-67629.719	22.839	359-42-05	89-59-46	22.954	-1552372.569926
145-21	41054.277	-67629.838	4.173	271-35-35	91-53-30	22.955	-1552442.931290
145-17	41054.393	-67634.009	1.372	271-37-46	180-02-11	0.155	-10483.271395
145-104	41054.432	-67635.380	3.274	271-38-42	180-00-56	0.133	-8995.505540
145-106	41054.526	-67638.653	12.758	271-38-38	179-59-56	0.460	-31113.780380
						倍面積	1019.345719
						面 積	509.6728595

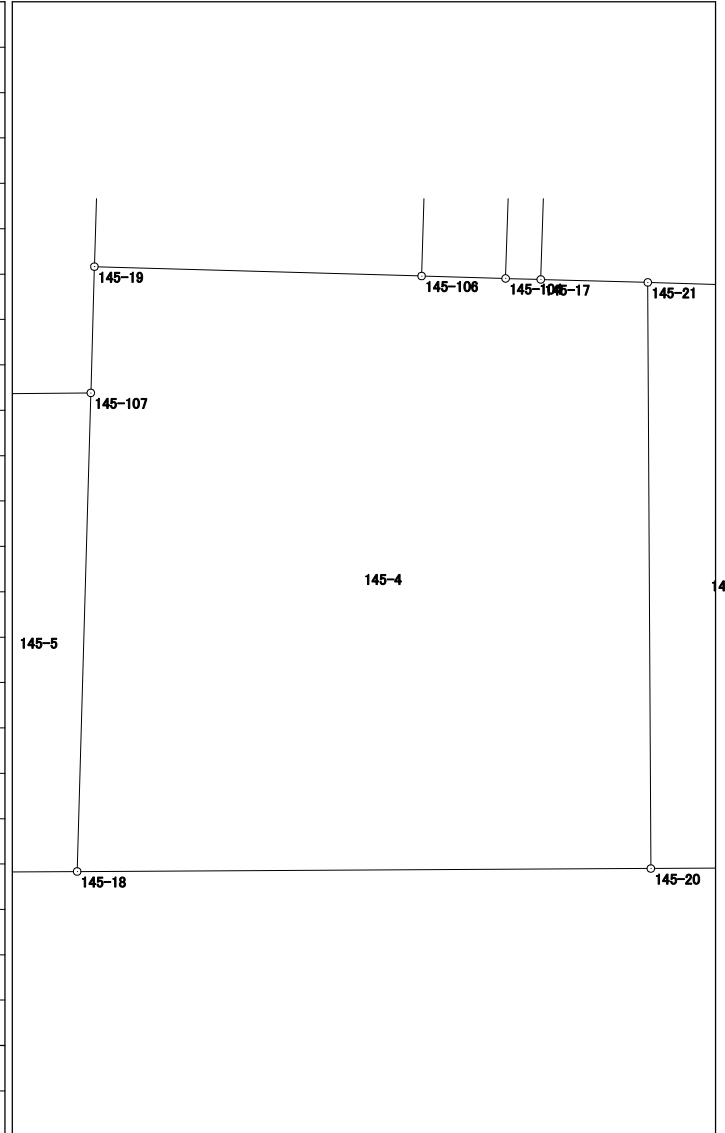


# 面積計算書 (座標法)

世界測地系 (測地成果2011)

所 在	地 番	公簿地目	現況地目	地 積	所 有 者
前橋市六供町五丁目	145-5			74.99 m <sup>2</sup>	

点 名	X 座 標	Y 座 標	辺 長	方 向 角	測 角	DX	倍 積 (Y×DX)
145-35	41049.931	-67655.547	17.660	181-36-34	92-11-48	-17.694	1197097.248618
145-36	41032.278	-67656.043	1.436	226-17-53	224-41-19	-18.645	1261446.921735
145-25	41031.286	-67657.081	5.003	89-34-35	43-16-42	-0.955	64612.512355
145-18	41031.323	-67652.078	18.657	1-38-03	92-03-28	18.686	-1264146.729508
145-107	41049.972	-67651.546	4.001	269-24-46	87-46-43	18.608	-1258859.967968
倍面積							149.985232
面 積							74.9926160

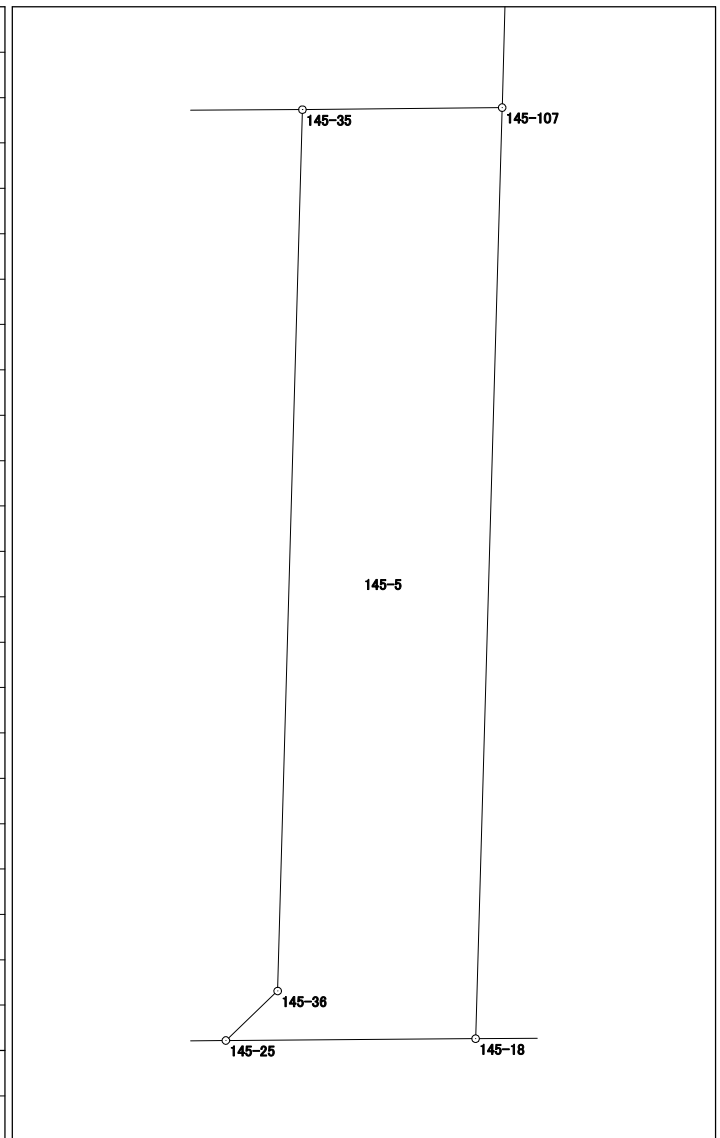

# 面積計算書（座標法）

世界測地系（測地成果2011）

所 在	地 番	公簿地目	現況地目	地 積	所 有 者
前橋市六供町五丁目	145-6			204.54 m <sup>2</sup>	


点 名	X 座標	Y 座標	辺 長	方 向 角	測 角	DX	倍 積 (Y×DX)				
145-33	41049.870	-67666.864	18.632	179-40-27	90-04-01	-18.648	1261851.679872				
145-26	41031.238	-67666.758	9.677	89-42-57	90-02-30	-18.584	1257519.030672				
145-25	41031.286	-67657.081	1.436	46-17-53	136-34-56	1.040	-70363.364240				
145-36	41032.278	-67656.043	17.660	1-36-34	135-18-41	18.645	-1261446.921735				
145-35	41049.931	-67655.547	8.983	269-42-47	88-06-13	17.608	-1191278.871576				
145-34	41049.886	-67664.530	2.334	269-36-26	179-53-39	-0.061	4127.536330				
						倍面積	409.089323				
						面 積	204.5446615				

## 面積計算書 (座標法)

世界測地系 (測地成果2011)

所 在	地 番	公簿地目	現況地目	地 積	所 有 者
前橋市六供町五丁目	145-7			198.37 m <sup>2</sup>	

点 名	X 座 標	Y 座 標	辺 長	方 向 角	測 角	DX	倍 積 (Y×DX)
145-31	41049.818	-67677.518	5.608	179-31-11	89-48-00	-5.648	382242.621664
145-32	41044.210	-67677.471	13.030	179-43-07	180-11-56	-18.638	1261372.704498
145-27	41031.180	-67677.407	10.649	89-41-17	89-58-10	-12.972	877911.323604
145-26	41031.238	-67666.758	18.632	359-40-27	89-59-10	18.690	-1264691.707020
145-33	41049.870	-67666.864	2.480	269-43-22	90-02-55	18.620	-1259957.007680
145-108	41049.858	-67669.344	8.174	269-43-11	179-59-49	-0.052	3518.805888
						倍面積	396.740954
						面 積	198.3704770

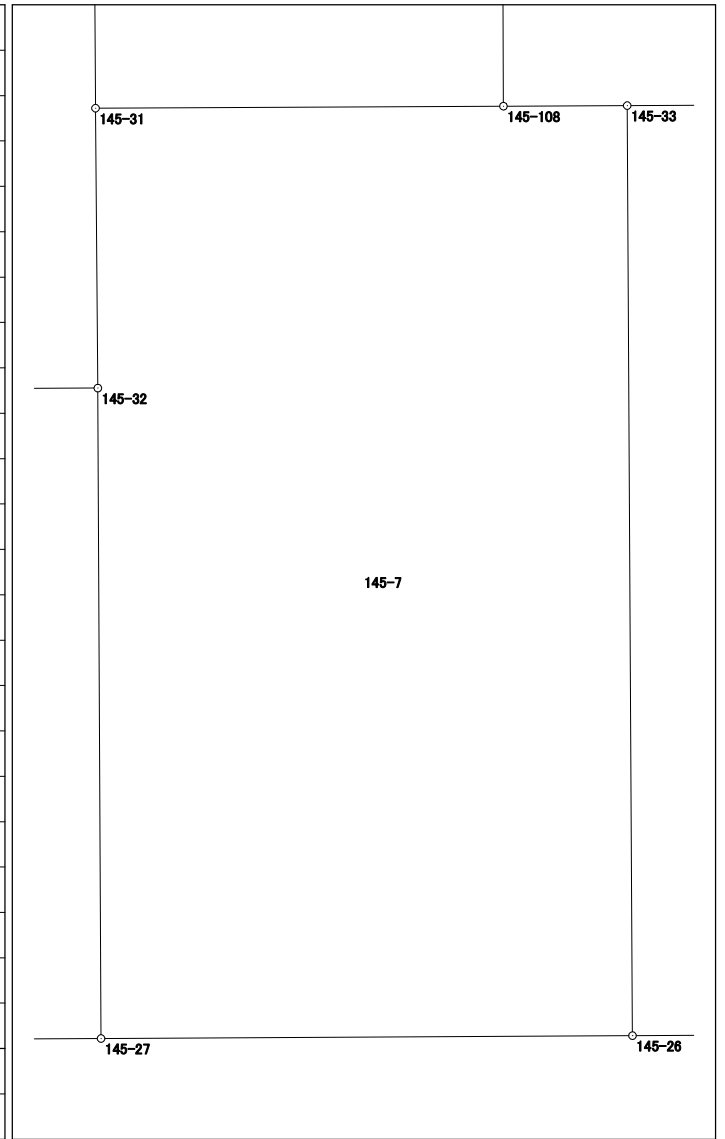




# 面積計算書（座標法）

世界測地系（測地成果2011）

所 在	地 番	公簿地目	現況地目	地 積	所 有 者
前橋市六供町五丁目	145-8			198.76 m <sup>2</sup>	

点 名	X 座標	Y 座標	辺 長	方 向 角	測 角	DX	倍 積 (Y×DX)
145-28	41044.138	-67693.231	10.272	177-45-46	88-01-28	-10.336	699677.235616
145-8	41033.874	-67692.830	4.011	133-44-14	135-58-28	-13.037	882511.424710
145-7	41031.101	-67689.932	12.525	89-38-19	135-54-05	-2.694	182356.676808
145-27	41031.180	-67677.407	13.030	359-43-07	90-04-48	13.109	-887183.128363
145-32	41044.210	-67677.471	15.760	269-44-18	90-01-11	12.958	-876964.669218
						倍面積	397.539553
						面 積	198.7697765

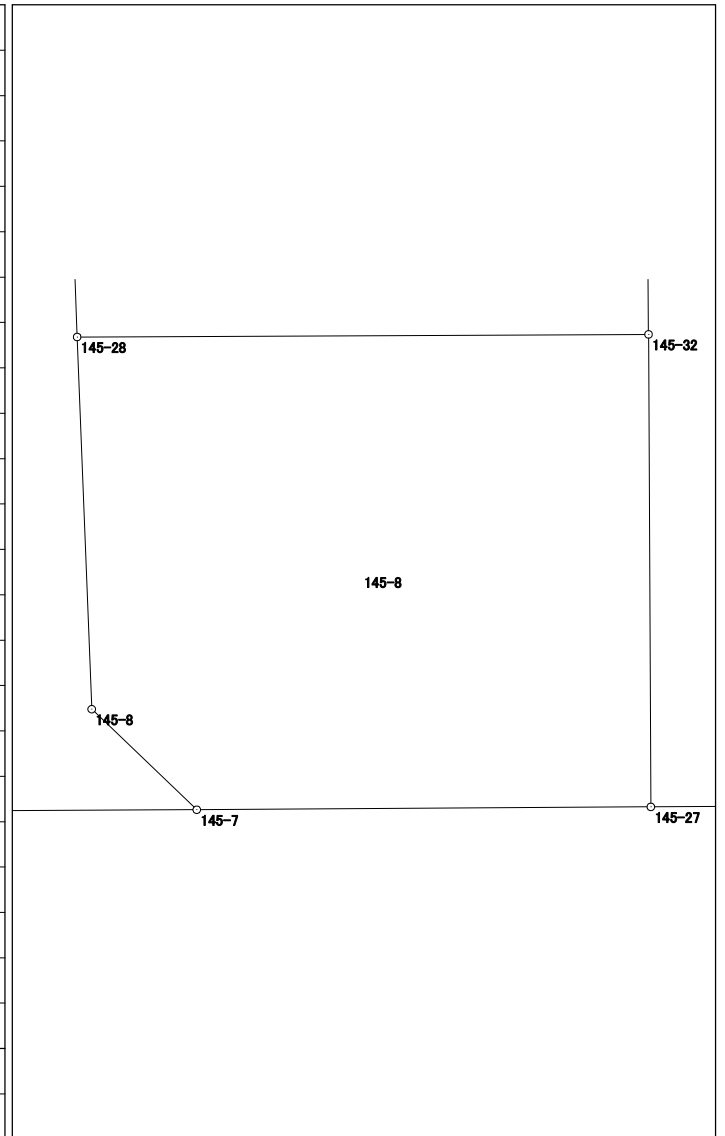


# 面積計算書 (座標法)

世界測地系 (測地成果2011)

所在	地番	公簿地目	現況地目	地積	所有者
前橋市六供町五丁目	145-9			199.21 m <sup>2</sup>	

点名	X座標	Y座標	辺長	方向角	測角	DX	倍積 (Y×DX)
145-29	41056.613	-67693.719	12.485	177-45-35	88-04-05	-12.562	850368.498078
145-28	41044.138	-67693.231	15.760	89-44-18	91-58-43	-12.403	839599.144093
145-32	41044.210	-67677.471	5.608	359-31-11	89-46-53	5.680	-384408.035280
145-31	41049.818	-67677.518	6.882	359-41-31	180-10-20	12.490	-845292.199820
145-30	41056.700	-67677.555	16.164	269-41-30	89-59-59	6.795	-459868.986225
倍面積							398.420846
面積							199.2104230

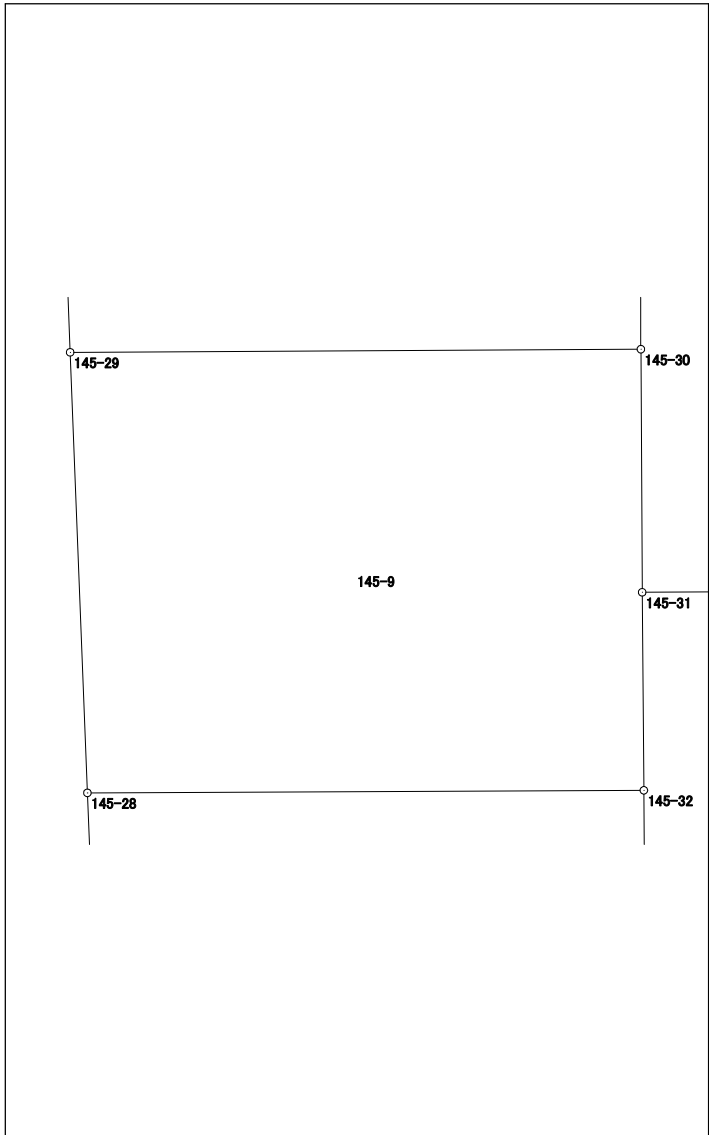








# 面積計算書（座標法）

世界測地系（測地成果2011）

所在	地番	公簿地目	現況地目	地積	所有者
前橋市六供町五丁目	145-保-2			43.00 m <sup>2</sup>	

点名	X座標	Y座標	辺長	方向角	測角	DX	倍積 (Y×DX)
145-103	41067.559	-67634.975	3.274	271-40-48	89-54-46	13.223	-894337.274425
145-105	41067.655	-67638.248	13.135	181-46-01	90-05-13	-13.033	881529.286184
145-106	41054.526	-67638.653	3.274	91-38-42	89-52-41	-13.223	894385.908619
145-104	41054.432	-67635.380	13.133	1-46-02	90-07-20	13.033	-881491.907540

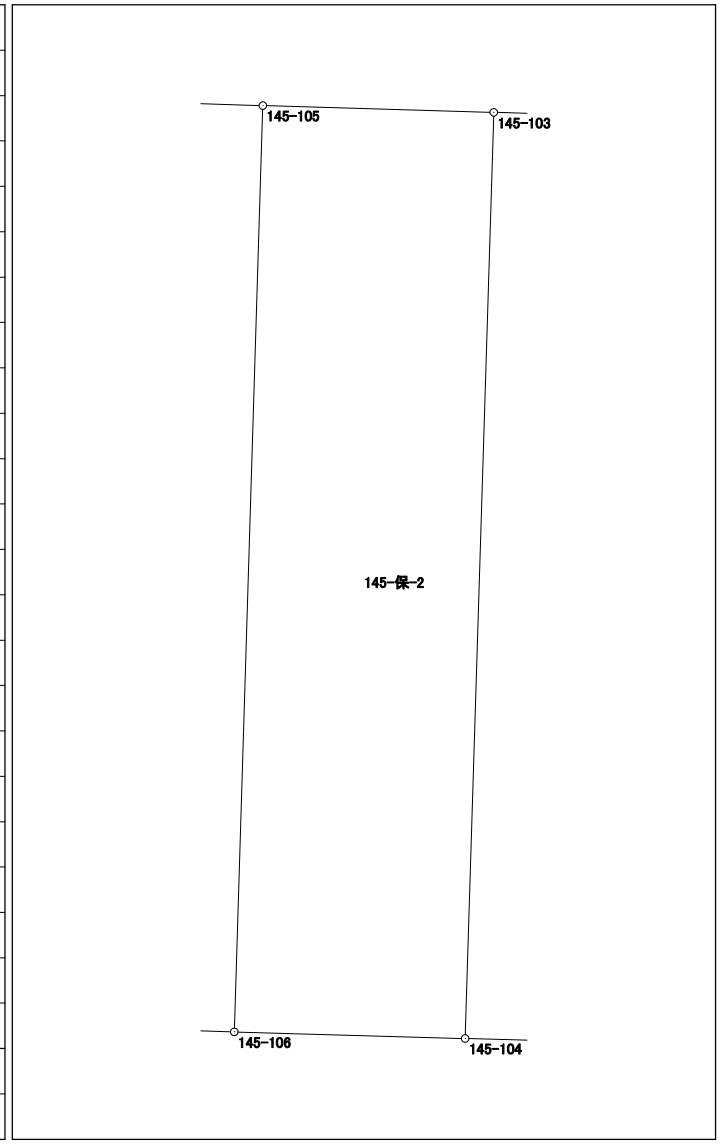


倍面積	86.012838
面積	43.0064190

# 面積計算書（座標法）

世界測地系（測地成果2011）

所 在	地 番	公簿地目	現況地目	地 積	所 有 者
前橋市六供町五丁目	145-保-3			109.00 m <sup>2</sup>	

点 名	X 座標	Y 座標	辺 長	方 向 角	測 角	DX	倍 積 (Y×DX)
145-21	41054.277	-67629.838	22.839	179-42-05	88-06-39	-22.706	1535603.101628
145-20	41031.438	-67629.719	4.789	89-42-46	90-00-41	-22.815	1542972.038985
145-101	41031.462	-67624.930	22.682	359-42-07	89-59-21	22.706	-1535491.660580
145-102	41054.144	-67625.048	4.792	271-35-26	91-53-19	22.815	-1542865.470120
						倍面積	218.009913
						面 積	109.0049565

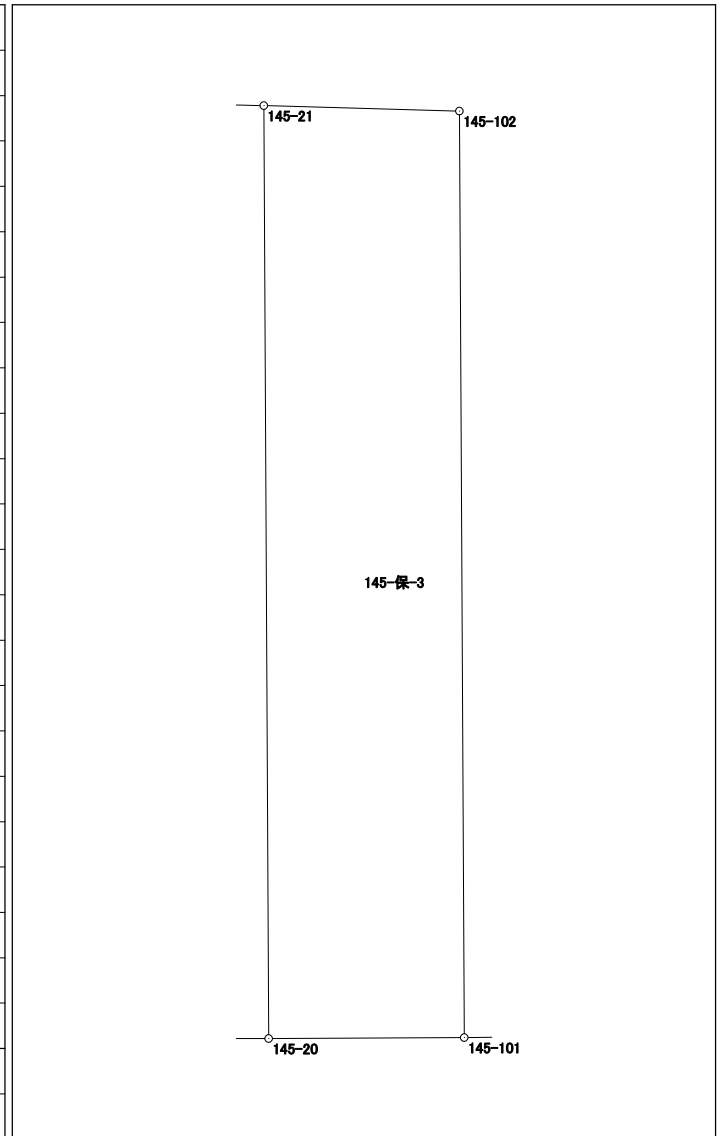

# 面積計算書（座標法）

世界測地系（測地成果2011）

所在	地番	公簿地目	現況地目	地積	所有者
前橋市六供町五丁目	145-保-4			154.00 m <sup>2</sup>	

点名	X座標	Y座標	辺長	方向角	測角	DX	倍積 (Y×DX)
145-30	41056.700	-67677.555	6.882	179-41-31	179-57-43	-18.972	1283978.573460
145-31	41049.818	-67677.518	8.174	89-43-11	90-01-40	-6.842	463049.578156
145-108	41049.858	-67669.344	18.703	359-42-54	89-59-43	18.743	-1268326.514592
145-109	41068.561	-67669.437	8.178	271-36-16	91-53-22	18.932	-1281117.781284
145-22	41068.790	-67677.612	12.090	179-43-48	88-07-32	-11.861	802724.155932
						倍面積	308.011672
						面積	154.0058360

