



150-2街区 画地出来形確認図 (5173.98m²)

⊕ 3-18

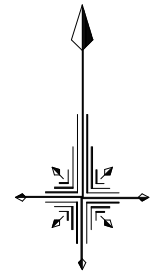

S=1/500

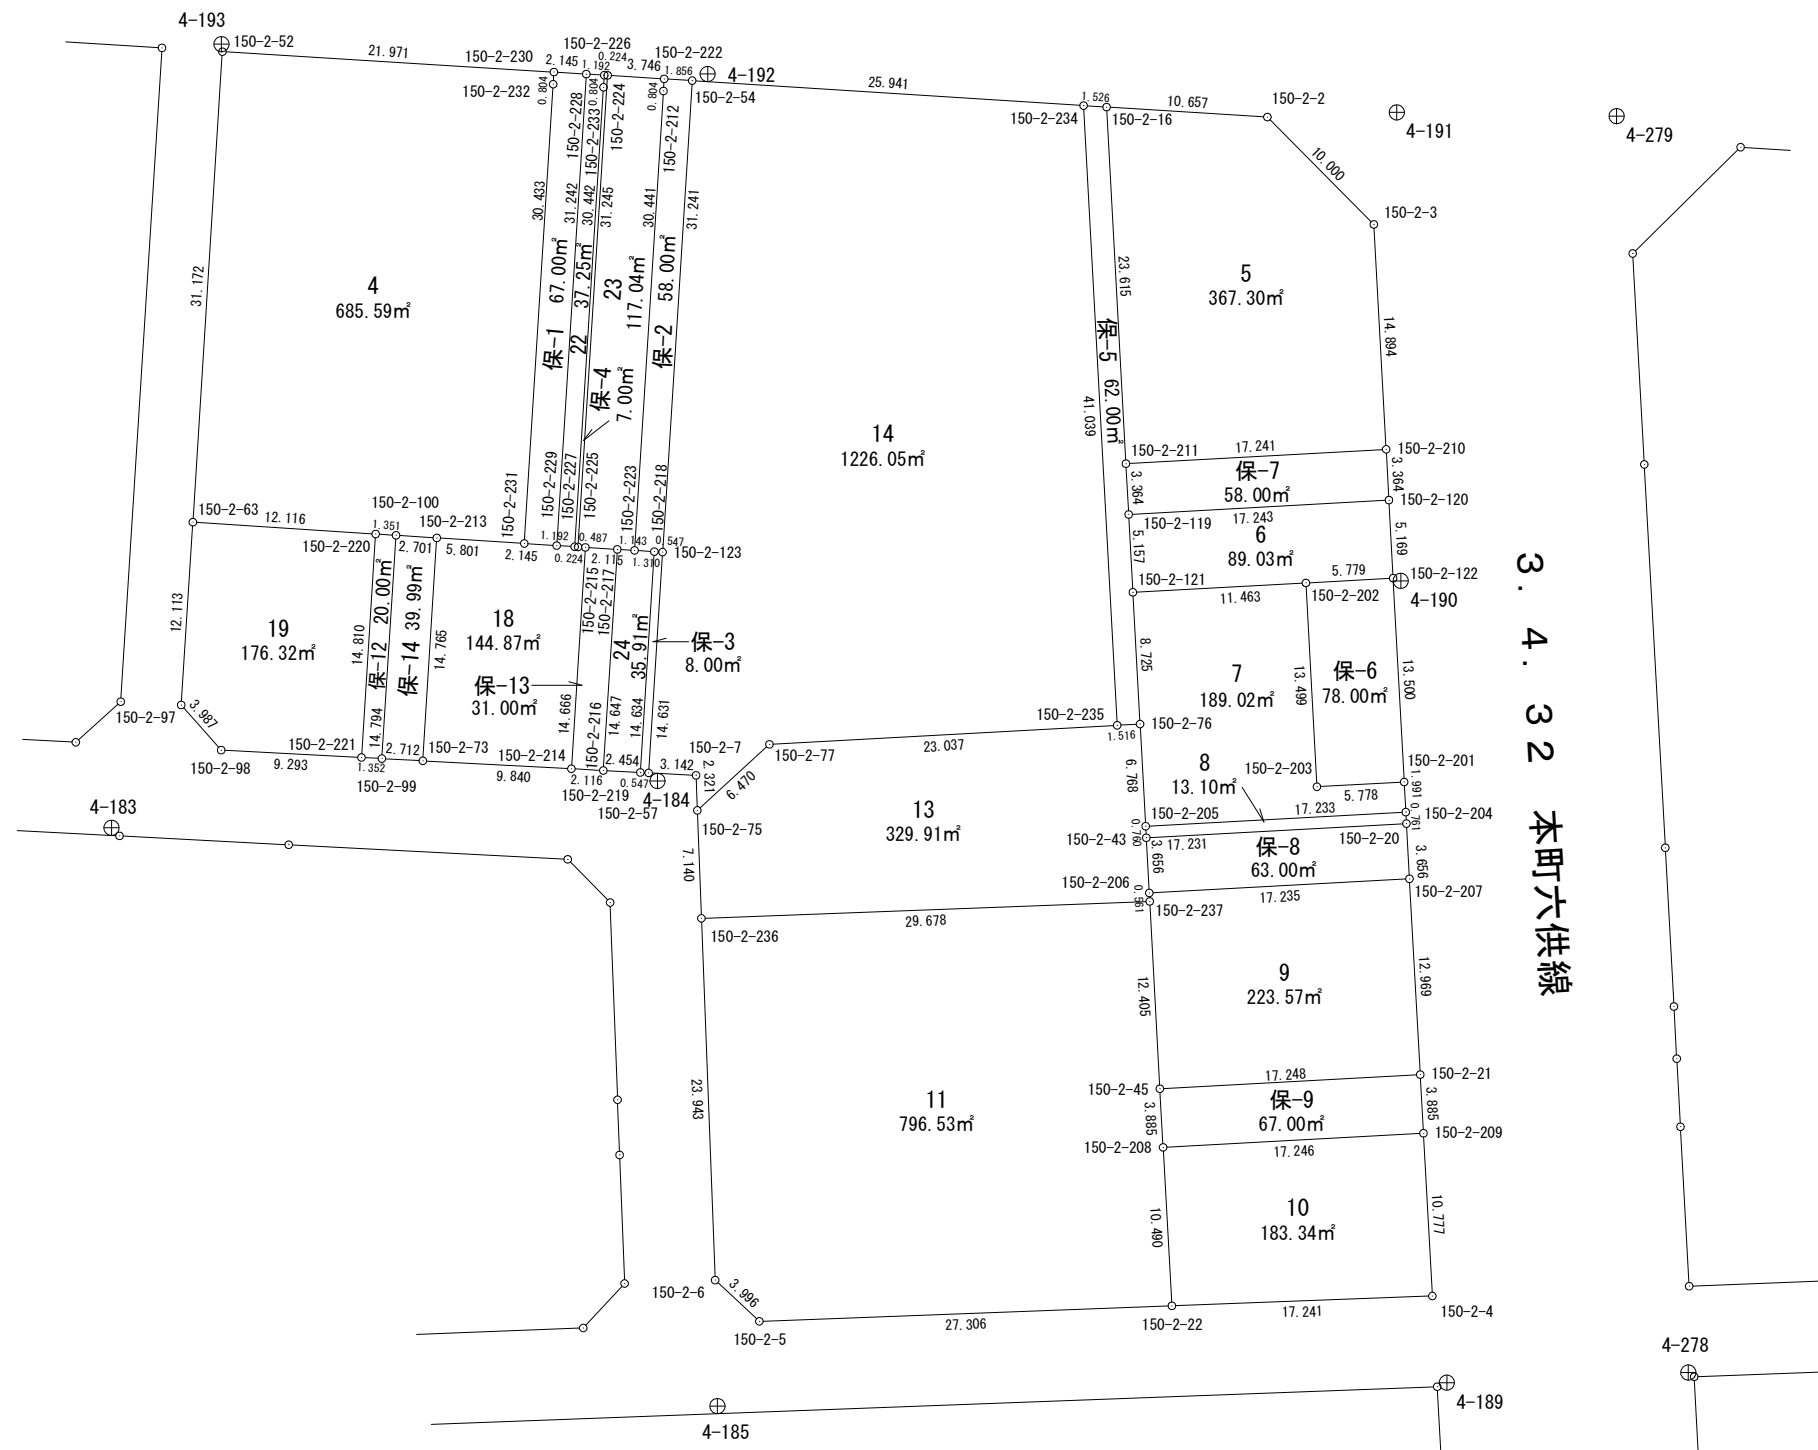


面積計算書（座標法）

世界測地系（測地成果2011）

所 在	地 番	公簿地目	現況地目	地 積	所 有 者
前橋市六供町三丁目	150-2-5			367.30 m ²	

点 名	X 座標	Y 座標	辺 長	方 向 角	測 角	DX	倍 積 (Y×DX)
150-2-210	41149.067	-67852.897	14.894	356-51-48	90-00-55	15.820	-1073432.830540
150-2-3	41163.939	-67853.712	10.000	315-14-35	138-22-47	21.973	-1490949.613776
150-2-2	41171.040	-67860.753	10.657	273-32-43	138-18-08	7.760	-526599.443280
150-2-16	41171.699	-67871.390	23.615	176-53-52	83-21-09	-22.921	1555680.130190
150-2-211	41148.119	-67870.112	17.241	86-50-53	89-57-01	-22.632	1536036.374784
						倍面積	734.617378
						面 積	367.3086890

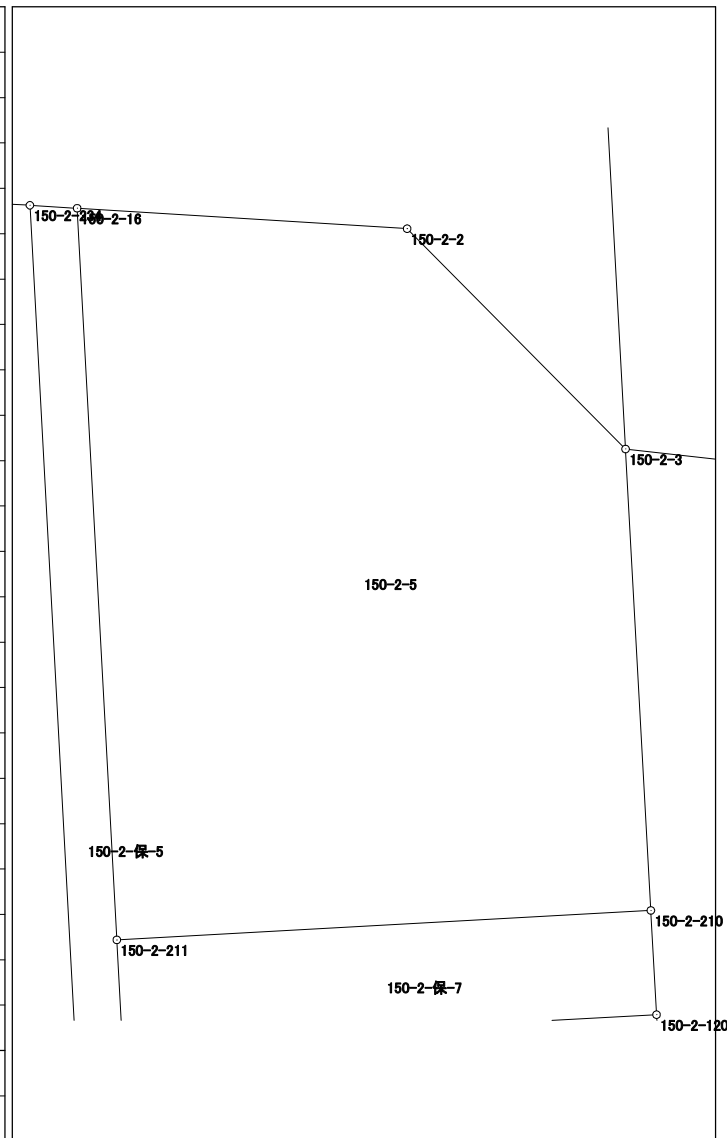


面積計算書 (座標法)

世界測地系 (測地成果2011)

所在	地番	公簿地目	現況地目	地積	所有者
前橋市六供町三丁目	150-2-6			89.03 m ²	

点名	X座標	Y座標	辺長	方向角	測角	DX	倍積 (Y×DX)
150-2-119	41144.760	-67869.930	5.157	176-54-37	90-03-43	-6.098	413870.833140
150-2-121	41139.610	-67869.652	11.463	86-53-22	89-58-45	-4.528	307313.784256
150-2-202	41140.232	-67858.206	5.779	86-53-06	179-59-44	0.936	-63515.280816
150-2-122	41140.546	-67852.436	5.169	356-55-42	90-02-36	5.476	-371559.939536
150-2-120	41145.708	-67852.713	17.243	266-50-54	89-55-12	4.214	-285931.332582
						倍面積	178.064462
						面積	89.0322310

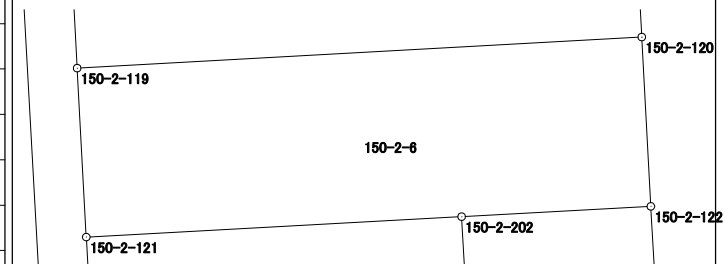


面積計算書（座標法）

世界測地系（測地成果2011）

所 在	地 番	公簿地目	現況地目	地 積	所 有 者
前橋市六供町三丁目	150-2-7			189.02 m ²	

点 名	X 座標	Y 座標	辺 長	方 向 角	測 角	DX	倍 積 (Y×DX)
150-2-204	41125.078	-67851.598	1.991	356-53-25	90-00-38	2.926	-198533.775748
150-2-201	41127.066	-67851.706	5.778	266-53-42	90-00-17	1.675	-113651.607550
150-2-203	41126.753	-67857.476	13.499	356-54-00	270-00-18	13.166	-893411.529016
150-2-202	41140.232	-67858.206	11.463	266-53-22	89-59-22	12.857	-872452.954542
150-2-121	41139.610	-67869.652	8.725	176-51-58	89-58-36	-9.334	633495.331768
150-2-76	41130.898	-67869.175	6.768	176-51-58	180-00-00	-15.470	1049936.137250
150-2-205	41124.140	-67868.805	17.233	86-52-47	90-00-49	-5.820	394996.445100

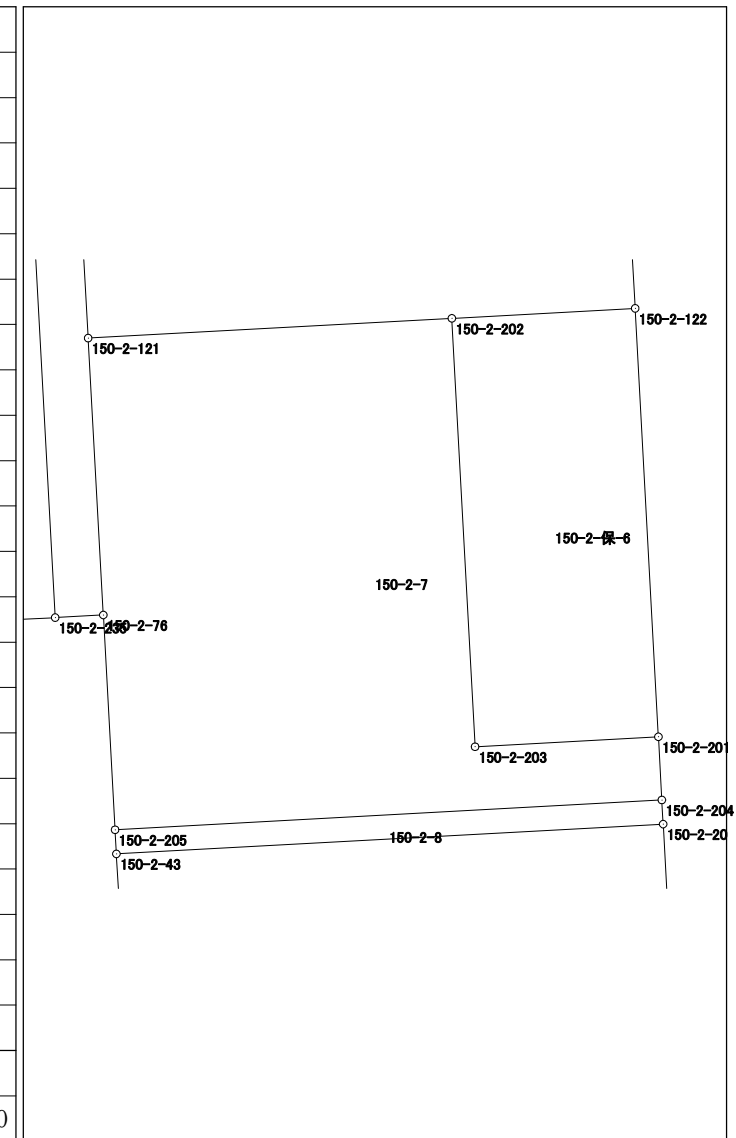


倍面積	378.047262
面 積	189.0236310

面積計算書 (座標法)

世界測地系 (測地成果2011)

所在	地番	公簿地目	現況地目	地積	所有者
前橋市六供町三丁目	150-2-8			13.10 m ²	

点名	X座標	Y座標	辺長	方向角	測角	DX	倍積 (Y×DX)
150-2-20	41124.318	-67851.557	0.761	356-54-43	90-01-45	1.697	-115144.092229
150-2-204	41125.078	-67851.598	17.233	266-52-47	89-58-04	-0.178	12077.584444
150-2-205	41124.140	-67868.805	0.760	176-49-58	89-57-11	-1.697	115173.362085
150-2-43	41123.381	-67868.763	17.231	86-52-58	90-03-00	0.178	-12080.639814
						倍面積	26.214486
						面積	13.1072430

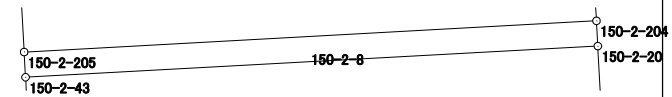


面積計算書（座標法）

世界測地系（測地成果2011）

所 在	地 番	公簿地目	現況地目	地 積	所 有 者
前橋市六供町三丁目	150-2-9			223.57 m ²	

点 名	X 座標	Y 座標	辺 長	方 向 角	測 角	DX	倍 積 (Y×DX)
150-2-206	41119.730	-67868.565	0.561	176-56-01	90-03-13	-1.498	101667.110370
150-2-237	41119.170	-67868.535	12.405	176-54-14	179-58-13	-12.947	878693.922645
150-2-45	41106.783	-67867.865	17.248	86-53-21	89-59-07	-11.451	777154.922115
150-2-21	41107.719	-67850.642	12.969	356-50-38	89-57-17	13.885	-942106.164170
150-2-207	41120.668	-67851.356	17.235	266-52-48	90-02-10	12.011	-814962.636916

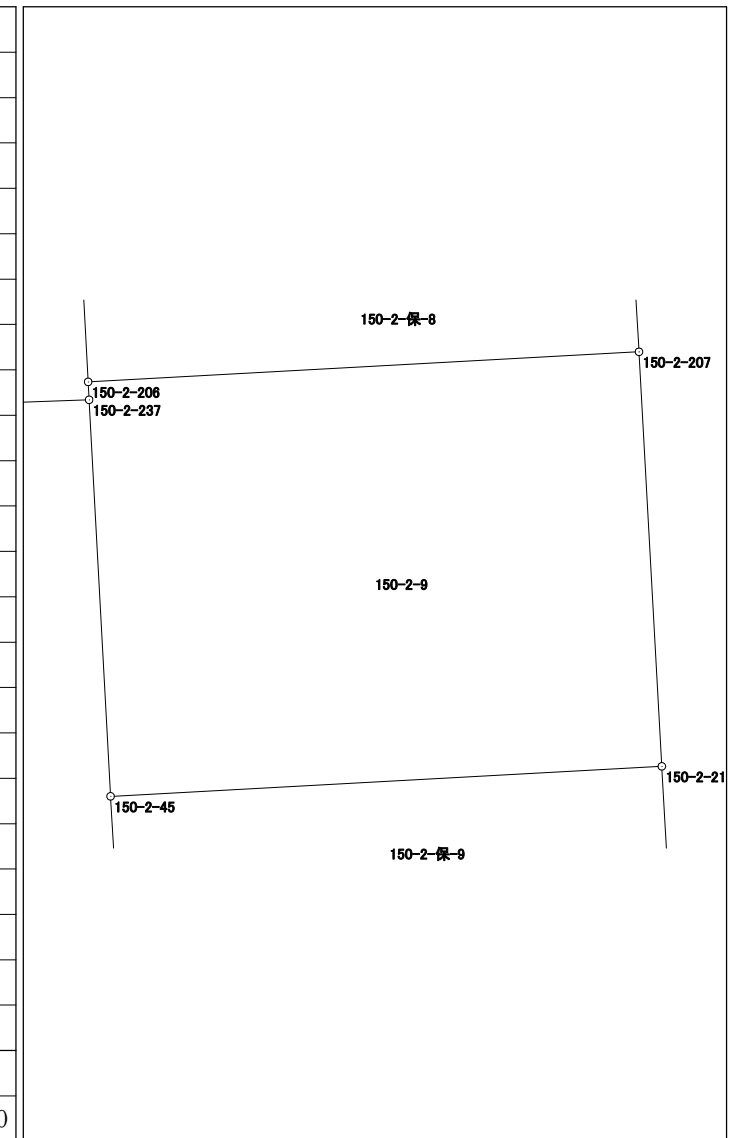


倍面積	447.154044
面積	223.5770220

面積計算書（座標法）

世界測地系（測地成果2011）

所 在	地 番	公簿地目	現況地目	地 積	所 有 者
前橋市六供町三丁目	150-2-10			183.34 m ²	

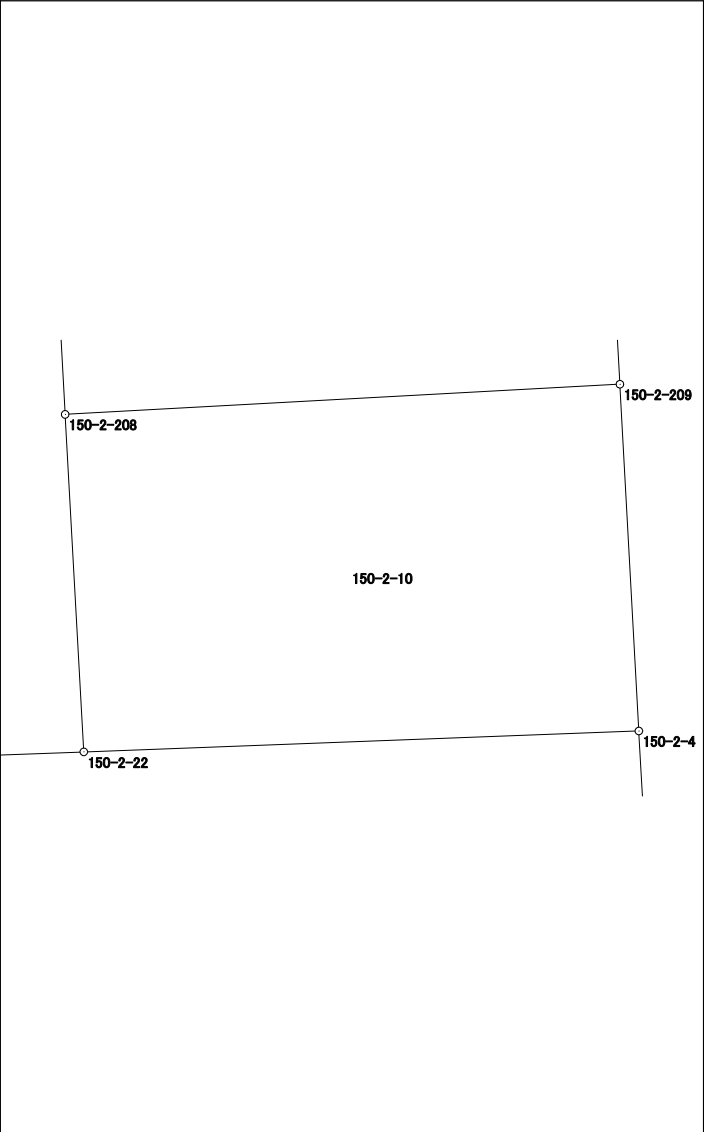
点 名	X 座標	Y 座標	辺 長	方 向 角	測 角	DX	倍 積 (Y×DX)		
150-2-208	41102.904	-67867.651	10.490	176-50-09	89-56-49	-11.410	774369.897910		
150-2-22	41092.430	-67867.072	17.241	87-50-34	91-00-25	-9.825	666793.982400		
150-2-4	41093.079	-67849.843	10.777	356-52-40	89-02-06	11.410	-774166.708630		
150-2-209	41103.840	-67850.430	17.246	266-53-20	90-00-40	9.825	-666630.474750		
									倍面積
									面積

面積計算書 (座標法)

世界測地系 (測地成果2011)

所在	地番	公簿地目	現況地目	地積	所有者
前橋市六供町三丁目	150-2-11			796.53 m ²	

点名	X座標	Y座標	辺長	方向角	測角	DX	倍積 (Y×DX)
150-2-236	41118.053	-67898.192	23.943	177-49-27	89-58-52	-25.043	1700374.422256
150-2-6	41094.127	-67897.283	3.996	132-58-19	135-08-52	-26.650	1809462.591950
150-2-5	41091.403	-67894.359	27.306	87-50-40	134-52-21	-1.697	115216.727223
150-2-22	41092.430	-67867.072	10.490	356-50-09	88-59-29	11.501	-780539.195072
150-2-208	41102.904	-67867.651	3.885	356-50-32	180-00-23	14.353	-974104.394803
150-2-45	41106.783	-67867.865	12.405	356-54-14	180-03-42	16.266	-1103938.692090
150-2-237	41119.170	-67868.535	29.678	267-50-35	90-56-21	11.270	-764878.389450
						倍面積	1593.070014
						面積	796.5350070

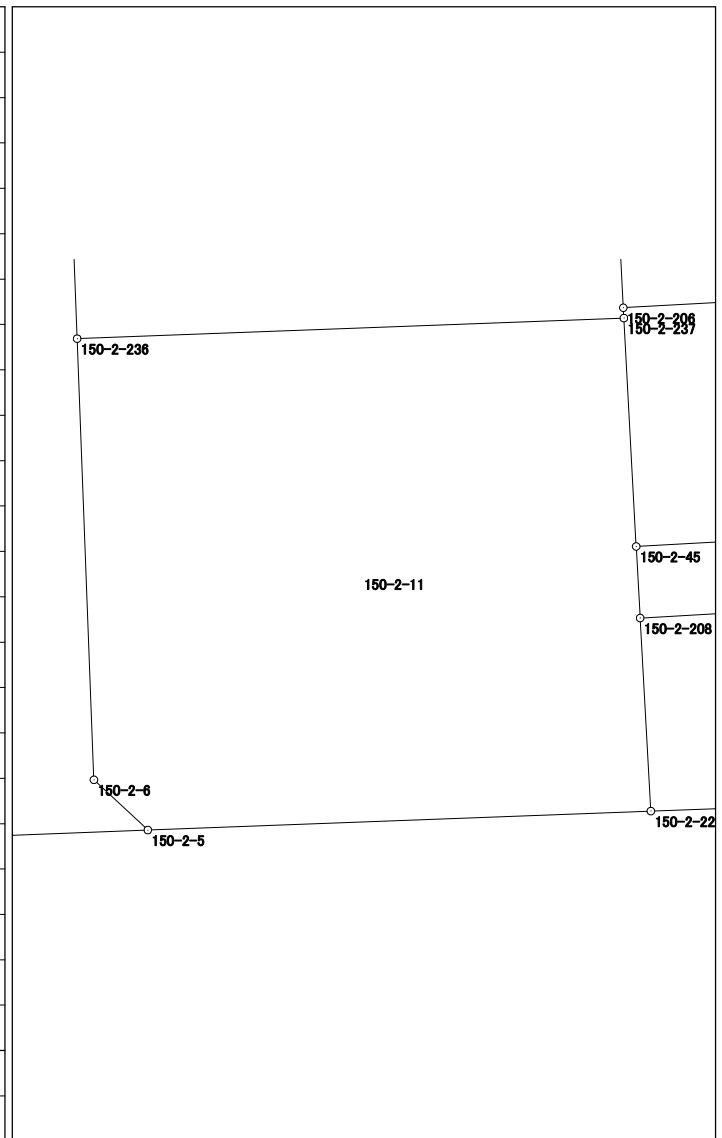


面積計算書（座標法）

世界測地系（測地成果2011）

所在	地番	公簿地目	現況地目	地積	所有者
前橋市六供町三丁目	150-2-13			329.91 m ²	

点名	X座標	Y座標	辺長	方向角	測角	DX	倍積 (Y×DX)
150-2-76	41130.898	-67869.175	1.516	266-53-59	90-02-01	6.676	-453094.612300
150-2-235	41130.816	-67870.689	23.037	266-52-11	179-58-12	-1.340	90946.723260
150-2-77	41129.558	-67893.692	6.470	227-30-43	140-38-32	-5.628	382105.698576
150-2-75	41125.188	-67898.463	7.140	177-49-29	130-18-46	-11.505	781171.816815
150-2-236	41118.053	-67898.192	29.678	87-50-35	90-01-06	-6.018	408611.319456
150-2-237	41119.170	-67868.535	0.561	356-56-01	89-05-26	1.677	-113815.533195
150-2-206	41119.730	-67868.565	3.656	356-53-45	179-57-44	4.211	-285794.527215
150-2-43	41123.381	-67868.763	0.760	356-49-58	179-56-13	4.410	-299301.244830
150-2-205	41124.140	-67868.805	6.768	356-51-58	180-02-00	7.517	-510169.807185

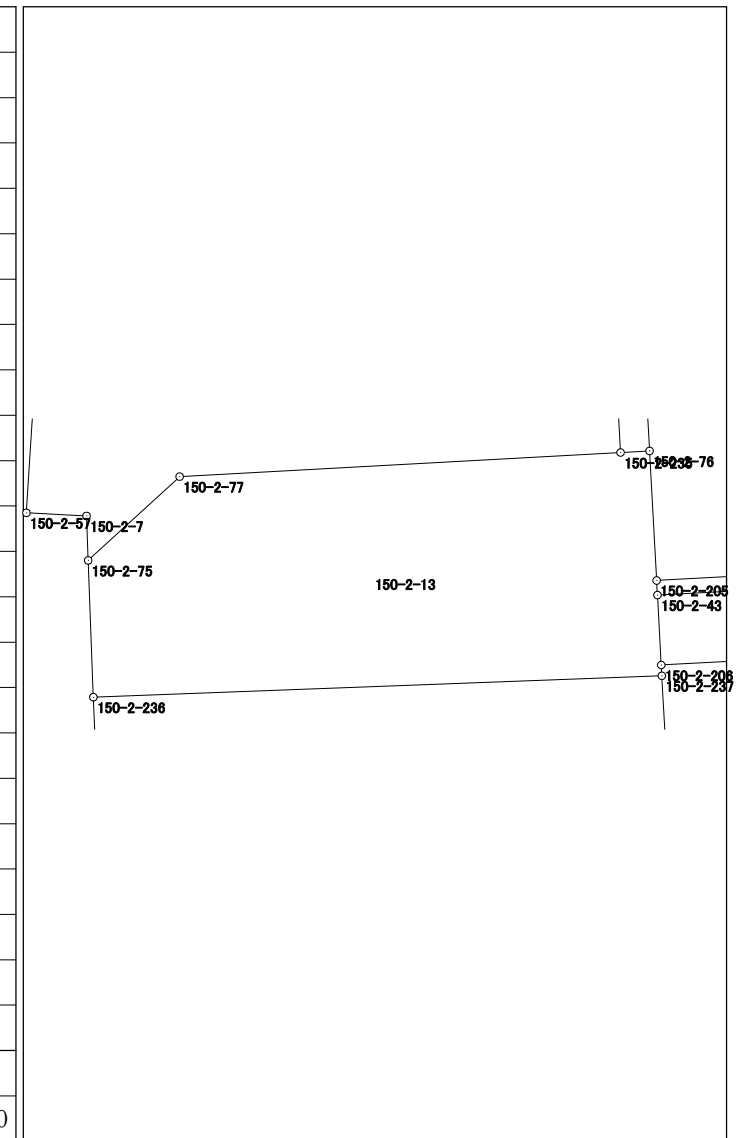


面積計算書 (座標法)

世界測地系 (測地成果2011)

所在	地番	公簿地目	現況地目	地積	所有者
前橋市六供町三丁目	150-2-14			1226.05 m ²	

点名	X座標	Y座標	辺長	方向角	測角	DX	倍積 (Y×DX)
150-2-234	41171.795	-67872.913	25.941	273-39-36	96-45-59	42.635	-2893761.645755
150-2-54	41173.451	-67898.801	31.241	183-35-36	89-56-00	-29.524	2004644.200724
150-2-123	41142.271	-67900.759	14.631	183-37-29	180-01-53	-45.782	3108632.548538
150-2-57	41127.669	-67901.684	3.142	92-56-13	89-18-44	-14.763	1002432.560892
150-2-7	41127.508	-67898.546	2.321	177-57-04	265-00-51	-2.481	168456.292626
150-2-75	41125.188	-67898.463	6.470	47-30-43	49-33-39	2.050	-139191.849150
150-2-77	41129.558	-67893.692	23.037	86-52-11	219-21-28	5.628	-382105.698576
150-2-235	41130.816	-67870.689	41.039	356-53-37	90-01-26	42.237	-2866654.291293

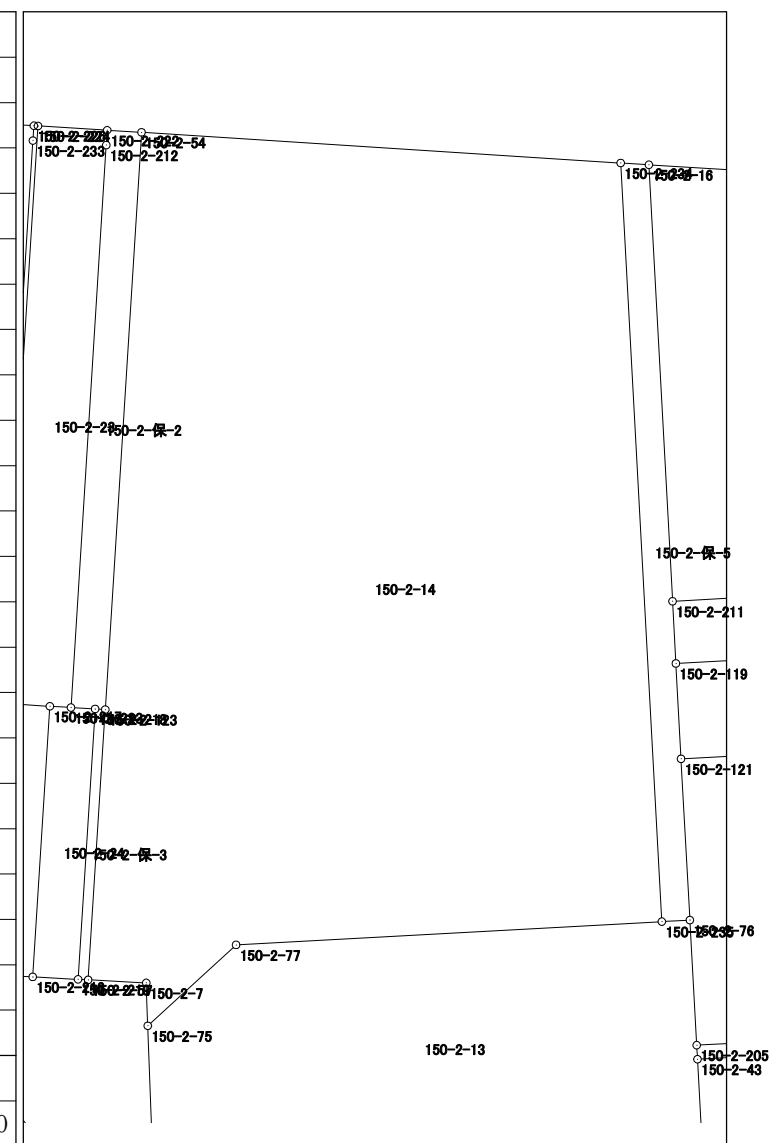


倍面積	2452.118006
面積	1226.0590030

面積計算書 (座標法)

所在	地番	公簿地目	現況地目	地積	所有者
前橋市六供町三丁目	150-2-18			144.87 m ²	

点名	X座標	Y座標	辺長	方向角	測角	DX	倍積 (Y×DX)
150-2-73	41128.471	-67916.619	9.840	93-04-33	89-29-16	-15.264	1036679.272416
150-2-214	41127.943	-67906.793	14.666	3-37-40	90-33-07	14.109	-958096.942437
150-2-215	41142.580	-67905.865	0.487	273-38-59	90-01-19	14.668	-996043.227820
150-2-225	41142.611	-67906.351	0.224	273-34-35	179-55-36	0.045	-3055.785795
150-2-227	41142.625	-67906.575	1.192	273-39-15	180-04-40	0.090	-6111.591750
150-2-229	41142.701	-67907.765	2.145	273-39-41	180-00-26	0.213	-14464.353945
150-2-231	41142.838	-67909.906	5.801	273-38-50	179-59-09	0.506	-34362.412436
150-2-213	41143.207	-67915.695	14.765	183-35-17	89-56-27	-14.367	975744.790065

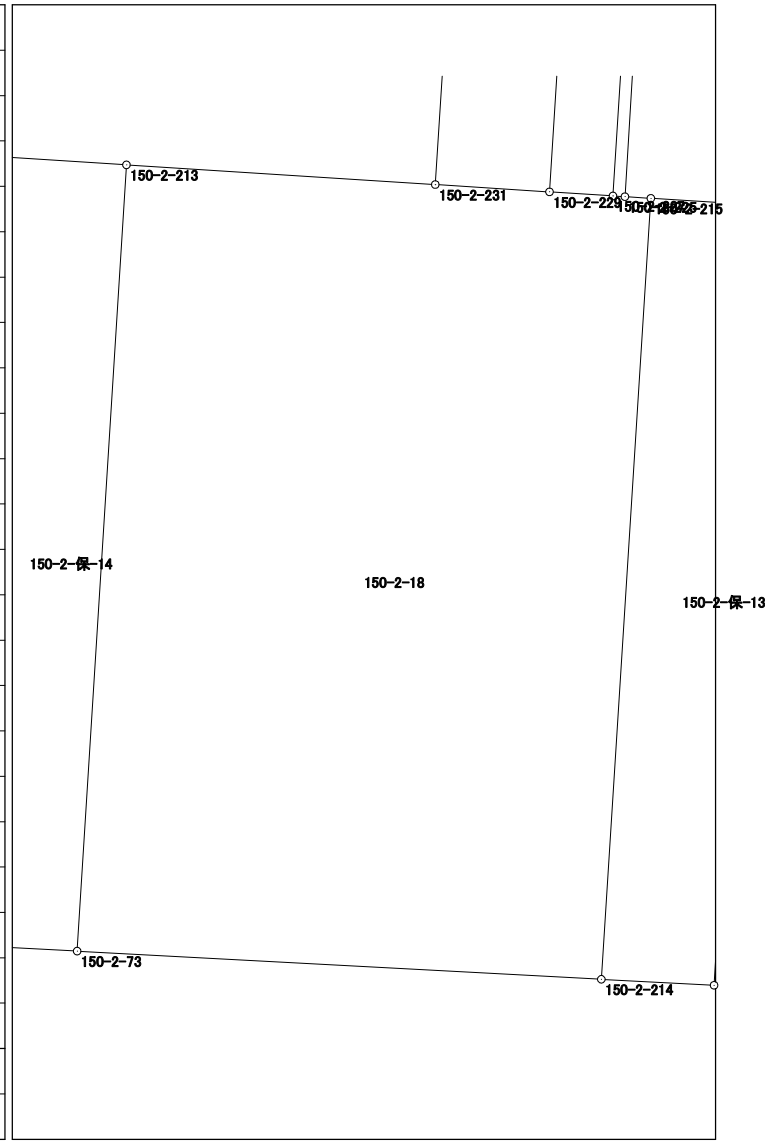


倍面積	289.748298
面積	144.8741490

面積計算書 (座標法)

世界測地系 (測地成果2011)

所在	地番	公簿地目	現況地目	地積	所有者
前橋市六供町三丁目	150-2-19			176.32 m ²	

点名	X座標	Y座標	辺長	方向角	測角	DX	倍積 (Y×DX)
150-2-220	41143.468	-67919.738	12.116	273-41-45	90-03-38	15.561	-1056899.043018
150-2-63	41144.249	-67931.829	12.113	183-38-58	89-57-13	-11.307	768105.190503
150-2-97	41132.161	-67932.600	3.987	138-28-39	134-49-41	-15.073	1023948.079800
150-2-98	41129.176	-67929.957	9.293	93-00-37	134-31-58	-3.473	235920.740661
150-2-221	41128.688	-67920.677	14.810	3-38-07	90-37-30	14.292	-970722.315684

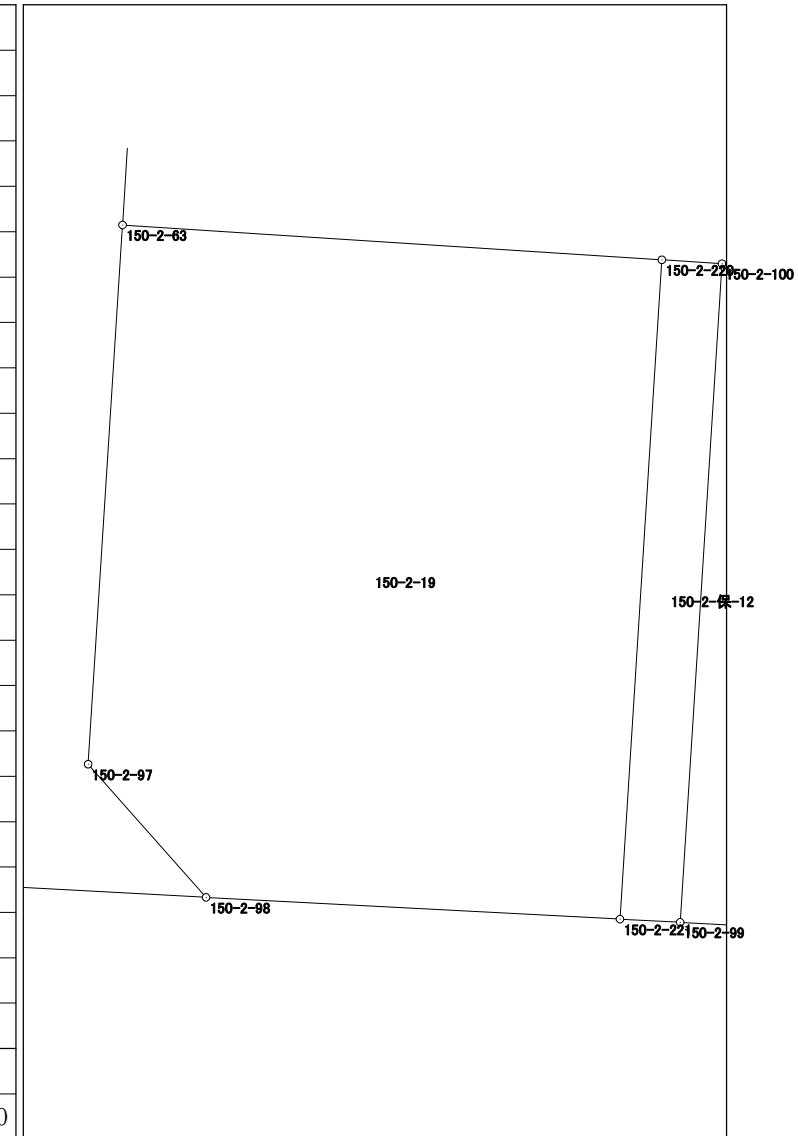

倍面積	352.652262
面積	176.3261310


面積計算書（座標法）

世界測地系（測地成果2011）

所在	地番	公簿地目	現況地目	地積	所有者
前橋市六供町三丁目	150-2-22			37.25 m ²	

点名	X 座標	Y 座標	辺長	方向角	測角	DX	倍積 (Y×DX)
150-2-227	41142.625	-67906.575	30.442	3-35-37	89-56-22	30.306	-2057976.661950
150-2-233	41173.007	-67904.667	0.804	3-34-03	179-58-26	31.184	-2117539.135728
150-2-226	41173.809	-67904.617	1.192	273-30-37	89-56-34	0.875	-59416.539875
150-2-228	41173.882	-67905.807	31.242	183-35-35	90-04-58	-31.108	2112413.844156
150-2-229	41142.701	-67907.765	1.192	93-39-15	90-03-40	-31.257	2122593.010605

倍面積	74.517208
面積	37.2586040

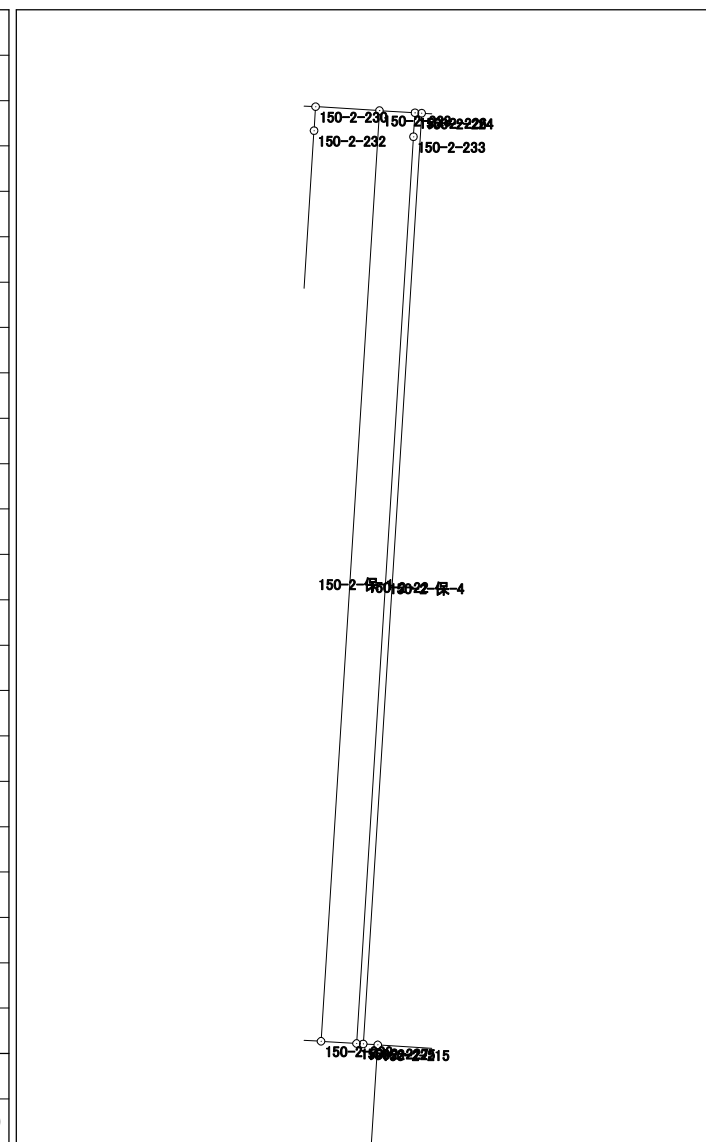


面積計算書 (座標法)

世界測地系 (測地成果2011)

所在	地番	公簿地目	現況地目	地積	所有者
前橋市六供町三丁目	150-2-23			117.04 m ²	

点名	X座標	Y座標	辺長	方向角	測角	DX	倍積 (Y×DX)
150-2-222	41173.564	-67900.654	3.746	273-32-07	89-58-04	1.033	-70141.375582
150-2-224	41173.795	-67904.393	31.245	183-35-34	90-03-27	-30.953	2101844.676529
150-2-225	41142.611	-67906.351	0.487	93-38-59	90-03-25	-31.215	2119696.746465
150-2-215	41142.580	-67905.865	2.115	93-34-41	179-55-42	-0.163	11068.655995
150-2-217	41142.448	-67903.754	1.143	93-21-38	179-46-57	-0.199	13512.847046
150-2-223	41142.381	-67902.613	30.441	3-35-44	90-14-06	30.314	-2058399.810482
150-2-212	41172.762	-67900.704	0.804	3-34-03	179-58-19	31.183	-2117347.652832
						倍面積	234.087139
						面積	117.0435695

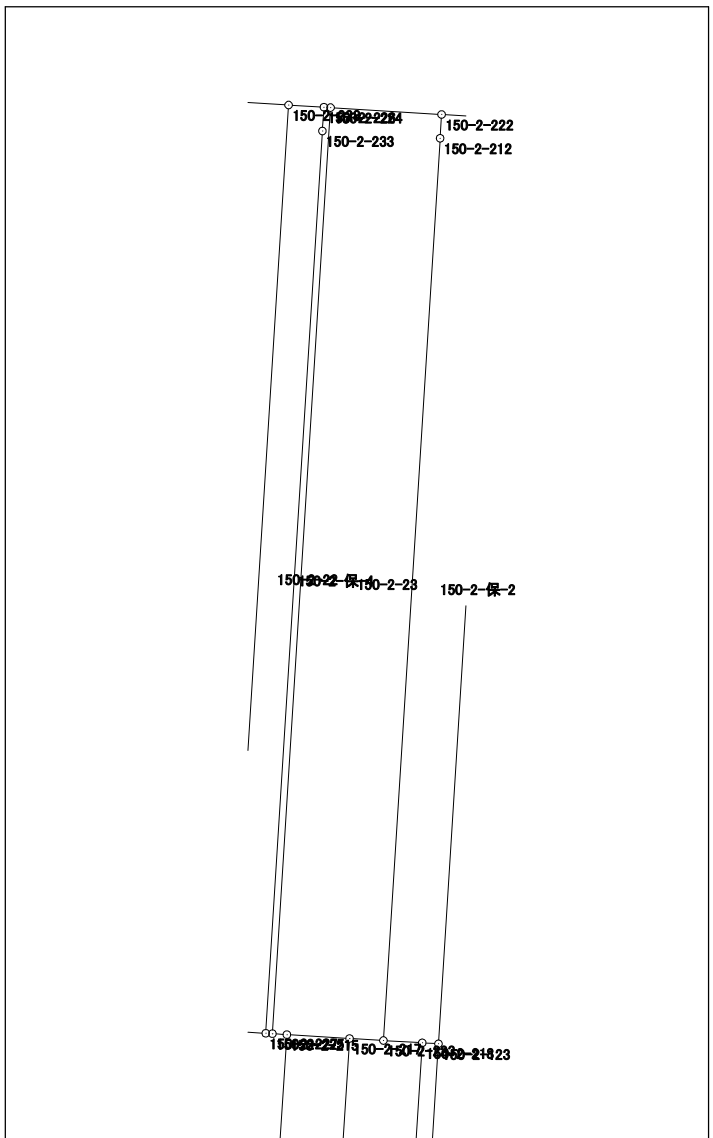


面積計算書 (座標法)

世界測地系 (測地成果2011)

所在	地番	公簿地目	現況地目	地積	所有者
前橋市六供町三丁目	150-2-24			35.91 m ²	

点名	X座標	Y座標	辺長	方向角	測角	DX	倍積 (Y×DX)
150-2-218	41142.303	-67901.305	1.310	273-24-46	89-47-20	14.683	-996994.861315
150-2-223	41142.381	-67902.613	1.143	273-21-38	179-56-52	0.145	-9845.878885
150-2-217	41142.448	-67903.754	14.647	183-37-29	90-15-51	-14.551	988067.524454
150-2-216	41127.830	-67904.680	2.454	93-05-02	89-27-33	-14.750	1001594.030000
150-2-219	41127.698	-67902.230	14.634	3-37-26	90-32-24	14.473	-982748.974790
倍面積							71.839464
面積							35.9197320

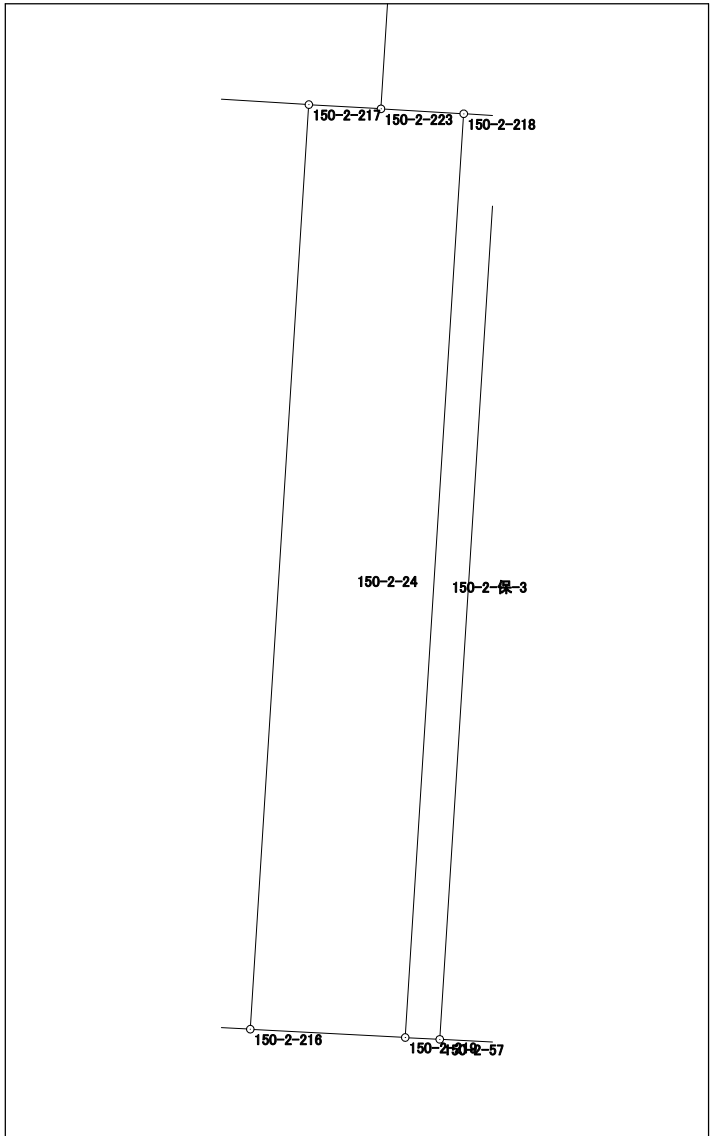


面積計算書（座標法）

世界測地系（測地成果2011）

所在	地番	公簿地目	現況地目	地積	所有者
前橋市六供町三丁目	150-2-保-2			58.00 m ²	

点名	X座標	Y座標	辺長	方向角	測角	DX	倍積(Y×DX)
150-2-123	41142.271	-67900.759	31.241	3-35-36	90-14-21	31.148	-2114972.841332
150-2-54	41173.451	-67898.801	1.856	273-29-23	89-53-47	31.293	-2124757.179693
150-2-222	41173.564	-67900.654	0.804	183-34-03	90-04-40	-0.689	46783.550606
150-2-212	41172.762	-67900.704	30.441	183-35-44	180-01-41	-31.183	2117347.652832
150-2-223	41142.381	-67902.613	1.310	93-24-46	89-49-02	-30.459	2068245.689367
150-2-218	41142.303	-67901.305	0.547	93-21-15	179-56-29	-0.110	7469.143550
						倍面積	116.015330
						面積	58.0076650

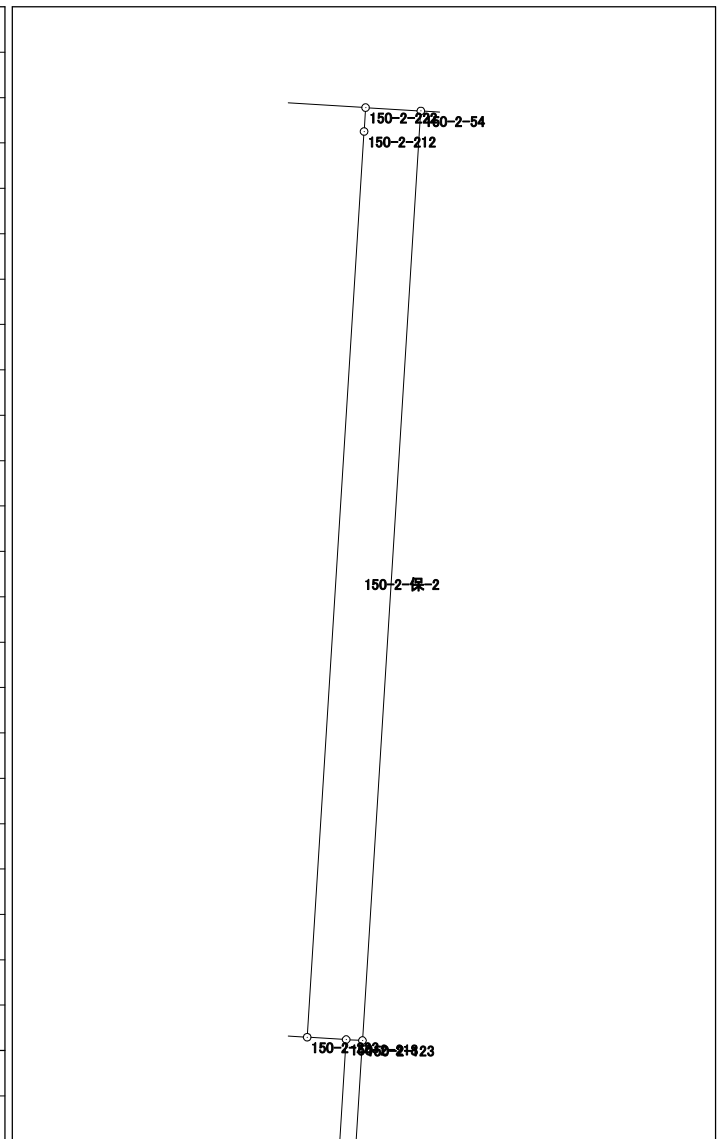


面積計算書（座標法）

世界測地系（測地成果2011）

所在	地番	公簿地目	現況地目	地積	所有者
前橋市六供町三丁目	150-2-保-3			8.00 m ²	

点名	X座標	Y座標	辺長	方向角	測角	DX	倍積 (Y×DX)
150-2-57	41127.669	-67901.684	14.631	3-37-29	90-35-04	14.573	-989531.240932
150-2-123	41142.271	-67900.759	0.547	273-21-15	89-43-46	14.634	-993659.707206
150-2-218	41142.303	-67901.305	14.634	183-37-26	90-16-11	-14.573	989525.717765
150-2-219	41127.698	-67902.230	0.547	93-02-25	89-24-59	-14.634	993681.233820

倍面積	16.003447
面積	8.0017235

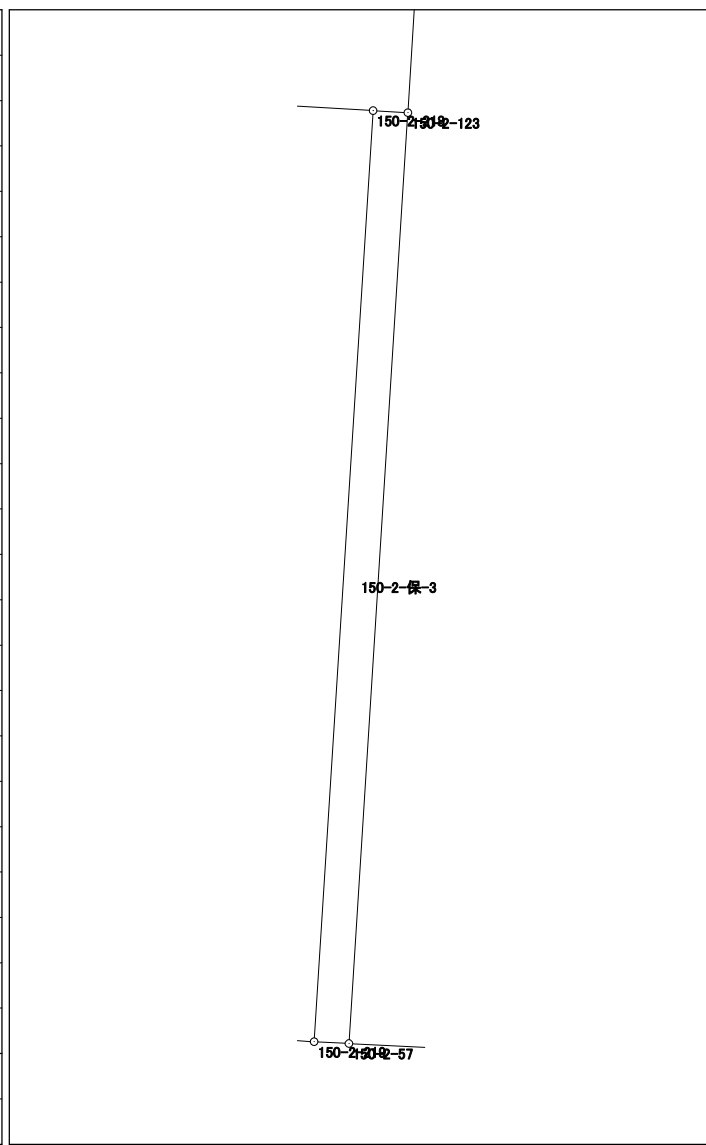


面積計算書 (座標法)

世界測地系 (測地成果2011)

所 在	地 番	公簿地目	現況地目	地 積	所 有 者
前橋市六供町三丁目	150-2-保-4			7.00 m ²	

点 名	X 座標	Y 座標	辺 長	方 向 角	測 角	DX	倍 積 (Y×DX)
150-2-225	41142.611	-67906.351	31.245	3-35-34	90-00-59	31.170	-2116640.960670
150-2-224	41173.795	-67904.393	0.224	273-34-35	89-59-01	31.198	-2118481.252814
150-2-226	41173.809	-67904.617	0.804	183-34-03	89-59-28	-0.788	53508.838196
150-2-233	41173.007	-67904.667	30.442	183-35-37	180-01-34	-31.184	2117539.135728
150-2-227	41142.625	-67906.575	0.224	93-34-35	89-58-58	-30.396	2064088.253700
						倍面積	14.014140
						面 積	7.0070700

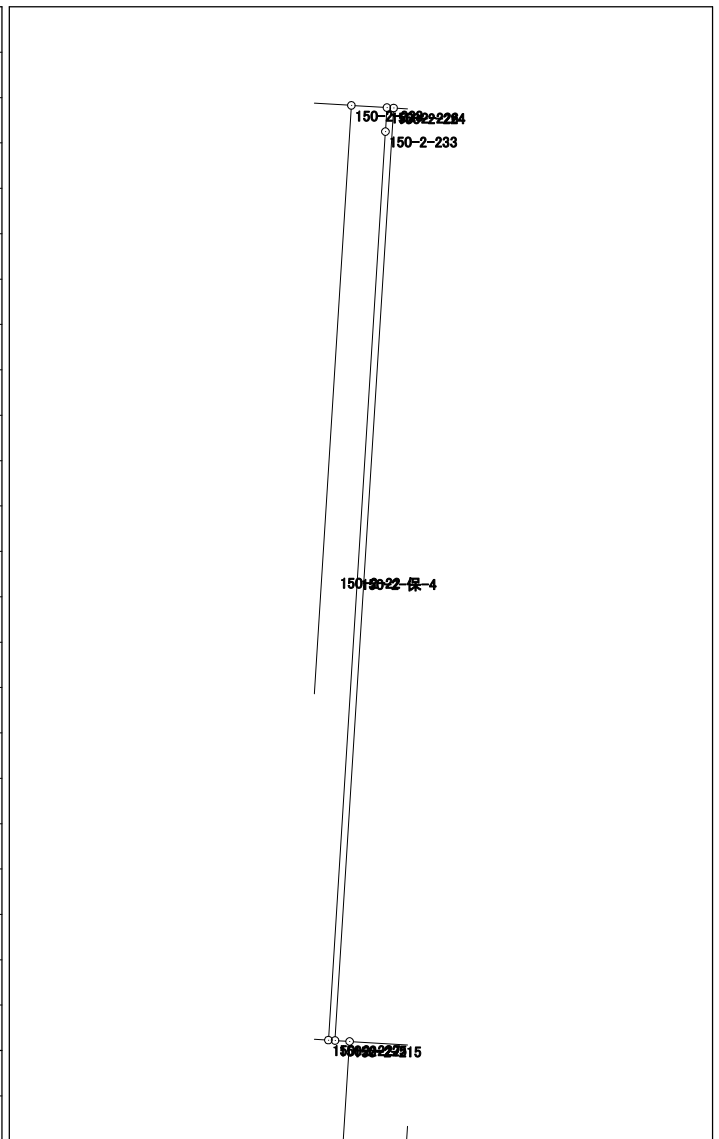


面積計算書 (座標法)

世界測地系 (測地成果2011)

所 在	地 番	公簿地目	現況地目	地 積	所 有 者
前橋市六供町三丁目	150-2-保-5			62.00 m ²	

点 名	X 座標	Y 座標	辺 長	方 向 角	測 角	DX	倍 積 (Y×DX)
150-2-76	41130.898	-67869.175	8.725	356-51-58	89-57-59	8.794	-596841.524950
150-2-121	41139.610	-67869.652	5.157	356-54-37	180-02-39	13.862	-940809.116024
150-2-119	41144.760	-67869.930	3.364	356-53-55	179-59-18	8.509	-577505.234370
150-2-211	41148.119	-67870.112	23.615	356-53-52	179-59-57	26.939	-1828352.947168
150-2-16	41171.699	-67871.390	1.526	273-36-24	96-42-32	23.676	-1606923.029640
150-2-234	41171.795	-67872.913	41.039	176-53-37	83-17-13	-40.883	2774848.302179
150-2-235	41130.816	-67870.689	1.516	86-53-59	90-00-22	-40.897	2775707.568033

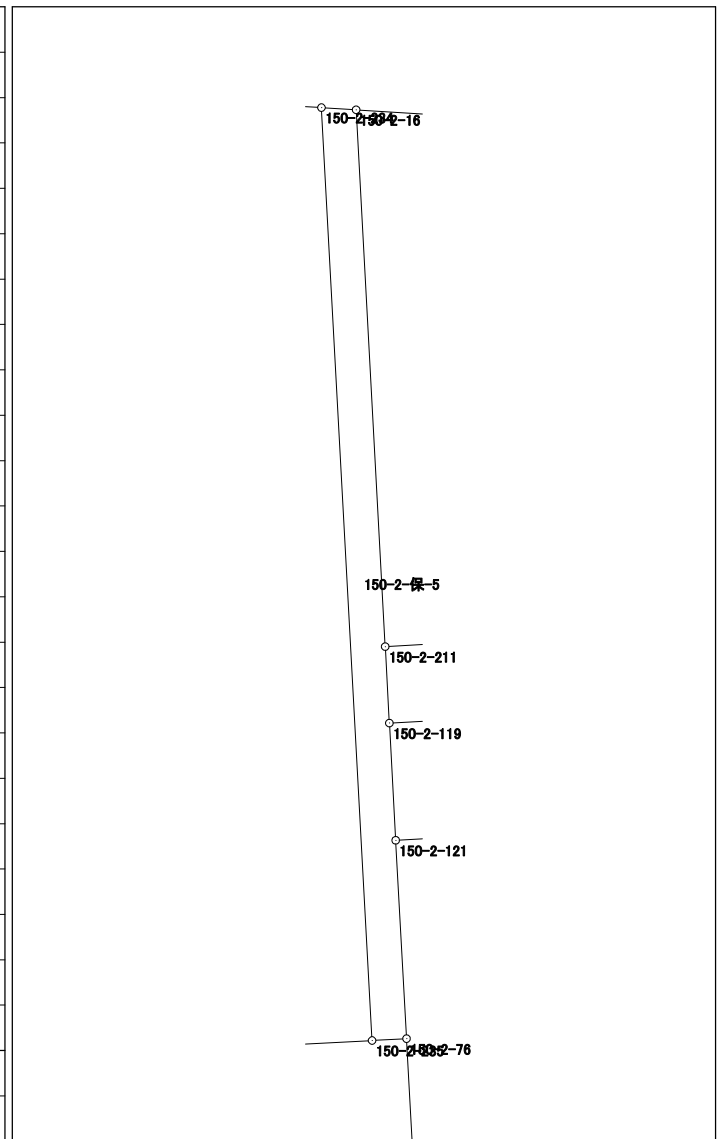


倍面積	124.018060
面 積	62.0090300

面積計算書（座標法）

世界測地系（測地成果2011）

所 在	地 番	公簿地目	現況地目	地 積	所 有 者
前橋市六供町三丁目	150-2-保-7			58.00 m ²	

点 名	X 座標	Y 座標	辺 長	方 向 角	測 角	DX	倍 積 (Y×DX)
150-2-120	41145.708	-67852.713	3.364	356-51-52	90-00-58	4.307	-292241.634891
150-2-210	41149.067	-67852.897	17.241	266-50-53	89-59-01	2.411	-163593.334667
150-2-211	41148.119	-67870.112	3.364	176-53-55	90-03-02	-4.307	292316.572384
150-2-119	41144.760	-67869.930	17.243	86-50-54	89-56-59	-2.411	163634.401230
						倍面積	116.004056
						面 積	58.0020280

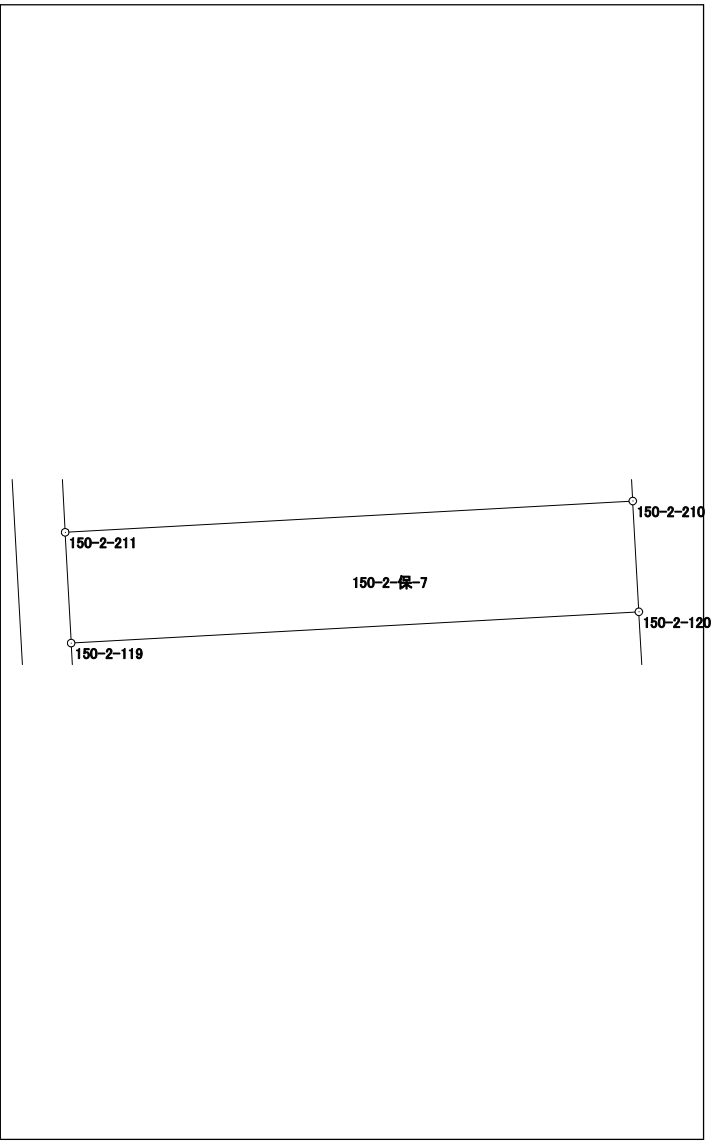

面積計算書 (座標法)

世界測地系 (測地成果2011)

所 在	地 番	公簿地目	現況地目	地 積	所 有 者
前橋市六供町三丁目	150-2-保-8			63.00 m ²	


点 名	X 座標	Y 座標	辺 長	方 向 角	測 角	DX	倍 積 (Y×DX)		
150-2-43	41123.381	-67868.763	3.656	176-53-45	90-00-47	-4.588	311381.884644		
150-2-206	41119.730	-67868.565	17.235	86-52-48	89-59-03	-2.713	184127.416845		
150-2-207	41120.668	-67851.356	3.656	356-50-53	89-58-05	4.588	-311302.021328		
150-2-20	41124.318	-67851.557	17.231	266-52-58	90-02-05	2.713	-184081.274141		
							倍面積	126.006020	
							面 積	63.0030100	

面積計算書（座標法）

世界測地系（測地成果2011）

所 在	地 番	公簿地目	現況地目	地 積	所 有 者
前橋市六供町三丁目	150-2-保-9			67.00 m ²	


点 名	X 座標	Y 座標	辺 長	方 向 角	測 角	DX	倍 積 (Y×DX)
150-2-45	41106.783	-67867.865	3.885	176-50-32	89-57-11	-4.815	326783.769975
150-2-208	41102.904	-67867.651	17.246	86-53-20	90-02-48	-2.943	199734.496893
150-2-209	41103.840	-67850.430	3.885	356-52-18	89-58-58	4.815	-326699.820450
150-2-21	41107.719	-67850.642	17.248	266-53-21	90-01-03	2.943	-199684.439406
						倍面積	134.007012
						面 積	67.0035060

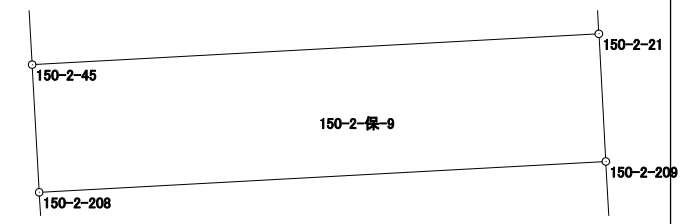

面積計算書 (座標法)

所在	地番	公簿地目	現況地目	地積	所有者
前橋市六供町三丁目	150-2-保-12			20.00 m ²	

点名	X座標	Y座標	辺長	方向角	測角	DX	倍積 (Y×DX)
150-2-99	41128.617	-67919.327	14.794	3-37-53	90-37-15	14.693	-997938.671611
150-2-100	41143.381	-67918.390	1.351	273-41-34	90-03-41	14.851	-1008656.009890
150-2-220	41143.468	-67919.738	14.810	183-38-07	89-56-33	-14.693	997944.710434
150-2-221	41128.688	-67920.677	1.352	93-00-38	89-22-31	-14.851	1008689.974127

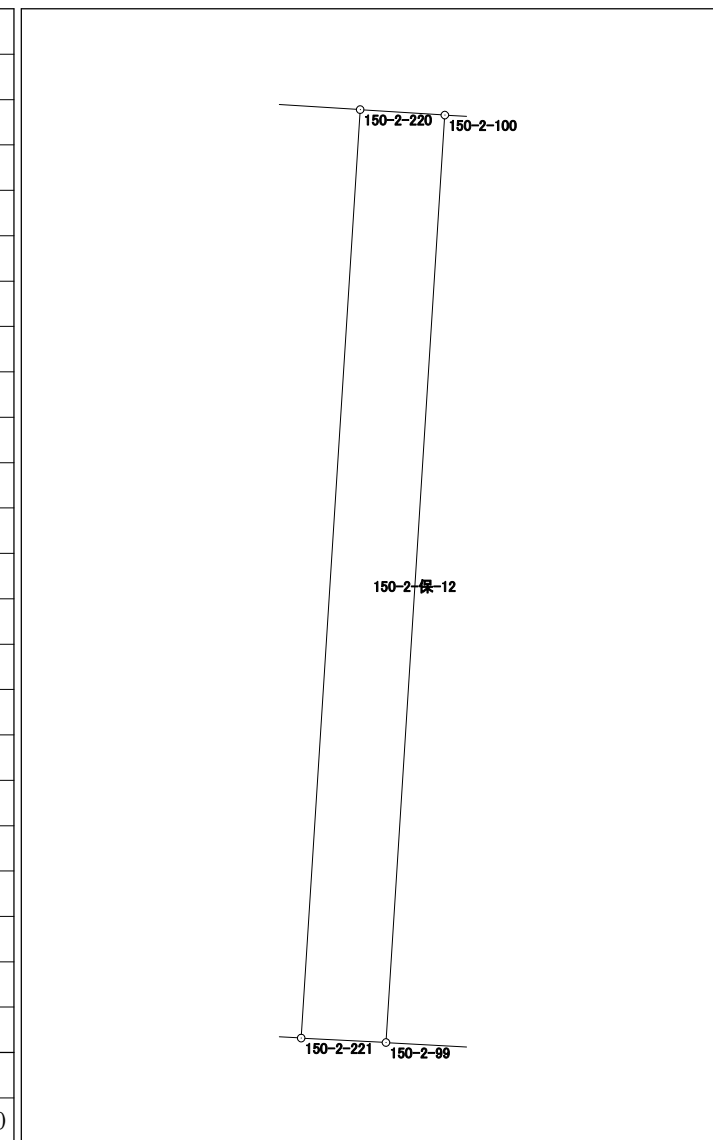


倍面積	40.003060
面積	20.0015300

面積計算書（座標法）

世界測地系（測地成果2011）

所在	地番	公簿地目	現況地目	地積	所有者
前橋市六供町三丁目	150-2-保-13			31.00 m ²	

点名	X座標	Y座標	辺長	方向角	測角	DX	倍積 (Y×DX)
150-2-214	41127.943	-67906.793	2.116	93-03-40	89-26-00	-14.750	1001625.196750
150-2-216	41127.830	-67904.680	14.647	3-37-29	90-33-49	14.505	-984957.383400
150-2-217	41142.448	-67903.754	2.115	273-34-41	89-57-12	14.750	-1001580.371500
150-2-215	41142.580	-67905.865	14.666	183-37-40	90-02-59	-14.505	984974.571825

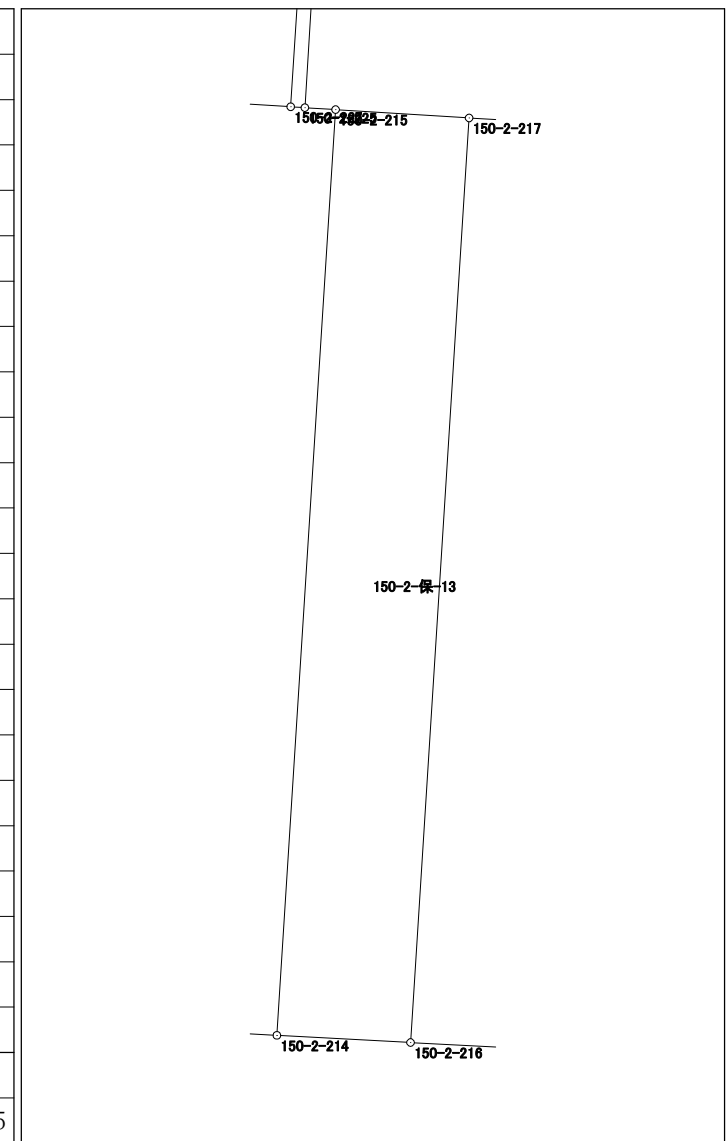

倍面積	62.013675
面積	31.0068375

面積計算書（座標法）

世界測地系（測地成果2011）

所 在	地 番	公簿地目	現況地目	地 積	所 有 者
前橋市六供町三丁目	150-2-保-14			39.99 m ²	

点 名	X 座 標	Y 座 標	辺 長	方 向 角	測 角	DX	倍 積 (Y×DX)
150-2-73	41128.471	-67916.619	14.765	3-35-17	90-30-07	14.590	-990903.471210
150-2-213	41143.207	-67915.695	2.701	273-41-39	90-06-22	14.910	-1012623.012450
150-2-100	41143.381	-67918.390	14.794	183-37-53	89-56-14	-14.590	990929.310100
150-2-99	41128.617	-67919.327	2.712	93-05-10	89-27-17	-14.910	1012677.165570
						倍面積	79.992010
						面 積	39.9960050

