



153-1街区
153-2街区 画地出来形確認図 (8857.45m²)

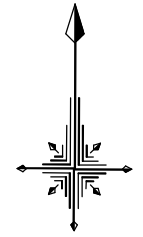

S=1/500

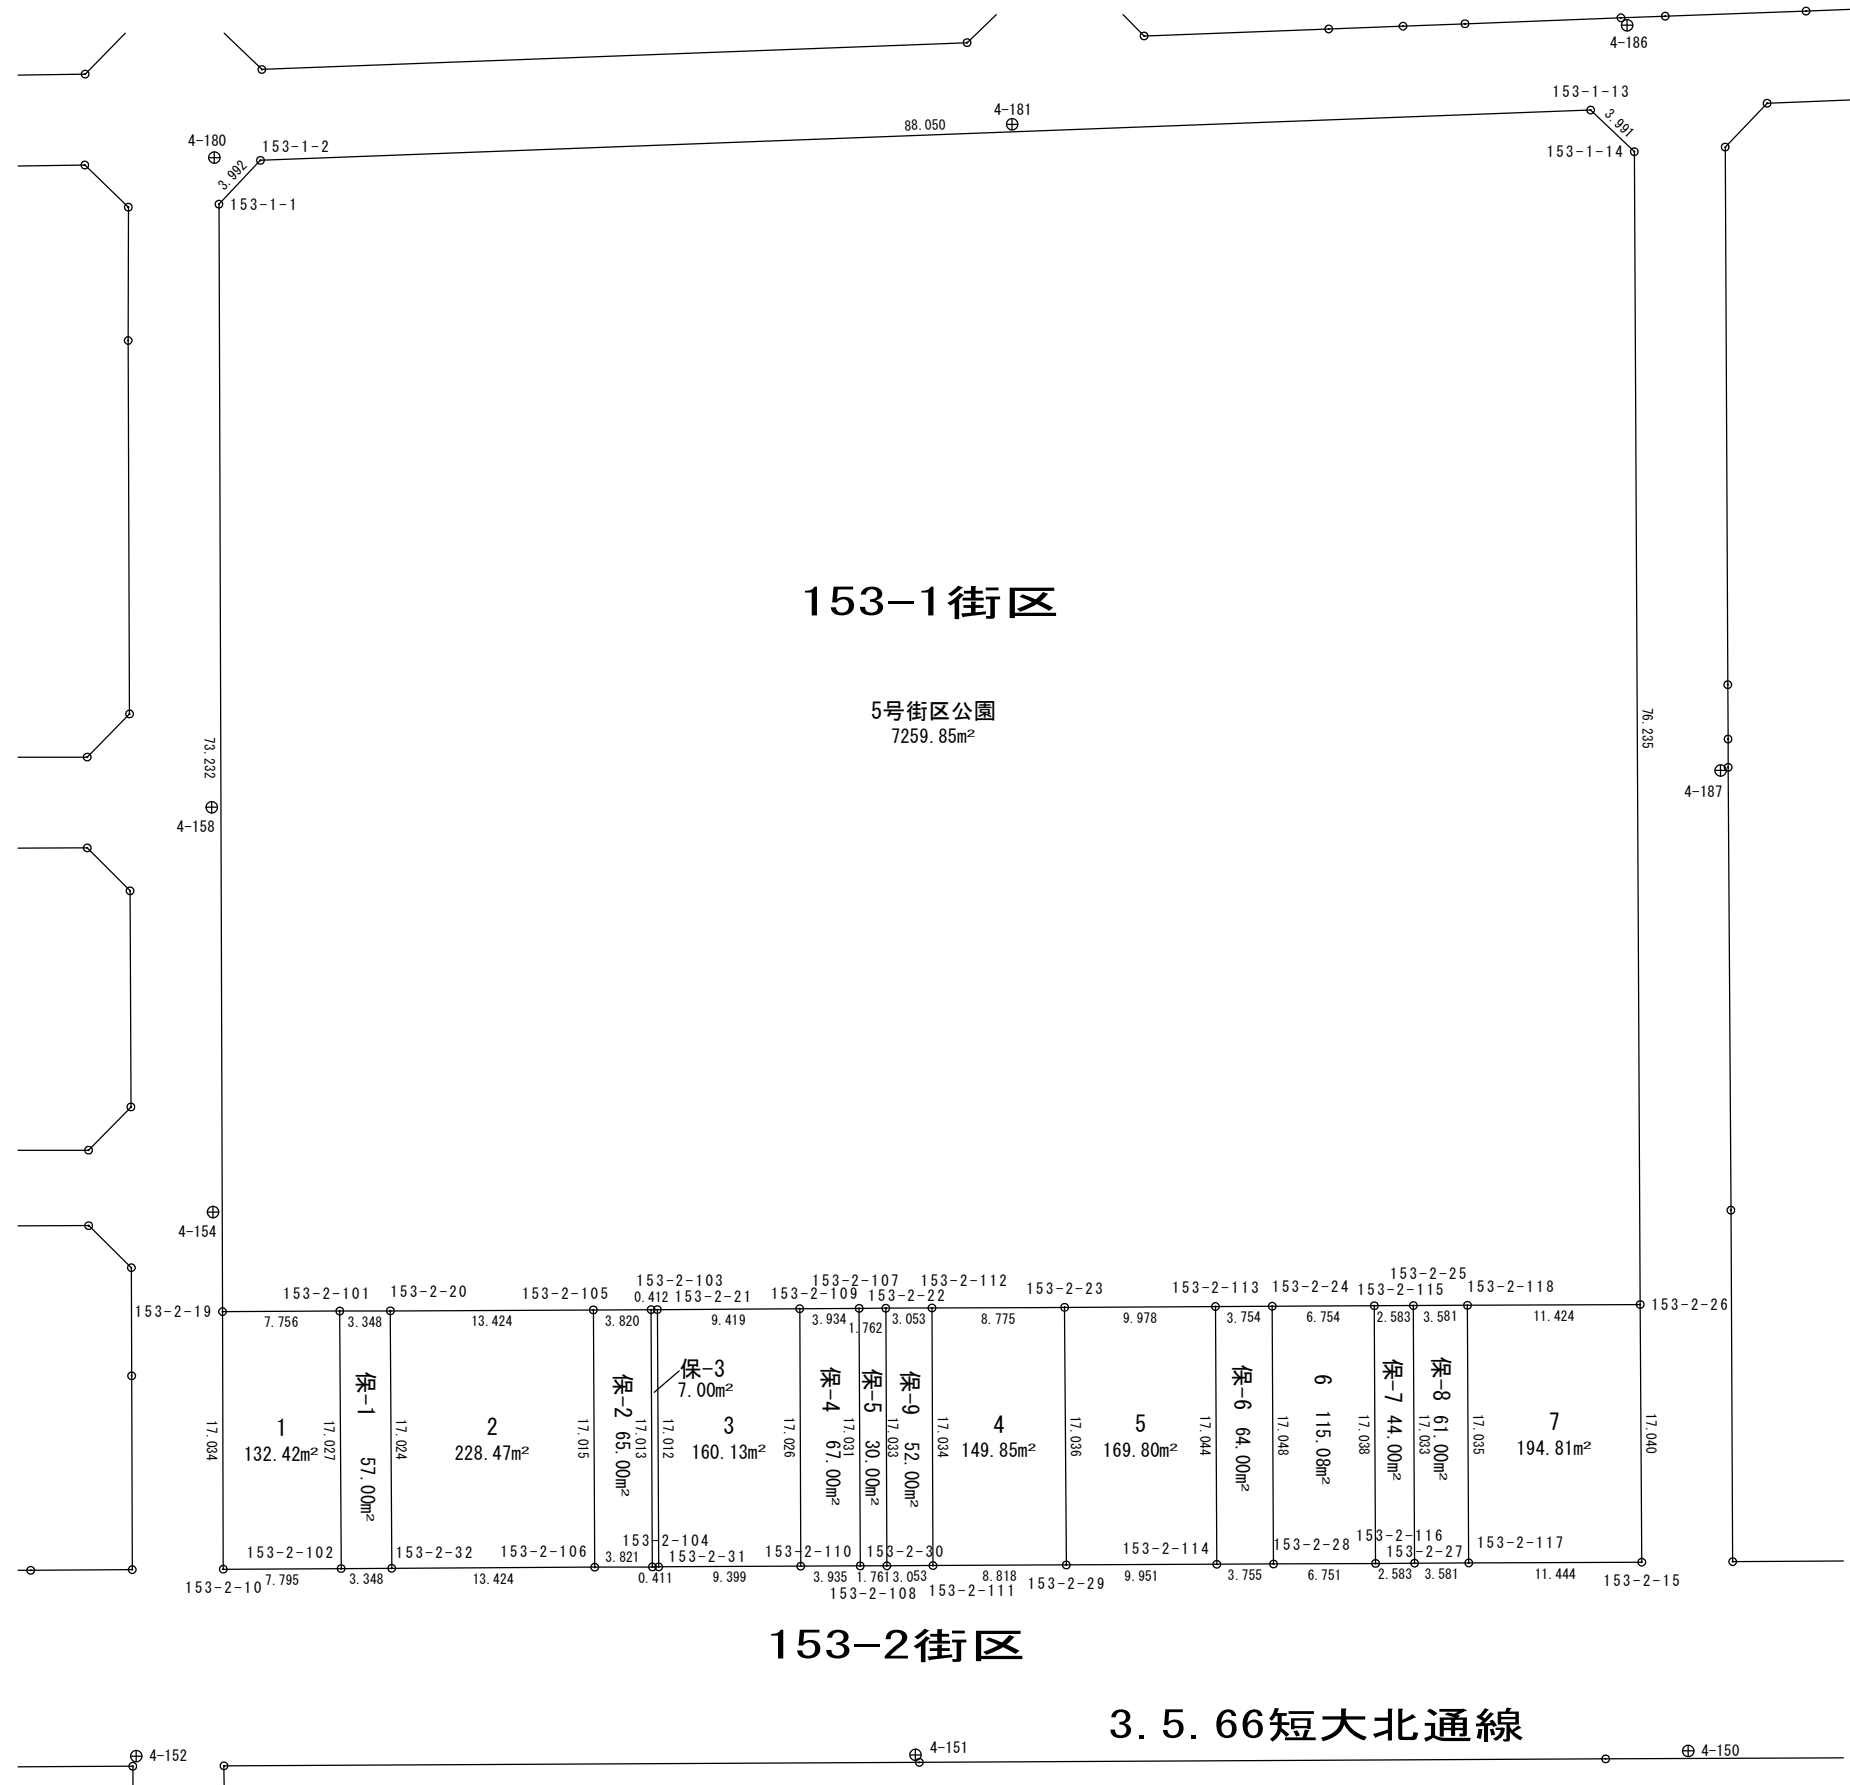


面積計算書 (座標法)

世界測地系 (測地成果2011)

所在	地番	公簿地目	現況地目	地積	所有者
前橋市六供町三丁目	153-2-1			132.42 m ²	

点名	X座標	Y座標	辺長	方向角	測角	DX	倍積 (Y×DX)
153-2-102	40987.324	-68019.895	17.027	359-42-02	90-00-33	17.069	-1161031.587755
153-2-101	41004.351	-68019.984	7.756	269-44-29	90-02-27	16.992	-1155795.568128
153-2-19	41004.316	-68027.740	17.034	179-49-55	90-05-26	-17.069	1161165.494060
153-2-10	40987.282	-68027.690	7.795	89-41-29	89-51-34	-16.992	1155926.508480
倍面積						264.846657	
面積						132.4233285	

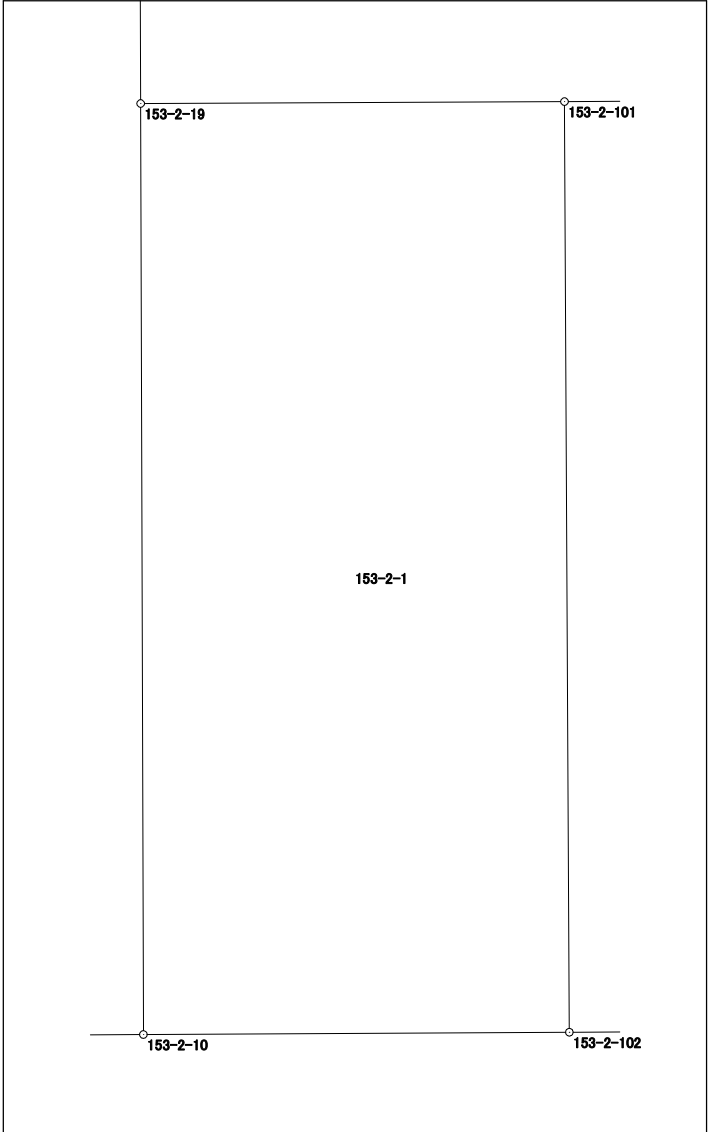


面積計算書（座標法）

世界測地系（測地成果2011）

所 在	地 番	公簿地目	現況地目	地 積	所 有 者
前橋市六供町三丁目	153-2-2			228.47 m ²	

点 名	X 座 標	Y 座 標	辺 長	方 向 角	測 角	DX	倍 積 (Y×DX)
153-2-106	40987.412	-68003.123	17.015	359-42-01	89-59-57	17.085	-1161833.356455
153-2-105	41004.427	-68003.212	13.424	269-44-23	90-02-22	16.954	-1152926.456248
153-2-20	41004.366	-68016.636	17.024	179-42-02	89-57-39	-17.085	1162064.226060
153-2-32	40987.342	-68016.547	13.424	89-42-04	90-00-02	-16.954	1153152.537838
倍面積						456.951195	
面 積						228.475975	

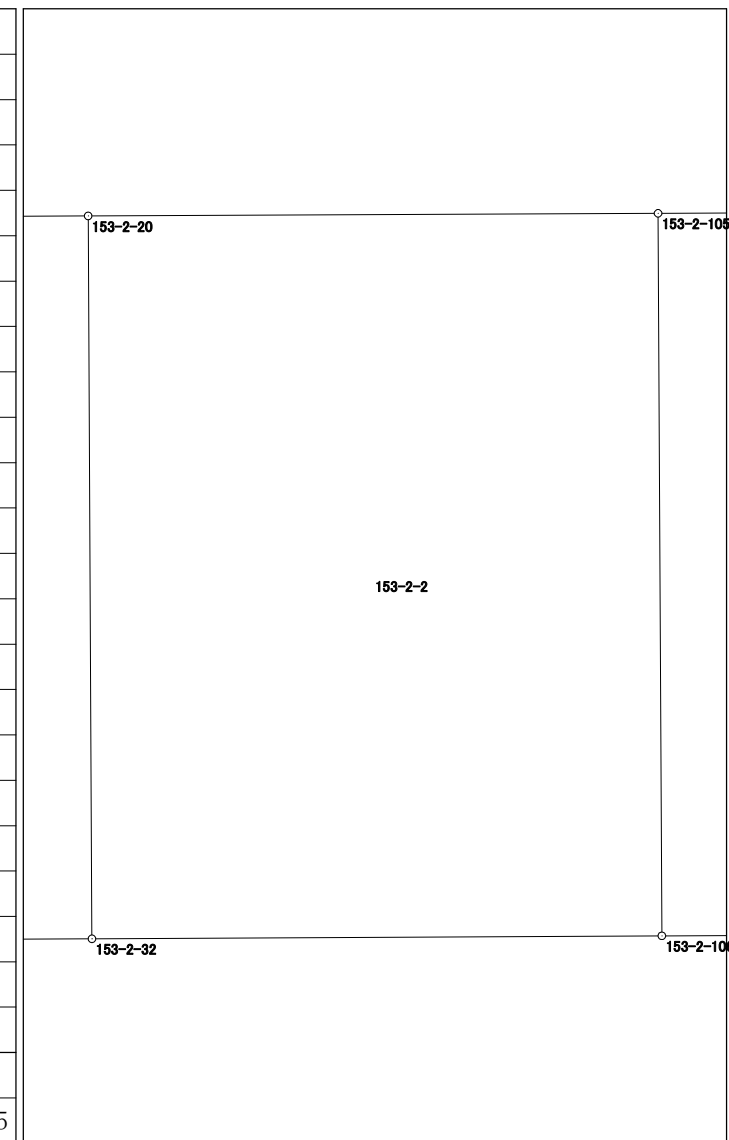


面積計算書（座標法）

世界測地系（測地成果2011）

所 在	地 番	公簿地目	現況地目	地 積	所 有 者
前橋市六供町三丁目	153-2-3			160.13 m ²	

点 名	X 座標	Y 座標	辺 長	方 向 角	測 角	DX	倍 積 (Y×DX)
153-2-110	40987.479	-67989.492	17.026	359-46-04	90-02-10	17.070	-1160580.628440
153-2-109	41004.505	-67989.561	9.419	269-38-50	89-52-46	16.968	-1153646.871048
153-2-21	41004.447	-67998.980	17.012	179-42-01	90-03-11	-17.070	1160742.588600
153-2-31	40987.435	-67998.891	9.399	89-43-54	90-01-53	-16.968	1153805.182488
						倍面積	320.271600
						面 積	160.1358000

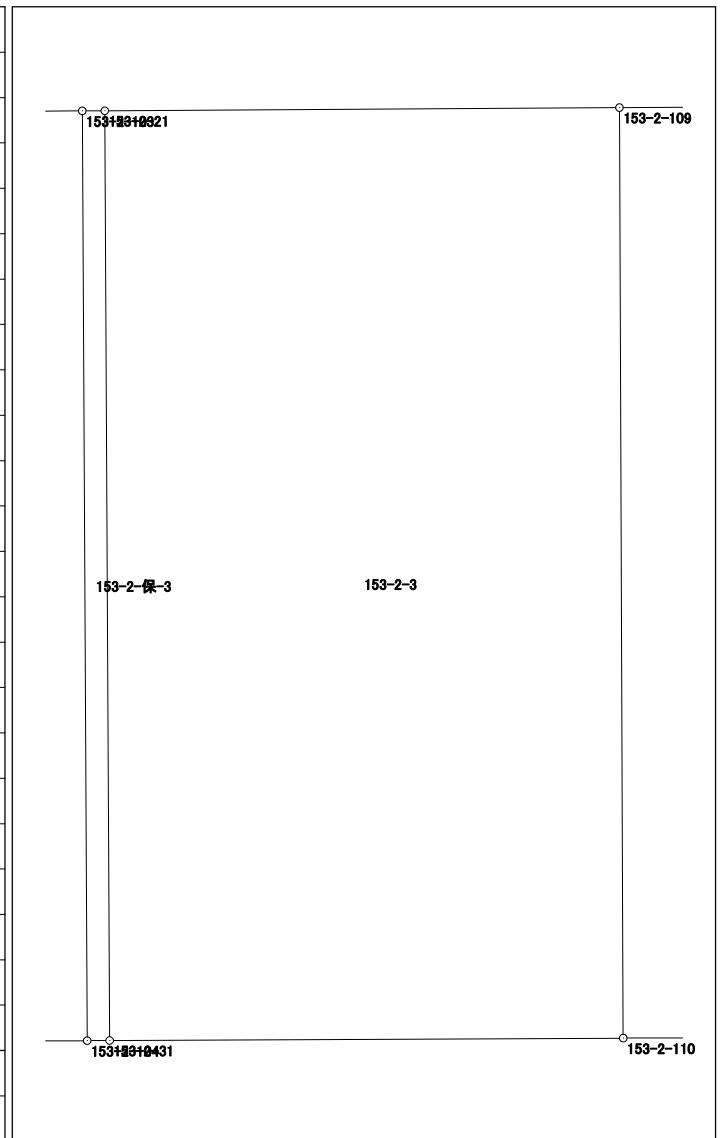


面積計算書 (座標法)

世界測地系 (測地成果2011)

所 在	地 番	公簿地目	現況地目	地 積	所 有 者
前橋市六供町三丁目	153-2-4			149.85 m ²	

点 名	X 座標	Y 座標	辺 長	方 向 角	測 角	DX	倍 積 (Y×DX)
153-2-112	41004.555	-67980.812	17.034	179-46-04	90-02-55	-17.077	1160908.326524
153-2-111	40987.521	-67980.743	8.818	89-44-01	89-57-57	-16.993	1155196.765799
153-2-29	40987.562	-67971.925	17.036	359-37-24	89-53-23	17.077	-1160756.563225
153-2-23	41004.598	-67972.037	8.775	269-43-09	90-05-45	16.993	-1155048.824741
						倍面積	299.704357
						面 積	149.8521785

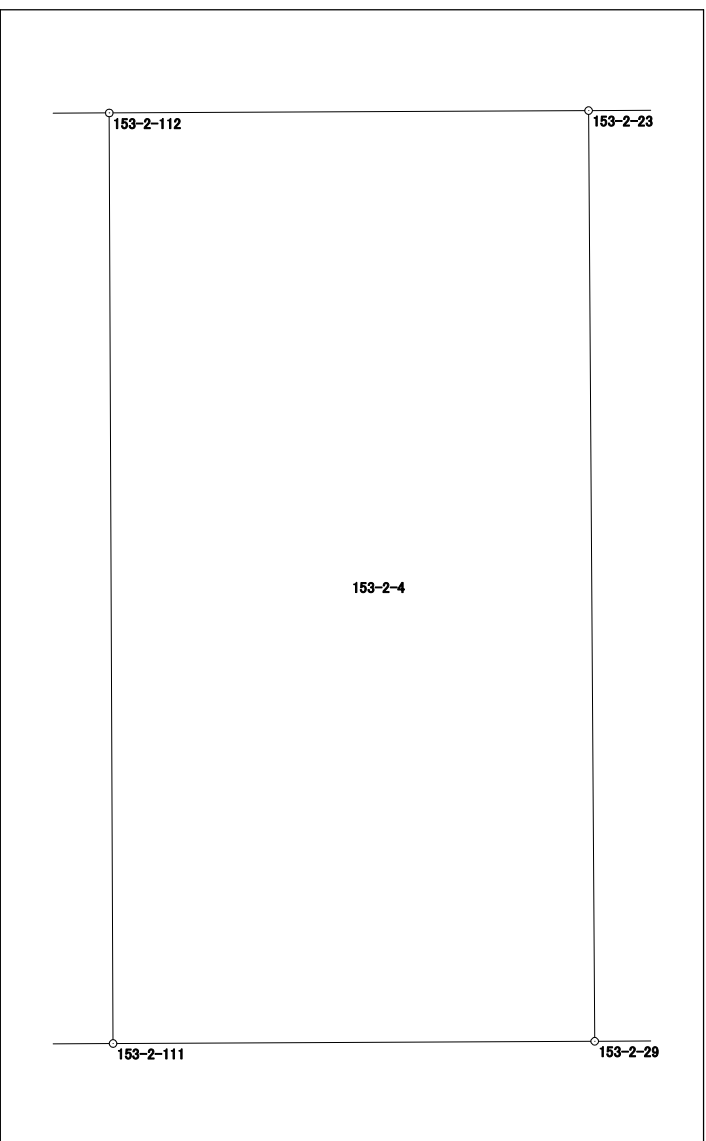


面積計算書 (座標法)

世界測地系 (測地成果2011)

所在	地番	公簿地目	現況地目	地積	所有者
前橋市六供町三丁目	153-2-5			169.80 m ²	

点名	X座標	Y座標	辺長	方向角	測角	DX	倍積 (Y×DX)
153-2-114	40987.608	-67961.974	17.044	359-42-51	89-58-44	17.090	-1161470.135660
153-2-113	41004.652	-67962.059	9.978	269-41-24	89-58-33	16.990	-1154675.382410
153-2-23	41004.598	-67972.037	17.036	179-37-24	89-56-00	-17.090	1161642.112330
153-2-29	40987.562	-67971.925	9.951	89-44-07	90-06-43	-16.990	1154843.005750
						倍面積	339.600010
						面積	169.8000050

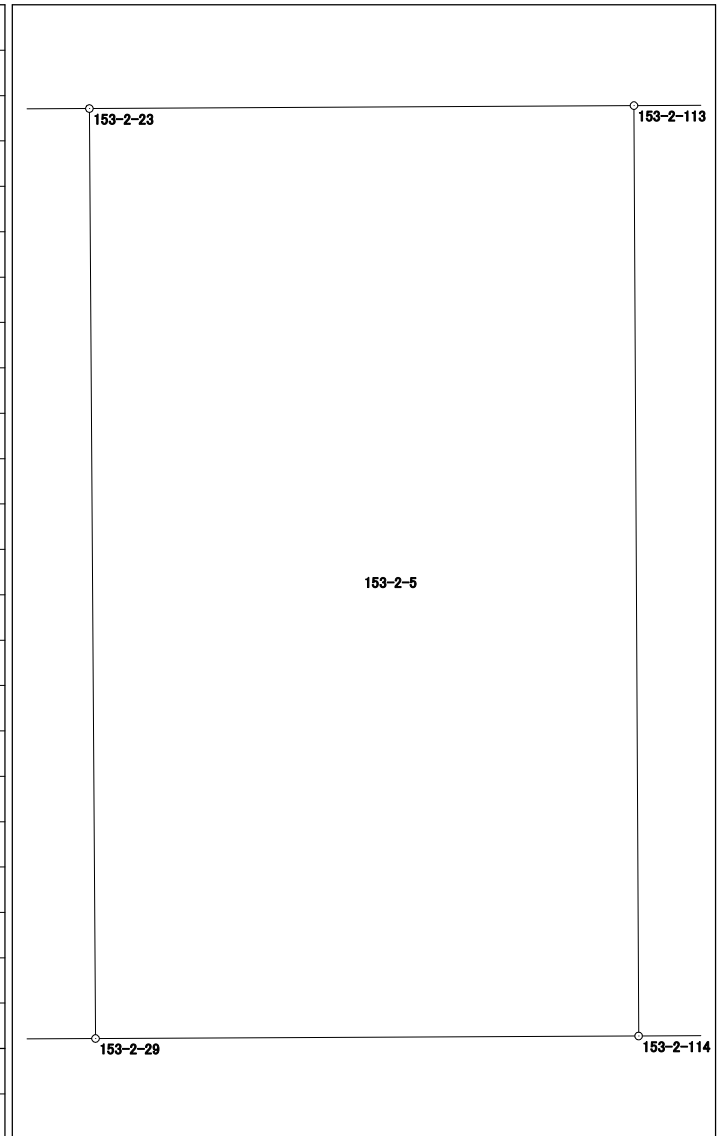

面積計算書 (座標法)

世界測地系 (測地成果2011)

所 在	地 番	公簿地目	現況地目	地 積	所 有 者
前橋市六供町三丁目	153-2-6			115.08 m ²	

点 名	X 座標	Y 座標	辺 長	方 向 角	測 角	DX	倍 積 (Y×DX)		
153-2-116	40987.665	-67951.468	17.038	359-43-15	90-03-37	17.078	-1160475.170504		
153-2-115	41004.703	-67951.551	6.754	269-44-44	90-01-29	17.008	-1155719.979408		
153-2-24	41004.673	-67958.305	17.048	179-42-39	89-57-55	-17.078	1160591.932790		
153-2-28	40987.625	-67958.219	6.751	89-39-38	89-56-59	-17.008	1155833.388752		
							倍面積	230.171630	
							面 積	115.0858150	

面積計算書（座標法）

世界測地系（測地成果2011）

所 在	地 番	公簿地目	現況地目	地 積	所 有 者
前橋市六供町三丁目	153-2-7			194.81 m ²	


点 名	X 座標	Y 座標	辺 長	方 向 角	測 角	DX	倍 積 (Y×DX)	<div style="border: 1px solid black; width: 100%; height: 100%; position: relative;"> <div style="position: absolute; top: 10%; left: 10%; font-size: 8px;">153-2-118</div> <div style="position: absolute; top: 10%; right: 10%; font-size: 8px;">153-2-26</div> <div style="position: absolute; bottom: 10%; left: 10%; font-size: 8px;">153-2-117</div> <div style="position: absolute; bottom: 10%; right: 10%; font-size: 8px;">153-2-15</div> <div style="position: absolute; top: 50%; left: 50%; transform: translate(-50%, -50%); font-weight: bold;">153-2-7</div> </div>		
153-2-118	41004.731	-67945.387	17.035	179-43-15	89-59-30	-17.089	1161118.718443			
153-2-117	40987.696	-67945.304	11.444	89-45-17	90-02-02	-16.986	1154118.933744			
153-2-15	40987.745	-67933.860	17.040	359-39-13	89-53-56	17.089	-1160921.733540			
153-2-26	41004.785	-67933.963	11.424	269-43-45	90-04-32	16.986	-1153926.295518			
							倍面積	389.623129		
							面 積	194.8115645		

面積計算書（座標法）

世界測地系（測地成果2011）

所在	地番	公簿地目	現況地目	地積	所有者
前橋市六供町三丁目	153-2-保-1			57.00 m ²	

点名	X座標	Y座標	辺長	方向角	測角	DX	倍積 (Y×DX)
153-2-101	41004.351	-68019.984	17.027	179-42-02	89-57-26	-17.042	1159196.567328
153-2-102	40987.324	-68019.895	3.348	89-41-31	89-59-29	-17.009	1156950.394055
153-2-32	40987.342	-68016.547	17.024	359-42-02	90-00-31	17.042	-1159137.993974
153-2-20	41004.366	-68016.636	3.348	269-44-36	90-02-34	17.009	-1156894.961724

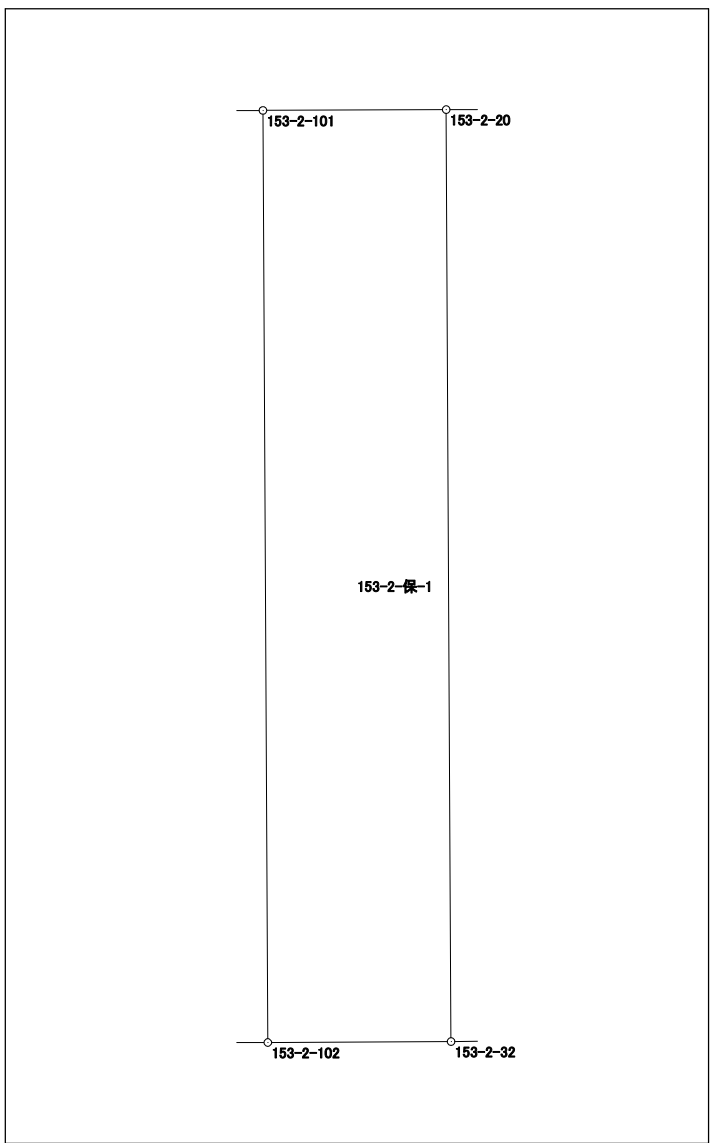


倍面積	114.005685
面積	57.0028425

面積計算書（座標法）

世界測地系（測地成果2011）

所 在	地 番	公簿地目	現況地目	地 積	所 有 者
前橋市六供町三丁目	153-2-保-2			65.00 m ²	

点 名	X 座標	Y 座標	辺 長	方 向 角	測 角	DX	倍 積 (Y×DX)
153-2-105	41004.427	-68003.212	17.015	179-42-01	89-58-13	-17.033	1158298.709996
153-2-106	40987.412	-68003.123	3.821	89-42-00	89-59-59	-16.995	1155713.075385
153-2-104	40987.432	-67999.302	17.013	359-41-49	89-59-49	17.033	-1158232.110966
153-2-103	41004.445	-67999.392	3.820	269-43-48	90-01-59	16.995	-1155649.667040
倍面積							130.007375
面 積							65.0036875

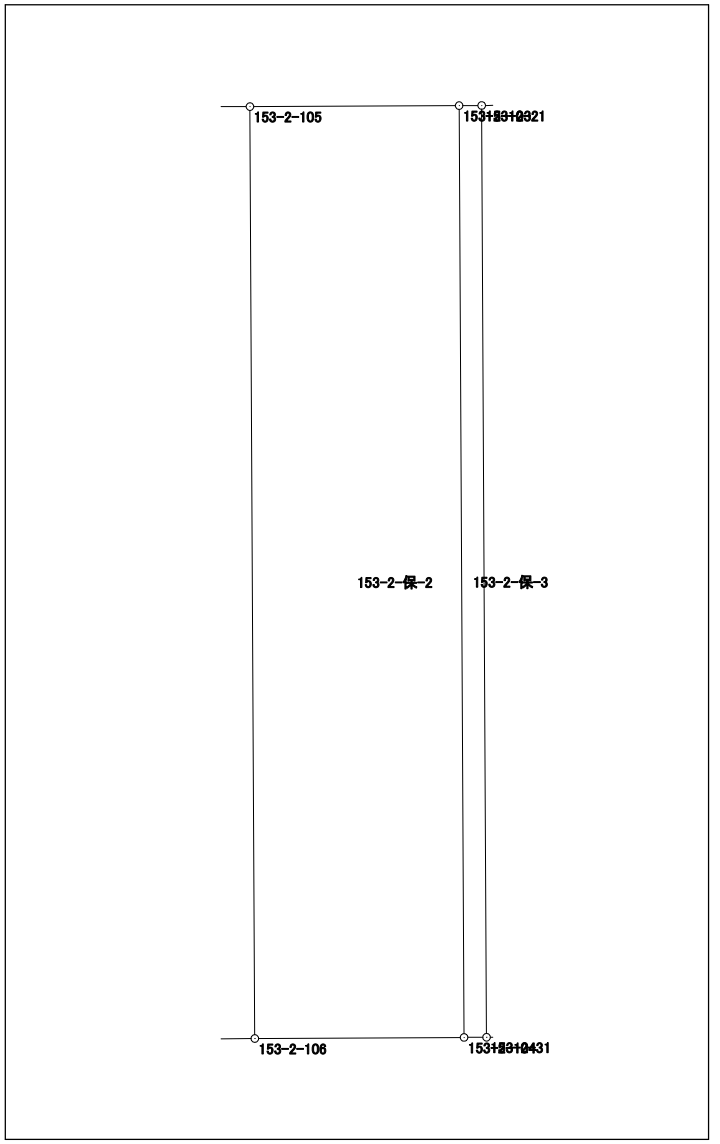


面積計算書（座標法）

世界測地系（測地成果2011）

所 在	地 番	公簿地目	現況地目	地 積	所 有 者
前橋市六供町三丁目	153-2-保-4			67.00 m ²	

点 名	X 座標	Y 座標	辺 長	方 向 角	測 角	DX	倍 積 (Y×DX)
153-2-109	41004.505	-67989.561	17.026	179-46-04	90-07-02	-17.050	1159222.015050
153-2-110	40987.479	-67989.492	3.935	89-43-24	89-57-20	-17.007	1156297.290444
153-2-108	40987.498	-67985.557	17.031	359-45-52	90-02-28	17.050	-1159153.746850
153-2-107	41004.529	-67985.627	3.934	269-39-02	89-53-10	17.007	-1156231.558389
						倍面積	134.000255
						面 積	67.0001275

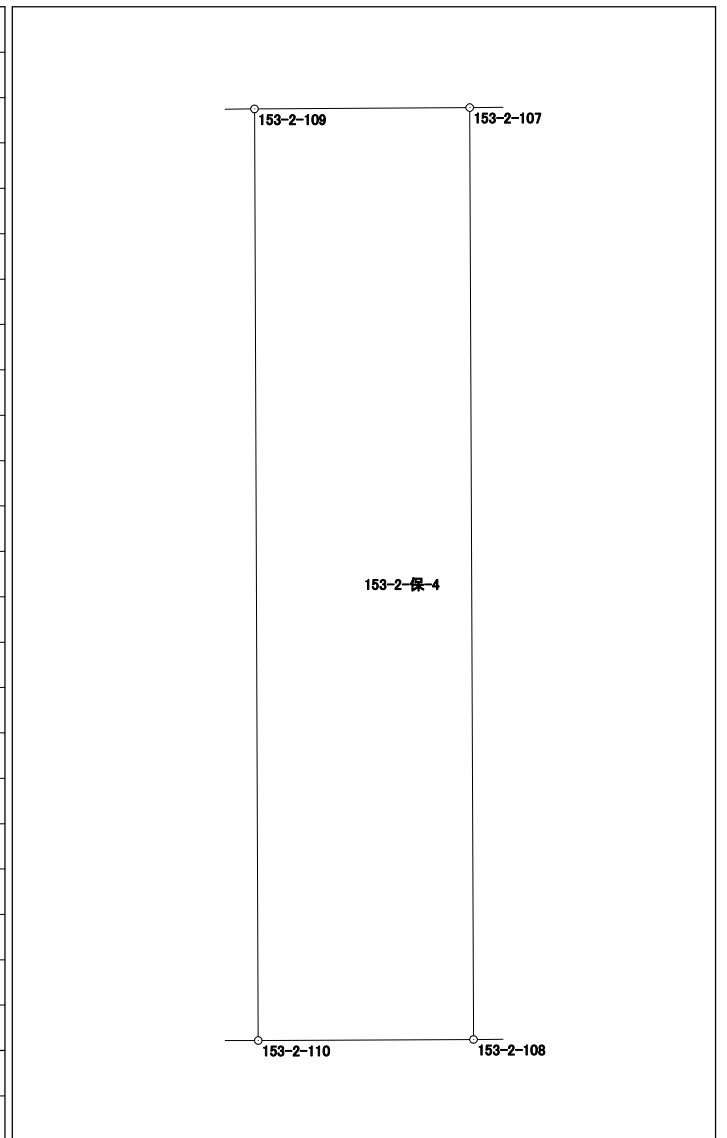


面積計算書 (座標法)

世界測地系 (測地成果2011)

所在	地番	公簿地目	現況地目	地積	所有者
前橋市六供町三丁目	153-2-保-5			30.00 m ²	

点名	X座標	Y座標	辺長	方向角	測角	D _X	倍積 (Y×D _X)
153-2-107	41004.529	-67985.627	17.031	179-45-52	90-07-20	-17.042	1158611.055334
153-2-108	40987.498	-67985.557	1.761	89-42-26	89-56-34	-17.022	1157250.151254
153-2-30	40987.507	-67983.796	17.033	359-46-04	90-03-38	17.042	-1158579.851432
153-2-22	41004.540	-67983.865	1.762	269-38-32	89-52-28	17.022	-1157221.350030

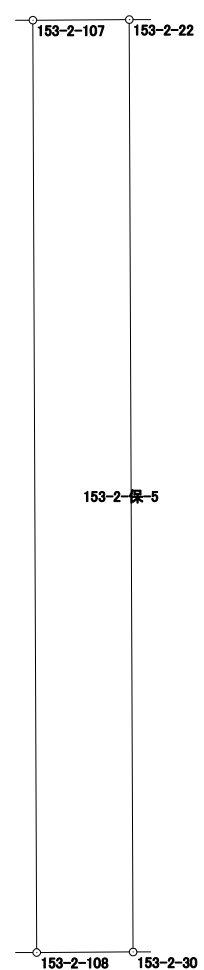


倍面積	60.005126
面積	30.0025630

面積計算書 (座標法)

世界測地系 (測地成果2011)

所在	地番	公簿地目	現況地目	地積	所有者
前橋市六供町三丁目	153-2-保-6			64.00 m ²	

点名	X座標	Y座標	辺長	方向角	測角	DX	倍積 (Y×DX)
153-2-113	41004.652	-67962.059	17.044	179-42-51	90-02-05	-17.065	1159772.536835
153-2-114	40987.608	-67961.974	3.755	89-44-26	90-01-35	-17.027	1157188.531298
153-2-28	40987.625	-67958.219	17.048	359-42-39	89-58-13	17.065	-1159707.007235
153-2-24	41004.673	-67958.305	3.754	269-40-46	89-58-07	17.027	-1157126.059235
						倍面積	128.001663
						面積	64.0008315

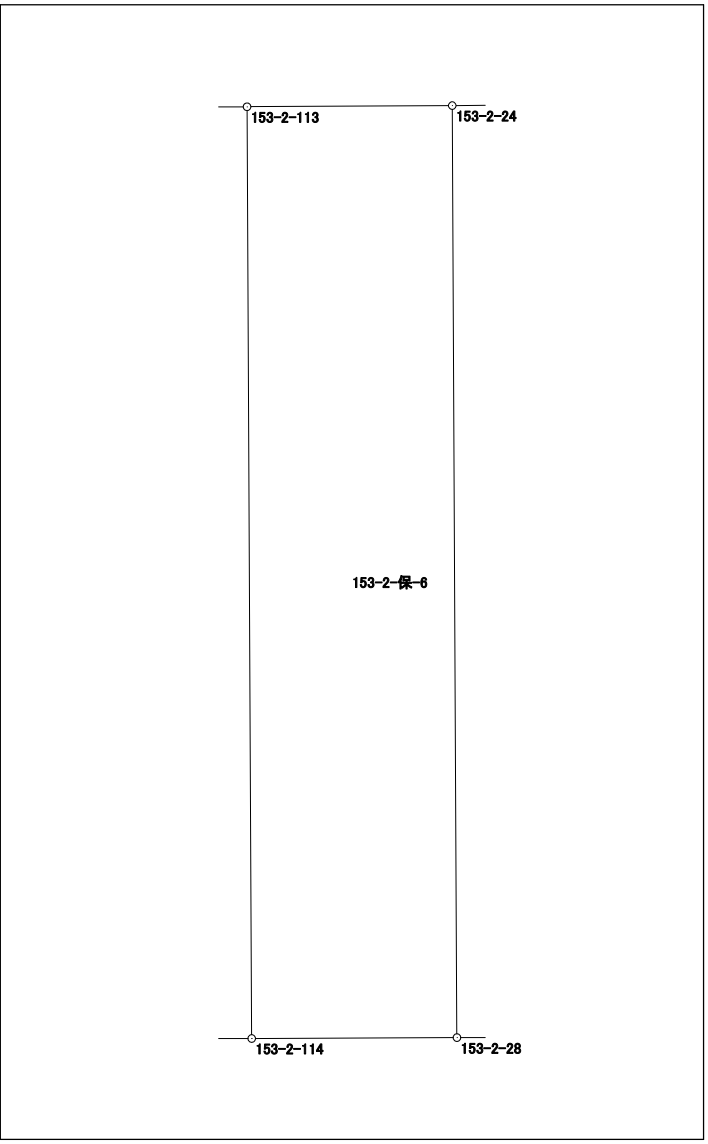


面積計算書 (座標法)

世界測地系 (測地成果2011)

所 在	地 番	公簿地目	現況地目	地 積	所 有 者
前橋市六供町三丁目	153-2-保-8			61.00 m ²	

点 名	X 座標	Y 座標	辺 長	方 向 角	測 角	DX	倍 積 (Y×DX)
153-2-117	40987.696	-67945.304	17.035	359-43-15	89-57-39	17.050	-1158467.433200
153-2-118	41004.731	-67945.387	3.581	269-43-41	90-00-26	17.018	-1156294.595966
153-2-25	41004.714	-67948.968	17.033	179-43-15	89-59-34	-17.050	1158529.904400
153-2-27	40987.681	-67948.885	3.581	89-45-36	90-02-21	-17.018	1156354.124930
倍面積							122.000164
面 積							61.0000820

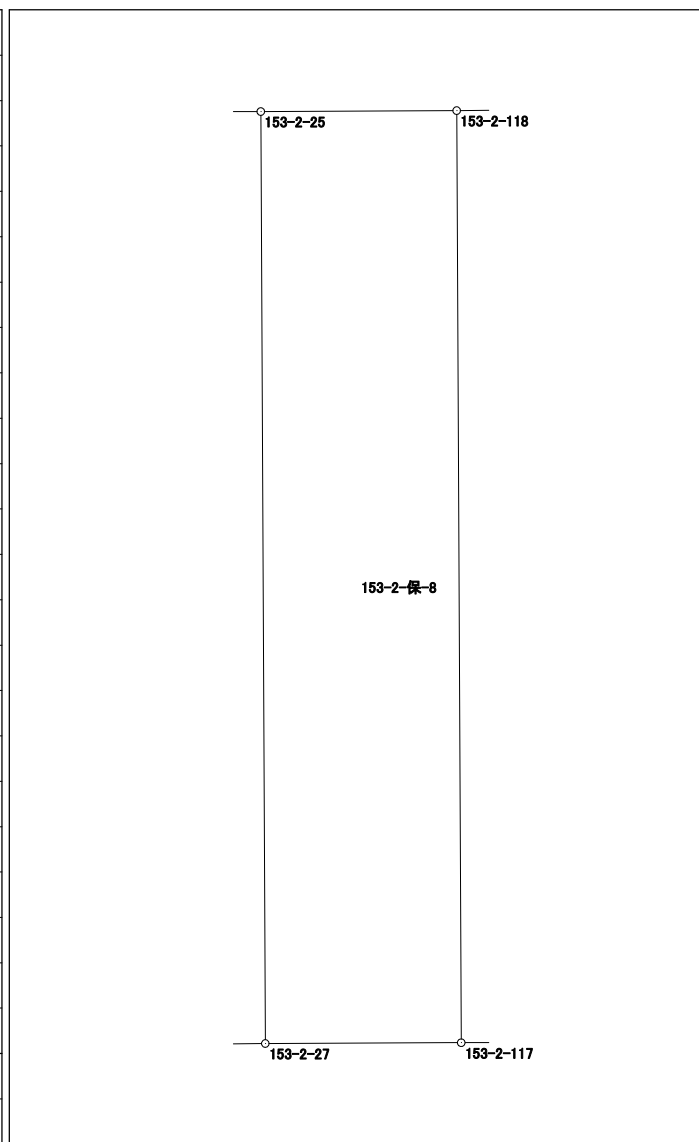


面積計算書（座標法）

世界測地系（測地成果2011）

所在	地番	公簿地目	現況地目	地積	所有者
前橋市六供町三丁目	153-2-保-9			52.00 m ²	

点名	X座標	Y座標	辺長	方向角	測角	DX	倍積 (Y×DX)
153-2-111	40987.521	-67980.743	17.034	359-46-04	90-01-50	17.048	-1158935.706664
153-2-112	41004.555	-67980.812	3.053	269-43-07	89-57-03	17.019	-1156965.439428
153-2-22	41004.540	-67983.865	17.033	179-46-04	90-02-57	-17.048	1158988.930520
153-2-30	40987.507	-67983.796	3.053	89-44-14	89-58-10	-17.019	1157016.224124

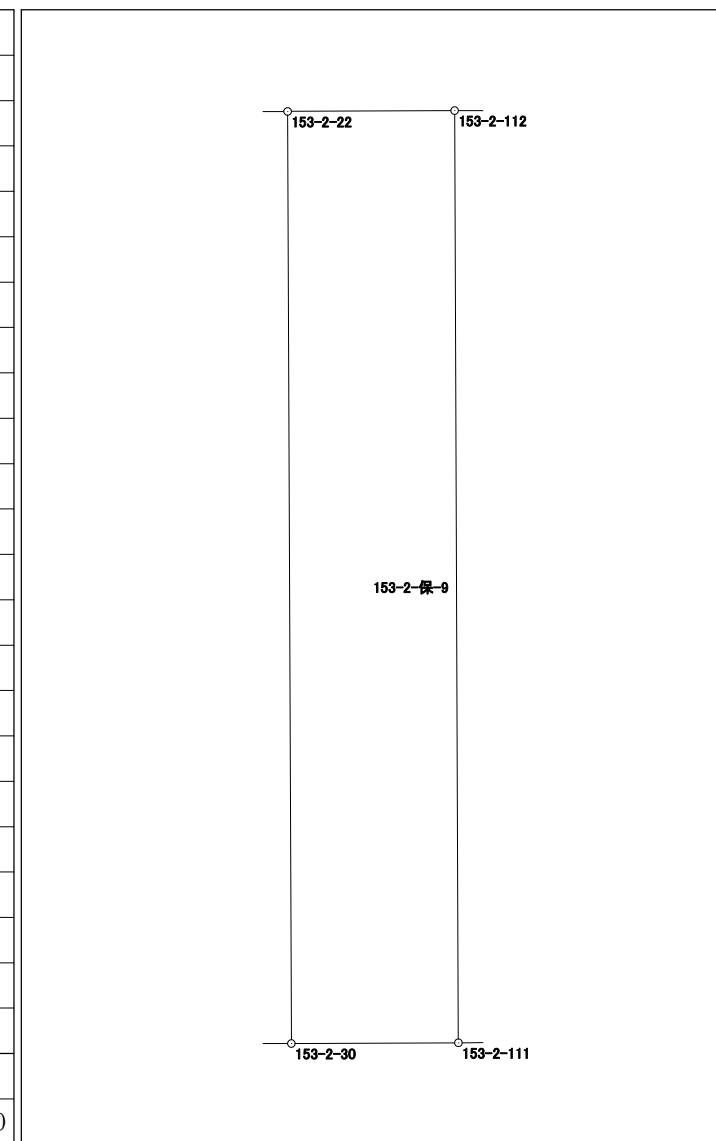

倍面積	104.008552
面積	52.0042760