


156街区 画地出来形確認図 (4959.26m²)

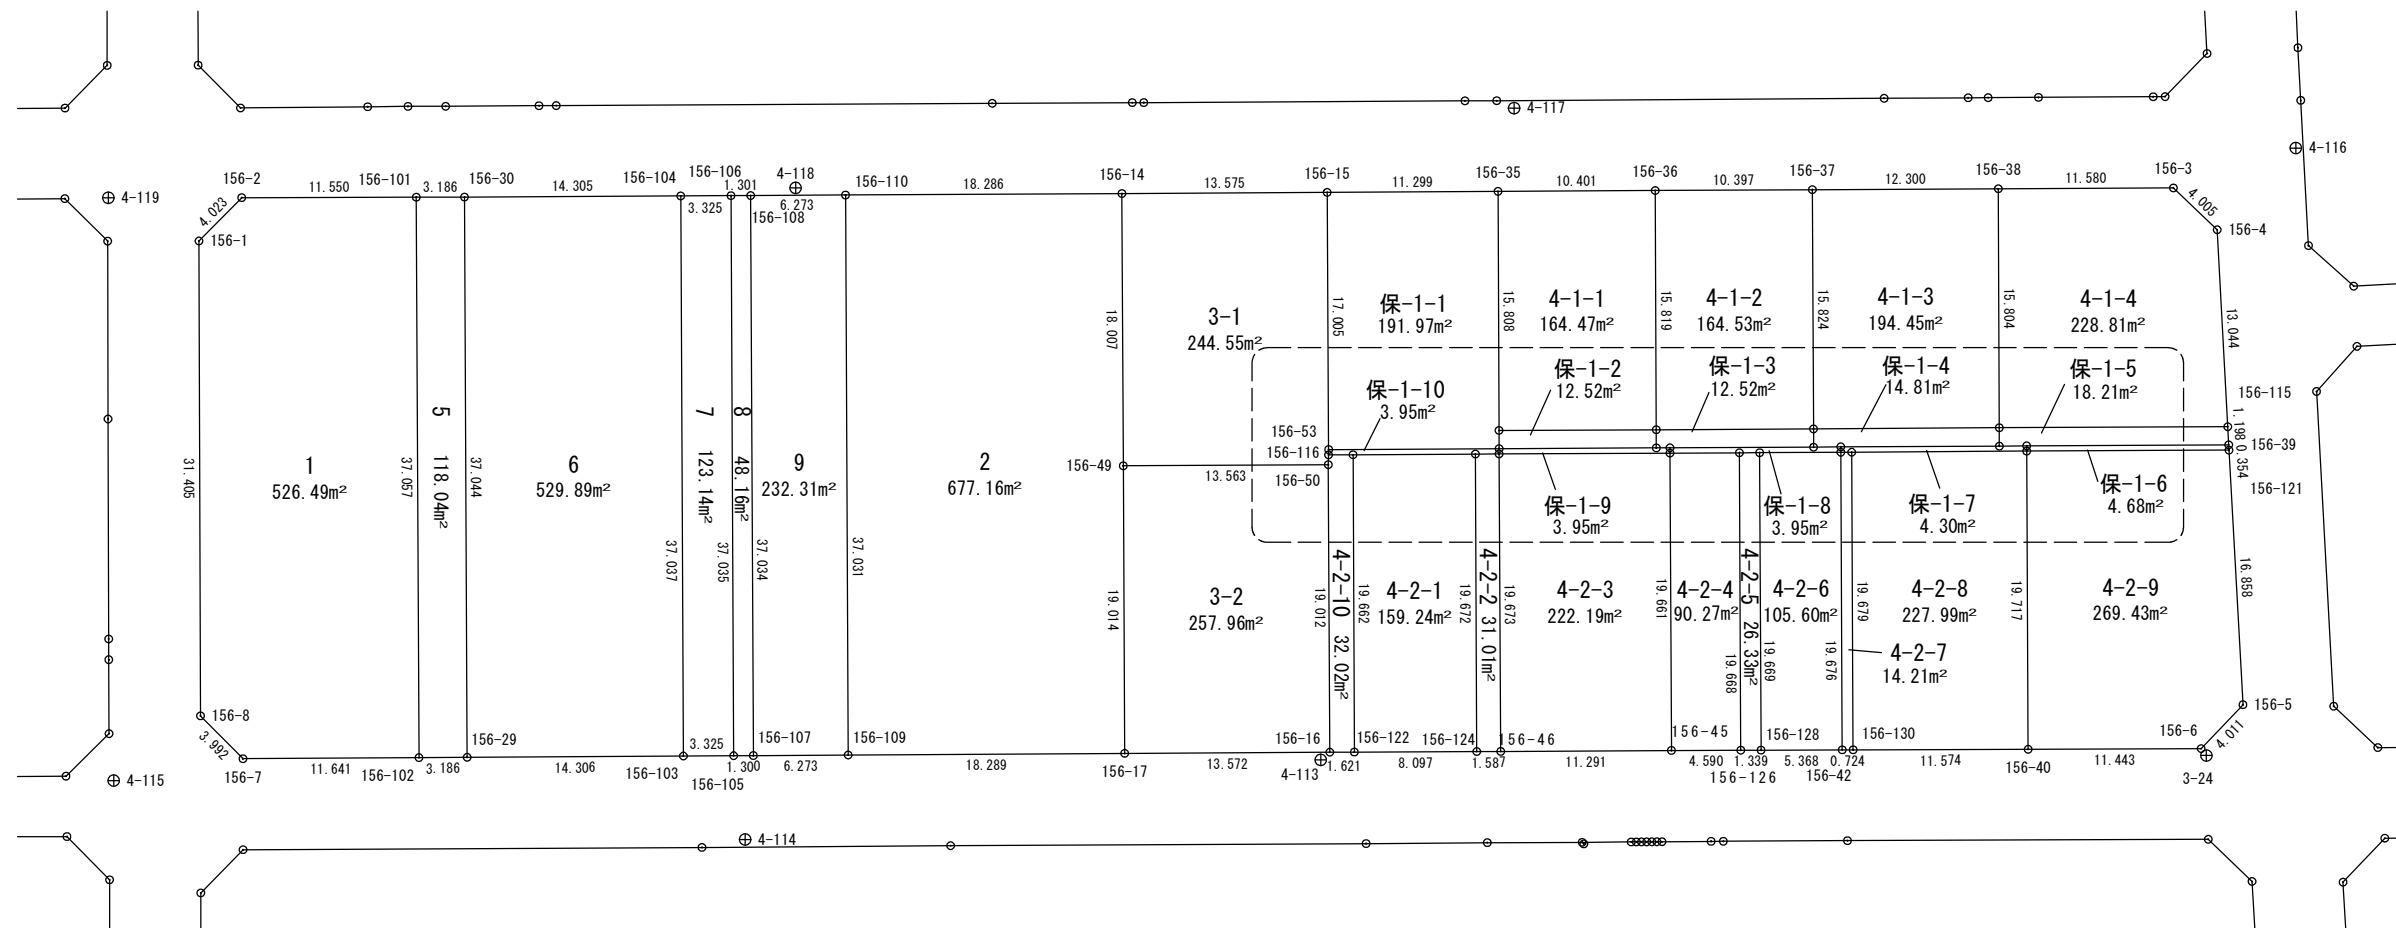

S=1/500



拡大図1/250

