



159街区 画地出来形確認図 (1243.50㎡)

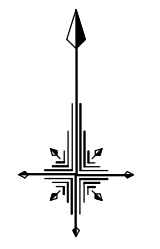

S=1/250

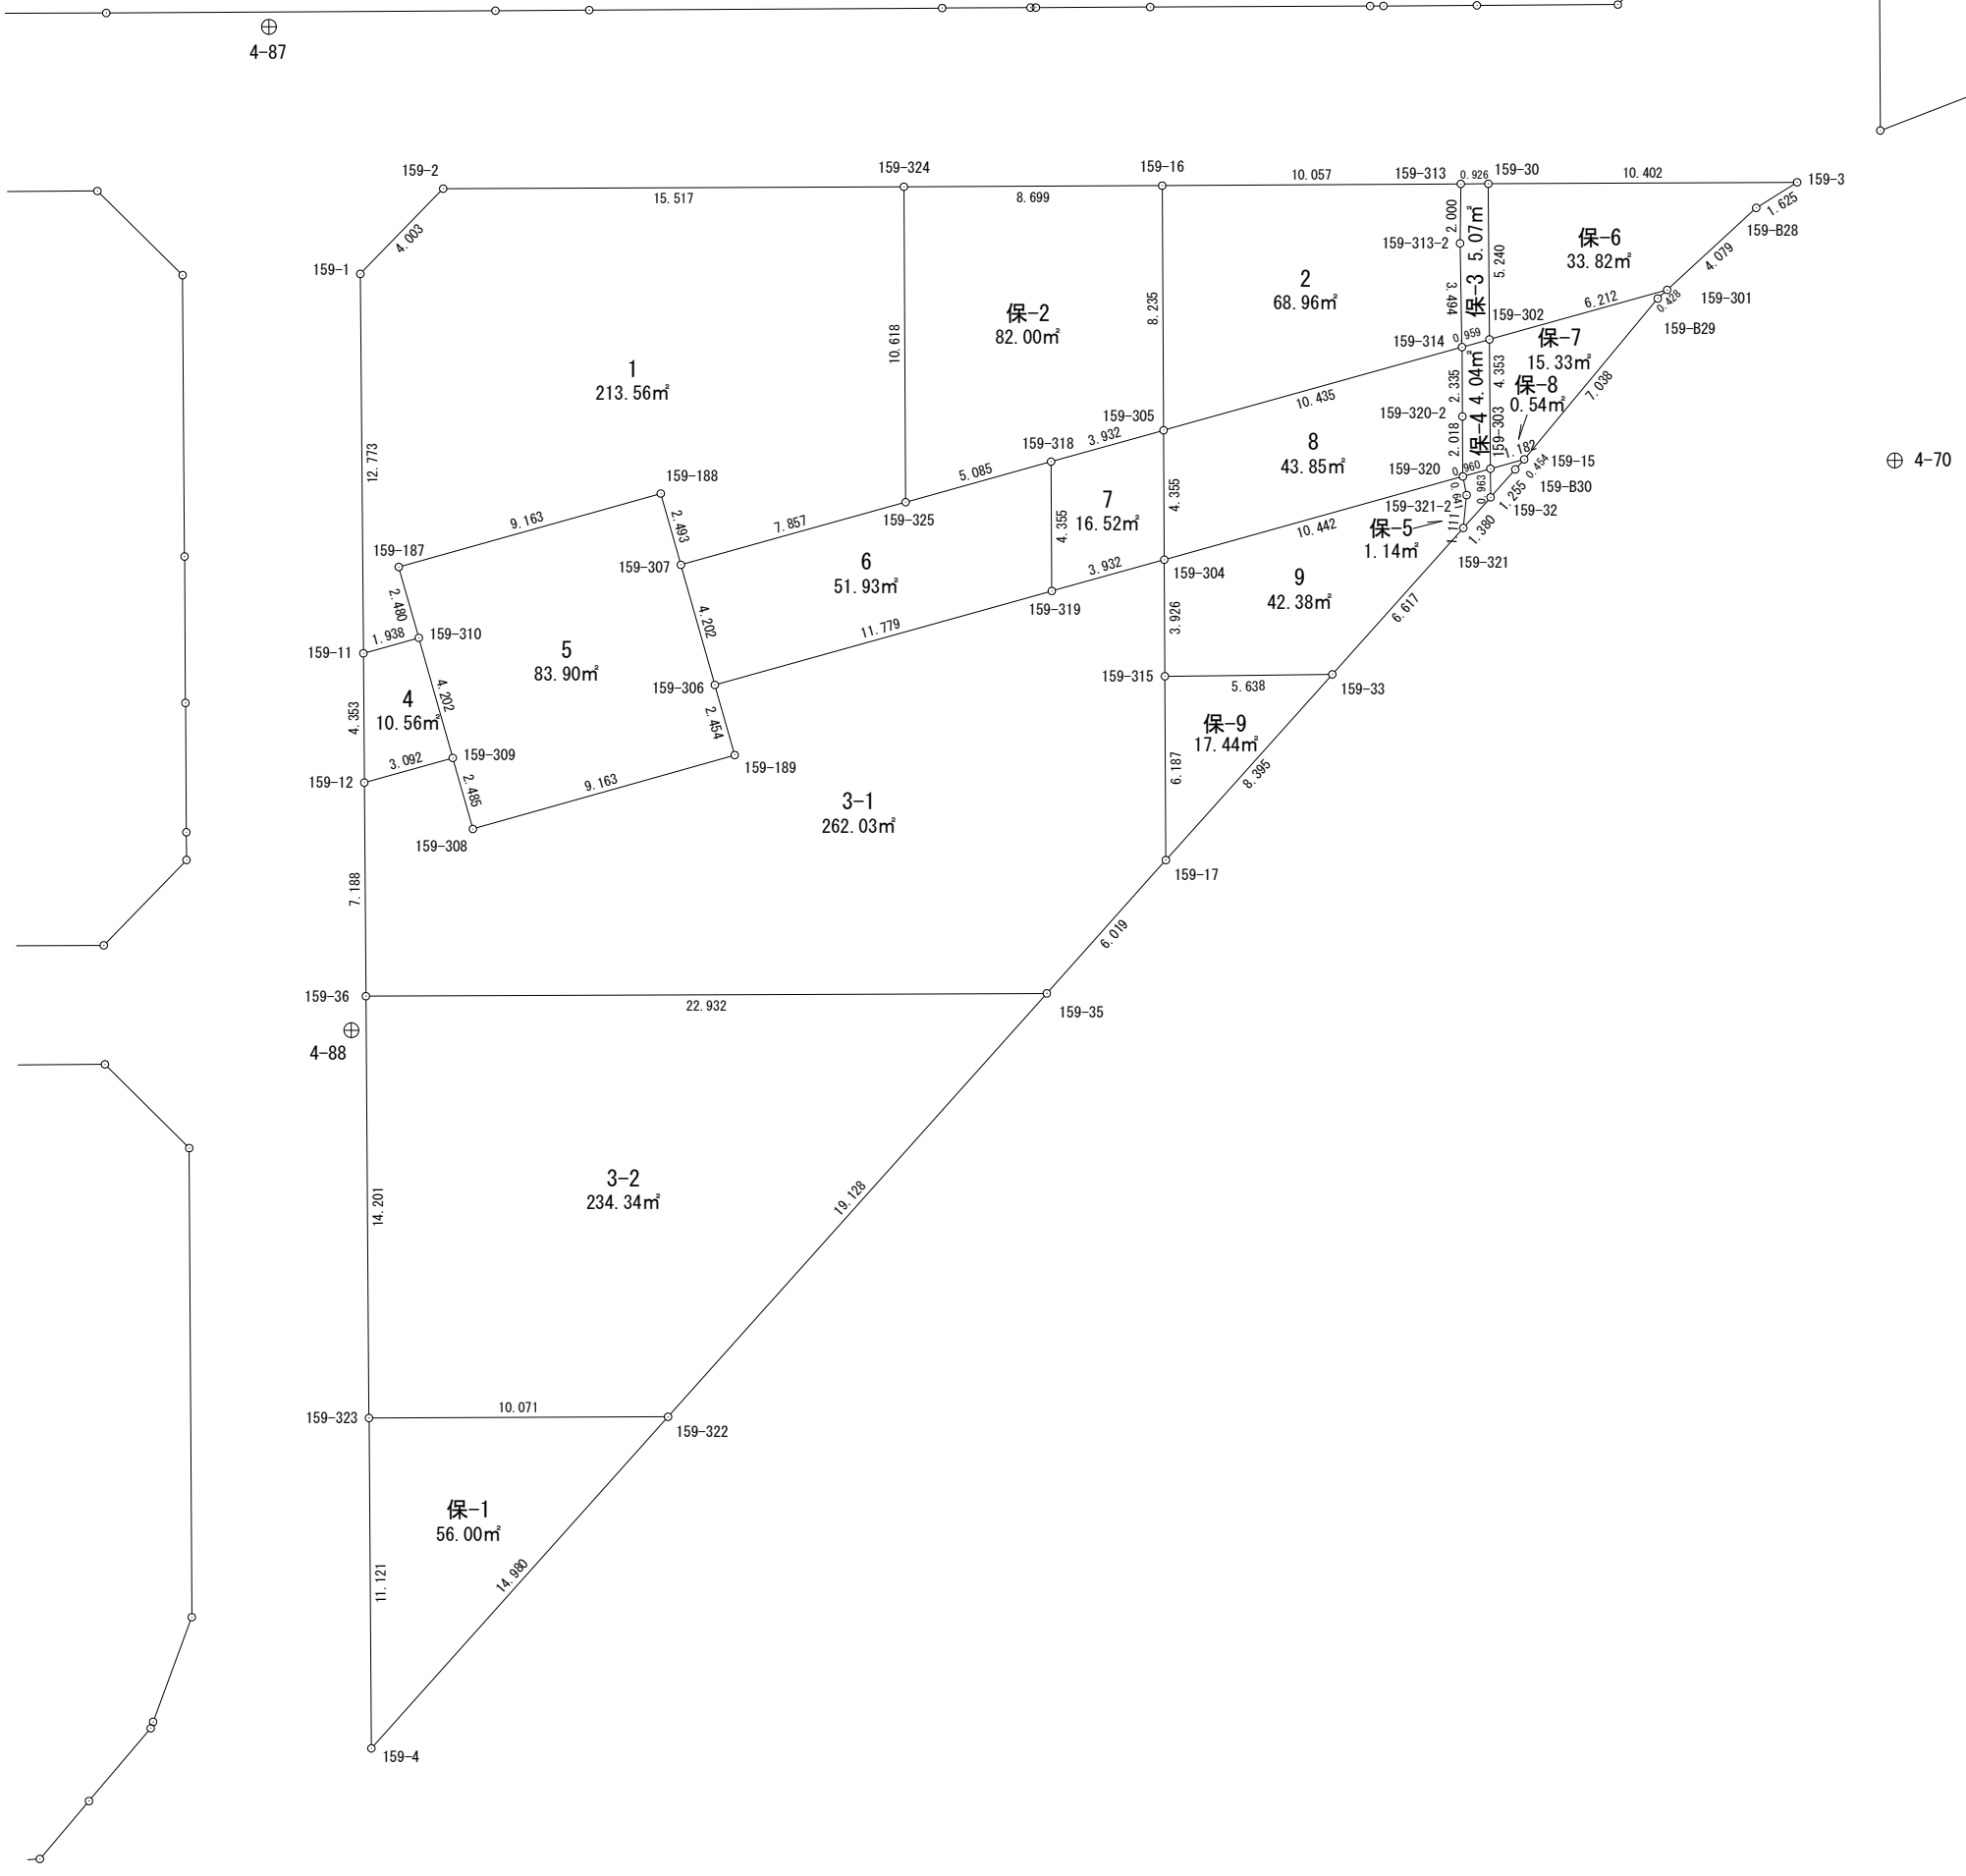

⊕ 4-87


⊕ 4-70

⊕ 4-88

面積計算書 (座標法)

所在	地番	公簿地目	現況地目	地積	所有者
前橋市六供町五丁目	159-1			213.56 m ²	

点名	X座標	Y座標	辺長	方向角	測角	DX	倍積 (Y×DX)
159-324	40842.578	-67693.392	15.517	269-45-36	90-04-23	10.553	-714368.365776
159-2	40842.513	-67708.909	4.003	224-13-51	134-28-15	-2.933	198590.230097
159-1	40839.645	-67711.701	12.773	179-32-01	135-18-10	-15.641	1059078.715341
159-11	40826.872	-67711.597	1.938	74-26-11	74-54-10	-12.253	829670.198041
159-310	40827.392	-67709.730	2.480	344-12-14	89-46-03	2.906	-196764.475380
159-187	40829.778	-67710.405	9.163	74-20-54	270-08-40	4.858	-328937.147490
159-188	40832.250	-67701.582	2.493	164-11-48	269-50-54	0.073	-4942.215486
159-307	40829.851	-67700.903	7.857	74-25-49	90-14-01	-0.290	19633.261870
159-325	40831.960	-67693.334	10.618	359-41-13	105-15-24	12.727	-861533.061818

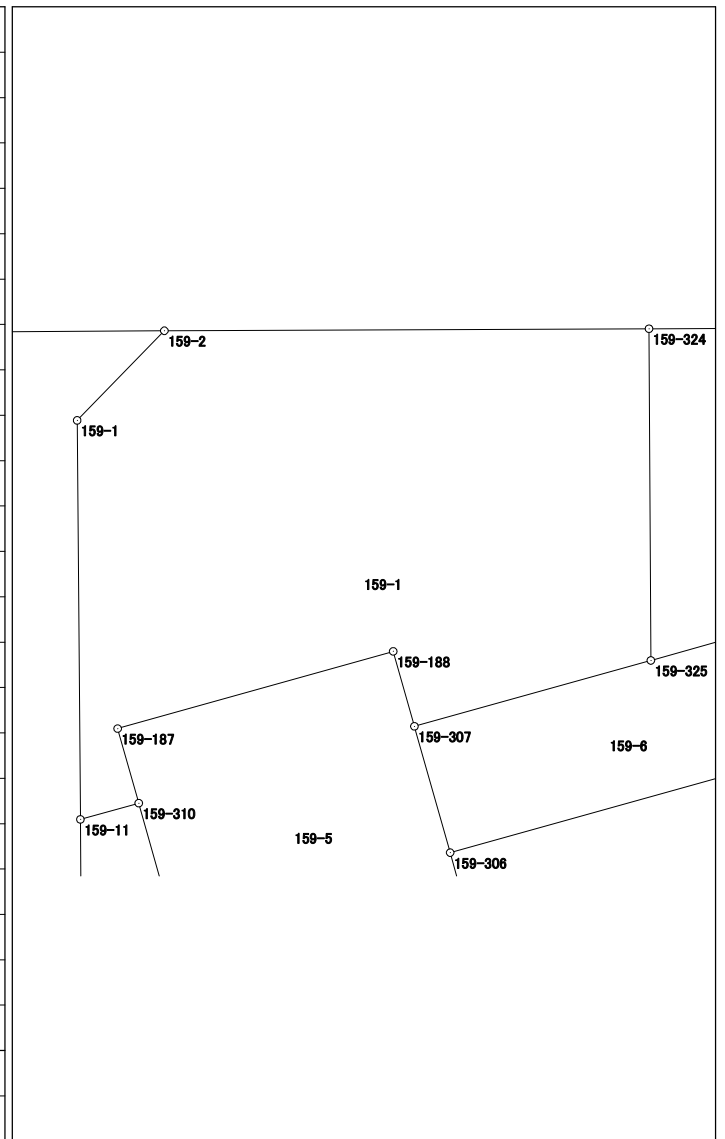

倍面積	427.139399
面積	213.5696995

面積計算書（座標法）

世界測地系（測地成果2011）


所 在	地 番	公簿地目	現況地目	地 積	所 有 者
前橋市六供町五丁目	159-2			68.96 m ²	

点 名	X 座標	Y 座標	辺 長	方 向 角	測 角	DX	倍 積 (Y×DX)	
159-16	40842.615	-67684.693	8.235	179-41-13	90-01-03	-8.293	561309.159049	
159-305	40834.380	-67684.648	10.435	74-26-05	74-44-52	-5.435	367866.061880	
159-314	40837.180	-67674.596	3.494	358-56-02	104-29-57	6.293	-425876.232628	
159-313-2	40840.673	-67674.661	2.000	0-42-58	181-46-56	5.493	-371736.912873	
159-313	40842.673	-67674.636	10.057	269-40-10	88-57-12	1.942	-131424.143112	
							倍面積	137.932316
							面 積	68.9661580

面積計算書 (座標法)

所在	地番	公簿地目	現況地目	地積	所有者
前橋市六供町五丁目	159-3-1			262.03 m ²	

点名	X座標	Y座標	辺長	方向角	測角	DX	倍積 (Y×DX)
159-35	40815.424	-67688.580	6.019	41-47-16	132-01-12	4.581	-310081.384980
159-17	40819.912	-67684.569	6.187	359-41-07	137-53-51	10.675	-722532.774075
159-315	40826.099	-67684.603	3.926	359-41-37	180-00-30	10.113	-684494.390139
159-304	40830.025	-67684.624	3.932	254-26-13	74-44-36	2.871	-194322.555504
159-319	40828.970	-67688.412	11.779	254-25-44	179-59-31	-4.217	285442.033404
159-306	40825.808	-67699.759	2.454	164-12-08	89-46-24	-5.523	373905.768957
159-189	40823.447	-67699.091	9.163	254-14-15	270-02-07	-4.850	328340.591350
159-308	40820.958	-67707.909	2.485	344-11-27	269-57-12	-0.098	6635.375082
159-309	40823.349	-67708.586	3.092	254-25-53	90-14-26	1.561	-105693.102746
159-12	40822.519	-67711.565	7.188	179-34-39	105-08-46	-8.018	542911.328170
159-36	40815.331	-67711.512	22.932	89-46-04	90-11-25	-7.095	480413.177640

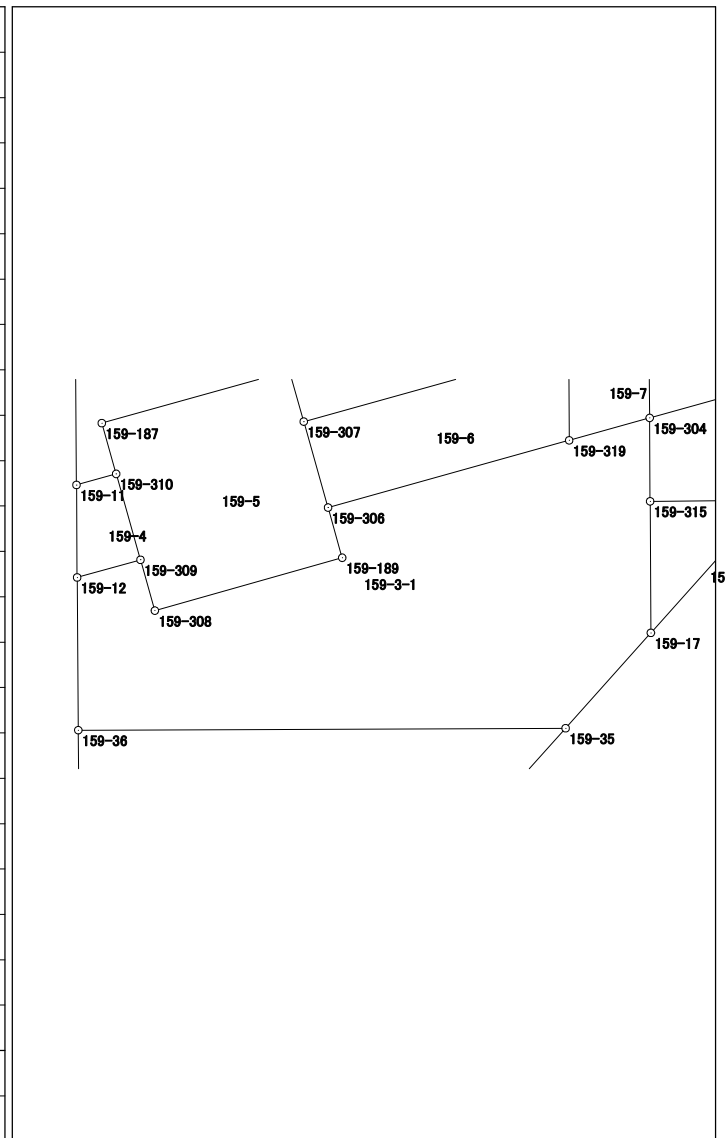


倍面積	524.067159
面積	262.0335795

面積計算書 (座標法)

世界測地系 (測地成果2011)

所在	地番	公簿地目	現況地目	地積	所有者
前橋市六供町五丁目	159-3-2			234.34 m ²	

点名	X座標	Y座標	辺長	方向角	測角	DX	倍積 (Y×DX)
159-322	40801.171	-67701.337	19.128	41-49-47	132-03-47	14.294	-967722.911078
159-35	40815.424	-67688.580	22.932	269-46-04	47-56-17	14.160	-958470.292800
159-36	40815.331	-67711.512	14.201	179-34-49	89-48-45	-14.294	967868.352528
159-323	40801.130	-67711.408	10.071	89-46-00	90-11-11	-14.160	958793.537280

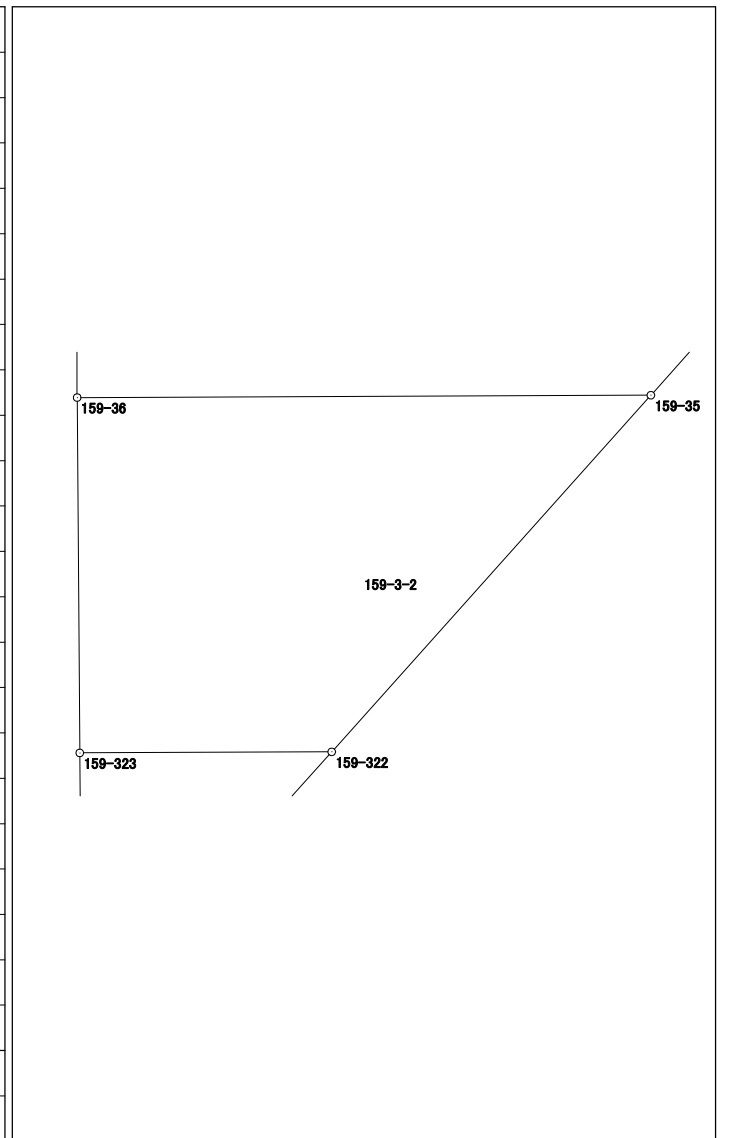


倍面積	468.685930
面積	234.3429650

面積計算書 (座標法)

世界測地系 (測地成果2011)

所在	地番	公簿地目	現況地目	地積	所有者
前橋市六供町五丁目	159-4			10.56 m ²	

点名	X座標	Y座標	辺長	方向角	測角	DX	倍積 (Y×DX)
159-11	40826.872	-67711.597	4.353	179-34-44	105-08-33	-4.873	329958.612181
159-12	40822.519	-67711.565	3.092	74-25-53	74-51-09	-3.523	238547.843495
159-309	40823.349	-67708.586	4.202	344-12-03	89-46-10	4.873	-329943.939578
159-310	40827.392	-67709.730	1.938	254-26-11	90-14-08	3.523	-238541.378790
						倍面積	21.137308
						面積	10.5686540

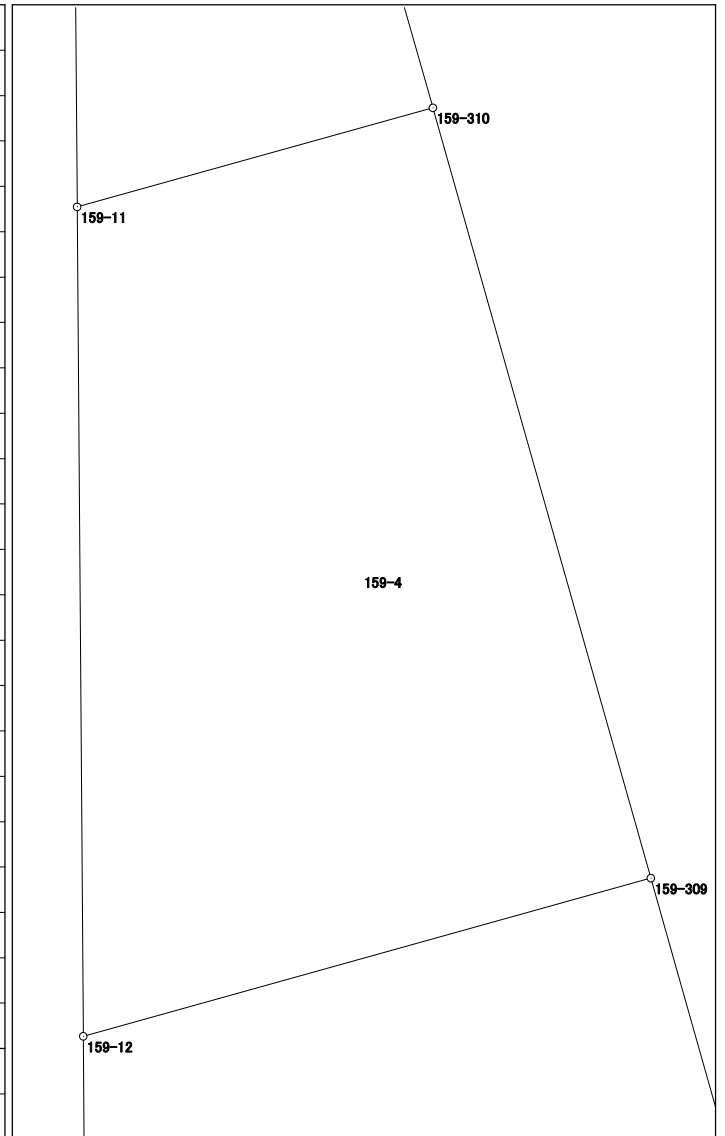


面積計算書 (座標法)

世界測地系 (測地成果2011)

所在	地番	公簿地目	現況地目	地積	所有者
前橋市六供町五丁目	159-5			83.90 m ²	

点名	X座標	Y座標	辺長	方向角	測角	Dx	倍積 (Y×Dx)
159-187	40829.778	-67710.405	2.480	164-12-14	89-51-20	-4.858	328937.147490
159-310	40827.392	-67709.730	4.202	164-12-03	179-59-49	-6.429	435305.854170
159-309	40823.349	-67708.586	2.485	164-11-27	179-59-24	-6.434	435637.042324
159-308	40820.958	-67707.909	9.163	74-14-15	90-02-48	0.098	-6635.375082
159-189	40823.447	-67699.091	2.454	344-12-08	89-57-53	4.850	-328340.591350
159-306	40825.808	-67699.759	4.202	344-12-03	179-59-55	6.404	-433549.256636
159-307	40829.851	-67700.903	2.493	344-11-48	179-59-45	6.442	-436129.217126
159-188	40832.250	-67701.582	9.163	254-20-54	90-09-06	-0.073	4942.215486

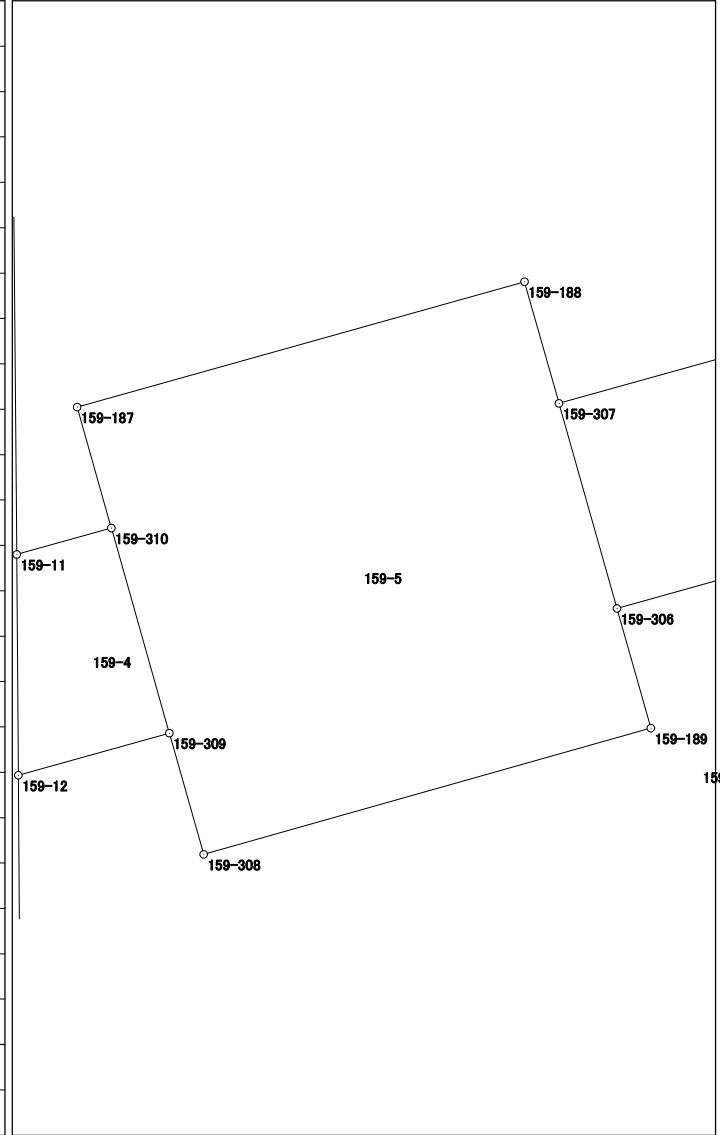


倍面積	167.819276
面積	83.9096380

面積計算書（座標法）

世界測地系（測地成果2011）

所 在	地 番	公簿地目	現況地目	地 積	所 有 者
前橋市六供町五丁目	159-6			51.93 m ²	

点 名	X 座標	Y 座標	辺 長	方 向 角	測 角	DX	倍 積 (Y×DX)
159-307	40829.851	-67700.903	4.202	164-12-03	89-46-14	-6.152	416495.955256
159-306	40825.808	-67699.759	11.779	74-25-44	90-13-41	-0.881	59643.487679
159-319	40828.970	-67688.412	4.355	359-41-03	105-15-19	7.517	-508813.793004
159-318	40833.325	-67688.436	5.085	254-25-39	74-44-36	2.990	-202388.423640
159-325	40831.960	-67693.334	7.857	254-25-49	180-00-10	-3.474	235166.642316
						倍面積	103.868607
						面 積	51.9343035

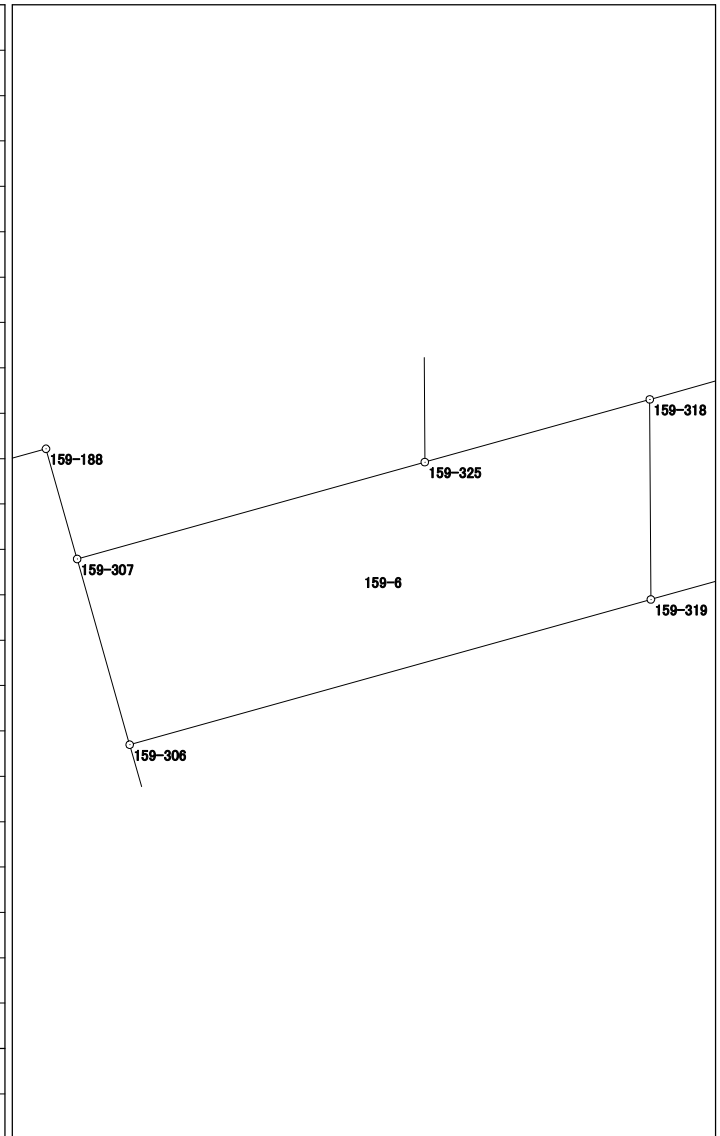


面積計算書 (座標法)

世界測地系 (測地成果2011)

所在	地番	公簿地目	現況地目	地積	所有者
前橋市六供町五丁目	159-7			16.52 m ²	

点名	X座標	Y座標	辺長	方向角	測角	DX	倍積 (Y×DX)
159-319	40828.970	-67688.412	3.932	74-26-13	74-45-10	-3.300	223371.759600
159-304	40830.025	-67684.624	4.355	359-41-03	105-14-50	5.410	-366173.815840
159-305	40834.380	-67684.648	3.932	254-26-13	74-45-10	3.300	-223359.338400
159-318	40833.325	-67688.436	4.355	179-41-03	105-14-50	-5.410	366194.438760

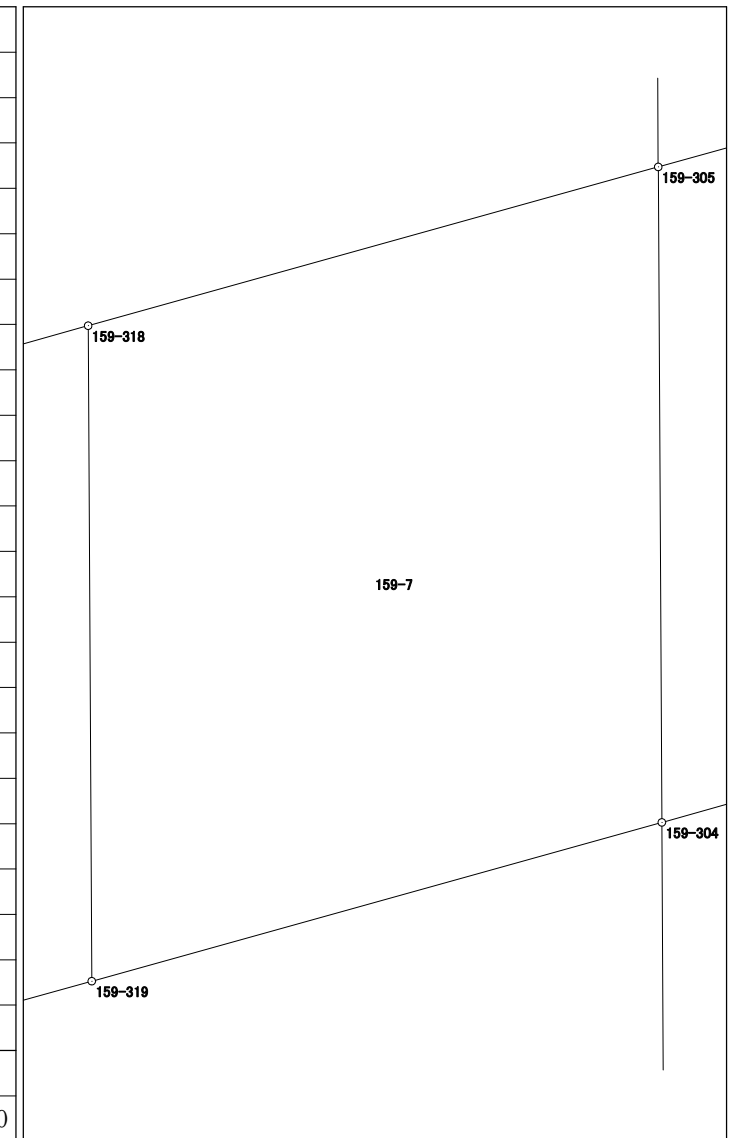


面積計算書 (座標法)

世界測地系 (測地成果2011)

所在	地番	公簿地目	現況地目	地積	所有者
前橋市六供町五丁目	159-9			42.38 m ²	

点名	X座標	Y座標	辺長	方向角	測角	DX	倍積 (Y×DX)
159-304	40830.025	-67684.624	3.926	179-41-37	105-15-33	-6.728	455382.150272
159-315	40826.099	-67684.603	5.638	89-20-59	89-39-22	-3.862	261397.936786
159-33	40826.163	-67678.965	6.617	41-49-58	132-28-59	4.994	-337988.751210
159-321	40831.093	-67674.552	1.111	5-47-15	143-57-17	6.035	-408415.921320
159-321-2	40832.198	-67674.440	0.641	348-45-37	162-58-22	1.734	-117347.478960
159-320	40832.827	-67674.565	10.442	254-26-04	85-40-27	-2.173	147056.829745

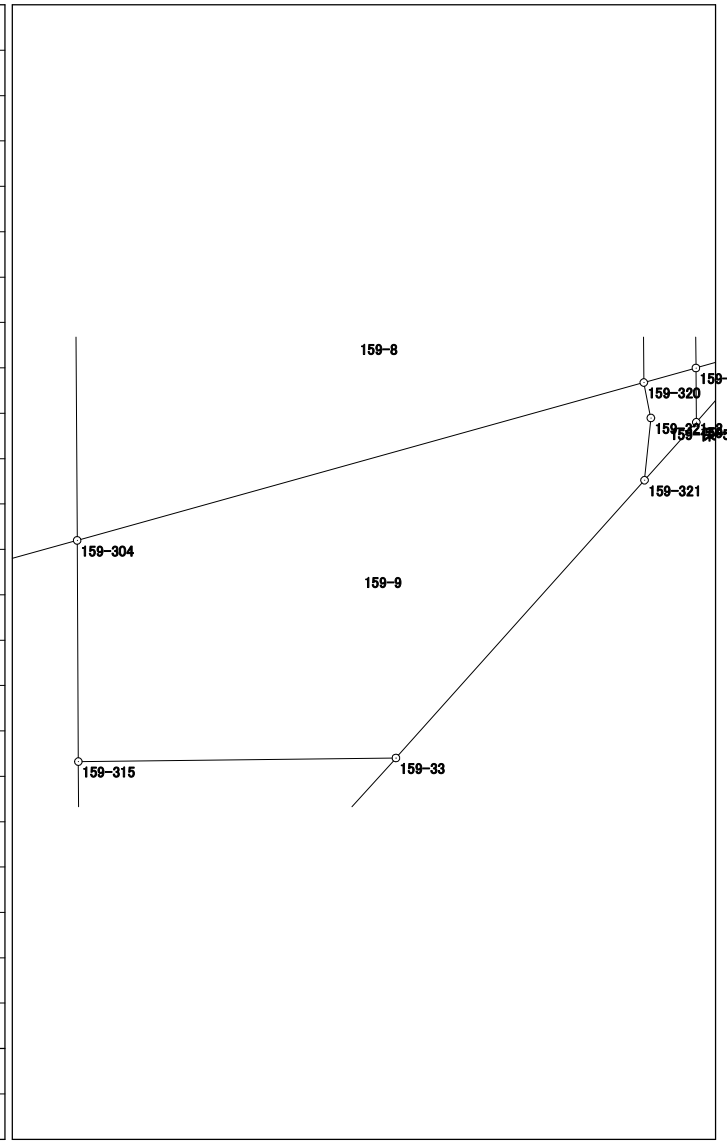


倍面積	84.765313
面積	42.3826565

面積計算書 (座標法)

世界測地系 (測地成果2011)

所在	地番	公簿地目	現況地目	地積	所有者
前橋市六供町五丁目	159-保-1			56.00 m ²	

点名	X座標	Y座標	辺長	方向角	測角	DX	倍積 (Y×DX)
159-4	40790.009	-67711.327	14.980	41-49-43	42-14-45	0.041	-2776.164407
159-322	40801.171	-67701.337	10.071	269-46-00	47-56-17	11.121	-752906.568777
159-323	40801.130	-67711.408	11.121	179-34-58	89-48-58	-11.162	755794.736096
						倍面積	112.002912
						面積	56.0014560

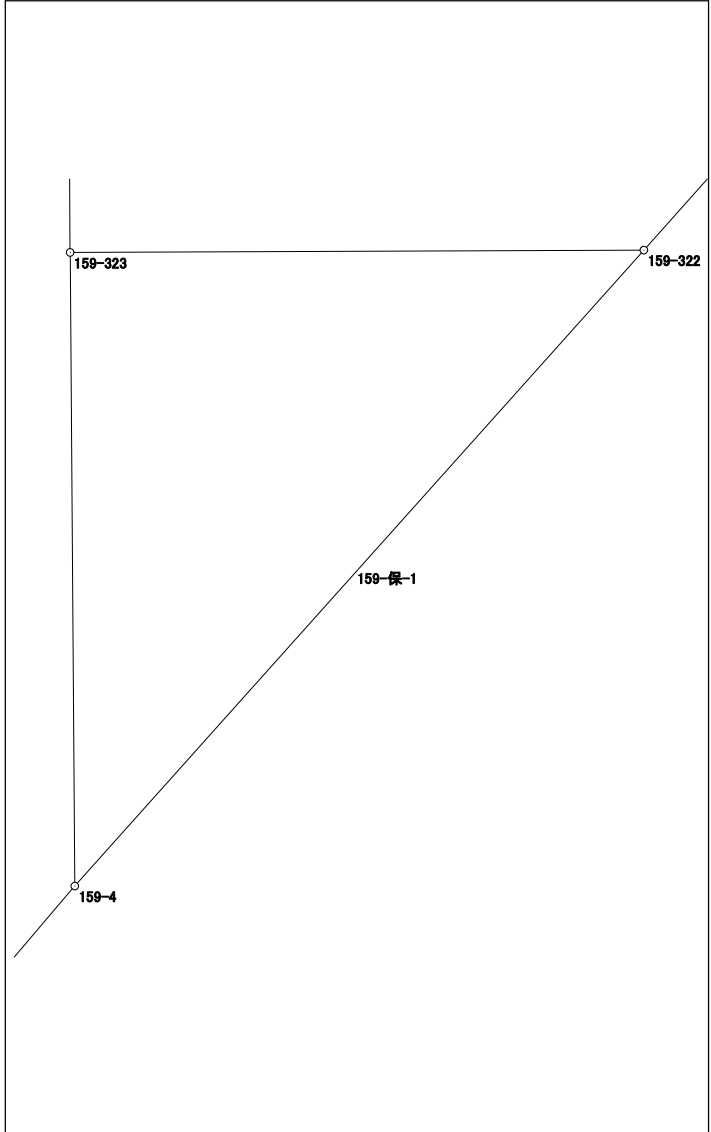


面積計算書（座標法）

世界測地系（測地成果2011）

所 在	地 番	公簿地目	現況地目	地 積	所 有 者
前橋市六供町五丁目	159-保-2			82.00 m ²	

点 名	X 座 標	Y 座 標	辺 長	方 向 角	測 角	DX	倍 積 (Y×DX)
159-305	40834.380	-67684.648	8.235	359-41-13	105-15-00	9.290	-628790.379920
159-16	40842.615	-67684.693	8.699	269-45-23	90-04-10	8.198	-554879.113214
159-324	40842.578	-67693.392	10.618	179-41-13	89-55-50	-10.655	721273.091760
159-325	40831.960	-67693.334	5.085	74-25-39	74-44-26	-9.253	626366.419502
159-318	40833.325	-67688.436	3.932	74-26-13	180-00-34	2.420	-163806.015120

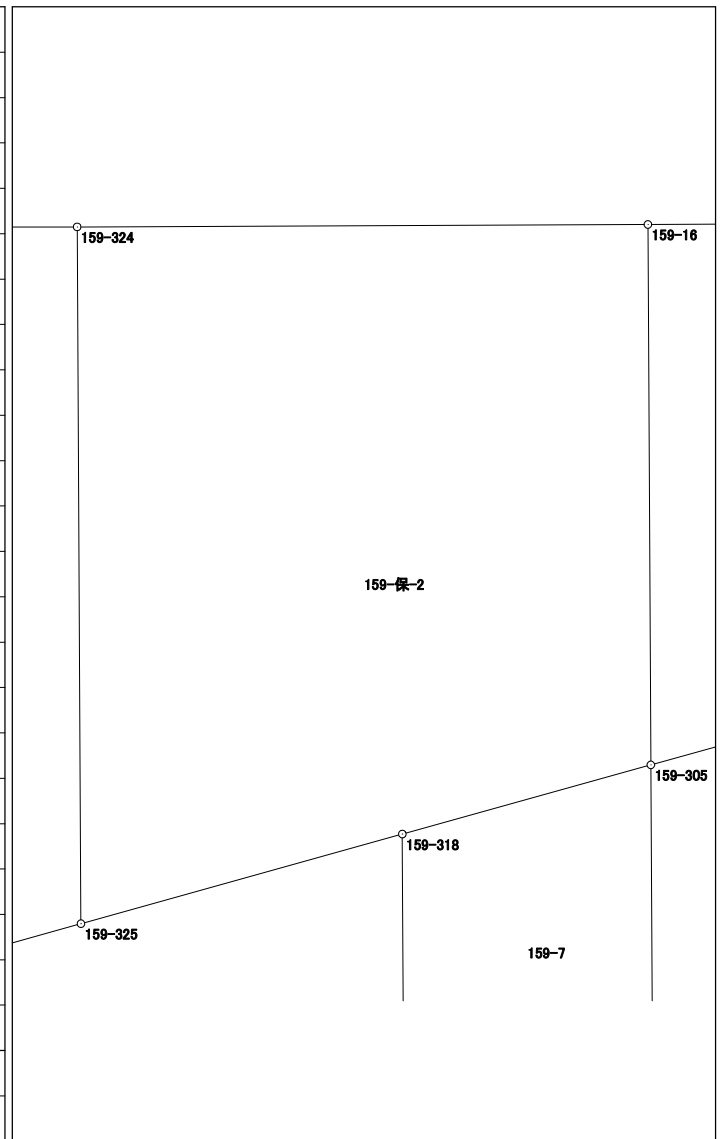


倍面積	164.003008
面 積	82.0015040

面積計算書（座標法）

世界測地系（測地成果2011）

所在	地番	公簿地目	現況地目	地積	所有者
前橋市六供町五丁目	159-保-3			5.07 m ²	

点名	X座標	Y座標	辺長	方向角	測角	DX	倍積 (Y×DX)
159-30	40842.678	-67673.710	0.926	269-41-26	90-06-22	5.235	-354271.871850
159-313	40842.673	-67674.636	2.000	180-42-58	91-01-32	-2.005	135687.645180
159-313-2	40840.673	-67674.661	3.494	178-56-02	178-13-04	-5.493	371736.912873
159-314	40837.180	-67674.596	0.959	74-23-57	75-27-55	-3.235	218927.318060
159-302	40837.438	-67673.672	5.240	359-35-04	105-11-07	5.498	-372069.848656
						倍面積	10.155607
						面積	5.0778035

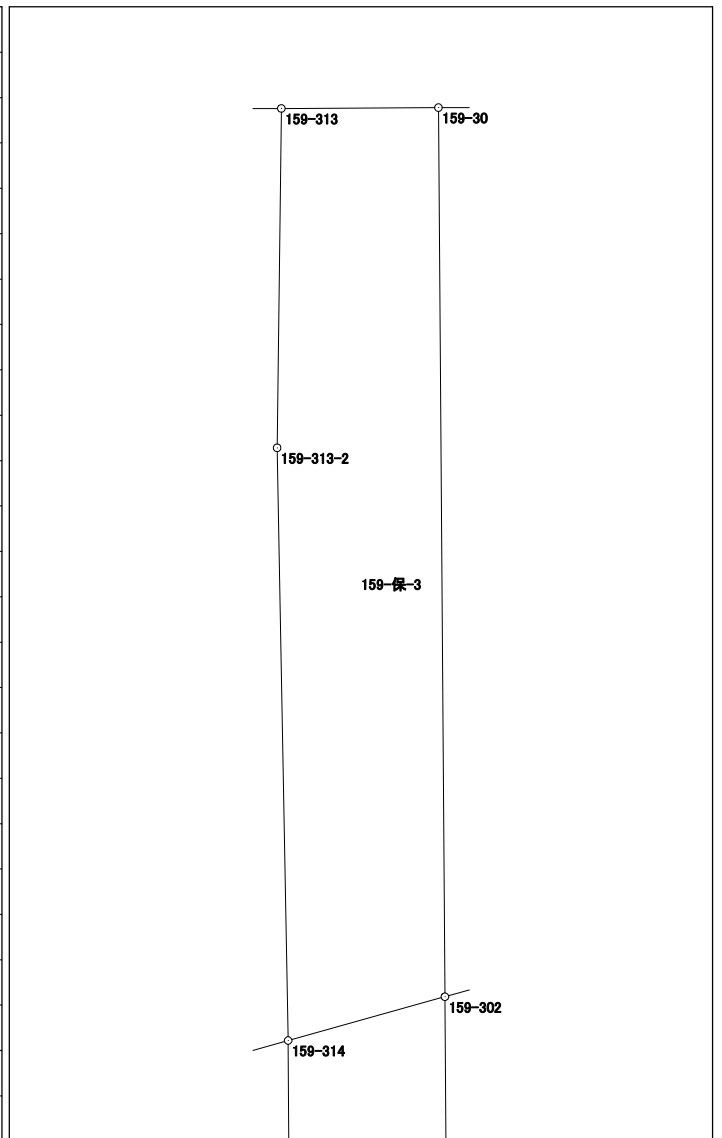


面積計算書 (座標法)

世界測地系 (測地成果2011)

所在	地番	公簿地目	現況地目	地積	所有者
前橋市六供町五丁目	159-保-5			1.14 m ²	

点名	X座標	Y座標	辺長	方向角	測角	DX	倍積 (Y×DX)
159-303	40833.085	-67673.640	0.960	254-24-55	74-49-54	0.705	-47709.916200
159-320	40832.827	-67674.565	0.641	168-45-37	94-20-42	-0.887	60027.339155
159-321-2	40832.198	-67674.440	1.111	185-47-15	197-01-38	-1.734	117347.478960
159-321	40831.093	-67674.552	1.380	41-46-05	35-58-50	-0.076	5143.265952
159-32	40832.122	-67673.633	0.963	359-35-01	137-48-56	1.992	-134805.876936

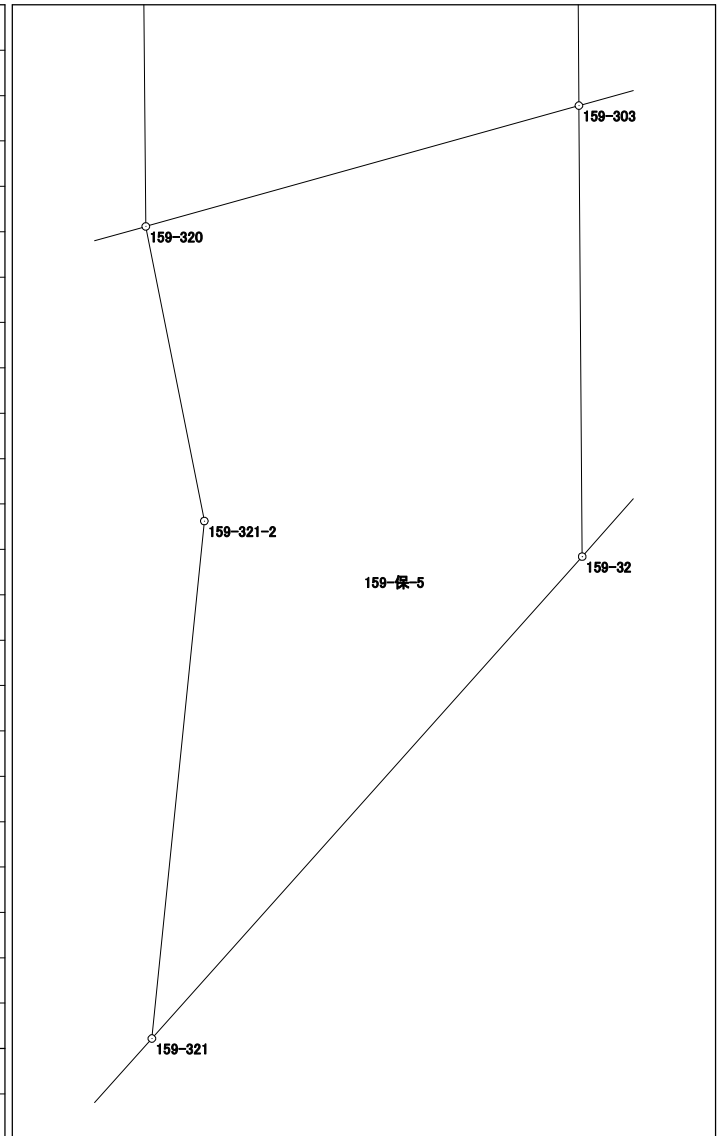


面積計算書 (座標法)

世界測地系 (測地成果2011)

所 在	地 番	公簿地目	現況地目	地 積	所 有 者
前橋市六供町五丁目	159-保-8			0.54 m ²	

点 名	X 座標	Y 座標	辺 長	方 向 角	測 角	DX	倍 積 (Y×DX)
159-303	40833.085	-67673.640	0.963	179-35-01	105-08-11	-1.280	86622.259200
159-32	40832.122	-67673.633	1.255	41-28-41	41-53-40	-0.023	1556.493559
159-B30	40833.062	-67672.802	0.454	41-31-06	180-02-25	1.280	-86621.186560
159-15	40833.402	-67672.501	1.182	254-26-50	32-55-44	0.023	-1556.467523
倍面積							1.098676
面 積							0.5493380

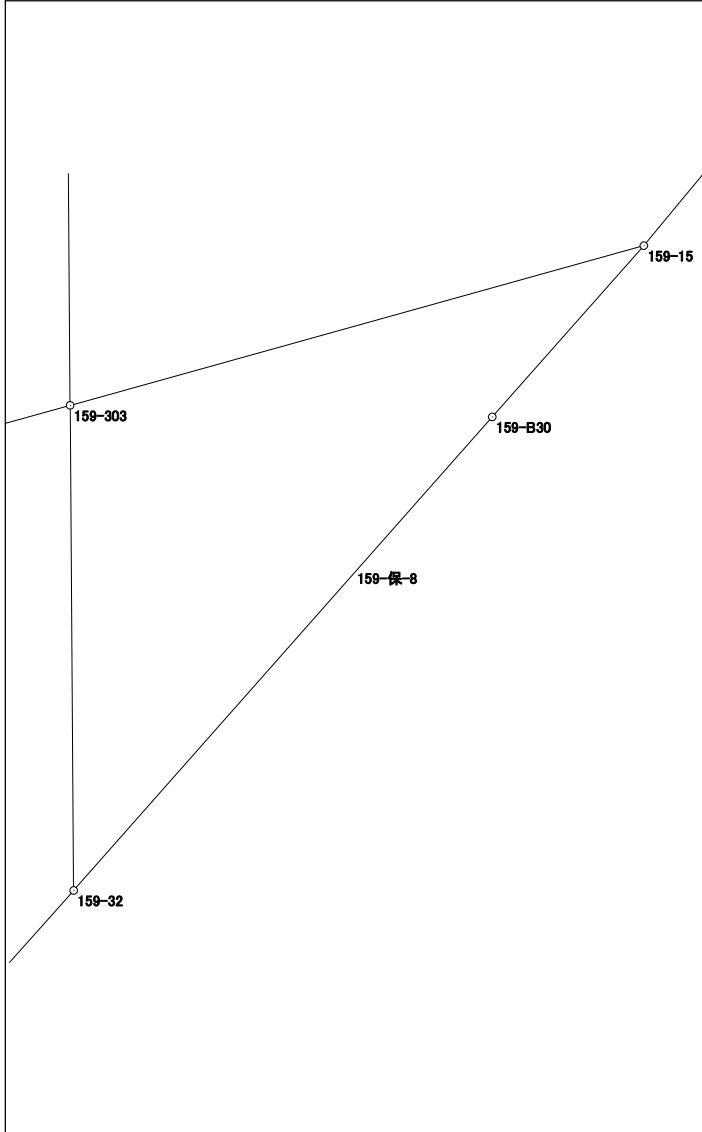

面積計算書（座標法）

世界測地系（測地成果2011）

所 在	地 番	公簿地目	現況地目	地 積	所 有 者
前橋市六供町五丁目	159-保-9			17.44 m ²	

点 名	X 座標	Y 座標	辺 長	方 向 角	測 角	DX	倍 積 (Y×DX)
159-33	40826.163	-67678.965	5.638	269-20-59	47-28-25	6.187	-418729.756455
159-315	40826.099	-67684.603	6.187	179-41-07	90-20-08	-6.251	423096.453353
159-17	40819.912	-67684.569	8.395	41-52-34	42-11-27	0.064	-4331.812416
						倍面積	34.884482
						面 積	17.4422410