



162街区 画地出来形確認図 (9015.96㎡)

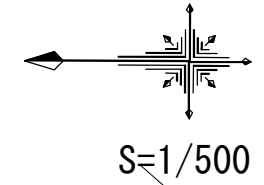

3. 4. 32本町六供線

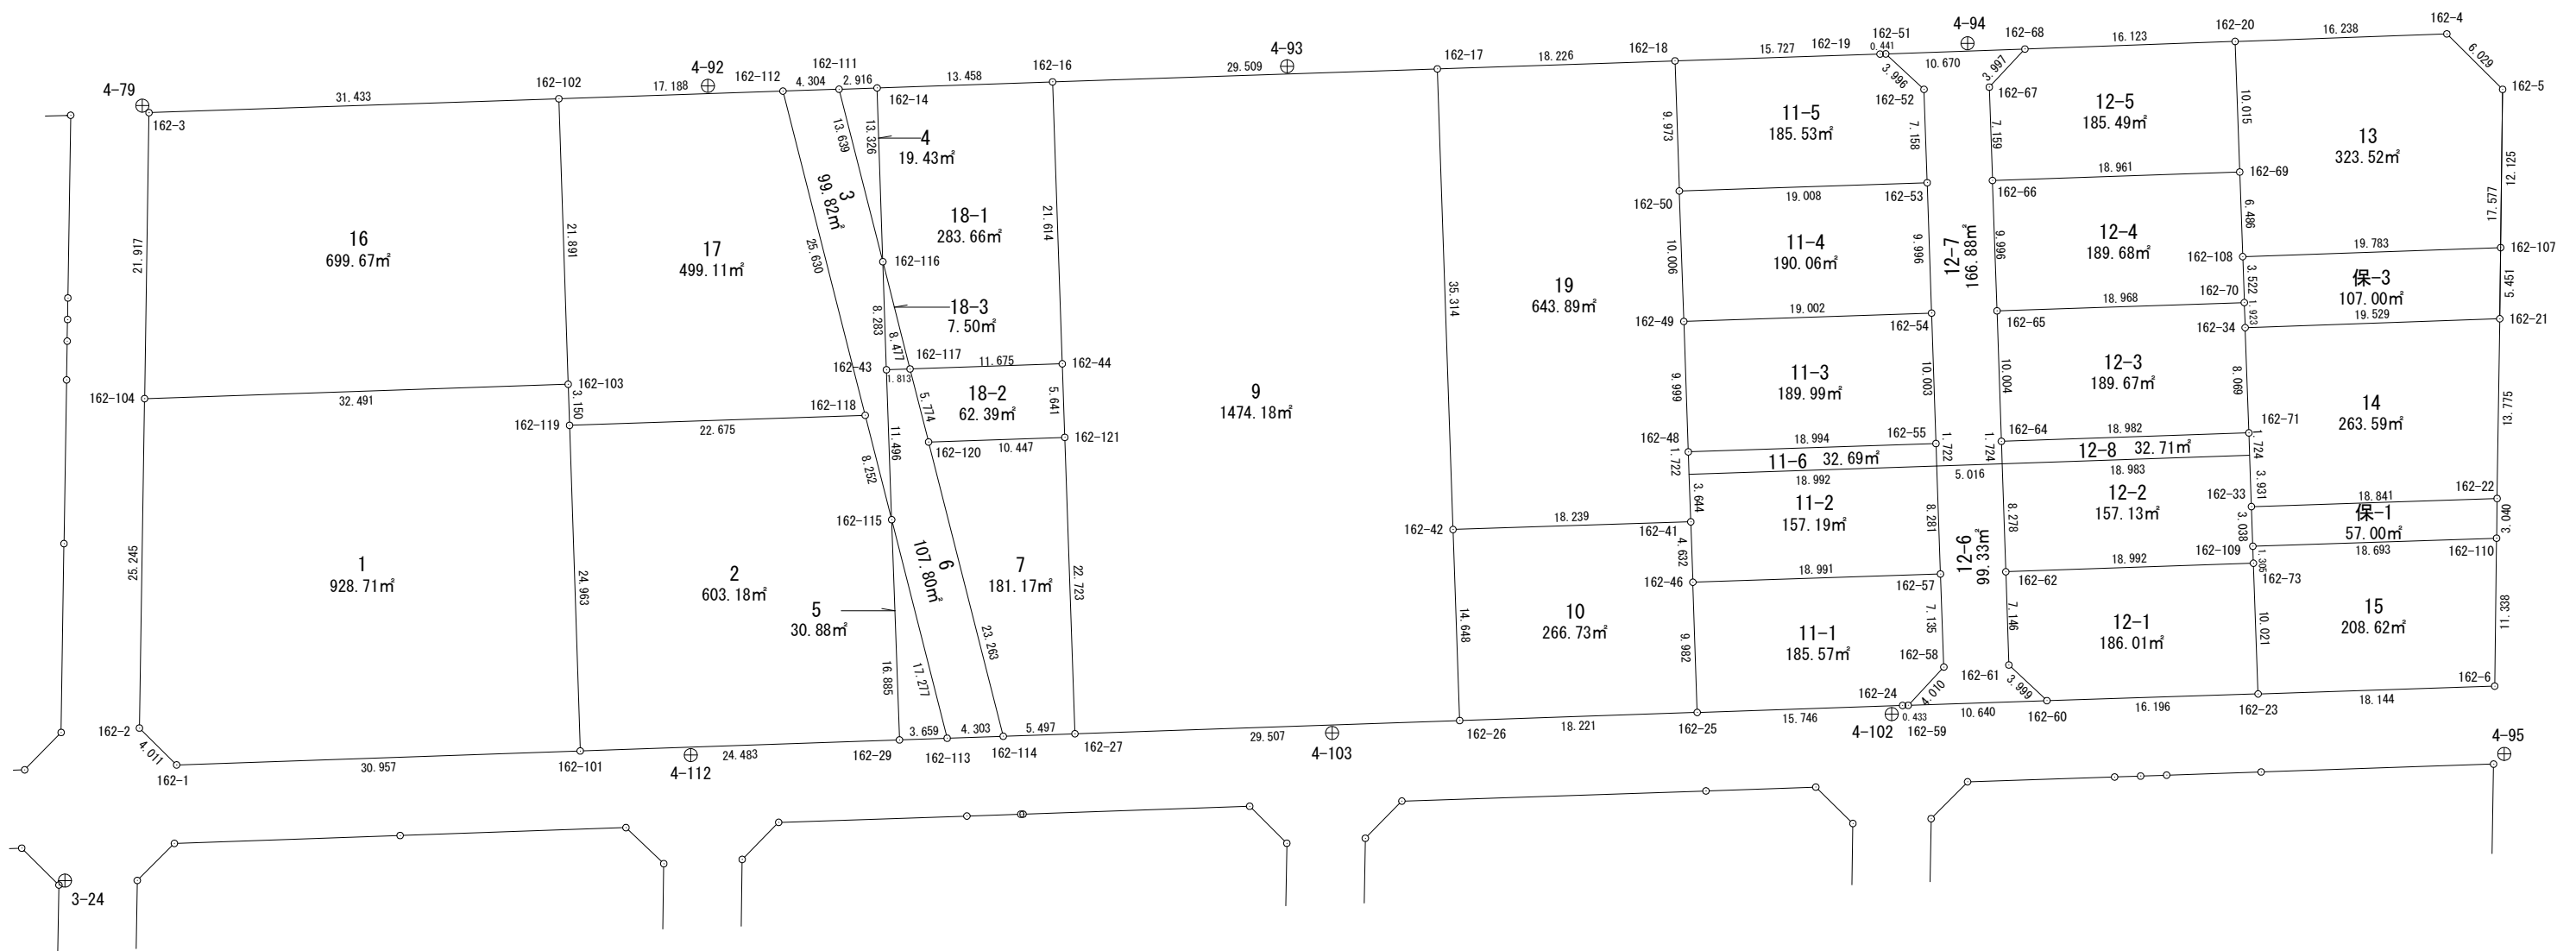

3-30 ⊕

4-95 ⊕

3-24 ⊕

4-112 ⊕

4-103 ⊕

4-102 ⊕


162-59 ⊕

面積計算書（座標法）

世界測地系（測地成果2011）

所 在	地 番	公簿地目	現況地目	地 積	所 有 者
前橋市六供町三丁目	162-3			99.82 m ²	

点 名	X 座標	Y 座標	辺 長	方 向 角	測 角	DX	倍 積 (Y×DX)
162-43	40784.893	-67854.143	8.283	86-55-38	180-07-07	1.084	-73553.891012
162-116	40785.337	-67845.872	13.639	74-35-10	167-39-32	4.069	-276064.853168
162-111	40788.962	-67832.724	4.304	356-53-01	102-17-51	7.923	-537438.672252
162-112	40793.260	-67832.958	25.630	254-35-03	77-42-02	-2.515	170599.889370
162-118	40786.447	-67857.666	8.252	254-34-52	179-59-49	-9.007	611193.997662
162-115	40784.253	-67865.621	11.496	86-48-31	12-13-39	-1.554	105463.175034
倍面積						199.645634	
面 積						99.8228170	

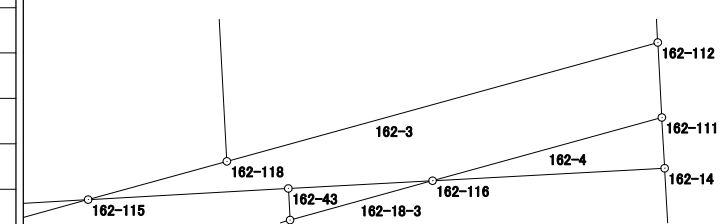


面積計算書（座標法）

世界測地系（測地成果2011）

所在	地番	公簿地目	現況地目	地積	所有者
前橋市六供町三丁目	162-4			19.43 m ²	

点名	X座標	Y座標	辺長	方向角	測角	Dx	倍積 (Y×Dx)
162-111	40788.962	-67832.724	13.639	254-35-10	77-42-41	-0.713	48364.732212
162-116	40785.337	-67845.872	13.326	86-55-59	12-20-49	-2.912	197567.179264
162-14	40786.050	-67832.565	2.916	356-52-29	89-56-30	3.625	-245893.048125
						倍面積	38.863351
						面積	19.4316755

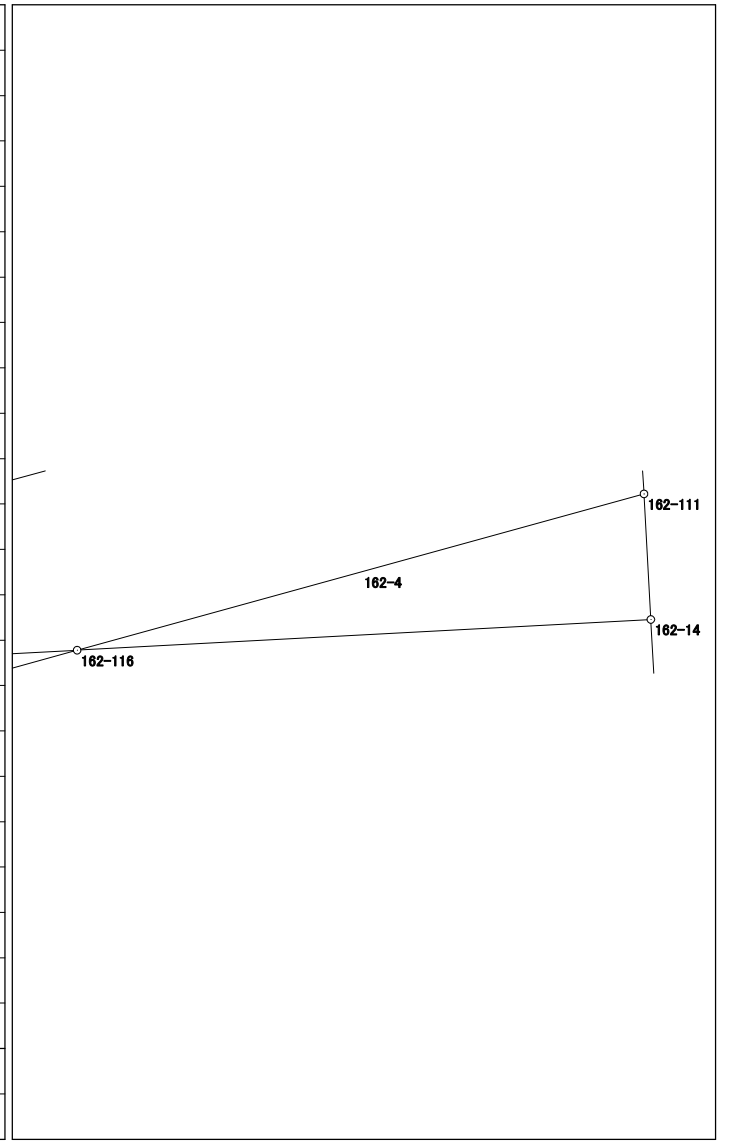

面積計算書（座標法）

世界測地系（測地成果2011）

所 在	地 番	公簿地目	現況地目	地 積	所 有 者
前橋市六供町三丁目	162-5			30.88 m ²	


点 名	X 座標	Y 座標	辺 長	方 向 角	測 角	DX	倍 積 (Y×DX)
162-115	40784.253	-67865.621	16.885	266-48-19	12-13-33	3.653	-247913.113513
162-29	40783.312	-67882.480	3.659	176-48-13	89-59-54	-4.594	311852.113120
162-113	40779.659	-67882.276	17.277	74-34-46	77-46-33	0.941	-63877.221716
						倍面積	61.777891
						面 積	30.8889455

面積計算書 (座標法)

世界測地系 (測地成果2011)

所在	地番	公簿地目	現況地目	地積	所有者
前橋市六供町三丁目	162-6			107.80 m ²	

点名	X座標	Y座標	辺長	方向角	測角	DX	倍積 (Y×DX)
162-113	40779.659	-67882.276	4.303	176-48-09	102-13-23	-8.890	603473.433640
162-114	40775.363	-67882.036	23.263	74-34-53	77-46-44	1.889	-128229.166004
162-120	40781.548	-67859.610	5.774	74-34-56	180-00-03	7.720	-523876.189200
162-117	40783.083	-67854.044	1.813	356-52-09	102-17-13	3.345	-226971.777180
162-43	40784.893	-67854.143	11.496	266-48-31	89-56-22	1.170	-79389.347310
162-115	40784.253	-67865.621	17.277	254-34-46	167-46-15	-5.234	355208.660314

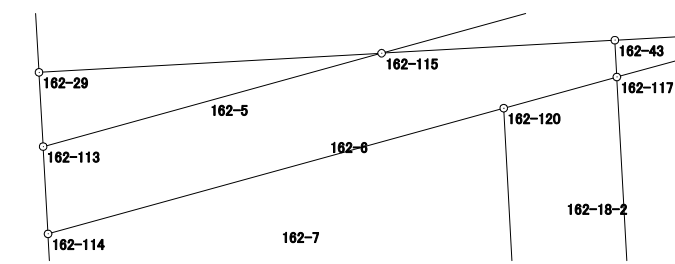


倍面積	215.614260
面積	107.8071300

面積計算書 (座標法)

世界測地系 (測地成果2011)

所在	地番	公簿地目	現況地目	地積	所有者
前橋市六供町三丁目	162-7			181.17 m ²	


点名	X座標	Y座標	辺長	方向角	測角	DX	倍積 (Y×DX)
162-121	40771.117	-67859.041	10.447	356-52-40	90-00-40	11.673	-792118.585593
162-120	40781.548	-67859.610	23.263	254-34-53	77-42-13	4.246	-288131.904060
162-114	40775.363	-67882.036	5.497	176-48-31	102-13-38	-11.673	792387.006228
162-27	40769.875	-67881.730	22.723	86-52-00	90-03-29	-4.246	288225.825580
						倍面積	362.342155
						面積	181.1710775

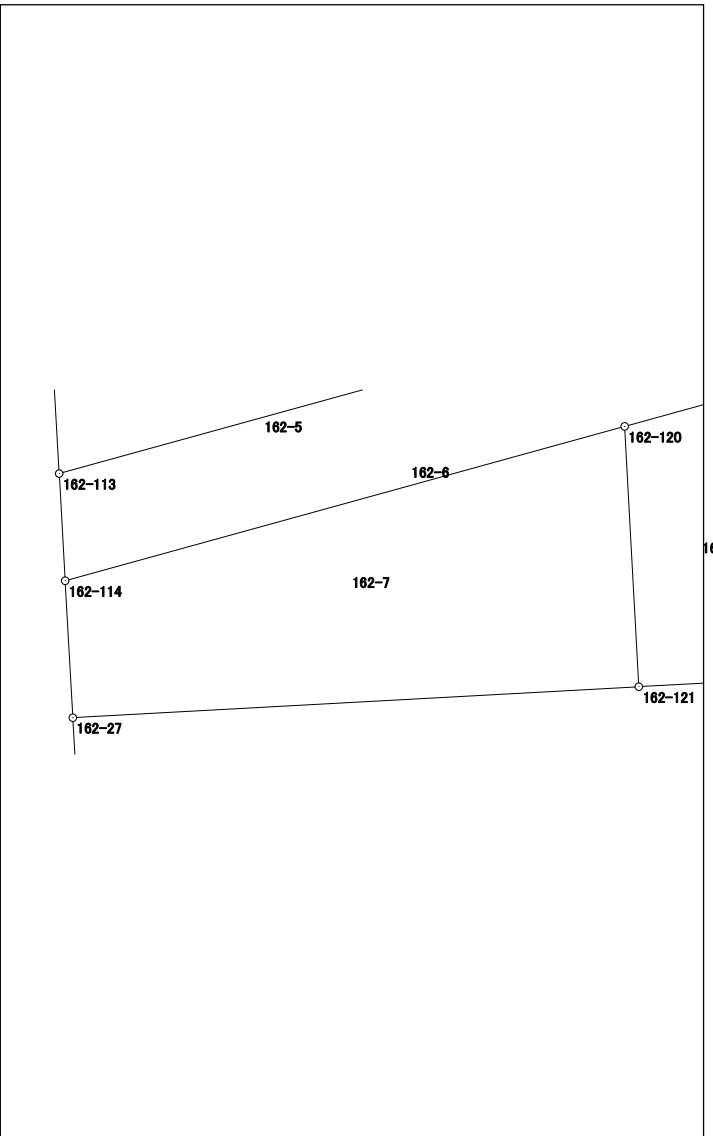

面積計算書（座標法）

世界測地系（測地成果2011）

所 在	地 番	公簿地目	現況地目	地 積	所 有 者
前橋市六供町三丁目	162-9			1474.18 m ²	

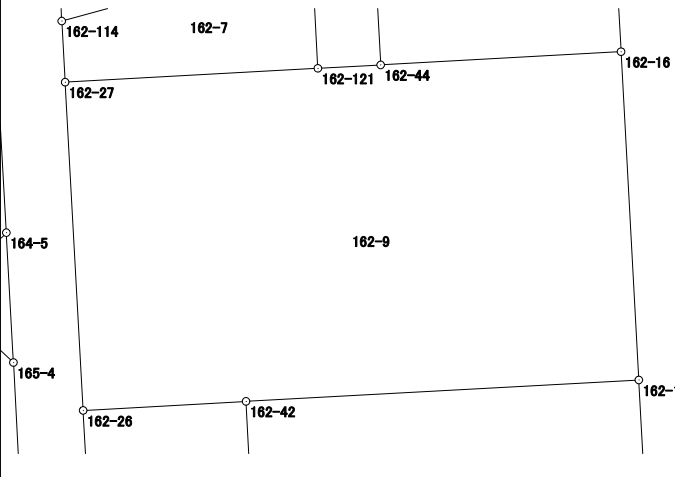
点 名	X 座標	Y 座標	辺 長	方 向 角	測 角	DX	倍 積 (Y×DX)	
162-44	40771.425	-67853.408	5.641	266-52-13	180-01-07	-1.495	101440.844960	
162-121	40771.117	-67859.041	22.723	266-52-00	179-59-47	-1.550	105181.513550	
162-27	40769.875	-67881.730	29.507	176-51-45	89-59-45	-30.705	2084308.519650	
162-26	40740.412	-67880.115	14.648	86-49-20	89-57-35	-28.651	1944833.174865	
162-42	40741.224	-67865.490	35.314	86-52-48	180-03-28	2.734	-185544.249660	
162-17	40743.146	-67830.228	29.509	356-53-38	90-00-50	31.388	-2129055.196464	
162-16	40772.612	-67831.827	21.614	266-51-06	89-57-28	28.279	-1918216.235733	
								
倍面積							2948.371168	
面 積							1474.1855840	

面積計算書（座標法）

世界測地系（測地成果2011）

所在	地番	公簿地目	現況地目	地積	所有者
前橋市六供町三丁目	162-10			266.73 m ²	

点名	X座標	Y座標	辺長	方向角	測角	DX	倍積 (Y×DX)
162-26	40740.412	-67880.115	18.221	176-52-11	90-02-51	-19.006	1290129.465690
162-25	40722.218	-67879.120	9.982	86-54-16	90-02-05	-17.655	1198405.863600
162-46	40722.757	-67869.153	4.632	86-52-08	179-57-52	0.792	-53752.369176
162-41	40723.010	-67864.528	18.239	356-58-36	90-06-28	18.467	-1253254.238576
162-42	40741.224	-67865.490	14.648	266-49-20	89-50-44	17.402	-1180995.256980
						倍面積	533.464558
						面積	266.7322790

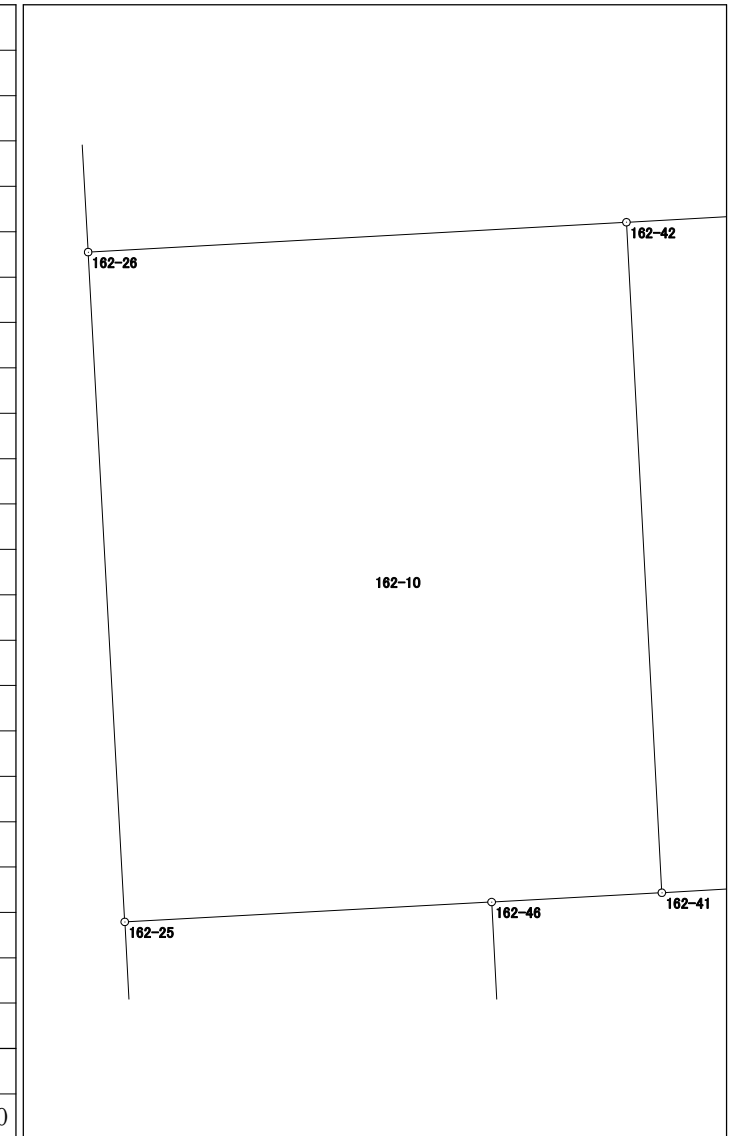


面積計算書（座標法）

世界測地系（測地成果2011）

所在	地番	公簿地目	現況地目	地積	所有者
前橋市六供町三丁目	162-11-1			185.57 m ²	

点名	X座標	Y座標	辺長	方向角	測角	DX	倍積 (Y×DX)
162-59	40706.062	-67878.244	4.010	131-47-08	134-17-53	-3.105	210761.947620
162-58	40703.390	-67875.254	7.135	86-45-15	134-58-07	-2.268	153941.076072
162-57	40703.794	-67868.130	18.991	356-54-43	90-09-28	19.367	-1314402.073710
162-46	40722.757	-67869.153	9.982	266-54-16	89-59-33	18.424	-1250421.274872
162-25	40722.218	-67879.120	15.746	176-52-48	89-58-32	-16.262	1103850.249440
162-24	40706.495	-67878.263	0.433	177-29-15	180-36-27	-16.156	1096641.217028
倍面積							371.141578
面積							185.5707890

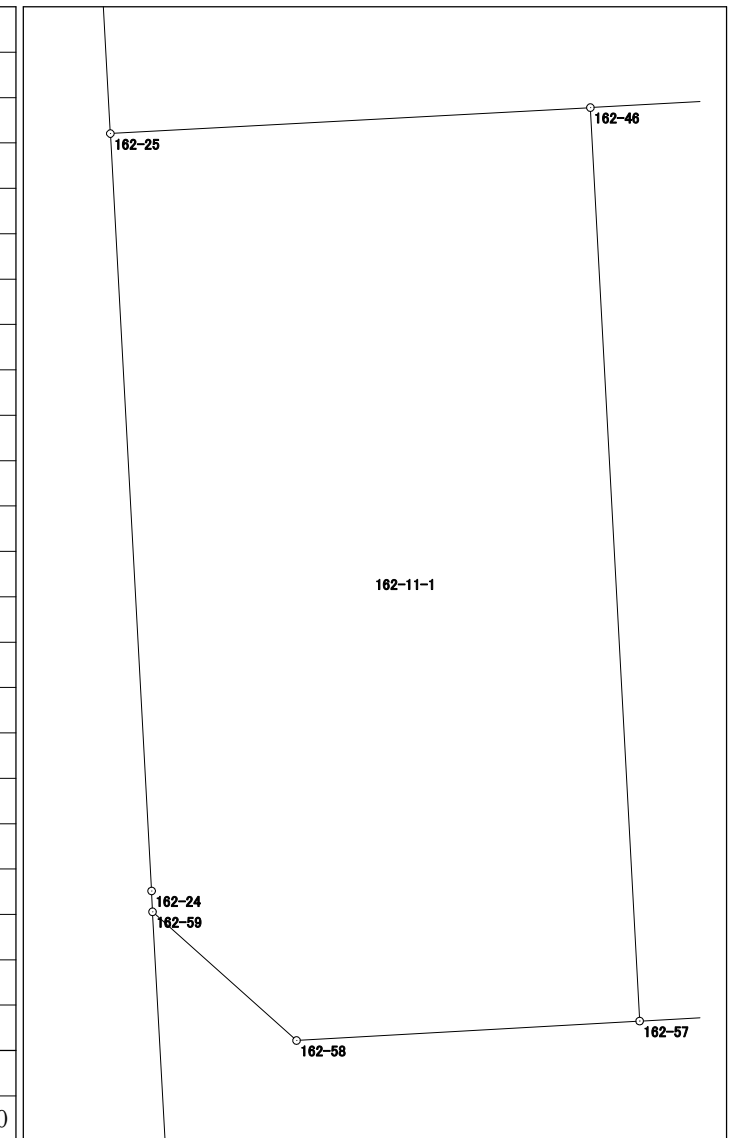


面積計算書（座標法）

世界測地系（測地成果2011）

所 在	地 番	公簿地目	現況地目	地 積	所 有 者
前橋市六供町三丁目	162-11-2			157.19 m ²	

点 名	X 座標	Y 座標	辺 長	方 向 角	測 角	DX	倍 積 (Y×DX)
162-122	40723.215	-67860.890	3.644	266-46-29	89-52-39	18.759	-1273002.435510
162-41	40723.010	-67864.528	4.632	266-52-08	180-05-39	-0.458	31081.953824
162-46	40722.757	-67869.153	18.991	176-54-43	90-02-35	-19.216	1304173.644048
162-57	40703.794	-67868.130	8.281	86-50-11	89-55-28	-18.506	1255967.613780
162-123	40704.251	-67859.862	18.992	356-53-50	90-03-39	19.421	-1317906.379902
倍面積							314.396240
面 積							157.1981200

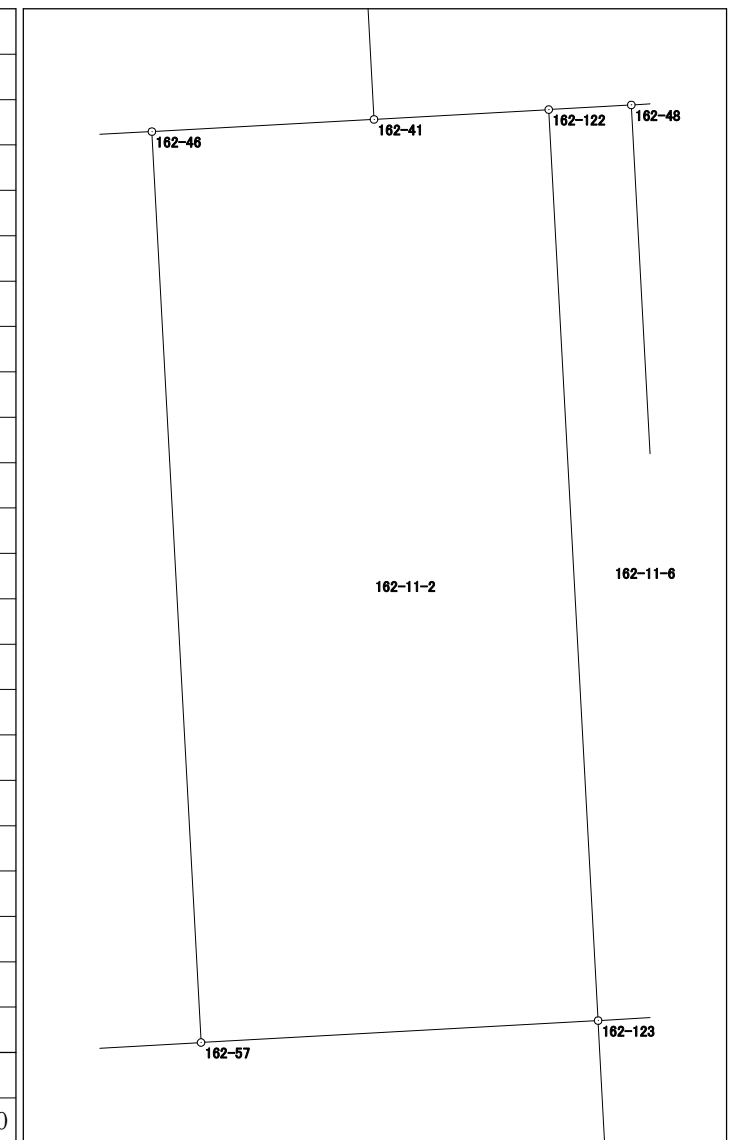


面積計算書 (座標法)

世界測地系 (測地成果2011)

所 在	地 番	公簿地目	現況地目	地 積	所 有 者
前橋市六供町三丁目	162-11-3			189.99 m ²	

点 名	X 座標	Y 座標	辺 長	方 向 角	測 角	DX	倍 積 (Y×DX)
162-48	40723.312	-67859.171	18.994	176-53-51	90-02-42	-19.515	1324271.722065
162-55	40704.346	-67858.143	10.003	86-53-59	90-00-08	-18.425	1250286.284775
162-54	40704.887	-67848.155	19.002	356-53-12	89-59-13	19.515	-1324056.744825
162-49	40723.861	-67849.187	9.999	266-51-09	89-57-57	18.425	-1250121.270475
						倍面積	379.991540
						面 積	189.9957700

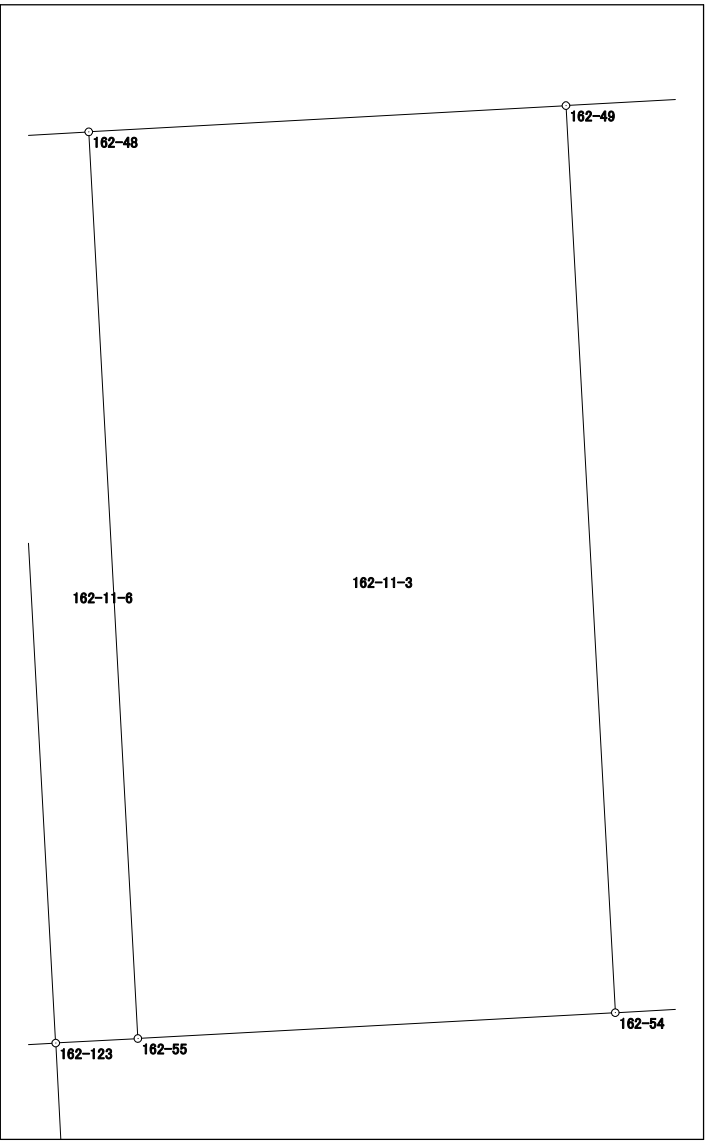


面積計算書（座標法）

世界測地系（測地成果2011）

所 在	地 番	公簿地目	現況地目	地 積	所 有 者
前橋市六供町三丁目	162-11-5			185.53 m ²	

点 名	X 座標	Y 座標	辺 長	方 向 角	測 角	DX	倍 積 (Y×DX)
162-50	40724.410	-67839.196	19.008	176-55-05	90-00-16	-19.518	1324085.427528
162-53	40705.429	-67838.174	7.158	86-53-04	89-57-59	-18.592	1261247.331008
162-52	40705.818	-67831.027	3.996	41-40-22	134-47-18	3.374	-228861.885098
162-51	40708.803	-67828.370	0.441	356-52-40	135-12-18	3.425	-232312.167250
162-19	40709.243	-67828.394	15.727	356-55-38	180-02-58	16.144	-1095021.592736
162-18	40724.947	-67829.237	9.973	266-54-49	89-59-11	15.167	-1028766.037579
						倍面積	371.075873
						面 積	185.5379365

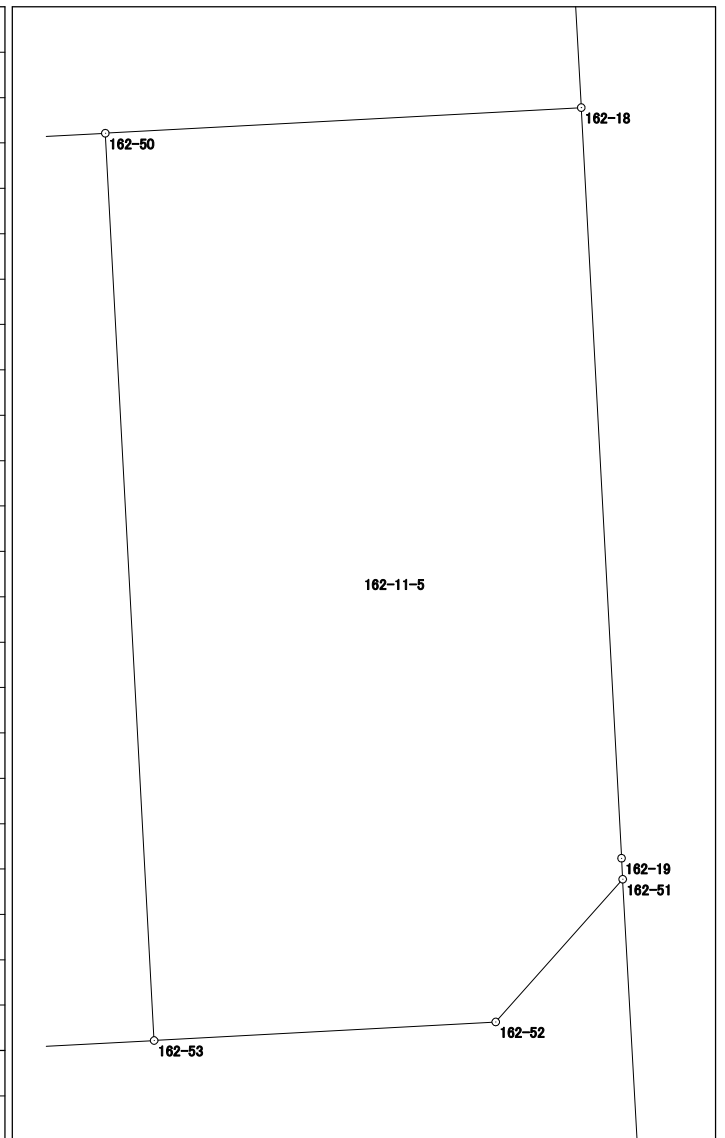


面積計算書（座標法）

世界測地系（測地成果2011）

所在	地番	公簿地目	現況地目	地積	所有者
前橋市六供町三丁目	162-11-6			32.69 m ²	

点名	X座標	Y座標	辺長	方向角	測角	DX	倍積 (Y×DX)
162-55	40704.346	-67858.143	18.994	356-53-51	90-03-39	19.061	-1293444.063723
162-48	40723.312	-67859.171	1.722	266-46-13	89-52-22	18.869	-1280434.697599
162-122	40723.215	-67860.890	18.992	176-53-50	90-07-37	-19.061	1293496.424290
162-123	40704.251	-67859.862	1.722	86-50-12	89-56-22	-18.869	1280447.736078
						倍面積	65.399046
						面積	32.6995230

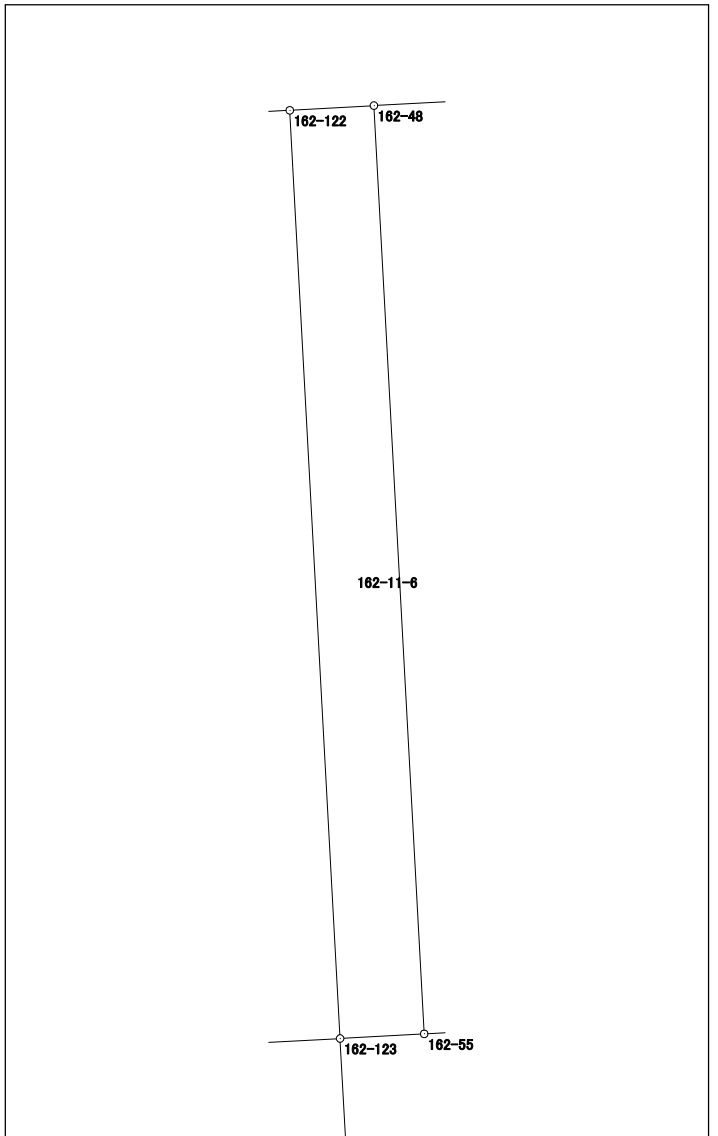


面積計算書（座標法）

世界測地系（測地成果2011）

所 在	地 番	公簿地目	現況地目	地 積	所 有 者
前橋市六供町三丁目	162-12-1			186.01 m ²	

点 名	X 座標	Y 座標	辺 長	方 向 角	測 角	DX	倍 積 (Y×DX)
162-23	40679.264	-67876.820	10.021	86-45-44	89-45-49	-15.608	1059421.406560
162-73	40679.830	-67866.815	18.992	356-51-06	90-05-22	19.529	-1325371.030135
162-62	40698.793	-67867.858	7.146	266-56-09	90-05-03	18.581	-1261052.669498
162-61	40698.411	-67874.994	3.999	221-58-09	135-02-00	-3.355	227720.604870
162-60	40695.438	-67877.668	16.196	176-59-55	135-01-46	-19.147	1299653.709196
						倍面積	372.020993
						面 積	186.0104965

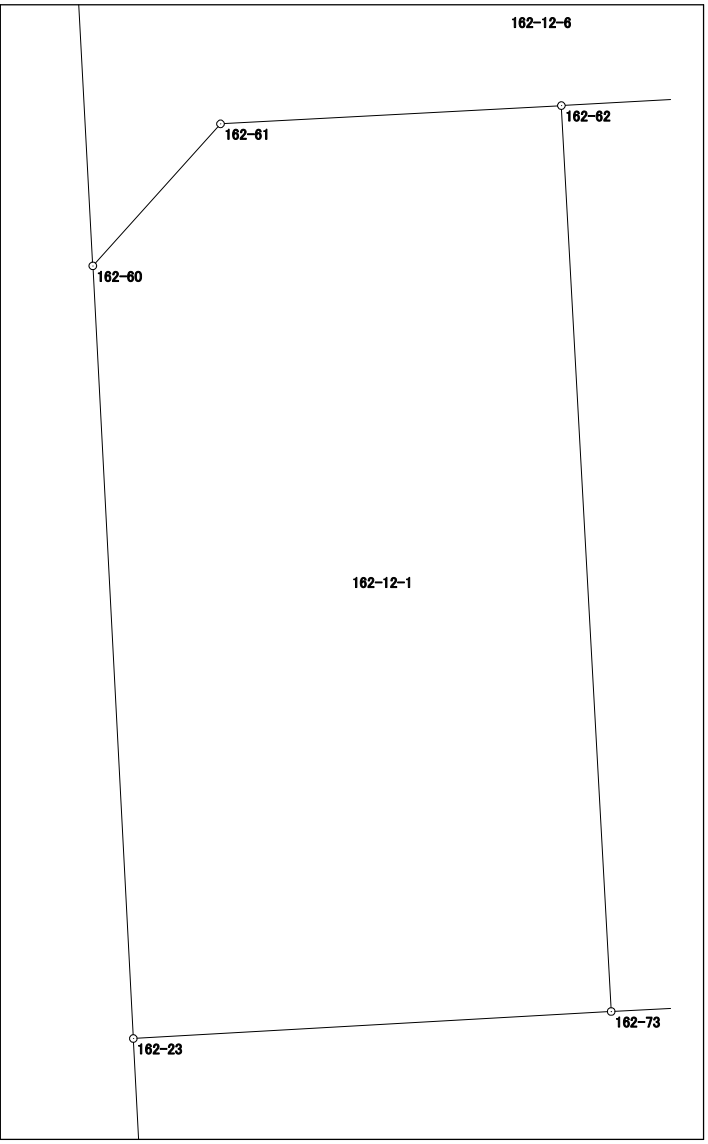


面積計算書（座標法）

世界測地系（測地成果2011）

所在	地番	公簿地目	現況地目	地積	所有者
前橋市六供町三丁目	162-12-2			157.13 m ²	

点名	X座標	Y座標	辺長	方向角	測角	DX	倍積 (Y×DX)
162-124	40699.242	-67859.592	8.278	266-53-27	90-01-31	18.506	-1255809.609552
162-62	40698.793	-67867.858	18.992	176-51-06	89-57-39	-19.412	1317450.859496
162-73	40679.830	-67866.815	1.305	86-55-30	90-04-24	-18.893	1282207.735795
162-109	40679.900	-67865.512	3.038	86-46-23	179-50-53	0.241	-16355.588392
162-33	40680.071	-67862.479	3.931	86-51-00	180-04-37	0.387	-26262.779373
162-125	40680.287	-67858.554	18.983	356-51-56	90-00-56	19.171	-1300916.338734

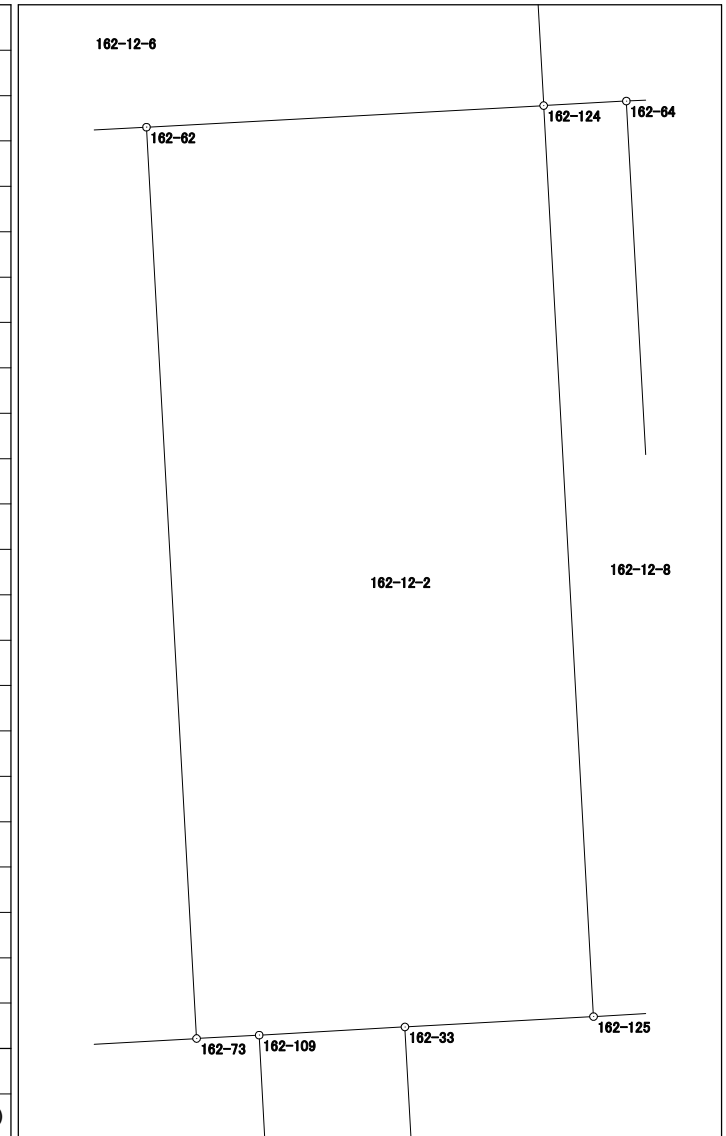


倍面積	314.279240
面積	157.1396200

面積計算書（座標法）

世界測地系（測地成果2011）

所在	地番	公簿地目	現況地目	地積	所有者
前橋市六供町三丁目	162-12-3			189.67 m ²	

点名	X座標	Y座標	辺長	方向角	測角	DX	倍積 (Y×DX)
162-64	40699.336	-67857.871	18.982	176-51-55	89-57-35	-19.494	1322821.337274
162-71	40680.382	-67856.833	8.069	86-46-54	89-54-59	-18.501	1255419.267333
162-34	40680.835	-67848.777	1.923	86-59-20	180-12-26	0.554	-37588.222458
162-70	40680.936	-67846.857	18.968	356-54-08	89-54-48	19.041	-1291872.004137
162-65	40699.876	-67847.882	10.004	266-54-20	90-00-12	18.400	-1248401.028800
倍面積							379.349212
面積							189.6746060

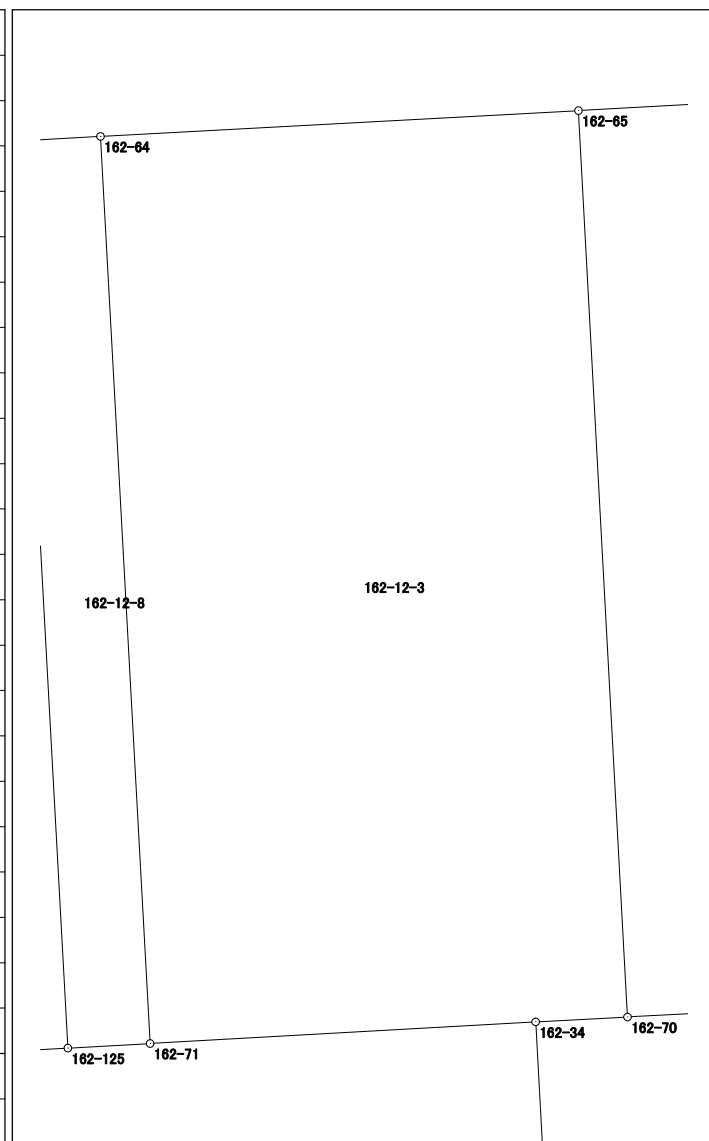


面積計算書（座標法）

世界測地系（測地成果2011）

所 在	地 番	公簿地目	現況地目	地 積	所 有 者
前橋市六供町三丁目	162-12-4			189.68 m ²	

点 名	X 座標	Y 座標	辺 長	方 向 角	測 角	DX	倍 積 (Y×DX)
162-65	40699.876	-67847.882	18.968	176-54-08	90-04-04	-19.492	1322490.915944
162-70	40680.936	-67846.857	3.522	86-47-35	89-53-27	-18.743	1271653.640751
162-108	40681.133	-67843.341	6.486	86-48-02	180-00-27	0.559	-37924.427619
162-69	40681.495	-67836.865	18.961	356-52-05	90-04-03	19.295	-1308912.310175
162-66	40700.428	-67837.901	9.996	266-50-04	89-57-59	18.381	-1246928.458281
						倍面積	379.360620
						面 積	189.6803100

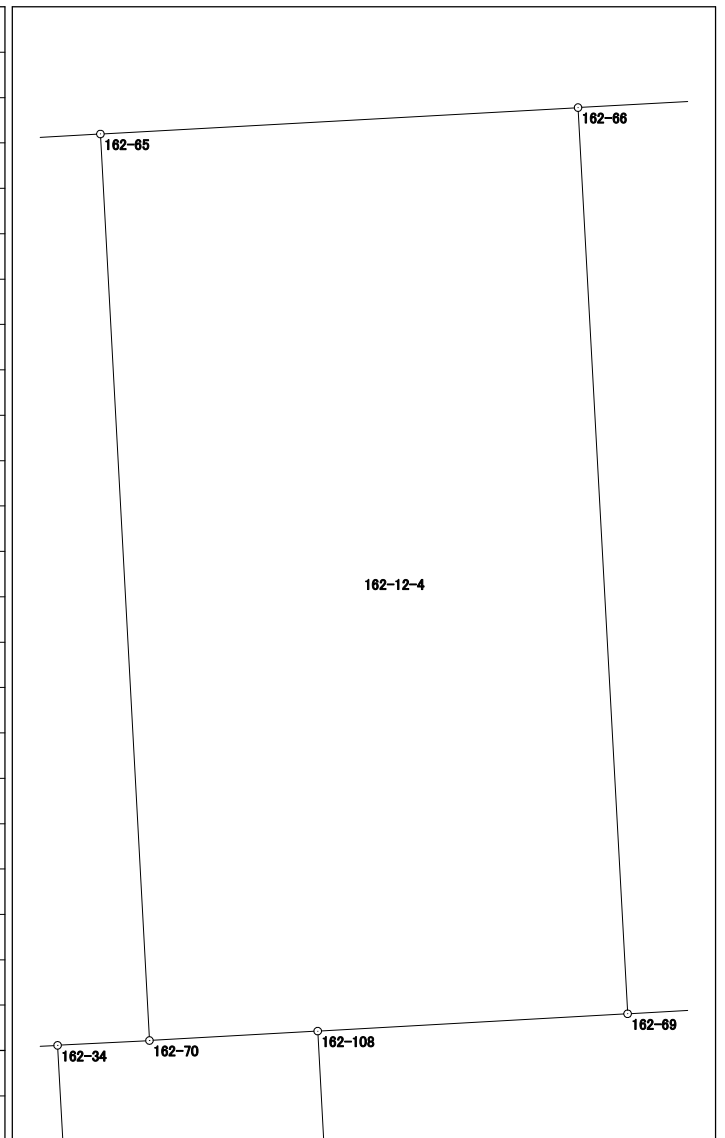


面積計算書 (座標法)

世界測地系 (測地成果2011)

所在	地番	公簿地目	現況地目	地積	所有者
前橋市六供町三丁目	162-12-5			185.49 m ²	

点名	X座標	Y座標	辺長	方向角	測角	DX	倍積 (Y×DX)
162-66	40700.428	-67837.901	18.961	176-52-05	90-00-25	-19.325	1310967.436825
162-69	40681.495	-67836.865	10.015	86-48-42	89-56-37	-18.376	1246570.231240
162-20	40682.052	-67826.866	16.123	356-45-01	89-56-19	16.654	-1129588.626364
162-68	40698.149	-67827.780	3.997	311-56-14	135-11-13	18.768	-1272991.775040
162-67	40700.820	-67830.753	7.159	266-51-40	134-55-26	2.279	-154586.286087

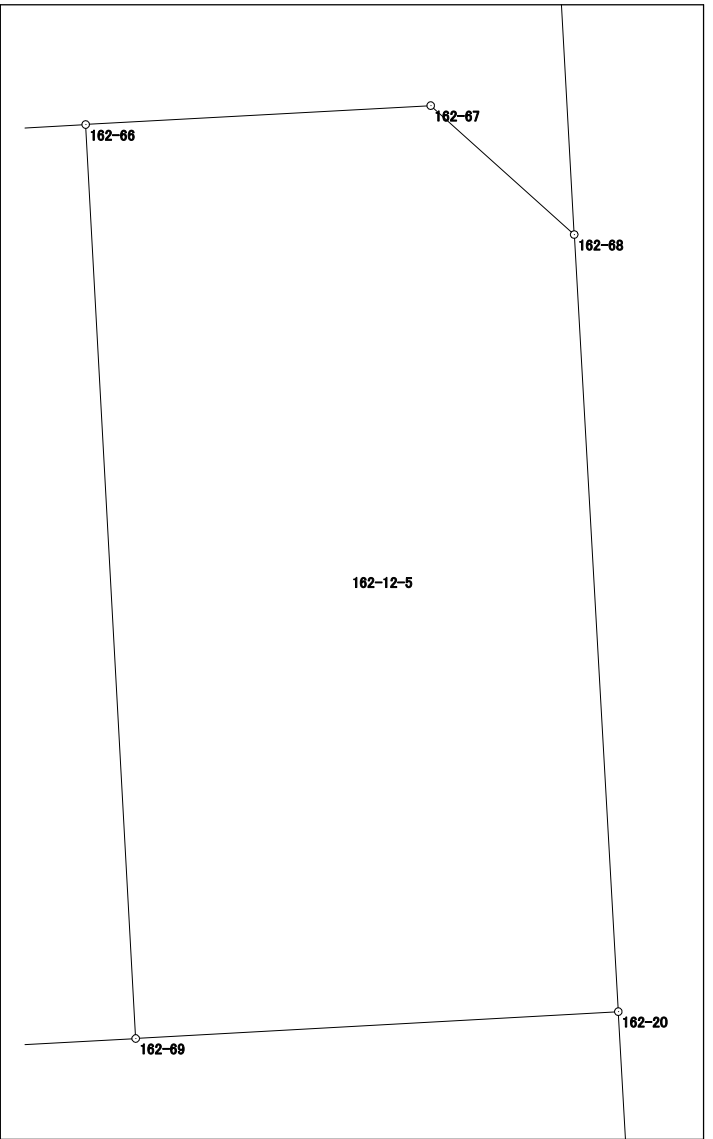

倍面積	370.980574
面積	185.4902870


面積計算書 (座標法)

世界測地系 (測地成果2011)

所 在	地 番	公簿地目	現況地目	地 積	所 有 者
前橋市六供町三丁目	162-12-6			99.33 m ²	

点 名	X 座標	Y 座標	辺 長	方 向 角	測 角	DX	倍 積 (Y×DX)
162-59	40706.062	-67878.244	10.640	176-53-48	45-06-40	-7.952	539767.796288
162-60	40695.438	-67877.668	3.999	41-58-09	45-04-21	-7.651	519332.037868
162-61	40698.411	-67874.994	7.146	86-56-09	224-58-00	3.355	-227720.604870
162-62	40698.793	-67867.858	8.278	86-53-27	179-57-18	0.831	-56398.189998
162-124	40699.242	-67859.592	5.016	356-54-52	90-01-25	5.458	-370377.653136
162-123	40704.251	-67859.862	8.281	266-50-11	89-55-19	4.552	-308898.091824
162-57	40703.794	-67868.130	7.135	266-45-15	179-55-04	-0.861	58434.459930
162-58	40703.390	-67875.254	4.010	311-47-08	225-01-53	2.268	-153941.076072

倍面積	198.678186
面 積	99.3390930

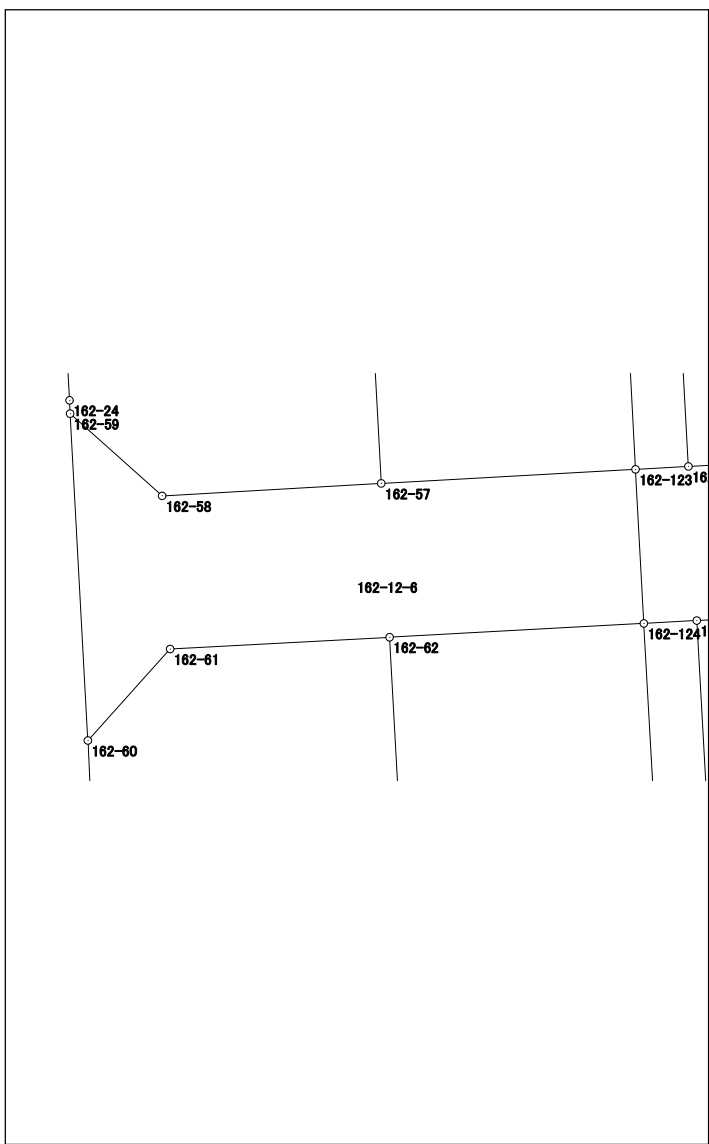


面積計算書 (座標法)

世界測地系 (測地成果2011)

所在	地番	公簿地目	現況地目	地積	所有者
前橋市六供町三丁目	162-12-7			166.88 m ²	

点名	X座標	Y座標	辺長	方向角	測角	DX	倍積 (Y×DX)
162-55	40704.346	-67858.143	1.722	266-50-12	179-56-13	-0.636	43157.778948
162-123	40704.251	-67859.862	5.016	176-54-52	90-04-40	-5.104	346356.735648
162-124	40699.242	-67859.592	1.724	86-52-25	89-57-33	-4.915	333529.894680
162-64	40699.336	-67857.871	10.004	86-54-20	180-01-55	0.634	-43021.890214
162-65	40699.876	-67847.882	9.996	86-50-04	179-55-44	1.092	-74089.887144
162-66	40700.428	-67837.901	7.159	86-51-40	180-01-36	0.944	-64038.978544
162-67	40700.820	-67830.753	3.997	131-56-14	225-04-34	-2.279	154586.286087
162-68	40698.149	-67827.780	10.670	356-49-49	44-53-35	7.983	-541469.167740
162-51	40708.803	-67828.370	3.996	221-40-22	44-50-33	7.669	-520175.769530
162-52	40705.818	-67831.027	7.158	266-53-04	225-12-42	-3.374	228861.885098
162-53	40705.429	-67838.174	9.996	266-53-30	180-00-26	-0.931	63157.339994
162-54	40704.887	-67848.155	10.003	266-53-59	180-00-29	-1.083	73479.551865

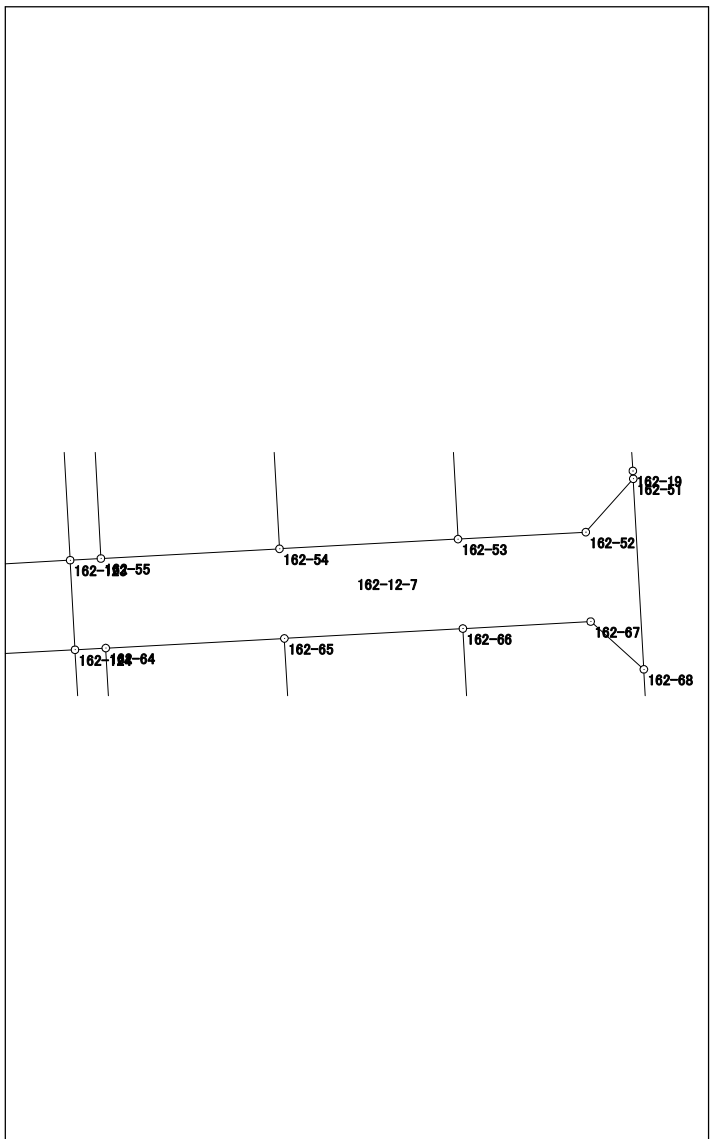


倍面積	333.779148
面積	166.8895740

面積計算書（座標法）

世界測地系（測地成果2011）

所在	地番	公簿地目	現況地目	地積	所有者
前橋市六供町三丁目	162-12-8			32.71 m ²	

点名	X座標	Y座標	辺長	方向角	測角	DX	倍積 (Y×DX)
162-64	40699.336	-67857.871	1.724	266-52-25	90-00-30	18.860	-1279799.447060
162-124	40699.242	-67859.592	18.983	176-51-56	89-59-31	-19.049	1292657.368008
162-125	40680.287	-67858.554	1.724	86-50-26	89-58-30	-18.860	1279812.328440
162-71	40680.382	-67856.833	18.982	356-51-55	90-01-29	19.049	-1292604.811817

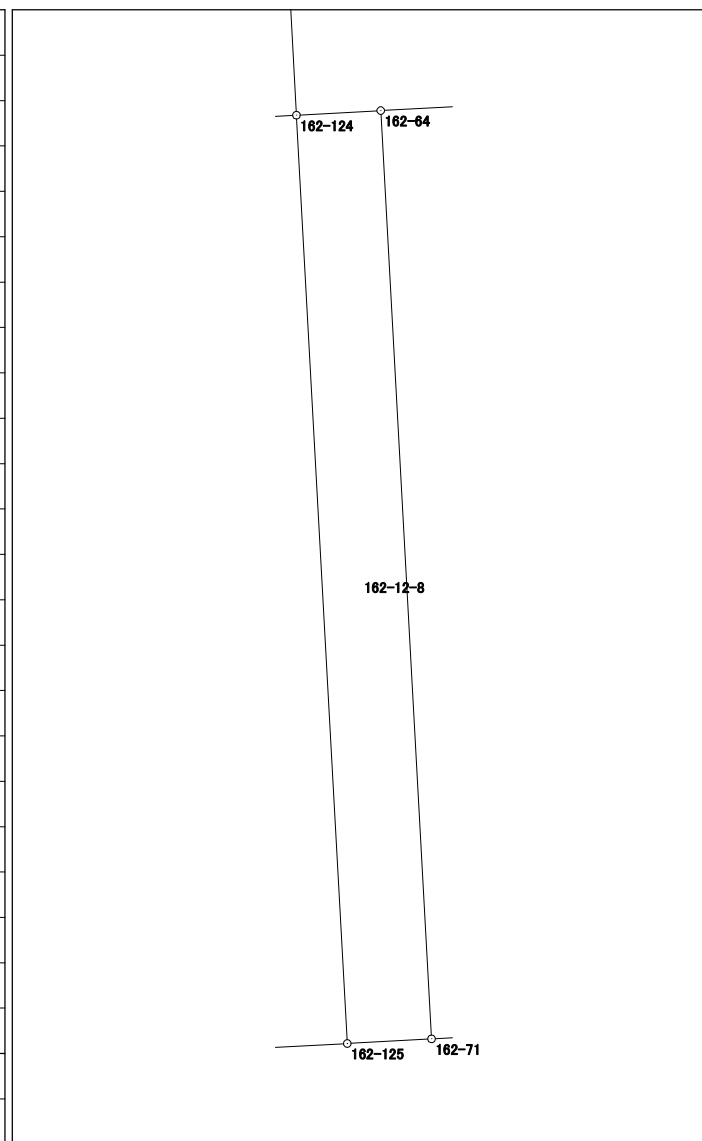


倍面積	65.437571
面積	32.7187855

面積計算書 (座標法)

世界測地系 (測地成果2011)

所 在	地 番	公簿地目	現況地目	地 積	所 有 者
前橋市六供町三丁目	162-18-1			283.66 m ²	

点 名	X 座標	Y 座標	辺 長	方 向 角	測 角	DX	倍 積 (Y×DX)
162-116	40785.337	-67845.872	8.477	254-34-48	167-38-49	-2.967	201298.702224
162-117	40783.083	-67854.044	11.675	176-52-38	102-17-50	-13.912	943985.460128
162-44	40771.425	-67853.408	21.614	86-51-06	89-58-28	-10.471	710493.035168
162-16	40772.612	-67831.827	13.458	356-51-24	90-00-18	14.625	-992040.469875
162-14	40786.050	-67832.565	13.326	266-55-59	90-04-35	12.725	-863169.389625
						倍面積	567.338020
						面 積	283.6690100

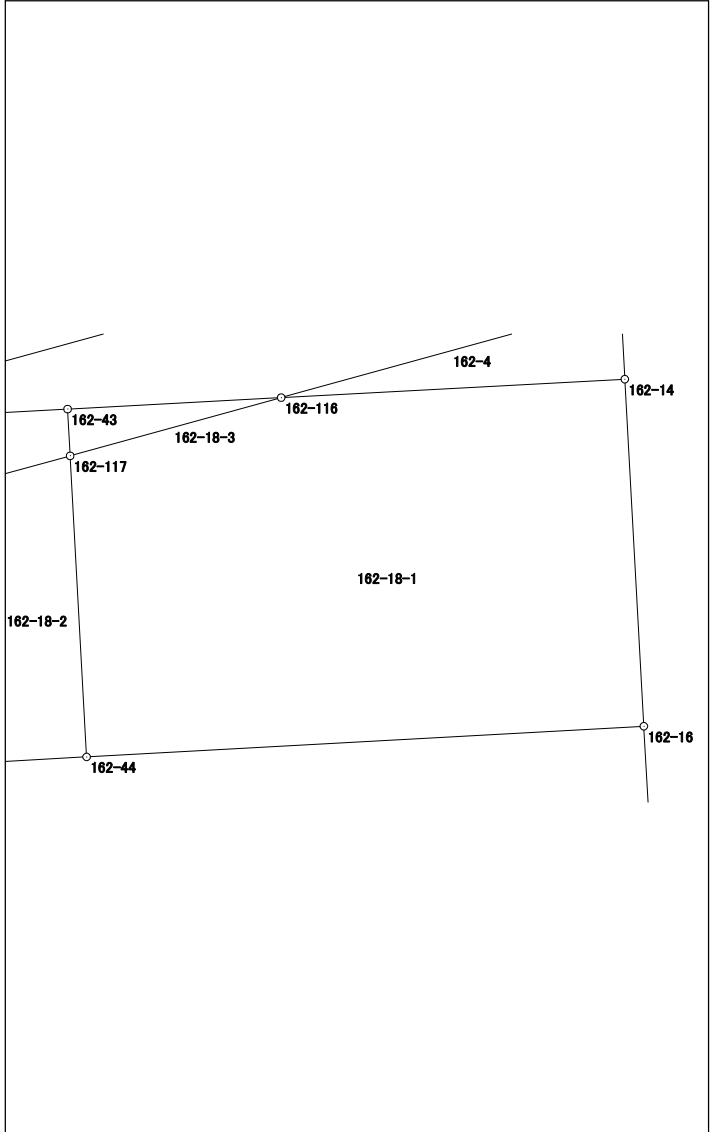


面積計算書（座標法）

世界測地系（測地成果2011）

所在	地番	公簿地目	現況地目	地積	所有者
前橋市六供町三丁目	162-18-3			7.50 m ²	

点名	X座標	Y座標	辺長	方向角	測角	DX	倍積 (Y×DX)
162-43	40784.893	-67854.143	1.813	176-52-09	89-56-31	-2.254	152943.238322
162-117	40783.083	-67854.044	8.477	74-34-48	77-42-39	0.444	-30127.195536
162-116	40785.337	-67845.872	8.283	266-55-38	12-20-50	1.810	-122801.028320
						倍面積	15.014466
						面積	7.5072330

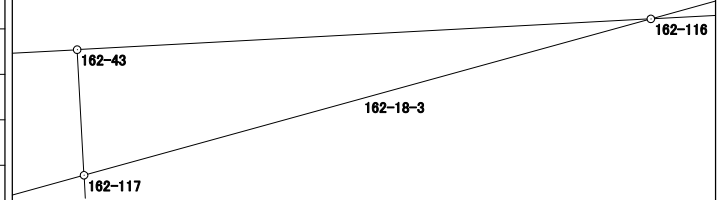

面積計算書 (座標法)

世界測地系 (測地成果2011)

所 在	地 番	公簿地目	現況地目	地 積	所 有 者
前橋市六供町三丁目	162-保-3			107.00 m ²	

点 名	X 座標	Y 座標	辺 長	方 向 角	測 角	DX	倍 積 (Y×DX)
162-21	40661.336	-67847.697	5.451	89-32-15	92-42-28	-19.455	1319976.945135
162-107	40661.380	-67842.246	19.783	356-49-37	87-17-22	19.797	-1343072.944062
162-108	40681.133	-67843.341	3.522	266-47-35	89-57-58	19.556	-1326744.376596
162-70	40680.936	-67846.857	1.923	266-59-20	180-11-45	-0.298	20218.363386
162-34	40680.835	-67848.777	19.529	176-49-47	89-50-27	-19.600	1329836.029200
						倍面積	214.017063
						面 積	107.0085315

