



168街区 画地出来形確認図 (1984.58m²)

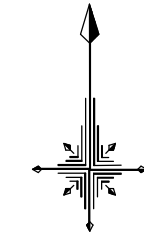

S=1/250

3. 4. 32本町六供線

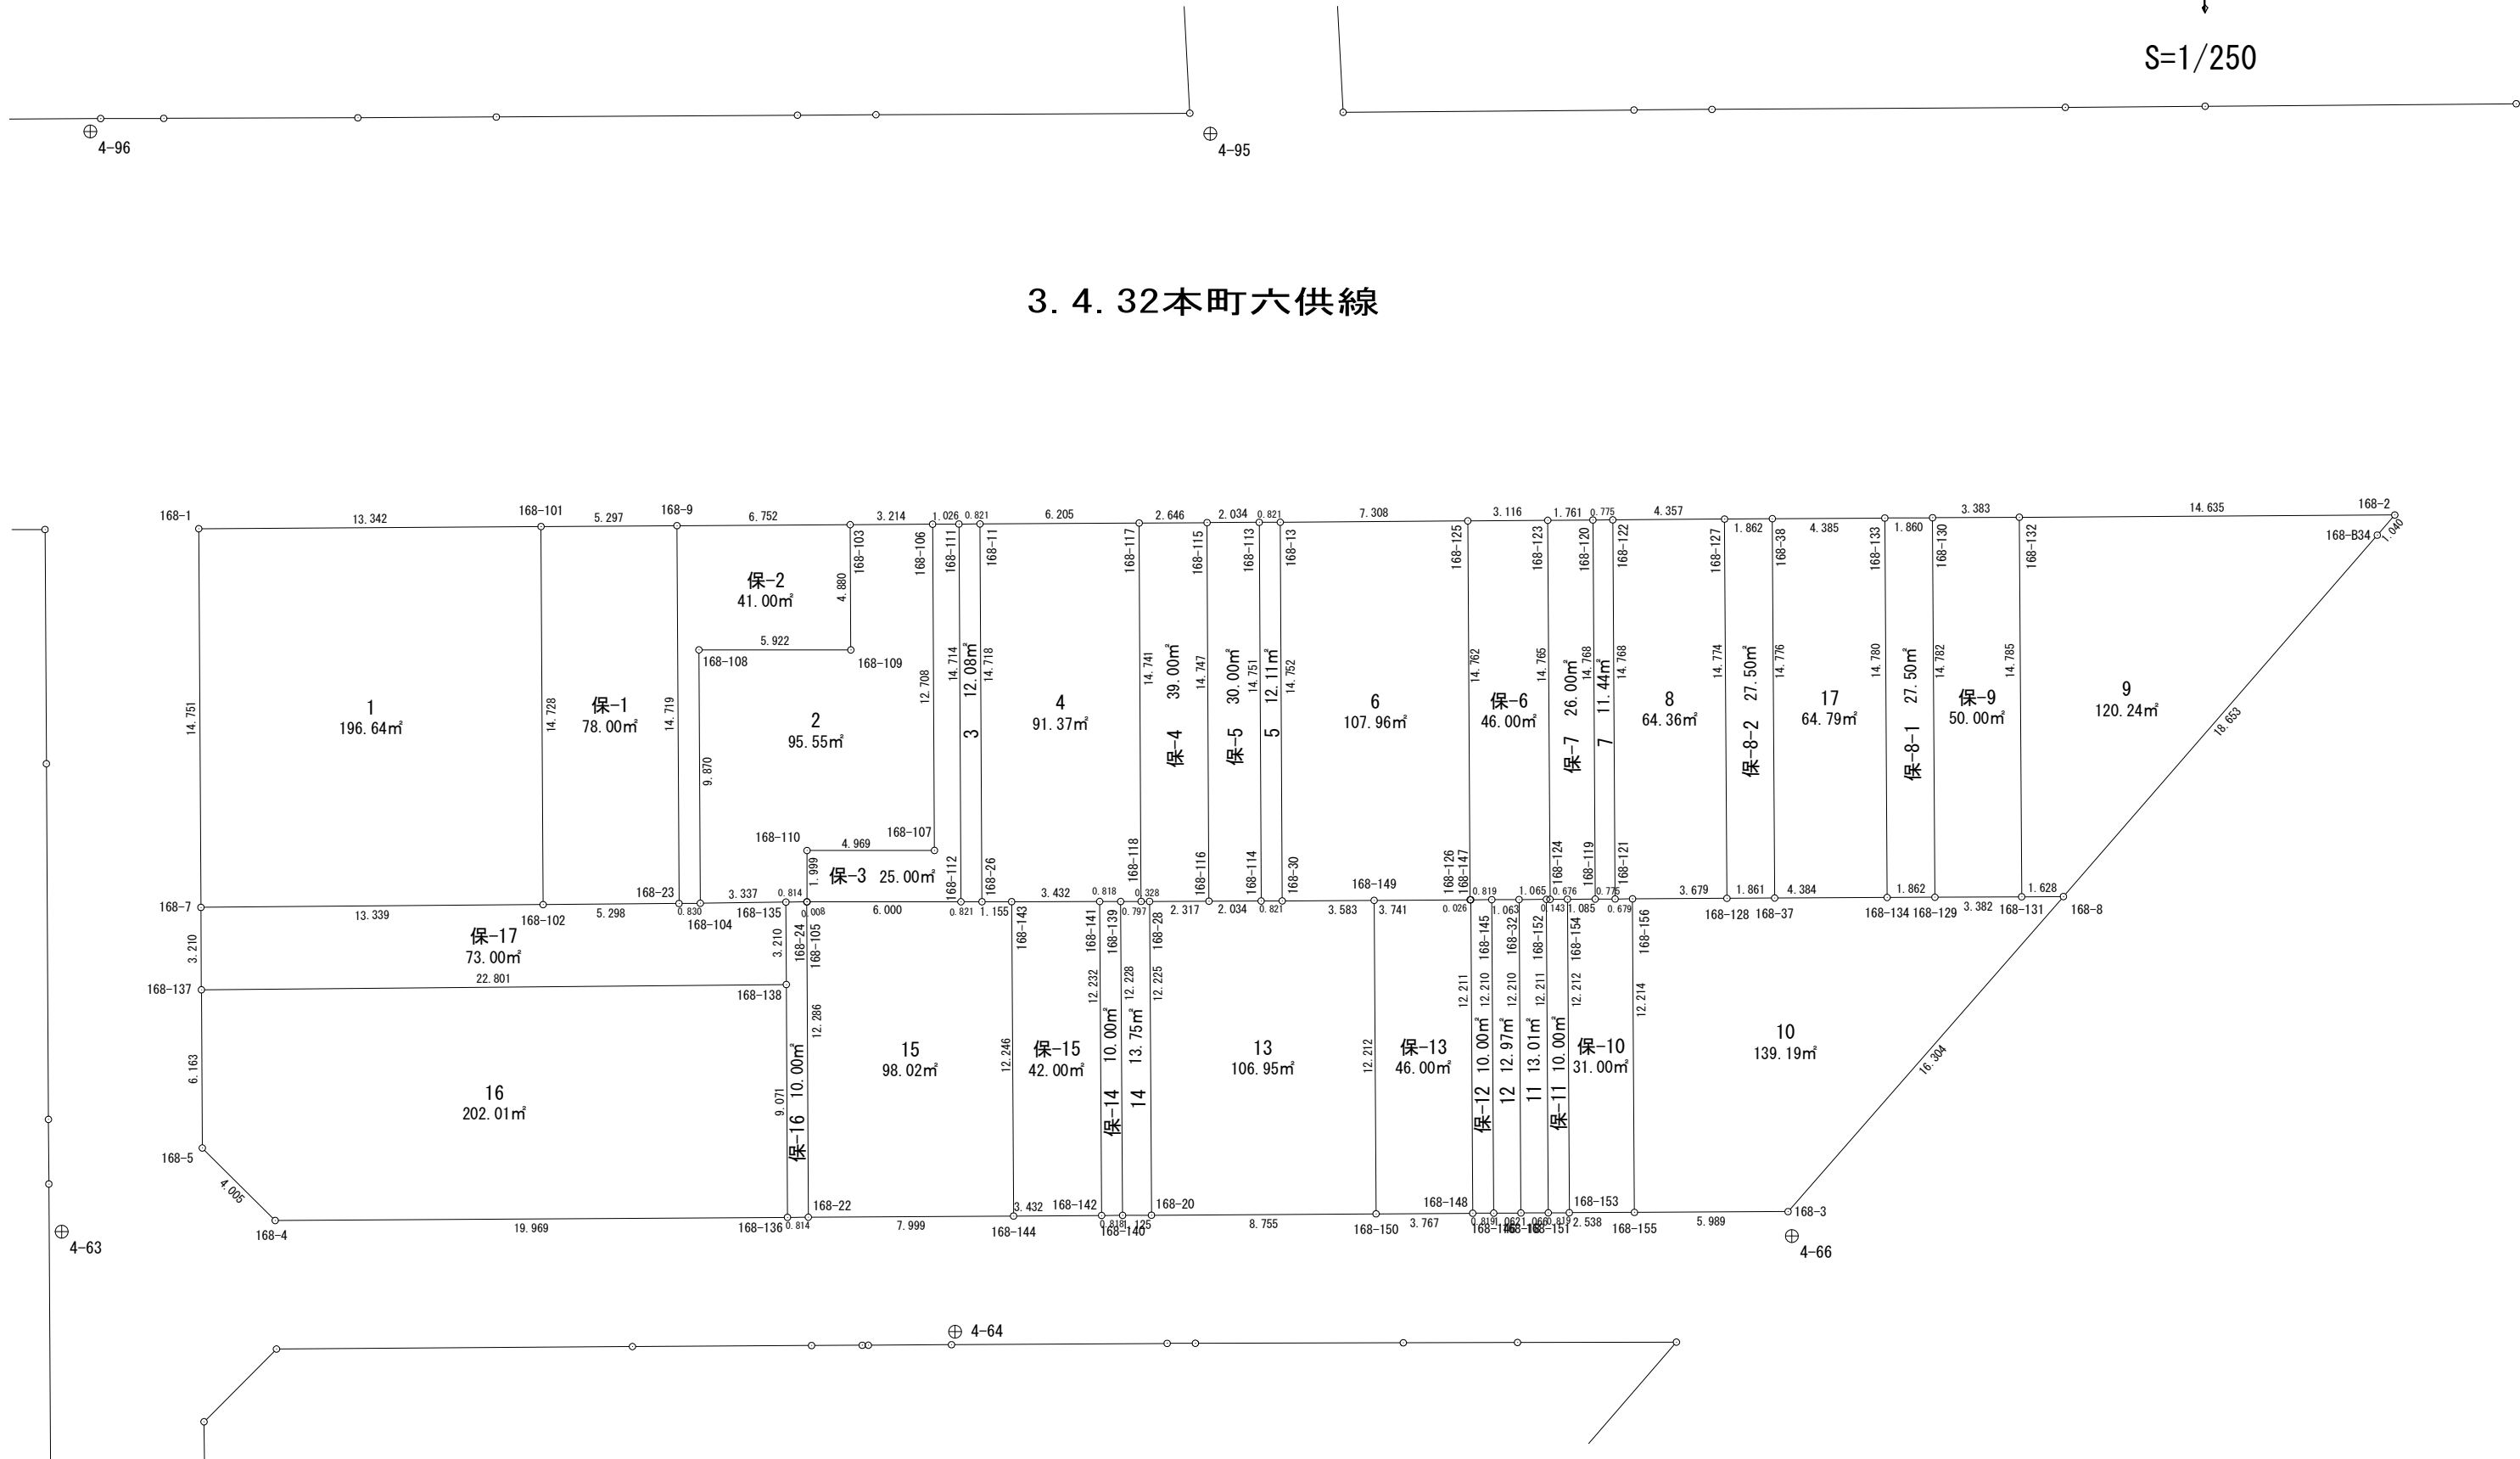


面積計算書（座標法）

世界測地系（測地成果2011）

所在	地番	公簿地目	現況地目	地積	所有者
前橋市六供町三丁目	168-4			91.37 m ²	

点名	X座標	Y座標	辺長	方向角	測角	DX	倍積 (Y×DX)
168-26	40630.391	-67889.925	1.155	89-54-03	90-12-30	-14.716	999068.136300
168-143	40630.393	-67888.770	3.432	89-52-59	179-58-56	0.009	-610.998930
168-141	40630.400	-67885.338	0.818	89-55-48	180-02-49	0.008	-543.082704
168-139	40630.401	-67884.520	0.797	89-51-22	179-55-34	0.003	-203.653560
168-118	40630.403	-67883.723	14.741	359-42-17	89-50-55	14.743	-1000809.728189
168-117	40645.144	-67883.799	6.205	269-40-37	89-58-20	14.706	-998299.148094
168-11	40645.109	-67890.004	14.718	179-41-33	90-00-56	-14.753	1001581.229012
						倍面積	182.753835
						面積	91.3769175

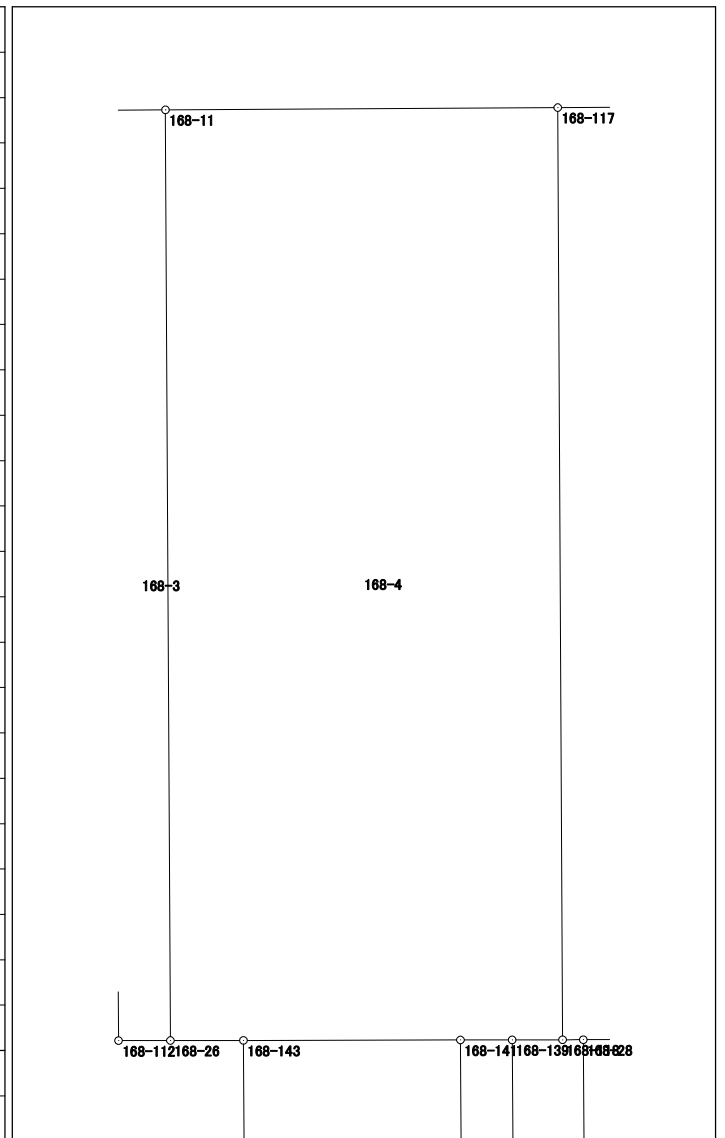


面積計算書 (座標法)

世界測地系 (測地成果2011)

所在	地番	公簿地目	現況地目	地積	所有者
前橋市六供町三丁目	168-5			12.11 m ²	

点名	X座標	Y座標	辺長	方向角	測角	DX	倍積 (Y×DX)	
168-113	40645.171	-67879.119	14.751	179-42-31	89-59-16	-14.755	1001556.400845	
168-114	40630.420	-67879.044	0.821	89-47-26	90-04-55	-14.748	1001080.140912	
168-30	40630.423	-67878.223	14.752	359-42-31	89-55-05	14.755	-1001543.180365	
168-13	40645.175	-67878.298	0.821	269-43-15	90-00-44	14.748	-1001069.138904	
							倍面積	24.222488
							面積	12.1112440

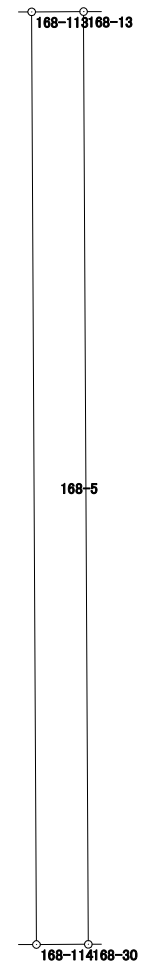


面積計算書（座標法）

世界測地系（測地成果2011）

所 在	地 番	公簿地目	現況地目	地 積	所 有 者
前橋市六供町三丁目	168-6			107.96 m ²	

点 名	X 座標	Y 座標	辺 長	方 向 角	測 角	DX	倍 積 (Y×DX)
168-125	40645.227	-67870.990	7.308	269-35-32	89-56-43	14.710	-998382.262900
168-13	40645.175	-67878.298	14.752	179-42-31	90-06-59	-14.804	1004870.323592
168-30	40630.423	-67878.223	3.583	89-39-51	89-57-20	-14.731	999914.103013
168-149	40630.444	-67874.640	3.741	89-40-42	180-00-51	0.042	-2850.734880
168-126	40630.465	-67870.899	14.762	359-38-49	89-58-07	14.783	-1003335.499917
						倍面積	215.928908
						面 積	107.9644540

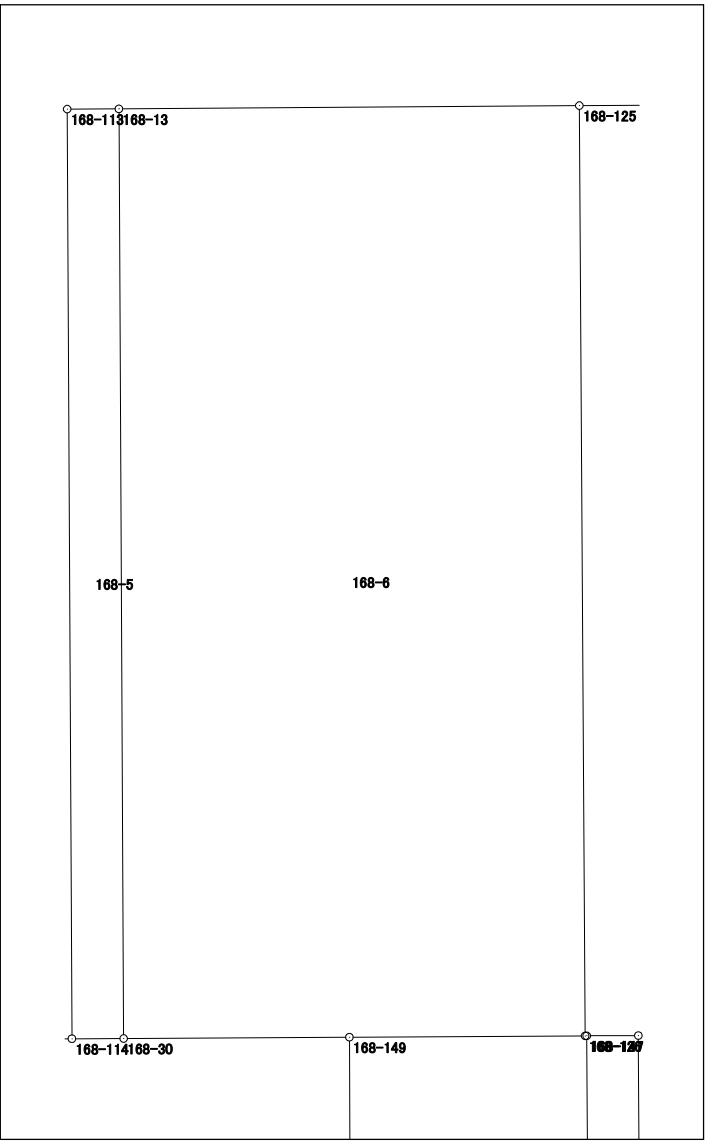


面積計算書（座標法）

世界測地系（測地成果2011）

所 在	地 番	公簿地目	現況地目	地 積	所 有 者
前橋市六供町三丁目	168-7			11.44 m ²	

点 名	X 座標	Y 座標	辺 長	方 向 角	測 角	DX	倍 積 (Y×DX)
168-121	40630.499	-67865.247	14.768	359-38-49	90-01-00	14.773	-1002573.293931
168-122	40645.267	-67865.338	0.775	269-37-49	89-59-00	14.763	-1001895.984894
168-120	40645.262	-67866.113	14.768	179-38-49	90-01-00	-14.773	1002586.087349
168-119	40630.494	-67866.022	0.775	89-37-49	89-59-00	-14.763	1001906.082786
						倍面積	22.891310
						面 積	11.4456550

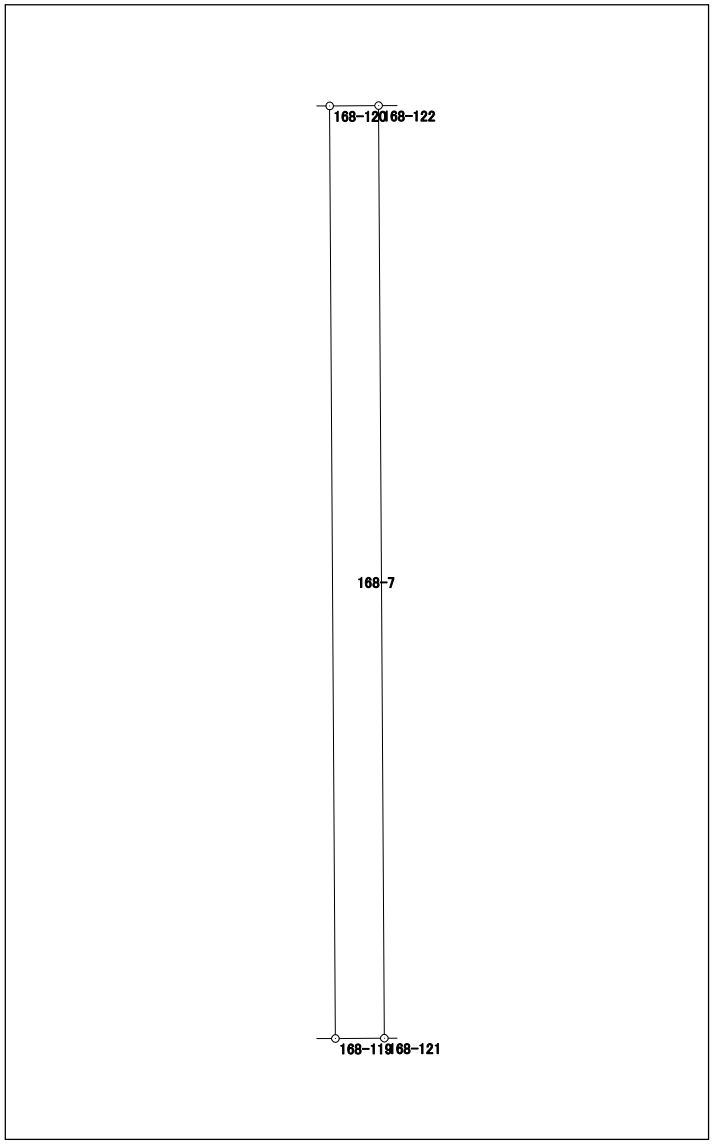


面積計算書（座標法）

世界測地系（測地成果2011）

所 在	地 番	公簿地目	現況地目	地 積	所 有 者
前橋市六供町三丁目	168-8			64.36 m ²	

点 名	X 座標	Y 座標	辺 長	方 向 角	測 角	DX	倍 積 (Y×DX)
168-127	40645.298	-67860.981	4.357	269-35-32	89-56-56	14.743	-1000474.442883
168-122	40645.267	-67865.338	14.768	179-38-49	90-03-17	-14.799	1004339.137062
168-121	40630.499	-67865.247	0.679	89-39-45	90-00-56	-14.764	1001962.506708
168-156	40630.503	-67864.568	3.679	89-40-23	180-00-38	0.025	-1696.614200
168-128	40630.524	-67860.889	14.774	359-38-36	89-58-13	14.795	-1004001.852755
						倍面積	128.733932
						面 積	64.3669660

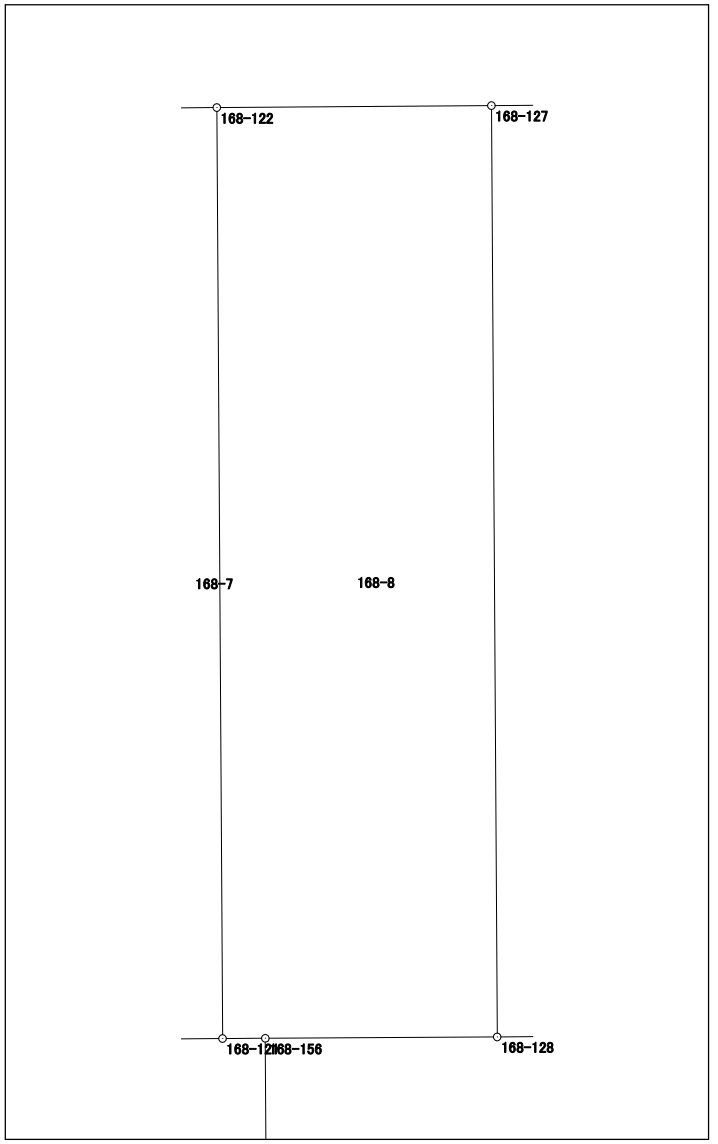

面積計算書（座標法）

世界測地系（測地成果2011）

所在	地番	公簿地目	現況地目	地積	所有者
前橋市六供町三丁目	168-9			120.24 m ²	


点名	X座標	Y座標	辺長	方向角	測角	DX	倍積 (Y×DX)	
168-132	40645.369	-67849.491	14.785	179-38-50	89-59-30	-14.873	1009125.479643	
168-131	40630.584	-67849.400	1.628	89-43-06	90-04-16	-14.777	1002610.583800	
168-8	40630.592	-67847.772	18.653	40-59-14	131-16-08	14.088	-955839.411936	
168-B34	40644.672	-67835.538	1.040	40-59-02	179-59-48	14.865	-1008375.272370	
168-2	40645.457	-67834.856	14.635	269-39-20	48-40-18	0.697	-47280.894632	
							倍面積	240.484505
							面積	120.2422525

面積計算書 (座標法)

世界測地系 (測地成果2011)

所在	地番	公簿地目	現況地目	地積	所有者
前橋市六供町三丁目	168-10			139.19 m ²	

点名	X座標	Y座標	辺長	方向角	測角	DX	倍積 (Y×DX)
168-156	40630.503	-67864.568	12.214	179-39-10	89-58-47	-12.235	830322.989480
168-155	40618.289	-67864.494	5.989	89-42-47	90-03-37	-12.184	826860.994896
168-3	40618.319	-67858.505	16.304	41-10-13	131-27-26	12.303	-834863.187015
168-8	40630.592	-67847.772	1.628	269-43-06	48-32-53	12.265	-832152.923580
168-131	40630.584	-67849.400	3.382	269-42-43	179-59-37	-0.025	1696.235000
168-129	40630.567	-67852.782	1.862	269-43-23	180-00-40	-0.026	1764.172332
168-134	40630.558	-67854.644	4.384	269-42-45	179-59-22	-0.031	2103.493964
168-37	40630.536	-67859.028	1.861	269-37-50	179-55-05	-0.034	2307.206952
168-128	40630.524	-67860.889	3.679	269-40-23	180-02-33	-0.033	2239.409337
倍面積							278.391366
面積							139.1956830

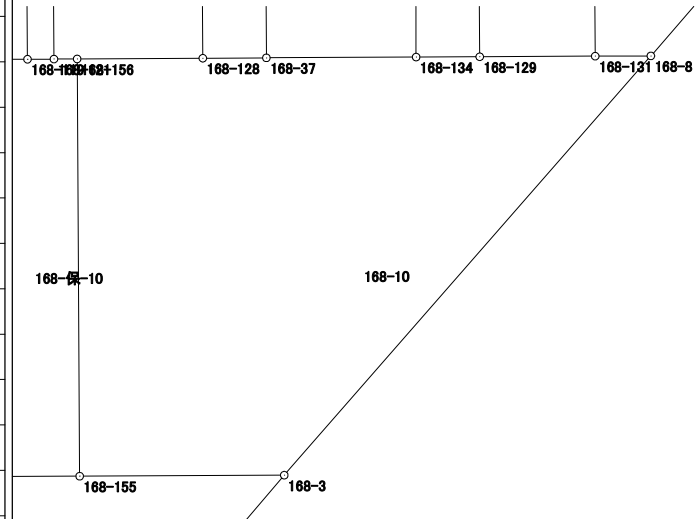


面積計算書（座標法）

世界測地系（測地成果2011）

所 在	地 番	公簿地目	現況地目	地 積	所 有 者
前橋市六供町三丁目	168-11			13.01 m ²	


点 名	X 座標	Y 座標	辺 長	方 向 角	測 角	DX	倍 積 (Y×DX)
168-151	40618.272	-67867.851	12.211	359-38-53	89-58-14	12.217	-829141.535667
168-152	40630.483	-67867.926	1.065	269-37-24	89-58-31	12.204	-828260.168904
168-32	40630.476	-67868.991	12.210	179-39-10	90-01-46	-12.217	829155.463047
168-18	40618.266	-67868.917	1.066	89-40-39	90-01-29	-12.204	828272.263068
						倍面積	26.021544
						面 積	13.0107720

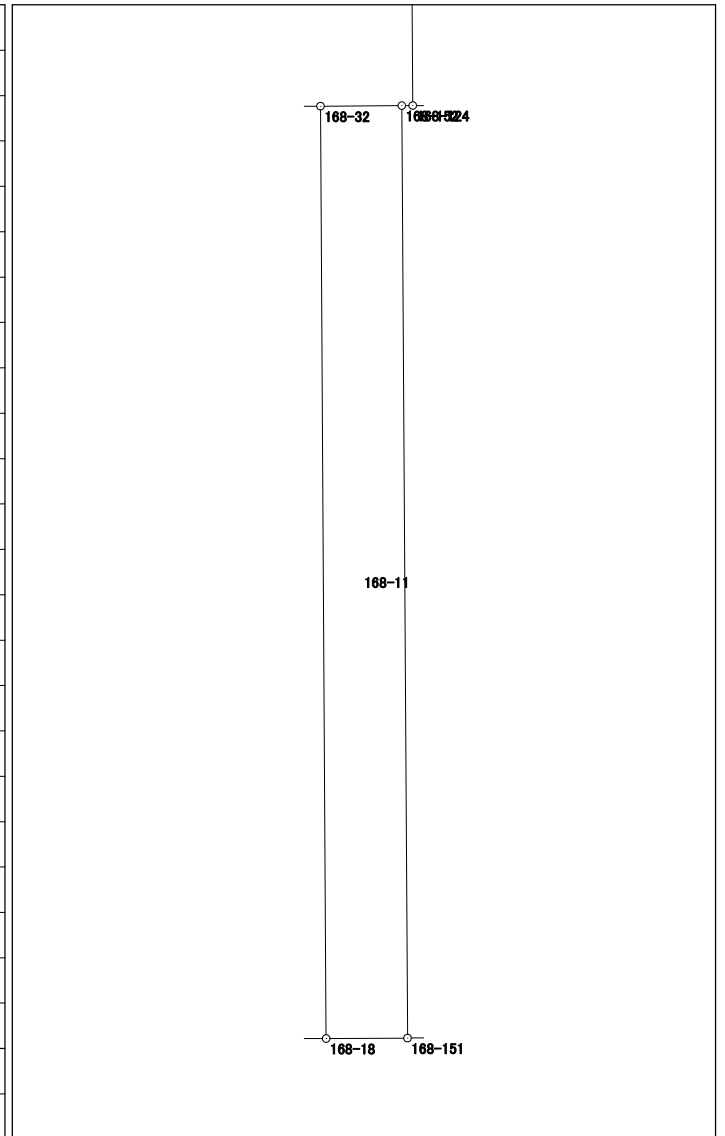

面積計算書 (座標法)

世界測地系 (測地成果2011)

所在	地番	公簿地目	現況地目	地積	所有者
前橋市六供町三丁目	168-12			12.97 m ²	

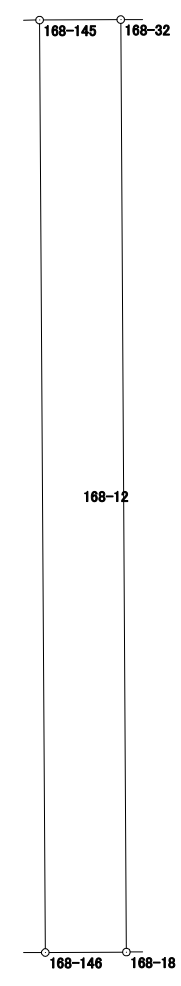
点名	X座標	Y座標	辺長	方向角	測角	DX	倍積 (Y×DX)	
168-145	40630.470	-67870.054	12.210	179-38-53	89-58-17	-12.216	829100.579664	
168-146	40618.260	-67869.979	1.062	89-40-35	90-01-42	-12.204	828285.223716	
168-18	40618.266	-67868.917	12.210	359-39-10	89-58-35	12.216	-829086.690072	
168-32	40630.476	-67868.991	1.063	269-40-36	90-01-26	12.204	-828273.166164	
倍面積							25.947144	
面積							12.9735720	

面積計算書（座標法）

世界測地系（測地成果2011）

所 在	地 番	公簿地目	現況地目	地 積	所 有 者
前橋市六供町三丁目	168-13			106.95 m ²	

点 名	X 座標	Y 座標	辺 長	方 向 角	測 角	DX	倍 積 (Y×DX)
168-150	40618.232	-67874.565	12.212	359-38-53	89-59-42	12.265	-832481.539725
168-149	40630.444	-67874.640	3.583	269-39-51	90-00-58	12.191	-827459.736240
168-30	40630.423	-67878.223	0.821	269-47-26	180-07-35	-0.024	1629.077352
168-114	40630.420	-67879.044	2.034	269-46-29	179-59-03	-0.011	746.669484
168-116	40630.412	-67881.078	2.317	269-48-08	180-01-39	-0.016	1086.097248
168-28	40630.404	-67883.395	12.225	179-38-55	89-50-47	-12.233	830417.571035
168-20	40618.179	-67883.320	8.755	89-39-11	90-00-16	-12.172	826275.771040
						倍面積	213.910194
						面 積	106.9550970

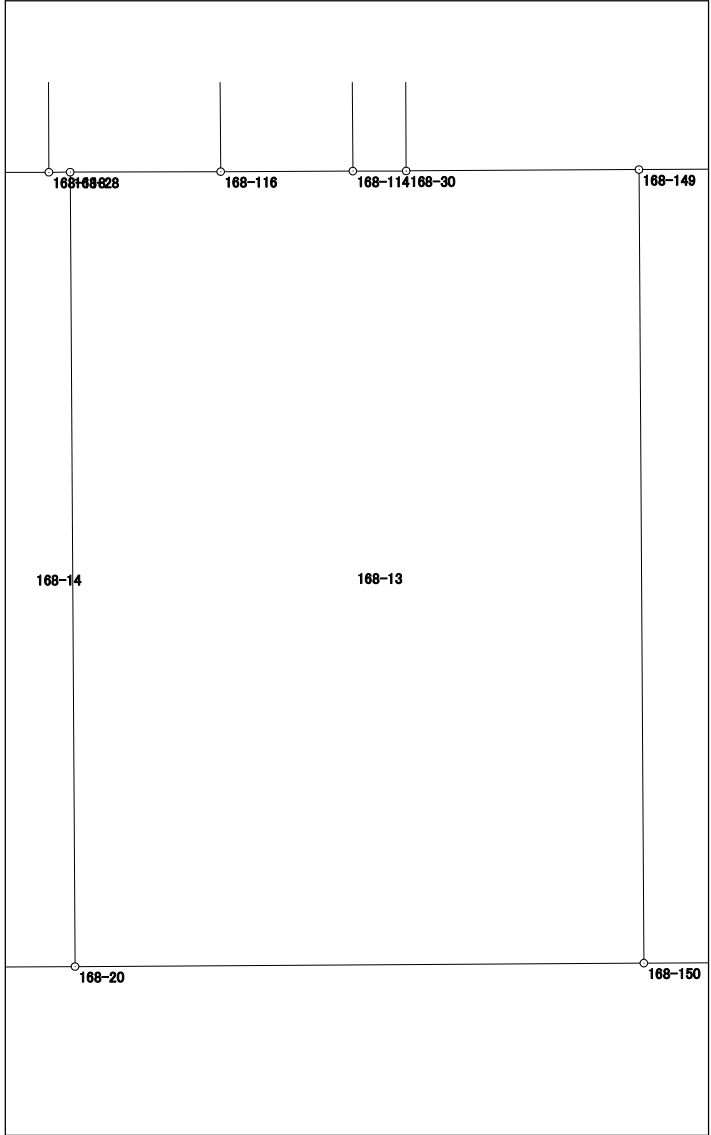


面積計算書 (座標法)

世界測地系 (測地成果2011)

所在	地番	公簿地目	現況地目	地積	所有者
前橋市六供町三丁目	168-14			13.75 m ²	

点名	X座標	Y座標	辺長	方向角	測角	DX	倍積 (Y×DX)
168-139	40630.401	-67884.520	12.228	179-38-55	89-47-33	-12.230	830227.679600
168-140	40618.173	-67884.445	1.125	89-41-40	90-02-45	-12.222	829683.686790
168-20	40618.179	-67883.320	12.225	359-38-55	89-57-15	12.231	-830280.886920
168-28	40630.404	-67883.395	0.328	269-49-31	90-10-36	12.224	-829806.620480
168-118	40630.403	-67883.723	0.797	269-51-22	180-01-51	-0.003	203.651169
						倍面積	27.510159
						面積	13.7550795

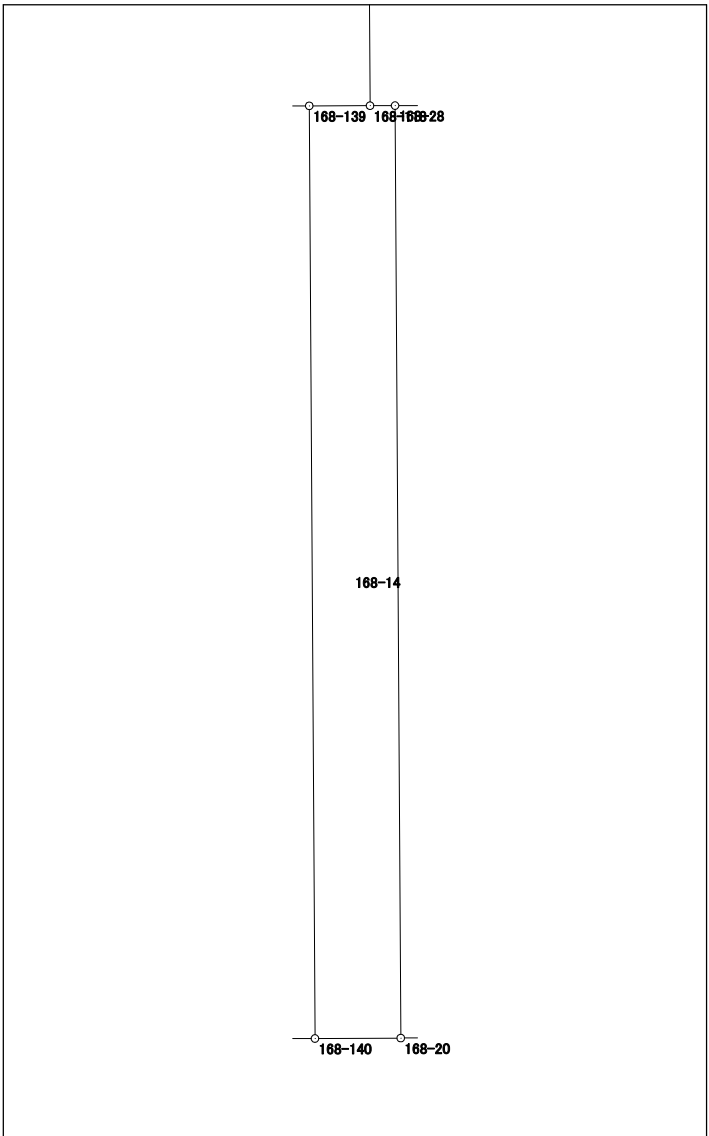


面積計算書 (座標法)

世界測地系 (測地成果2011)

所在	地番	公簿地目	現況地目	地積	所有者
前橋市六供町三丁目	168-15			98.02 m ²	

点名	X座標	Y座標	辺長	方向角	測角	DX	倍積 (Y×DX)
168-144	40618.147	-67888.695	12.246	359-38-57	89-59-09	12.293	-834555.727635
168-143	40630.393	-67888.770	1.155	269-54-03	90-15-06	12.244	-831230.099880
168-26	40630.391	-67889.925	0.821	269-55-49	180-01-46	-0.003	203.669775
168-112	40630.390	-67890.746	6.000	269-58-17	180-02-28	-0.004	271.562984
168-105	40630.387	-67896.746	0.008	262-52-30	172-54-13	-0.004	271.586984
168-24	40630.386	-67896.754	12.286	179-43-13	96-50-43	-12.287	834247.416398
168-22	40618.100	-67896.694	7.999	89-39-48	89-56-35	-12.239	830987.637866

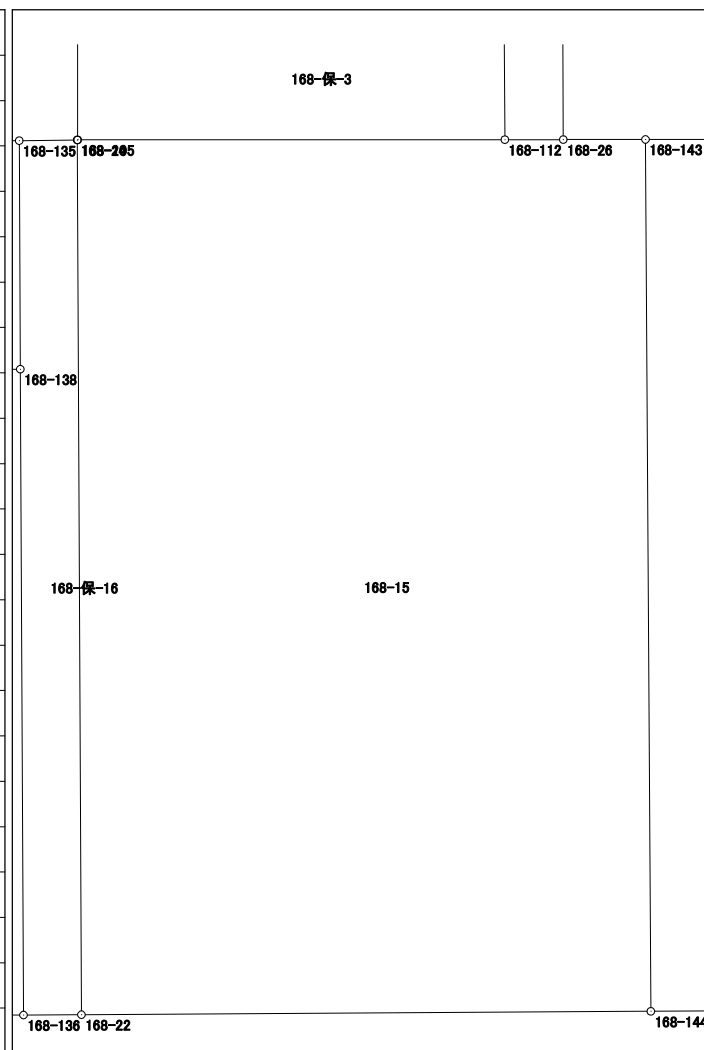


倍面積	196.046492
面積	98.0232460

面積計算書（座標法）

世界測地系（測地成果2011）

所 在	地 番	公簿地目	現況地目	地 積	所 有 者
前橋市六供町三丁目	168-16			202.01 m ²	

点 名	X 座標	Y 座標	辺 長	方 向 角	測 角	DX	倍 積 (Y×DX)
168-138	40627.166	-67897.553	22.801	269-29-05	89-46-08	8.866	-601979.704898
168-137	40626.961	-67920.353	6.163	179-39-55	90-10-50	-6.368	432516.807904
168-5	40620.798	-67920.317	4.005	134-50-17	135-10-22	-8.987	610399.888879
168-4	40617.974	-67917.477	19.969	89-39-10	134-48-53	-2.703	183580.940331
168-136	40618.095	-67897.508	9.071	359-42-57	90-03-47	9.192	-624113.893536
						倍面積	404.038680
						面 積	202.0193400

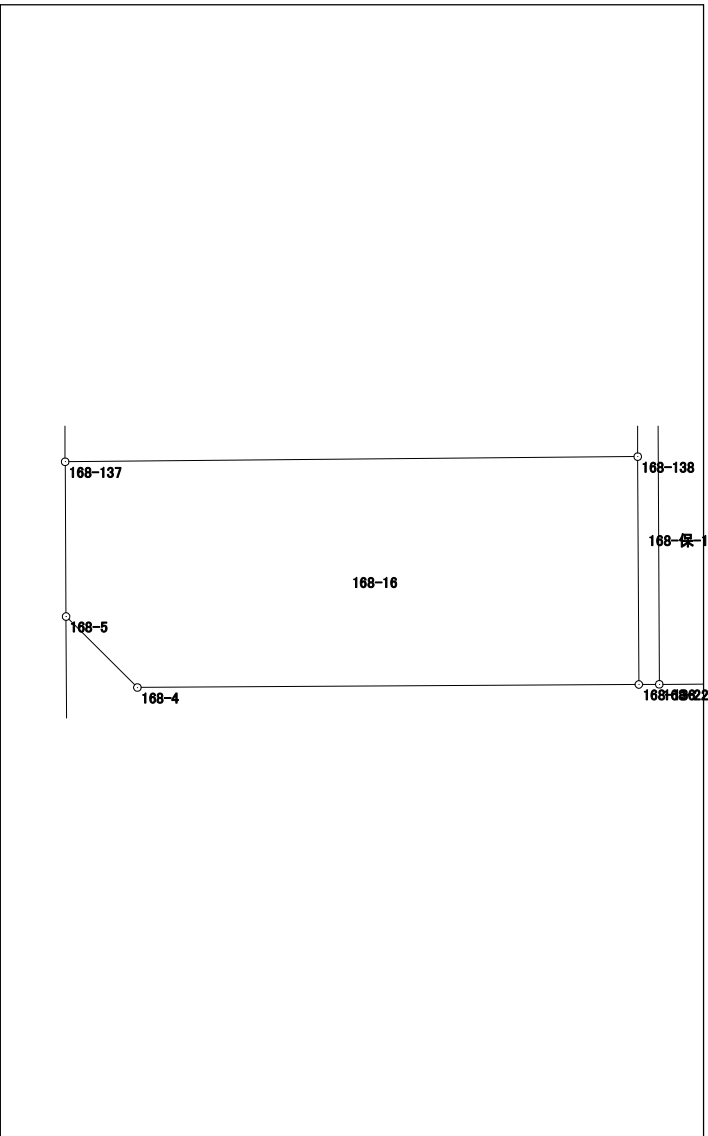


面積計算書（座標法）

世界測地系（測地成果2011）

所在	地番	公簿地目	現況地目	地積	所有者
前橋市六供町三丁目	168-17			64.79 m ²	

点名	X座標	Y座標	辺長	方向角	測角	DX	倍積 (Y×DX)
168-134	40630.558	-67854.644	14.780	359-39-04	89-56-19	14.802	-1004384.440488
168-133	40645.338	-67854.734	4.385	269-39-37	90-00-33	14.754	-1001128.745436
168-38	40645.312	-67859.119	14.776	179-38-50	89-59-13	-14.802	1004450.679438
168-37	40630.536	-67859.028	4.384	89-42-45	90-03-55	-14.754	1001192.099112
倍面積						129.592626	
面積						64.7963130	

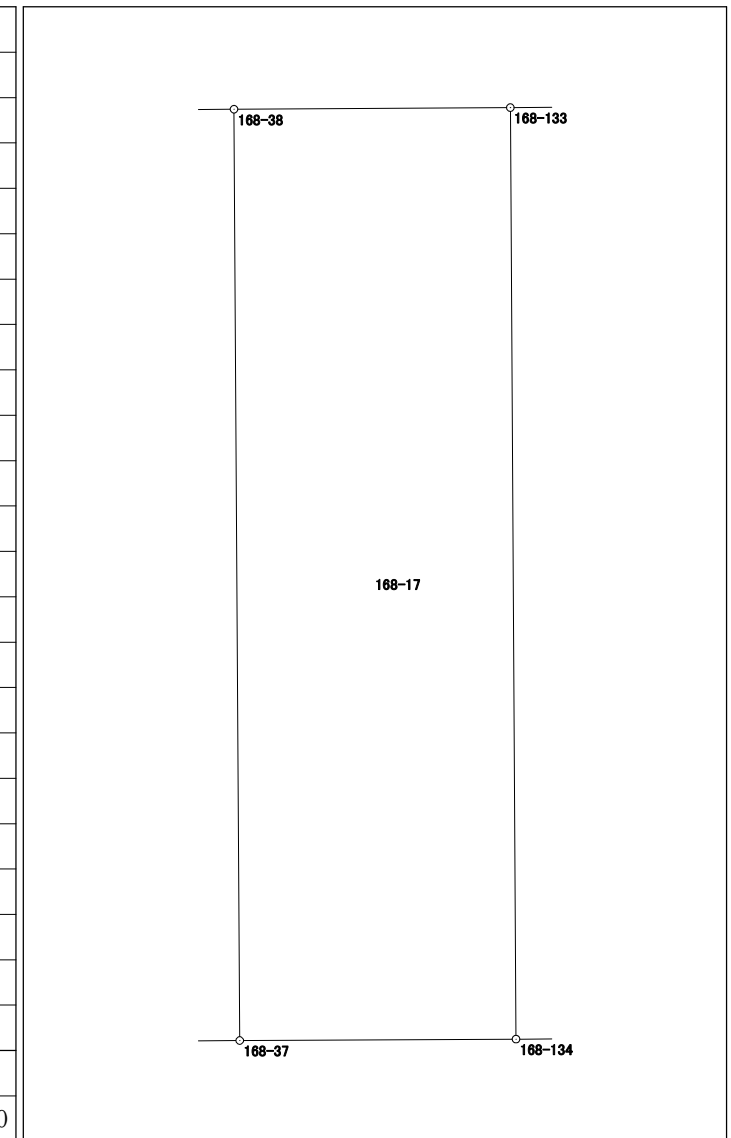


面積計算書（座標法）

世界測地系（測地成果2011）

所在	地番	公簿地目	現況地目	地積	所有者
前橋市六供町三丁目	168-保-1			78.00 m ²	

点名	X座標	Y座標	辺長	方向角	測角	D _X	倍積 (Y×D _X)
168-101	40645.007	-67907.114	14.728	179-41-06	90-03-10	-14.762	1002444.816868
168-102	40630.279	-67907.033	5.298	89-32-06	89-51-00	-14.685	997214.779605
168-23	40630.322	-67901.735	14.719	359-40-51	90-08-45	14.762	-1002365.412070
168-9	40645.041	-67901.817	5.297	269-37-56	89-57-05	14.685	-997138.182645
倍面積							156.001758
面積							78.0008790

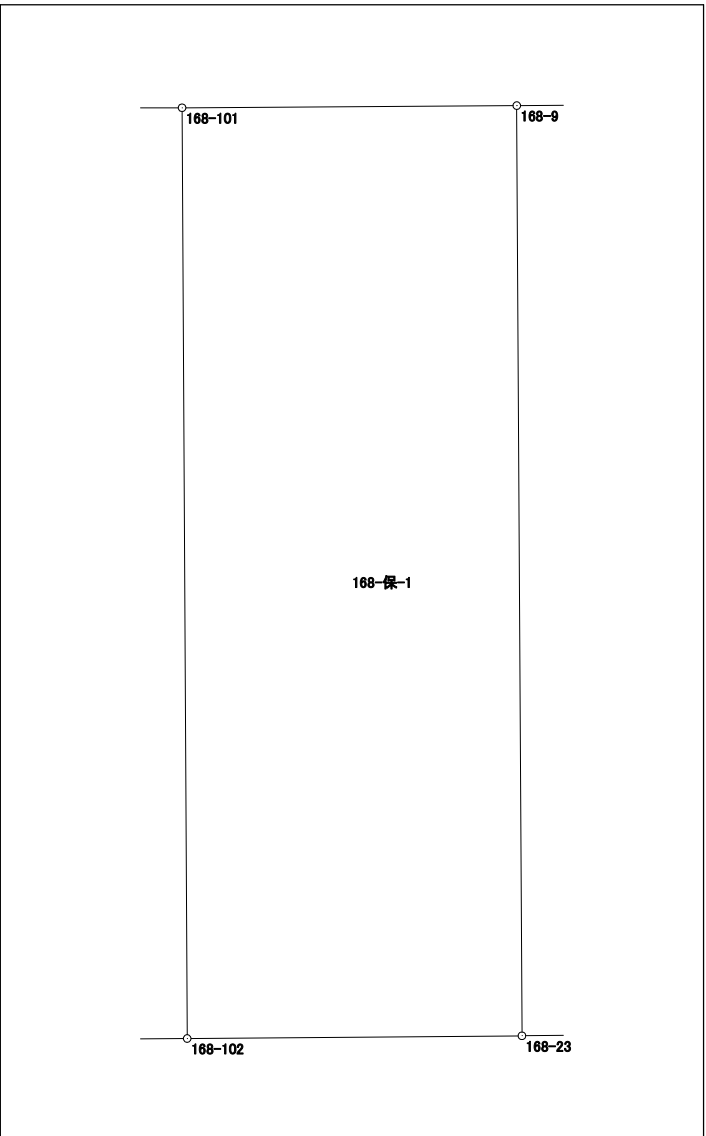


面積計算書（座標法）

世界測地系（測地成果2011）

所 在	地 番	公簿地目	現況地目	地 積	所 有 者
前橋市六供町三丁目	168-保-2			41.00 m ²	

点 名	X 座標	Y 座標	辺 長	方 向 角	測 角	DX	倍 積 (Y×DX)
168-9	40645.041	-67901.817	14.719	179-40-51	90-00-42	-14.758	1002095.015286
168-23	40630.322	-67901.735	0.830	89-18-35	89-37-44	-14.709	998766.620115
168-104	40630.332	-67900.905	9.870	359-40-51	90-22-16	9.880	-670860.941400
168-108	40640.202	-67900.960	5.922	90-01-10	270-20-19	9.868	-670046.673280
168-109	40640.200	-67895.038	4.880	359-40-59	89-39-49	4.878	-331191.995364
168-103	40645.080	-67895.065	6.752	269-40-09	89-59-10	4.841	-328680.009665
倍面積							82.015692
面 積							41.0078460

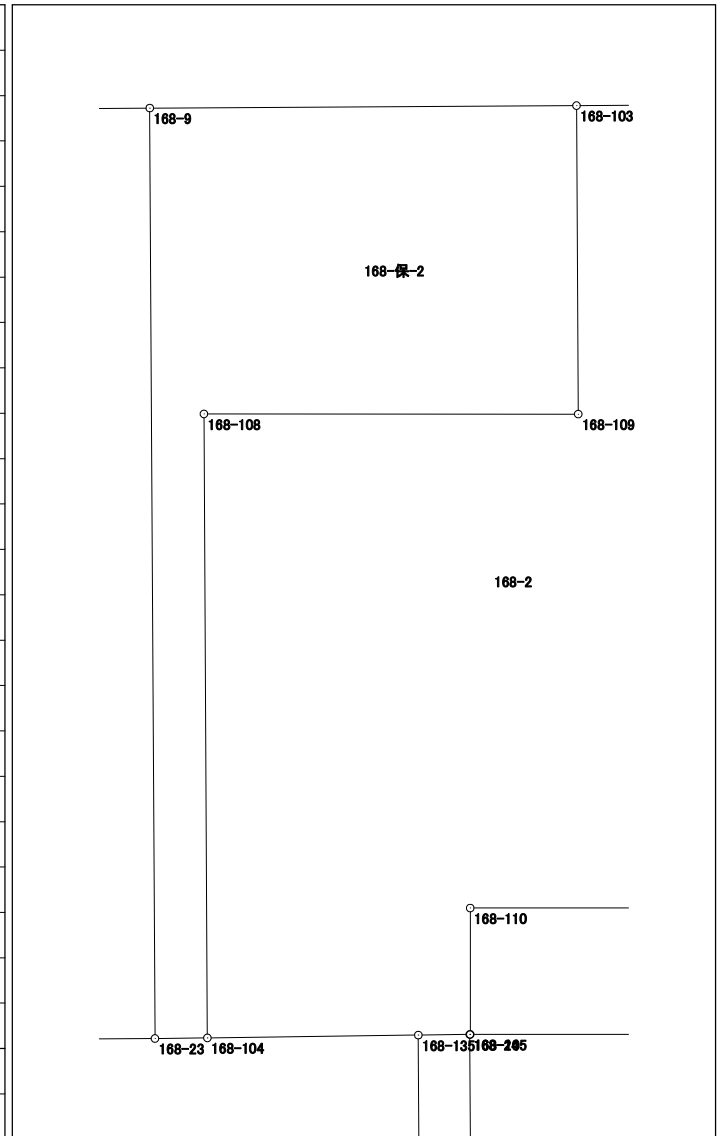


面積計算書 (座標法)

世界測地系 (測地成果2011)

所在	地番	公簿地目	現況地目	地積	所有者
前橋市六供町三丁目	168-保-3			25.00 m ²	

点名	X座標	Y座標	辺長	方向角	測角	DX	倍積 (Y×DX)
168-112	40630.390	-67890.746	14.714	359-41-33	89-43-16	14.717	-999148.108882
168-111	40645.104	-67890.825	1.026	269-39-54	89-58-21	14.708	-998538.254100
168-106	40645.098	-67891.851	12.708	179-40-15	90-00-21	-12.714	863176.993614
168-107	40632.390	-67891.778	4.969	269-57-14	270-16-59	-12.712	863040.281936
168-110	40632.386	-67896.747	1.999	179-58-17	90-01-03	-2.003	135997.184241
168-105	40630.387	-67896.746	6.000	89-58-17	90-00-00	-1.996	135521.905016
						倍面積	50.001825
						面積	25.0009125

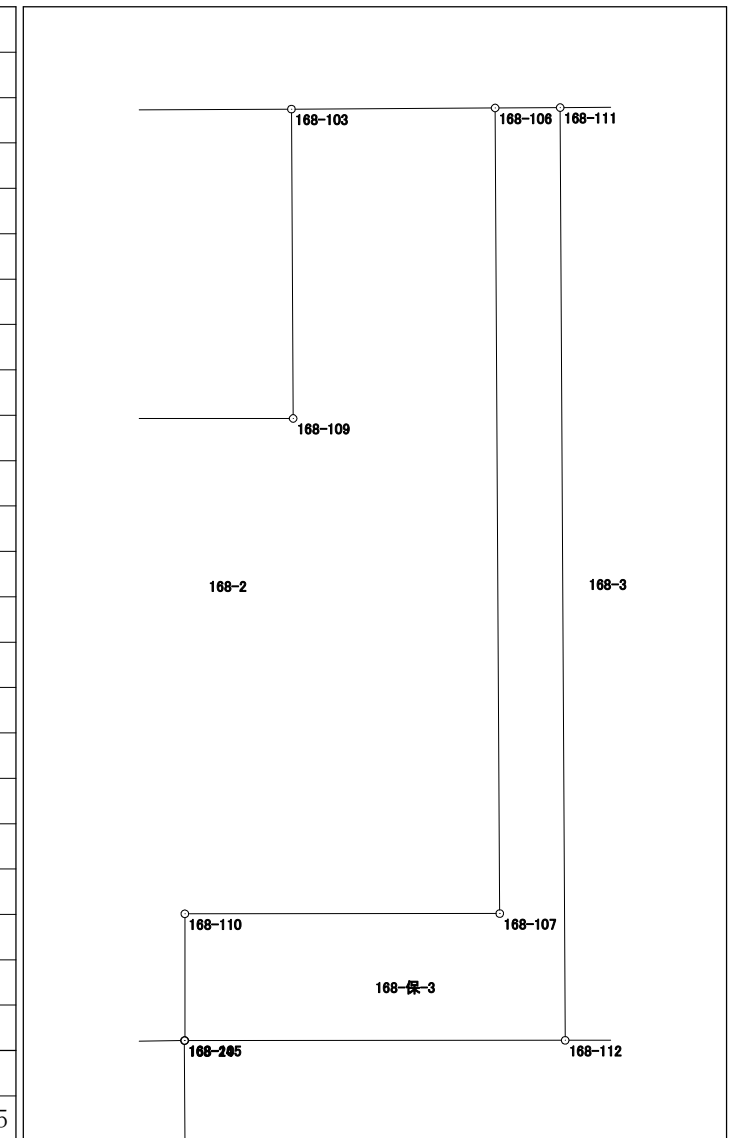


面積計算書 (座標法)

世界測地系 (測地成果2011)

所 在	地 番	公簿地目	現況地目	地 積	所 有 者
前橋市六供町三丁目	168-保-4			39.00 m ²	

点 名	X 座標	Y 座標	辺 長	方 向 角	測 角	DX	倍 積 (Y×DX)
168-117	40645.144	-67883.799	14.741	179-42-17	90-01-46	-14.756	1001693.338044
168-118	40630.403	-67883.723	0.328	89-49-31	90-07-14	-14.740	1000606.077020
168-28	40630.404	-67883.395	2.317	89-48-08	179-58-37	0.009	-610.950555
168-116	40630.412	-67881.078	14.747	359-42-31	89-54-23	14.755	-1001585.305890
168-115	40645.159	-67881.153	2.646	269-40-31	89-58-00	14.732	-1000025.145996

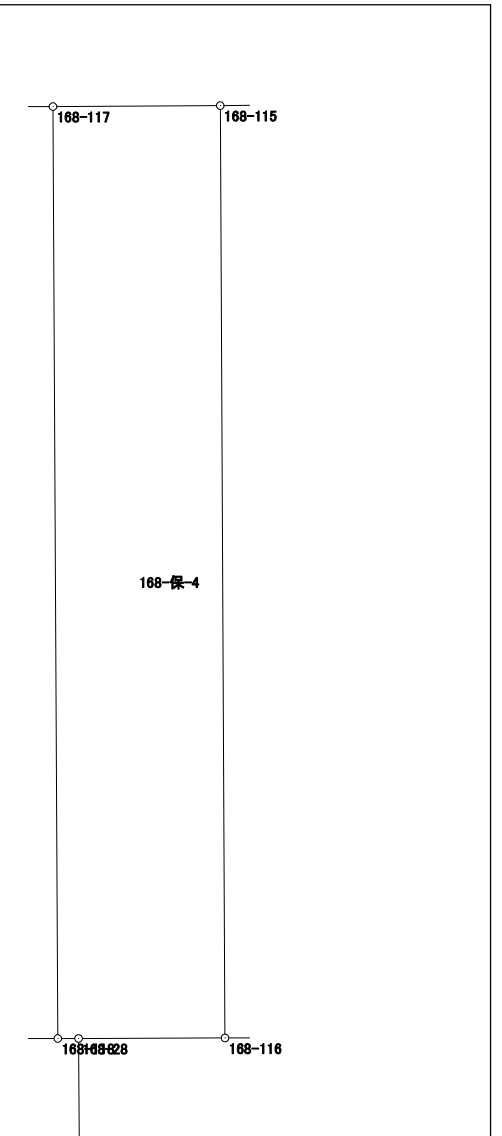


倍面積	78.012623
面積	39.0063115

面積計算書 (座標法)

世界測地系 (測地成果2011)

所 在	地 番	公簿地目	現況地目	地 積	所 有 者
前橋市六供町三丁目	168-保-5			30.00 m ²	

点 名	X 座標	Y 座標	辺 長	方 向 角	測 角	DX	倍 積 (Y×DX)
168-115	40645.159	-67881.153	14.747	179-42-31	90-02-48	-14.759	1001857.937127
168-116	40630.412	-67881.078	2.034	89-46-29	90-03-58	-14.739	1000499.208642
168-114	40630.420	-67879.044	14.751	359-42-31	89-56-02	14.759	-1001826.810396
168-113	40645.171	-67879.119	2.034	269-39-43	89-57-12	14.739	-1000470.334941
倍面積						60.000432	
面 積						30.0002160	

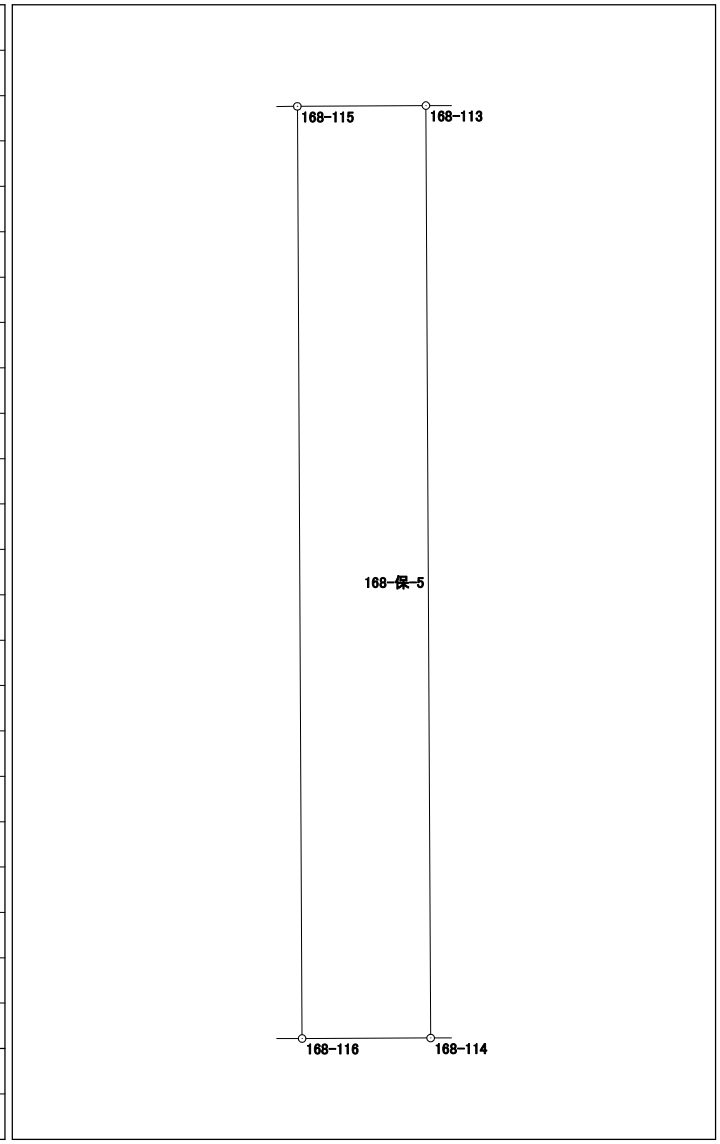


面積計算書 (座標法)

世界測地系 (測地成果2011)

所在	地番	公簿地目	現況地目	地積	所有者
前橋市六供町三丁目	168-保-6			46.00 m ²	

点名	X座標	Y座標	辺長	方向角	測角	DX	倍積 (Y×DX)	
168-145	40630.470	-67870.054	1.063	89-40-36	179-57-23	0.010	-678.700540	
168-32	40630.476	-67868.991	1.065	89-37-24	179-56-48	0.013	-882.296883	
168-152	40630.483	-67867.926	0.143	89-35-58	179-58-34	0.008	-542.943408	
168-124	40630.484	-67867.783	14.765	359-38-49	90-02-51	14.766	-1002135.683778	
168-123	40645.249	-67867.874	3.116	269-35-44	89-56-55	14.743	-1000576.066382	
168-125	40645.227	-67870.990	14.762	179-38-49	90-03-05	-14.784	1003404.716160	
168-126	40630.465	-67870.899	0.026	87-47-51	88-09-02	-14.761	1001842.340139	
168-147	40630.466	-67870.873	0.819	89-43-13	181-55-22	0.005	-339.354365	
							倍面積	92.010943
							面積	46.0054715

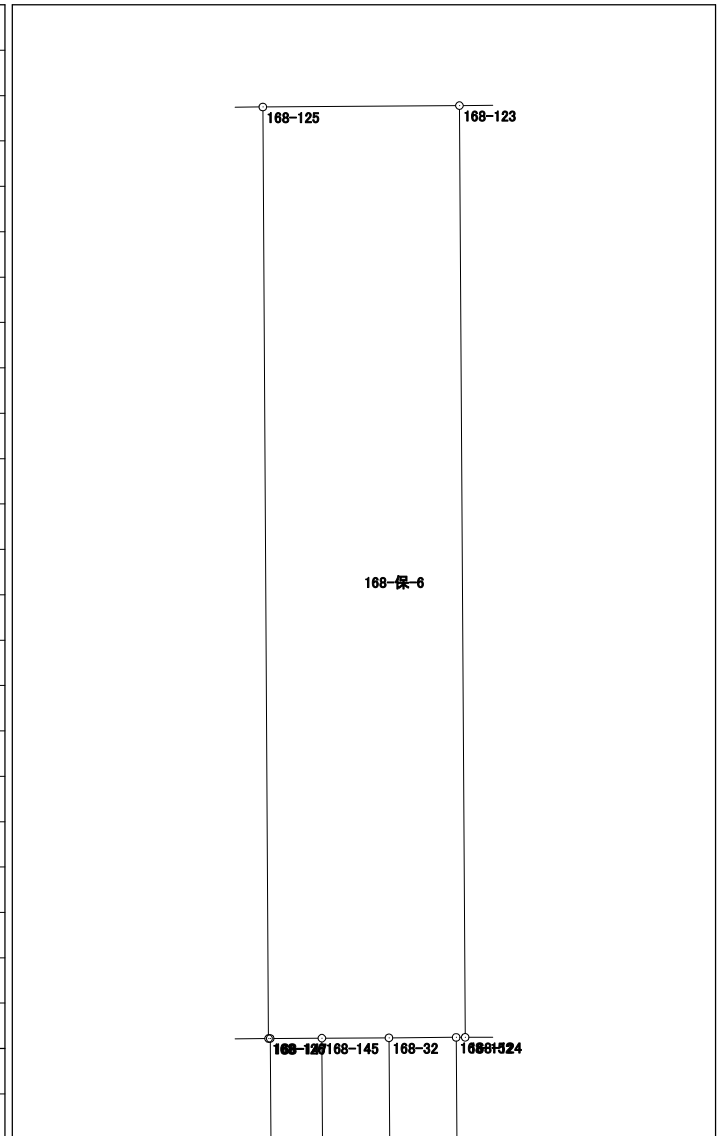


面積計算書 (座標法)

世界測地系 (測地成果2011)

所在	地番	公簿地目	現況地目	地積	所有者
前橋市六供町三丁目	168-保-7			26.00 m ²	

点名	X座標	Y座標	辺長	方向角	測角	DX	倍積 (Y×DX)
168-124	40630.484	-67867.783	0.676	89-39-40	90-00-51	-14.761	1001796.344863
168-154	40630.488	-67867.107	1.085	89-40-59	180-01-19	0.010	-678.671070
168-119	40630.494	-67866.022	14.768	359-38-49	89-57-50	14.774	-1002652.609028
168-120	40645.262	-67866.113	1.761	269-34-37	89-55-48	14.755	-1001364.497315
168-123	40645.249	-67867.874	14.765	179-38-49	90-04-12	-14.778	1002951.441972

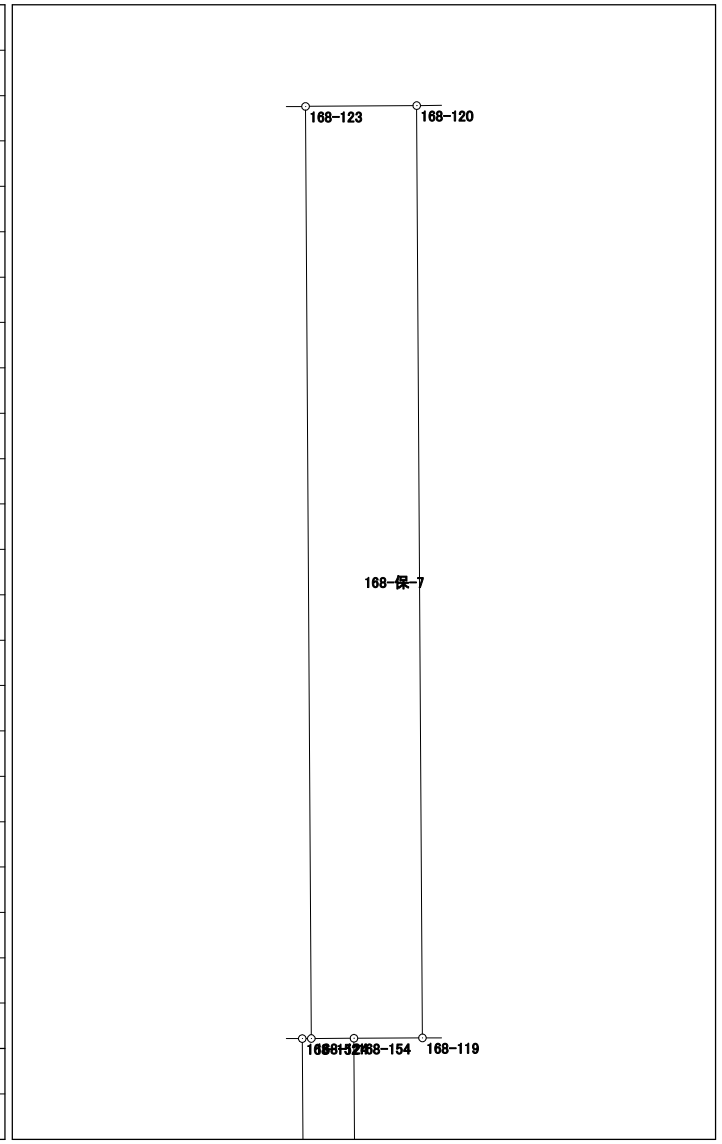


倍面積	52.009422
面積	26.0047110

面積計算書 (座標法)

世界測地系 (測地成果2011)

所 在	地 番	公簿地目	現況地目	地 積	所 有 者
前橋市六供町三丁目	168-保-8-1			27.50 m ²	

点 名	X 座標	Y 座標	辺 長	方 向 角	測 角	DX	倍 積 (Y×DX)
168-133	40645.338	-67854.734	14.780	179-39-04	89-59-24	-14.791	1003639.370594
168-134	40630.558	-67854.644	1.862	89-43-23	90-04-19	-14.771	1002280.946524
168-129	40630.567	-67852.782	14.782	359-38-36	89-55-13	14.791	-1003610.498562
168-130	40645.349	-67852.874	1.860	269-39-40	90-01-04	14.771	-1002254.801854

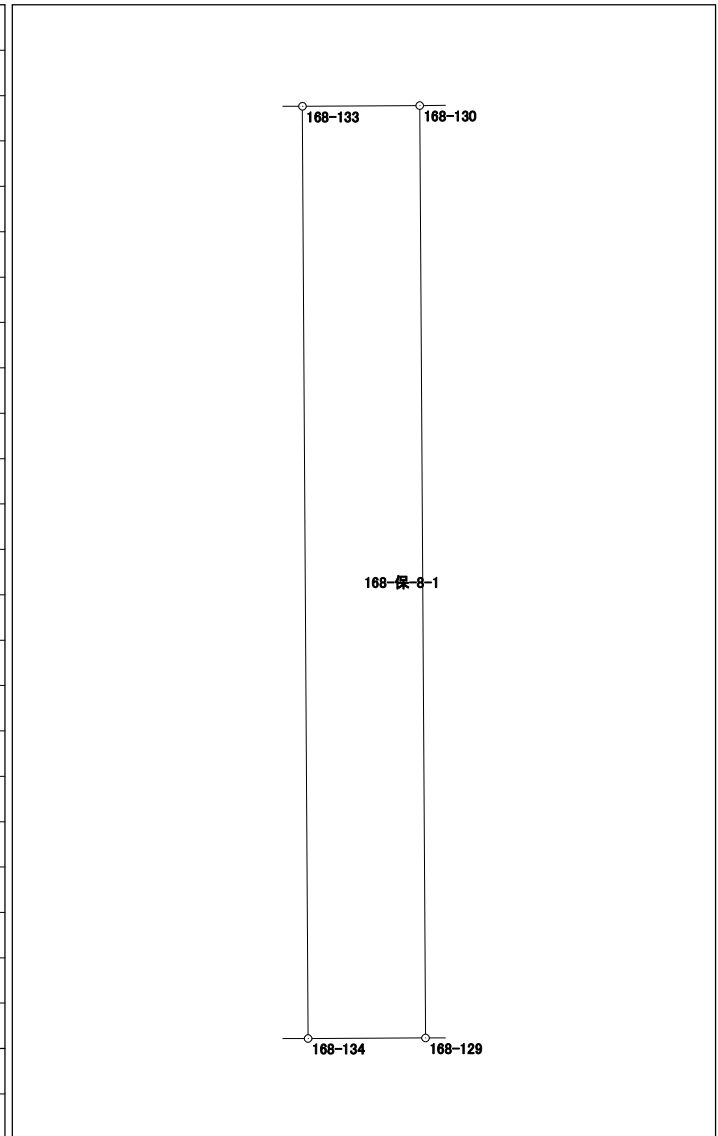


面積計算書 (座標法)

世界測地系 (測地成果2011)

所在	地番	公簿地目	現況地目	地積	所有者
前橋市六供町三丁目	168-保-8-2			27.50 m ²	

点名	X座標	Y座標	辺長	方向角	測角	DX	倍積 (Y×DX)
168-127	40645.298	-67860.981	14.774	179-38-36	90-04-27	-14.788	1003528.187028
168-128	40630.524	-67860.889	1.861	89-37-50	89-59-14	-14.762	1001762.443418
168-37	40630.536	-67859.028	14.776	359-38-50	90-01-00	14.788	-1003499.306064
168-38	40645.312	-67859.119	1.862	269-34-09	89-55-19	14.762	-1001736.314678

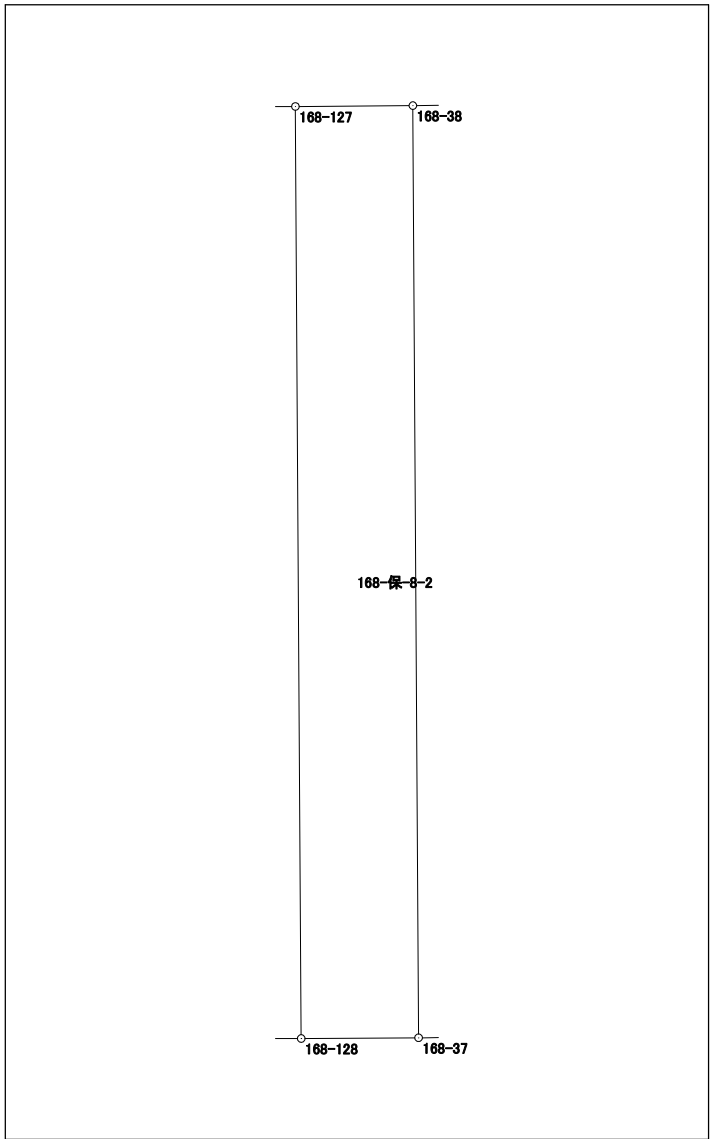


倍面積	55.009704
面積	27.5048520

面積計算書 (座標法)

世界測地系 (測地成果2011)

所 在	地 番	公簿地目	現況地目	地 積	所 有 者
前橋市六供町三丁目	168-保-9			50.00 m ²	

点 名	X 座標	Y 座標	辺 長	方 向 角	測 角	DX	倍 積 (Y×DX)
168-131	40630.584	-67849.400	14.785	359-38-50	89-56-07	14.802	-1004306.818800
168-132	40645.369	-67849.491	3.383	269-39-41	90-00-51	14.765	-1001797.734615
168-130	40645.349	-67852.874	14.782	179-38-36	89-58-55	-14.802	1004358.240948
168-129	40630.567	-67852.782	3.382	89-42-43	90-04-07	-14.765	1001846.326230
						倍面積	100.013763
						面 積	50.0068815

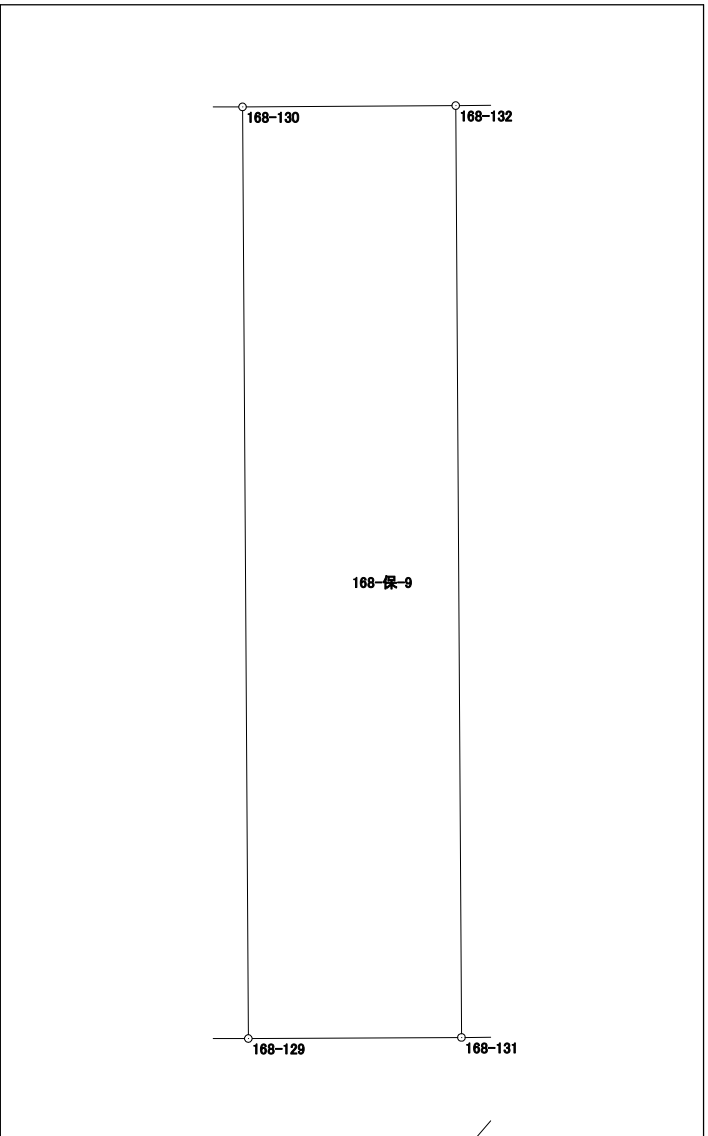


面積計算書 (座標法)

世界測地系 (測地成果2011)

所在	地番	公簿地目	現況地目	地積	所有者
前橋市六供町三丁目	168-保-10			31.00 m ²	

点名	X座標	Y座標	辺長	方向角	測角	DX	倍積 (Y×DX)
168-155	40618.289	-67864.494	12.214	359-39-10	89-56-47	12.227	-829779.168138
168-156	40630.503	-67864.568	0.679	269-39-45	90-00-35	12.210	-828626.375280
168-121	40630.499	-67865.247	0.775	269-37-49	179-58-04	-0.009	610.787223
168-119	40630.494	-67866.022	1.085	269-40-59	180-03-10	-0.011	746.526242
168-154	40630.488	-67867.107	12.212	179-38-53	89-57-54	-12.218	829200.313326
168-153	40618.276	-67867.032	2.538	89-42-23	90-03-30	-12.199	827909.923368
						倍面積	62.006741
						面積	31.0033705

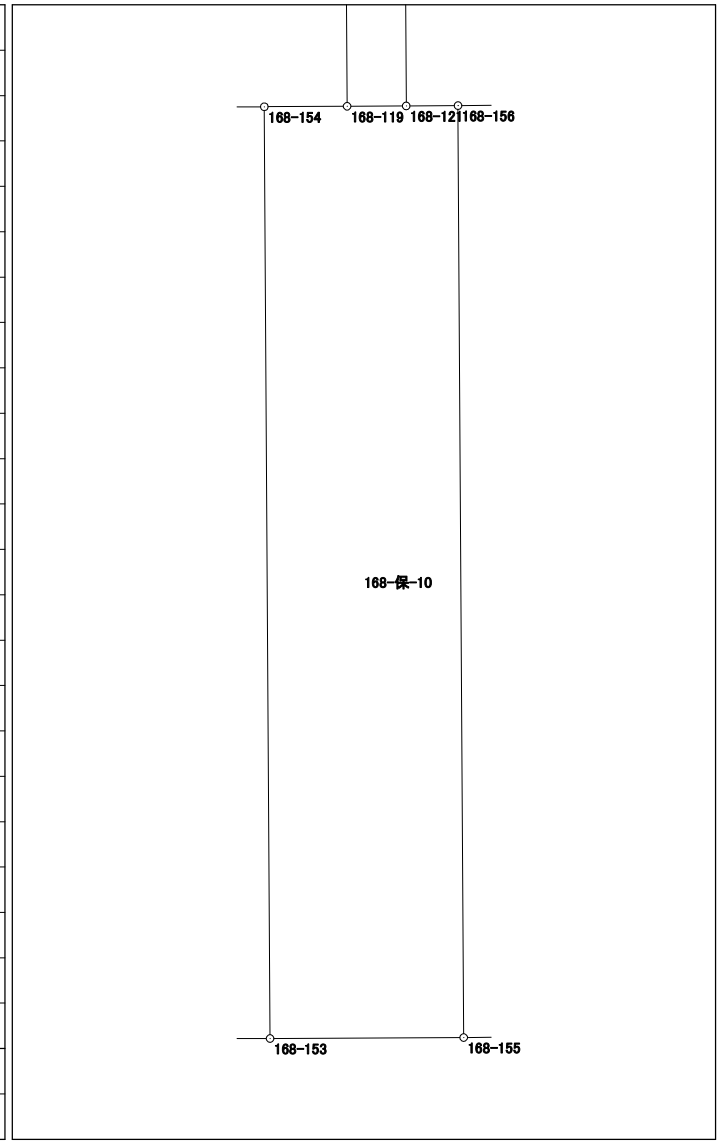


面積計算書（座標法）

世界測地系（測地成果2011）

所 在	地 番	公簿地目	現況地目	地 積	所 有 者
前橋市六供町三丁目	168-保-12			10.00 m ²	

点 名	X 座標	Y 座標	辺 長	方 向 角	測 角	DX	倍 積 (Y×DX)
168-147	40630.466	-67870.873	12.211	179-38-53	89-55-40	-12.215	829042.713695
168-148	40618.255	-67870.798	0.819	89-39-01	90-00-08	-12.206	828430.960388
168-146	40618.260	-67869.979	12.210	359-38-53	89-59-52	12.215	-829031.793485
168-145	40630.470	-67870.054	0.819	269-43-13	90-04-20	12.206	-828421.879124
						倍面積	20.001474
						面 積	10.0007370

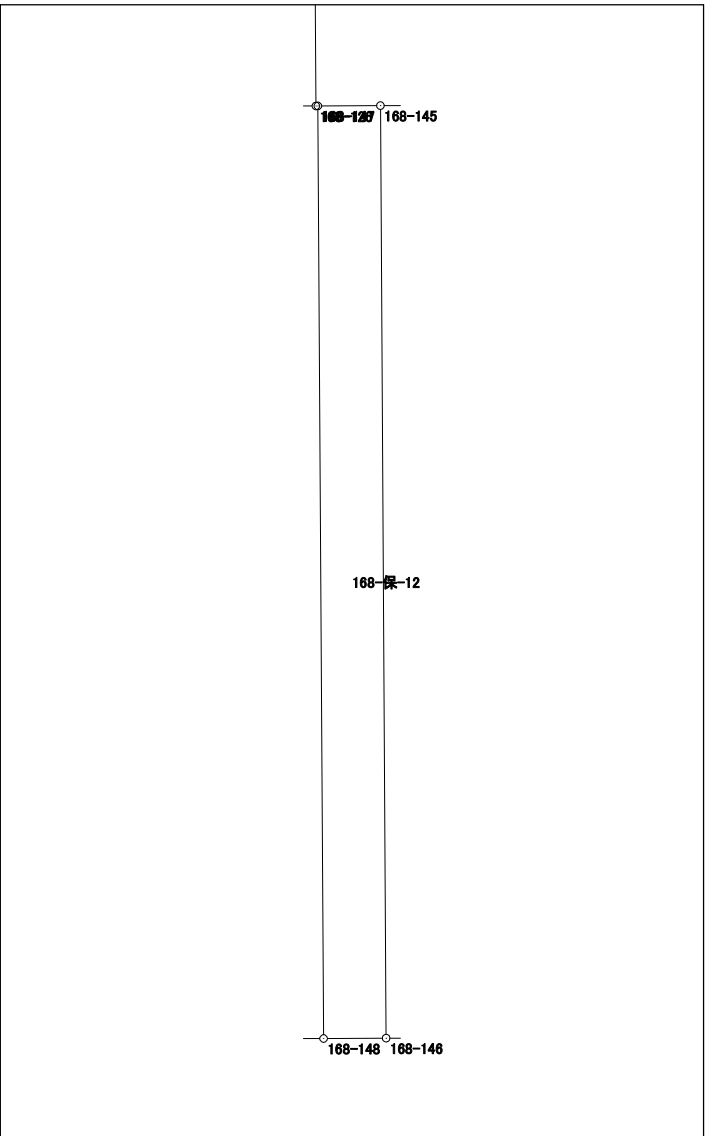


面積計算書 (座標法)

世界測地系 (測地成果2011)

所在	地番	公簿地目	現況地目	地積	所有者
前橋市六供町三丁目	168-保-13			46.00 m ²	

点名	X座標	Y座標	辺長	方向角	測角	DX	倍積 (Y×DX)
168-149	40630.444	-67874.640	12.212	179-38-53	89-58-11	-12.233	830310.471120
168-150	40618.232	-67874.565	3.767	89-39-01	90-00-08	-12.189	827323.072785
168-148	40618.255	-67870.798	12.211	359-38-53	89-59-52	12.234	-830331.342732
168-147	40630.466	-67870.873	0.026	267-47-51	88-08-58	12.210	-828703.359330
168-126	40630.465	-67870.899	3.741	269-40-42	181-52-51	-0.022	1493.159778
						倍面積	92.001621
						面積	46.0008105

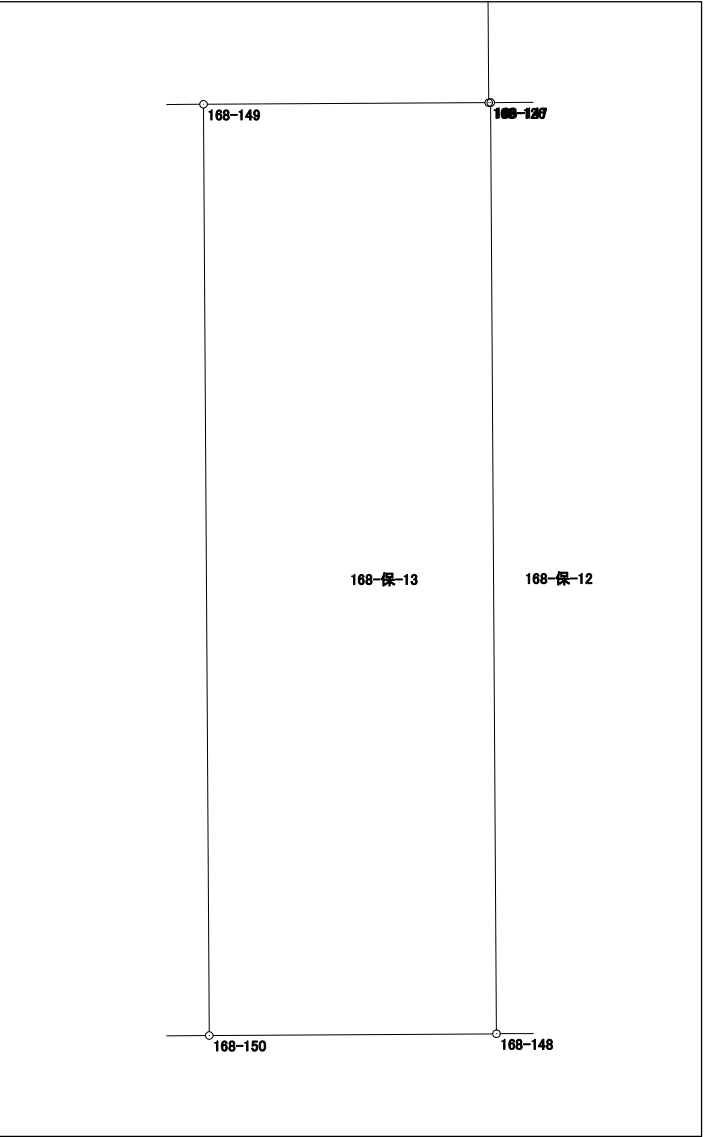


面積計算書（座標法）

世界測地系（測地成果2011）

所在	地番	公簿地目	現況地目	地積	所有者
前橋市六供町三丁目	168-保-14			10.00 m ²	

点名	X座標	Y座標	辺長	方向角	測角	DX	倍積 (Y×DX)
168-141	40630.400	-67885.338	12.232	179-38-55	89-43-07	-12.233	830441.339754
168-142	40618.168	-67885.263	0.818	89-38-59	90-00-04	-12.227	830033.110701
168-140	40618.173	-67884.445	12.228	359-38-55	89-59-56	12.233	-830430.415685
168-139	40630.401	-67884.520	0.818	269-55-48	90-16-53	12.227	-830024.026040

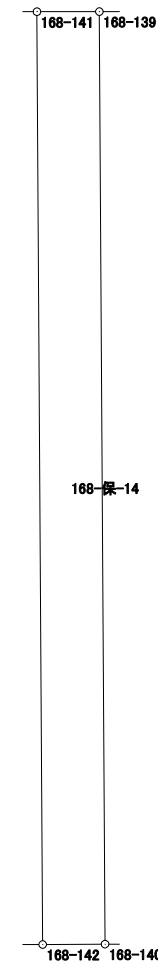


倍面積	20.008730
面積	10.0043650

面積計算書 (座標法)

世界測地系 (測地成果2011)

所在	地番	公簿地目	現況地目	地積	所有者
前橋市六供町三丁目	168-保-15			42.00 m ²	

点名	X座標	Y座標	辺長	方向角	測角	DX	倍積 (Y×DX)
168-143	40630.393	-67888.770	12.246	179-38-57	89-45-58	-12.253	831841.098810
168-144	40618.147	-67888.695	3.432	89-38-58	90-00-01	-12.225	829939.296375
168-142	40618.168	-67885.263	12.232	359-38-55	89-59-57	12.253	-831798.127539
168-141	40630.400	-67885.338	3.432	269-52-59	90-14-04	12.225	-829898.257050
						倍面積	84.010596
						面積	42.0052980

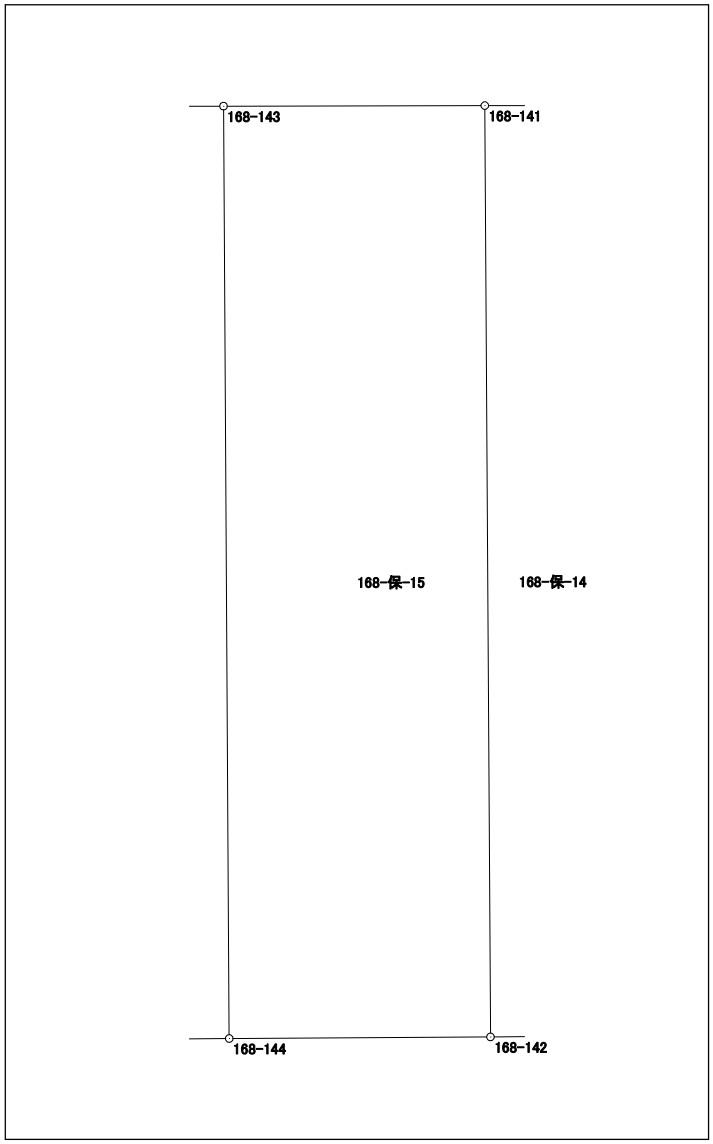

面積計算書（座標法）

世界測地系（測地成果2011）

所 在	地 番	公簿地目	現況地目	地 積	所 有 者
前橋市六供町三丁目	168-保-16			10.00 m ²	

点 名	X 座標	Y 座標	辺 長	方 向 角	測 角	DX	倍 積 (Y×DX)
168-138	40627.166	-67897.553	9.071	179-42-57	179-59-01	-12.281	833849.848393
168-136	40618.095	-67897.508	0.814	89-38-53	89-55-56	-9.066	615558.807528
168-22	40618.100	-67896.694	12.286	359-43-13	90-04-20	12.291	-834518.265954
168-24	40630.386	-67896.754	0.814	269-17-46	89-34-33	12.276	-833500.552104
168-135	40630.376	-67897.568	3.210	179-43-56	90-26-10	-3.220	218630.168960
						倍面積	20.006823
						面 積	10.0034115

