



171街区 画地出来形確認図 (1157.59m²)

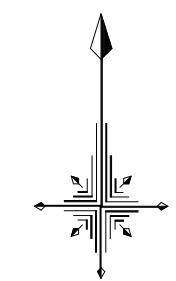

S=1/250

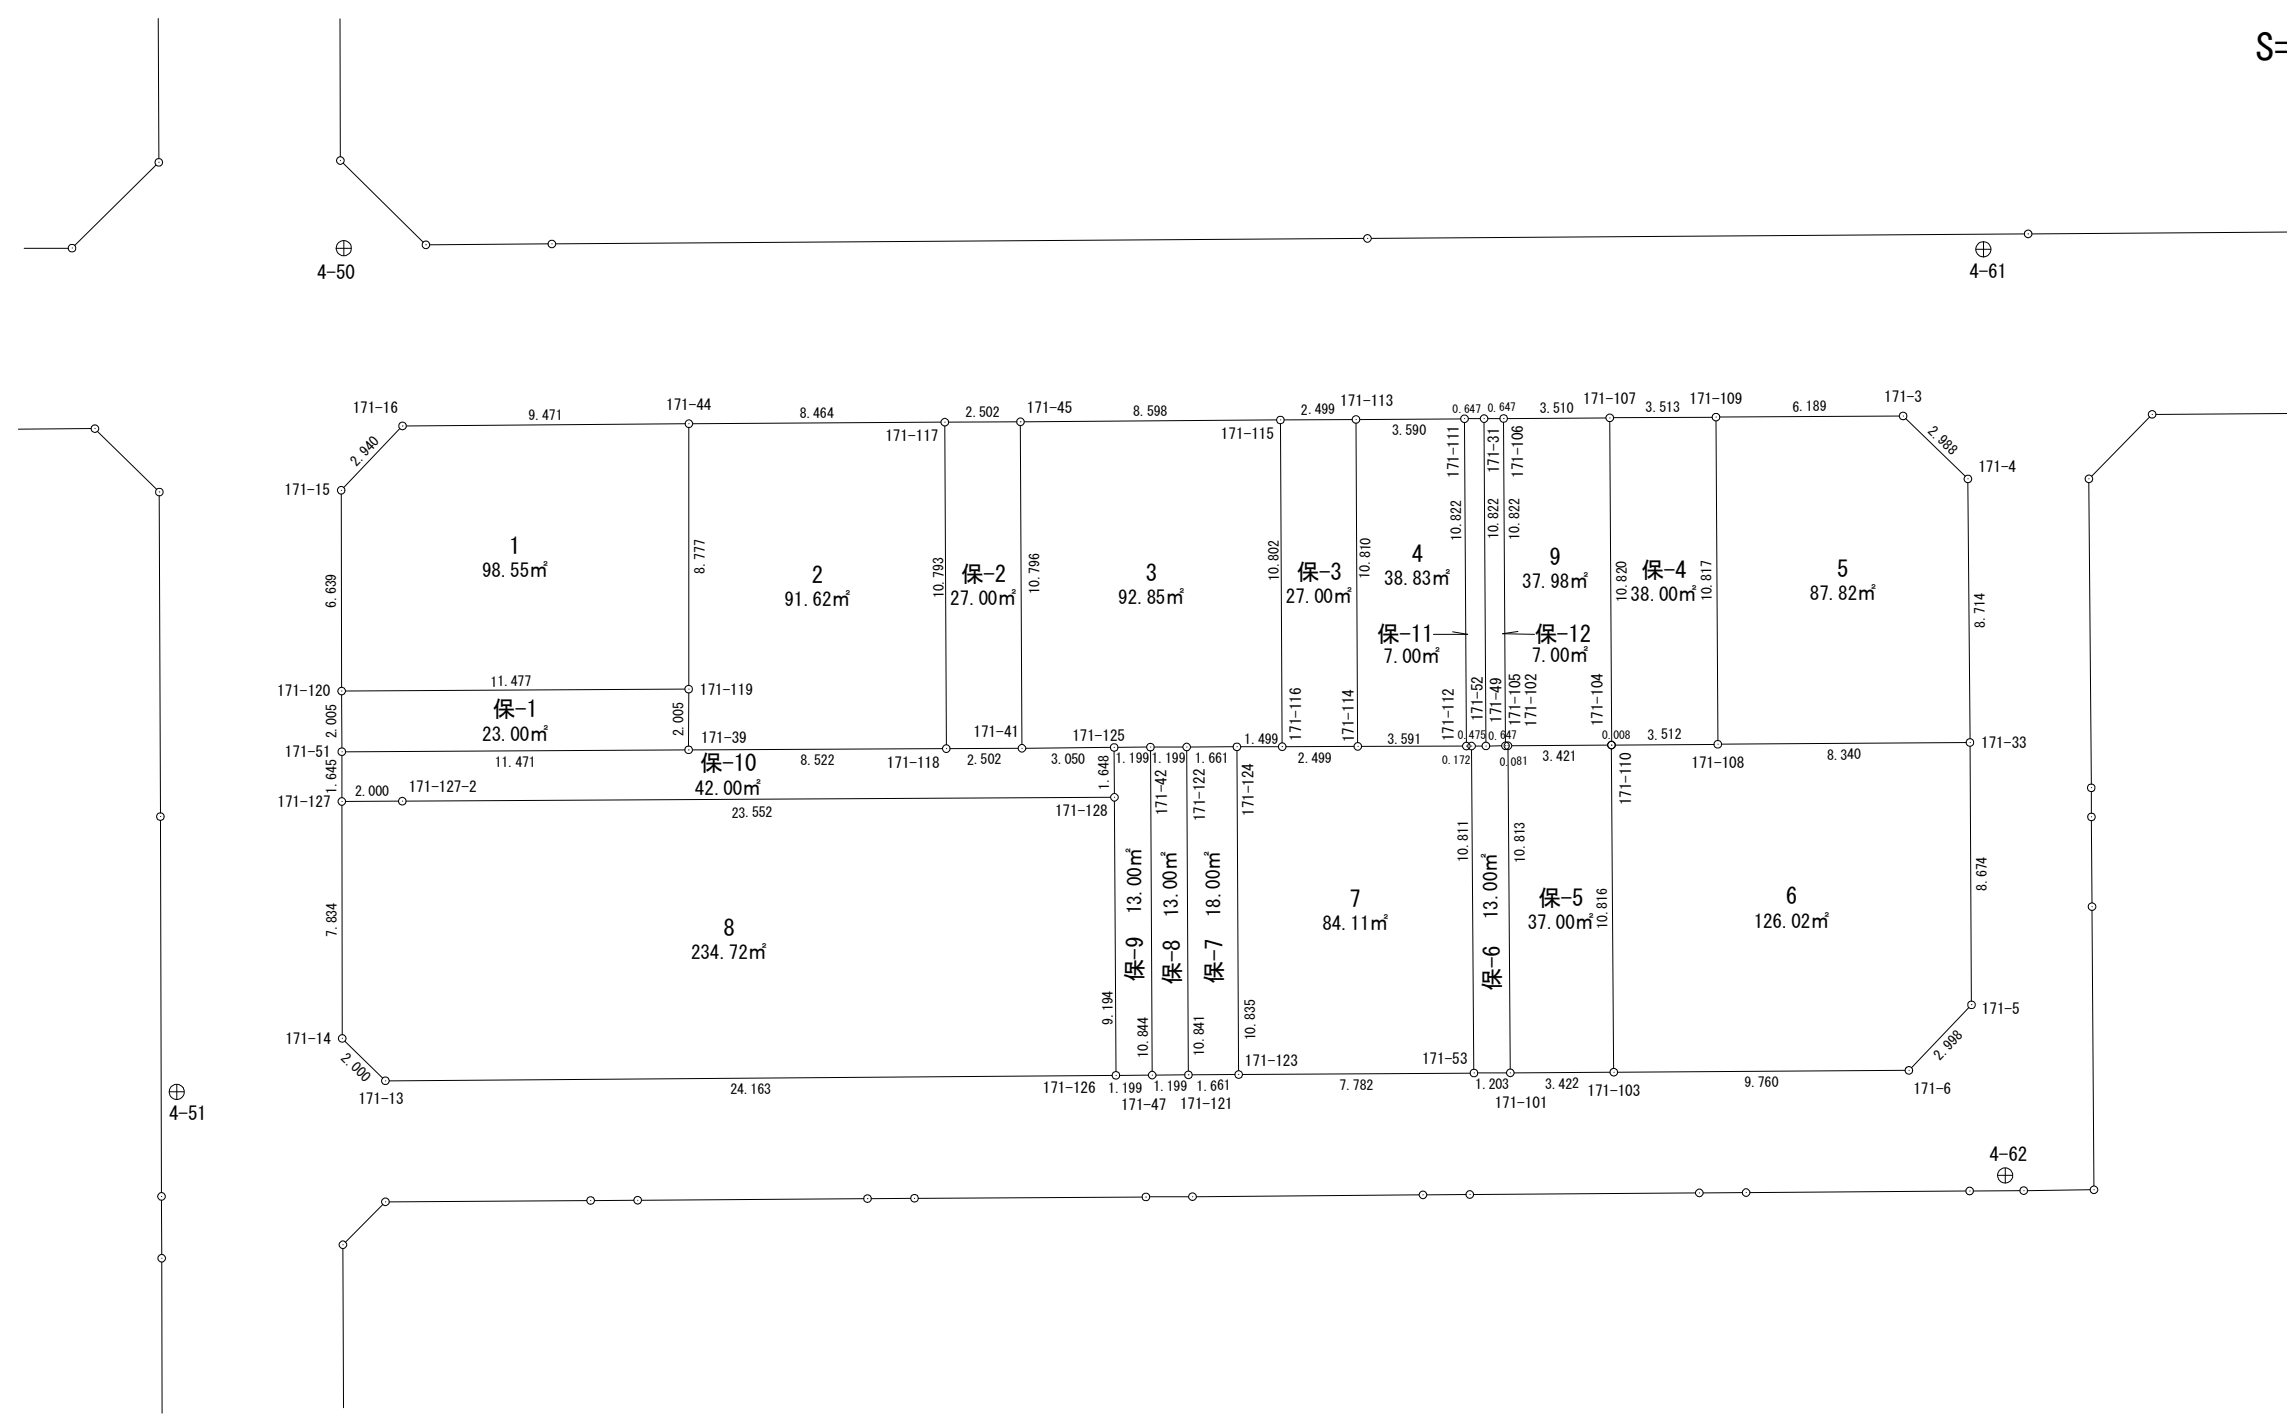


面積計算書（座標法）

世界測地系（測地成果2011）

所 在	地 番	公簿地目	現況地目	地 積	所 有 者
前橋市六供町三丁目	171-1			98.55 m ²	

点 名	X 座標	Y 座標	辺 長	方 向 角	測 角	DX	倍 積 (Y×DX)
171-120	40579.070	-68026.430	11.477	89-41-08	89-48-54	-6.576	447341.803680
171-119	40579.133	-68014.953	8.777	0-02-45	90-21-37	8.840	-601252.184520
171-44	40587.910	-68014.946	9.471	269-33-30	89-30-45	8.704	-592002.089984
171-16	40587.837	-68024.417	2.940	223-37-18	134-03-48	-2.201	149721.741817
171-15	40585.709	-68026.445	6.639	179-52-14	136-14-56	-8.767	596387.843315
						倍面積	197.114308
						面 積	98.5571540

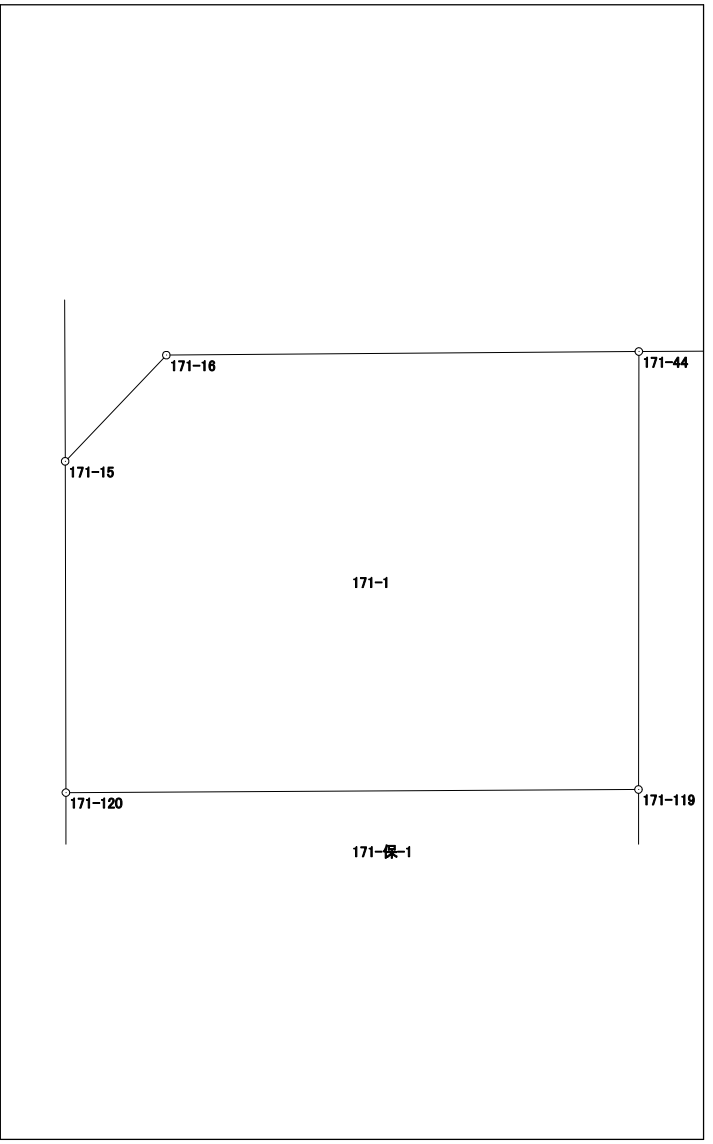

面積計算書 (座標法)

世界測地系 (測地成果2011)

所 在	地 番	公簿地目	現況地目	地 積	所 有 者
前橋市六供町三丁目	171-2			91.62 m ²	

点 名	X 座標	Y 座標	辺 長	方 向 角	測 角	DX	倍 積 (Y×DX)				
171-117	40587.960	-68006.482	8.464	269-39-42	89-55-38	10.743	-730593.636126				
171-44	40587.910	-68014.946	8.777	180-02-45	90-23-03	-8.827	600367.928342				
171-119	40579.133	-68014.953	2.005	180-01-43	179-58-58	-10.782	733337.223246				
171-39	40577.128	-68014.954	8.522	89-44-16	89-42-33	-1.966	133717.399564	<div style="text-align: center; vertical-align: middle; height: 400px;"> <p style="font-size: 2em; margin: 0;">171-2</p> <p style="font-size: 1.2em; margin: 0;">171-保-10</p> </div>			
171-118	40577.167	-68006.432	10.793	359-44-04	89-59-48	10.832	-736645.671424				
倍面積							183.243602				
面 積							91.6218010				

面積計算書 (座標法)

世界測地系 (測地成果2011)

所 在	地 番	公簿地目	現況地目	地 積	所 有 者
前橋市六供町三丁目	171-3			92.85 m ²	


点 名	X 座標	Y 座標	辺 長	方 向 角	測 角	DX	倍 積 (Y×DX)	
171-41	40577.178	-68003.930	3.050	89-28-26	89-44-21	-10.768	732266.318240	
171-125	40577.206	-68000.880	1.199	89-28-28	180-00-02	0.039	-2652.034320	
171-42	40577.217	-67999.681	1.199	89-48-32	180-20-04	0.015	-1019.995215	
171-122	40577.221	-67998.482	1.661	89-49-39	180-01-07	0.009	-611.986338	
171-124	40577.226	-67996.821	1.499	89-48-32	179-58-53	0.010	-679.968210	
171-116	40577.231	-67995.322	10.802	359-40-54	89-52-22	10.807	-734825.444854	
171-115	40588.033	-67995.382	8.598	269-36-25	89-55-31	10.743	-730474.388826	
171-45	40587.974	-68003.980	10.796	179-44-05	90-07-40	-10.855	738183.202900	
							倍面積	185.703377
							面 積	92.8516885

面積計算書 (座標法)

所在	地番	公簿地目	現況地目	地積	所有者
前橋市六供町三丁目	171-4			38.83 m ²	

点名	X座標	Y座標	辺長	方向角	測角	DX	倍積(Y×DX)
171-113	40588.050	-67992.883	10.810	179-40-55	90-03-54	-10.834	736634.894422
171-114	40577.240	-67992.823	3.591	89-48-31	90-07-36	-10.798	734186.502754
171-112	40577.252	-67989.232	10.822	359-40-37	89-52-06	10.834	-736595.339488
171-111	40588.074	-67989.293	3.590	269-37-01	89-56-24	10.798	-734148.385814

倍面積	77.671874
面積	38.8359370

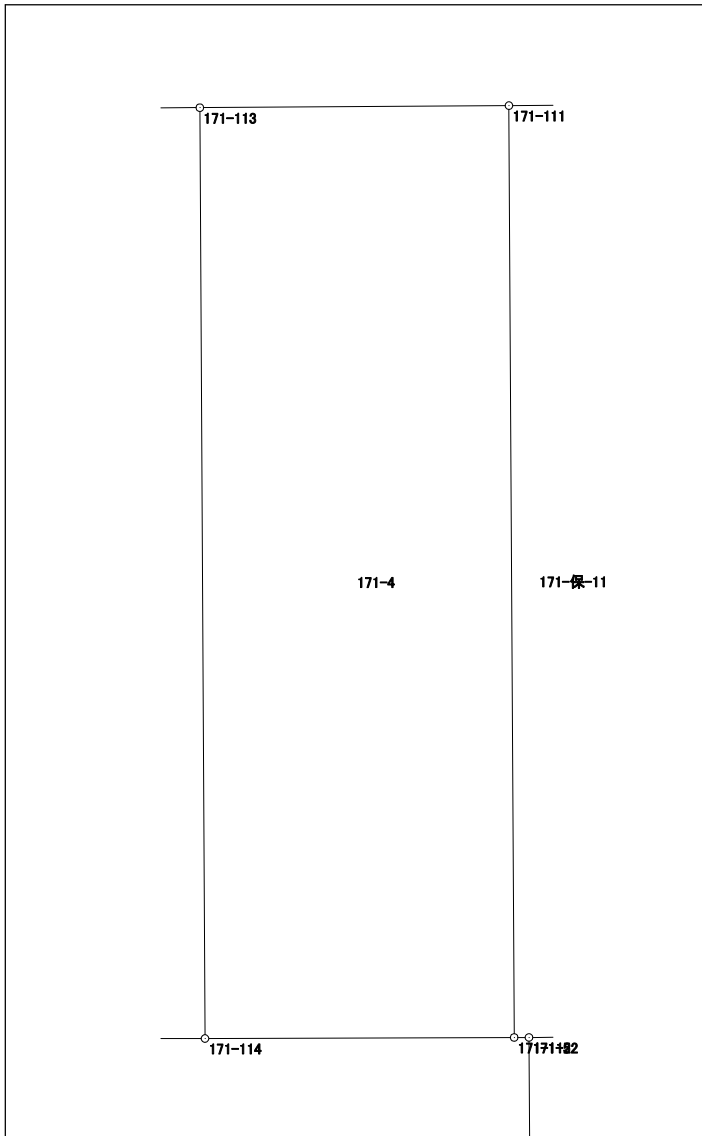


面積計算書（座標法）

世界測地系（測地成果2011）

所在	地番	公簿地目	現況地目	地積	所有者
前橋市六供町三丁目	171-5			87.82 m ²	

点名	X座標	Y座標	辺長	方向角	測角	DX	倍積 (Y×DX)
171-109	40588.127	-67980.976	10.817	179-40-56	90-02-36	-10.856	738001.475456
171-108	40577.310	-67980.916	8.340	89-35-16	89-54-20	-10.757	731270.713412
171-33	40577.370	-67972.576	8.714	359-33-10	89-57-54	8.774	-596391.381824
171-4	40586.084	-67972.644	2.988	314-10-22	134-37-12	10.796	-733832.664624
171-3	40588.166	-67974.787	6.189	269-38-20	135-27-58	2.043	-138872.489841
						倍面積	175.652579
						面積	87.8262895

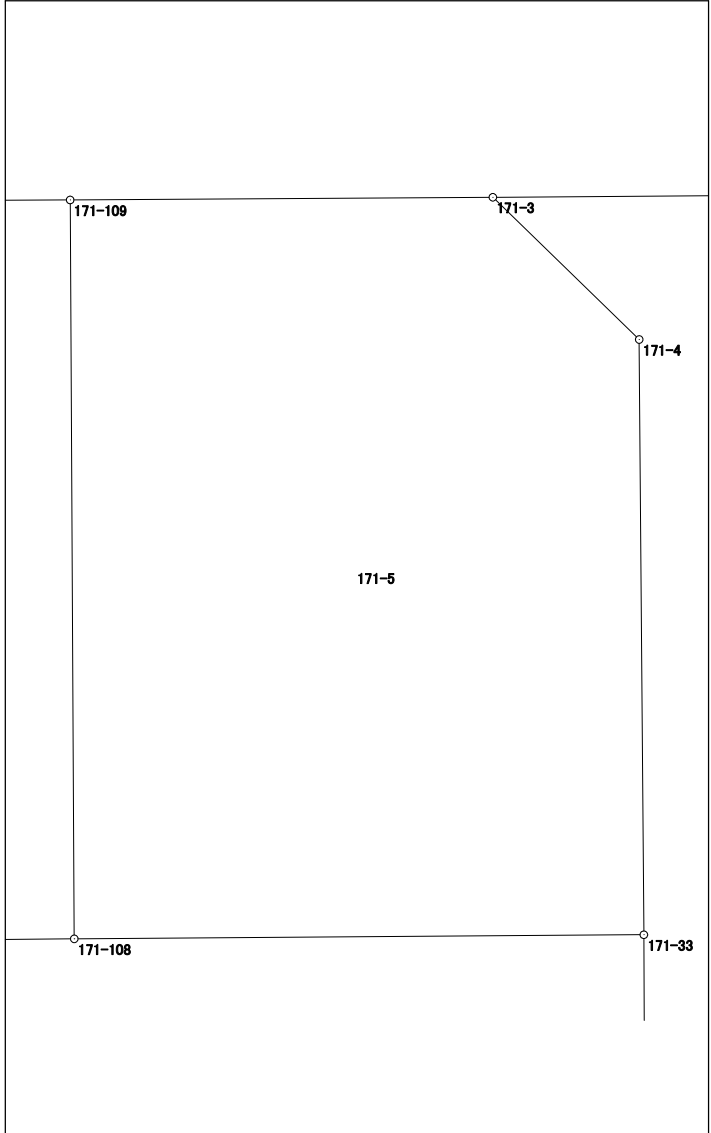


面積計算書 (座標法)

世界測地系 (測地成果2011)

所在	地番	公簿地目	現況地目	地積	所有者
前橋市六供町三丁目	171-6			126.02 m ²	

点名	X座標	Y座標	辺長	方向角	測角	DX	倍積 (Y×DX)
171-6	40566.528	-67974.596	2.998	43-41-21	134-02-08	2.227	-151379.425292
171-5	40568.696	-67972.525	8.674	359-39-47	135-58-26	10.842	-736958.116050
171-33	40577.370	-67972.576	8.340	269-35-16	89-55-29	8.614	-585515.769664
171-108	40577.310	-67980.916	3.512	269-35-32	180-00-16	-0.085	5778.377860
171-110	40577.285	-67984.428	0.008	270-00-00	180-24-28	-0.025	1699.610700
171-104	40577.285	-67984.436	10.816	179-34-34	89-34-34	-10.816	735319.659776
171-103	40566.469	-67984.356	9.760	89-39-13	90-04-39	-10.757	731307.717492

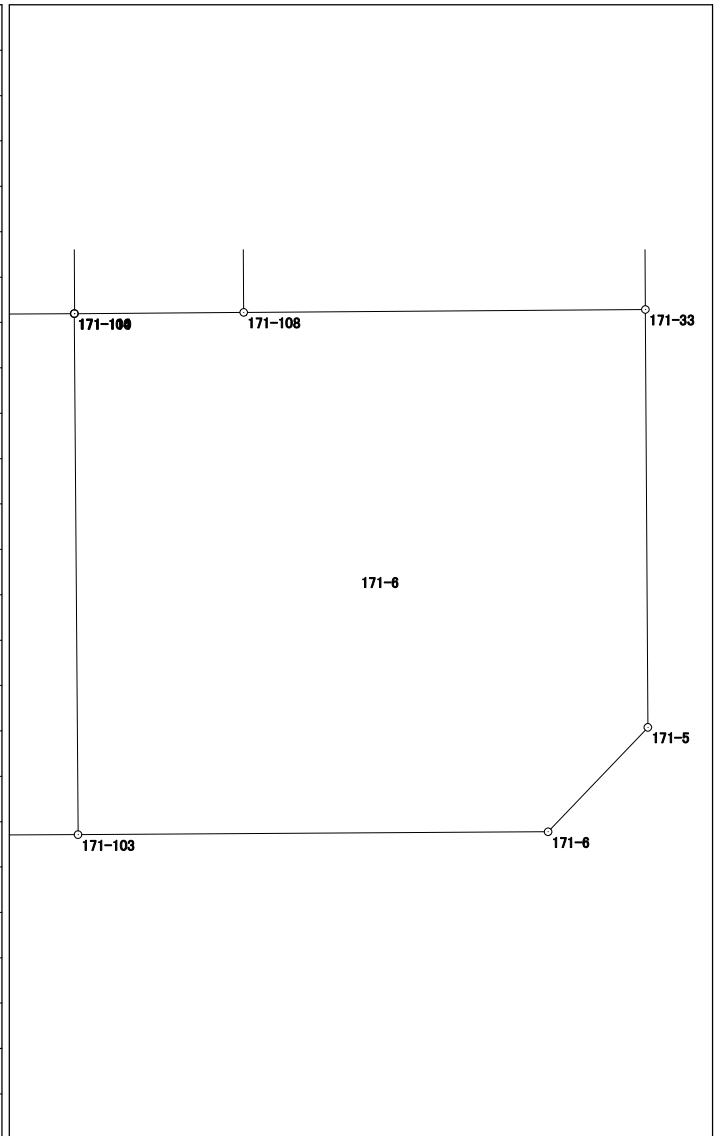

倍面積	252.054822
面積	126.0274110

面積計算書（座標法）

世界測地系（測地成果2011）

所在	地番	公簿地目	現況地目	地積	所有者
前橋市六供町三丁目	171-7			84.11 m ²	


点名	X座標	Y座標	辺長	方向角	測角	DX	倍積 (Y×DX)			
171-124	40577.226	-67996.821	10.835	179-41-36	89-53-04	-10.840	737085.539640			
171-123	40566.391	-67996.763	7.782	89-37-55	89-56-19	-10.785	733345.088955			
171-53	40566.441	-67988.981	10.811	359-34-53	89-56-58	10.861	-738428.322641			
171-52	40577.252	-67989.060	0.172	270-00-00	90-25-07	10.811	-735029.727660			
171-112	40577.252	-67989.232	3.591	269-48-31	179-48-31	-0.012	815.870784			
171-114	40577.240	-67992.823	2.499	269-47-37	179-59-06	-0.021	1427.849283			
171-116	40577.231	-67995.322	1.499	269-48-32	180-00-55	-0.014	951.934508			
							倍面積	168.232869		
							面積	84.1164345		

面積計算書 (座標法)

世界測地系 (測地成果2011)

所在	地番	公簿地目	現況地目	地積	所有者
前橋市六供町三丁目	171-8			234.72 m ²	

点名	X座標	Y座標	辺長	方向角	測角	Dx	倍積 (Y×Dx)
171-127-2	40575.429	-68024.424	2.000	269-44-32	180-03-22	-0.138	9387.370512
171-127	40575.420	-68026.424	7.834	179-54-18	90-09-46	-7.843	533531.243432
171-14	40567.586	-68026.411	2.000	134-28-24	134-34-06	-9.235	628223.905585
171-13	40566.185	-68024.984	24.163	89-34-32	135-06-08	-1.222	83126.530448
171-126	40566.364	-68000.822	9.194	359-41-18	90-06-46	9.373	-637371.704606
171-128	40575.558	-68000.872	23.552	269-41-10	89-59-52	9.065	-616427.904680

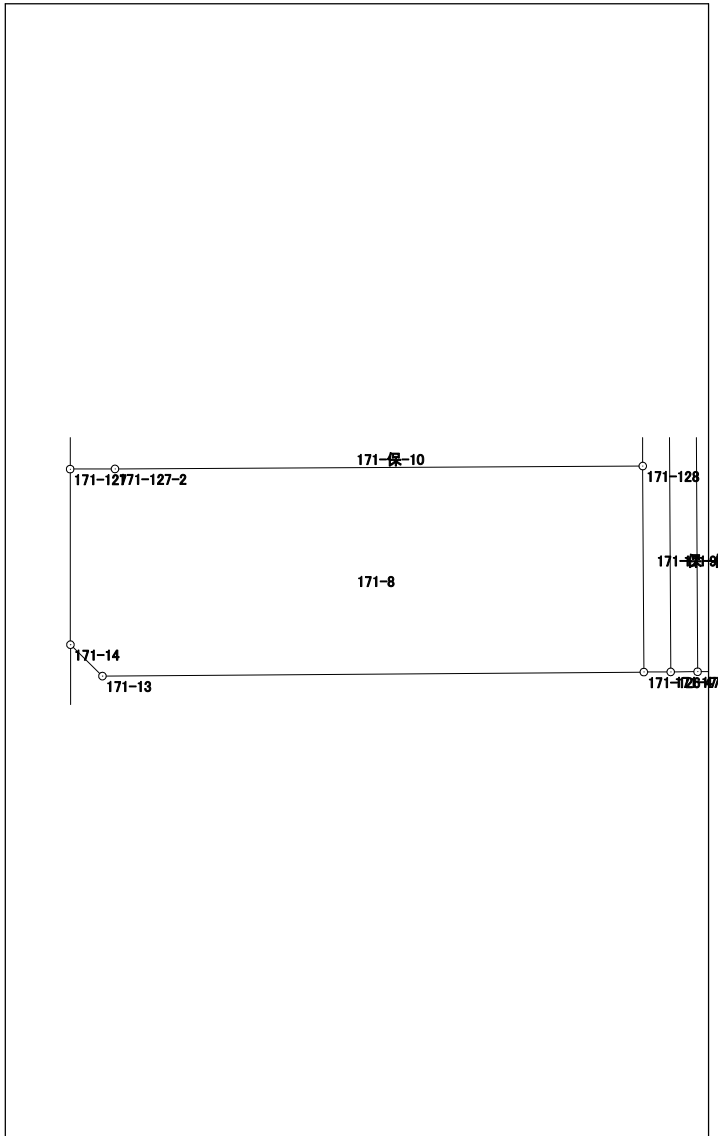


倍面積	469.440691
面積	234.7203455

面積計算書（座標法）

世界測地系（測地成果2011）

所 在	地 番	公簿地目	現況地目	地 積	所 有 者
前橋市六供町三丁目	171-9			37.98 m ²	

点 名	X 座 標	Y 座 標	辺 長	方 向 角	測 角	DX	倍 積 (Y×DX)
171-110	40577.285	-67984.428	10.820	359-40-37	89-40-37	10.820	-735591.510960
171-107	40588.105	-67984.489	3.510	269-37-28	89-56-51	10.797	-734028.527733
171-106	40588.082	-67987.999	10.822	179-40-37	90-03-09	-10.845	737329.849155
171-105	40577.260	-67987.938	0.081	89-17-34	89-36-57	-10.821	735697.477098
171-102	40577.261	-67987.857	3.421	89-35-53	180-18-19	0.025	-1699.696425
171-104	40577.285	-67984.436	0.008	90-00-00	180-24-07	0.024	-1631.626464
						倍面積	75.964671
						面 積	37.9823355

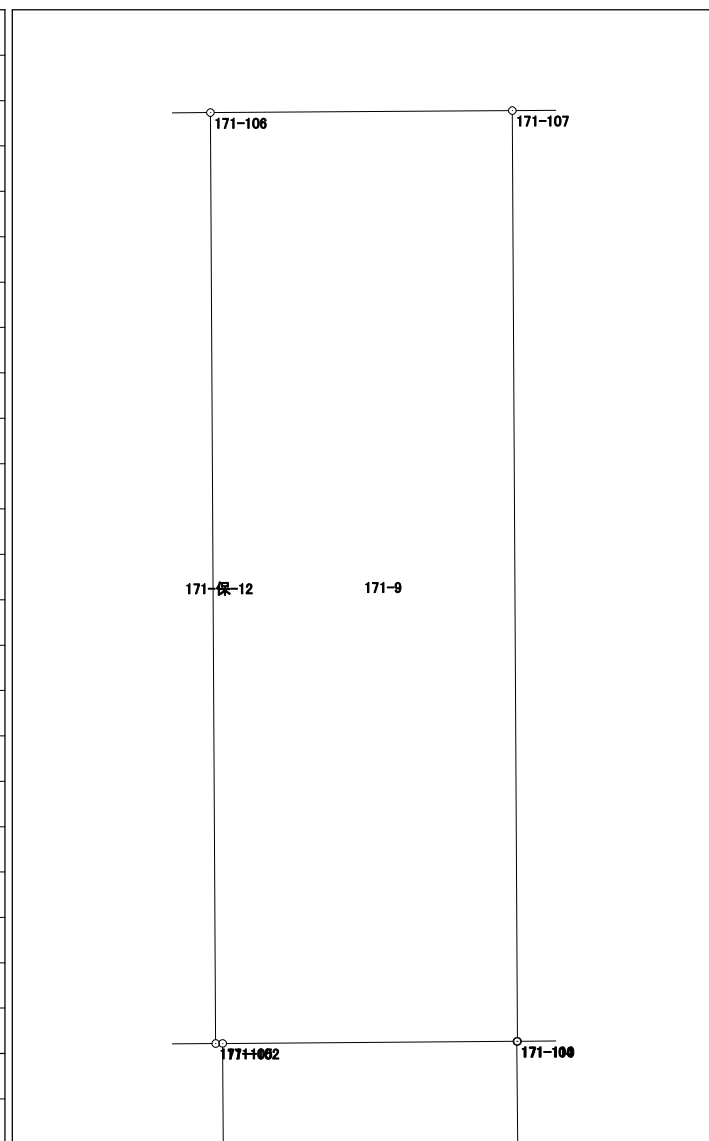


面積計算書 (座標法)

世界測地系 (測地成果2011)

所在	地番	公簿地目	現況地目	地積	所有者
前橋市六供町三丁目	171-保-1			23.00 m ²	

点名	X座標	Y座標	辺長	方向角	測角	DX	倍積 (Y×DX)
171-119	40579.133	-68014.953	11.477	269-41-08	89-39-25	1.942	-132085.038726
171-120	40579.070	-68026.430	2.005	179-51-26	90-10-18	-2.068	140678.657240
171-51	40577.065	-68026.425	11.471	89-41-07	89-49-41	-1.942	132107.317350
171-39	40577.128	-68014.954	2.005	0-01-43	90-20-36	2.068	-140654.924872
						倍面積	46.010992
						面積	23.0054960

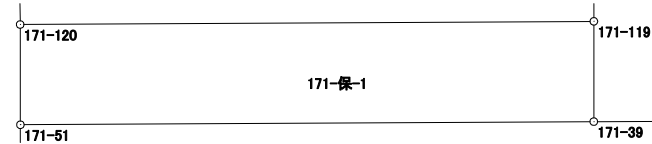


面積計算書（座標法）

世界測地系（測地成果2011）

所 在	地 番	公簿地目	現況地目	地 積	所 有 者
前橋市六供町三丁目	171-保-2			27.00 m ²	

点 名	X 座標	Y 座標	辺 長	方 向 角	測 角	DX	倍 積 (Y×DX)
171-117	40587.960	-68006.482	10.793	179-44-04	90-03-18	-10.807	734946.050974
171-118	40577.167	-68006.432	2.502	89-44-53	90-00-49	-10.782	733245.349824
171-41	40577.178	-68003.930	10.796	359-44-05	89-59-12	10.807	-734918.471510
171-45	40587.974	-68003.980	2.502	269-40-46	89-56-41	10.782	-733218.912360
倍面積							54.016928
面 積							27.0084640

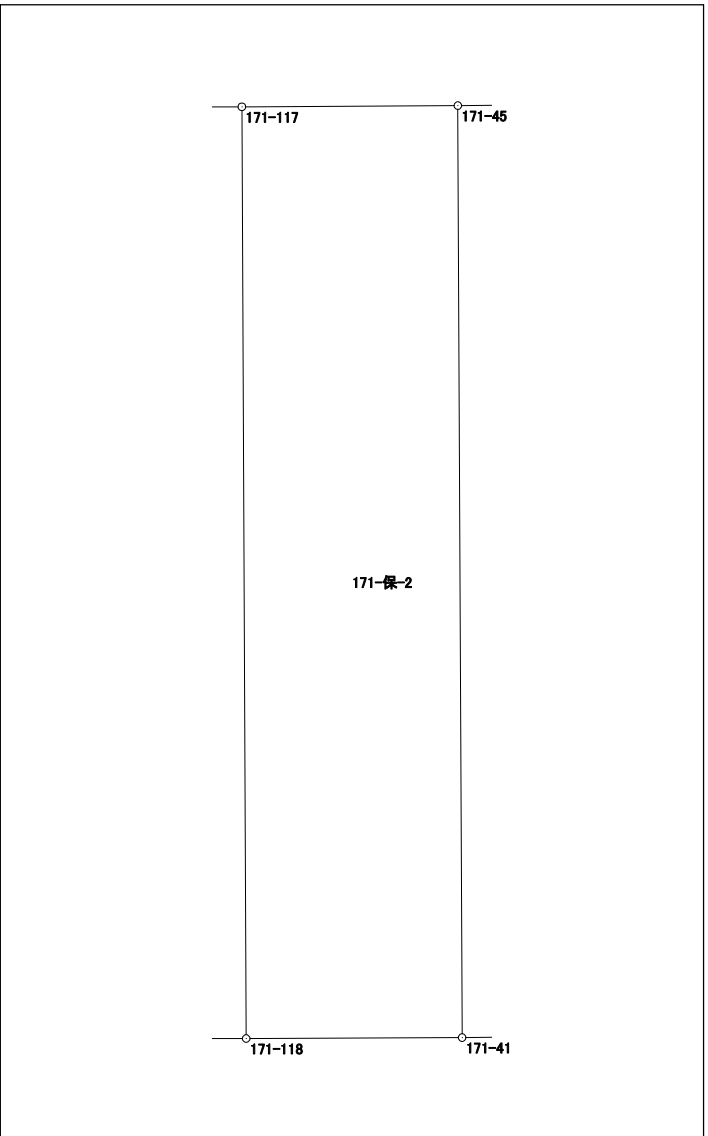


面積計算書（座標法）

世界測地系（測地成果2011）

所 在	地 番	公簿地目	現況地目	地 積	所 有 者
前橋市六供町三丁目	171-保-3			27.00 m ²	

点 名	X 座標	Y 座標	辺 長	方 向 角	測 角	DX	倍 積 (Y×DX)
171-115	40588.033	-67995.382	10.802	179-40-54	90-04-17	-10.819	735642.037858
171-116	40577.231	-67995.322	2.499	89-47-37	90-06-43	-10.793	733873.510346
171-114	40577.240	-67992.823	10.810	359-40-55	89-53-18	10.819	-735614.352037
171-113	40588.050	-67992.883	2.499	269-36-37	89-55-42	10.793	-733847.186219
						倍面積	54.009948
						面 積	27.0049740

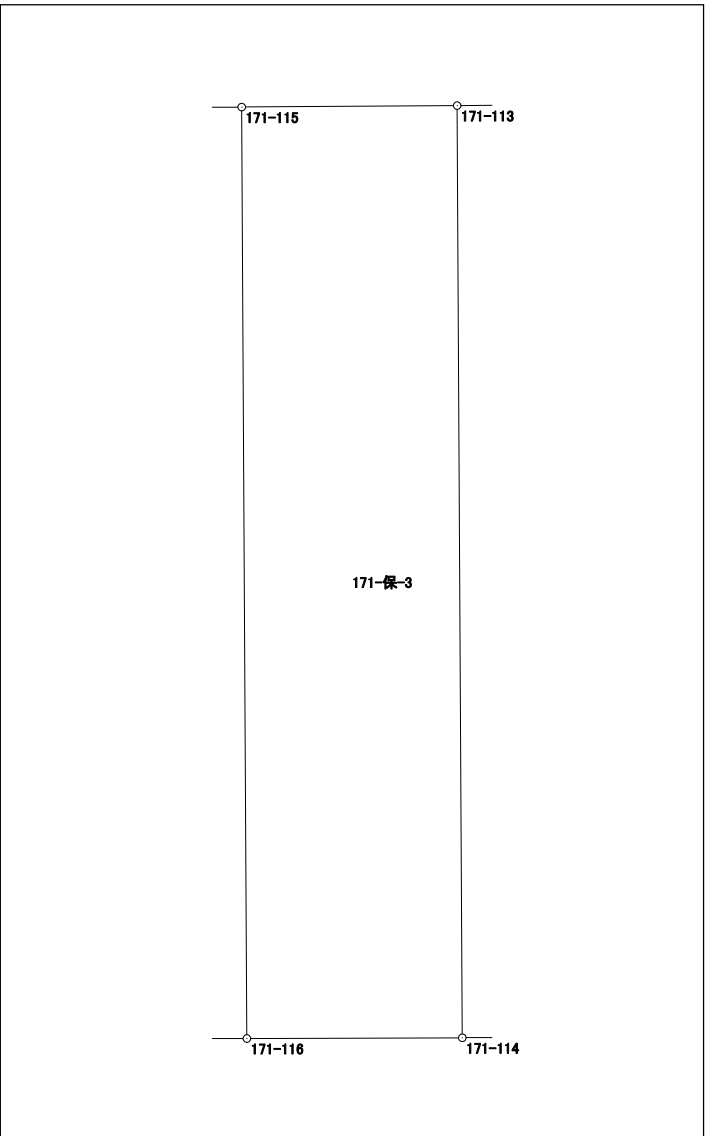


面積計算書 (座標法)

世界測地系 (測地成果2011)

所在	地番	公簿地目	現況地目	地積	所有者
前橋市六供町三丁目	171-保-4			38.00 m ²	

点名	X座標	Y座標	辺長	方向角	測角	DX	倍積 (Y×DX)
171-108	40577.310	-67980.916	10.817	359-40-56	90-05-24	10.842	-737049.091272
171-109	40588.127	-67980.976	3.513	269-38-28	89-57-32	10.795	-733854.635920
171-107	40588.105	-67984.489	10.820	179-40-37	90-02-09	-10.842	737087.829738
171-110	40577.285	-67984.428	3.512	89-35-32	89-54-55	-10.795	733891.900260
						倍面積	76.002806
						面積	38.0014030

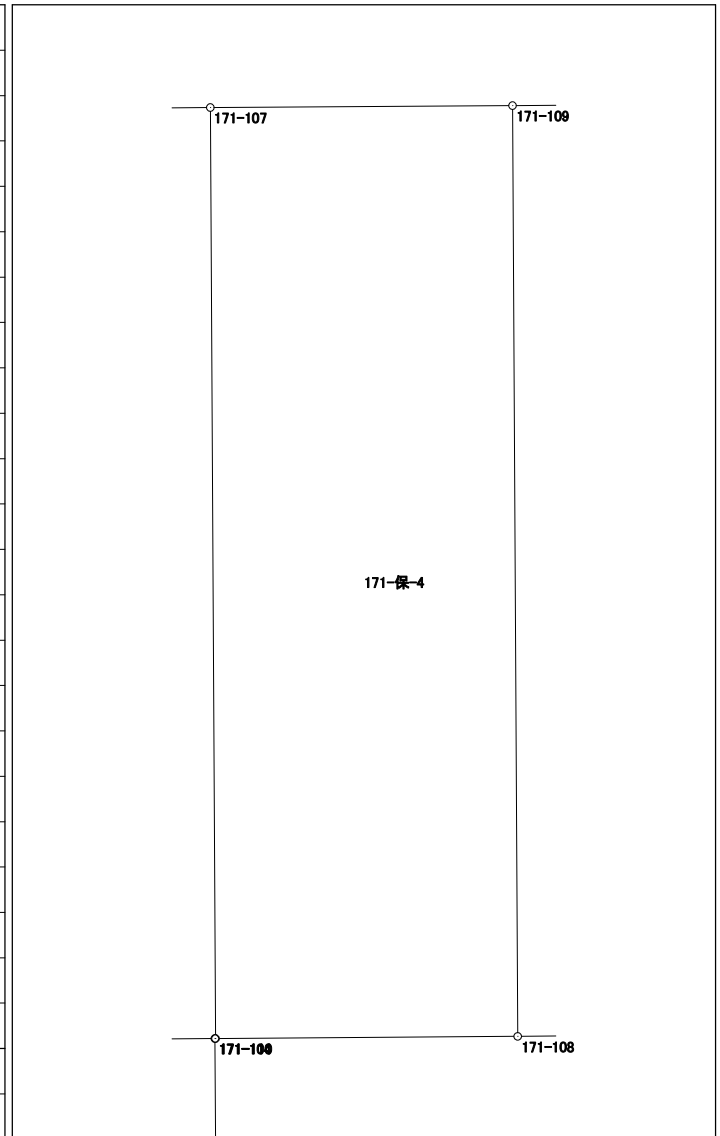


面積計算書（座標法）

世界測地系（測地成果2011）

所在	地番	公簿地目	現況地目	地積	所有者
前橋市六供町三丁目	171-保-5			37.00 m ²	

点名	X座標	Y座標	辺長	方向角	測角	DX	倍積 (Y×DX)
171-103	40566.469	-67984.356	10.816	359-34-34	89-55-40	10.837	-736746.465972
171-104	40577.285	-67984.436	3.421	269-35-53	90-01-19	10.792	-733688.033312
171-102	40577.261	-67987.857	10.813	179-34-53	89-59-00	-10.837	736784.406309
171-101	40566.448	-67987.778	3.422	89-38-54	90-04-01	-10.792	733724.100176

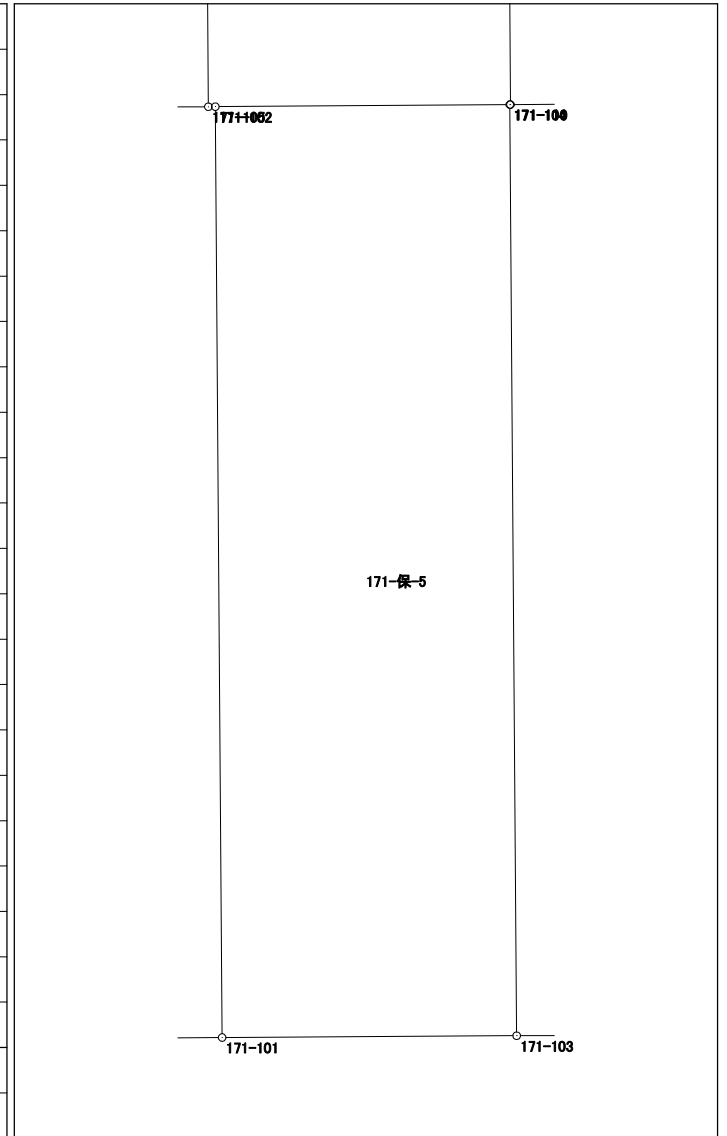


倍面積	74.007201
面積	37.0036005

面積計算書（座標法）

世界測地系（測地成果2011）

所 在	地 番	公簿地目	現況地目	地 積	所 有 者
前橋市六供町三丁目	171-保-6			13.00 m ²	


点 名	X 座標	Y 座標	辺 長	方 向 角	測 角	DX	倍 積 (Y×DX)
171-102	40577.261	-67987.857	0.081	269-17-34	89-42-41	10.812	-735084.709884
171-105	40577.260	-67987.938	0.647	269-38-45	180-21-11	-0.005	339.939690
171-49	40577.256	-67988.585	0.475	269-31-03	179-52-18	-0.008	543.908680
171-52	40577.252	-67989.060	10.811	179-34-53	90-03-50	-10.815	735301.683900
171-53	40566.441	-67988.981	1.203	89-40-00	90-05-07	-10.804	734552.950724
171-101	40566.448	-67987.778	10.813	359-34-53	89-54-53	10.820	-735627.757960
						倍面積	26.015150
						面 積	13.0075750

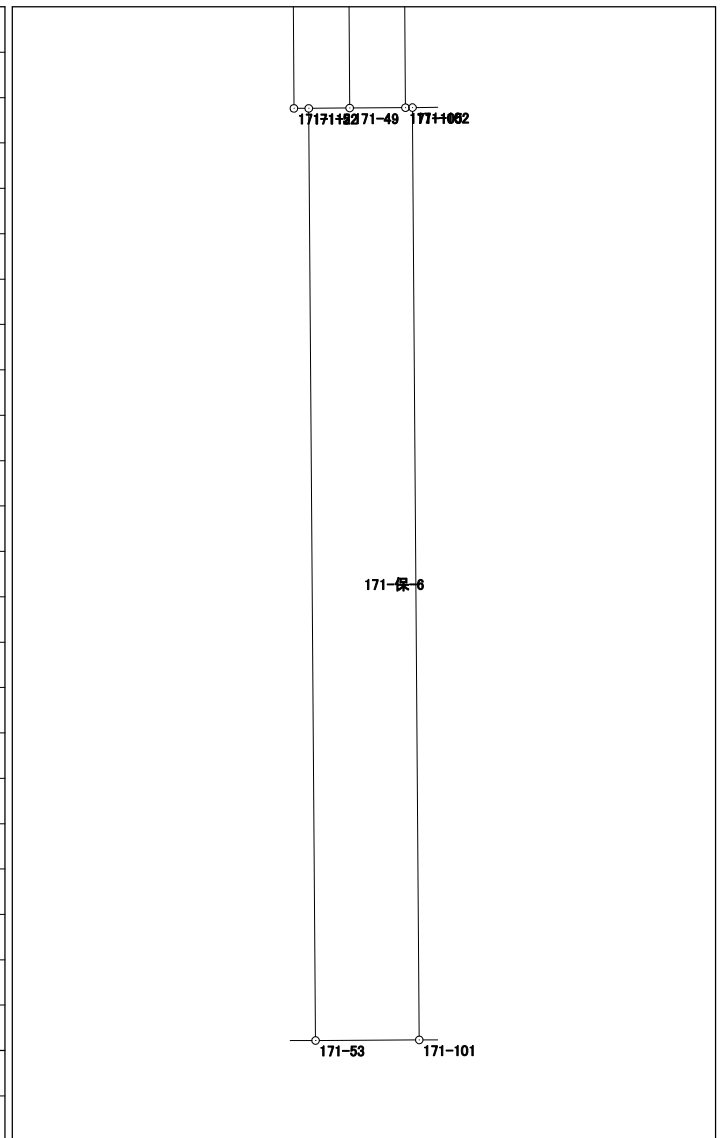

面積計算書（座標法）

世界測地系（測地成果2011）

所 在	地 番	公簿地目	現況地目	地 積	所 有 者
前橋市六供町三丁目	171-保-7			18.00 m ²	


点 名	X 座標	Y 座標	辺 長	方 向 角	測 角	DX	倍 積 (Y×DX)		
171-123	40566.391	-67996.763	10.835	359-41-36	90-04-22	10.846	-737492.891498		
171-124	40577.226	-67996.821	1.661	269-49-39	90-08-03	10.830	-736405.571430		
171-122	40577.221	-67998.482	10.841	179-41-36	89-51-57	-10.846	737511.535772		
171-121	40566.380	-67998.424	1.661	89-37-14	89-55-38	-10.830	736422.931920		
倍面積							36.004764		
面 積							18.0023820		

面積計算書 (座標法)

世界測地系 (測地成果2011)

所在	地番	公簿地目	現況地目	地積	所有者
前橋市六供町三丁目	171-保-8			13.00 m ²	

点名	X座標	Y座標	辺長	方向角	測角	DX	倍積 (Y×DX)
171-121	40566.380	-67998.424	10.841	359-41-36	90-01-40	10.848	-737646.903552
171-122	40577.221	-67998.482	1.199	269-48-32	90-06-56	10.837	-736899.549434
171-42	40577.217	-67999.681	10.844	179-41-37	89-53-05	-10.848	737660.539488
171-47	40566.373	-67999.623	1.199	89-39-56	89-58-19	-10.837	736911.914451
						倍面積	26.000953
						面積	13.0004765

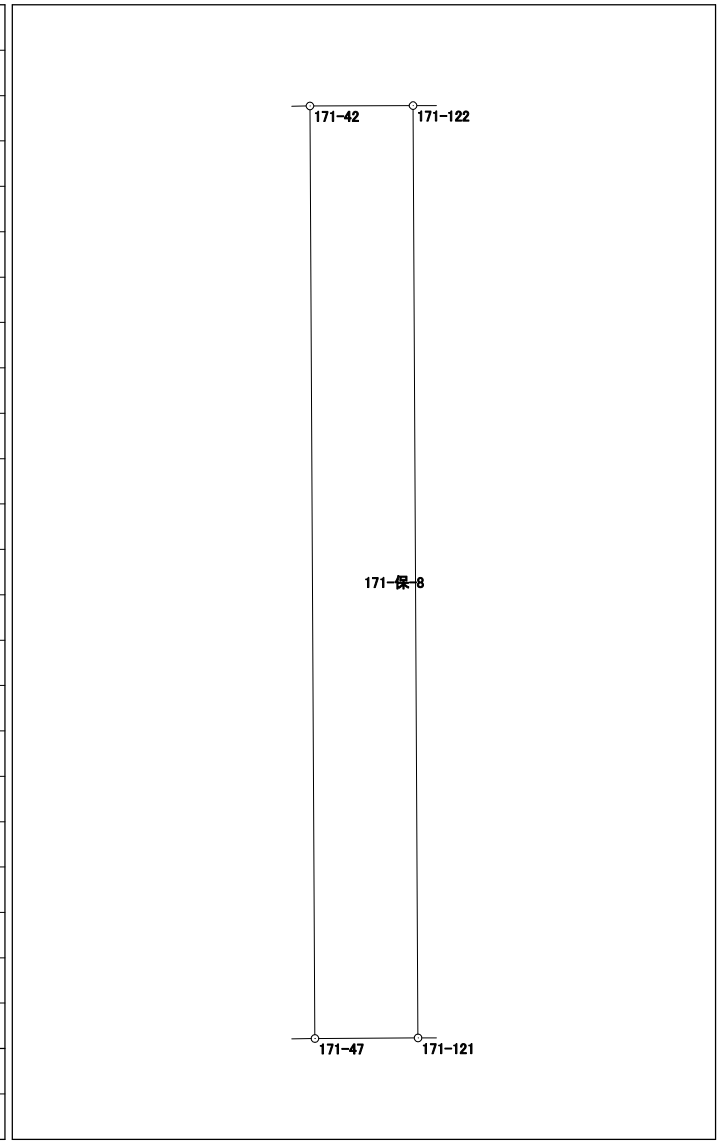


面積計算書 (座標法)

世界測地系 (測地成果2011)

所 在	地 番	公簿地目	現況地目	地 積	所 有 者
前橋市六供町三丁目	171-保-9			13.00 m ²	

点 名	X 座標	Y 座標	辺 長	方 向 角	測 角	DX	倍 積 (Y×DX)
171-128	40575.558	-68000.872	9.194	179-41-18	179-57-59	-10.842	737265.454224
171-126	40566.364	-68000.822	1.199	89-34-12	89-52-54	-9.185	624587.550070
171-47	40566.373	-67999.623	10.844	359-41-37	90-07-25	10.853	-737999.908419
171-42	40577.217	-67999.681	1.199	269-28-28	89-46-51	10.833	-736640.544273
171-125	40577.206	-68000.880	1.648	179-43-19	90-14-51	-1.659	112813.459920
						倍面積	26.011522
						面 積	13.0057610

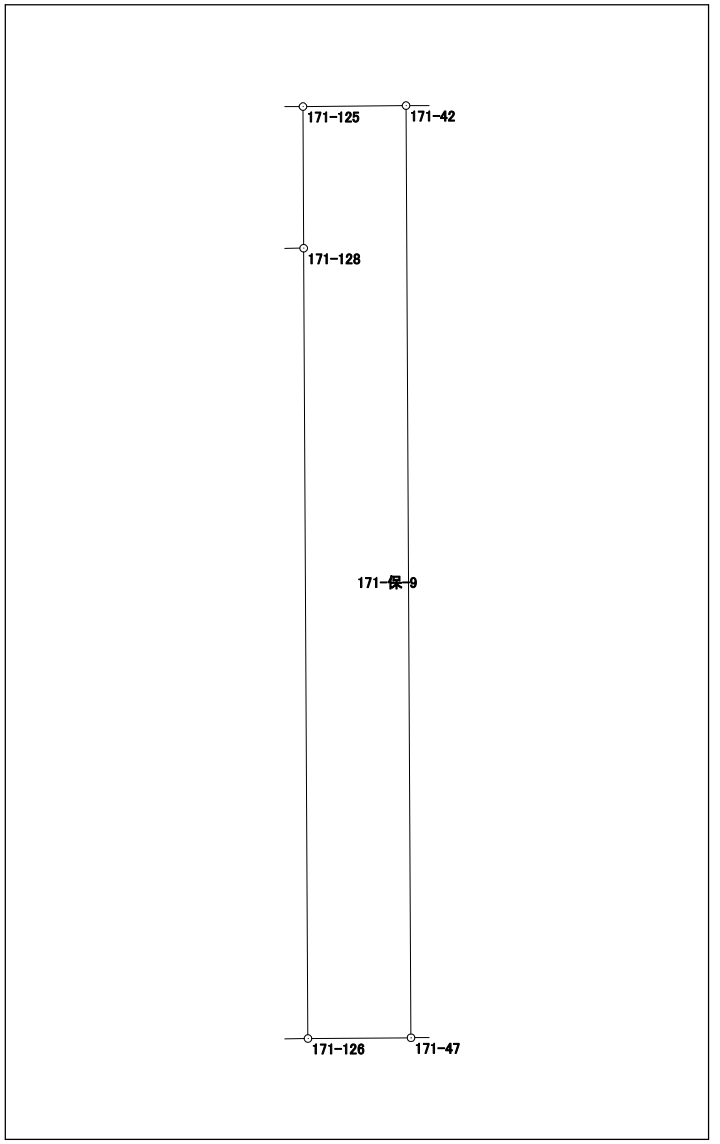

面積計算書（座標法）

世界測地系（測地成果2011）

所 在	地 番	公簿地目	現況地目	地 積	所 有 者
前橋市六供町三丁目	171-保-10			42.00 m ²	

点 名	X 座標	Y 座標	辺 長	方 向 角	測 角	DX	倍 積 (Y×DX)	
171-127-2	40575.429	-68024.424	23.552	89-41-10	179-56-38	0.138	-9387.370512	
171-128	40575.558	-68000.872	1.648	359-43-19	90-02-09	1.777	-120837.549544	
171-125	40577.206	-68000.880	3.050	269-28-26	89-45-07	1.620	-110161.425600	
171-41	40577.178	-68003.930	2.502	269-44-53	180-16-27	-0.039	2652.153270	
171-118	40577.167	-68006.432	8.522	269-44-16	179-59-23	-0.050	3400.321600	
171-39	40577.128	-68014.954	11.471	269-41-07	179-56-51	-0.102	6937.525308	
171-51	40577.065	-68026.425	1.645	179-57-55	90-16-48	-1.708	116189.133900	
171-127	40575.420	-68026.424	2.000	89-44-32	89-46-37	-1.636	111291.229664	
倍面積							84.018086	
面 積							42.0090430	


面積計算書 (座標法)

世界測地系 (測地成果2011)

所在	地番	公簿地目	現況地目	地積	所有者
前橋市六供町三丁目	171-保-11			7.00 m ²	

点名	X座標	Y座標	辺長	方向角	測角	DX	倍積 (Y×DX)
171-111	40588.074	-67989.293	10.822	179-40-37	90-01-52	-10.826	736052.086018
171-112	40577.252	-67989.232	0.172	90-00-00	90-19-23	-10.822	735779.468704
171-52	40577.252	-67989.060	0.475	89-31-03	179-31-03	0.004	-271.956240
171-49	40577.256	-67988.585	10.822	359-40-37	90-09-34	10.826	-736044.421210
171-31	40588.078	-67988.646	0.647	269-38-45	89-58-08	10.818	-735501.172428

倍面積	14.004844
面積	7.0024220

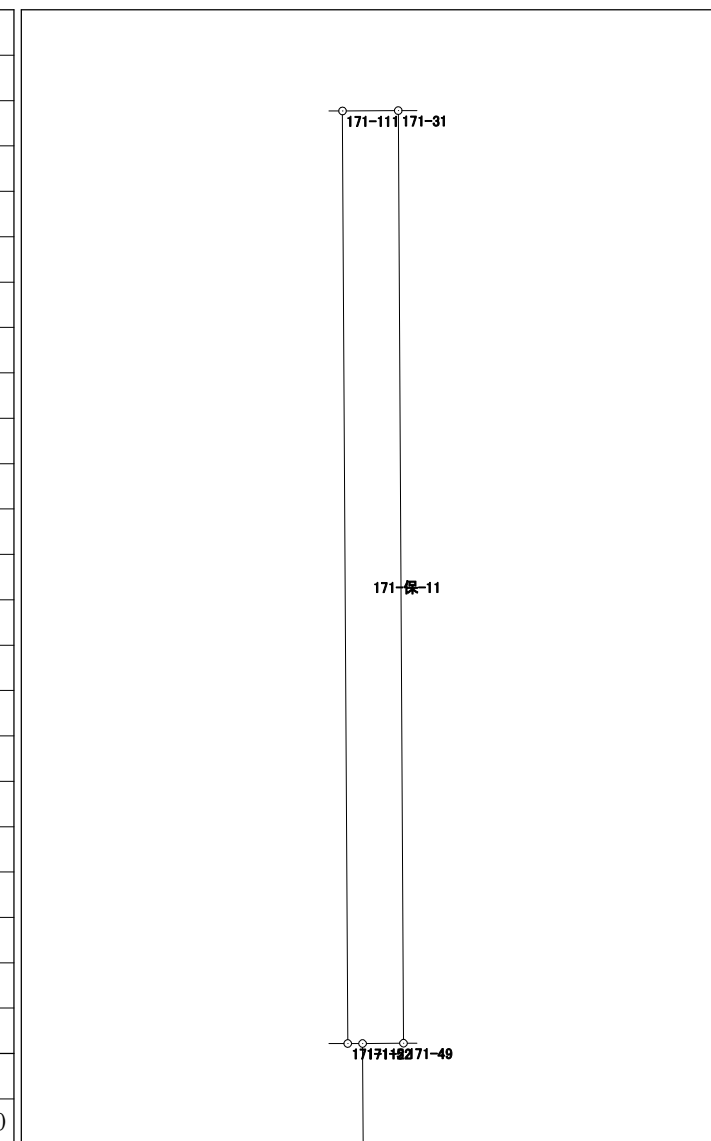


面積計算書（座標法）

世界測地系（測地成果2011）

所 在	地 番	公簿地目	現況地目	地 積	所 有 者
前橋市六供町三丁目	171-保-12			7.00 m ²	

点 名	X 座標	Y 座標	辺 長	方 向 角	測 角	DX	倍 積 (Y×DX)
171-105	40577.260	-67987.938	10.822	359-40-37	90-01-52	10.826	-736037.416788
171-106	40588.082	-67987.999	0.647	269-38-45	89-58-08	10.818	-735494.173182
171-31	40588.078	-67988.646	10.822	179-40-37	90-01-52	-10.826	736045.081596
171-49	40577.256	-67988.585	0.647	89-38-45	89-58-08	-10.818	735500.512530

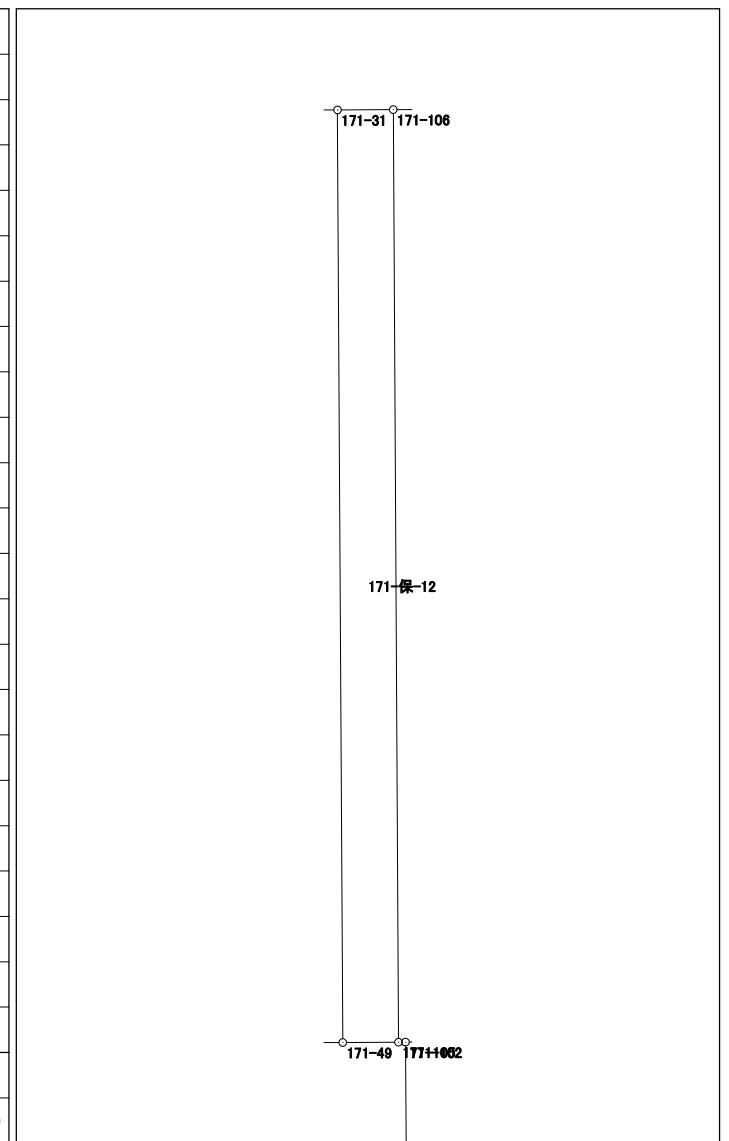

倍面積	14.004156
面 積	7.0020780