



172-2街区 画地出来形確認図 (847.90m²)

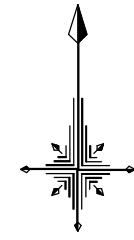

S=1/500

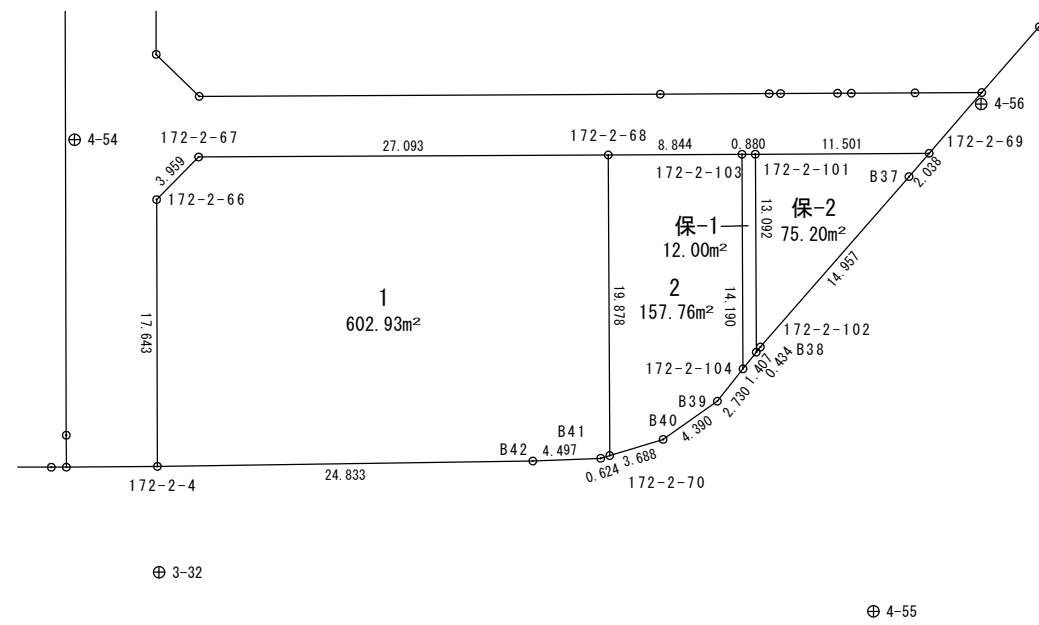


面積計算書（座標法）

世界測地系（測地成果2011）

所 在	地 番	公簿地目	現況地目	地 積	所 有 者
前橋市六供町三丁目	172-2-1			602.93 m ²	

点 名	X 座標	Y 座標	辺 長	方 向 角	測 角	DX	倍 積 (Y×DX)
172-2-67	40483.991	-68023.344	3.959	224-39-44	134-56-44	-2.950	200668.864800
172-2-66	40481.175	-68026.127	17.643	179-49-29	135-09-45	-20.459	1391746.532293
172-2-4	40463.532	-68026.073	24.833	89-10-59	89-21-30	-17.289	1176102.776097
B42	40463.886	-68001.243	4.497	87-42-21	178-31-22	0.534	-36312.663762
B41	40464.066	-67996.750	0.624	73-08-01	165-25-40	0.361	-24546.826750
172-2-70	40464.247	-67996.153	19.878	359-43-03	106-35-02	20.059	-1363934.833027
172-2-68	40484.125	-67996.251	27.093	269-43-00	89-59-57	19.744	-1342517.979744

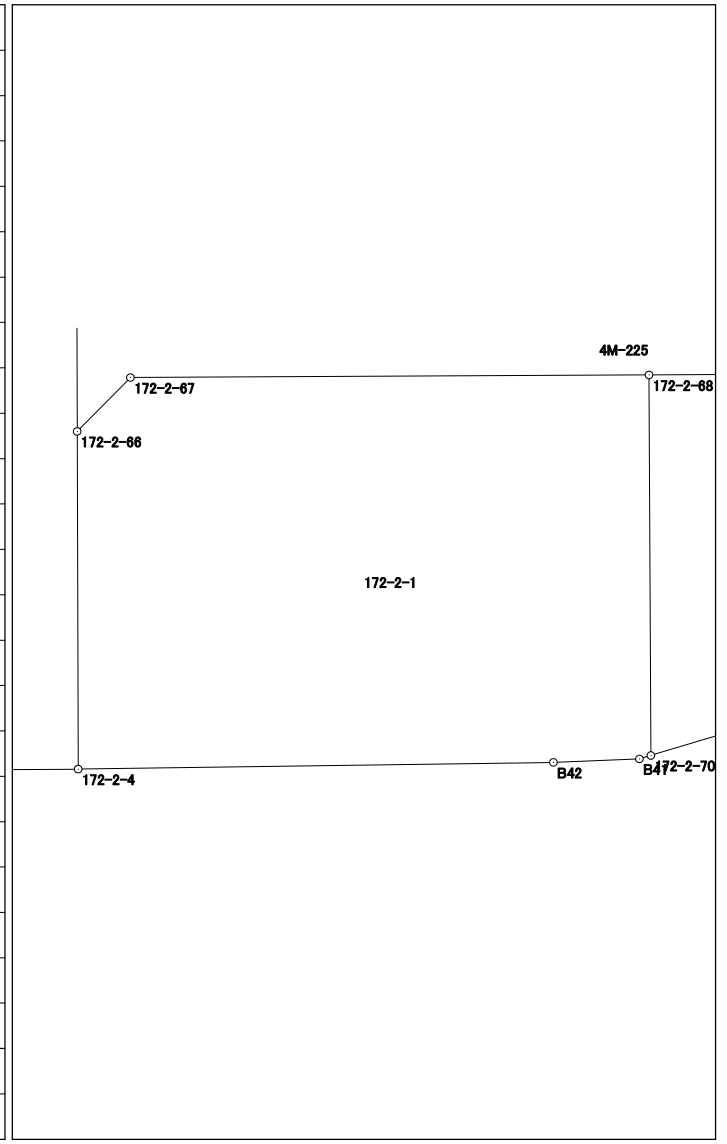


倍面積	1205.869907
面 積	602.9349535

面積計算書 (座標法)

世界測地系 (測地成果2011)

所 在	地 番	公簿地目	現況地目	地 積	所 有 者
前橋市六供町三丁目	172-2-2			157.76 m ²	

点 名	X 座標	Y 座標	辺 長	方 向 角	測 角	DX	倍 積 (Y×DX)
172-2-104	40469.981	-67987.336	14.190	359-42-48	141-15-24	16.328	-1110097.222208
172-2-103	40484.171	-67987.407	8.844	269-42-07	89-59-19	14.144	-961613.884608
172-2-68	40484.125	-67996.251	19.878	179-43-03	90-00-56	-19.924	1354757.304924
172-2-70	40464.247	-67996.153	3.688	73-10-01	73-26-58	-18.810	1279007.637930
B40	40465.315	-67992.623	4.390	54-50-24	161-40-23	3.596	-244501.472308
B39	40467.843	-67989.034	2.730	38-27-24	163-37-00	4.666	-317236.832644

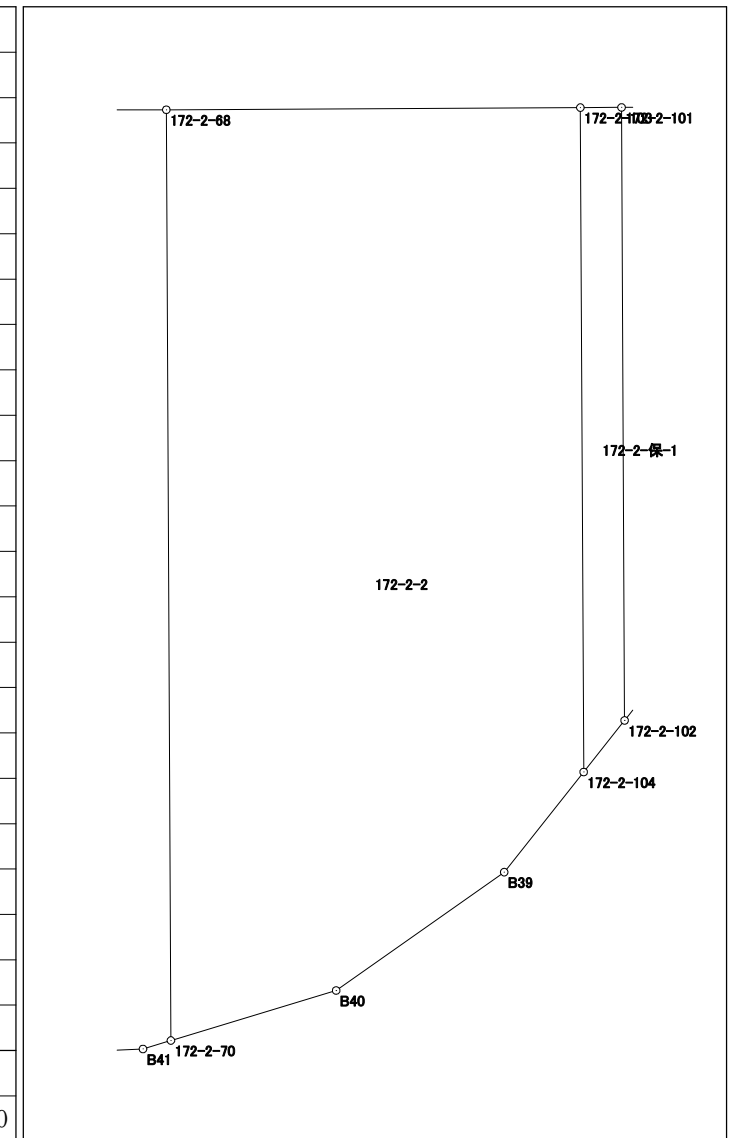

倍面積	315.531086
面 積	157.7655430

面積計算書（座標法）

世界測地系（測地成果2011）

所在	地番	公簿地目	現況地目	地積	所有者
前橋市六供町三丁目	172-2-保-2			75.20 m ²	

点名	X座標	Y座標	辺長	方向角	測角	DX	倍積 (Y×DX)	
172-2-101	40484.175	-67986.527	13.092	179-42-56	90-00-52	-13.152	894158.803104	
172-2-102	40471.083	-67986.462	0.434	38-27-13	38-44-17	-12.752	866963.363424	
B38	40471.423	-67986.192	14.957	41-06-36	182-39-23	11.609	-789251.702928	
B37	40482.692	-67976.358	2.038	40-48-09	179-41-33	12.812	-870913.098696	
172-2-69	40484.235	-67975.026	11.501	269-42-04	48-53-55	1.483	-100806.963558	
						倍面積	150.401346	
						面積	75.2006730	