




176街区 画地出来形確認図 (3654.89m²)

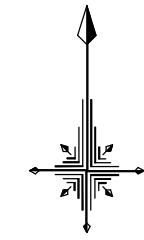

S=1/500

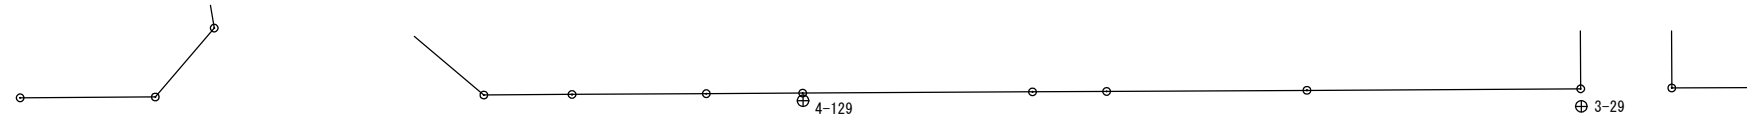

3. 4. 32本町六供線

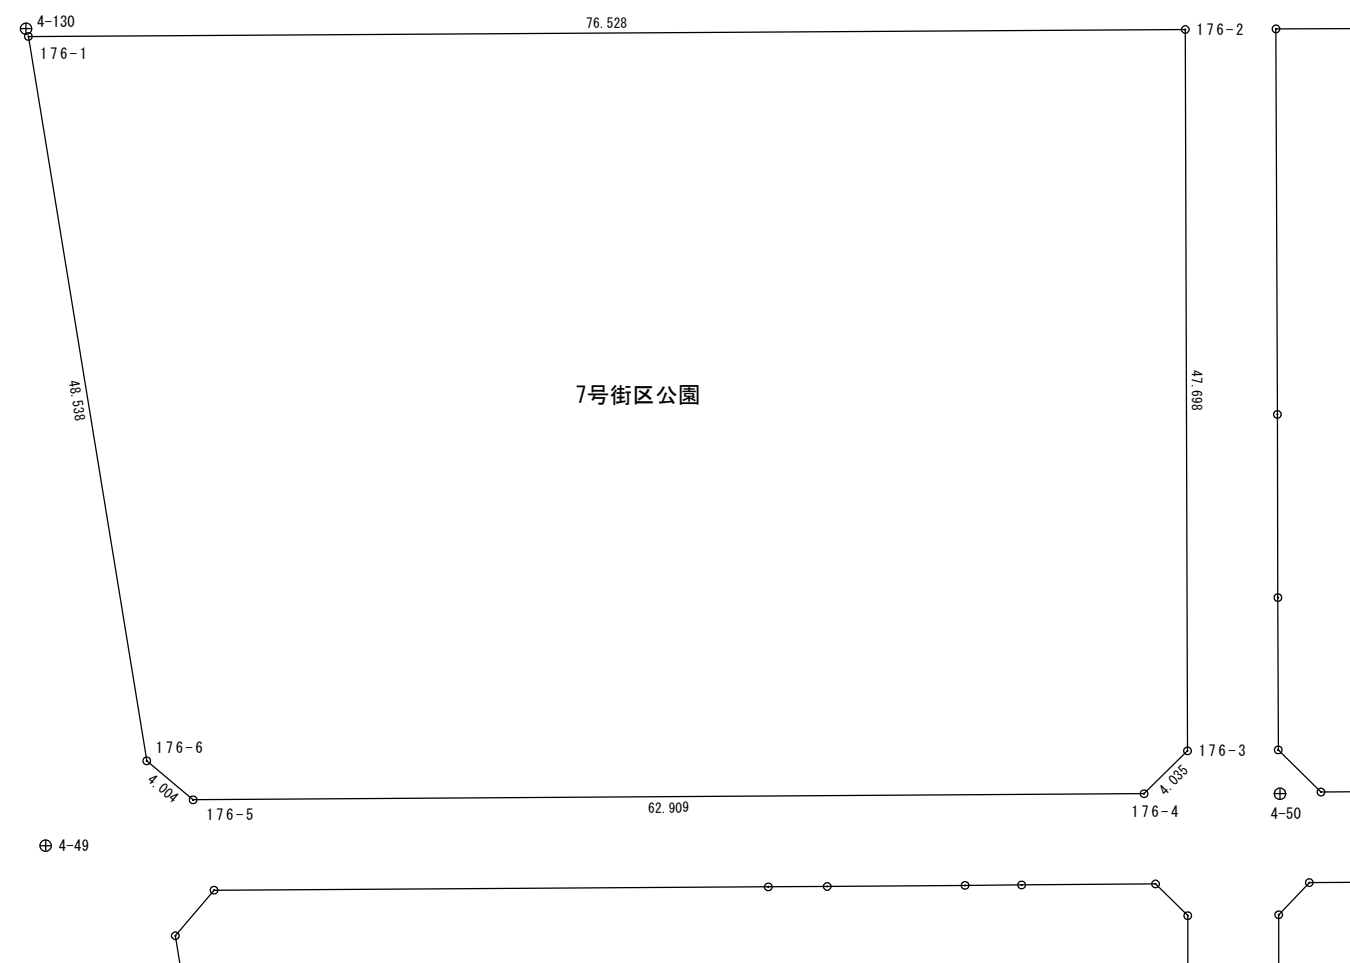


面積計算書 (座標法)

世界測地系 (測地成果2011)

所在	地番	公簿地目	現況地目	地積	所有者
前橋市六供町三丁目	7号街区公園			3654.89 m ²	

点名	X座標	Y座標	辺長	方向角	測角	Dx	倍積 (Y×Dx)
176-1	40643.790	-68109.150	48.538	170-43-00	81-03-37	-48.361	3293826.603150
176-6	40595.888	-68101.320	4.004	130-03-57	139-20-57	-50.479	3437686.532280
176-5	40593.311	-68098.256	62.909	89-37-55	139-33-58	-2.173	147977.510288
176-4	40593.715	-68035.348	4.035	45-20-29	135-42-34	3.240	-220434.527520
176-3	40596.551	-68032.478	47.698	359-49-33	134-29-04	50.534	-3437953.243252
176-2	40644.249	-68032.623	76.528	269-39-23	89-49-50	47.239	-3213793.077897

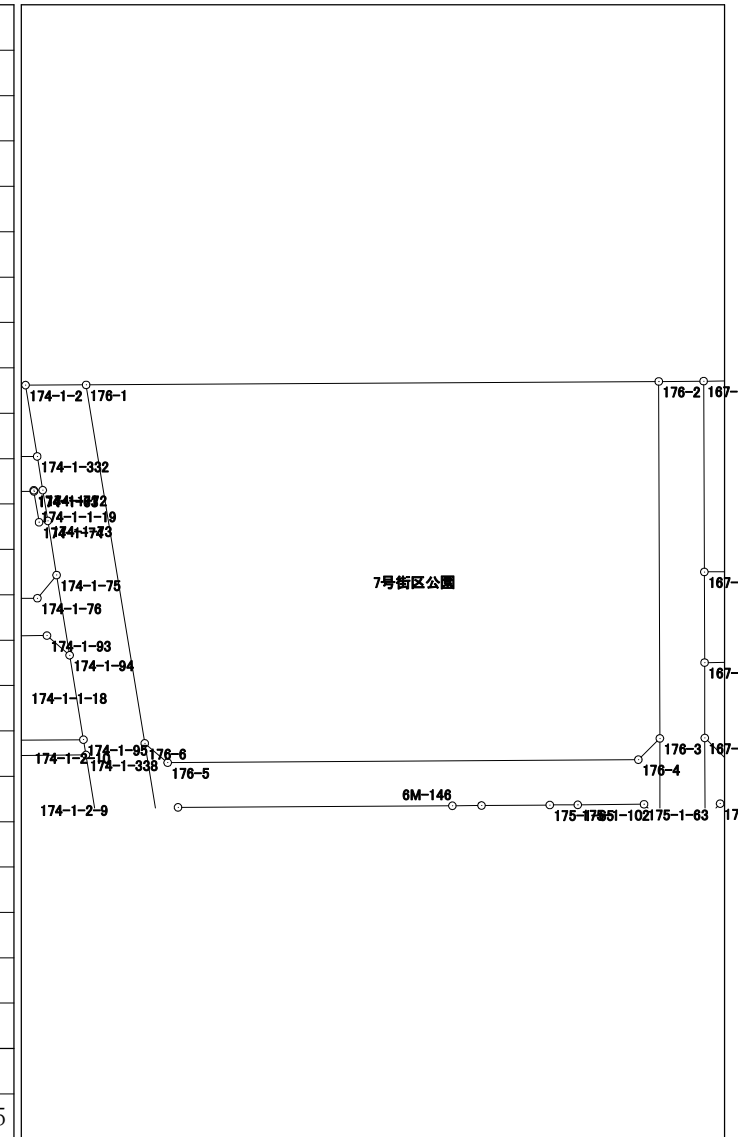

倍面積	7309.797049
面積	3654.8985245