




# 177-2街区 画地出来形確認図 (2511.61m<sup>2</sup>)

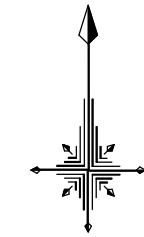

S=1/500

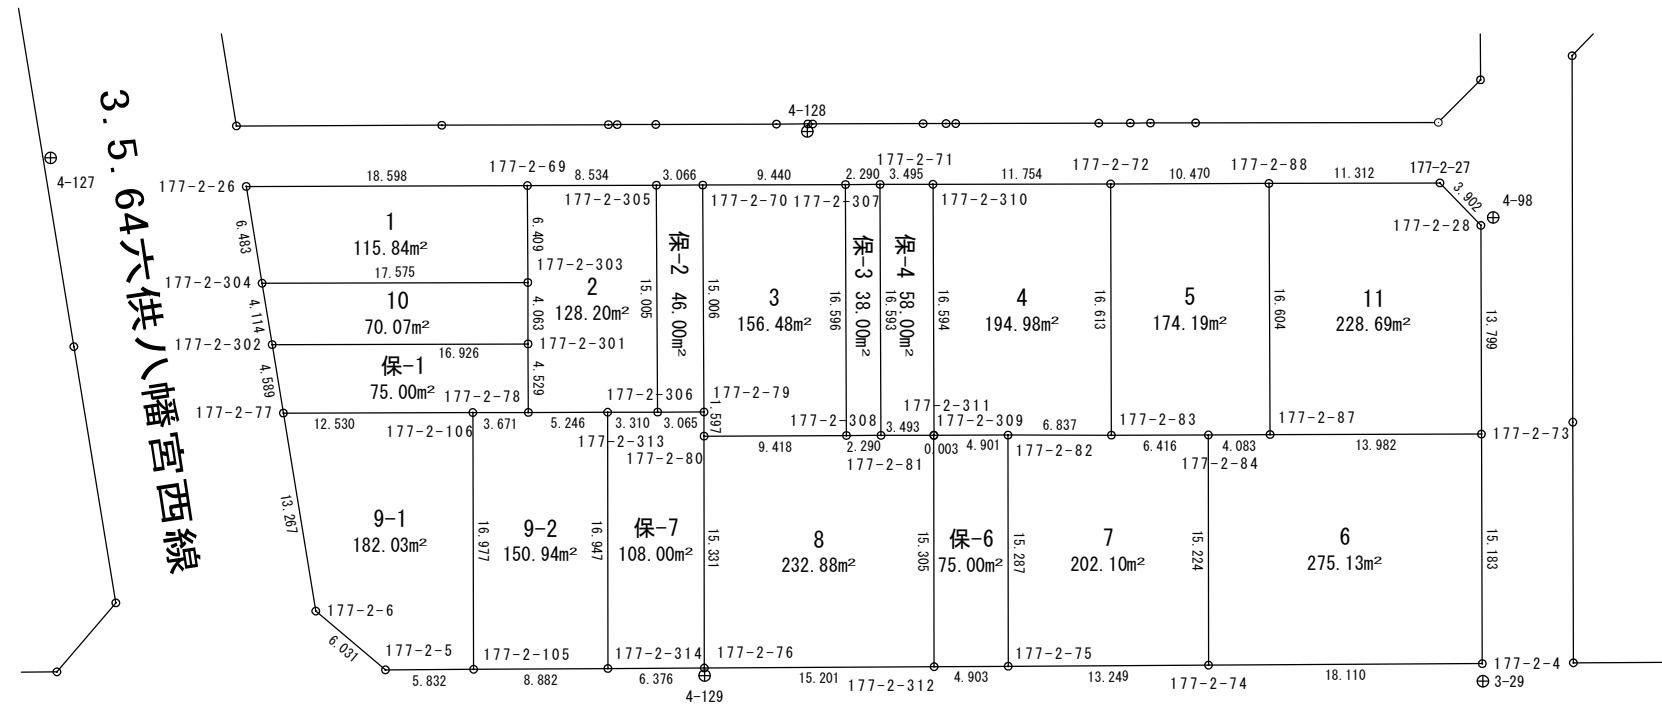

⊕ 4-131

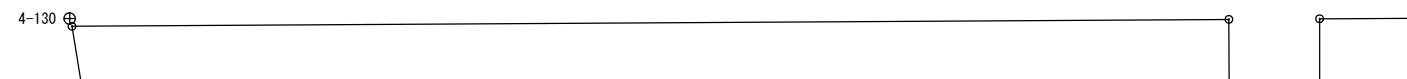






# 面積計算書 (座標法)

世界測地系 (測地成果2011)

所在	地番	公簿地目	現況地目	地積	所有者
前橋市六供町三丁目	177-2-3			156.48 m <sup>2</sup>	

点名	X座標	Y座標	辺長	方向角	測角	DX	倍積 (Y×DX)
177-2-308	40675.319	-68074.788	16.596	359-46-57	90-01-33	16.636	-1132492.173168
177-2-307	40691.915	-68074.851	9.440	269-47-59	90-01-02	16.563	-1127523.757113
177-2-70	40691.882	-68084.291	15.006	179-41-27	89-53-28	-15.039	1023919.652349
177-2-79	40676.876	-68084.210	1.597	179-51-23	180-09-56	-16.603	1130402.138630
177-2-80	40675.279	-68084.206	9.418	89-45-24	89-54-01	-1.557	106007.108742
						倍面積	312.969440
						面積	156.4847200

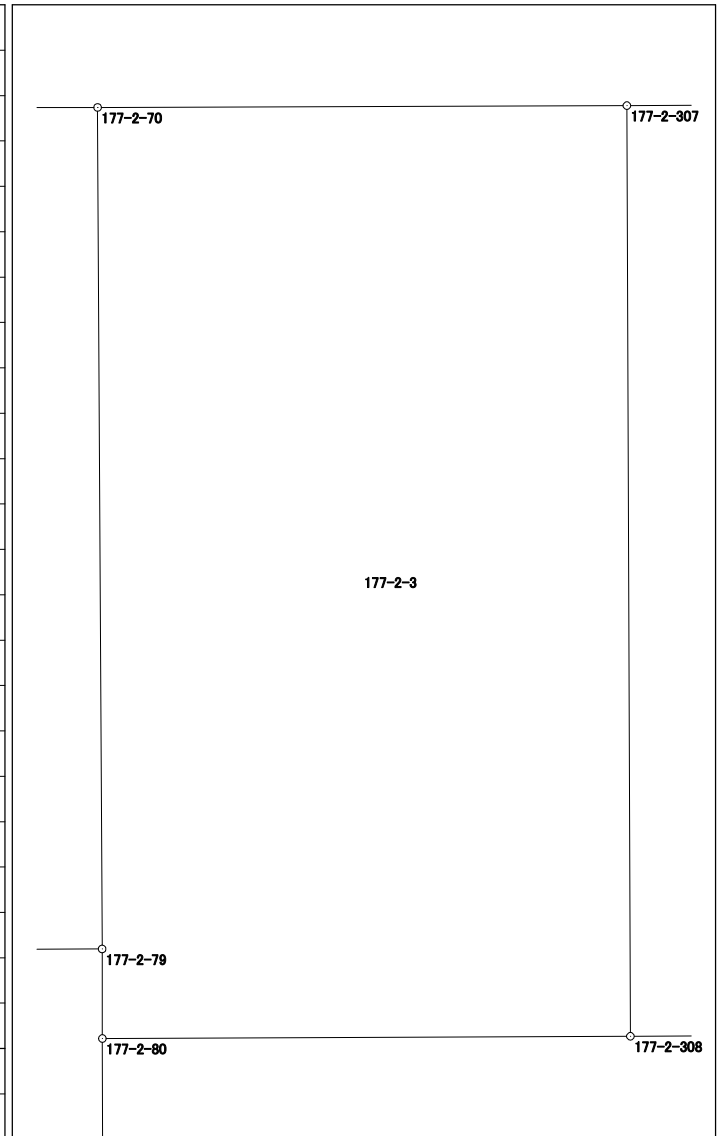


# 面積計算書 (座標法)

世界測地系 (測地成果2011)

所在	地番	公簿地目	現況地目	地積	所有者
前橋市六供町三丁目	177-2-4			194.98 m <sup>2</sup>	

点名	X座標	Y座標	辺長	方向角	測角	DX	倍積 (Y×DX)
177-2-310	40691.931	-68069.066	16.594	179-46-44	89-54-38	-16.621	1131375.945986
177-2-309	40675.337	-68069.002	4.901	89-52-59	90-06-15	-16.584	1128856.329168
177-2-82	40675.347	-68064.101	6.837	90-01-00	180-08-01	0.008	-544.512808
177-2-83	40675.345	-68057.264	16.613	359-50-04	89-49-04	16.611	-1130499.212304
177-2-72	40691.958	-68057.312	11.754	269-52-06	90-02-02	16.586	-1128798.576832

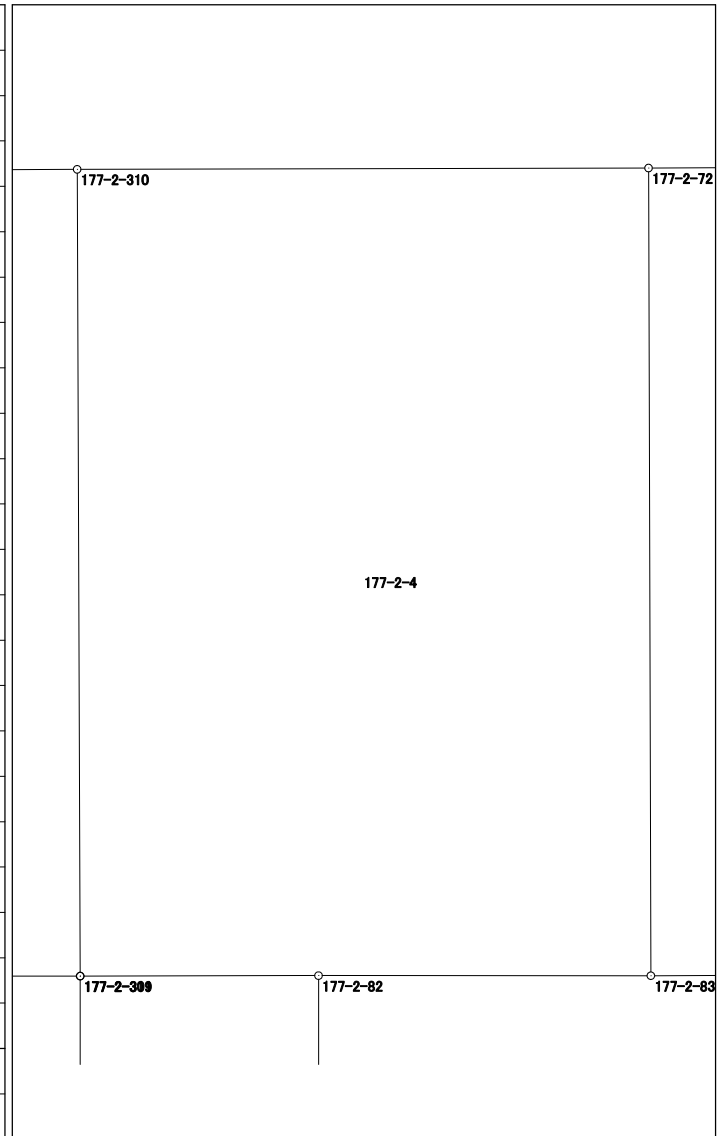


# 面積計算書（座標法）

世界測地系（測地成果2011）

所在	地番	公簿地目	現況地目	地積	所有者
前橋市六供町三丁目	177-2-5			174.19 m <sup>2</sup>	

点名	X座標	Y座標	辺長	方向角	測角	Dx	倍積 (Y×Dx)
177-2-72	40691.958	-68057.312	16.613	179-50-04	90-00-34	-16.645	1132813.958240
177-2-83	40675.345	-68057.264	6.416	89-53-02	90-02-58	-16.600	1129750.582400
177-2-84	40675.358	-68050.848	4.083	89-36-26	179-43-24	0.041	-2790.084768
177-2-87	40675.386	-68046.765	16.604	359-44-03	90-07-37	16.632	-1131753.795480
177-2-88	40691.990	-68046.842	10.470	269-49-30	90-05-27	16.572	-1127672.265624
倍面積							348.394768
面積							174.1973840

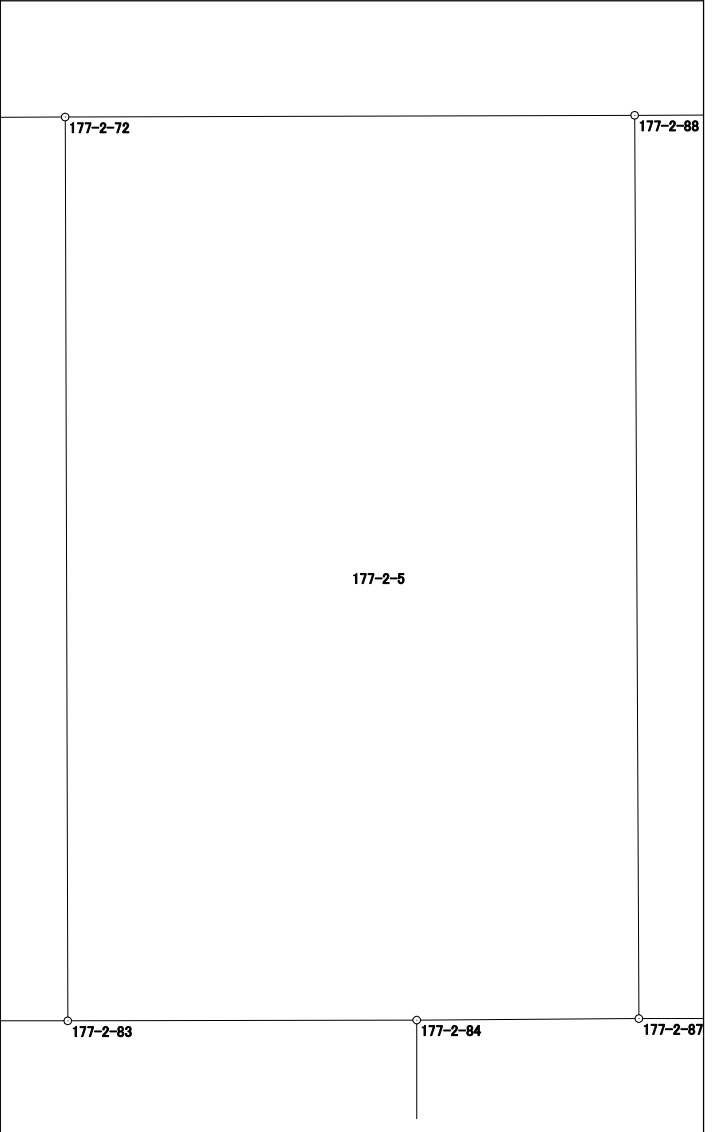


## 面積計算書（座標法）

世界測地系（測地成果2011）

所 在	地 番	公簿地目	現況地目	地 積	所 有 者
前橋市六供町三丁目	177-2-6			275.13 m <sup>2</sup>	

点 名	X 座標	Y 座標	辺 長	方 向 角	測 角	DX	倍 積 (Y×DX)
177-2-84	40675.358	-68050.848	15.224	179-57-45	90-21-19	-15.252	1037911.533696
177-2-74	40660.134	-68050.838	18.110	89-41-12	89-43-27	-15.125	1029268.924750
177-2-4	40660.233	-68032.728	15.183	359-47-33	90-06-21	15.282	-1039676.149296
177-2-73	40675.416	-68032.783	13.982	269-52-37	90-05-04	15.153	-1030900.760799
177-2-87	40675.386	-68046.765	4.083	269-36-26	179-43-49	-0.058	3946.712370

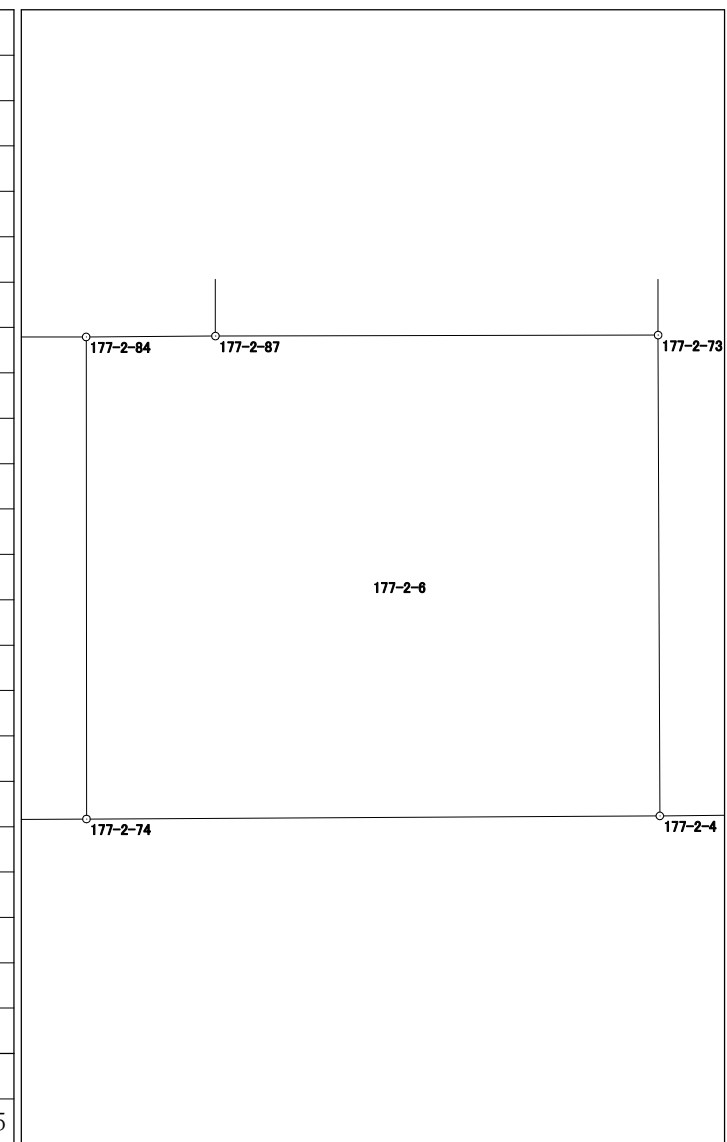

倍面積	550.260721
面 積	275.1303605

# 面積計算書 (座標法)

世界測地系 (測地成果2011)

所在	地番	公簿地目	現況地目	地積	所有者
前橋市六供町三丁目	177-2-7			202.10 m <sup>2</sup>	

点名	X座標	Y座標	辺長	方向角	測角	DX	倍積 (Y×DX)		
177-2-82	40675.347	-68064.101	15.287	179-56-51	89-55-51	-15.285	1040359.783785		
177-2-75	40660.060	-68064.087	13.249	89-40-48	89-43-57	-15.213	1035458.955531		
177-2-74	40660.134	-68050.838	15.224	359-57-45	90-16-57	15.298	-1041041.719724		
177-2-84	40675.358	-68050.848	6.416	269-53-02	89-55-17	15.211	-1035121.448928		
177-2-83	40675.345	-68057.264	6.837	270-01-00	180-07-58	-0.011	748.629904		
倍面積							404.200568		
面積							202.1002840		



# 面積計算書 (座標法)

世界測地系 (測地成果2011)

所在	地番	公簿地目	現況地目	地積	所有者
前橋市六供町三丁目	177-2-8			232.88 m <sup>2</sup>	


点名	X座標	Y座標	辺長	方向角	測角	DX	倍積 (Y×DX)	
177-2-312	40660.032	-68068.990	15.305	359-56-38	90-15-38	15.389	-1047513.687110	
177-2-311	40675.337	-68069.005	3.493	269-52-08	89-55-30	15.297	-1041251.569485	
177-2-81	40675.329	-68072.498	2.290	269-44-59	179-52-51	-0.018	1225.304964	
177-2-308	40675.319	-68074.788	9.418	269-45-24	180-00-25	-0.050	3403.739400	
177-2-80	40675.279	-68084.206	15.331	179-56-38	90-11-14	-15.371	1046522.330426	
177-2-76	40659.948	-68084.191	15.201	89-41-00	89-44-22	-15.247	1038079.660177	
						倍面積	465.778372	
						面積	232.8891860	

# 面積計算書 (座標法)

世界測地系 (測地成果2011)

所在	地番	公簿地目	現況地目	地積	所有者
前橋市六供町三丁目	177-2-9-1			182.03 m <sup>2</sup>	


点名	X座標	Y座標	辺長	方向角	測角	DX	倍積 (Y×DX)
177-2-77	40676.804	-68112.032	13.267	170-42-47	80-52-23	-13.128	894174.756096
177-2-6	40663.711	-68109.891	6.031	130-09-04	139-26-17	-16.982	1156642.168962
177-2-5	40659.822	-68105.281	5.832	89-36-25	139-27-21	-3.849	262137.226569
177-2-105	40659.862	-68099.449	16.977	359-49-16	90-12-51	17.017	-1158848.323633
177-2-106	40676.839	-68099.502	12.530	269-50-24	90-01-08	16.942	-1153741.762884
						倍面積	364.065110
						面積	182.032550

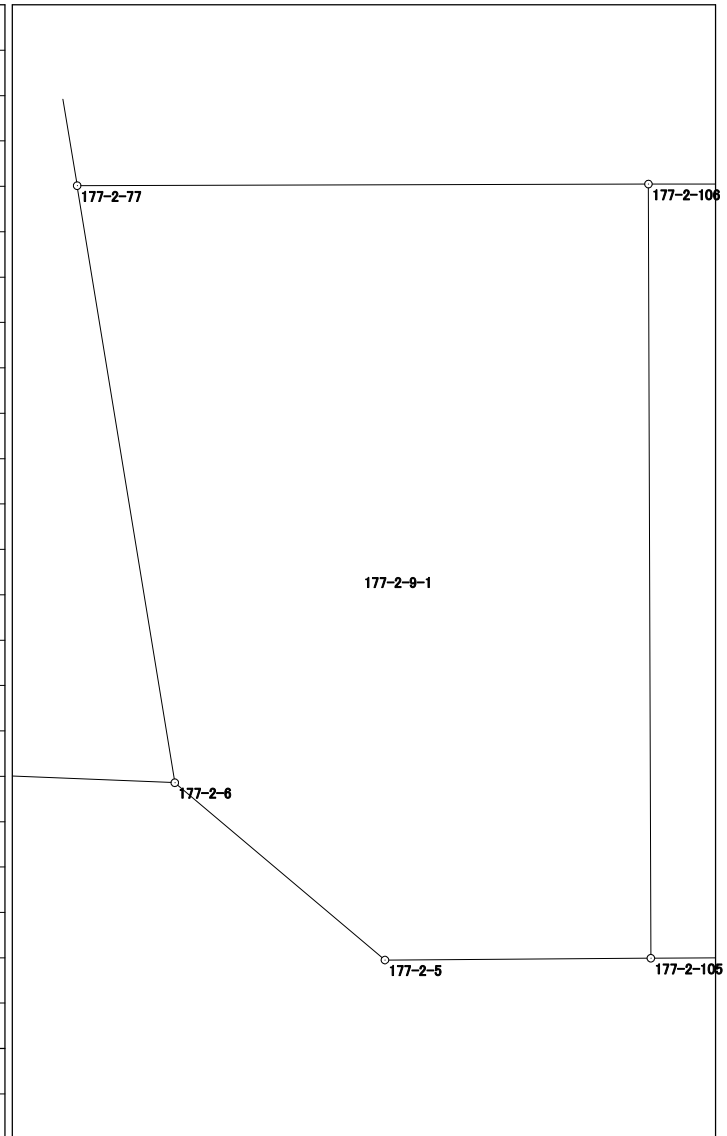

# 面積計算書（座標法）

世界測地系（測地成果2011）


所 在	地 番	公簿地目	現況地目	地 積	所 有 者
前橋市六供町三丁目	177-2-9-2			150.94 m <sup>2</sup>	

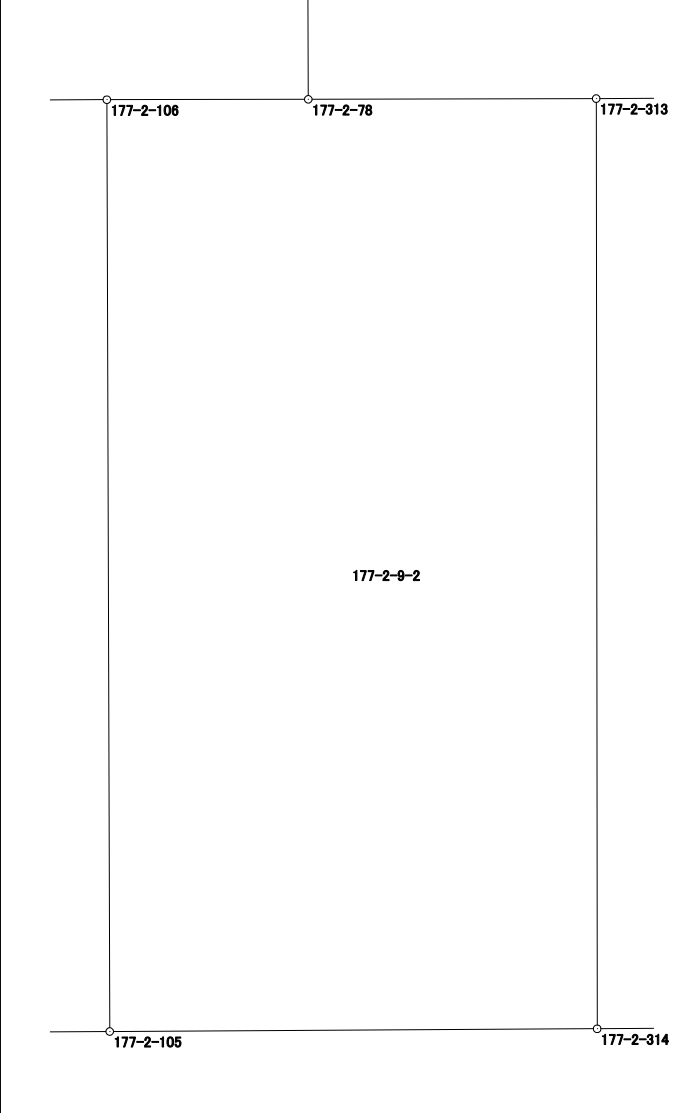点 名	X 座標	Y 座標	辺 長	方 向 角	測 角	DX	倍 積 (Y×DX)		
177-2-314	40659.912	-68090.567	16.947	359-56-21	90-15-42	16.997	-1157335.367299		
177-2-313	40676.859	-68090.585	5.246	269-51-29	89-55-08	16.934	-1153045.966390		
177-2-78	40676.846	-68095.831	3.671	269-53-27	180-01-58	-0.020	1361.916620		
177-2-106	40676.839	-68099.502	16.977	179-49-16	89-55-49	-16.984	1156601.941968		
177-2-105	40659.862	-68099.449	8.882	89-40-39	89-51-23	-16.927	1152719.373223		
							倍面積	301.898122	
							面 積	150.9490610	

# 面積計算書 (座標法)

世界測地系 (測地成果2011)


所 在	地 番	公簿地目	現況地目	地 積	所 有 者
前橋市六供町三丁目	177-2-10			70.07 m <sup>2</sup>	

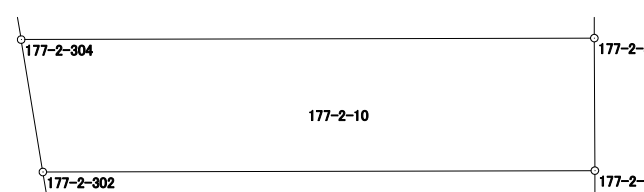点 名	X 座標	Y 座標	辺 長	方 向 角	測 角	DX	倍 積 (Y×DX)	
177-2-303	40685.438	-68095.865	17.575	269-51-00	90-04-32	4.017	-273541.089705	
177-2-304	40685.392	-68113.440	4.114	170-41-53	80-50-53	-4.106	279673.784640	
177-2-302	40681.332	-68112.775	16.926	89-51-16	99-09-23	-4.017	273609.017175	
177-2-301	40681.375	-68095.849	4.063	359-46-28	89-55-12	4.106	-279601.555994	
						倍面積	140.156116	
						面 積	70.0780580	

# 面積計算書 (座標法)

世界測地系 (測地成果2011)

所 在	地 番	公簿地目	現況地目	地 積	所 有 者
前橋市六供町三丁目	177-2-11			228.69 m <sup>2</sup>	

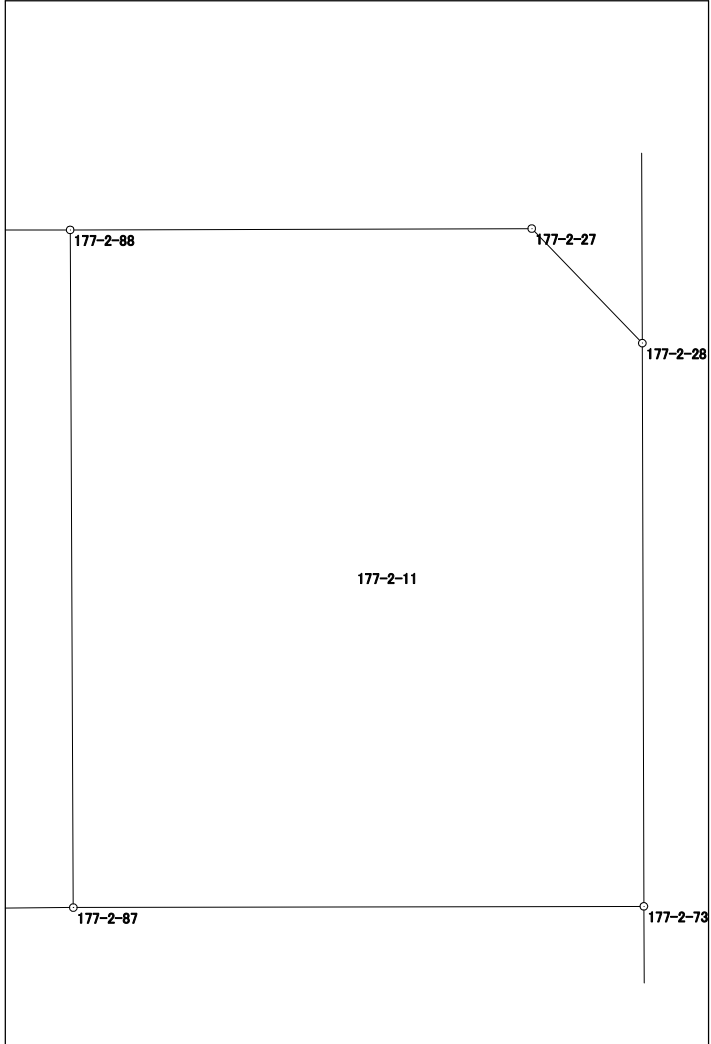点 名	X 座標	Y 座標	辺 長	方 向 角	測 角	DX	倍 積 (Y×DX)	
177-2-88	40691.990	-68046.842	16.604	179-44-03	89-54-05	-16.637	1132095.310354	
177-2-87	40675.386	-68046.765	13.982	89-52-37	90-08-34	-16.574	1127807.083110	
177-2-73	40675.416	-68032.783	13.799	359-50-47	89-58-10	13.829	-940825.356107	
177-2-28	40689.215	-68032.820	3.902	316-01-03	136-10-16	16.607	-1129821.041740	
177-2-27	40692.023	-68035.530	11.312	269-49-58	133-48-55	2.775	-188798.595750	
倍面積							457.399867	
面 積							228.6999335	




# 面積計算書（座標法）

世界測地系（測地成果2011）

所 在	地 番	公簿地目	現況地目	地 積	所 有 者
前橋市六供町三丁目	177-2-保-2			46.00 m <sup>2</sup>	

点 名	X 座標	Y 座標	辺 長	方 向 角	測 角	DX	倍 積 (Y×DX)
177-2-305	40691.873	-68087.357	15.005	179-41-13	89-51-18	-15.014	1022263.577998
177-2-306	40676.868	-68087.275	3.065	89-51-02	90-09-49	-14.997	1021104.863175
177-2-79	40676.876	-68084.210	15.006	359-41-27	89-50-25	15.014	-1022216.328940
177-2-70	40691.882	-68084.291	3.066	269-49-55	90-08-28	14.997	-1021060.112127
						倍面積	92.000106
						面 積	46.0000530

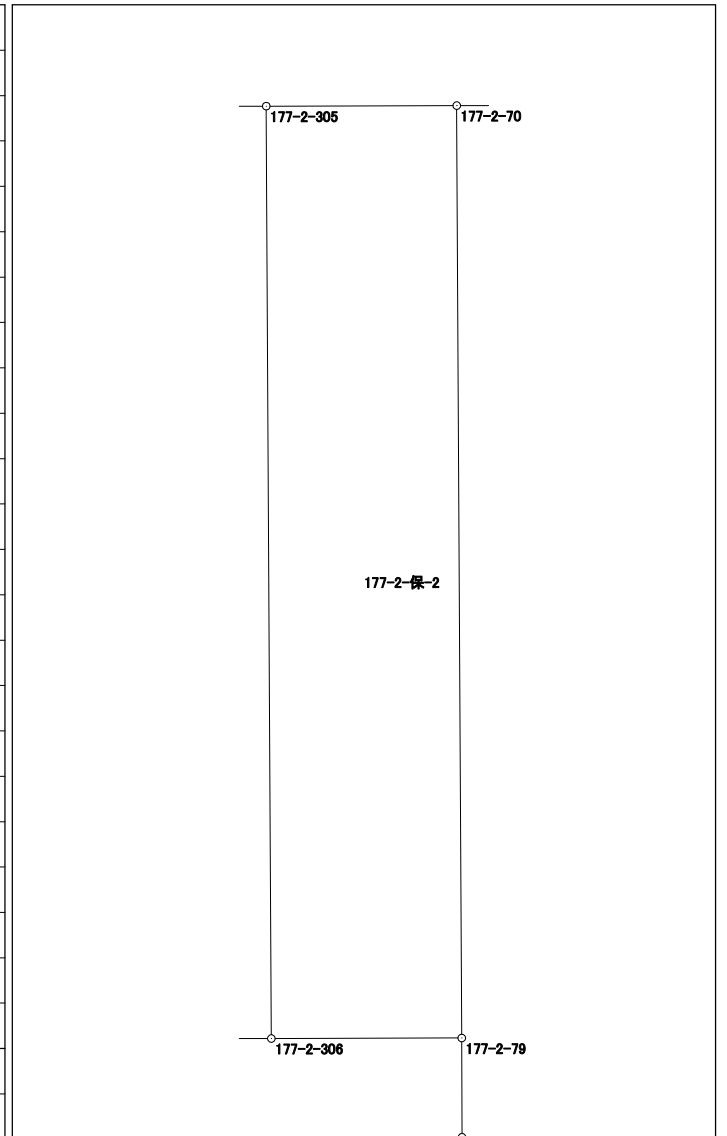


# 面積計算書（座標法）

世界測地系（測地成果2011）

所 在	地 番	公簿地目	現況地目	地 積	所 有 者
前橋市六供町三丁目	177-2-保-3			38.00 m <sup>2</sup>	

点 名	X 座標	Y 座標	辺 長	方 向 角	測 角	DX	倍 積 (Y×DX)
177-2-307	40691.915	-68074.851	16.596	179-46-57	89-57-28	-16.603	1130246.751153
177-2-308	40675.319	-68074.788	2.290	89-44-59	89-58-02	-16.586	1129088.433768
177-2-81	40675.329	-68072.498	16.593	359-46-57	90-01-58	16.603	-1130207.684294
177-2-71	40691.922	-68072.561	2.290	269-49-29	90-02-32	16.586	-1129051.496746
						倍面積	76.003881
						面 積	38.0019405

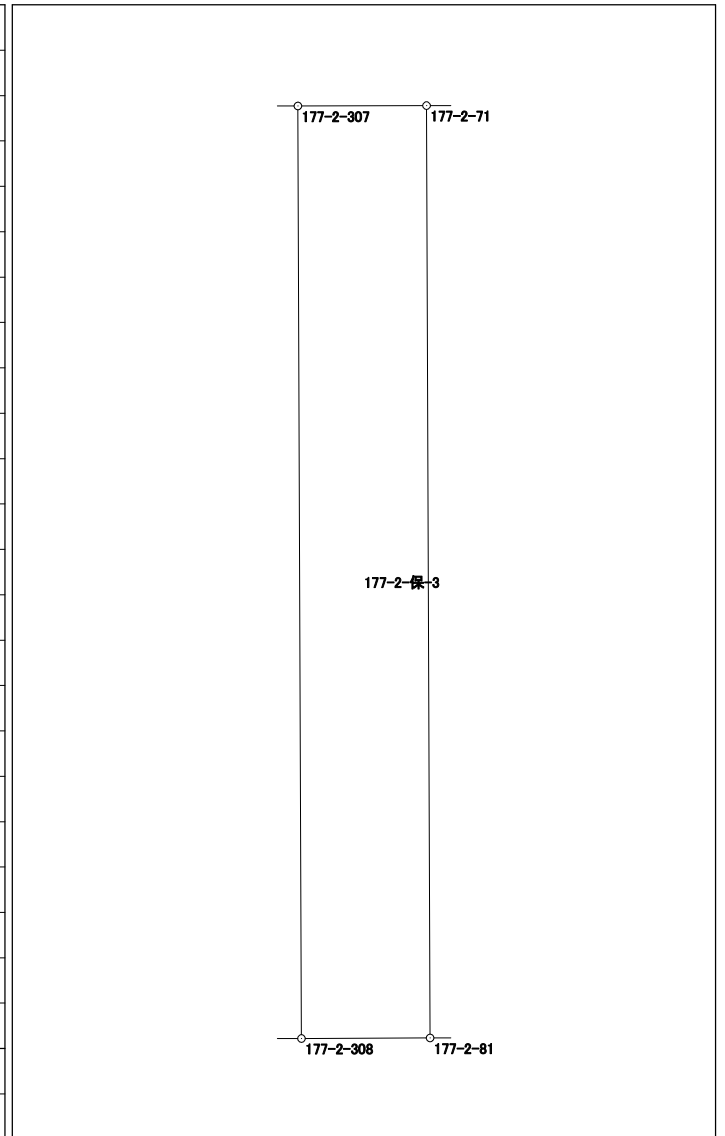




# 面積計算書（座標法）

世界測地系（測地成果2011）

所 在	地 番	公簿地目	現況地目	地 積	所 有 者
前橋市六供町三丁目	177-2-保-4			58.00 m <sup>2</sup>	

点 名	X 座標	Y 座標	辺 長	方 向 角	測 角	DX	倍 積 (Y×DX)
177-2-310	40691.931	-68069.066	3.495	269-51-09	90-04-25	16.585	-1128925.459610
177-2-71	40691.922	-68072.561	16.593	179-46-57	89-55-48	-16.602	1130140.657722
177-2-81	40675.329	-68072.498	3.493	89-52-08	90-05-11	-16.585	1128982.379330
177-2-311	40675.337	-68069.005	0.003	90-00-00	180-07-52	0.008	-544.552040
177-2-309	40675.337	-68069.002	16.594	359-46-44	89-46-44	16.594	-1129537.019188
倍面積						116.006214	
面 積						58.0031070	

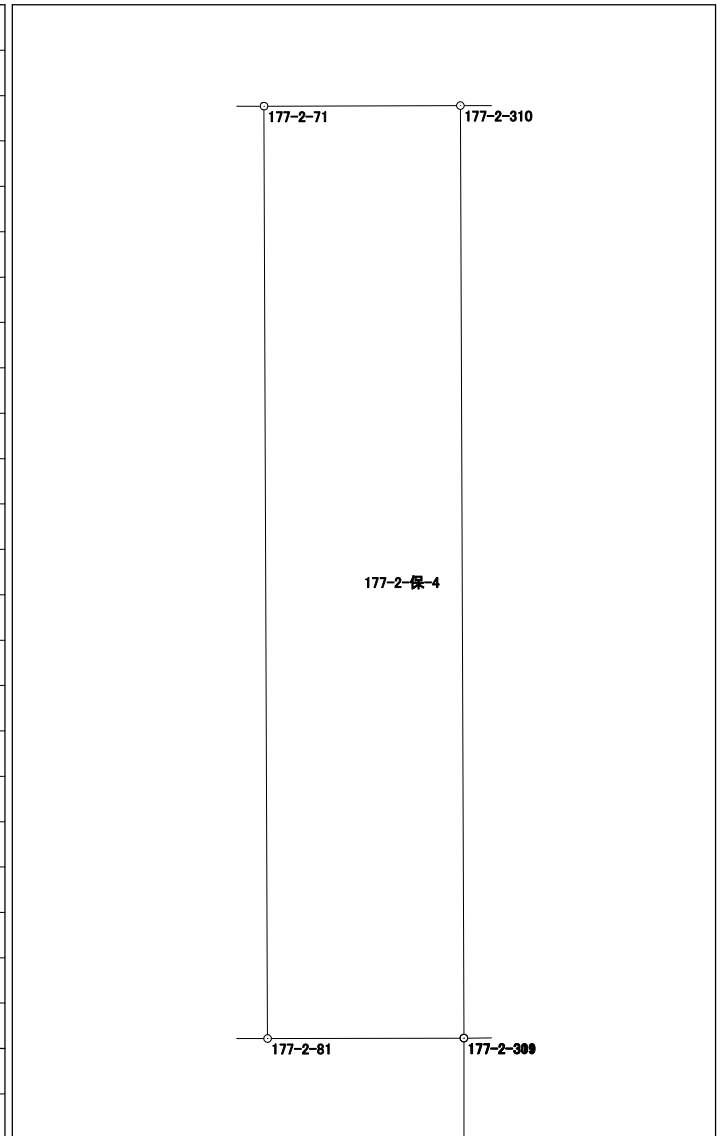



## 面積計算書（座標法）

世界測地系（測地成果2011）

所在	地番	公簿地目	現況地目	地積	所有者
前橋市六供町三丁目	177-2-保-7			108.00 m <sup>2</sup>	

点名	X座標	Y座標	辺長	方向角	測角	DX	倍積 (Y×DX)
177-2-313	40676.859	-68090.585	16.947	179-56-21	90-05-42	-16.956	1154543.959260
177-2-314	40659.912	-68090.567	6.376	89-40-35	89-44-14	-16.911	1151479.578537
177-2-76	40659.948	-68084.191	15.331	359-56-38	90-16-03	15.367	-1046249.763097
177-2-80	40675.279	-68084.206	1.597	359-51-23	179-54-45	16.928	-1152529.439168
177-2-79	40676.876	-68084.210	3.065	269-51-02	89-59-39	1.589	-108185.809690
177-2-306	40676.868	-68087.275	3.310	269-50-39	179-59-37	-0.017	1157.483675
						倍面積	216.009517
						面積	108.0047585

