


179街区 画地出来形確認図 (1147.50m²)

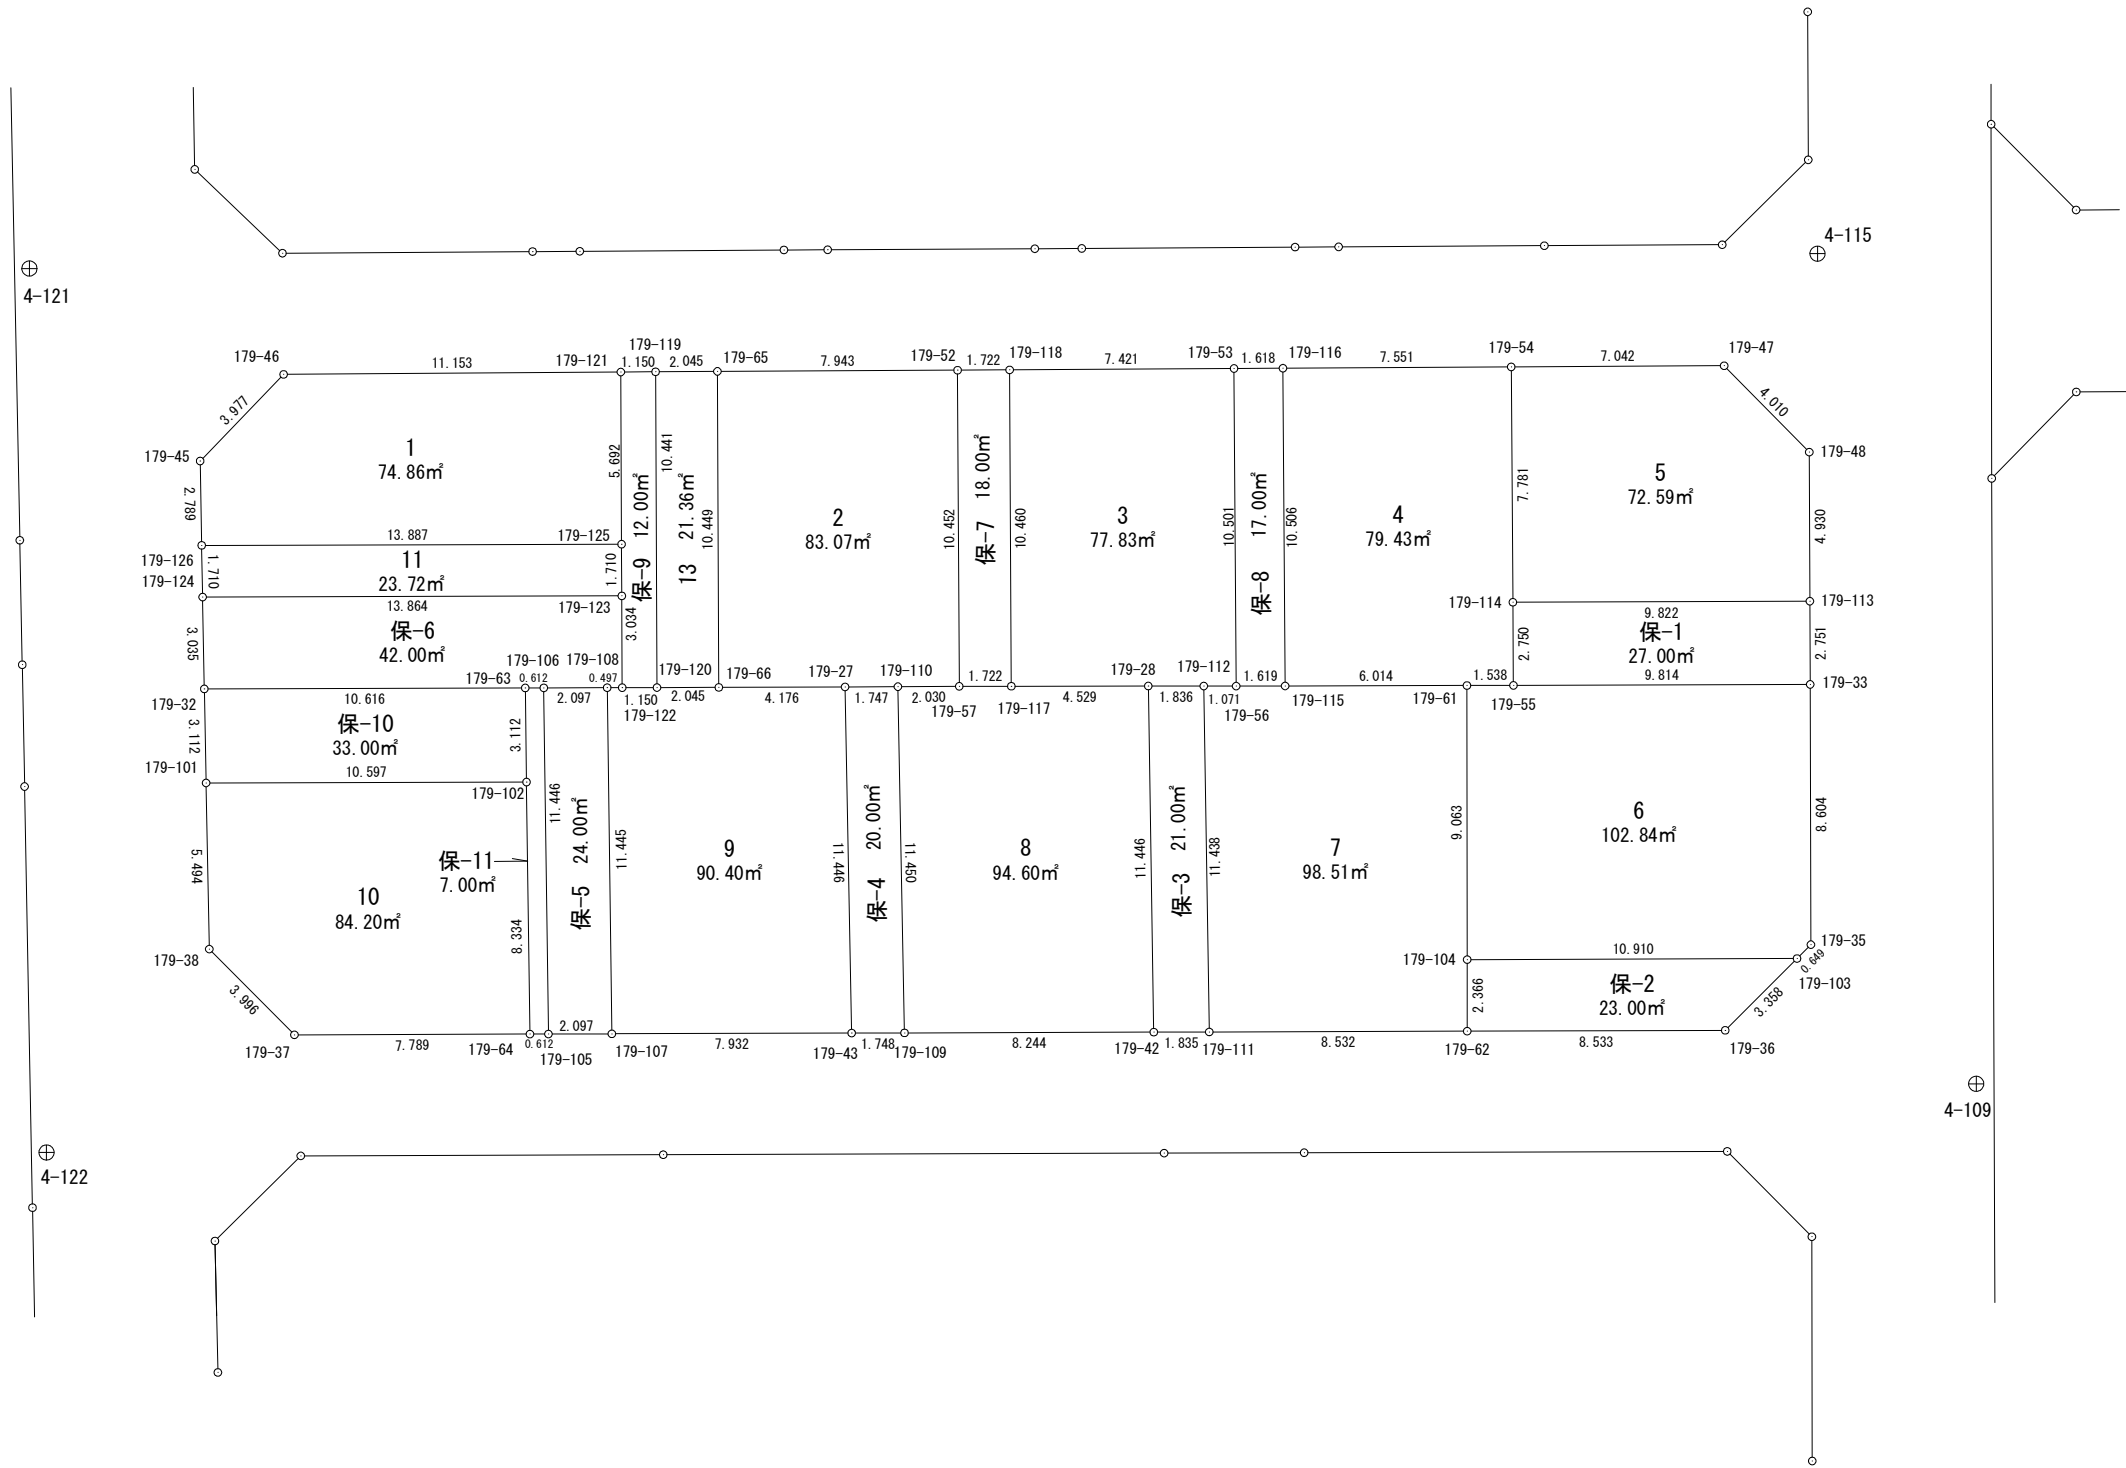

S=1/250




面積計算書（座標法）

世界測地系（測地成果2011）

所在	地番	公簿地目	現況地目	地積	所有者
前橋市六供町三丁目	179-1			74.86 m ²	

点名	X座標	Y座標	辺長	方向角	測角	DX	倍積 (Y×DX)
179-126	40835.740	-68086.439	13.887	89-50-21	90-53-12	-2.750	187237.707250
179-125	40835.779	-68072.552	5.692	359-44-54	89-54-33	5.731	-390123.795512
179-121	40841.471	-68072.577	11.153	269-35-57	89-51-03	5.614	-382159.447278
179-46	40841.393	-68083.730	3.977	223-56-26	134-20-29	-2.942	200302.333660
179-45	40838.529	-68086.490	2.789	178-57-09	135-00-43	-5.653	384892.927970
倍面積						149.726090	
面積						74.8630450	

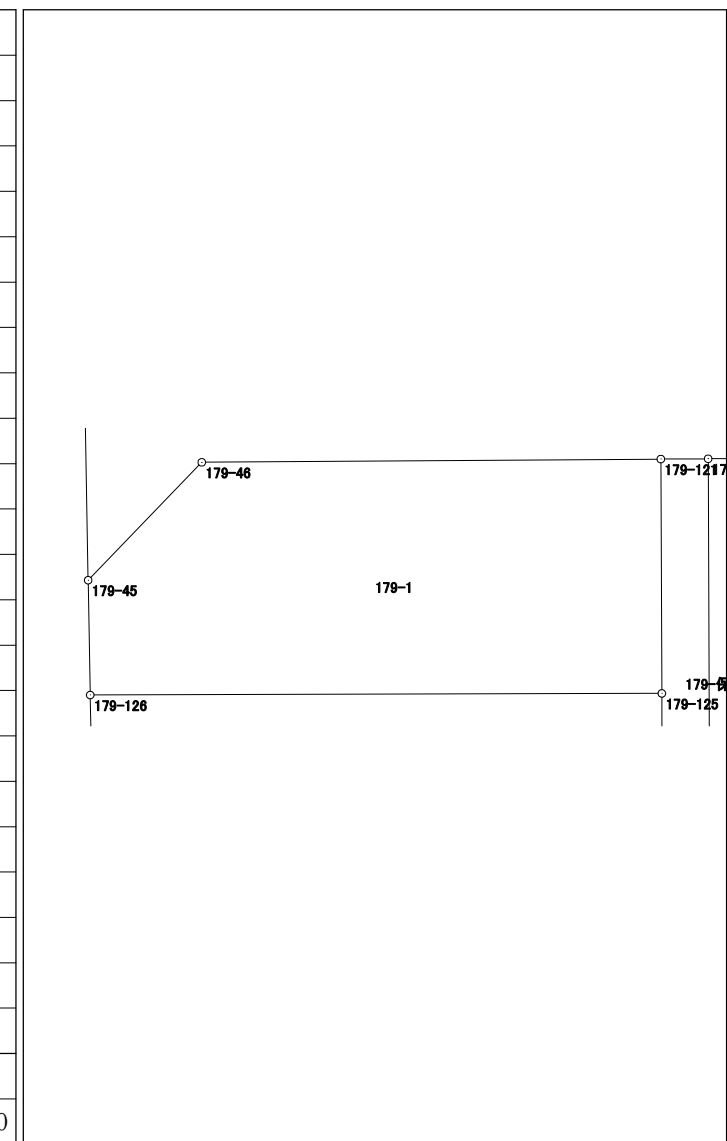


面積計算書 (座標法)

世界測地系 (測地成果2011)

所在	地番	公簿地目	現況地目	地積	所有者
前橋市六供町三丁目	179-2			83.07 m ²	

点名	X座標	Y座標	辺長	方向角	測角	DX	倍積 (Y×DX)	
179-66	40831.044	-68069.336	4.176	89-47-39	90-02-47	-10.434	710235.451824	
179-27	40831.059	-68065.160	1.747	89-42-17	179-54-38	0.024	-1633.563840	
179-110	40831.068	-68063.413	2.030	89-41-22	179-59-05	0.020	-1361.268260	
179-57	40831.079	-68061.383	10.452	359-41-35	90-00-13	10.463	-712126.250329	
179-52	40841.531	-68061.439	7.943	269-43-33	90-01-58	10.414	-708791.825746	
179-65	40841.493	-68069.382	10.449	179-44-52	90-01-19	-10.487	713843.609034	
							倍面積	166.152683
							面積	83.0763415

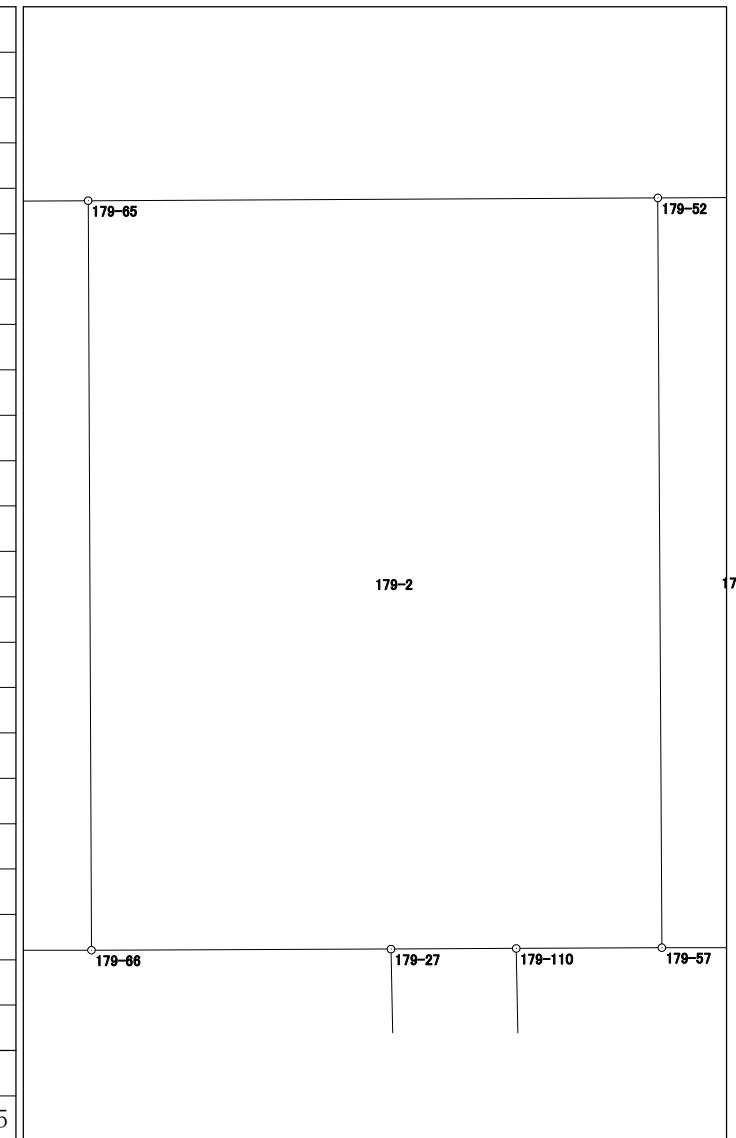


面積計算書（座標法）

世界測地系（測地成果2011）

所在	地番	公簿地目	現況地目	地積	所有者
前橋市六供町三丁目	179-3			77.83 m ²	

点名	X座標	Y座標	辺長	方向角	測角	DX	倍積(Y×DX)
179-117	40831.082	-68059.661	4.529	89-53-56	90-12-20	-10.452	711359.576772
179-28	40831.090	-68055.132	1.836	90-03-45	180-09-49	0.006	-408.330792
179-112	40831.088	-68053.296	1.071	90-03-13	179-59-28	-0.003	204.159888
179-56	40831.087	-68052.225	10.501	359-36-45	89-33-32	10.500	-714548.362500
179-53	40841.588	-68052.296	7.421	269-38-41	90-01-56	10.455	-711486.754680
179-118	40841.542	-68059.717	10.460	179-41-36	90-02-55	-10.506	715035.386802

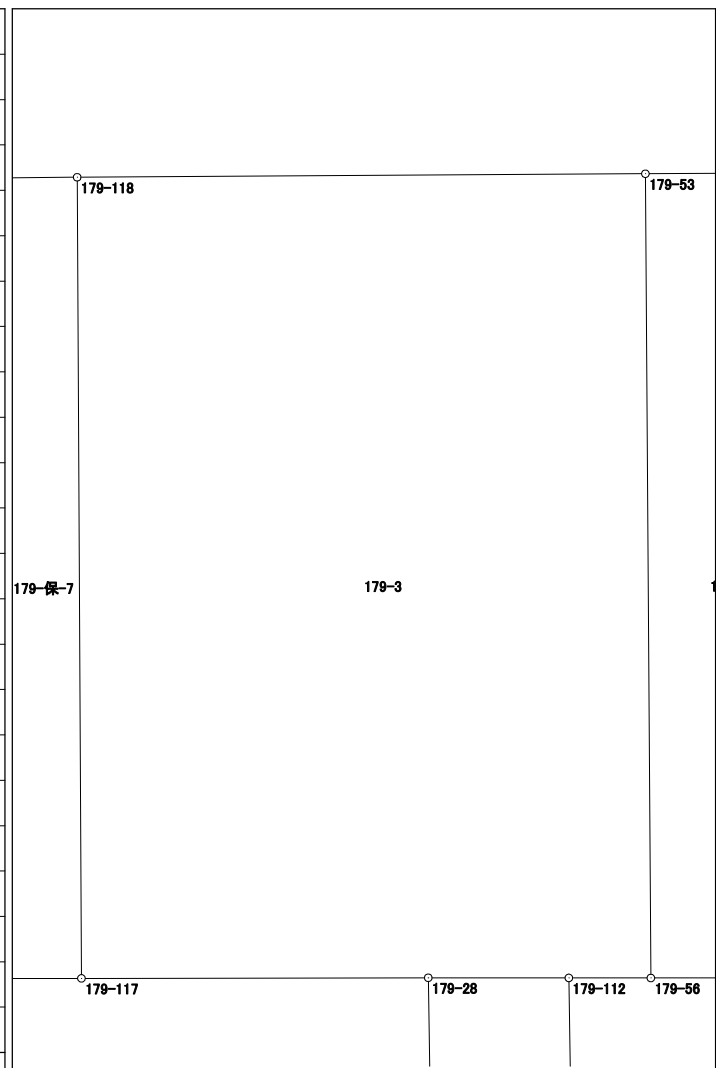

倍面積	155.675490
面積	77.8377450

面積計算書 (座標法)

世界測地系 (測地成果2011)

所 在	地 番	公簿地目	現況地目	地 積	所 有 者
前橋市六供町三丁目	179-4			79.43 m ²	


点 名	X 座標	Y 座標	辺 長	方 向 角	測 角	DX	倍 積 (Y×DX)	
179-115	40831.091	-68050.606	6.014	89-51-26	90-15-00	-10.491	713918.907546	
179-61	40831.106	-68044.592	1.538	89-53-18	180-01-52	0.018	-1224.802656	
179-55	40831.109	-68043.054	2.750	359-36-15	89-42-57	2.753	-187322.527662	
179-114	40833.859	-68043.073	7.781	359-36-09	179-59-54	10.531	-716561.601763	
179-54	40841.640	-68043.127	7.551	269-40-25	90-04-16	7.738	-526517.716726	
179-116	40841.597	-68050.678	10.506	179-36-26	89-56-01	-10.549	717866.602222	
							倍面積	158.860961
							面 積	79.4304805

面積計算書 (座標法)

世界測地系 (測地成果2011)

所在	地番	公簿地目	現況地目	地積	所有者
前橋市六供町三丁目	179-5			72.59 m ²	

点名	X座標	Y座標	辺長	方向角	測角	DX	倍積 (Y×DX)
179-113	40833.893	-68033.251	4.930	359-46-45	89-58-39	4.964	-337717.057964
179-48	40838.823	-68033.270	4.010	315-24-51	135-38-06	7.786	-529707.040220
179-47	40841.679	-68036.085	7.042	269-40-58	134-16-07	2.817	-191657.651445
179-54	40841.640	-68043.127	7.781	179-36-09	89-55-11	-7.820	532097.253140
179-114	40833.859	-68043.073	9.822	89-48-06	90-11-57	-7.747	527129.686531

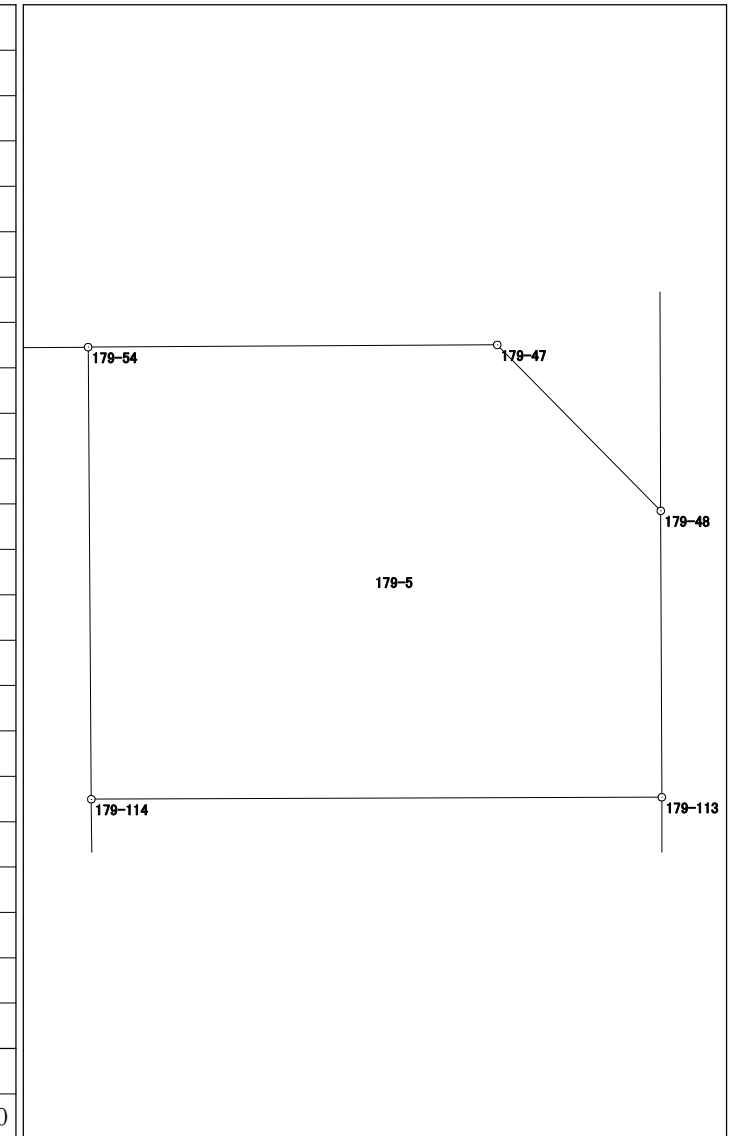


倍面積	145.190042
面積	72.5950210

面積計算書（座標法）

世界測地系（測地成果2011）

所 在	地 番	公簿地目	現況地目	地 積	所 有 者
前橋市六供町三丁目	179-6			102.84 m ²	

点 名	X 座標	Y 座標	辺 長	方 向 角	測 角	DX	倍 積 (Y×DX)
179-104	40822.043	-68044.585	10.910	89-48-39	89-51-18	-9.027	614238.468795
179-103	40822.079	-68033.675	0.649	45-00-00	135-11-21	0.495	-33676.669125
179-35	40822.538	-68033.216	8.604	359-50-25	134-50-25	9.063	-616585.036608
179-33	40831.142	-68033.240	9.814	269-48-26	89-58-01	8.571	-583112.900040
179-55	40831.109	-68043.054	1.538	269-53-18	180-04-52	-0.036	2449.549944
179-61	40831.106	-68044.592	9.063	179-57-21	90-04-03	-9.066	616892.271072
						倍面積	205.684038
						面 積	102.8420190

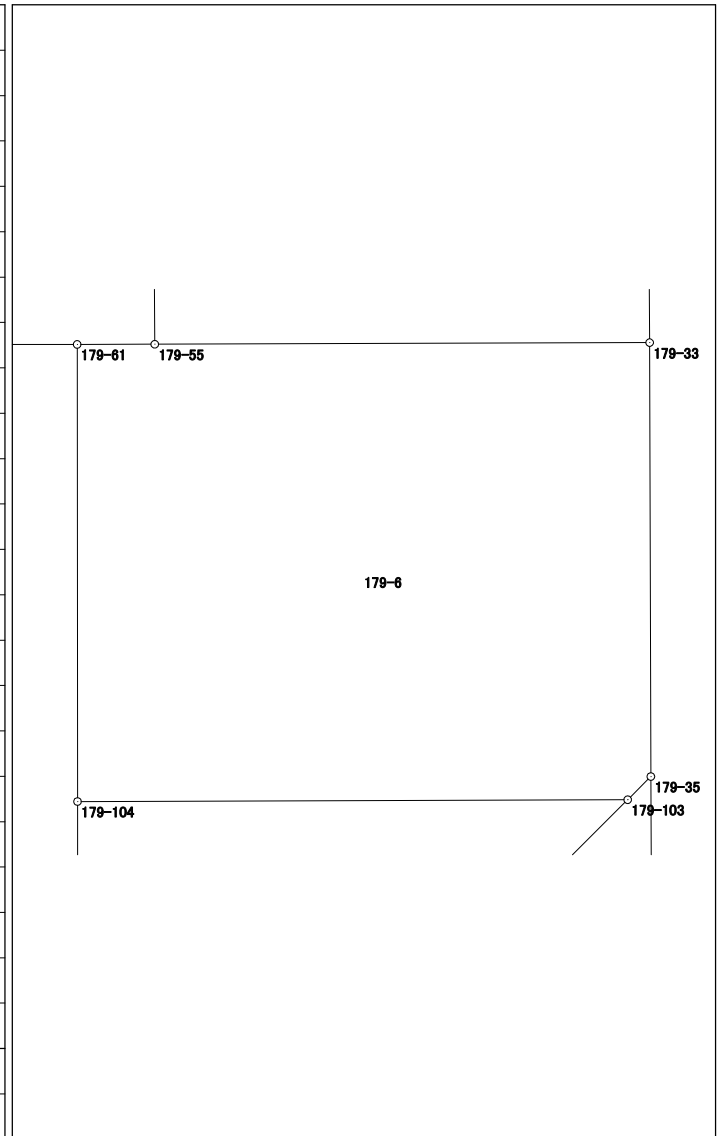

面積計算書（座標法）

世界測地系（測地成果2011）


所 在	地 番	公簿地目	現況地目	地 積	所 有 者
前橋市六供町三丁目	179-8			94.60 m ²	

点 名	X 座標	Y 座標	辺 長	方 向 角	測 角	DX	倍 積 (Y×DX)	
179-109	40819.620	-68063.194	8.244	89-49-35	90-55-20	-11.423	777485.865062	
179-42	40819.645	-68054.950	11.446	359-05-20	89-15-45	11.470	-780590.276500	
179-28	40831.090	-68055.132	4.529	269-53-56	90-48-36	11.437	-778346.544684	
179-117	40831.082	-68059.661	1.722	269-54-01	180-00-05	-0.011	748.656271	
179-57	40831.079	-68061.383	2.030	269-41-22	179-47-21	-0.014	952.859362	
179-110	40831.068	-68063.413	11.450	178-54-15	89-12-53	-11.459	779938.649567	
倍面積							189.209078	
面 積							94.6045390	

面積計算書（座標法）

世界測地系（測地成果2011）

所 在	地 番	公簿地目	現況地目	地 積	所 有 者
前橋市六供町三丁目	179-9			90.40 m ²	

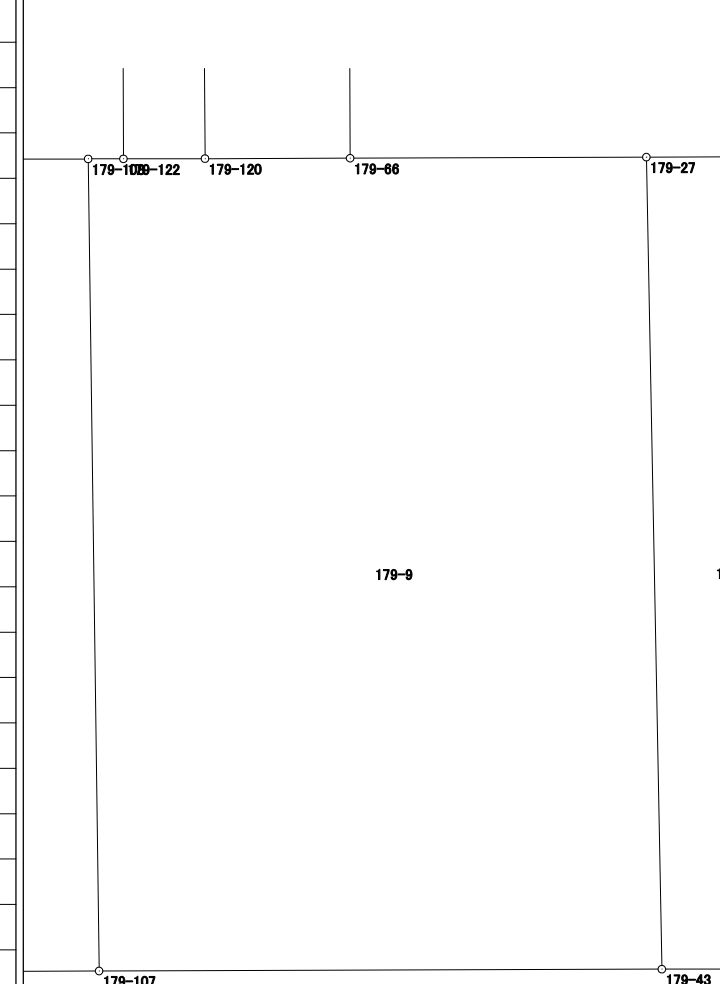
点 名	X 座 標	Y 座 標	辺 長	方 向 角	測 角	DX	倍 積 (Y×DX)	
179-43	40819.615	-68064.942	11.446	358-54-31	89-05-21	11.469	-780636.819798	
179-27	40831.059	-68065.160	4.176	269-47-39	90-53-08	11.429	-777916.713640	
179-66	40831.044	-68069.336	2.045	269-49-55	180-02-16	-0.021	1429.456056	
179-120	40831.038	-68071.381	1.150	269-51-02	180-01-07	-0.009	612.642429	
179-122	40831.035	-68072.531	0.497	269-53-05	180-02-03	-0.004	272.290124	
179-108	40831.034	-68073.028	11.445	179-13-44	89-20-39	-11.445	779095.805460	
179-107	40819.590	-68072.874	7.932	89-49-10	90-35-26	-11.419	777324.148206	
						倍面積	180.808837	
						面 積	90.4044185	

面積計算書（座標法）

世界測地系（測地成果2011）

所在	地番	公簿地目	現況地目	地積	所有者
前橋市六供町三丁目	179-10			84.20 m ²	

点名	X座標	Y座標	辺長	方向角	測角	DX	倍積 (Y×DX)
179-102	40827.914	-68075.696	10.597	269-50-16	90-36-53	8.303	-565232.503888
179-101	40827.884	-68086.293	5.494	178-54-18	89-04-02	-5.523	376040.596239
179-38	40822.391	-68086.188	3.996	135-11-34	136-17-16	-8.328	567021.773664
179-37	40819.556	-68083.372	7.789	89-48-58	134-37-24	-2.810	191314.275320
179-64	40819.581	-68075.583	8.334	359-13-23	89-24-25	8.358	-568975.722714
						倍面積	168.418621
						面積	84.2093105

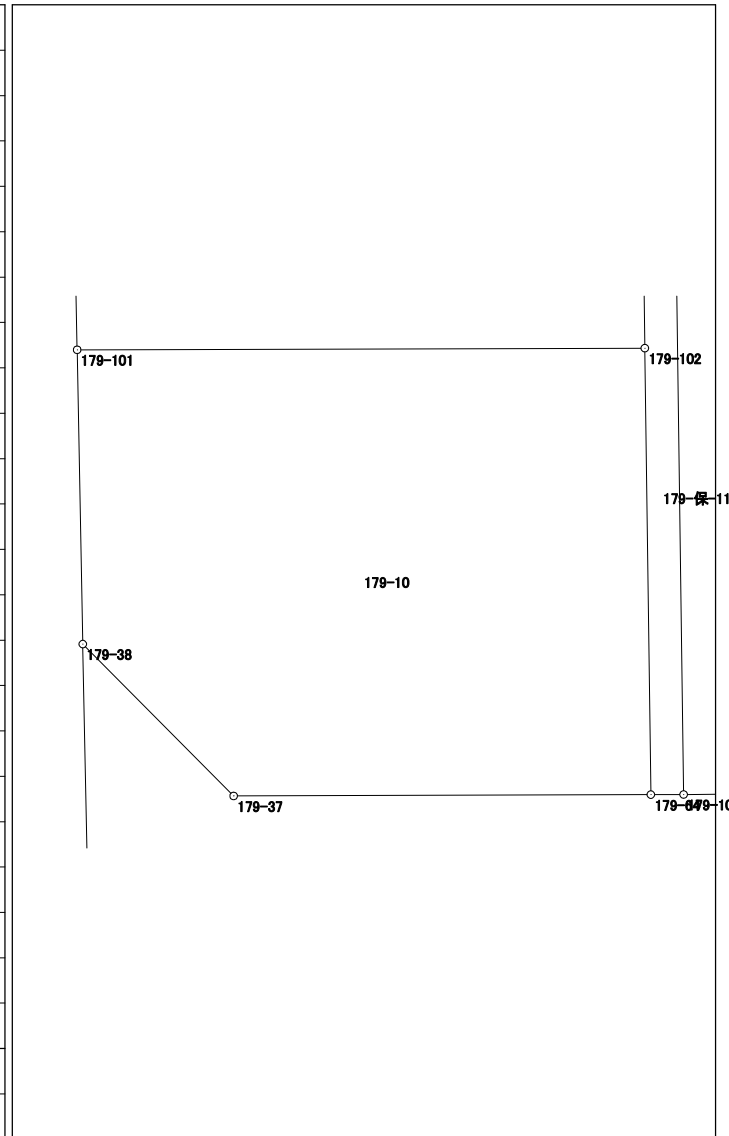


面積計算書（座標法）

世界測地系（測地成果2011）

所 在	地 番	公簿地目	現況地目	地 積	所 有 者
前橋市六供町三丁目	179-11			23.72 m ²	

点 名	X 座標	Y 座標	辺 長	方 向 角	測 角	DX	倍 積 (Y×DX)
179-123	40834.069	-68072.544	1.710	359-43-55	89-53-35	1.749	-119058.879456
179-125	40835.779	-68072.552	13.887	269-50-21	90-06-26	1.671	-113749.234392
179-126	40835.740	-68086.439	1.710	178-57-41	89-07-20	-1.749	119083.181811
179-124	40834.030	-68086.408	13.864	89-50-20	90-52-39	-1.671	113772.387768
						倍面積	47.455731
						面積	23.7278655

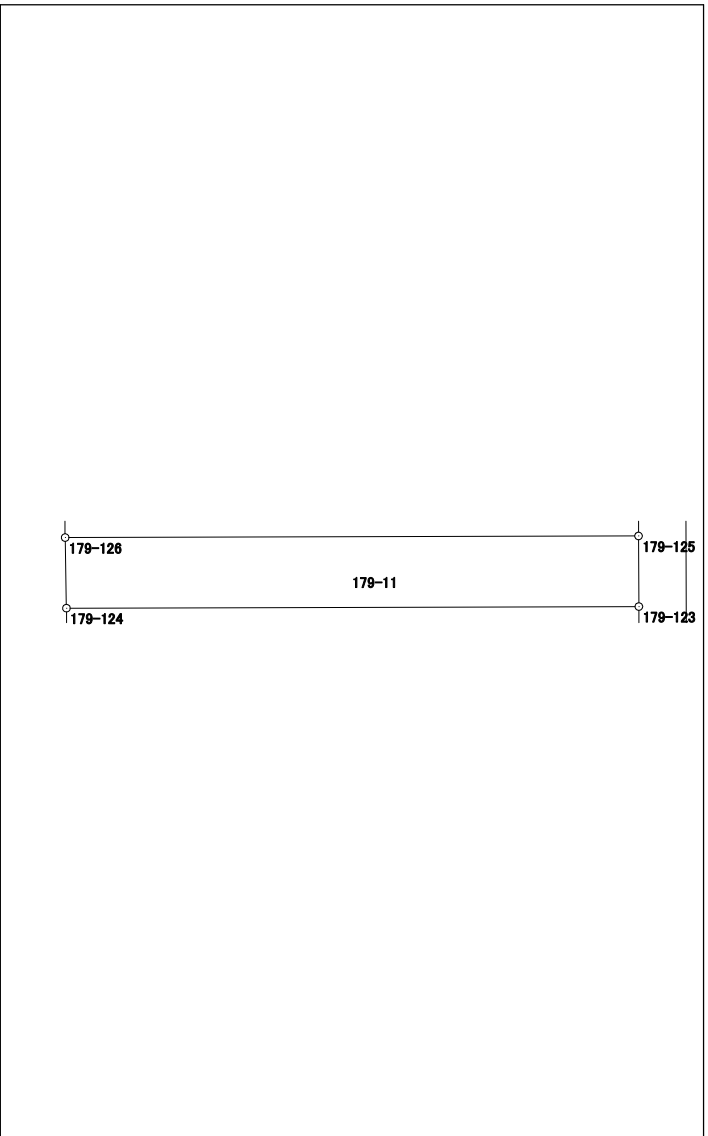


面積計算書 (座標法)

世界測地系 (測地成果2011)

所在	地番	公簿地目	現況地目	地積	所有者
前橋市六供町三丁目	179-13			21.36 m ²	

点名	X座標	Y座標	辺長	方向角	測角	DX	倍積 (Y×DX)
179-119	40841.479	-68071.427	10.441	179-44-51	90-08-23	-10.455	711686.769285
179-120	40831.038	-68071.381	2.045	89-49-55	90-05-04	-10.435	710324.860735
179-66	40831.044	-68069.336	10.449	359-44-52	89-54-57	10.455	-711664.907880
179-65	40841.493	-68069.382	2.045	269-36-28	89-51-36	10.435	-710304.001170
						倍面積	42.720970
						面積	21.3604850

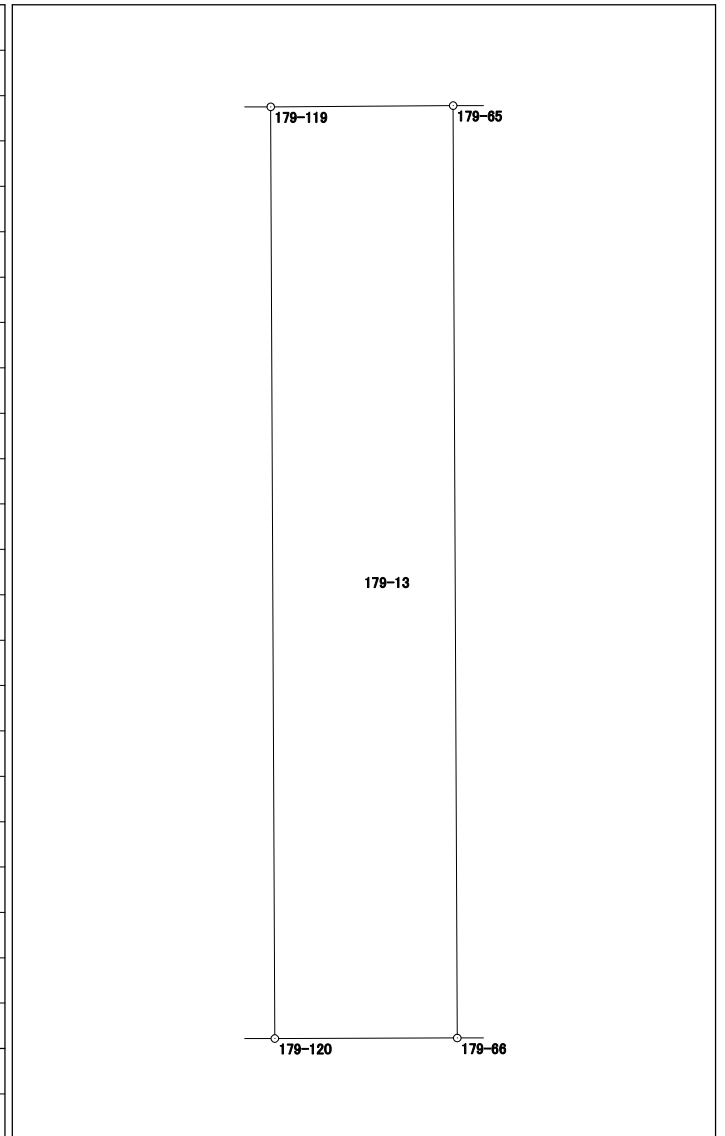


面積計算書 (座標法)

世界測地系 (測地成果2011)

所在	地番	公簿地目	現況地目	地積	所有者
前橋市六供町三丁目	179-保-1			27.00 m ²	

点名	X座標	Y座標	辺長	方向角	測角	DX	倍積 (Y×DX)
179-33	40831.142	-68033.240	2.751	359-46-15	89-57-49	2.784	-189404.540160
179-113	40833.893	-68033.251	9.822	269-48-06	90-01-51	2.717	-184846.342967
179-114	40833.859	-68043.073	2.750	179-36-15	89-48-09	-2.784	189431.915232
179-55	40831.109	-68043.054	9.814	89-48-26	90-12-11	-2.717	184872.977718
倍面積							54.009823
面積							27.0049115

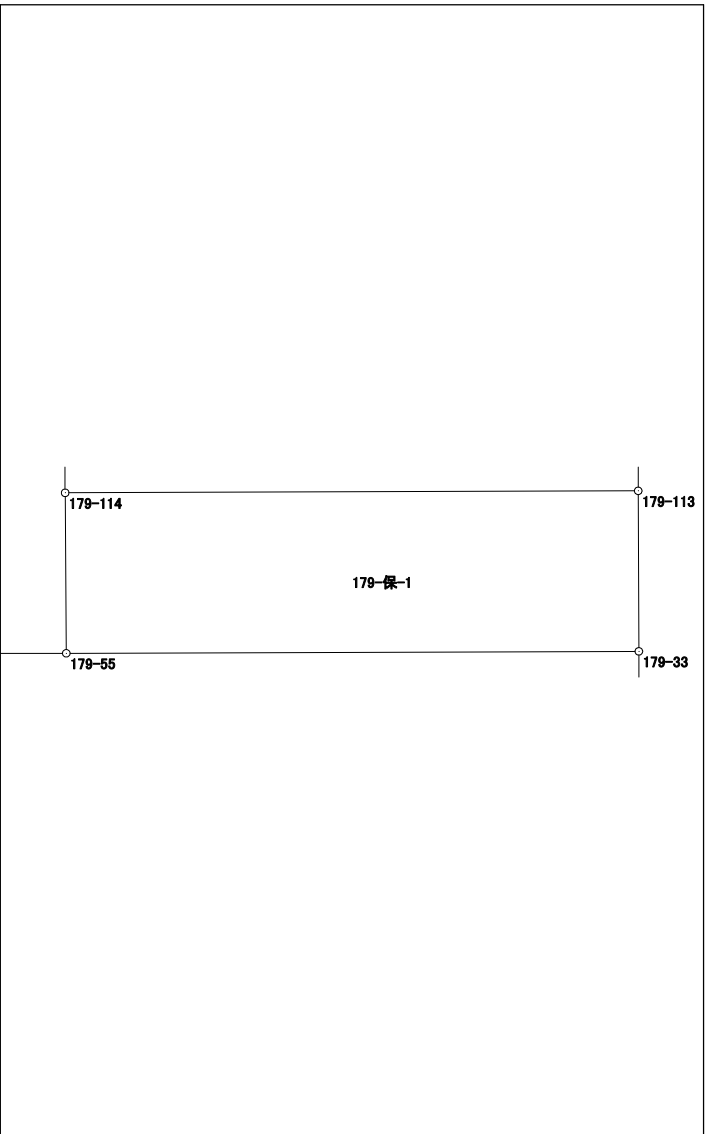

面積計算書（座標法）

世界測地系（測地成果2011）

所 在	地 番	公簿地目	現況地目	地 積	所 有 者
前橋市六供町三丁目	179-保-2			23.00 m ²	

点 名	X 座標	Y 座標	辺 長	方 向 角	測 角	DX	倍 積 (Y×DX)	
179-103	40822.079	-68033.675	10.910	269-48-39	44-47-56	2.338	-159062.732150	
179-104	40822.043	-68044.585	2.366	179-57-06	90-08-27	-2.402	163443.093170	
179-62	40819.677	-68044.583	8.533	89-48-43	89-51-37	-2.338	159088.235054	
179-36	40819.705	-68036.050	3.358	45-00-43	135-12-00	2.402	-163422.592100	
						倍面積	46.003974	
						面 積	23.0019870	


面積計算書（座標法）

世界測地系（測地成果2011）

所在	地番	公簿地目	現況地目	地積	所有者
前橋市六供町三丁目	179-保-3			21.00 m ²	

点名	X座標	Y座標	辺長	方向角	測角	DX	倍積 (Y×DX)
179-111	40819.651	-68053.115	11.438	359-05-36	89-16-50	11.443	-778731.794945
179-112	40831.088	-68053.296	1.836	270-03-45	90-58-09	11.439	-778461.652944
179-28	40831.090	-68055.132	11.446	179-05-20	89-01-35	-11.443	778754.875476
179-42	40819.645	-68054.950	1.835	89-48-46	90-43-26	-11.439	778480.573050

倍面積	42.000637
面積	21.0003185

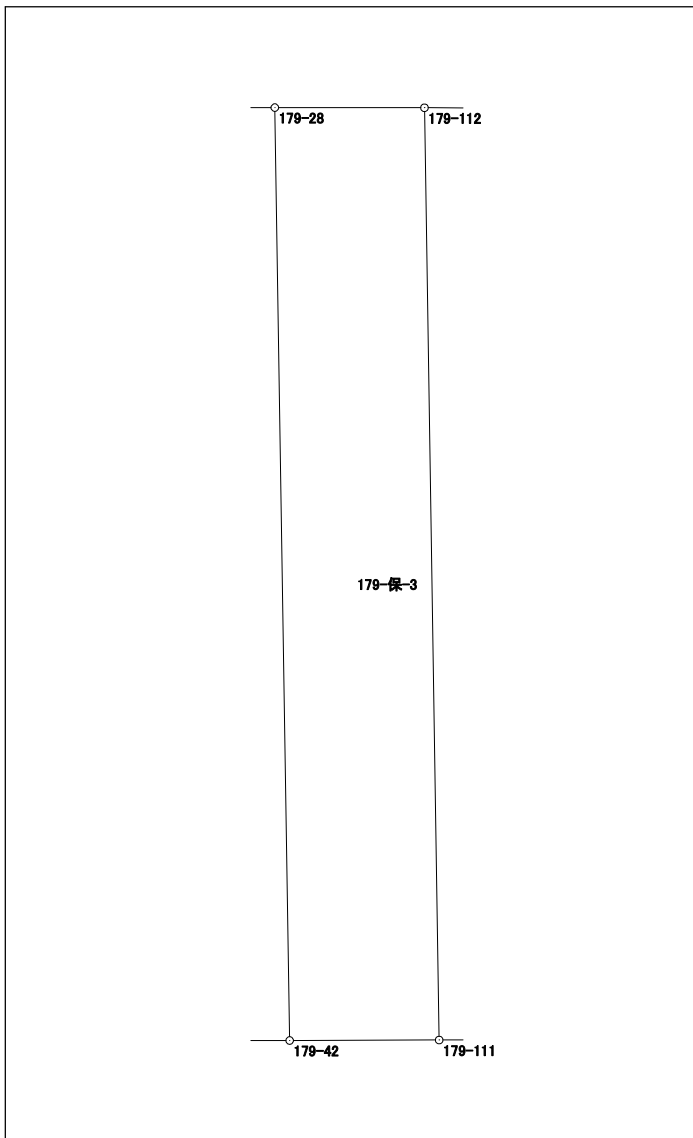


面積計算書（座標法）

世界測地系（測地成果2011）

所 在	地 番	公簿地目	現況地目	地 積	所 有 者
前橋市六供町三丁目	179-保-4			20.00 m ²	

点 名	X 座標	Y 座標	辺 長	方 向 角	測 角	DX	倍 積 (Y×DX)
179-109	40819.620	-68063.194	11.450	358-54-15	89-04-05	11.453	-779527.760882
179-110	40831.068	-68063.413	1.747	269-42-17	90-48-02	11.439	-778577.381307
179-27	40831.059	-68065.160	11.446	178-54-31	89-12-14	-11.453	779550.277480
179-43	40819.615	-68064.942	1.748	89-50-10	90-55-39	-11.439	778594.871538
倍面積							40.006829
面 積							20.0034145

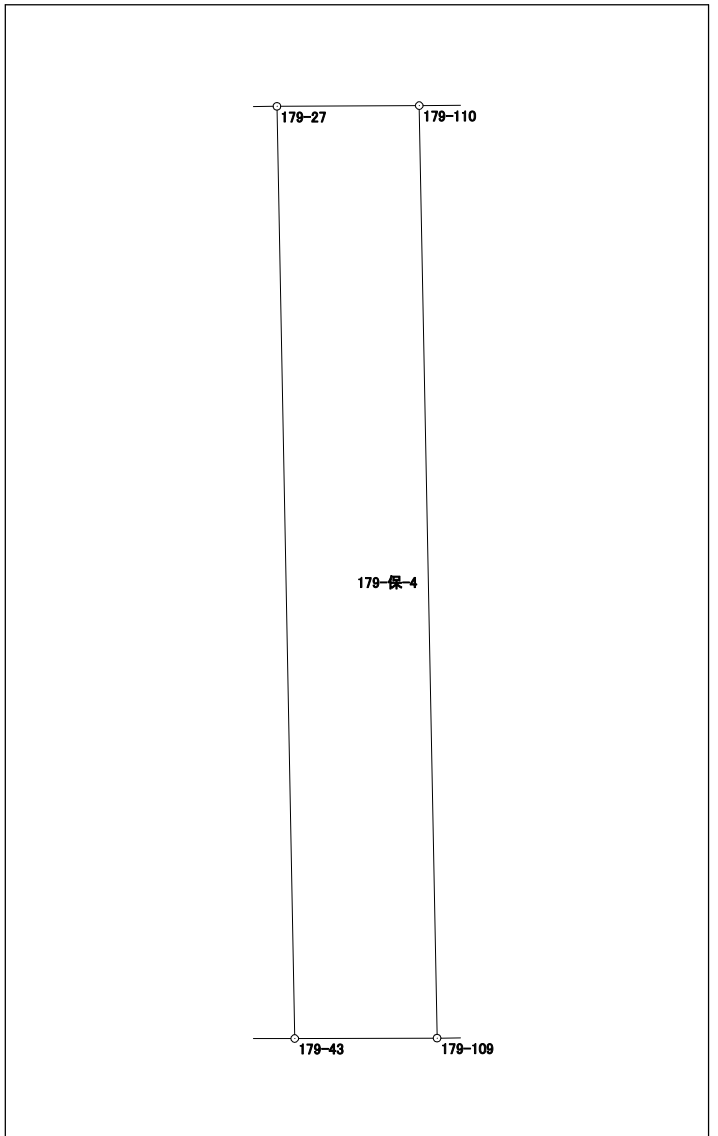


面積計算書 (座標法)

世界測地系 (測地成果2011)

所 在	地 番	公簿地目	現況地目	地 積	所 有 者
前橋市六供町三丁目	179-保-5			24.00 m ²	

点 名	X 座標	Y 座標	辺 長	方 向 角	測 角	DX	倍 積 (Y×DX)
179-107	40819.590	-68072.874	11.445	359-13-44	89-25-13	11.451	-779502.480174
179-108	40831.034	-68073.028	2.097	269-50-10	90-36-26	11.438	-778619.294264
179-106	40831.028	-68075.125	11.446	179-13-45	89-23-35	-11.451	779528.256375
179-105	40819.583	-68074.971	2.097	89-48-31	90-34-46	-11.438	778641.518298

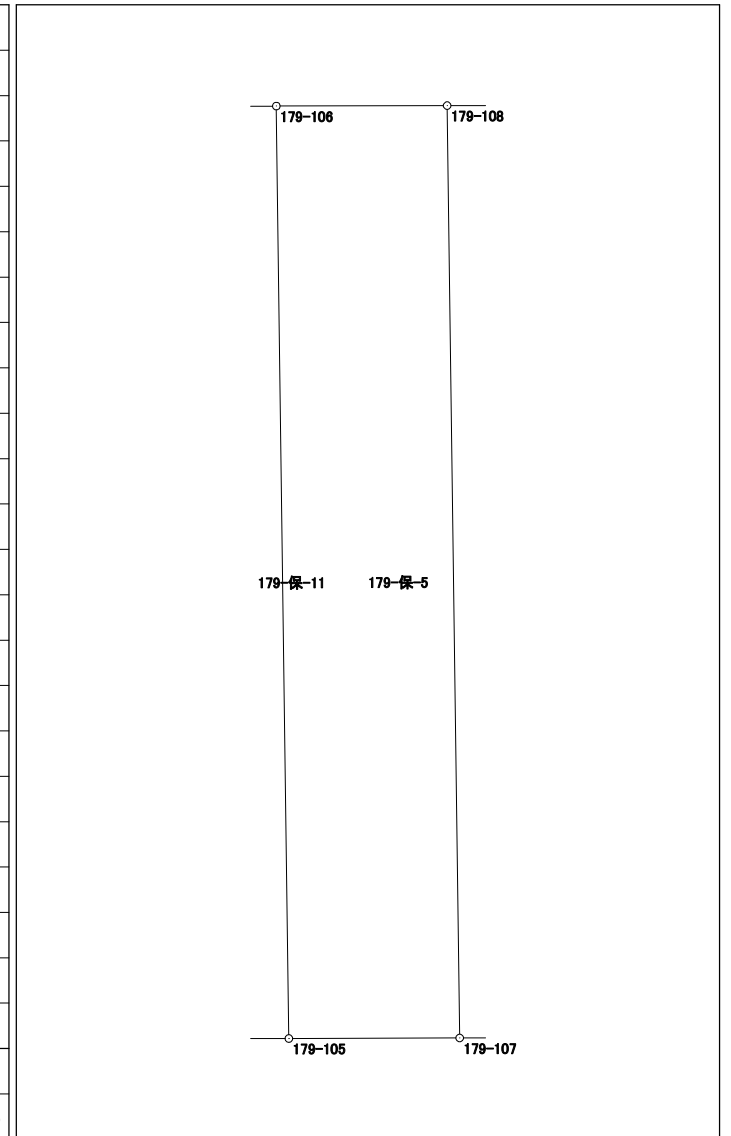

倍面積	48.000235
面 積	24.0001175

面積計算書（座標法）

世界測地系（測地成果2011）

所 在	地 番	公簿地目	現況地目	地 積	所 有 者
前橋市六供町三丁目	179-保-6			42.00 m ²	


点 名	X 座標	Y 座標	辺 長	方 向 角	測 角	DX	倍 積 (Y×DX)		
179-32	40830.995	-68086.353	10.616	89-49-58	90-52-16	-3.004	204531.404412		
179-63	40831.026	-68075.737	0.612	89-48-46	179-58-48	0.033	-2246.499321		
179-106	40831.028	-68075.125	2.097	89-50-10	180-01-24	0.008	-544.601000		
179-108	40831.034	-68073.028	0.497	89-53-05	180-02-55	0.007	-476.511196		
179-122	40831.035	-68072.531	3.034	359-45-16	89-52-11	3.035	-206600.131585		
179-123	40834.069	-68072.544	13.864	269-50-20	90-05-04	2.995	-203877.269280		
179-124	40834.030	-68086.408	3.035	178-57-42	89-07-22	-3.074	209297.618192		
						倍面積	84.010222		
						面 積	42.0051110		

面積計算書 (座標法)

世界測地系 (測地成果2011)

所 在	地 番	公簿地目	現況地目	地 積	所 有 者
前橋市六供町三丁目	179-保-7			18.00 m ²	

点 名	X 座標	Y 座標	辺 長	方 向 角	測 角	DX	倍 積 (Y×DX)
179-117	40831.082	-68059.661	10.460	359-41-36	89-47-35	10.463	-712108.233043
179-118	40841.542	-68059.717	1.722	269-38-02	89-56-26	10.449	-711155.982933
179-52	40841.531	-68061.439	10.452	179-41-35	90-03-33	-10.463	712126.836257
179-57	40831.079	-68061.383	1.722	89-54-01	90-12-26	-10.449	711173.390967
						倍面積	36.011248
						面 積	18.0056240

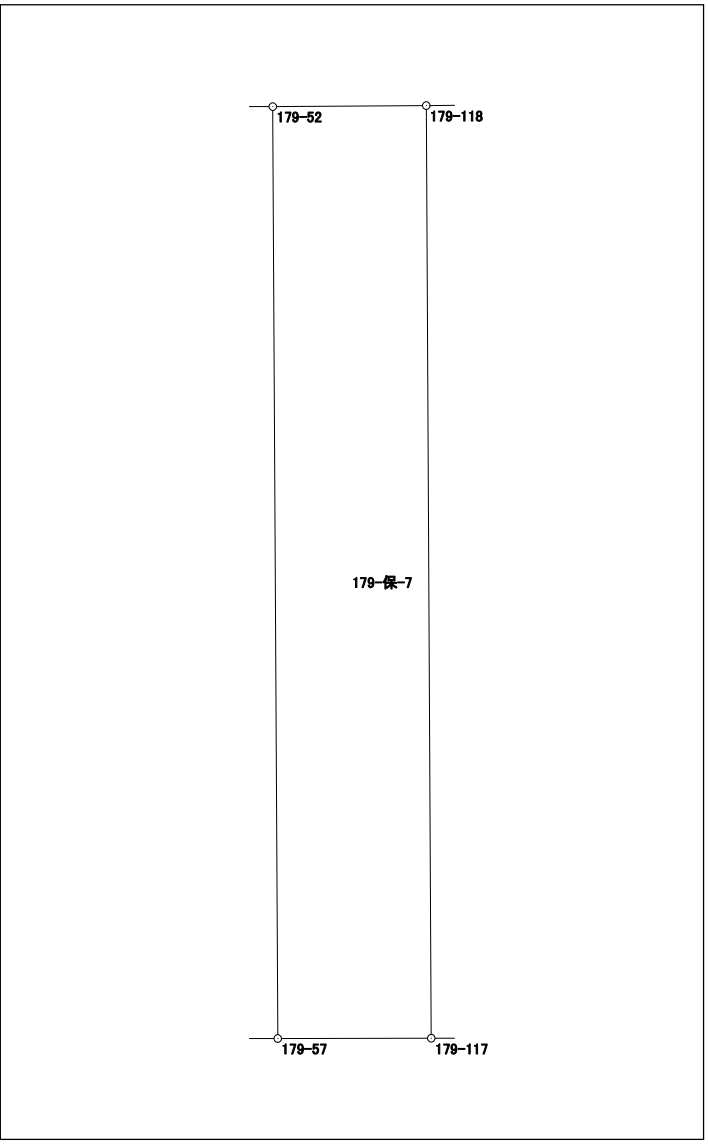


面積計算書（座標法）

世界測地系（測地成果2011）

所在	地番	公簿地目	現況地目	地積	所有者
前橋市六供町三丁目	179-保-9			12.00 m ²	

点名	X座標	Y座標	辺長	方向角	測角	Dx	倍積(Y×Dx)
179-123	40834.069	-68072.544	3.034	179-45-16	180-01-21	-4.744	322936.148736
179-122	40831.035	-68072.531	1.150	89-51-02	90-05-46	-3.031	206327.841461
179-120	40831.038	-68071.381	10.441	359-44-51	89-53-49	10.444	-710937.503164
179-119	40841.479	-68071.427	1.150	269-36-05	89-51-14	10.433	-710189.197891
179-121	40841.471	-68072.577	5.692	179-44-54	90-08-49	-5.700	388013.688900
179-125	40835.779	-68072.552	1.710	179-43-55	179-59-01	-7.402	503873.029904

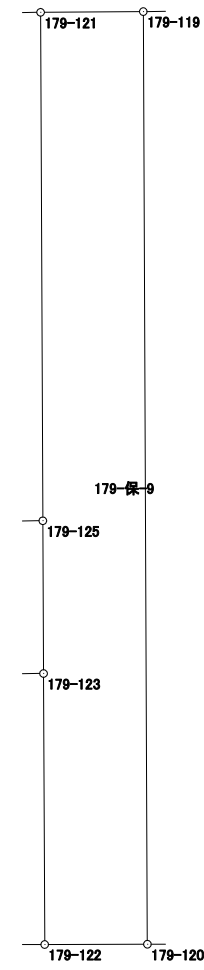


倍面積	24.007946
面積	12.0039730

面積計算書 (座標法)

世界測地系 (測地成果2011)

所 在	地 番	公簿地目	現況地目	地 積	所 有 者
前橋市六供町三丁目	179-保-10			33.00 m ²	

点 名	X 座 標	Y 座 標	辺 長	方 向 角	測 角	DX	倍 積 (Y×DX)
179-101	40827.884	-68086.293	10.597	89-50-16	90-56-34	-3.081	209773.868733
179-102	40827.914	-68075.696	3.112	359-14-43	89-24-27	3.142	-213893.836832
179-63	40831.026	-68075.737	10.616	269-49-58	90-35-15	3.081	-209741.345697
179-32	40830.995	-68086.353	3.112	178-53-42	89-03-44	-3.142	213927.321126

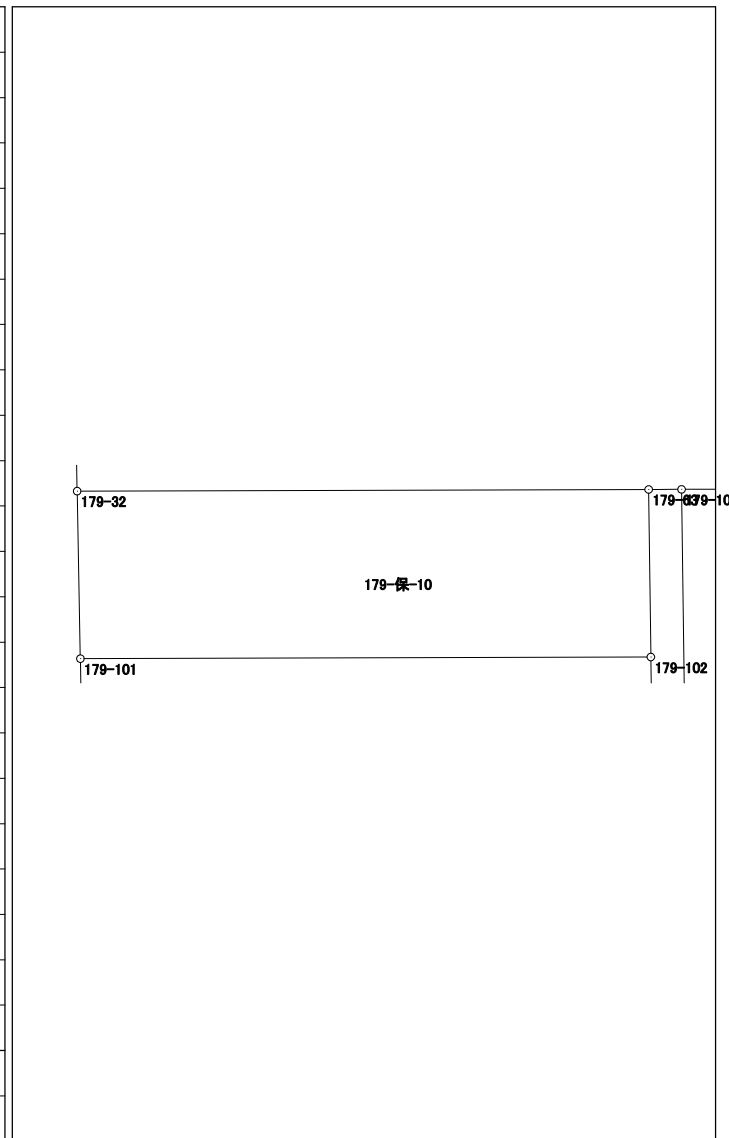

倍面積	66.007330
面 積	33.0036650

面積計算書 (座標法)

世界測地系 (測地成果2011)

所 在	地 番	公簿地目	現況地目	地 積	所 有 者
前橋市六供町三丁目	179-保-11			7.00 m ²	

点 名	X 座標	Y 座標	辺 長	方 向 角	測 角	DX	倍 積 (Y×DX)
179-105	40819.583	-68074.971	11.446	359-13-45	89-24-59	11.447	-779254.193037
179-106	40831.028	-68075.125	0.612	269-48-46	90-35-01	11.443	-778983.655375
179-63	40831.026	-68075.737	3.112	179-14-43	89-25-57	-3.114	211987.845018
179-102	40827.914	-68075.696	8.334	179-13-23	179-58-40	-11.445	779126.340720
179-64	40819.581	-68075.583	0.612	89-48-46	90-35-23	-8.331	567137.681973
						倍面積	14.019299
						面 積	7.0096495

