



180街区 画地出来形確認図 (2031.59㎡)

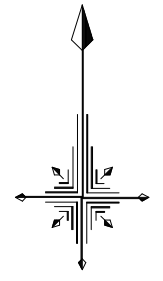

S=1/250

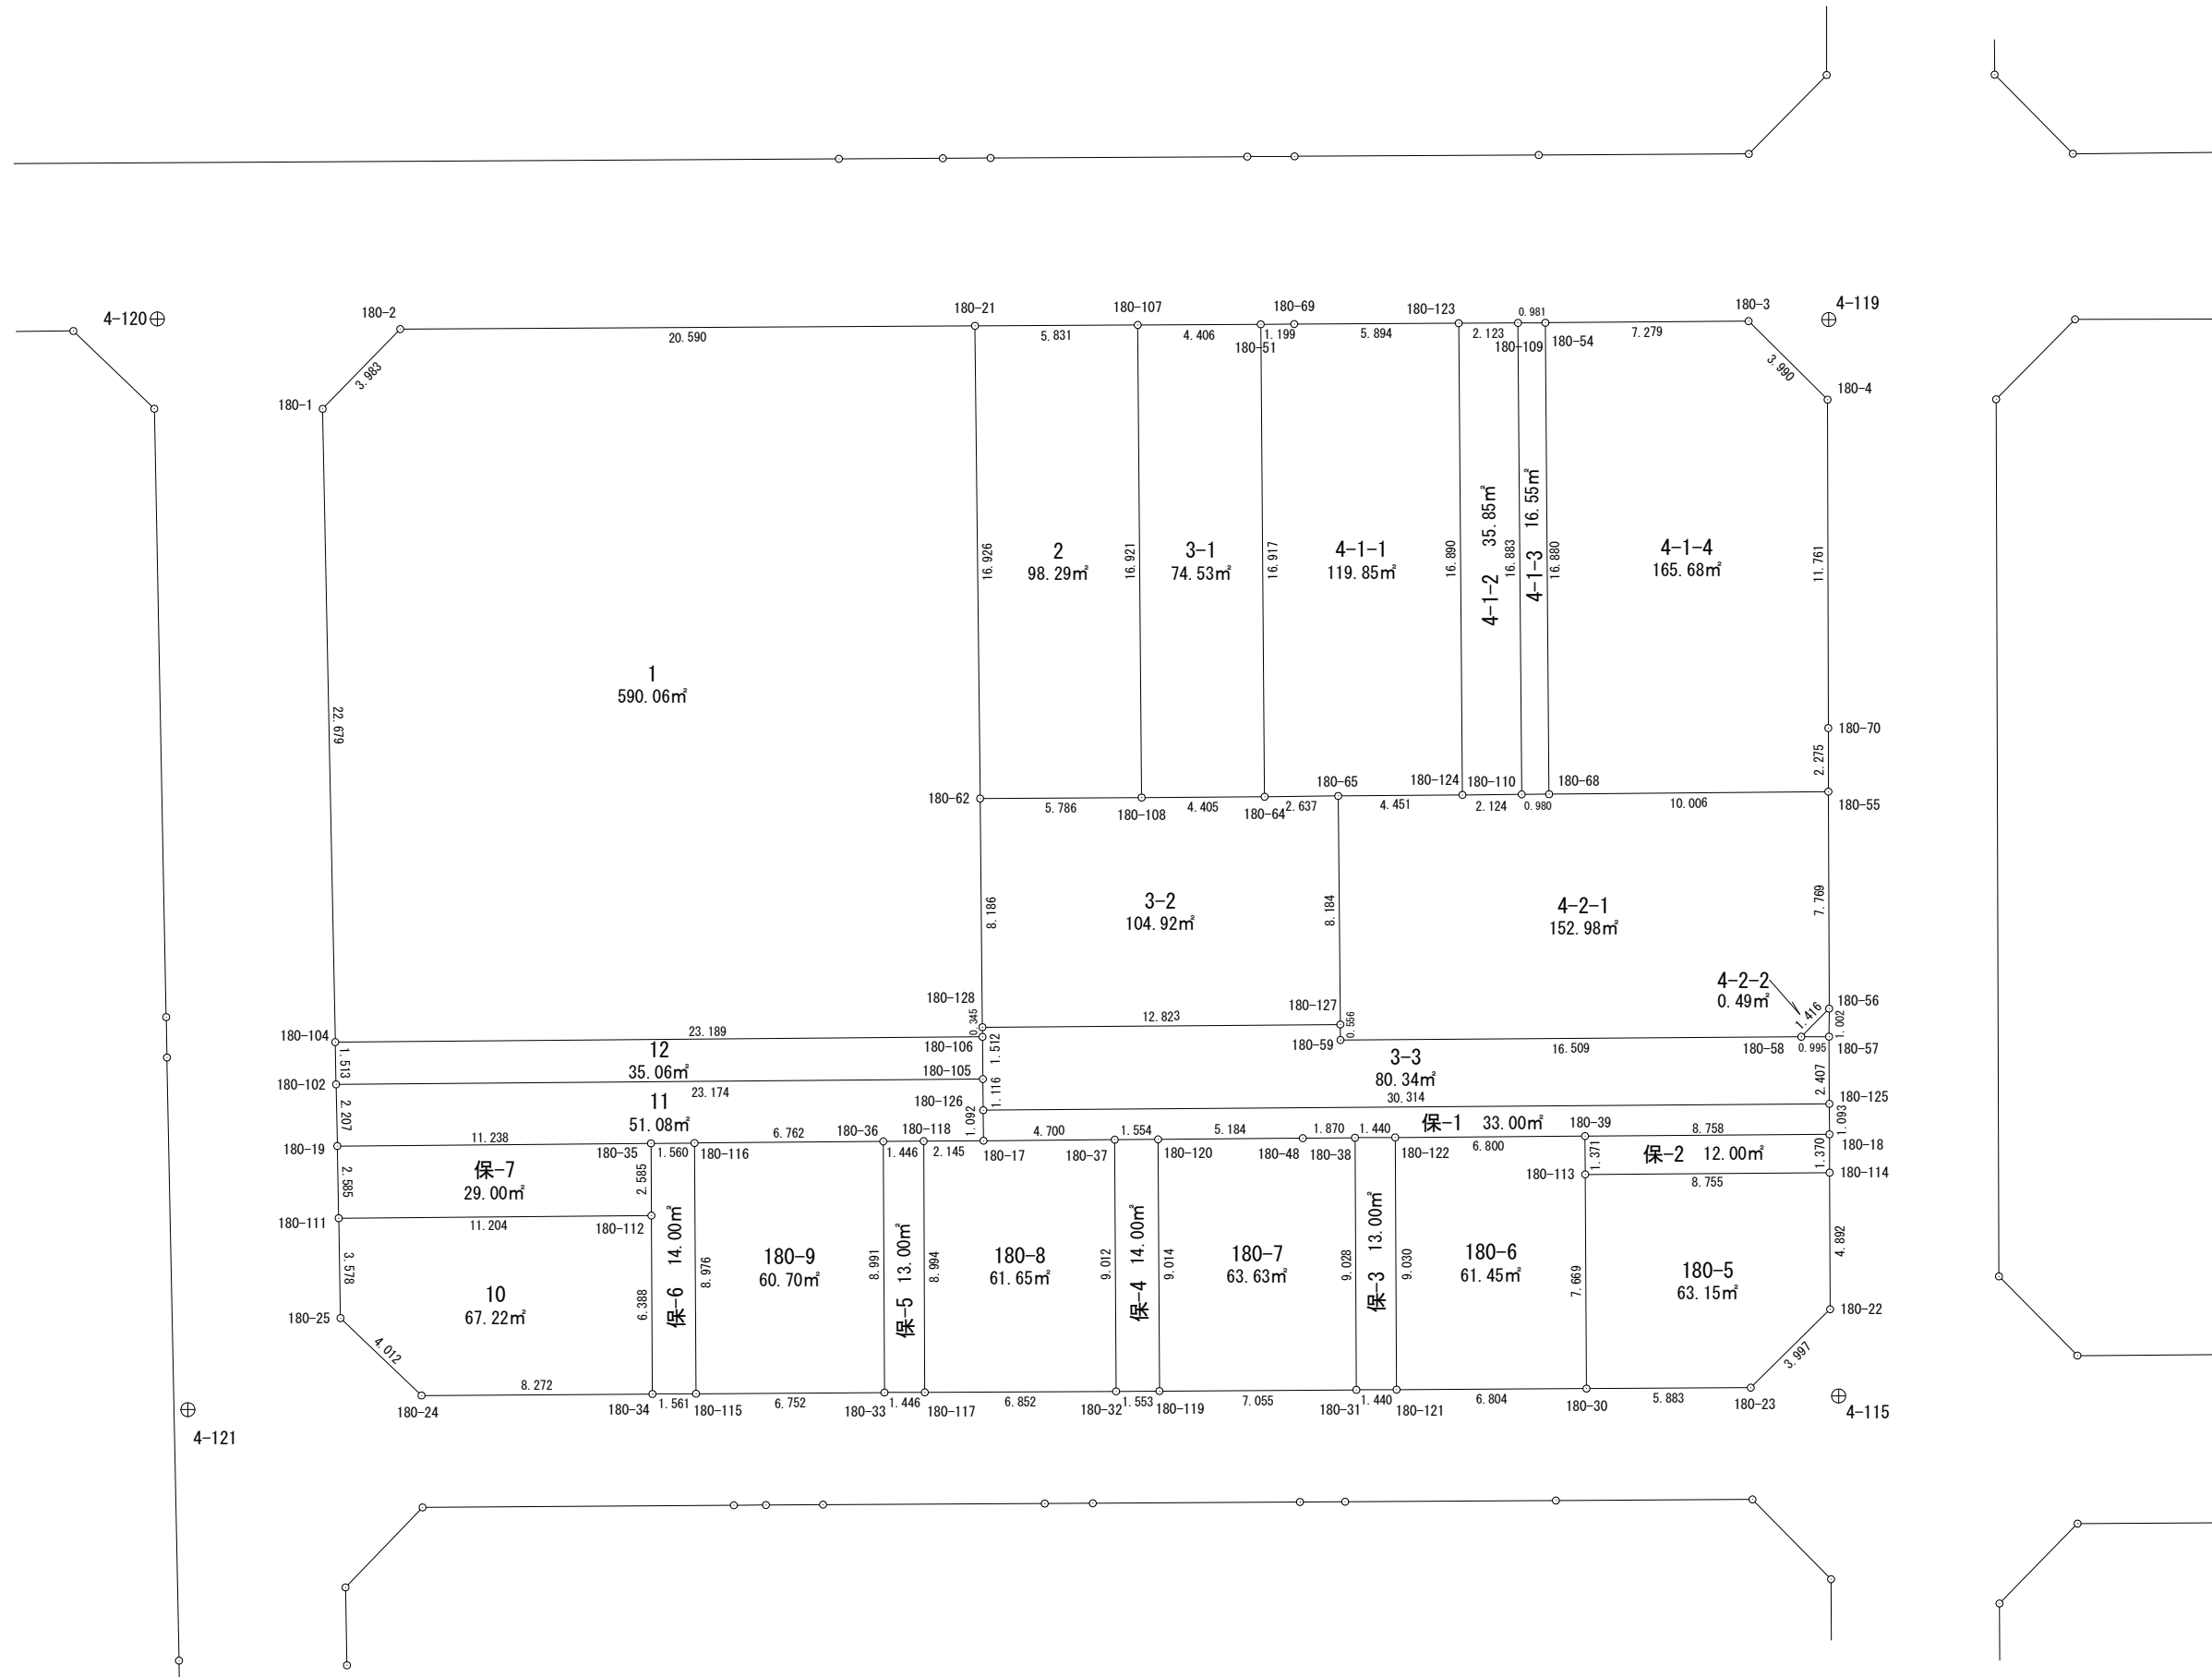

面積計算書（座標法）

世界測地系（測地成果2011）

所 在	地 番	公簿地目	現況地目	地 積	所 有 者
前橋市六供町三丁目	180-1			590.06 m ²	


点 名	X 座標	Y 座標	辺 長	方 向 角	測 角	DX	倍 積 (Y×DX)	
180-104	40858.053	-68086.858	23.189	89-31-59	90-40-12	-22.486	1531001.088988	
180-106	40858.242	-68063.670	0.345	359-30-06	89-58-07	0.534	-36345.999780	
180-128	40858.587	-68063.673	8.186	359-25-34	179-55-28	8.531	-580651.194363	
180-62	40866.773	-68063.755	16.926	359-22-38	179-57-04	25.111	-1709148.951805	
180-21	40883.698	-68063.939	20.590	269-40-38	90-18-00	16.809	-1144086.750651	
180-2	40883.582	-68084.529	3.983	224-14-14	134-33-36	-2.970	202211.051130	
180-1	40880.728	-68087.308	22.679	178-51-47	134-37-33	-25.529	1738200.885932	
						倍面積	1180.129451	
						面 積	590.0647255	

面積計算書（座標法）

世界測地系（測地成果2011）

所在	地番	公簿地目	現況地目	地積	所有者
前橋市六供町三丁目	180-2			98.29 m ²	

点名	X 座標	Y 座標	辺長	方向角	測角	DX	倍積 (Y×DX)
180-107	40883.730	-68058.108	5.831	269-41-08	90-09-22	16.888	-1149365.327904
180-21	40883.698	-68063.939	16.926	179-22-38	89-41-30	-16.957	1154160.213623
180-62	40866.773	-68063.755	5.786	89-38-01	90-15-23	-16.888	1149460.694440
180-108	40866.810	-68057.969	16.921	359-31-46	89-53-45	16.957	-1154058.980333

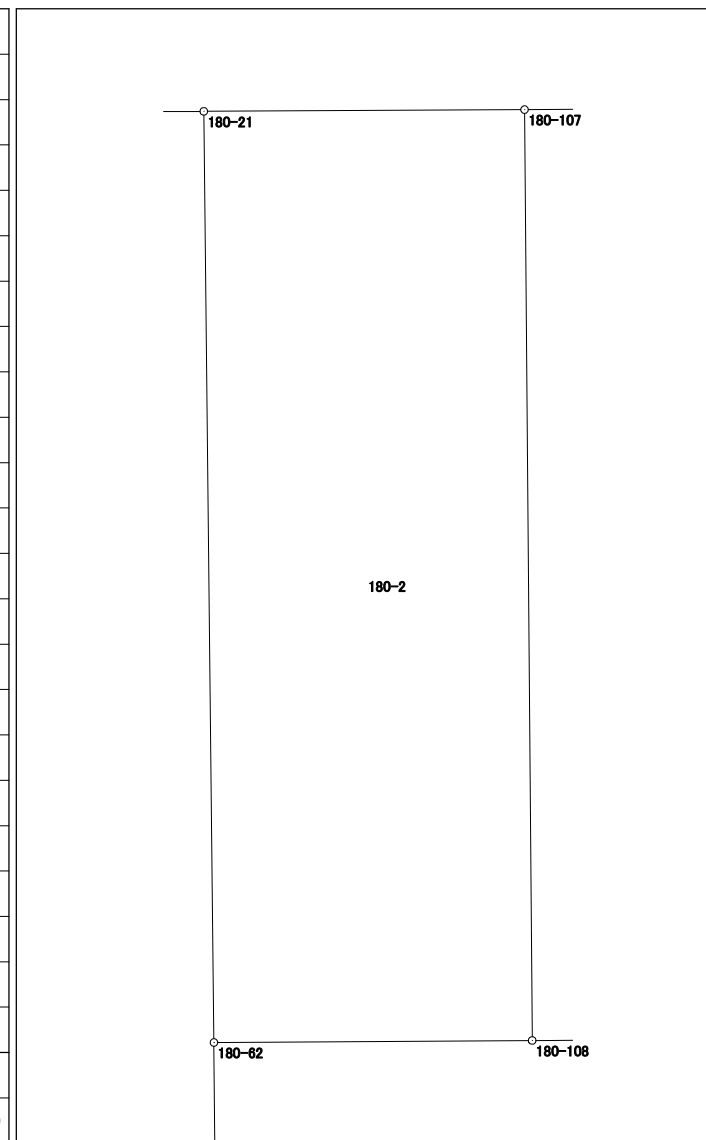


倍面積	196.599826
面積	98.2999130

面積計算書 (座標法)

世界測地系 (測地成果2011)

所 在	地 番	公簿地目	現況地目	地 積	所 有 者
前橋市六供町三丁目	180-3-1			74.53 m ²	

点 名	X 座標	Y 座標	辺 長	方 向 角	測 角	DX	倍 積 (Y×DX)
180-64	40866.838	-68053.564	16.917	359-31-57	89-53-48	16.944	-1153099.588416
180-51	40883.754	-68053.702	4.406	269-41-16	90-09-19	16.892	-1149563.134184
180-107	40883.730	-68058.108	16.921	179-31-46	89-50-30	-16.944	1153176.581952
180-108	40866.810	-68057.969	4.405	89-38-09	90-06-23	-16.892	1149635.212348
						倍面積	149.071700
						面 積	74.5358500

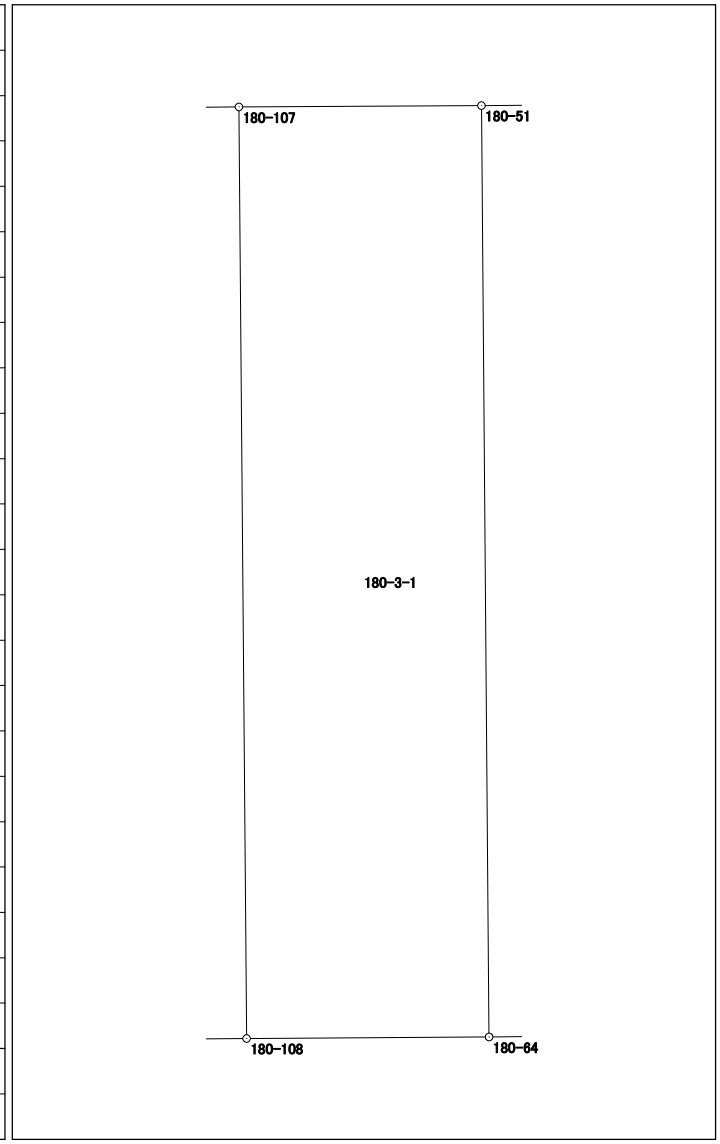


面積計算書（座標法）

世界測地系（測地成果2011）

所 在	地 番	公簿地目	現況地目	地 積	所 有 者
前橋市六供町三丁目	180-3-2			104.92 m ²	

点 名	X 座標	Y 座標	辺 長	方 向 角	測 角	DX	倍 積 (Y×DX)
180-127	40858.683	-68050.850	8.184	359-27-39	89-53-23	8.280	-563461.038000
180-65	40866.867	-68050.927	2.637	269-22-12	89-54-33	8.155	-554955.309685
180-64	40866.838	-68053.564	4.405	269-38-09	180-15-57	-0.057	3879.053148
180-108	40866.810	-68057.969	5.786	269-38-01	179-59-52	-0.065	4423.767985
180-62	40866.773	-68063.755	8.186	179-25-34	89-47-33	-8.223	559688.257365
180-128	40858.587	-68063.673	12.823	89-34-16	90-08-42	-8.090	550635.114570
						倍面積	209.845383
						面 積	104.9226915

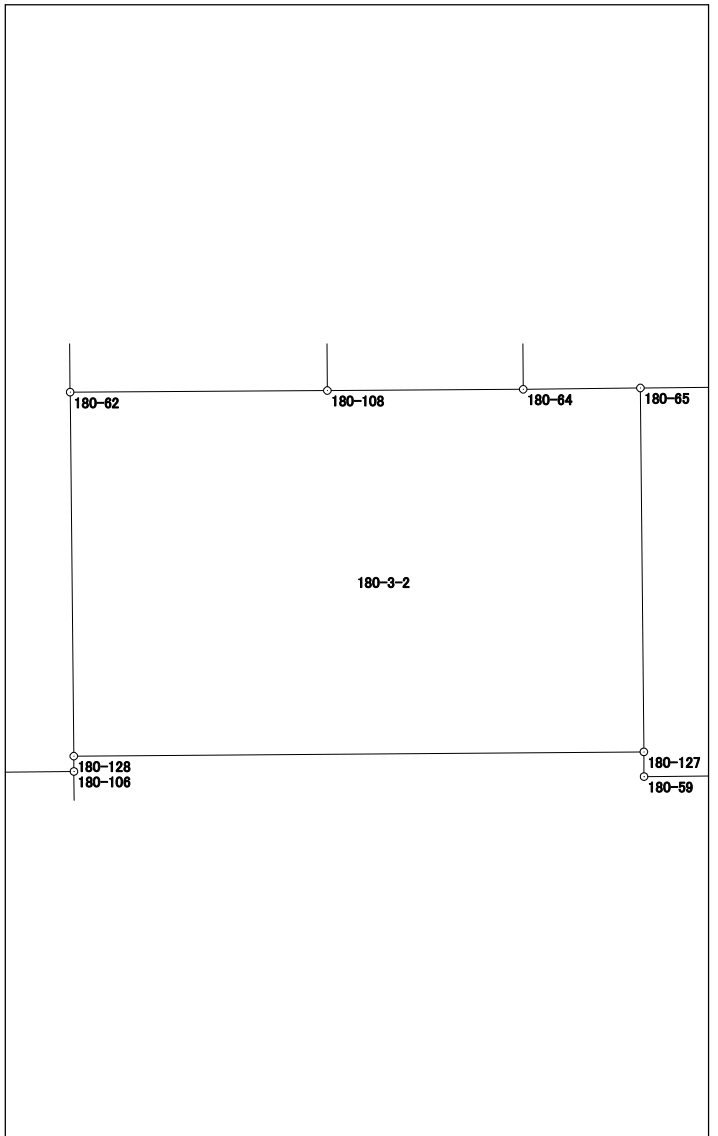


面積計算書（座標法）

世界測地系（測地成果2011）

所在	地番	公簿地目	現況地目	地積	所有者
前橋市六供町三丁目	180-3-3			80.34 m ²	

点名	X座標	Y座標	辺長	方向角	測角	Dx	倍積 (Y×Dx)
180-126	40855.614	-68063.644	30.314	89-34-02	90-07-55	-0.887	60372.452228
180-125	40855.843	-68033.331	2.407	359-45-43	90-11-41	2.636	-179335.860516
180-57	40858.250	-68033.341	0.995	269-46-11	90-00-28	2.403	-163484.118423
180-58	40858.246	-68034.336	16.509	269-35-13	179-49-02	-0.123	8368.223328
180-59	40858.127	-68050.845	0.556	359-29-05	269-53-52	0.437	-29738.219265
180-127	40858.683	-68050.850	12.823	269-34-16	90-05-11	0.460	-31303.391000
180-128	40858.587	-68063.673	0.345	179-30-06	89-55-50	-0.441	30016.079793
180-106	40858.242	-68063.670	1.512	179-25-54	179-55-48	-1.857	126394.235190
180-105	40856.730	-68063.655	1.116	179-26-07	180-00-13	-2.628	178871.285340

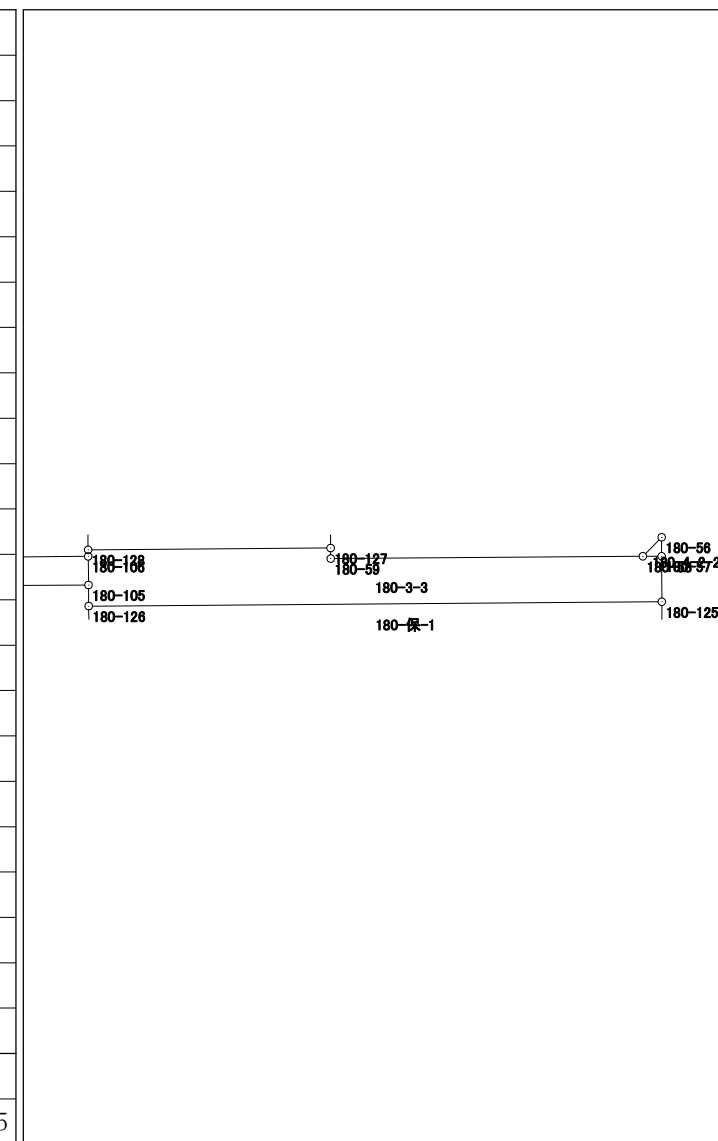


倍面積	160.686675
面積	80.3433375

面積計算書 (座標法)

世界測地系 (測地成果2011)

所在	地番	公簿地目	現況地目	地積	所有者
前橋市六供町三丁目	180-4-1-1			119.85 m ²	

点名	X座標	Y座標	辺長	方向角	測角	DX	倍積 (Y×DX)
180-123	40883.793	-68046.609	5.894	269-43-05	90-10-09	16.860	-1147265.827740
180-69	40883.764	-68052.503	1.199	269-31-20	179-48-15	-0.039	2654.047617
180-51	40883.754	-68053.702	16.917	179-31-57	90-00-37	-16.926	1151876.960052
180-64	40866.838	-68053.564	2.637	89-22-12	89-50-15	-16.887	1149220.535268
180-65	40866.867	-68050.927	4.451	89-31-25	180-09-13	0.066	-4491.361182
180-124	40866.904	-68046.476	16.890	359-32-56	90-01-31	16.926	-1151754.652776

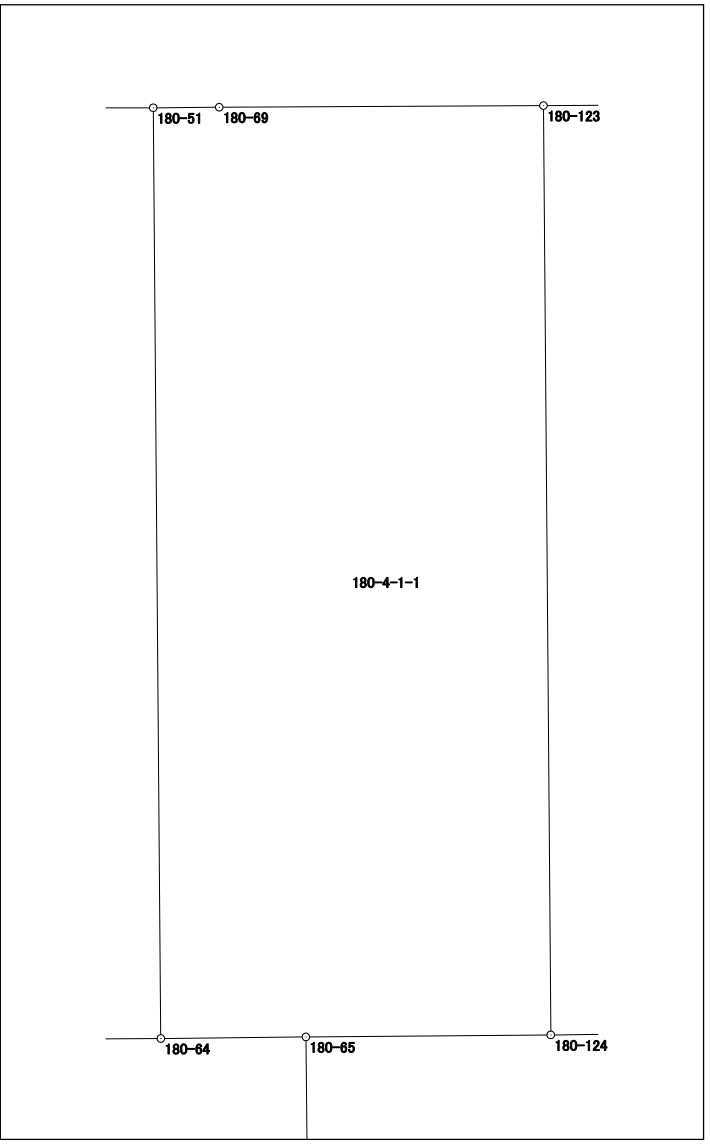


倍面積	239.701239
面積	119.8506195

面積計算書 (座標法)

世界測地系 (測地成果2011)

所在	地番	公簿地目	現況地目	地積	所有者
前橋市六供町三丁目	180-4-1-2			35.85 m ²	

点名	X座標	Y座標	辺長	方向角	測角	DX	倍積 (Y×DX)
180-110	40866.922	-68044.352	16.883	359-32-43	90-01-51	16.900	-1149949.548800
180-109	40883.804	-68044.486	2.123	269-42-11	90-09-28	16.871	-1147978.523306
180-123	40883.793	-68046.609	16.890	179-32-56	89-50-45	-16.900	1149987.692100
180-124	40866.904	-68046.476	2.124	89-30-52	89-57-56	-16.871	1148012.096596
						倍面積	71.716590
						面積	35.8582950

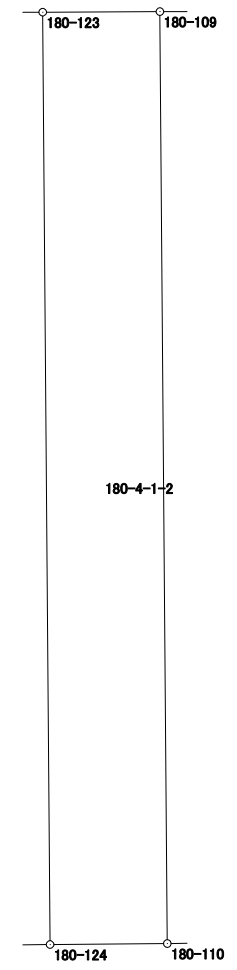


面積計算書 (座標法)

世界測地系 (測地成果2011)

所在	地番	公簿地目	現況地目	地積	所有者
前橋市六供町三丁目	180-4-1-3			16.55 m ²	

点名	X座標	Y座標	辺長	方向角	測角	DX	倍積 (Y×DX)
180-68	40866.930	-68043.372	16.880	359-32-55	90-00-59	16.887	-1149048.422964
180-54	40883.809	-68043.505	0.981	269-42-29	90-09-34	16.874	-1148166.103370
180-109	40883.804	-68044.486	16.883	179-32-43	89-50-14	-16.887	1149067.235082
180-110	40866.922	-68044.352	0.980	89-31-56	89-59-13	-16.874	1148180.395648

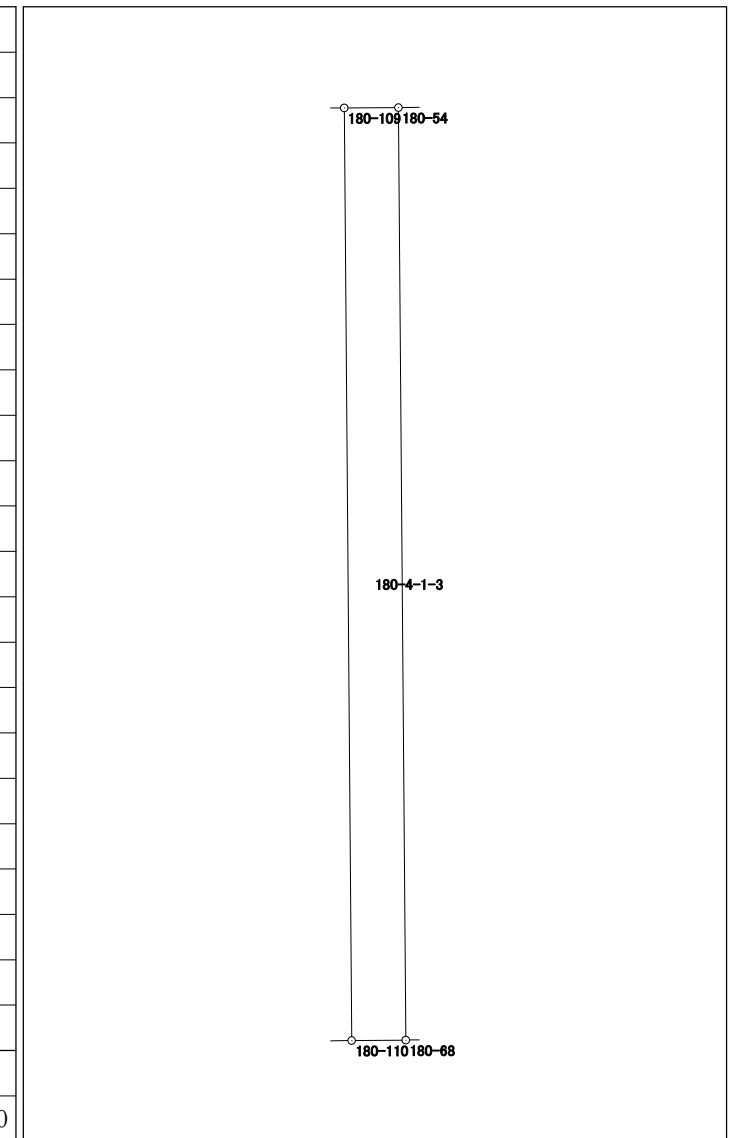

倍面積	33.104396
面積	16.5521980

面積計算書 (座標法)

世界測地系 (測地成果2011)

所 在	地 番	公簿地目	現況地目	地 積	所 有 者
前橋市六供町三丁目	180-4-1-4			165.68 m ²	


点 名	X 座標	Y 座標	辺 長	方 向 角	測 角	DX	倍 積 (Y×DX)	
180-54	40883.809	-68043.505	16.880	179-32-55	90-00-47	-16.938	1152520.887690	
180-68	40866.930	-68043.372	10.006	89-28-44	89-55-49	-16.788	1142312.129136	
180-55	40867.021	-68033.366	2.275	359-53-57	90-25-13	2.366	-160966.943956	
180-70	40869.296	-68033.370	11.761	359-52-42	179-58-45	14.036	-954916.381320	
180-4	40881.057	-68033.395	3.990	314-47-49	134-55-07	14.572	-991382.631940	
180-3	40883.868	-68036.226	7.279	269-32-08	134-44-19	2.752	-187235.693952	
							倍面積	
							面 積	165.6828290

面積計算書（座標法）

世界測地系（測地成果2011）

所在	地番	公簿地目	現況地目	地積	所有者
前橋市六供町三丁目	180-4-2-1			152.98 m ²	

点名	X座標	Y座標	辺長	方向角	測角	DX	倍積 (Y×DX)
180-65	40866.867	-68050.927	8.184	179-27-39	89-56-14	-8.221	559446.670867
180-127	40858.683	-68050.850	0.556	179-29-05	180-01-26	-8.740	594764.429000
180-59	40858.127	-68050.845	16.509	89-35-13	90-06-08	-0.437	29738.219265
180-58	40858.246	-68034.336	1.416	44-44-33	135-09-20	1.125	-76538.628000
180-56	40859.252	-68033.339	7.769	359-48-03	135-03-30	8.775	-596992.549725
180-55	40867.021	-68033.366	10.006	269-28-44	89-40-41	7.678	-522360.184148
180-68	40866.930	-68043.372	0.980	269-31-56	180-03-12	-0.099	6736.293828
180-110	40866.922	-68044.352	2.124	269-30-52	179-58-56	-0.026	1769.153152
180-124	40866.904	-68046.476	4.451	269-31-25	180-00-33	-0.055	3742.556180

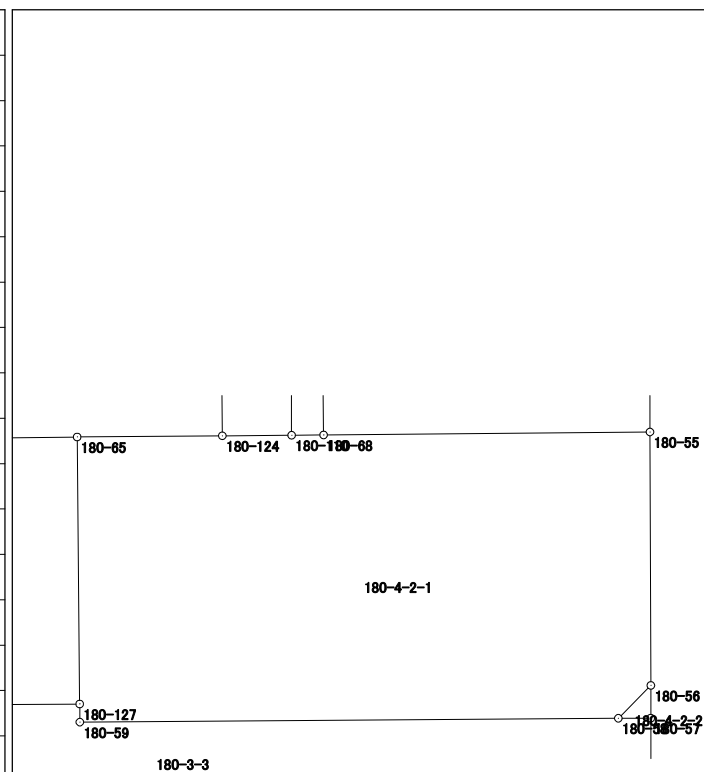


倍面積	305.960419
面積	152.9802095

面積計算書 (座標法)

世界測地系 (測地成果2011)

所在	地番	公簿地目	現況地目	地積	所有者
前橋市六供町三丁目	180-5			63.15 m ²	

点名	X座標	Y座標	辺長	方向角	測角	DX	倍積 (Y×DX)
180-114	40853.380	-68033.322	8.755	269-35-16	89-47-55	4.829	-328532.911938
180-113	40853.317	-68042.077	7.669	179-39-50	90-04-34	-7.732	526101.339364
180-30	40845.648	-68042.032	5.883	89-40-43	90-00-53	-7.636	519568.956352
180-23	40845.681	-68036.149	3.997	45-23-07	135-42-24	2.840	-193222.663160
180-22	40848.488	-68033.304	4.892	359-47-21	134-24-14	7.699	-523788.407496
						倍面積	126.313122
						面積	63.1565610

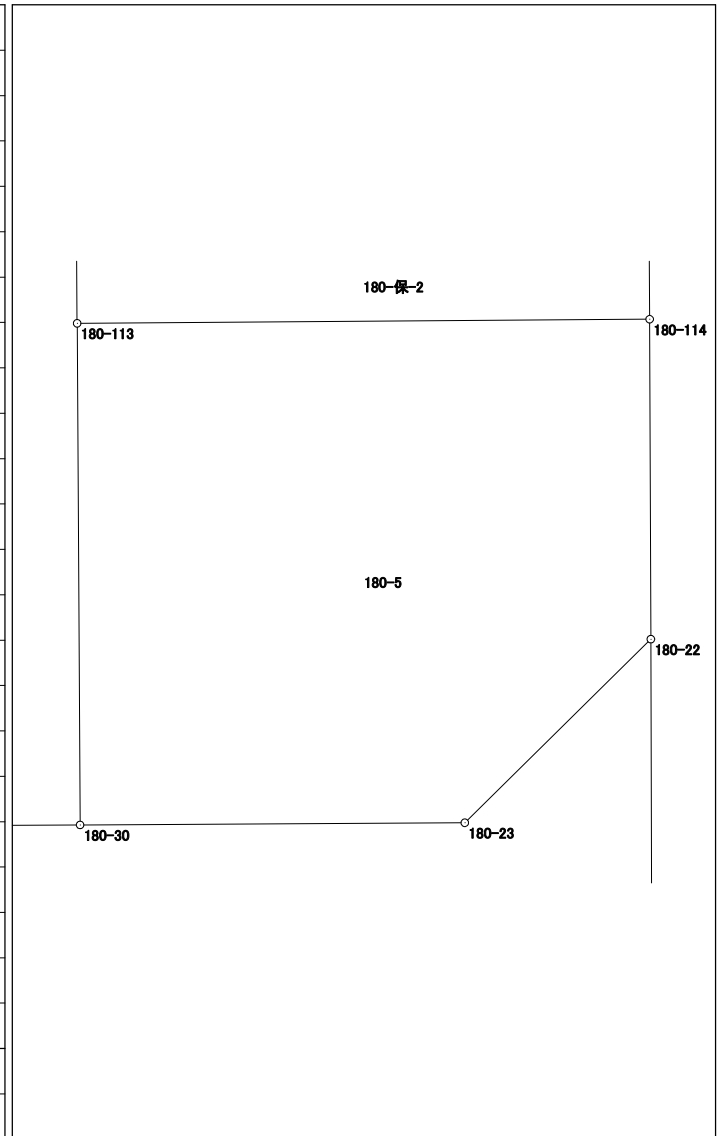


面積計算書 (座標法)

世界測地系 (測地成果2011)

所在	地番	公簿地目	現況地目	地積	所有者
前橋市六供町三丁目	180-7			63.63 m ²	

点名	X座標	Y座標	辺長	方向角	測角	DX	倍積 (Y×DX)
180-120	40854.572	-68057.379	9.014	179-41-42	90-09-33	-9.056	616327.624224
180-119	40845.558	-68057.331	7.055	89-38-34	89-56-52	-8.970	610474.259070
180-31	40845.602	-68050.276	9.028	359-41-20	90-02-46	9.072	-617352.103872
180-38	40854.630	-68050.325	1.870	269-30-35	89-49-15	9.012	-613269.528900
180-48	40854.614	-68052.195	5.184	269-32-09	180-01-34	-0.058	3947.027310
						倍面積	127.277832
						面積	63.6389160

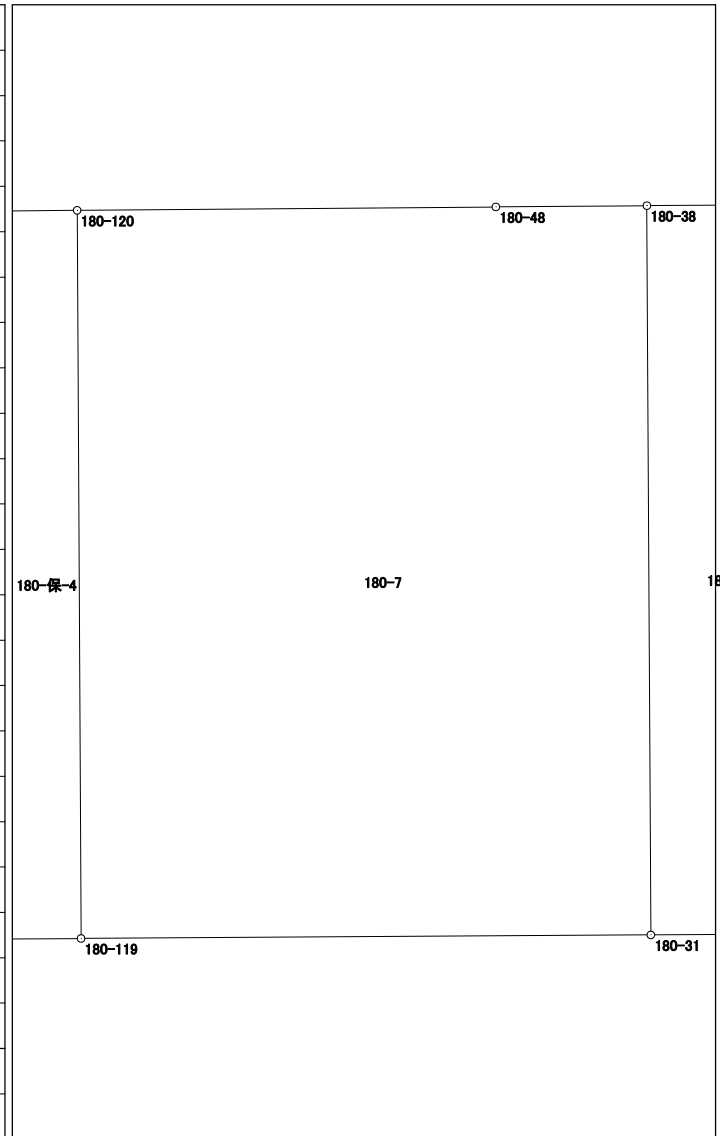

面積計算書（座標法）

世界測地系（測地成果2011）

所 在	地 番	公簿地目	現況地目	地 積	所 有 者
前橋市六供町三丁目	180-8			61.65 m ²	

点 名	X 座標	Y 座標	辺 長	方 向 角	測 角	DX	倍 積 (Y×DX)				
180-118	40854.508	-68065.778	8.994	179-43-57	90-06-23	-9.008	613136.528224				
180-117	40845.514	-68065.736	6.852	89-42-57	89-59-00	-8.960	609868.994560				
180-32	40845.548	-68058.884	9.012	359-41-19	89-58-22	9.046	-615660.664664				
180-37	40854.560	-68058.933	4.700	269-32-12	89-50-53	8.974	-610760.864742				
180-17	40854.522	-68063.633	2.145	269-37-34	180-05-22	-0.052	3539.308916				
							倍面積			123.302294	
							面 積			61.6511470	

面積計算書 (座標法)

世界測地系 (測地成果2011)

所 在	地 番	公簿地目	現況地目	地 積	所 有 者
前橋市六供町三丁目	180-9			60.70 m ²	

点 名	X 座標	Y 座標	辺 長	方 向 角	測 角	DX	倍 積 (Y×DX)			
180-116	40854.440	-68073.986	8.976	179-40-05	90-09-34	-9.034	614980.389524			
180-115	40845.464	-68073.934	6.752	89-38-06	89-58-01	-8.933	608104.452422			
180-33	40845.507	-68067.182	8.991	359-43-56	90-05-50	9.034	-614918.922188			
180-36	40854.498	-68067.224	6.762	269-30-31	89-46-35	8.933	-608044.511992			
							倍面積	121.407766		
							面 積	60.7038830		


The diagram illustrates the land plot boundaries. The vertices of the polygon are marked with small circles and labeled: 180-116 (top-left), 180-115 (bottom-left), 180-33 (bottom-right), and 180-36 (top-right). The plot is located within a larger area designated as 180-9. The left boundary of this area is labeled 180-保-6 and the right boundary is labeled 180-保-5.

面積計算書（座標法）

世界測地系（測地成果2011）

所在	地番	公簿地目	現況地目	地積	所有者
前橋市六供町三丁目	180-10			67.22 m ²	

点名	X座標	Y座標	辺長	方向角	測角	DX	倍積 (Y×DX)
180-112	40851.842	-68075.531	11.204	269-31-10	89-50-32	6.294	-428467.392114
180-111	40851.748	-68086.735	3.578	178-56-35	89-25-25	-3.671	249946.404185
180-25	40848.171	-68086.669	4.012	133-40-38	134-44-03	-6.348	432214.174812
180-24	40845.400	-68083.767	8.272	89-37-34	135-56-56	-2.717	184983.594939
180-34	40845.454	-68075.495	6.388	359-40-38	90-03-04	6.442	-438542.338790
						倍面積	134.443032
						面積	67.2215160

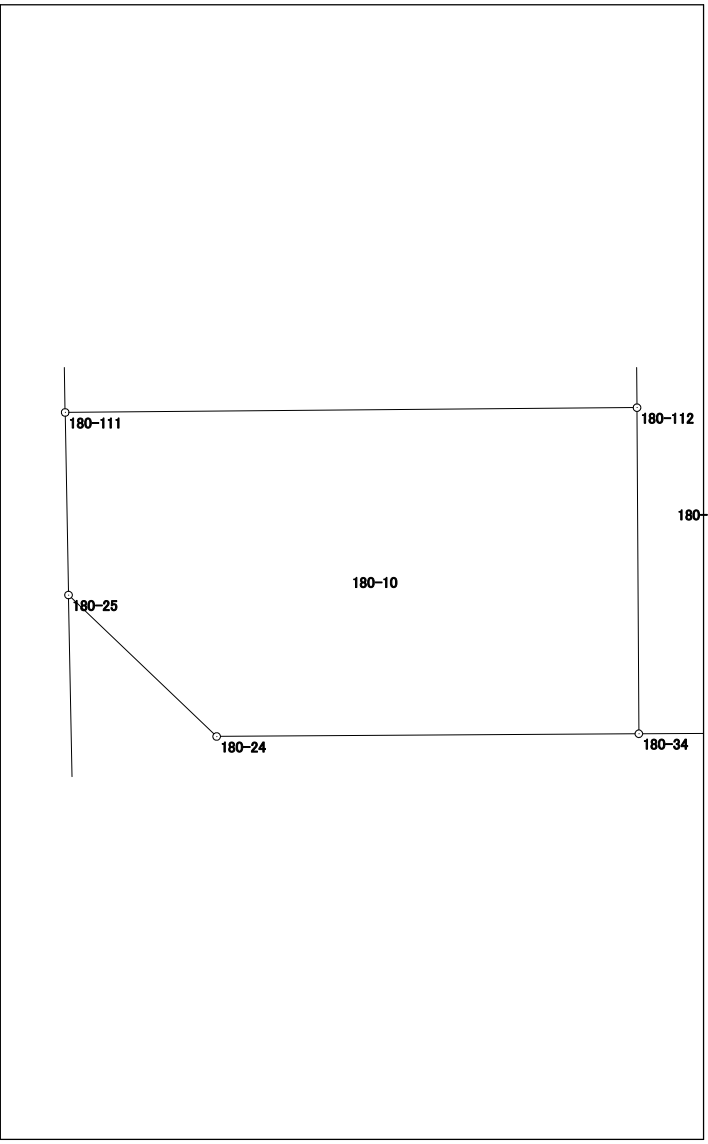


面積計算書（座標法）

世界測地系（測地成果2011）

所 在	地 番	公簿地目	現況地目	地 積	所 有 者
前橋市六供町三丁目	180-11			51.08 m ²	

点 名	X 座標	Y 座標	辺 長	方 向 角	測 角	DX	倍 積 (Y×DX)
180-102	40856.540	-68086.828	2.207	178-51-28	89-19-39	-2.397	163204.126716
180-19	40854.333	-68086.784	11.238	89-31-15	90-39-47	-2.113	143867.374592
180-35	40854.427	-68075.546	1.560	89-31-21	180-00-06	0.107	-7284.083422
180-116	40854.440	-68073.986	6.762	89-30-31	179-59-10	0.071	-4833.253006
180-36	40854.498	-68067.224	1.446	89-36-14	180-05-43	0.068	-4628.571232
180-118	40854.508	-68065.778	2.145	89-37-34	180-01-20	0.024	-1633.578672
180-17	40854.522	-68063.633	1.092	359-25-22	89-47-48	1.106	-75278.378098
180-126	40855.614	-68063.644	1.116	359-26-07	180-00-45	2.208	-150284.525952
180-105	40856.730	-68063.655	23.174	269-31-49	90-05-42	0.926	-63026.944530

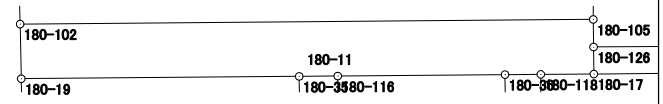


倍面積	102.166396
面積	51.0831980

面積計算書 (座標法)

世界測地系 (測地成果2011)

所 在	地 番	公簿地目	現況地目	地 積	所 有 者
前橋市六供町三丁目	180-12			35.06 m ²	


点 名	X 座標	Y 座標	辺 長	方 向 角	測 角	DX	倍 積 (Y×DX)
180-104	40858.053	-68086.858	1.513	178-51-51	89-19-52	-1.702	115883.832316
180-102	40856.540	-68086.828	23.174	89-31-49	90-39-58	-1.323	90078.873444
180-105	40856.730	-68063.655	1.512	359-25-54	89-54-05	1.702	-115844.340810
180-106	40858.242	-68063.670	23.189	269-31-59	90-06-05	1.323	-90048.235410
						倍面積	70.129540
						面 積	35.0647700

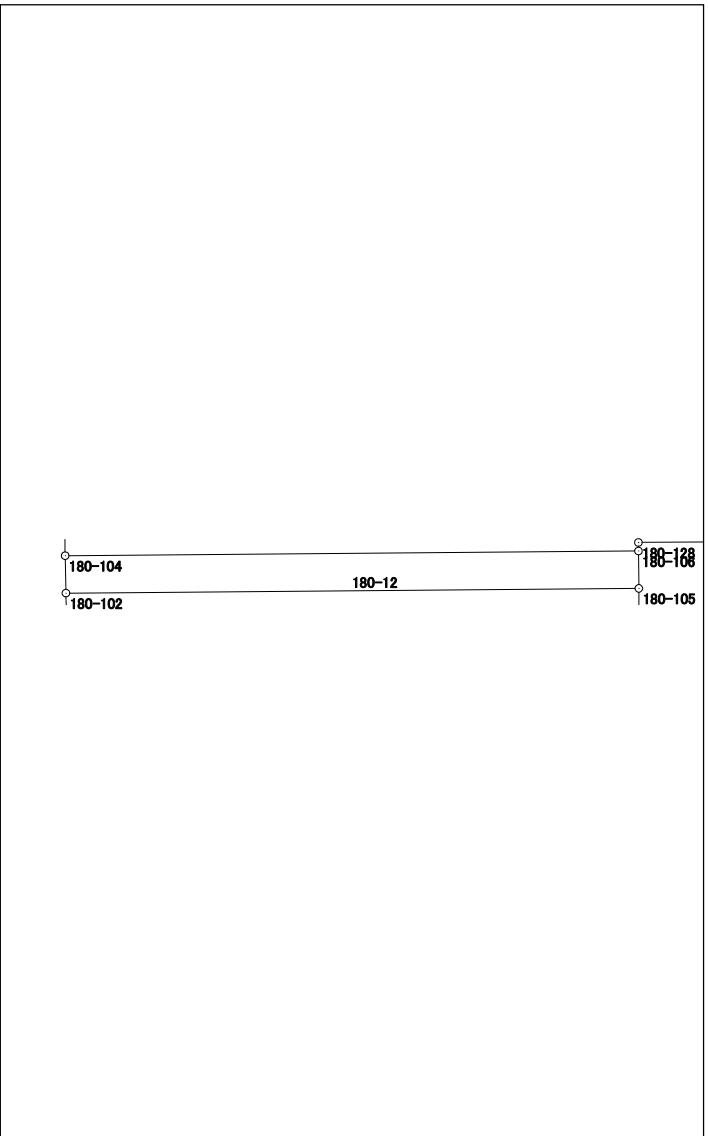

面積計算書（座標法）

世界測地系（測地成果2011）

所 在	地 番	公簿地目	現況地目	地 積	所 有 者
前橋市六供町三丁目	180-保-1			33.00 m ²	

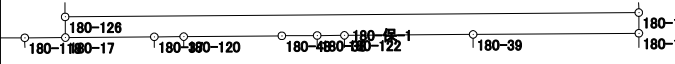
点 名	X 座標	Y 座標	辺 長	方 向 角	測 角	DX	倍 積 (Y×DX)	
180-17	40854.522	-68063.633	4.700	89-32-12	90-06-50	-1.054	71739.069182	
180-37	40854.560	-68058.933	1.554	89-33-27	180-01-15	0.050	-3402.946650	
180-120	40854.572	-68057.379	5.184	89-32-09	179-58-42	0.054	-3675.098466	
180-48	40854.614	-68052.195	1.870	89-30-35	179-58-26	0.058	-3947.027310	
180-38	40854.630	-68050.325	1.440	89-36-08	180-05-33	0.026	-1769.308450	
180-122	40854.640	-68048.885	6.800	89-35-44	179-59-36	0.058	-3946.835330	
180-39	40854.688	-68042.085	8.758	89-35-40	179-59-56	0.110	-7484.629350	
180-18	40854.750	-68033.327	1.093	359-47-25	90-11-45	1.155	-78578.492685	
180-125	40855.843	-68033.331	30.314	269-34-02	89-46-37	0.864	-58780.797984	
180-126	40855.614	-68063.644	1.092	179-25-22	89-51-20	-1.321	89912.073724	
						倍面積	66.006681	
						面 積	33.0033405	

面積計算書 (座標法)

世界測地系 (測地成果2011)

所在	地番	公簿地目	現況地目	地積	所有者
前橋市六供町三丁目	180-保-2			12.00 m ²	

点名	X座標	Y座標	辺長	方向角	測角	DX	倍積 (Y×DX)
180-113	40853.317	-68042.077	8.755	89-35-16	89-55-20	-1.308	88999.036716
180-114	40853.380	-68033.322	1.370	359-47-27	90-12-11	1.433	-97491.750426
180-18	40854.750	-68033.327	8.758	269-35-40	89-48-13	1.308	-88987.591716
180-39	40854.688	-68042.085	1.371	179-39-56	90-04-16	-1.433	97504.307805

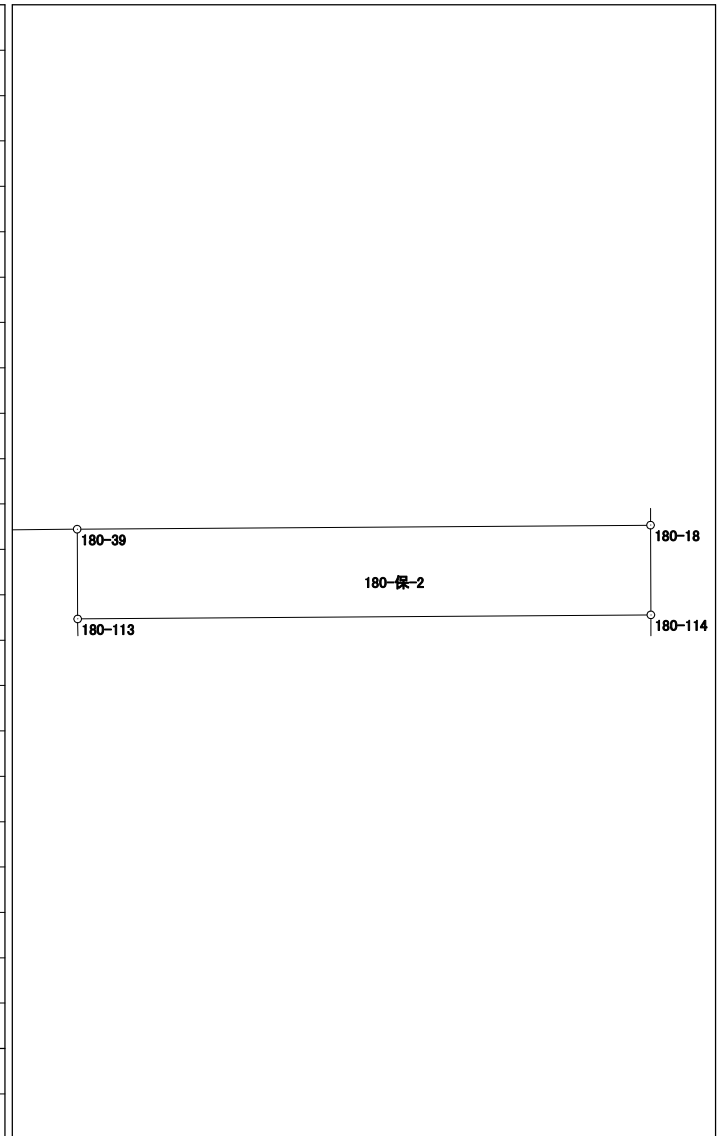


倍面積	24.002379
面積	12.0011895

面積計算書 (座標法)

世界測地系 (測地成果2011)

所在	地番	公簿地目	現況地目	地積	所有者
前橋市六供町三丁目	180-保-3			13.00 m ²	

点名	X座標	Y座標	辺長	方向角	測角	DX	倍積 (Y×DX)
180-121	40845.610	-68048.836	9.030	359-41-21	90-00-27	9.038	-615025.379768
180-122	40854.640	-68048.885	1.440	269-36-08	89-54-47	9.020	-613800.942700
180-38	40854.630	-68050.325	9.028	179-41-20	90-05-12	-9.038	615038.837350
180-31	40845.602	-68050.276	1.440	89-40-54	89-59-34	-9.020	613813.489520

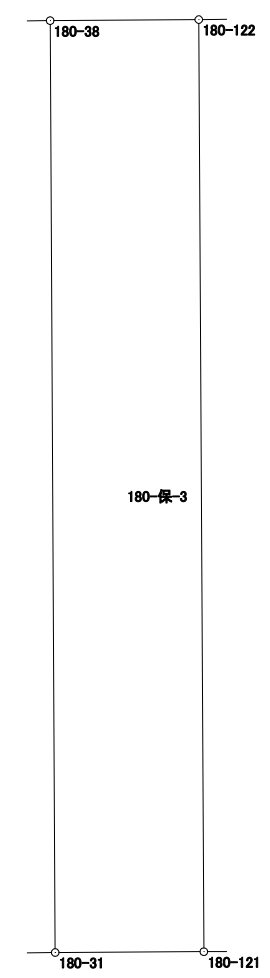


倍面積	26.004402
面積	13.0022010

面積計算書 (座標法)

世界測地系 (測地成果2011)

所 在	地 番	公簿地目	現況地目	地 積	所 有 者
前橋市六供町三丁目	180-保-4			14.00 m ²	

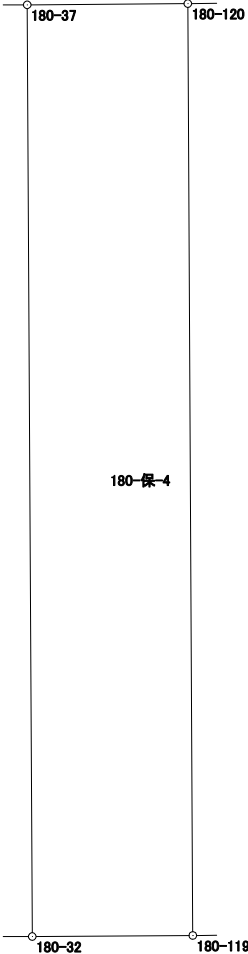
点 名	X 座標	Y 座標	辺 長	方 向 角	測 角	DX	倍 積 (Y×DX)	
180-119	40845.558	-68057.331	9.014	359-41-42	90-03-50	9.024	-614149.354944	
180-120	40854.572	-68057.379	1.554	269-33-27	89-51-45	9.002	-612652.525758	
180-37	40854.560	-68058.933	9.012	179-41-19	90-07-52	-9.024	614163.811392	
180-32	40845.548	-68058.884	1.553	89-37-52	89-56-33	-9.002	612666.073768	
倍面積							28.004458	
面 積							14.0022290	

面積計算書（座標法）

世界測地系（測地成果2011）

所 在	地 番	公簿地目	現況地目	地 積	所 有 者
前橋市六供町三丁目	180-保-5			13.00 m ²	

点 名	X 座標	Y 座標	辺 長	方 向 角	測 角	DX	倍 積 (Y×DX)
180-117	40845.514	-68065.736	8.994	359-43-57	90-00-36	9.001	-612659.689736
180-118	40854.508	-68065.778	1.446	269-36-14	89-52-17	8.984	-611502.949552
180-36	40854.498	-68067.224	8.991	179-43-56	90-07-42	-9.001	612673.083224
180-33	40845.507	-68067.182	1.446	89-43-21	89-59-25	-8.984	611515.563088
						倍面積	26.007024
						面 積	13.0035120

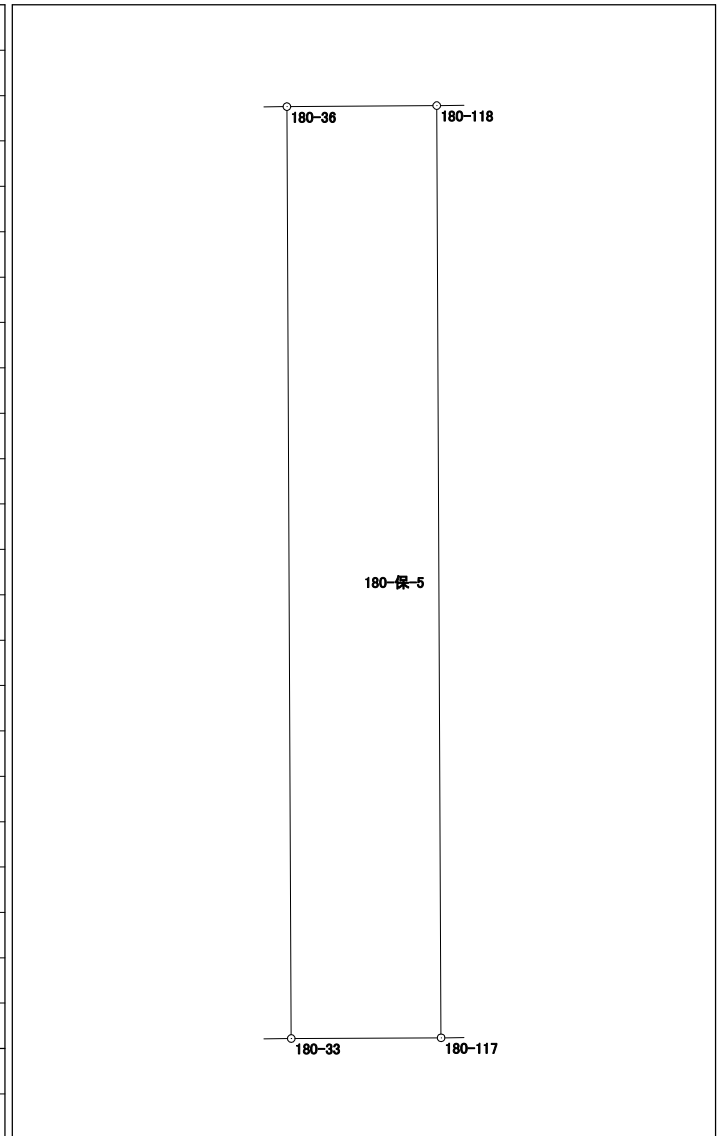


面積計算書 (座標法)

世界測地系 (測地成果2011)

所 在	地 番	公簿地目	現況地目	地 積	所 有 者
前橋市六供町三丁目	180-保-6			14.00 m ²	

点 名	X 座標	Y 座標	辺 長	方 向 角	測 角	DX	倍 積 (Y×DX)
180-115	40845.464	-68073.934	8.976	359-40-05	90-02-06	8.986	-611712.370924
180-116	40854.440	-68073.986	1.560	269-31-21	89-51-16	8.963	-610147.136518
180-35	40854.427	-68075.546	2.585	179-40-03	90-08-42	-2.598	176860.268508
180-112	40851.842	-68075.531	6.388	179-40-38	180-00-35	-8.973	610841.739663
180-34	40845.454	-68075.495	1.561	89-37-59	89-57-21	-6.378	434185.507110
						倍面積	28.007839
						面 積	14.0039195

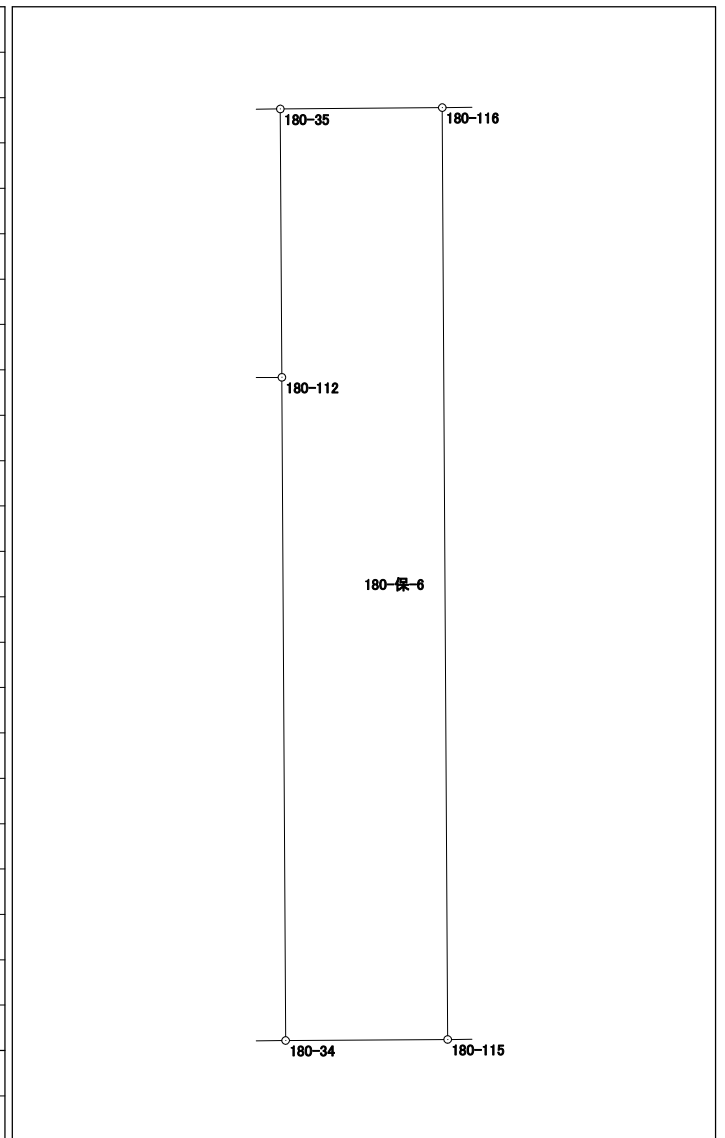


面積計算書 (座標法)

世界測地系 (測地成果2011)

所在	地番	公簿地目	現況地目	地積	所有者
前橋市六供町三丁目	180-保-7			29.00 m ²	

点名	X座標	Y座標	辺長	方向角	測角	DX	倍積 (Y×DX)
180-111	40851.748	-68086.735	11.204	89-31-10	90-36-19	-2.491	169604.056885
180-112	40851.842	-68075.531	2.585	359-40-03	90-08-53	2.679	-182374.347549
180-35	40854.427	-68075.546	11.238	269-31-15	89-51-12	2.491	-169576.185086
180-19	40854.333	-68086.784	2.585	178-54-51	89-23-36	-2.679	182404.494336

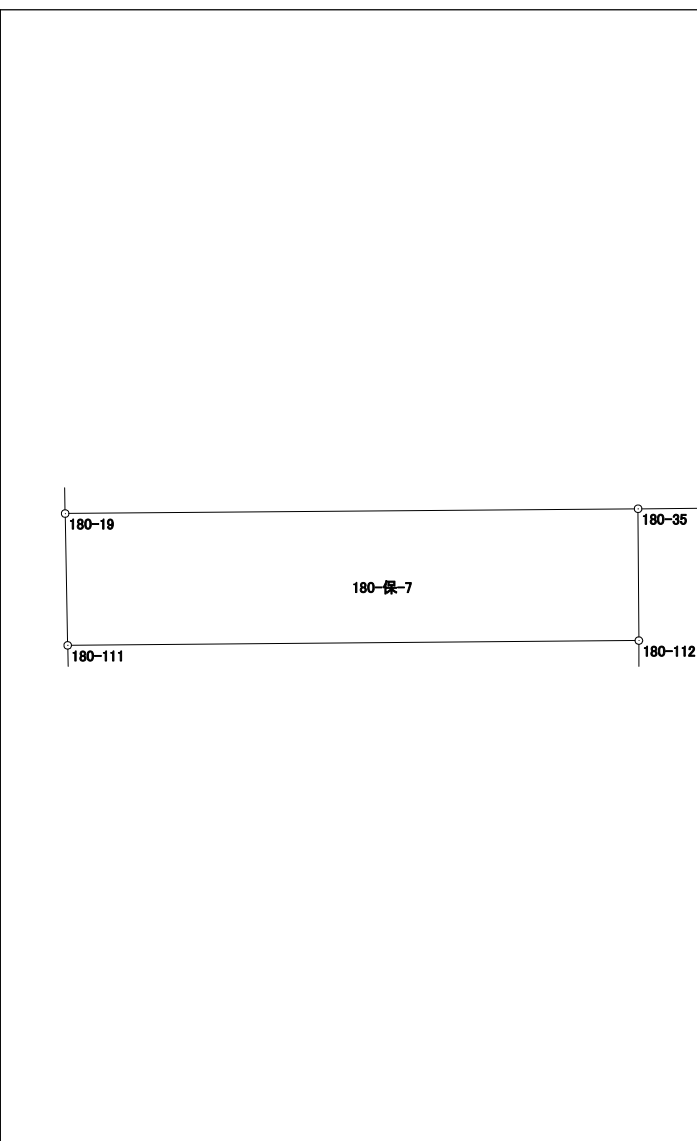

倍面積	58.018586
面積	29.0092930