
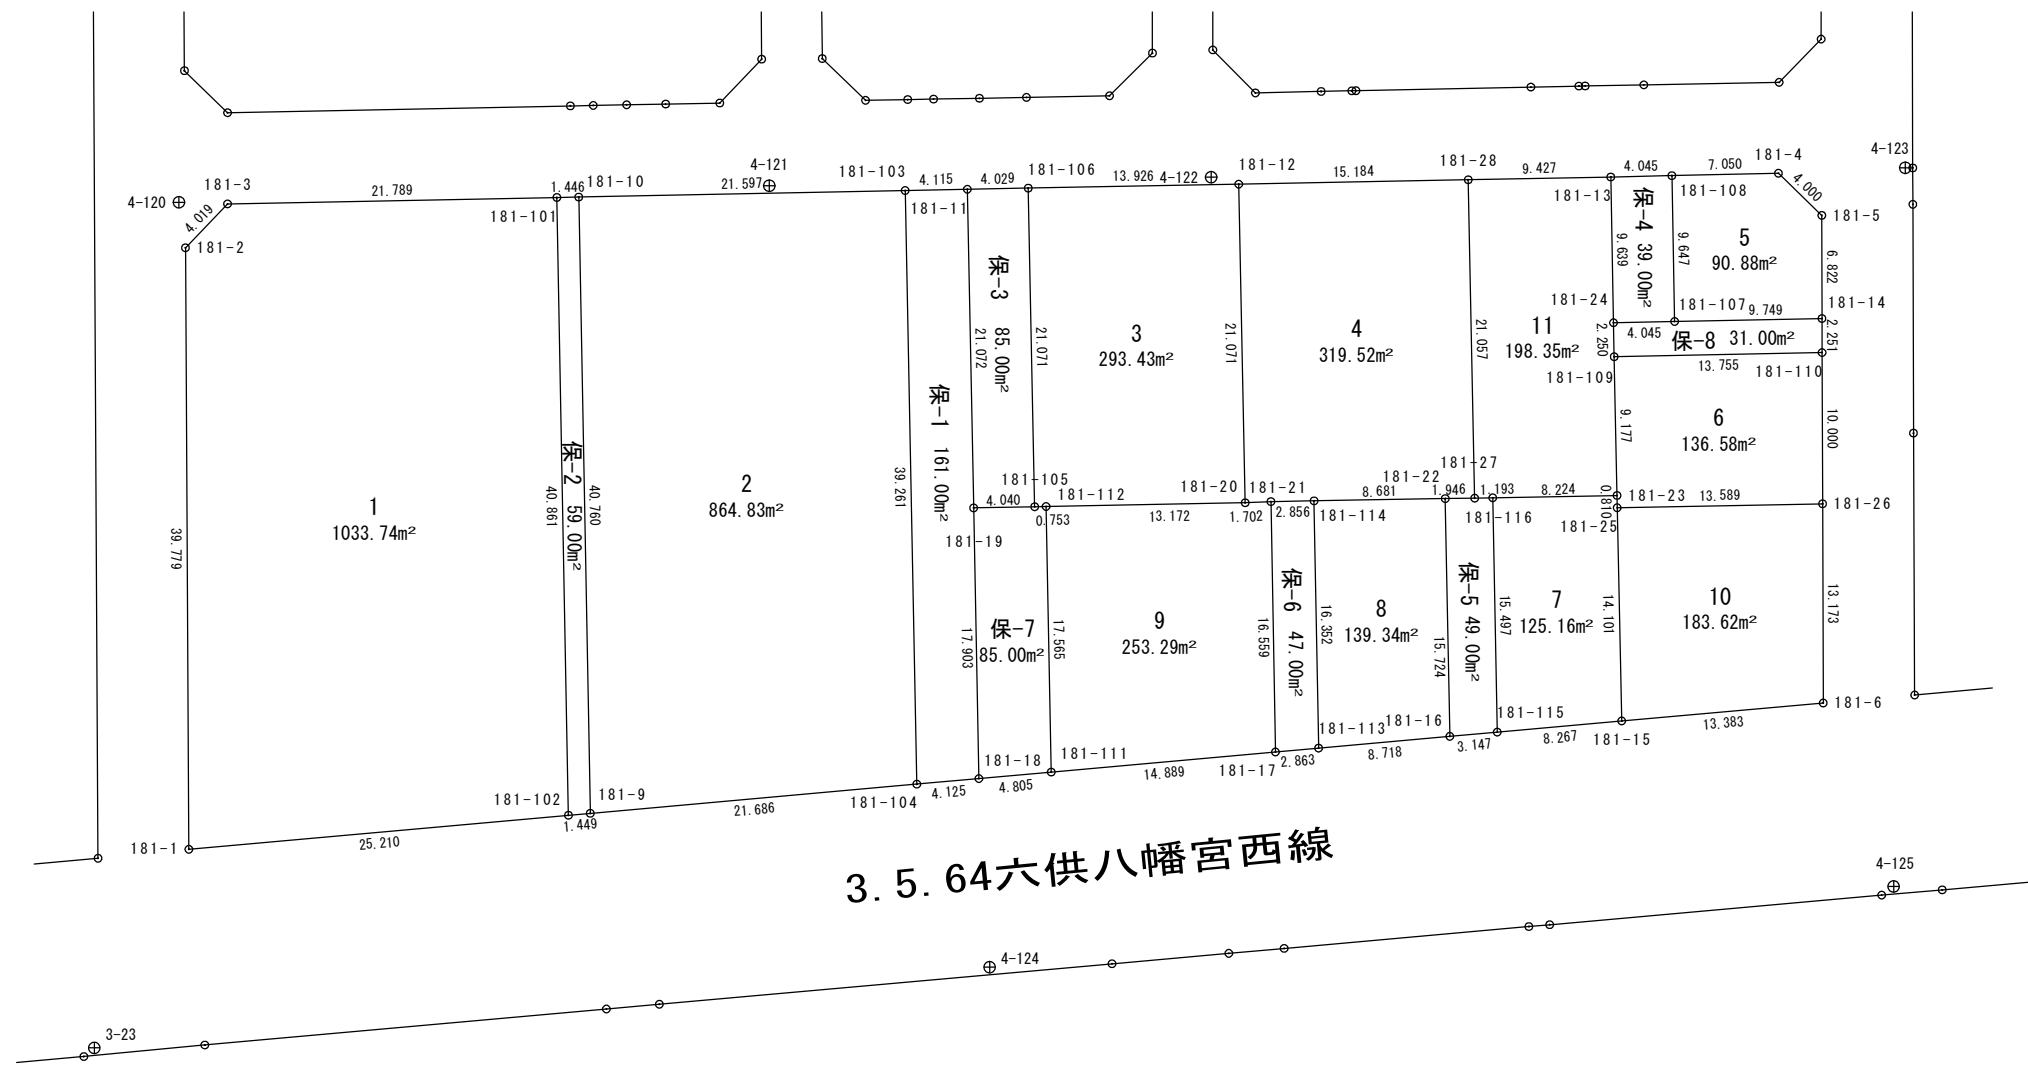


181街区 画地出来形確認図 (4194.83m²)

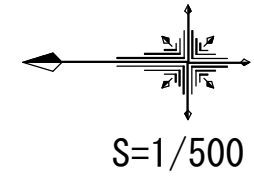


面積計算書 (座標法)

世界測地系 (測地成果2011)

所在	地番	公簿地目	現況地目	地積	所有者
前橋市六供町三丁目	181-2			864.83 m ²	

点名	X座標	Y座標	辺長	方向角	測角	DX	倍積 (Y×DX)
181-104	40835.138	-68131.708	39.261	88-52-34	93-59-05	-20.830	1419183.477640
181-103	40835.908	-68092.455	21.597	358-51-23	89-58-49	22.363	-1522751.571165
181-10	40857.501	-68092.886	40.760	268-55-39	90-04-16	20.830	-1418374.815380
181-9	40856.738	-68133.639	21.686	174-53-29	85-57-50	-22.363	1523672.568957

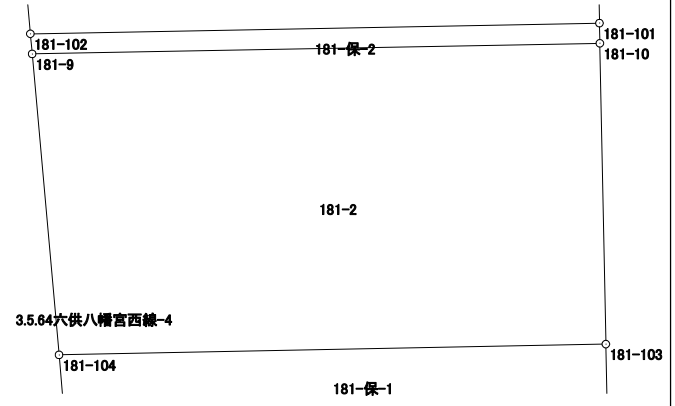


倍面積	1729.660052
面積	864.8300260

面積計算書（座標法）

世界測地系（測地成果2011）

所 在	地 番	公簿地目	現況地目	地 積	所 有 者
前橋市六供町三丁目	181-3			293.43 m ²	


点 名	X 座標	Y 座標	辺 長	方 向 角	測 角	DX	倍 積 (Y×DX)
181-105	40827.340	-68113.364	0.753	178-56-06	90-05-36	-1.179	80305.656156
181-112	40826.587	-68113.350	13.172	178-55-01	179-58-55	-13.923	948342.172050
181-20	40813.417	-68113.101	21.071	88-50-39	89-55-38	-12.745	868101.472245
181-12	40813.842	-68092.034	13.926	358-55-04	90-04-25	14.349	-977052.595866
181-106	40827.766	-68092.297	21.071	268-50-30	89-55-26	13.498	-919109.824906
倍面積							586.879679
面 積							293.4398395

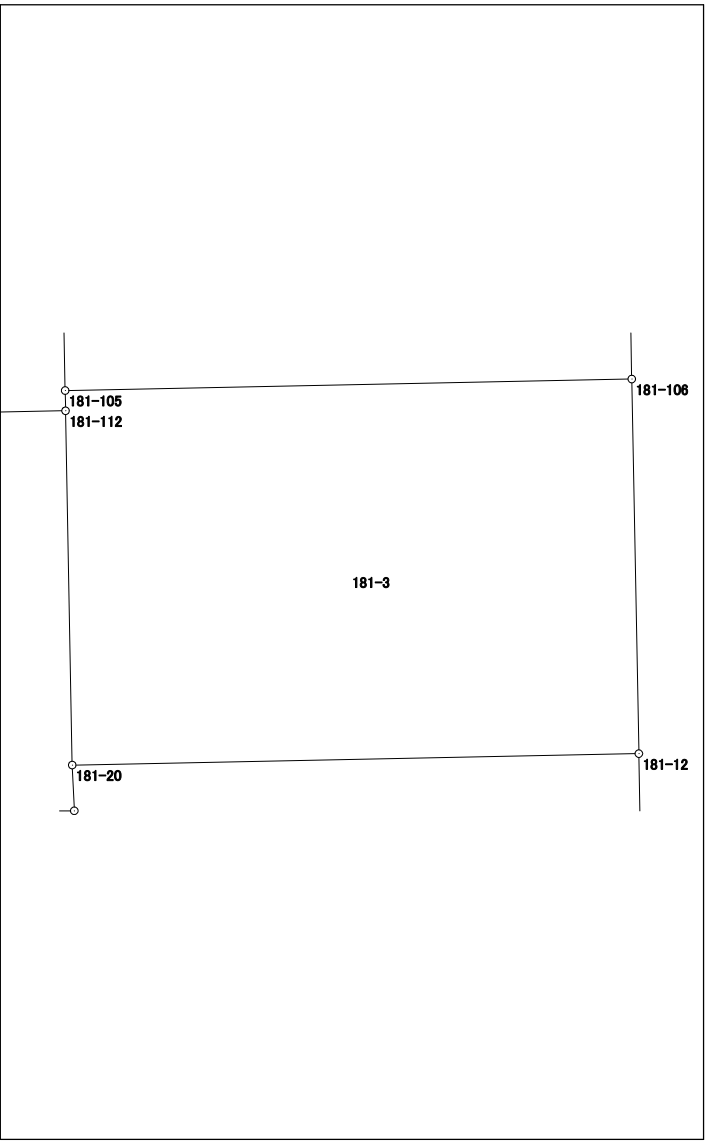

面積計算書（座標法）

世界測地系（測地成果2011）

所 在	地 番	公簿地目	現況地目	地 積	所 有 者
前橋市六供町三丁目	181-4			319.52 m ²	

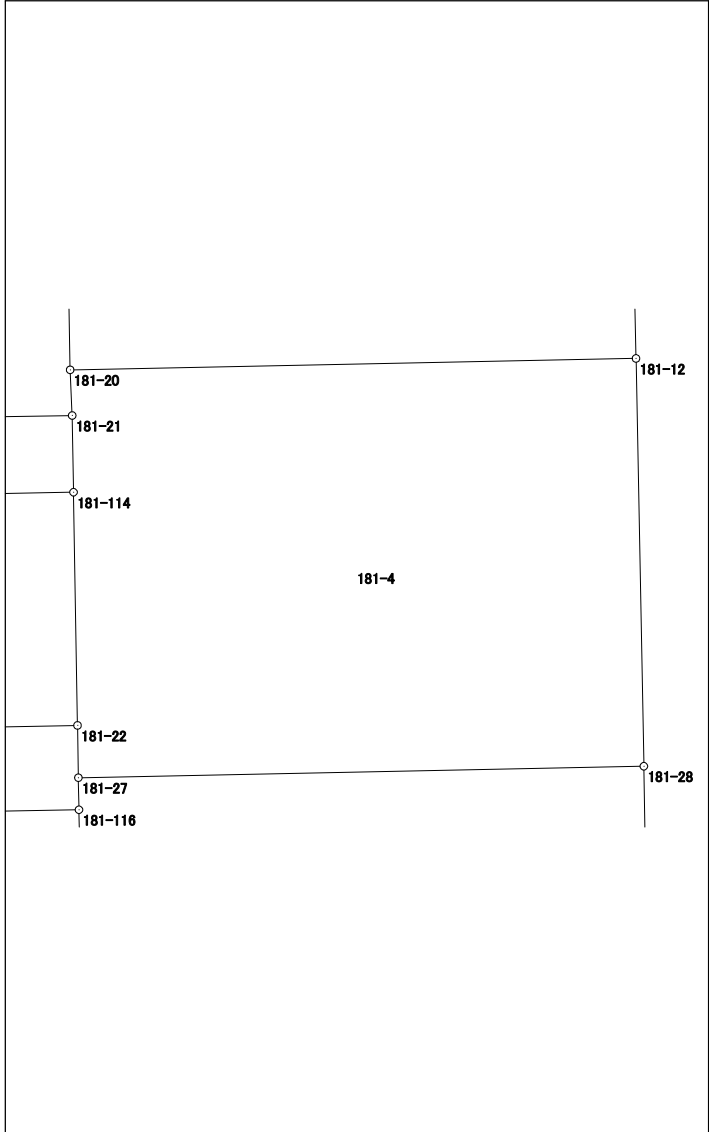
点 名	X 座標	Y 座標	辺 長	方 向 角	測 角	DX	倍 積 (Y×DX)	
181-21	40811.717	-68113.025	2.856	179-01-01	181-34-36	-4.556	310322.941900	
181-114	40808.861	-68112.976	8.681	179-01-00	179-59-59	-11.536	785751.291136	
181-22	40800.181	-68112.827	1.946	179-03-28	180-02-28	-10.626	723766.899702	
181-27	40798.235	-68112.795	21.057	88-50-27	89-46-59	-1.520	103531.448400	
181-28	40798.661	-68091.742	15.184	358-53-53	90-03-26	15.607	-1062707.817394	
181-12	40813.842	-68092.034	21.071	268-50-39	89-56-46	14.756	-1004766.053704	
181-20	40813.417	-68113.101	1.702	177-26-25	88-35-46	-2.125	144740.339625	
						倍面積	639.049665	
						面 積	319.5248325	

面積計算書 (座標法)

世界測地系 (測地成果2011)

所在	地番	公簿地目	現況地目	地積	所有者
前橋市六供町三丁目	181-5			90.88 m ²	

点名	X座標	Y座標	辺長	方向角	測角	Dx	倍積 (Y×Dx)
181-108	40785.192	-68091.469	9.647	268-55-08	90-12-11	6.866	-467516.026154
181-107	40785.010	-68101.114	9.749	178-51-14	89-56-06	-9.929	676175.960906
181-14	40775.263	-68100.919	6.822	89-54-27	91-03-13	-9.736	663030.547384
181-5	40775.274	-68094.097	4.000	44-08-57	134-14-30	2.881	-196179.093457
181-4	40778.144	-68091.311	7.050	358-42-57	134-34-00	9.918	-675329.622498

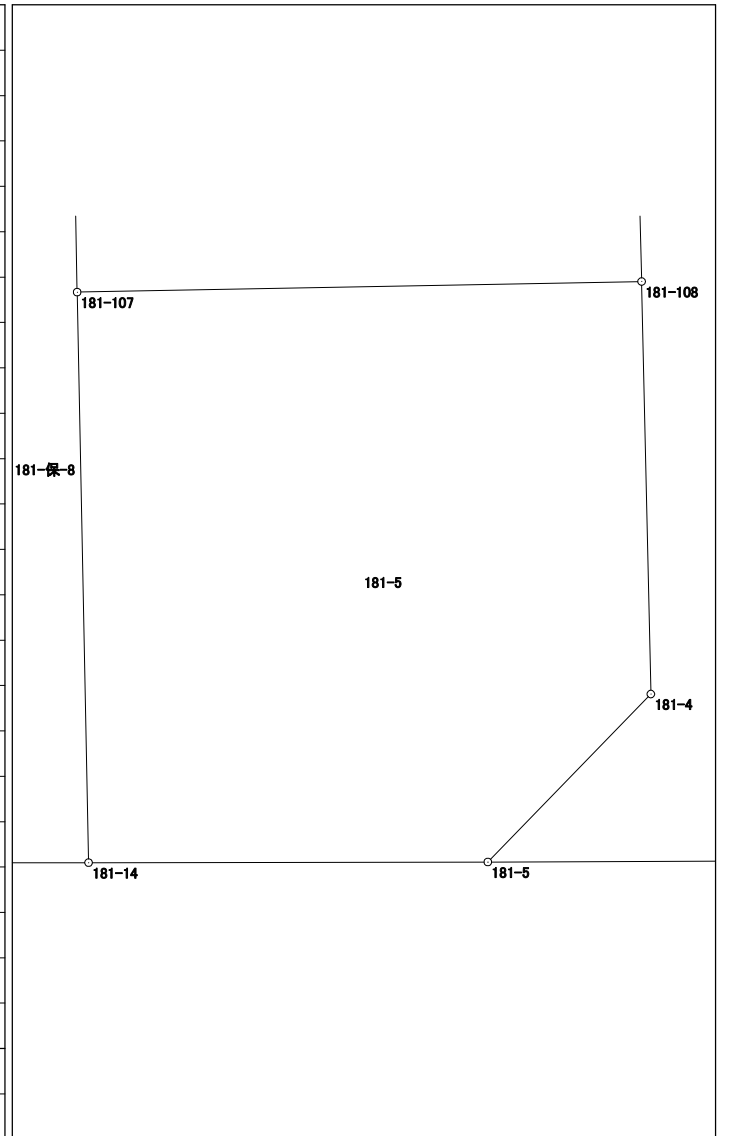


倍面積	181.766181
面積	90.8830905

面積計算書 (座標法)

世界測地系 (測地成果2011)

所在	地番	公簿地目	現況地目	地積	所有者
前橋市六供町三丁目	181-6			136.58 m ²	

点名	X座標	Y座標	辺長	方向角	測角	DX	倍積 (Y×DX)
181-110	40775.256	-68103.170	13.755	358-51-01	89-02-22	13.785	-938802.198450
181-109	40789.008	-68103.446	9.177	268-49-12	89-58-11	13.563	-923687.038098
181-23	40788.819	-68112.621	0.810	269-17-34	180-28-22	-0.199	13554.411579
181-25	40788.809	-68113.431	13.589	178-53-58	89-36-24	-13.596	926070.207876
181-26	40775.223	-68113.170	10.000	89-48-39	90-54-41	-13.553	923137.793010

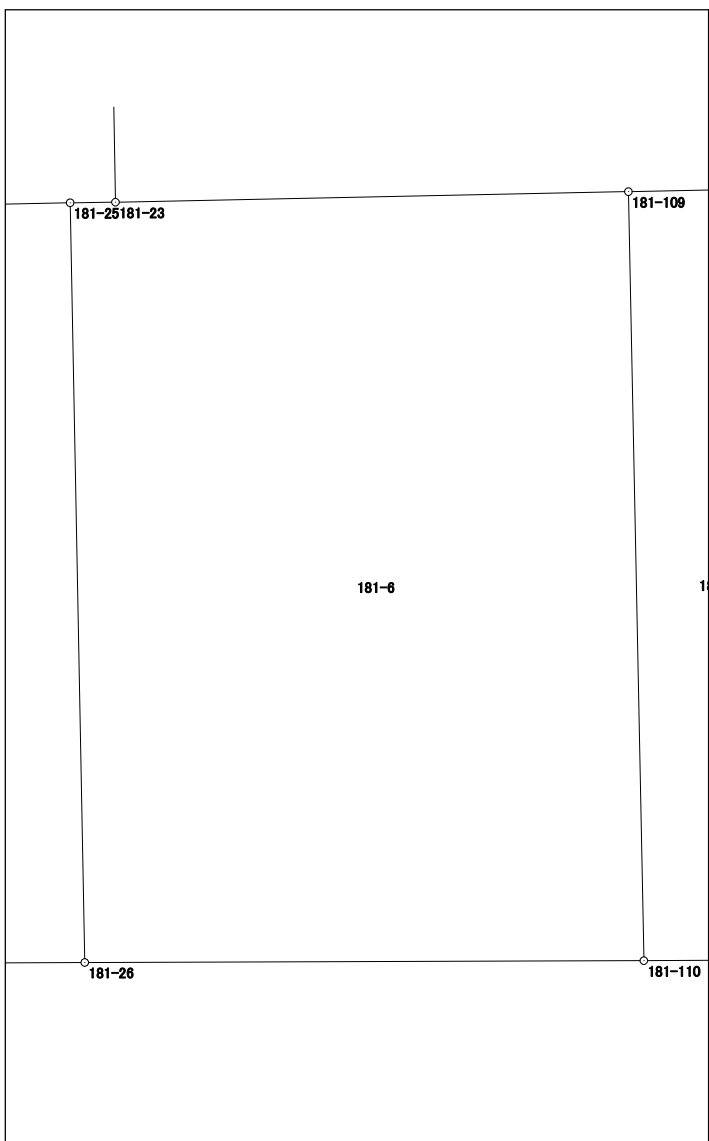


倍面積	273.175917
面積	136.5879585

面積計算書（座標法）

世界測地系（測地成果2011）

所 在	地 番	公簿地目	現況地目	地 積	所 有 者
前橋市六供町三丁目	181-7			125.16 m ²	

点 名	X 座標	Y 座標	辺 長	方 向 角	測 角	DX	倍 積 (Y×DX)
181-116	40797.042	-68112.773	15.497	268-54-07	89-57-39	7.926	-539861.838798
181-115	40796.745	-68128.267	8.267	174-52-42	85-58-35	-8.531	581202.245777
181-15	40788.511	-68127.529	14.101	88-47-21	93-54-39	-7.936	540660.070144
181-25	40788.809	-68113.431	0.810	89-17-34	180-30-13	0.308	-20978.936748
181-23	40788.819	-68112.621	8.224	358-56-28	89-38-54	8.233	-560771.208693
						倍面積	250.331682
						面 積	125.1658410

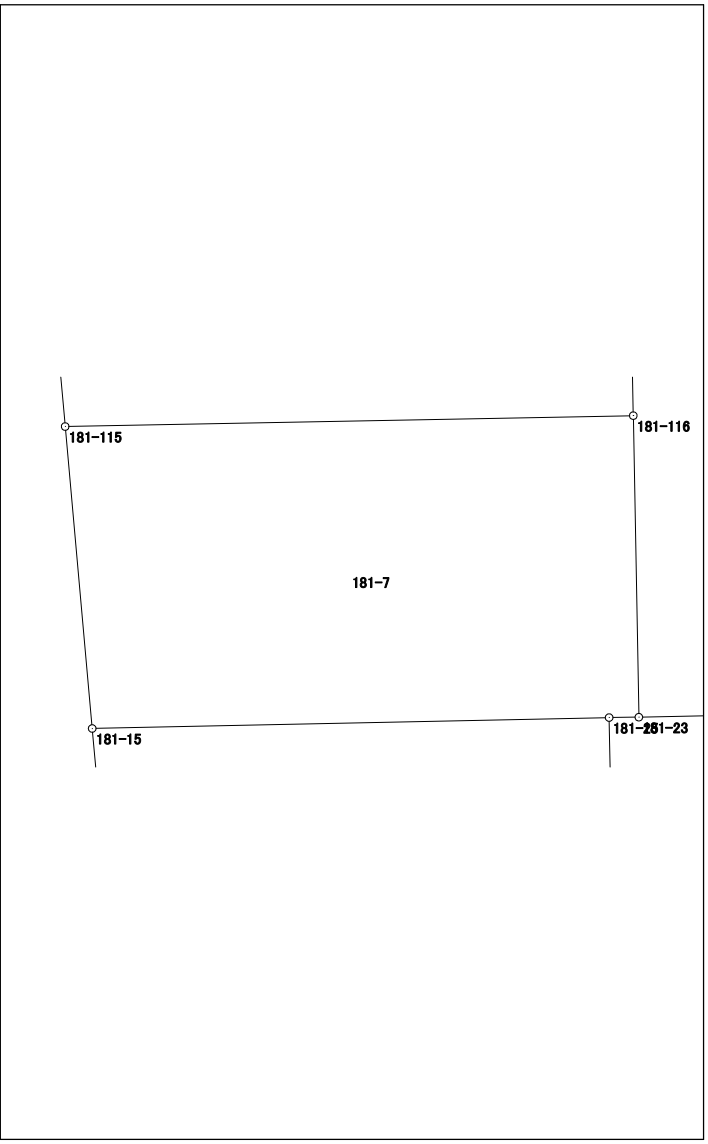


面積計算書 (座標法)

世界測地系 (測地成果2011)

所在	地番	公簿地目	現況地目	地積	所有者
前橋市六供町三丁目	181-8			139.34 m ²	

点名	X座標	Y座標	辺長	方向角	測角	DX	倍積 (Y×DX)
181-114	40808.861	-68112.976	16.352	268-57-08	89-56-08	8.381	-570854.851856
181-113	40808.562	-68129.325	8.718	174-53-11	85-56-03	-8.982	611937.597150
181-16	40799.879	-68128.548	15.724	88-53-58	94-00-47	-8.381	570985.360788
181-22	40800.181	-68112.827	8.681	359-01-00	90-07-02	8.982	-611789.412114

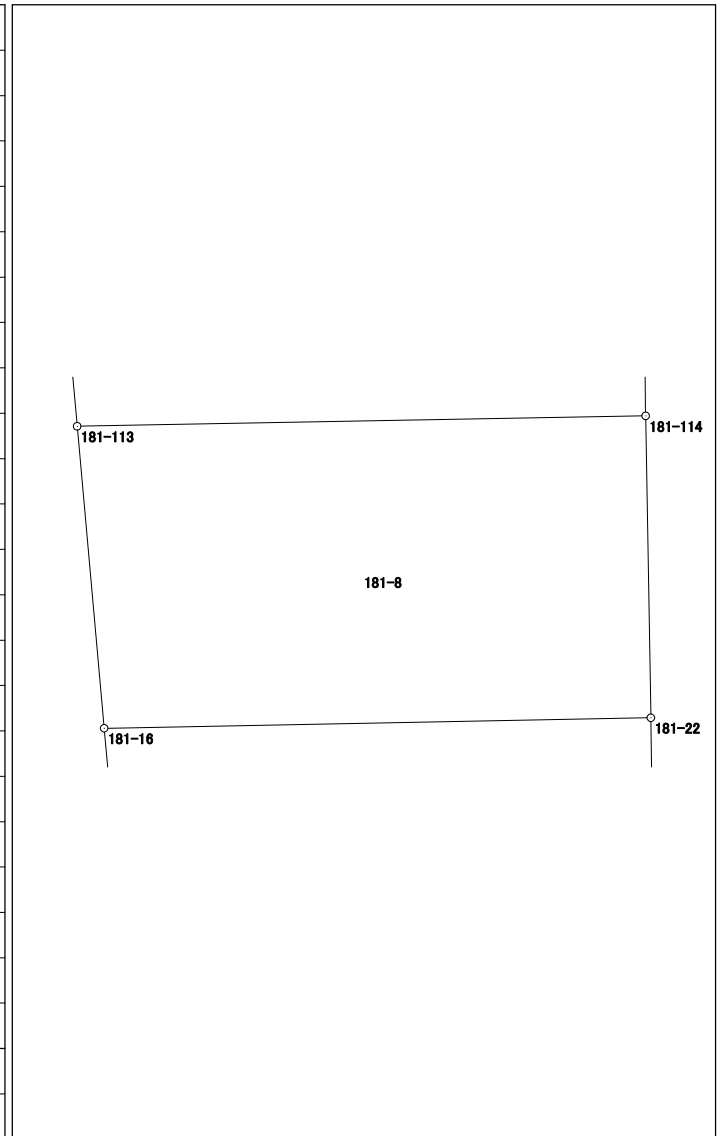


倍面積	278.693968
面積	139.3469840

面積計算書 (座標法)

世界測地系 (測地成果2011)

所 在	地 番	公簿地目	現況地目	地 積	所 有 者
前橋市六供町三丁目	181-9			253.29 m ²	

点 名	X 座標	Y 座標	辺 長	方 向 角	測 角	DX	倍 積 (Y×DX)
181-112	40826.587	-68113.350	17.565	268-52-40	89-57-39	12.826	-873621.827100
181-111	40826.243	-68130.912	14.889	174-52-16	85-59-36	-15.173	1033750.327776
181-17	40811.414	-68129.581	16.559	88-57-05	94-04-49	-14.526	989650.293606
181-21	40811.717	-68113.025	1.702	357-26-25	88-29-20	2.003	-136430.389075
181-20	40813.417	-68113.101	13.172	358-55-01	181-28-36	14.870	-1012841.811870
						倍面積	506.593337
						面 積	253.296685

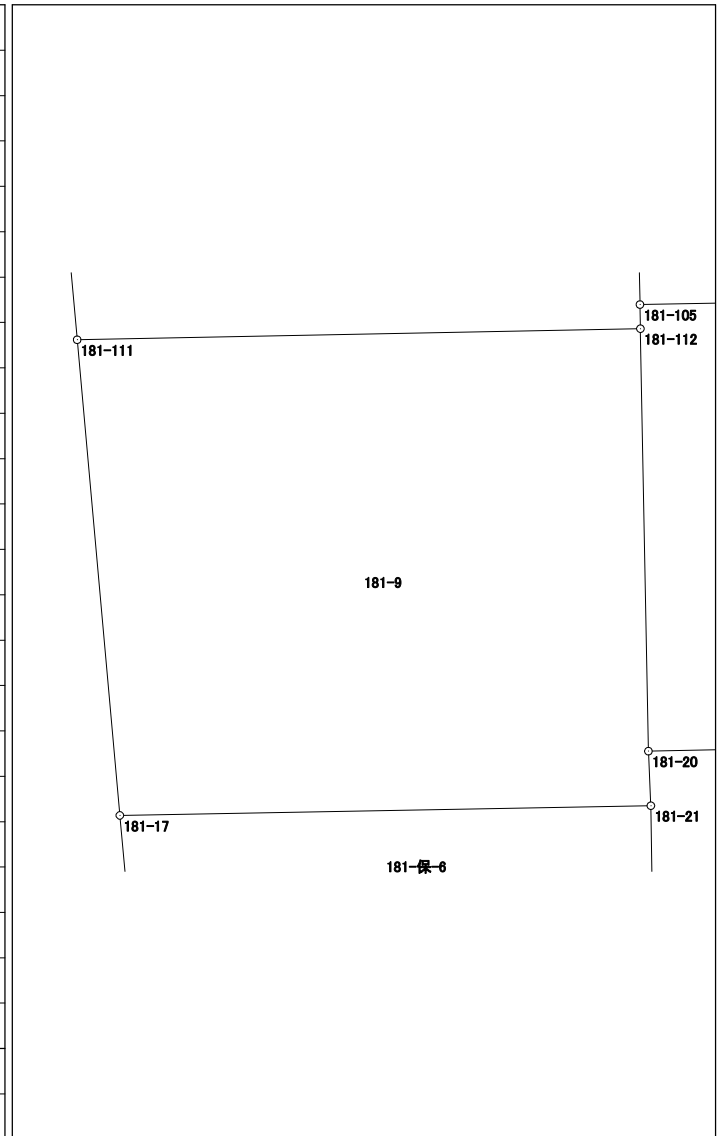

面積計算書（座標法）

世界測地系（測地成果2011）

所 在	地 番	公簿地目	現況地目	地 積	所 有 者
前橋市六供町三丁目	181-11			198.35 m ²	


点 名	X 座標	Y 座標	辺 長	方 向 角	測 角	DX	倍 積 (Y×DX)	
181-23	40788.819	-68112.621	9.177	88-49-12	89-52-44	-8.034	547216.797114	
181-109	40789.008	-68103.446	2.250	88-49-44	180-00-32	0.235	-16004.309810	
181-24	40789.054	-68101.196	9.639	88-55-05	180-05-21	0.228	-15527.072688	
181-13	40789.236	-68091.559	9.427	358-53-16	89-58-11	9.607	-654155.607313	
181-28	40798.661	-68091.742	21.057	268-50-27	89-57-11	8.999	-612757.586258	
181-27	40798.235	-68112.795	1.193	178-56-37	90-06-10	-1.619	110274.615105	
181-116	40797.042	-68112.773	8.224	178-56-28	179-59-51	-9.416	641349.870568	
							倍面積	396.706718
							面 積	198.3533590

面積計算書 (座標法)

世界測地系 (測地成果2011)

所在	地番	公簿地目	現況地目	地積	所有者
前橋市六供町三丁目	181-保-1			161.00 m ²	


点名	X座標	Y座標	辺長	方向角	測角	DX	倍積 (Y×DX)
181-103	40835.908	-68092.455	39.261	268-52-34	90-01-05	3.344	-227701.169520
181-104	40835.138	-68131.708	4.125	174-53-46	86-01-12	-4.879	332414.603332
181-18	40831.029	-68131.341	17.903	88-52-47	93-59-01	-3.759	256105.710819
181-19	40831.379	-68113.441	21.072	88-52-17	179-59-30	0.765	-52106.782365
181-11	40831.794	-68092.373	4.115	358-51-29	89-59-12	4.529	-308390.357317
						倍面積	322.004949
						面積	161.0024745

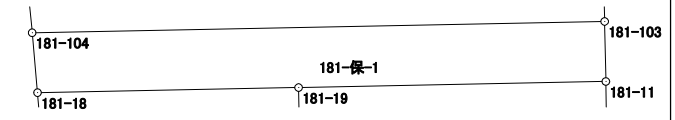

面積計算書（座標法）

世界測地系（測地成果2011）


所在	地番	公簿地目	現況地目	地積	所有者
前橋市六供町三丁目	181-保-2			59.00 m ²	

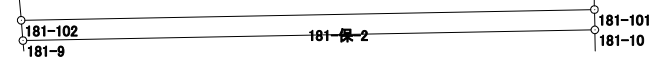点名	X座標	Y座標	辺長	方向角	測角	DX	倍積 (Y×DX)	
181-101	40858.947	-68092.914	40.861	268-55-33	90-02-07	0.680	-46303.181520	
181-102	40858.181	-68133.768	1.449	174-53-29	85-57-56	-2.209	150507.493512	
181-9	40856.738	-68133.639	40.760	88-55-39	94-02-10	-0.680	46330.874520	
181-10	40857.501	-68092.886	1.446	358-53-26	89-57-47	2.209	-150417.185174	
						倍面積	118.001338	
						面積	59.0006690	

面積計算書（座標法）

世界測地系（測地成果2011）

所在	地番	公簿地目	現況地目	地積	所有者
前橋市六供町三丁目	181-保-3			85.00 m ²	

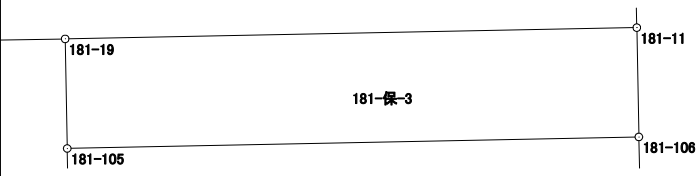点名	X座標	Y座標	辺長	方向角	測角	DX	倍積 (Y×DX)	
181-105	40827.340	-68113.364	21.071	88-50-30	89-56-02	-3.613	246093.584132	
181-106	40827.766	-68092.297	4.029	358-55-09	90-04-39	4.454	-303283.090838	
181-11	40831.794	-68092.373	21.072	268-52-17	89-57-08	3.613	-246017.743649	
181-19	40831.379	-68113.441	4.040	178-54-28	90-02-11	-4.454	303377.266214	


倍面積	170.015859
面積	85.0079295

面積計算書（座標法）

世界測地系（測地成果2011）

所在	地番	公簿地目	現況地目	地積	所有者
前橋市六供町三丁目	181-保-4			39.00 m ²	

点名	X座標	Y座標	辺長	方向角	測角	DX	倍積 (Y×DX)
181-107	40785.010	-68101.114	9.647	88-55-08	90-04-50	-3.862	263006.502268
181-108	40785.192	-68091.469	4.045	358-43-30	89-48-22	4.226	-287754.547994
181-13	40789.236	-68091.559	9.639	268-55-05	90-11-35	3.862	-262969.600858
181-24	40789.054	-68101.196	4.045	178-50-18	89-55-13	-4.226	287795.654296

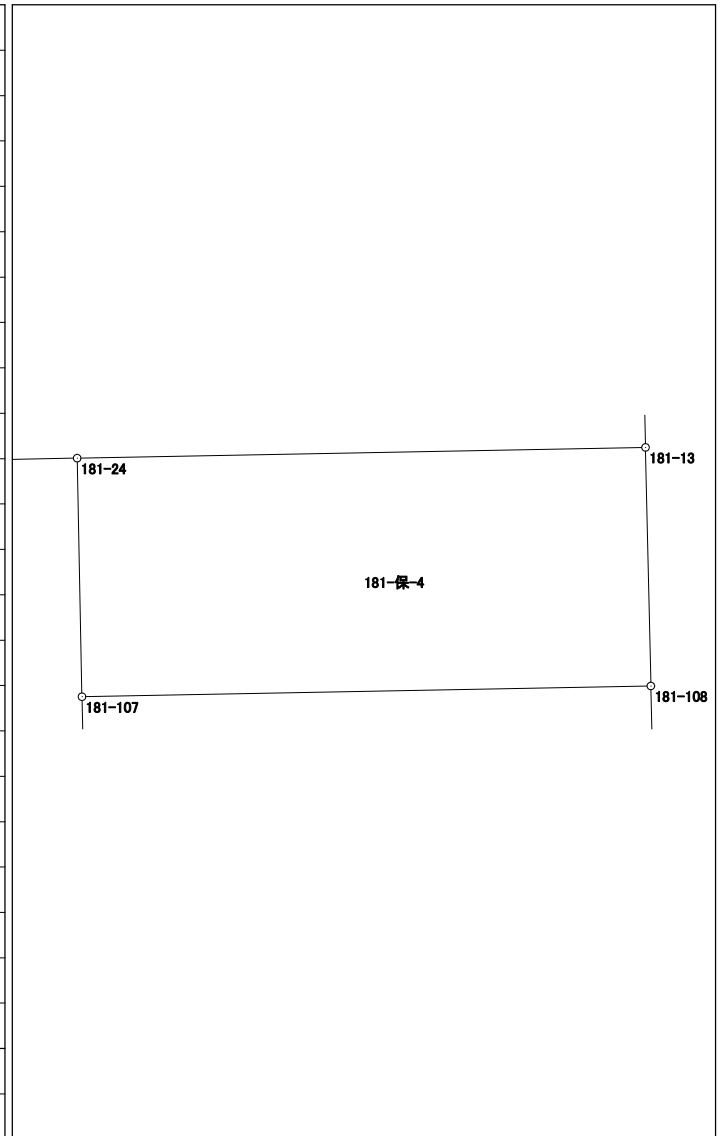


倍面積	78.007712
面積	39.0038560

面積計算書（座標法）

世界測地系（測地成果2011）

所 在	地 番	公簿地目	現況地目	地 積	所 有 者
前橋市六供町三丁目	181-保-5			49.00 m ²	

点 名	X 座 標	Y 座 標	辺 長	方 向 角	測 角	DX	倍 積 (Y×DX)
181-115	40796.745	-68128.267	15.497	88-54-07	94-01-32	-2.837	193279.893479
181-116	40797.042	-68112.773	1.193	358-56-37	90-02-30	1.490	-101488.031770
181-27	40798.235	-68112.795	1.946	359-03-28	180-06-51	3.139	-213806.063505
181-22	40800.181	-68112.827	15.724	268-53-58	89-50-30	1.644	-111977.487588
181-16	40799.879	-68128.548	3.147	174-52-35	85-58-37	-3.436	234089.690928
倍面積							98.001544
面 積							49.0007720

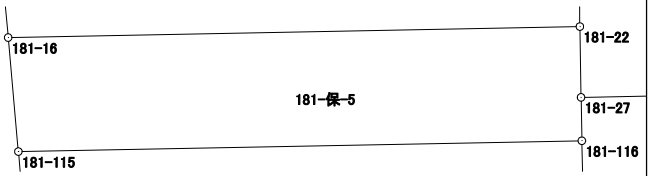


面積計算書（座標法）

世界測地系（測地成果2011）

所 在	地 番	公簿地目	現況地目	地 積	所 有 者
前橋市六供町三丁目	181-保-7			85.00 m ²	

点 名	X 座 標	Y 座 標	辺 長	方 向 角	測 角	DX	倍 積 (Y×DX)
181-111	40826.243	-68130.912	17.565	88-52-40	94-00-00	-4.442	302637.511104
181-112	40826.587	-68113.350	0.753	358-56-06	90-03-26	1.097	-74720.344950
181-105	40827.340	-68113.364	4.040	358-54-28	179-58-22	4.792	-326399.240288
181-19	40831.379	-68113.441	17.903	268-52-47	89-58-19	3.689	-251270.483849
181-18	40831.029	-68131.341	4.805	174-52-40	85-59-53	-5.136	349922.567376
						倍面積	170.009393
						面 積	85.0046965

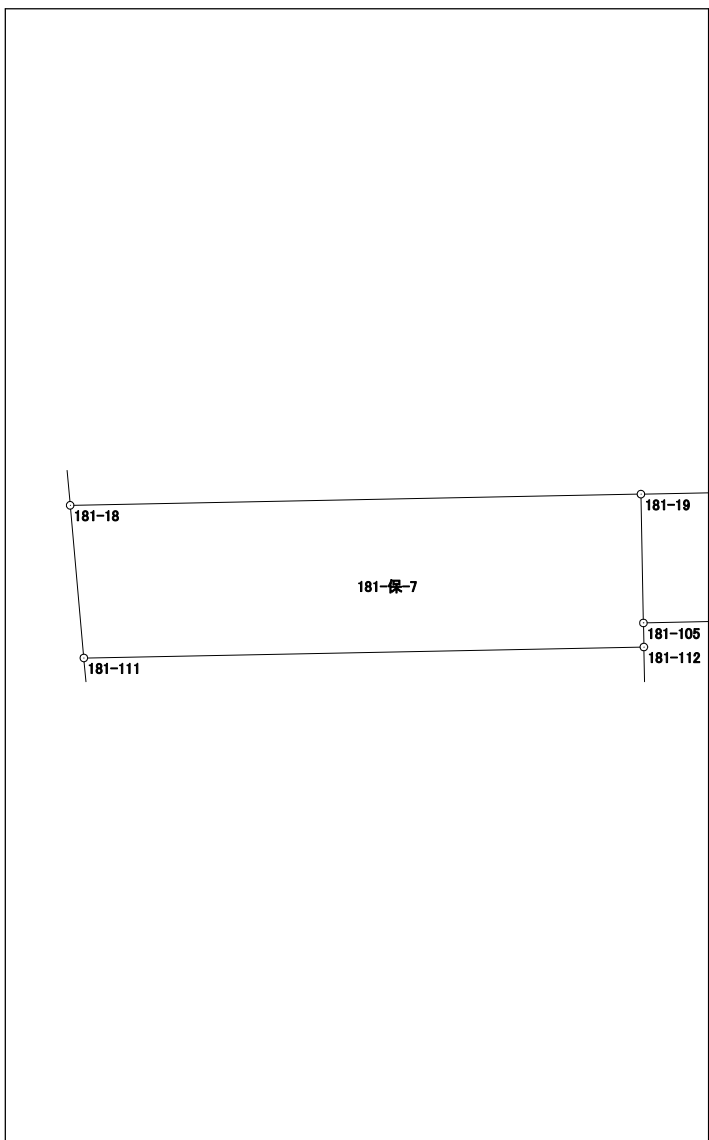

面積計算書 (座標法)

世界測地系 (測地成果2011)

所 在	地 番	公簿地目	現況地目	地 積	所 有 者
前橋市六供町三丁目	181-保-8			31.00 m ²	

点 名	X 座 標	Y 座 標	辺 長	方 向 角	測 角	DX	倍 積 (Y×DX)
181-109	40789.008	-68103.446	13.755	178-51-01	90-01-17	-13.798	939691.347908
181-110	40775.256	-68103.170	2.251	89-49-19	90-58-18	-13.745	936078.071650
181-14	40775.263	-68100.919	9.749	358-51-14	89-01-55	9.754	-664256.363926
181-107	40785.010	-68101.114	4.045	358-50-18	179-59-04	13.791	-939182.463174
181-24	40789.054	-68101.196	2.250	268-49-44	89-59-26	3.998	-272268.581608
倍面積							62.010850
面 積							31.0054250

