



182街区 画地出来形確認図 (4151.84m²)

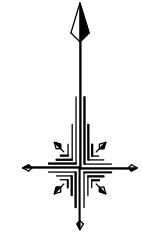

S=1/500

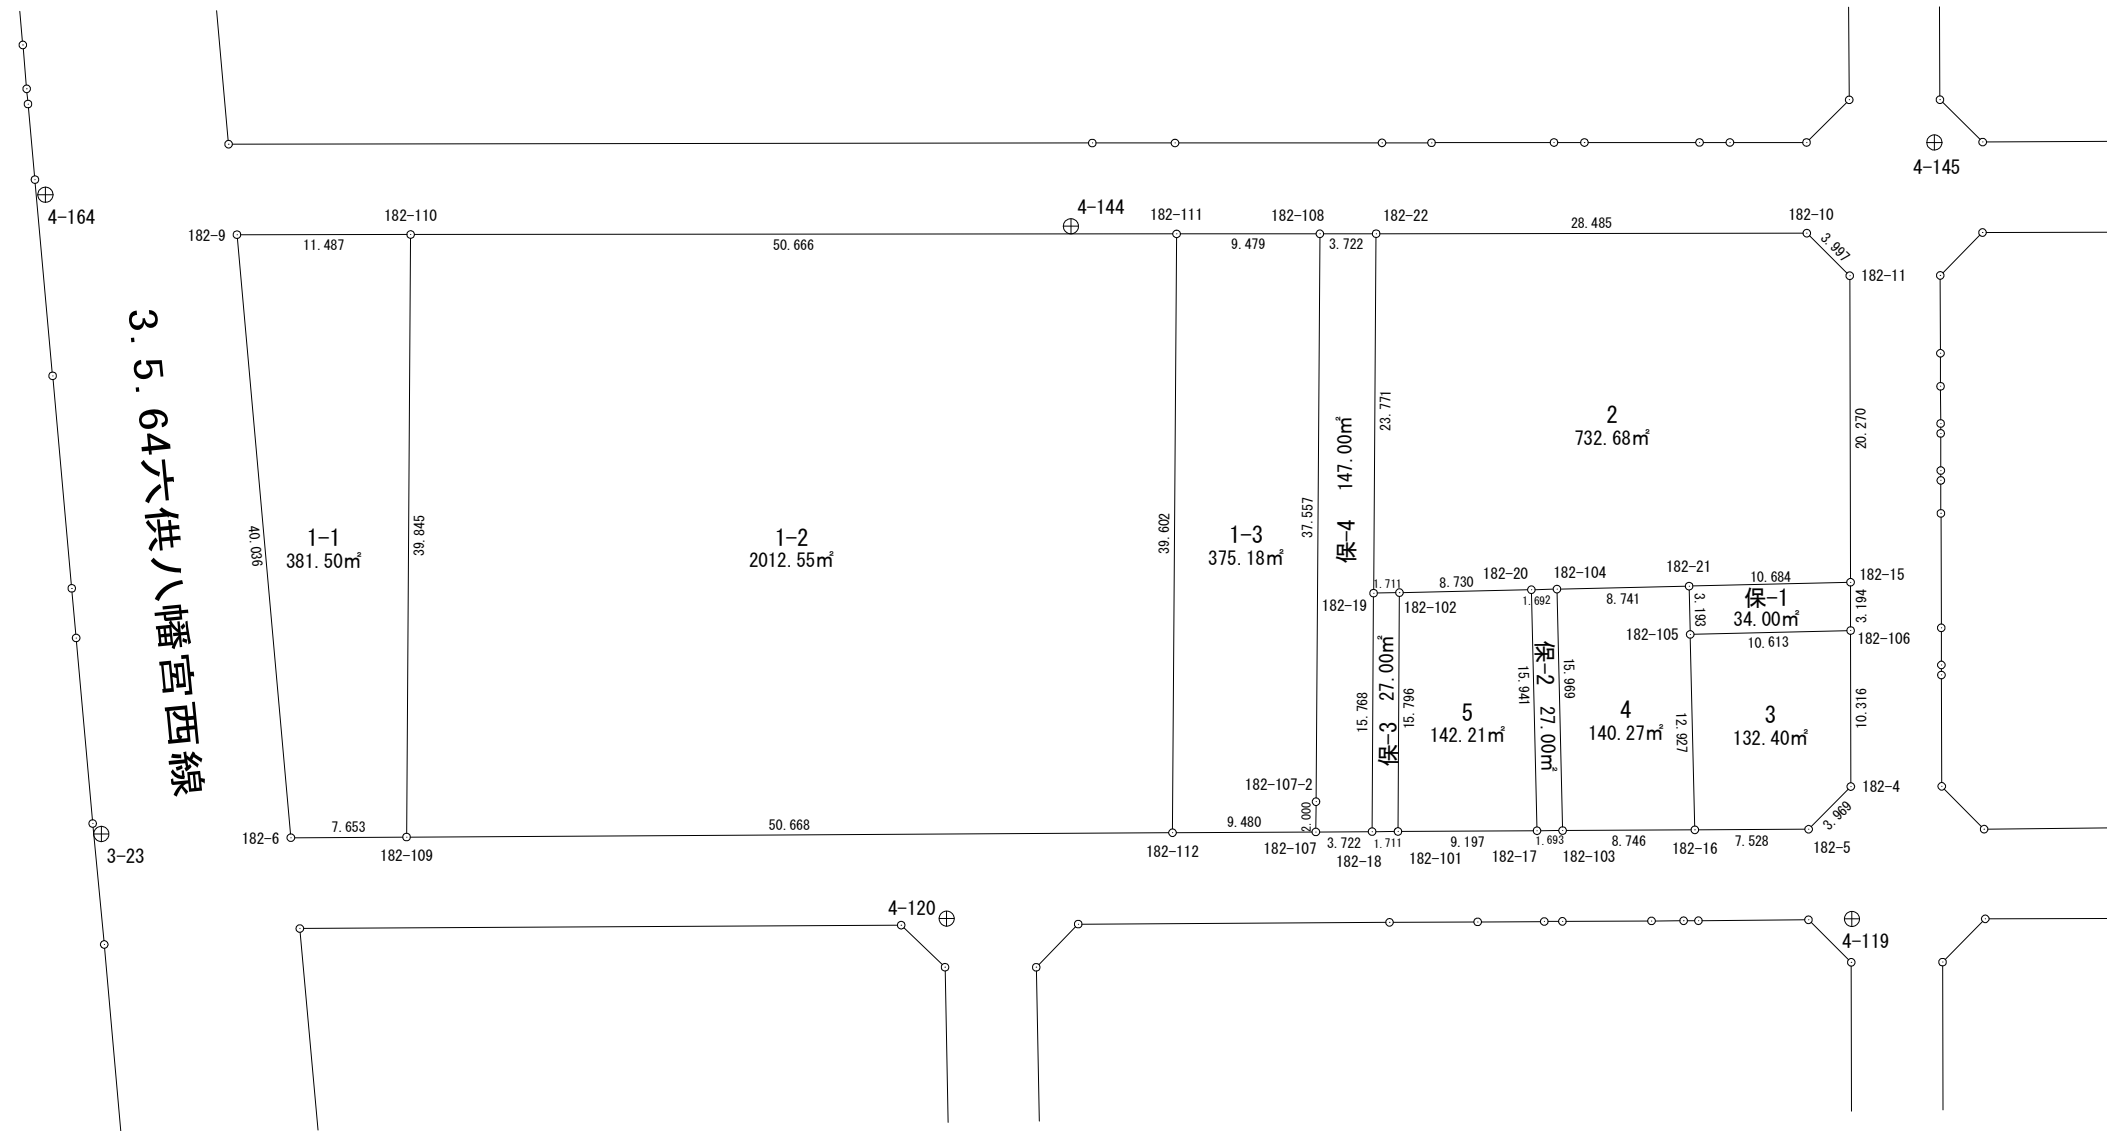


面積計算書 (座標法)

世界測地系 (測地成果2011)

所在	地番	公簿地目	現況地目	地積	所有者
前橋市六供町三丁目	182-1-1			381.50 m ²	

点名	X座標	Y座標	辺長	方向角	測角	DX	倍積 (Y×DX)
182-9	40929.174	-68140.177	40.036	174-53-34	84-56-34	-39.887	2717907.239999
182-6	40889.297	-68136.613	7.653	89-40-41	94-47-07	-39.834	2714153.842242
182-109	40889.340	-68128.960	39.845	0-23-18	90-42-37	39.887	-2717459.827520
182-110	40929.184	-68128.690	11.487	269-57-00	89-33-42	39.834	-2713838.237460
						倍面積	763.017261
						面積	381.5086305

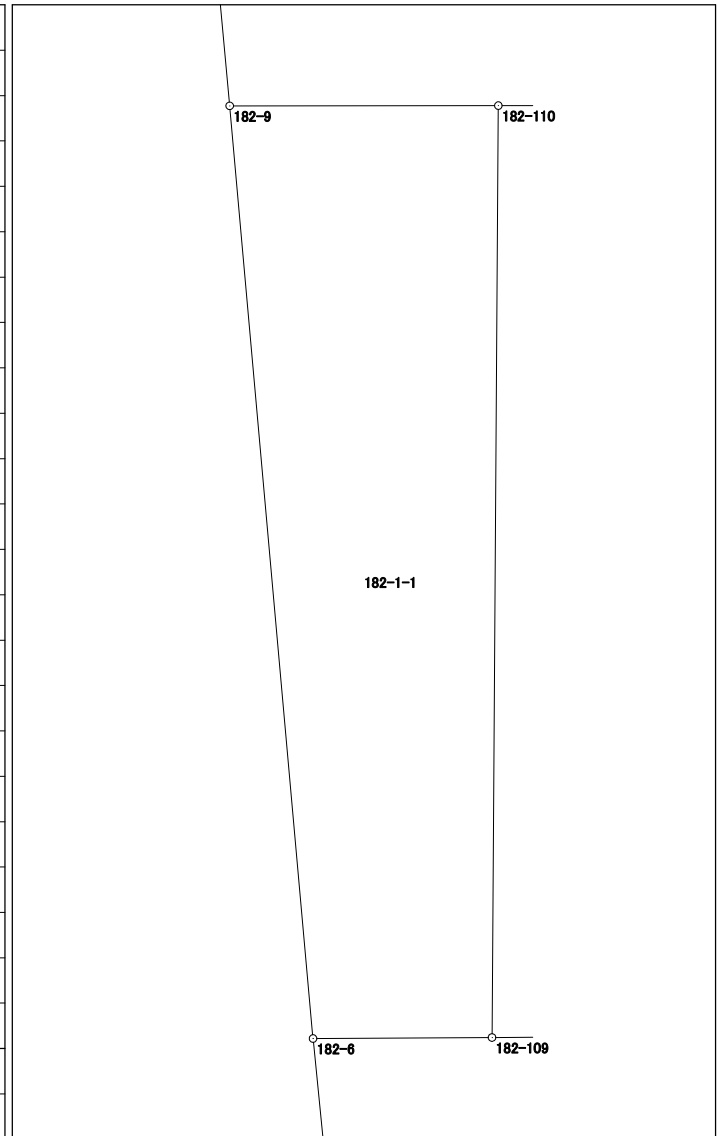


面積計算書（座標法）

世界測地系（測地成果2011）

所在	地番	公簿地目	現況地目	地積	所有者
前橋市六供町三丁目	182-1-2			2012.55 m ²	

点名	X座標	Y座標	辺長	方向角	測角	DX	倍積 (Y×DX)
182-111	40929.226	-68078.024	50.666	269-57-09	89-33-48	39.559	-2693098.551416
182-110	40929.184	-68128.690	39.845	180-23-18	90-26-09	-39.886	2717380.929340
182-109	40889.340	-68128.960	50.668	89-40-40	89-17-22	-39.559	2695113.528640
182-112	40889.625	-68078.293	39.602	0-23-21	90-42-41	39.886	-2715370.794598
						倍面積	4025.111966
						面積	2012.5559830

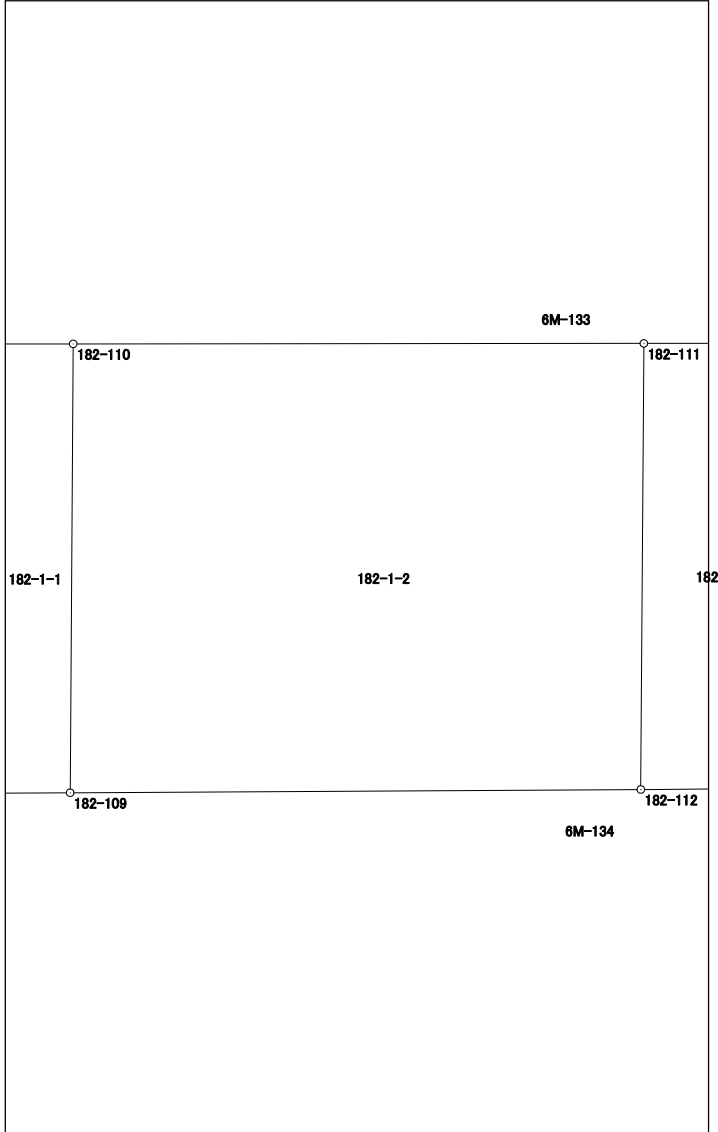


面積計算書 (座標法)

世界測地系 (測地成果2011)

所在	地番	公簿地目	現況地目	地積	所有者
前橋市六供町三丁目	182-1-3			375.18 m ²	

点名	X座標	Y座標	辺長	方向角	測角	DX	倍積 (Y×DX)
182-107-2	40891.678	-68068.799	37.557	0-23-15	179-59-11	39.556	-2692529.413244
182-108	40929.234	-68068.545	9.479	269-57-06	89-33-51	37.548	-2555837.727660
182-111	40929.226	-68078.024	39.602	180-23-21	90-26-15	-39.609	2696502.452616
182-112	40889.625	-68078.293	9.480	89-40-47	89-17-26	-39.548	2692360.331564
182-107	40889.678	-68068.813	2.000	0-24-04	90-43-17	2.053	-139745.273089
倍面積						750.370187	
面積						375.1850935	

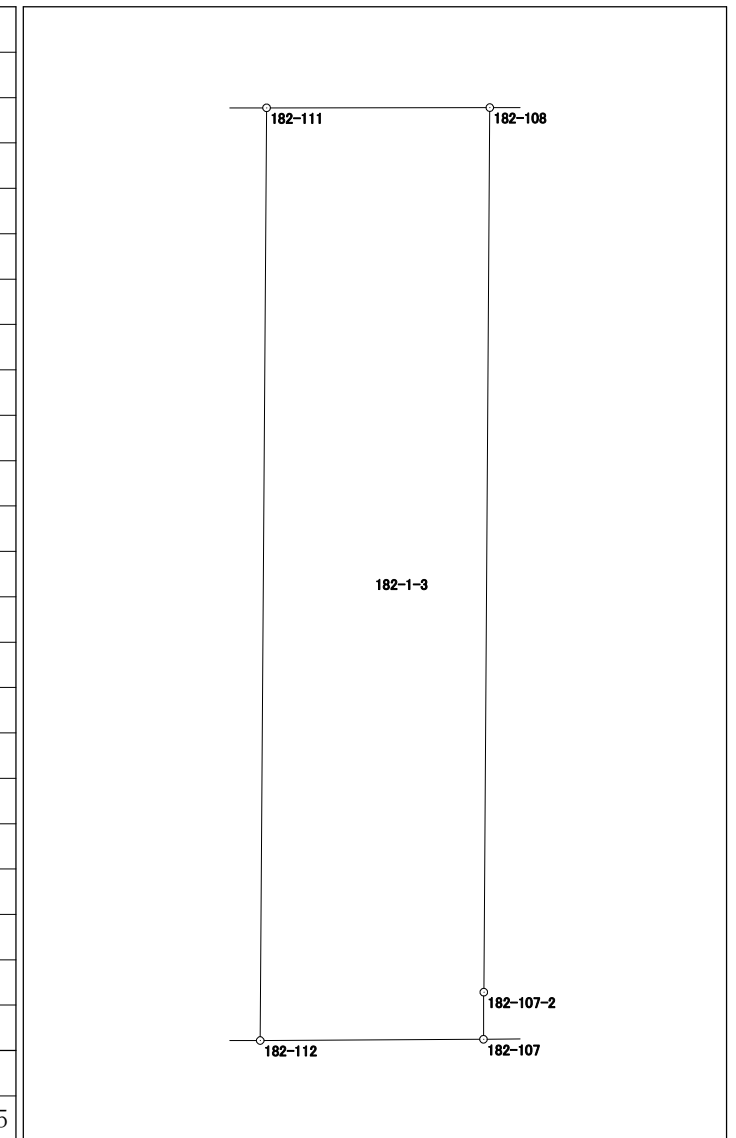


面積計算書（座標法）

世界測地系（測地成果2011）

所在	地番	公簿地目	現況地目	地積	所有者
前橋市六供町三丁目	182-2			732.68 m ²	

点名	X座標	Y座標	辺長	方向角	測角	DX	倍積 (Y×DX)
182-22	40929.237	-68064.823	23.771	180-24-35	90-28-41	-23.804	1620215.046692
182-19	40905.467	-68064.993	1.711	88-45-40	88-21-05	-23.733	1615386.478869
182-102	40905.504	-68063.282	8.730	88-44-47	179-59-07	0.228	-15518.428296
182-20	40905.695	-68054.554	1.692	88-42-48	179-58-01	0.229	-15584.492866
182-104	40905.733	-68052.862	8.741	88-42-07	179-59-19	0.236	-16060.475432
182-21	40905.931	-68044.123	10.684	88-36-39	179-54-32	0.457	-31096.164211
182-15	40906.190	-68033.442	20.270	359-50-40	91-14-01	20.529	-1396658.530818
182-11	40926.460	-68033.497	3.997	314-41-45	134-51-05	23.081	-1570281.144257
182-10	40929.271	-68036.338	28.485	269-55-54	135-14-09	2.777	-188936.910626

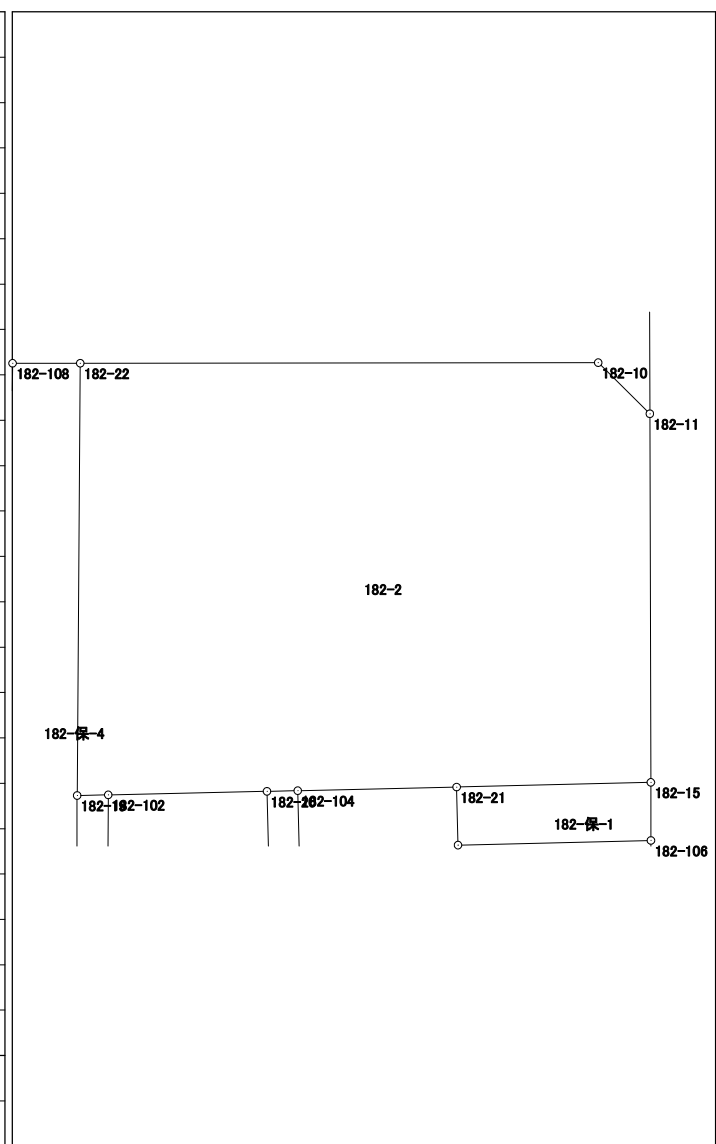


倍面積	1465.379055
面積	732.6895275

面積計算書 (座標法)

世界測地系 (測地成果2011)

所在	地番	公簿地目	現況地目	地積	所有者
前橋市六供町三丁目	182-3			132.40 m ²	

点名	X座標	Y座標	辺長	方向角	測角	DX	倍積 (Y×DX)
182-105	40902.739	-68044.048	12.927	178-39-09	90-02-24	-13.180	896820.552640
182-16	40889.816	-68043.744	7.528	89-41-44	91-02-35	-12.883	876607.553952
182-5	40889.856	-68036.216	3.969	44-38-34	134-56-50	2.864	-194855.722624
182-4	40892.680	-68033.427	10.316	359-56-20	135-17-46	13.140	-893959.230780
182-106	40902.996	-68033.438	10.613	268-36-45	88-40-25	10.059	-684348.352842

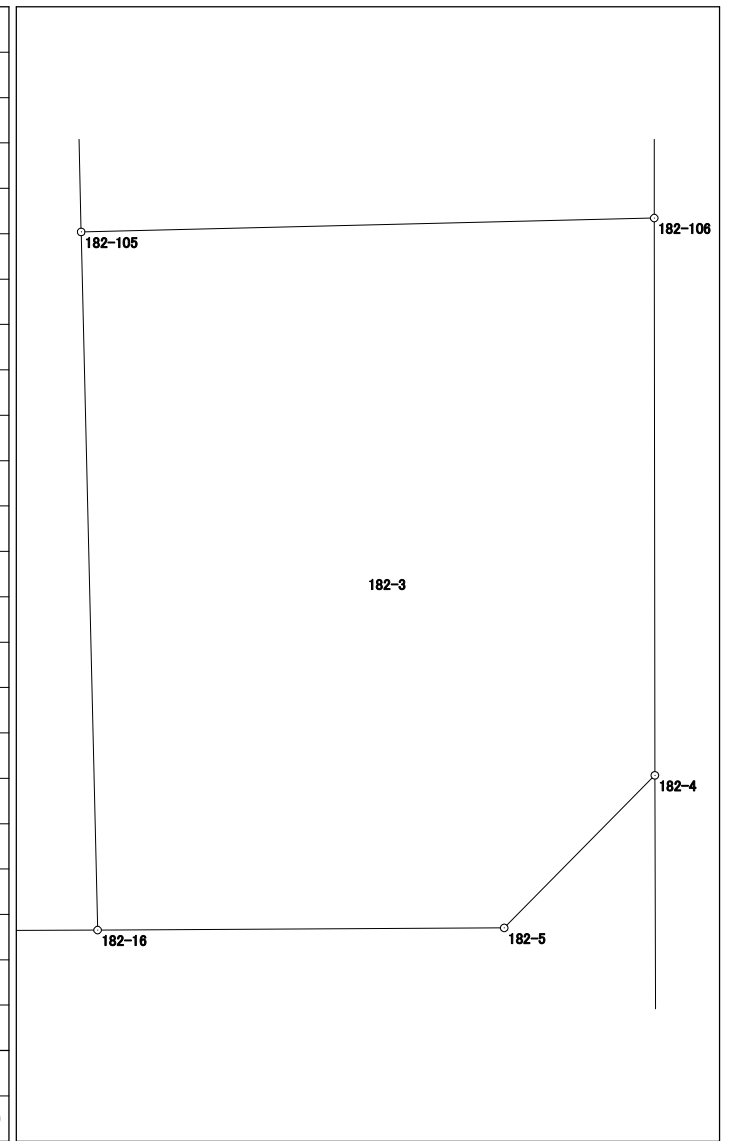


倍面積	264.800346
面積	132.4001730

面積計算書（座標法）

世界測地系（測地成果2011）

所在	地番	公簿地目	現況地目	地積	所有者
前橋市六供町三丁目	182-4			140.27 m ²	

点名	X座標	Y座標	辺長	方向角	測角	DX	倍積 (Y×DX)
182-103	40889.768	-68052.490	8.746	89-41-08	91-01-13	-15.917	1083191.483330
182-16	40889.816	-68043.744	12.927	358-39-09	88-58-01	12.971	-882595.403424
182-105	40902.739	-68044.048	3.193	358-39-14	180-00-05	16.115	-1096529.833520
182-21	40905.931	-68044.123	8.741	268-42-07	90-02-53	2.994	-203724.104262
182-104	40905.733	-68052.862	15.969	178-39-55	89-57-48	-16.163	1099938.408506
						倍面積	280.550630
						面積	140.2753150

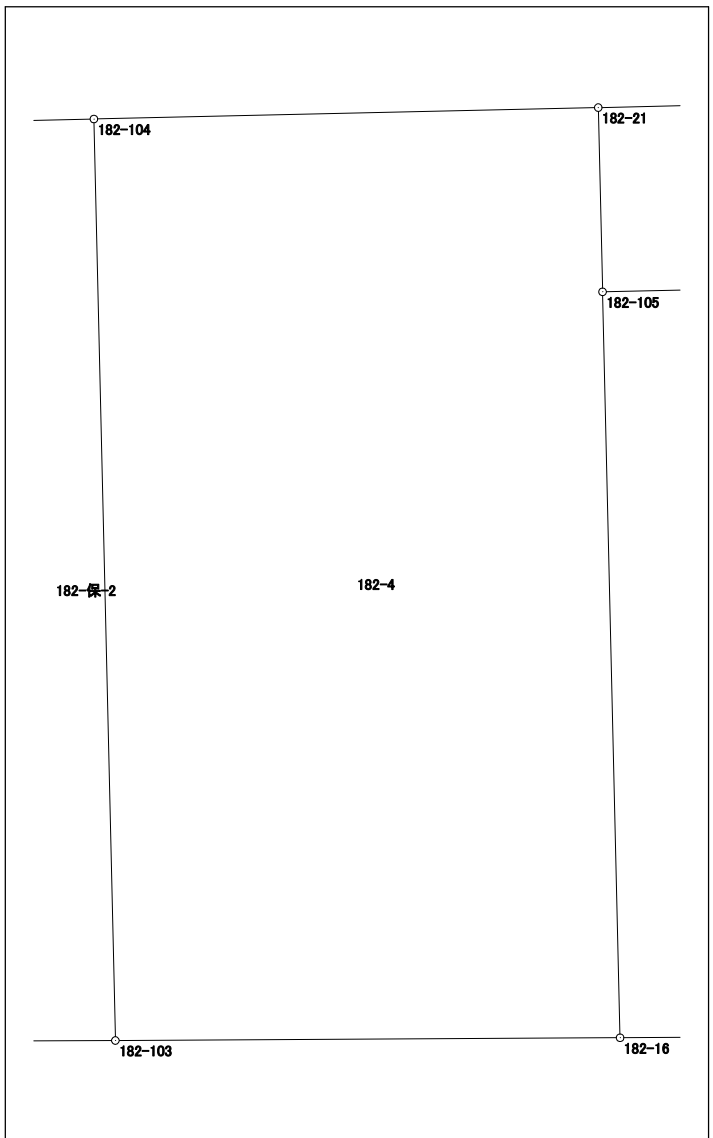


面積計算書 (座標法)

世界測地系 (測地成果2011)

所在	地番	公簿地目	現況地目	地積	所有者
前橋市六供町三丁目	182-5			142.21 m ²	

点名	X座標	Y座標	辺長	方向角	測角	DX	倍積 (Y×DX)
182-102	40905.504	-68063.282	15.796	180-21-20	91-36-33	-15.987	1088127.689334
182-101	40889.708	-68063.380	9.197	89-41-19	89-19-59	-15.746	1071725.981480
182-17	40889.758	-68054.183	15.941	358-39-59	88-58-40	15.987	-1087982.223621
182-20	40905.695	-68054.554	8.730	268-44-47	90-04-48	15.746	-1071587.007284
倍面積							284.439909
面積							142.2199545

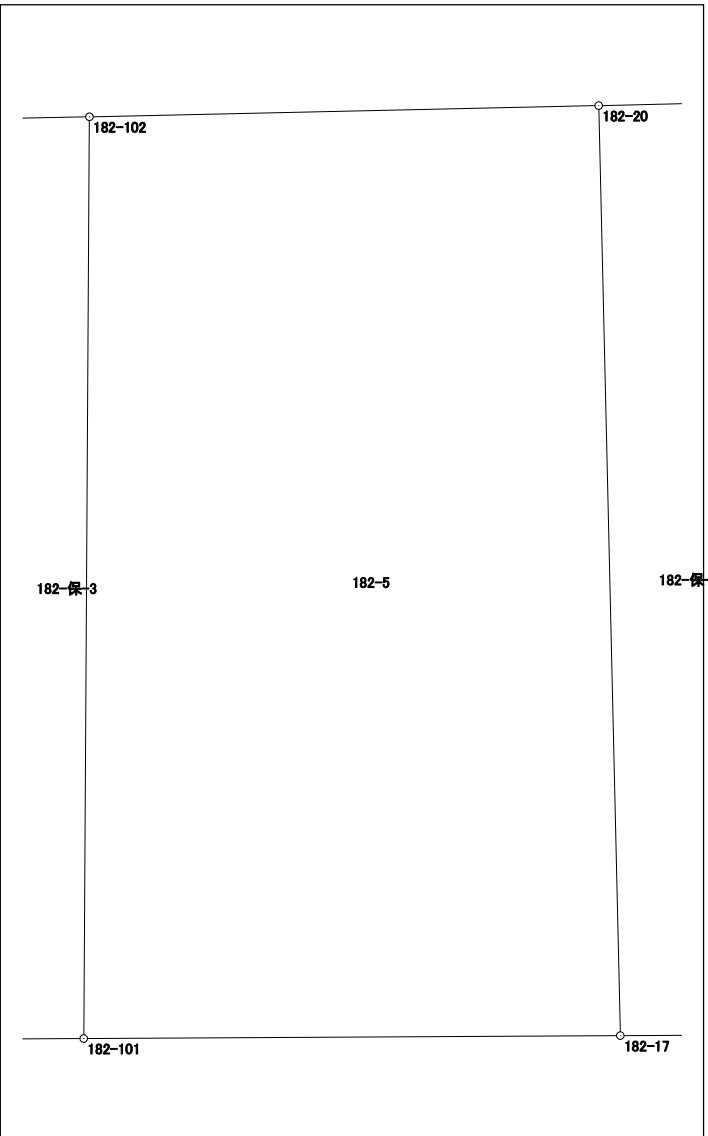

面積計算書 (座標法)

世界測地系 (測地成果2011)

所 在	地 番	公簿地目	現況地目	地 積	所 有 者
前橋市六供町三丁目	182-保-1			34.00 m ²	


点 名	X 座標	Y 座標	辺 長	方 向 角	測 角	DX	倍 積 (Y×DX)		
182-21	40905.931	-68044.123	3.193	178-39-14	90-02-35	-3.451	234820.268473	 <p style="text-align: center;">182-保-1</p>	
182-105	40902.739	-68044.048	10.613	88-36-45	89-57-31	-2.935	199709.280880		
182-106	40902.996	-68033.438	3.194	359-55-42	91-18-57	3.451	-234783.394538		
182-15	40906.190	-68033.442	10.684	268-36-39	88-40-57	2.935	-199678.152270		
							倍面積	68.002545	
							面 積	34.0012725	

面積計算書（座標法）

世界測地系（測地成果2011）

所 在	地 番	公簿地目	現況地目	地 積	所 有 者
前橋市六供町三丁目	182-保-2			27.00 m ²	

点 名	X 座標	Y 座標	辺 長	方 向 角	測 角	DX	倍 積 (Y×DX)
182-103	40889.768	-68052.490	15.969	358-39-55	89-00-13	15.975	-1087138.527750
182-104	40905.733	-68052.862	1.692	268-42-48	90-02-53	15.927	-1083877.933074
182-20	40905.695	-68054.554	15.941	178-39-59	89-57-11	-15.975	1087171.500150
182-17	40889.758	-68054.183	1.693	89-39-42	90-59-43	-15.927	1083898.972641

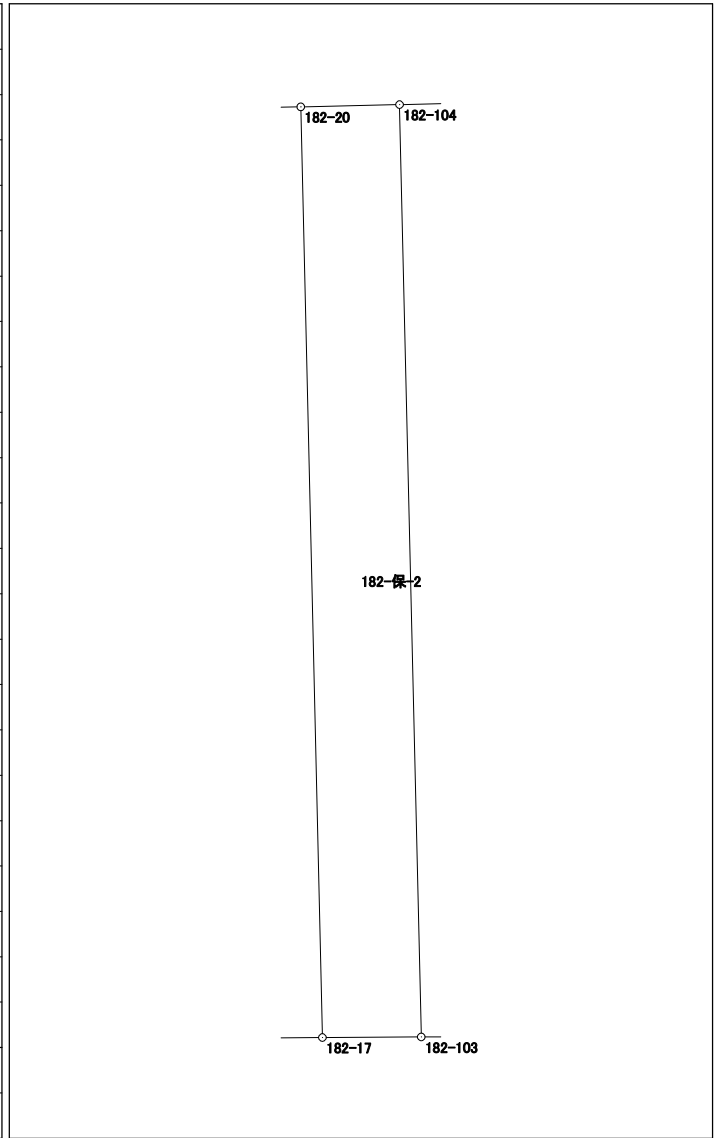


倍面積	54.011967
面 積	27.0059835

面積計算書（座標法）

世界測地系（測地成果2011）

所在	地番	公簿地目	現況地目	地積	所有者
前橋市六供町三丁目	182-保-3			27.00 m ²	

点名	X座標	Y座標	辺長	方向角	測角	DX	倍積 (Y×DX)
182-101	40889.708	-68063.380	15.796	0-21-20	90-39-25	15.805	-1075741.720900
182-102	40905.504	-68063.282	1.711	268-45-40	88-24-20	15.759	-1072609.261038
182-19	40905.467	-68064.993	15.768	180-21-22	91-35-42	-15.805	1075767.214365
182-18	40889.699	-68065.091	1.711	89-41-55	89-20-33	-15.759	1072637.769069
						倍面積	54.001496
						面積	27.0007480

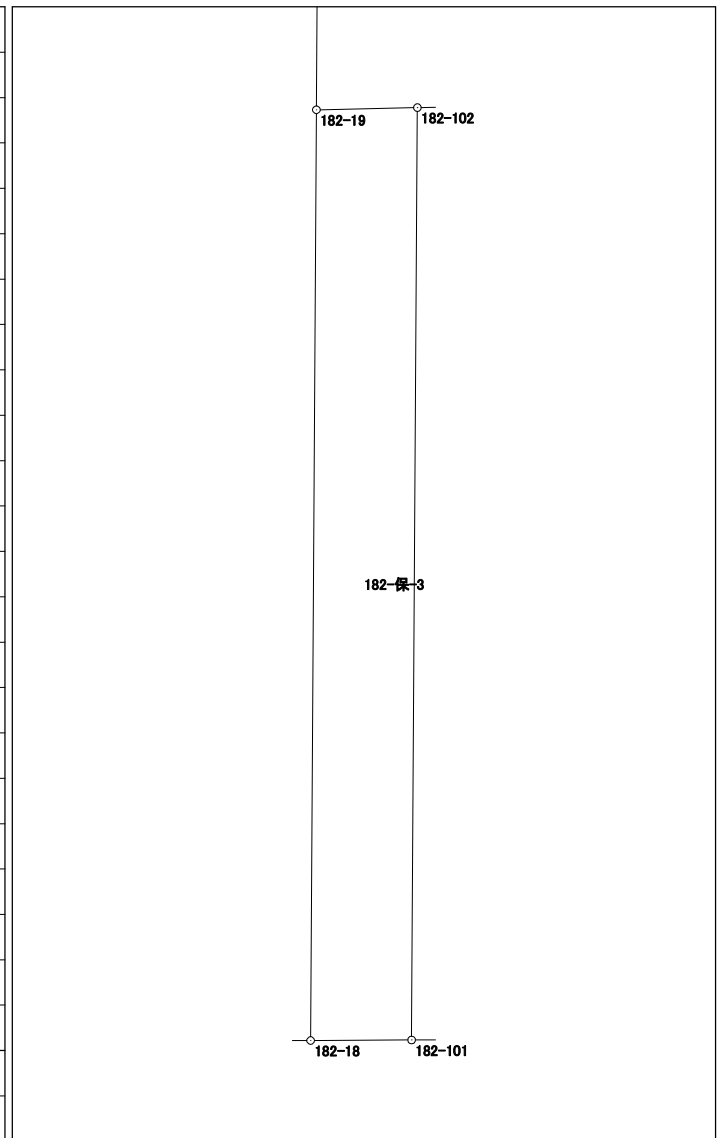

面積計算書 (座標法)

世界測地系 (測地成果2011)

所 在	地 番	公簿地目	現況地目	地 積	所 有 者
前橋市六供町三丁目	182-保-4			147.00 m ²	

点 名	X 座標	Y 座標	辺 長	方 向 角	測 角	DX	倍 積 (Y×DX)
182-107-2	40891.678	-68068.799	2.000	180-24-04	180-00-49	-39.556	2692529.413244
182-107	40889.678	-68068.813	3.722	89-40-36	89-16-32	-1.979	134708.180927
182-18	40889.699	-68065.091	15.768	0-21-22	90-40-46	15.789	-1074679.721799
182-19	40905.467	-68064.993	23.771	0-24-35	180-03-13	39.538	-2691153.693234
182-22	40929.237	-68064.823	3.722	269-57-14	89-32-39	23.767	-1617696.648241
182-108	40929.234	-68068.545	37.557	180-23-15	90-26-01	-37.559	2556586.481655

倍面積	294.012552
面 積	147.0062760

