



186街区 画地出来形確認図 (4453.53m²)

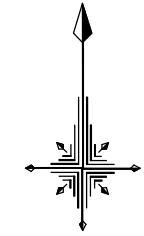

S=1/500

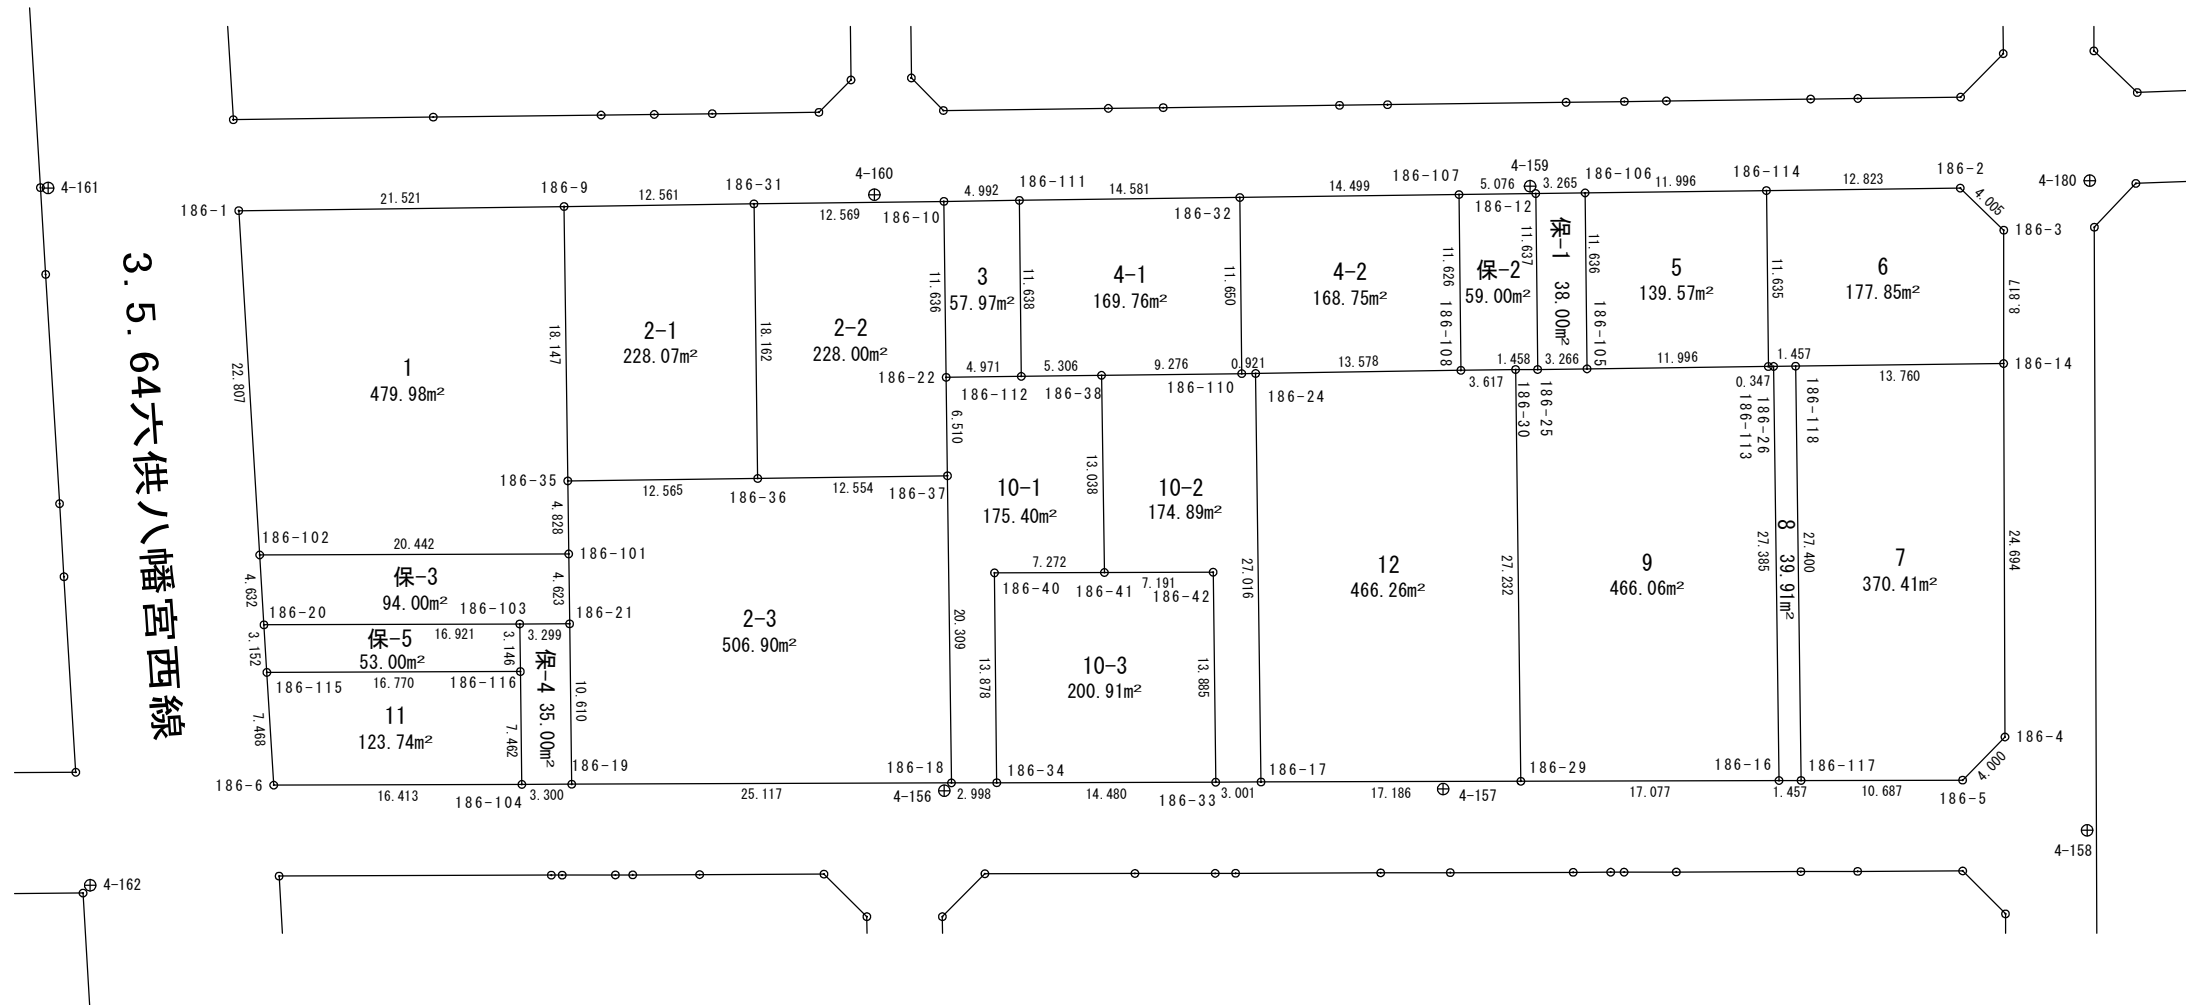


面積計算書 (座標法)

世界測地系 (測地成果2011)

所 在	地 番	公簿地目	現況地目	地 積	所 有 者
前橋市六供町三丁目	186-1			479.98 m ²	


点 名	X 座標	Y 座標	辺 長	方 向 角	測 角	DX	倍 積 (Y×DX)
186-102	41055.878	-68149.336	20.442	89-48-44	93-17-47	-22.698	1546853.628528
186-101	41055.945	-68128.894	4.828	359-15-51	89-27-07	4.895	-333490.936130
186-35	41060.773	-68128.956	18.147	359-13-12	179-57-21	22.973	-1565126.506188
186-9	41078.918	-68129.203	21.521	269-16-04	90-02-52	17.870	-1217468.857610
186-1	41078.643	-68150.722	22.807	176-30-57	87-14-53	-23.040	1570192.634880
						倍面積	959.963480
						面 積	479.9817400

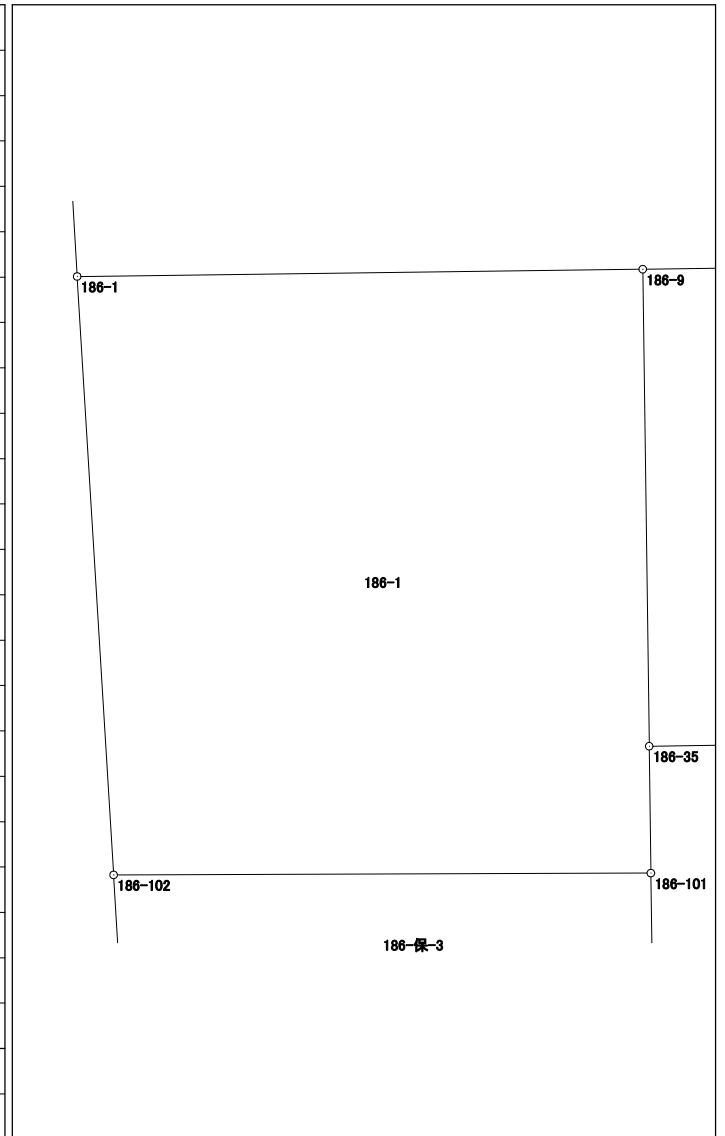

面積計算書 (座標法)

世界測地系 (測地成果2011)

所 在	地 番	公簿地目	現況地目	地 積	所 有 者
前橋市六供町三丁目	186-2-1			228.07 m ²	

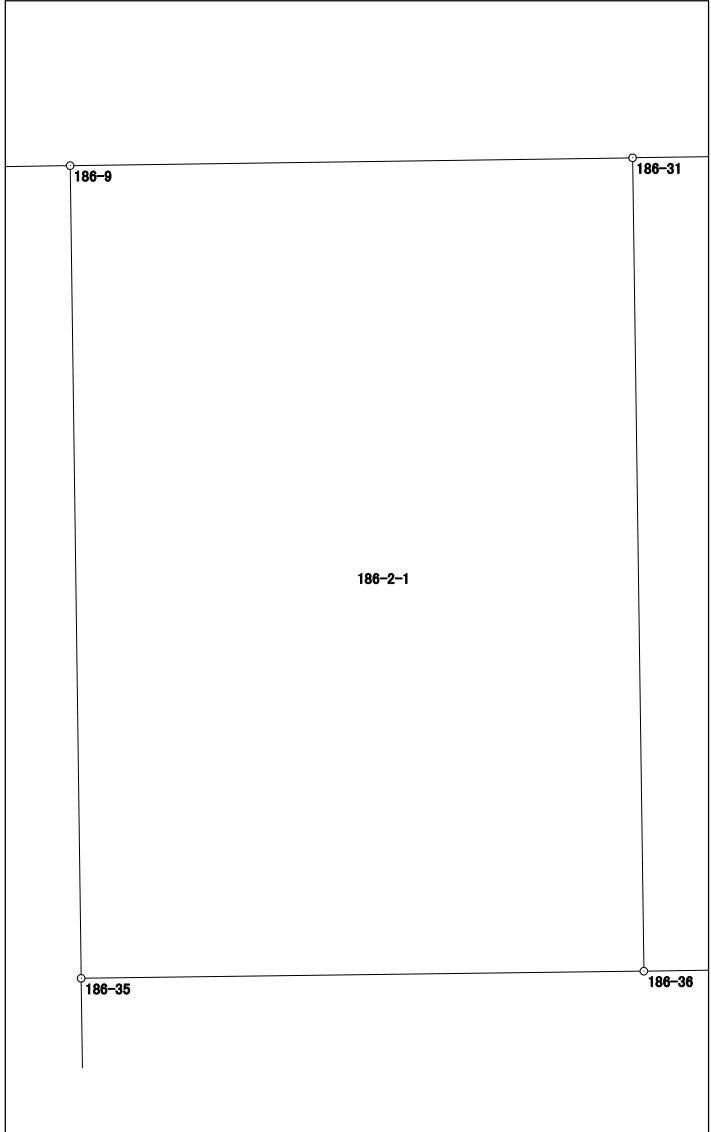点 名	X 座標	Y 座標	辺 長	方 向 角	測 角	DX	倍 積 (Y×DX)	
186-9	41078.918	-68129.203	18.147	179-13-12	90-01-06	-18.320	1248126.998960	
186-35	41060.773	-68128.956	12.565	89-16-13	90-03-01	-17.985	1225299.273660	
186-36	41060.933	-68116.392	18.162	359-12-29	89-56-16	18.320	-1247892.301440	
186-31	41079.093	-68116.643	12.561	269-12-06	89-59-37	17.985	-1225077.824355	
								<div style="text-align: center; margin-top: 20px;"> <p>186-2-1</p> </div>
倍面積							456.146825	
面 積							228.0734125	

面積計算書（座標法）

世界測地系（測地成果2011）

所 在	地 番	公簿地目	現況地目	地 積	所 有 者
前橋市六供町三丁目	186-2-2			228.00 m ²	


点 名	X 座標	Y 座標	辺 長	方 向 角	測 角	DX	倍 積 (Y×DX)	
186-36	41060.933	-68116.392	12.554	89-10-59	89-58-30	-17.981	1224800.844552	
186-37	41061.112	-68103.839	6.510	359-13-32	90-02-33	6.688	-455478.475232	
186-22	41067.621	-68103.927	11.636	359-16-16	180-02-44	18.144	-1235677.651488	
186-10	41079.256	-68104.075	12.569	269-15-25	89-59-09	11.472	-781289.948400	
186-31	41079.093	-68116.643	18.162	179-12-29	89-57-04	-18.323	1248101.249689	
								186-2-2
							倍面積	
							面 積	228.0095605

面積計算書 (座標法)

世界測地系 (測地成果2011)

所在	地番	公簿地目	現況地目	地積	所有者
前橋市六供町三丁目	186-2-3			506.90 m ²	

点名	X座標	Y座標	辺長	方向角	測角	DX	倍積 (Y×DX)
186-101	41055.945	-68128.894	4.623	179-16-08	180-00-17	-9.451	643886.177194
186-21	41051.322	-68128.835	10.610	179-14-19	179-58-11	-15.232	1037738.414720
186-19	41040.713	-68128.694	25.117	89-47-24	90-33-05	-10.517	716509.474798
186-18	41040.805	-68103.577	20.309	359-15-39	89-28-15	20.399	-1389244.867223
186-37	41061.112	-68103.839	12.554	269-10-59	89-55-20	20.128	-1370794.071392
186-36	41060.933	-68116.392	12.565	269-16-13	180-05-14	-0.339	23091.456888
186-35	41060.773	-68128.956	4.828	179-15-51	89-59-38	-4.988	339827.232528

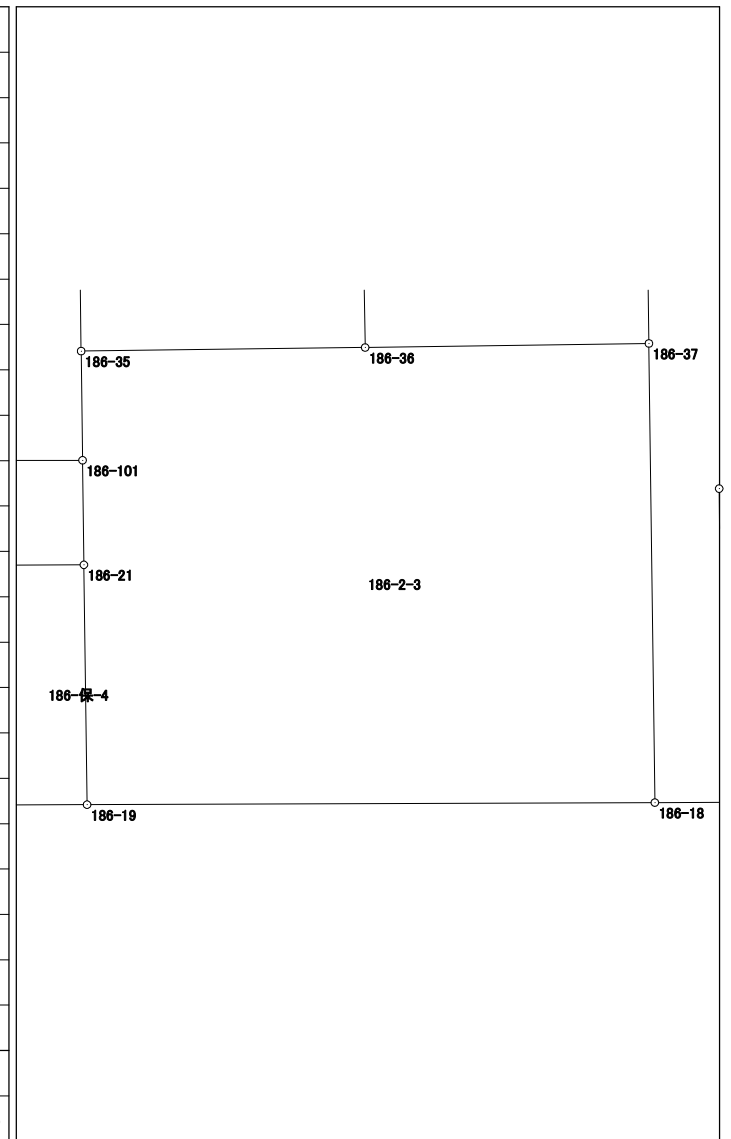


面積計算書 (座標法)

世界測地系 (測地成果2011)

所在	地番	公簿地目	現況地目	地積	所有者
前橋市六供町三丁目	186-3			57.97 m ²	

点名	X座標	Y座標	辺長	方向角	測角	DX	倍積 (Y×DX)
186-112	41067.685	-68098.956	11.638	359-22-29	90-06-44	11.701	-796825.884156
186-111	41079.322	-68099.083	4.992	269-14-33	89-52-04	11.571	-787974.489393
186-10	41079.256	-68104.075	11.636	179-16-16	90-01-43	-11.701	796885.781575
186-22	41067.621	-68103.927	4.971	89-15-45	89-59-29	-11.571	788030.539317

倍面積	115.947343
面積	57.9736715

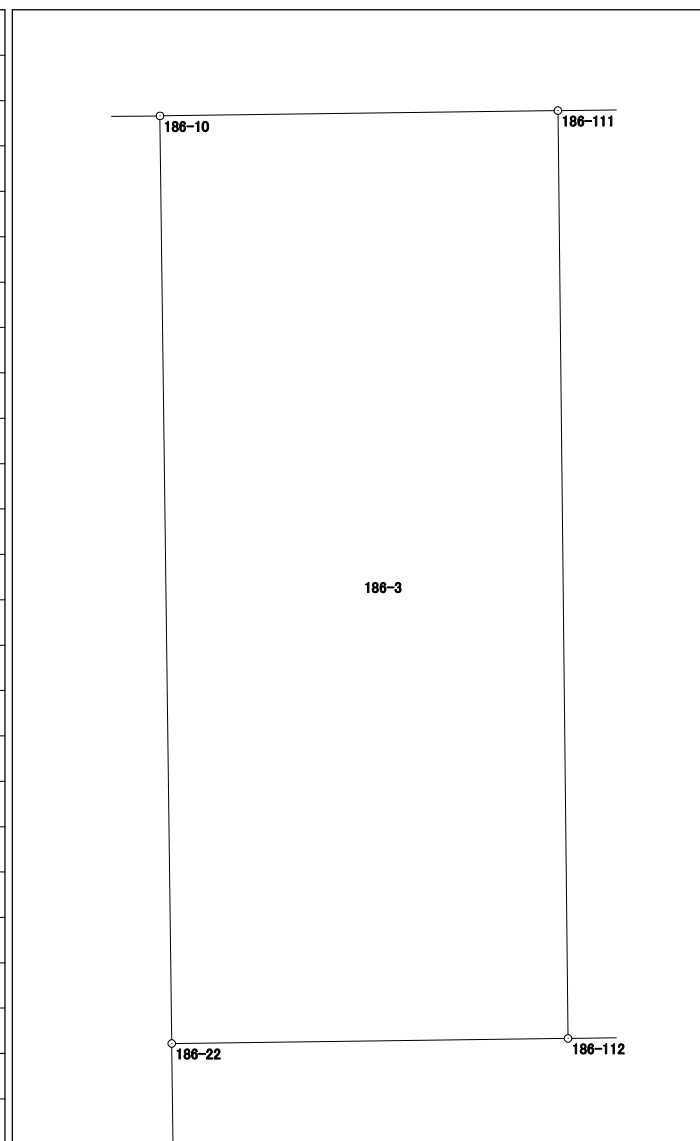

面積計算書（座標法）

世界測地系（測地成果2011）


所 在	地 番	公簿地目	現況地目	地 積	所 有 者
前橋市六供町三丁目	186-4-1			169.76 m ²	

点 名	X 座標	Y 座標	辺 長	方 向 角	測 角	DX	倍 積 (Y×DX)	
186-111	41079.322	-68099.083	11.638	179-22-29	90-07-59	-11.830	805612.151890	
186-112	41067.685	-68098.956	5.306	89-15-18	89-52-49	-11.568	787768.723008	
186-38	41067.754	-68093.650	9.276	89-18-29	180-03-11	0.181	-12324.950650	
186-110	41067.866	-68084.375	11.650	359-22-14	90-03-45	11.761	-800740.334375	
186-32	41079.515	-68084.503	14.581	269-14-30	89-52-16	11.456	-779976.066368	
						倍面積	339.523505	
						面 積	169.7617525	

面積計算書 (座標法)

世界測地系 (測地成果2011)

所在	地番	公簿地目	現況地目	地積	所有者
前橋市六供町三丁目	186-4-2			168.75 m ²	

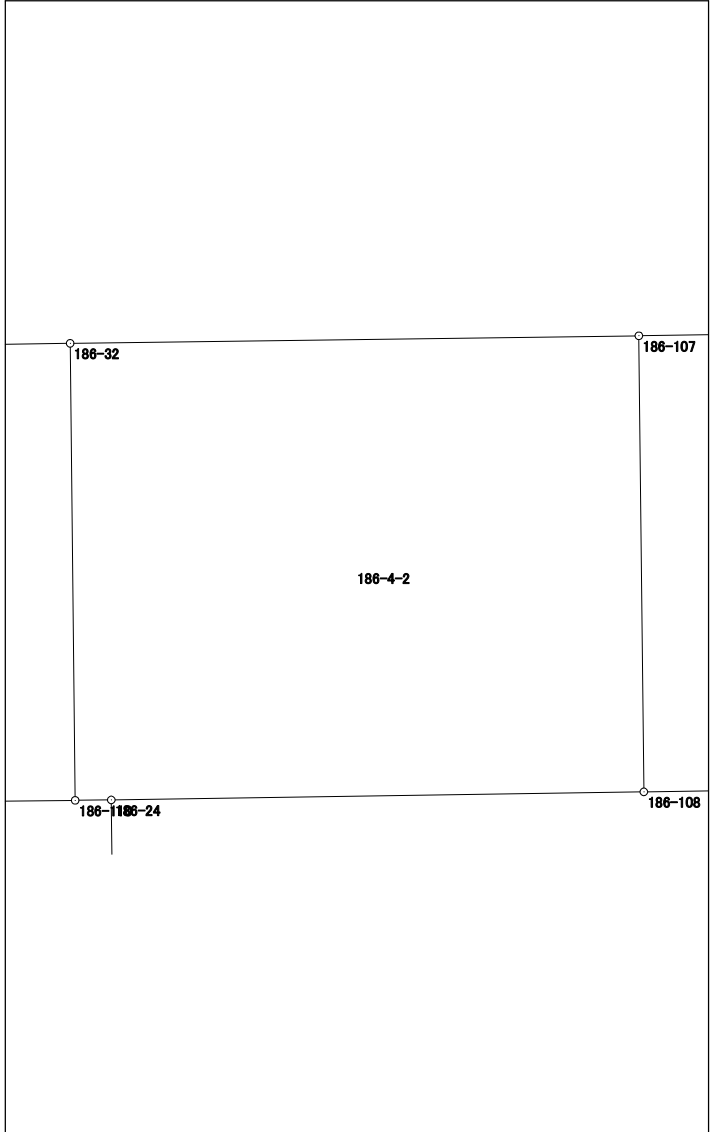点名	X座標	Y座標	辺長	方向角	測角	DX	倍積 (Y×DX)	
186-32	41079.515	-68084.503	11.650	179-22-14	90-08-00	-11.842	806256.684526	
186-110	41067.866	-68084.375	0.921	89-18-57	89-56-43	-11.638	792365.956250	
186-24	41067.877	-68083.454	13.578	89-07-50	179-48-53	0.217	-14774.109518	
186-108	41068.083	-68069.878	11.626	359-22-27	90-14-37	11.831	-805334.726618	
186-107	41079.708	-68070.005	14.499	269-14-14	89-51-47	11.432	-778176.297160	
							倍面積	
							面積	168.7537400

面積計算書 (座標法)

所在	地番	公簿地目	現況地目	地積	所有者
前橋市六供町三丁目	186-6			177.85 m ²	


点名	X座標	Y座標	辺長	方向角	測角	DX	倍積 (Y×DX)	
186-113	41068.337	-68049.542	0.347	89-10-28	89-48-00	-11.629	791348.123918	
186-26	41068.342	-68049.195	1.457	89-17-32	180-07-04	0.023	-1565.131485	
186-118	41068.360	-68047.738	13.760	89-16-47	179-59-15	0.191	-12997.117958	
186-14	41068.533	-68033.979	8.817	0-03-54	90-47-07	8.990	-611625.471210	
186-3	41077.350	-68033.969	4.005	314-03-33	133-59-39	11.602	-789330.108338	
186-2	41080.135	-68036.847	12.823	269-16-02	135-12-29	2.621	-178324.575987	
186-114	41079.971	-68049.669	11.635	179-22-28	90-06-26	-11.798	802849.994862	
						倍面積	355.713802	
						面積	177.8569010	

面積計算書 (座標法)

世界測地系 (測地成果2011)

所 在	地 番	公簿地目	現況地目	地 積	所 有 者
前橋市六供町三丁目	186-7			370.41 m ²	

点 名	X 座標	Y 座標	辺 長	方 向 角	測 角	DX	倍 積 (Y×DX)
186-118	41068.360	-68047.738	27.400	179-14-50	89-58-03	-27.571	1876144.184398
186-117	41040.962	-68047.378	10.687	89-52-55	90-38-05	-27.376	1862865.020128
186-5	41040.984	-68036.691	4.000	44-27-48	134-34-53	2.877	-195741.560007
186-4	41043.839	-68033.889	24.694	359-47-28	135-19-40	27.549	-1874265.608061
186-14	41068.533	-68033.979	13.760	269-16-47	89-29-19	24.521	-1668261.199059
倍面積							740.837399
面 積							370.4186995

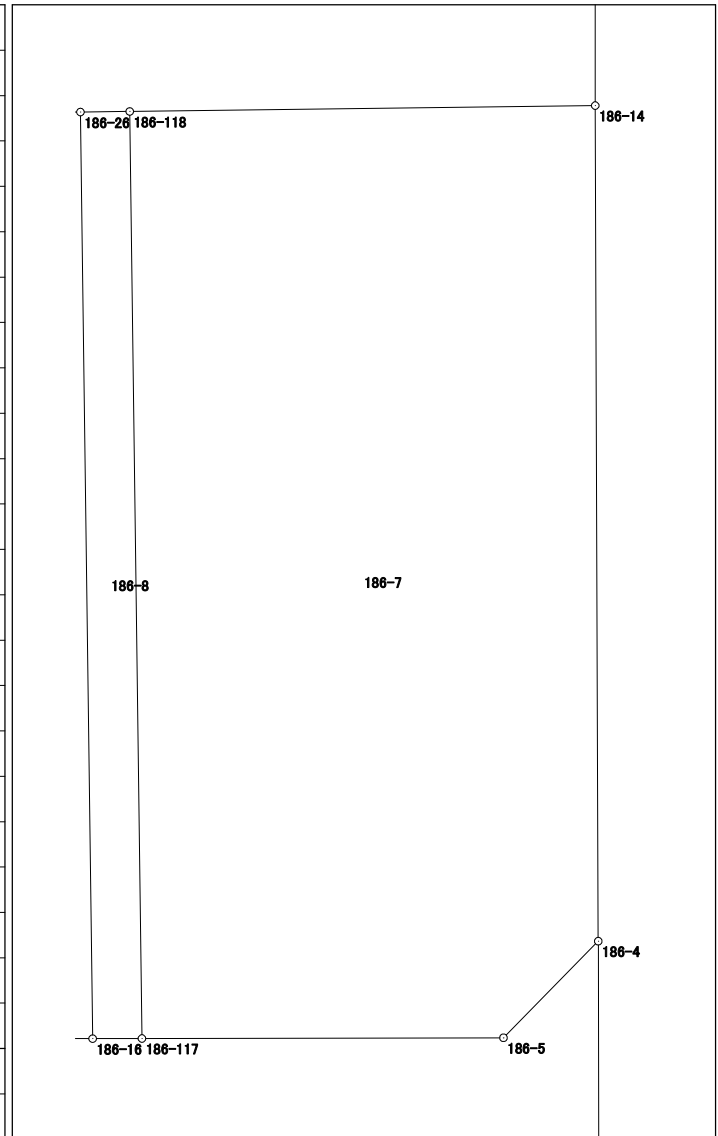


面積計算書（座標法）

世界測地系（測地成果2011）

所 在	地 番	公簿地目	現況地目	地 積	所 有 者
前橋市六供町三丁目	186-8			39.91 m ²	

点 名	X 座標	Y 座標	辺 長	方 向 角	測 角	DX	倍 積 (Y×DX)
186-117	41040.962	-68047.378	27.400	359-14-50	89-21-55	27.401	-1864566.204578
186-118	41068.360	-68047.738	1.457	269-17-32	90-02-42	27.380	-1863147.066440
186-26	41068.342	-68049.195	27.385	179-14-48	89-57-16	-27.401	1864615.992195
186-16	41040.959	-68048.835	1.457	89-52-55	90-38-07	-27.380	1863177.102300
						倍面積	79.823477
						面 積	39.9117385

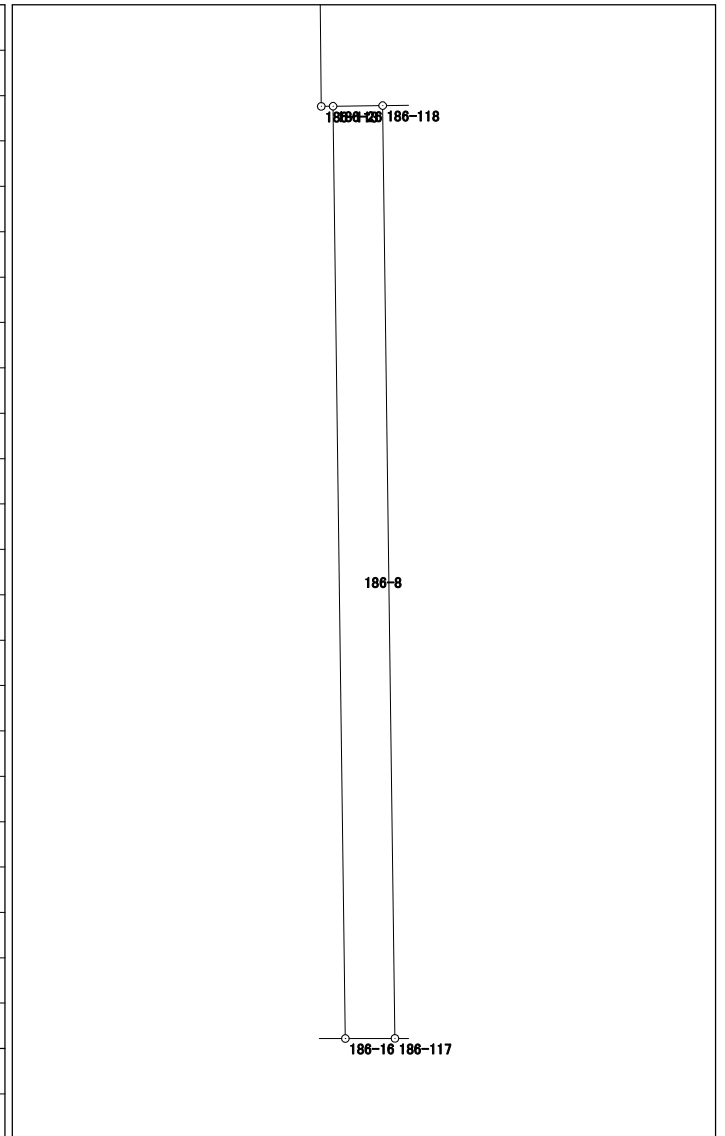


面積計算書 (座標法)

世界測地系 (測地成果2011)

所在	地番	公簿地目	現況地目	地積	所有者
前橋市六供町三丁目	186-9			466.06 m ²	

点名	X座標	Y座標	辺長	方向角	測角	DX	倍積 (Y×DX)
186-16	41040.959	-68048.835	27.385	359-14-48	89-25-04	27.434	-1866851.739390
186-26	41068.342	-68049.195	0.347	269-10-28	89-55-40	27.378	-1863050.860710
186-113	41068.337	-68049.542	11.996	269-15-35	180-05-07	-0.160	10887.926720
186-105	41068.182	-68061.537	3.266	269-14-44	179-59-09	-0.198	13476.184326
186-25	41068.139	-68064.803	1.458	269-57-39	180-42-55	-0.044	2994.851332
186-30	41068.138	-68066.261	27.232	179-15-57	89-18-18	-27.231	1853512.353291
186-29	41040.908	-68065.912	17.077	89-49-44	90-33-47	-27.179	1849963.422248

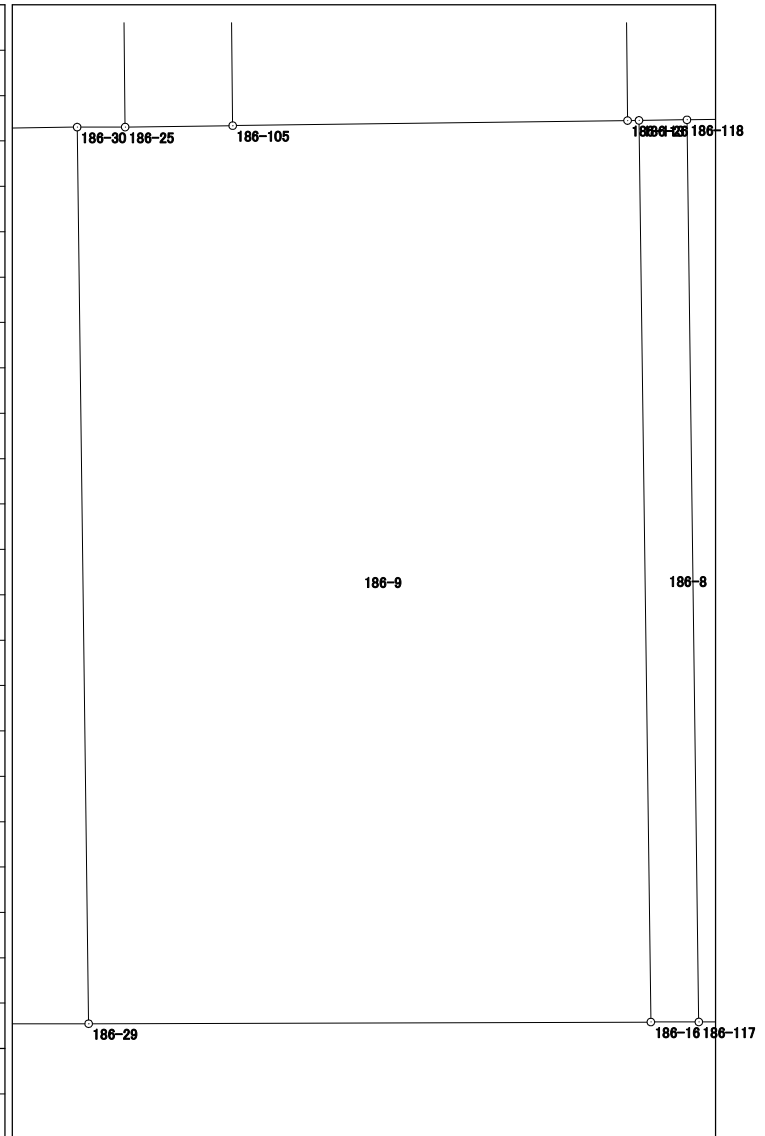


倍面積	932.137817
面積	466.0689085

面積計算書 (座標法)

世界測地系 (測地成果2011)

所 在	地 番	公簿地目	現況地目	地 積	所 有 者
前橋市六供町三丁目	186-10-1			175.40 m ²	

点 名	X 座標	Y 座標	辺 長	方 向 角	測 角	DX	倍 積 (Y×DX)
186-34	41040.814	-68100.579	13.878	359-22-21	89-32-40	13.886	-945644.639994
186-40	41054.691	-68100.731	7.272	89-47-43	270-25-22	13.903	-946804.463093
186-41	41054.717	-68093.459	13.038	359-09-38	89-21-55	13.063	-889504.854917
186-38	41067.754	-68093.650	5.306	269-15-18	90-05-40	12.968	-883038.453200
186-112	41067.685	-68098.956	4.971	269-15-45	180-00-27	-0.133	9057.161148
186-22	41067.621	-68103.927	6.510	179-13-32	89-57-47	-6.573	447647.112171
186-37	41061.112	-68103.839	20.309	179-15-39	180-02-07	-26.816	1826272.546624
186-18	41040.805	-68103.577	2.998	89-49-41	90-34-02	-20.298	1382366.405946

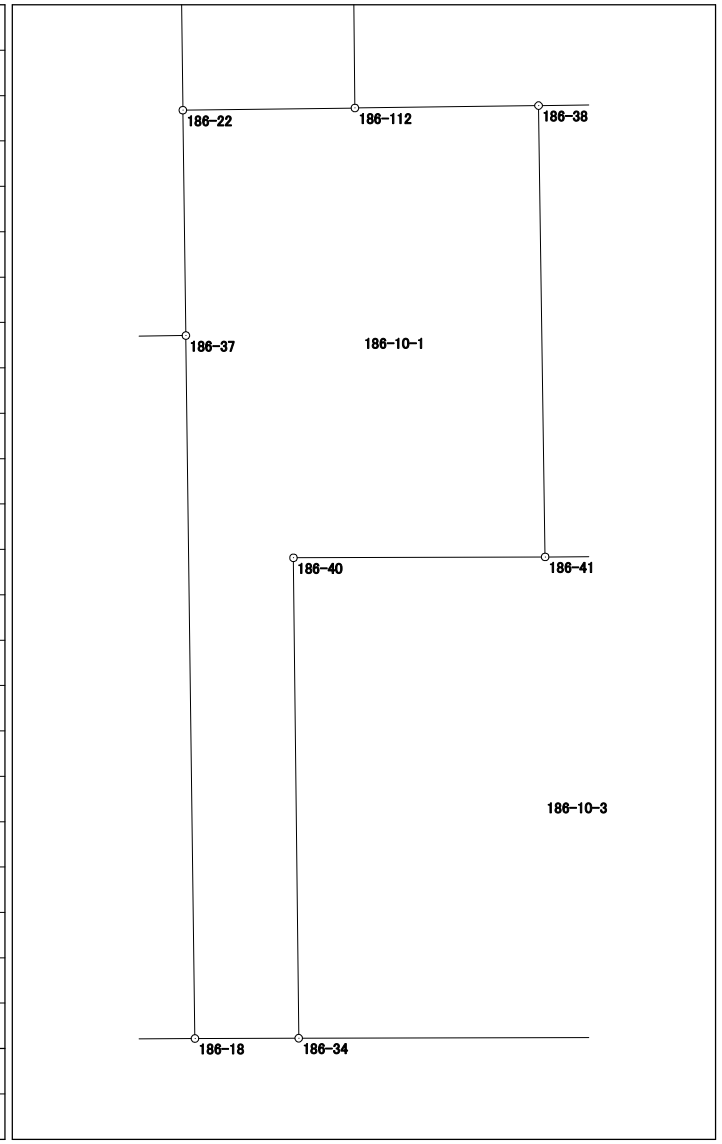


面積計算書 (座標法)

世界測地系 (測地成果2011)

所在	地番	公簿地目	現況地目	地積	所有者
前橋市六供町三丁目	186-10-3			200.91 m ²	

点名	X座標	Y座標	辺長	方向角	測角	DX	倍積 (Y×DX)
186-40	41054.691	-68100.731	13.878	179-22-21	89-34-38	-13.903	946804.463093
186-34	41040.814	-68100.579	14.480	89-51-41	90-29-20	-13.842	942648.214518
186-33	41040.849	-68086.099	13.885	359-18-09	89-26-28	13.919	-947690.411981
186-42	41054.733	-68086.268	7.191	269-52-21	90-34-12	13.868	-944220.364624
186-41	41054.717	-68093.459	7.272	269-47-43	179-55-22	-0.042	2859.925278

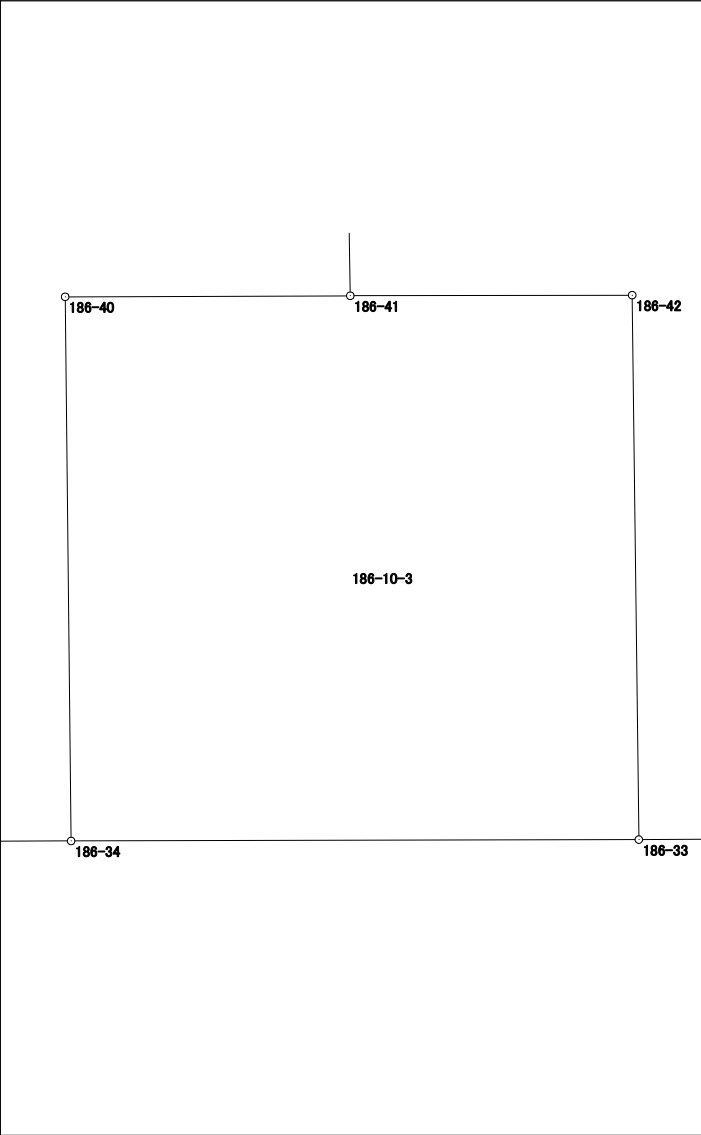


倍面積	401.826284
面積	200.9131420

面積計算書 (座標法)

世界測地系 (測地成果2011)

所在	地番	公簿地目	現況地目	地積	所有者
前橋市六供町三丁目	186-11			123.74 m ²	

点名	X座標	Y座標	辺長	方向角	測角	DX	倍積 (Y×DX)
186-116	41048.165	-68132.093	16.770	269-48-31	90-34-08	7.405	-504518.148665
186-115	41048.109	-68148.863	7.468	176-29-57	86-41-26	-7.510	511797.961130
186-6	41040.655	-68148.407	16.413	89-49-44	93-19-47	-7.405	504638.953835
186-104	41040.704	-68131.994	7.462	359-14-23	89-24-39	7.510	-511671.274940

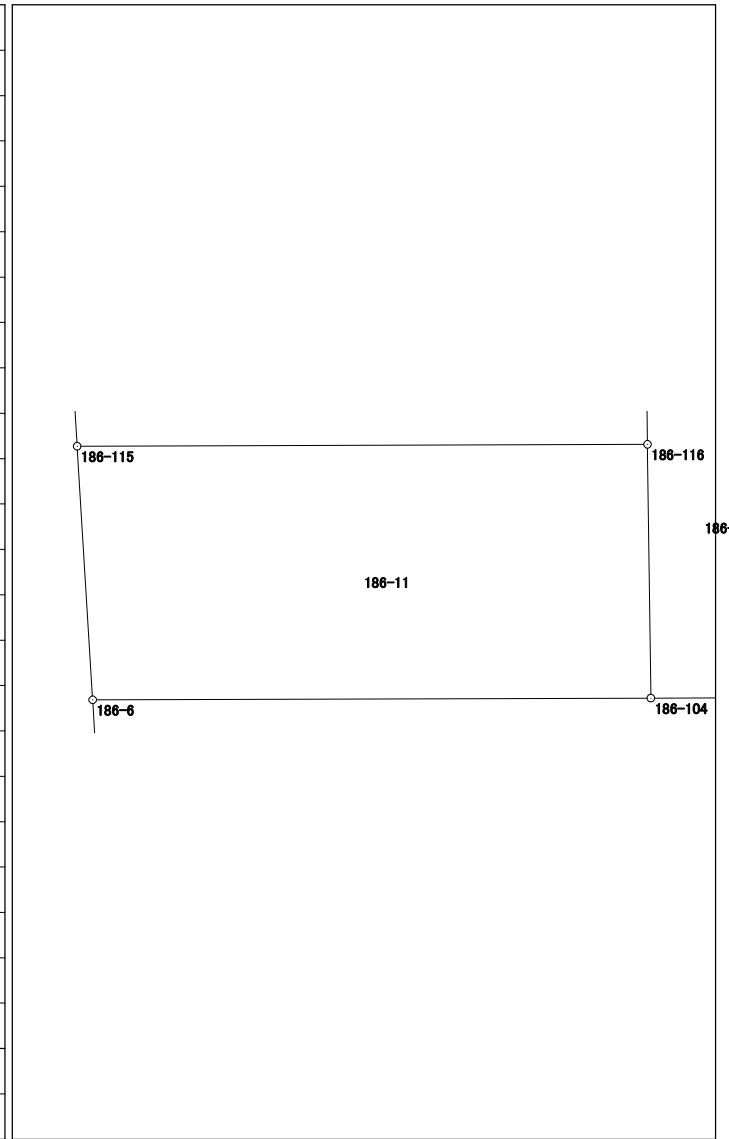


倍面積	247.491360
面積	123.7456800

面積計算書（座標法）

世界測地系（測地成果2011）

所在	地番	公簿地目	現況地目	地積	所有者
前橋市六供町三丁目	186-12			466.26 m ²	

点名	X座標	Y座標	辺長	方向角	測角	DX	倍積 (Y×DX)
186-17	41040.863	-68083.098	17.186	89-51-00	90-36-18	-26.969	1836133.069962
186-29	41040.908	-68065.912	27.232	359-15-57	89-24-57	27.275	-1856497.749800
186-30	41068.138	-68066.261	3.617	269-07-44	89-51-47	27.175	-1849700.642675
186-108	41068.083	-68069.878	13.578	269-07-50	180-00-06	-0.261	17766.238158
186-24	41067.877	-68083.454	27.016	179-14-42	90-06-52	-27.220	1853231.617880

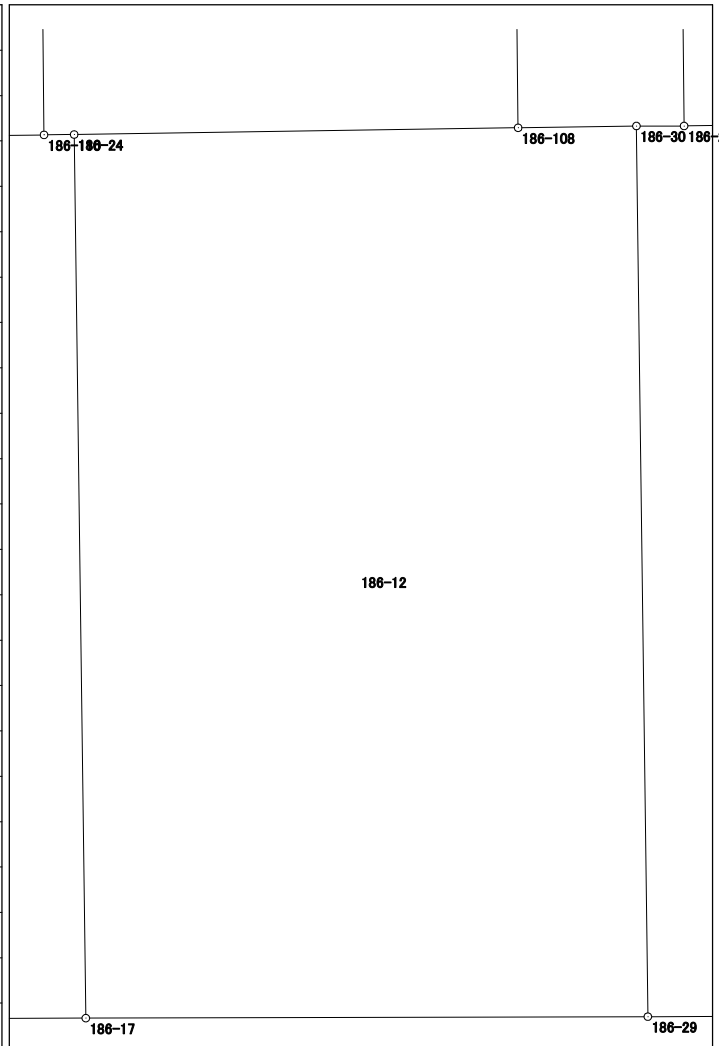


倍面積	932.533525
面積	466.2667625

面積計算書（座標法）

世界測地系（測地成果2011）

所在	地番	公簿地目	現況地目	地積	所有者
前橋市六供町三丁目	186-保-1			38.00 m ²	

点名	X座標	Y座標	辺長	方向角	測角	DX	倍積 (Y×DX)
186-105	41068.182	-68061.537	11.636	359-22-29	90-07-45	11.678	-794822.629086
186-106	41079.817	-68061.664	3.265	269-15-47	89-53-18	11.593	-789038.870752
186-12	41079.775	-68064.929	11.637	179-22-47	90-07-00	-11.678	794862.240862
186-25	41068.139	-68064.803	3.266	89-14-44	89-51-57	-11.593	789075.261179
						倍面積	76.002203
						面積	38.0011015

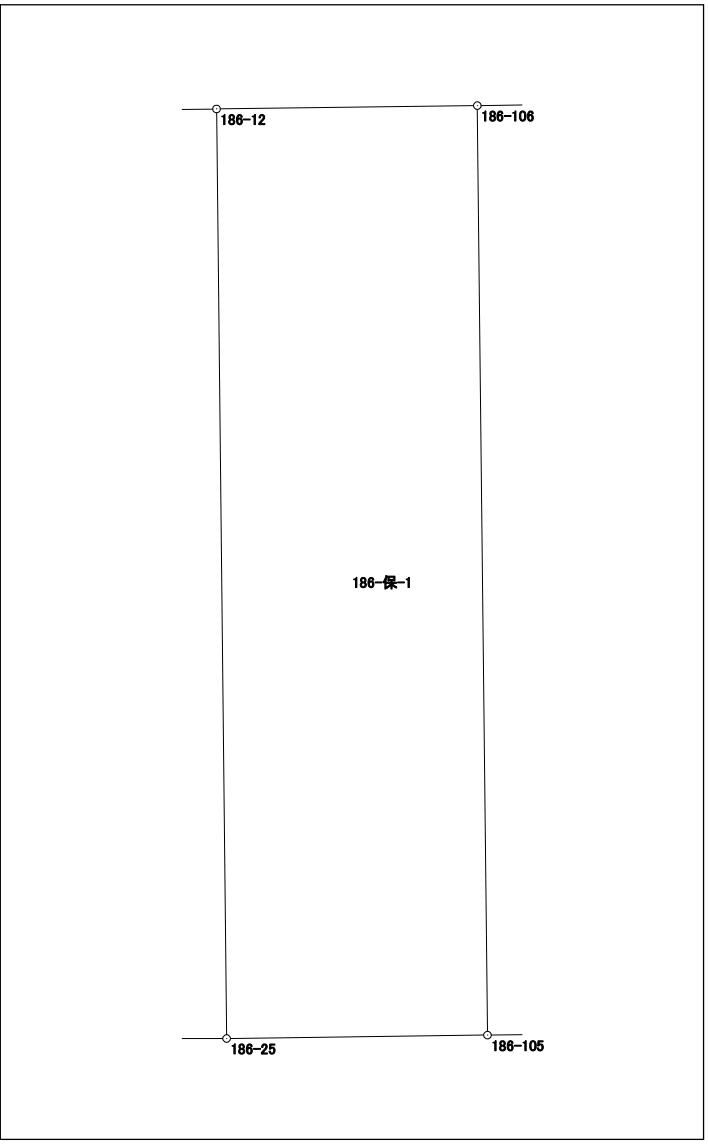


面積計算書 (座標法)

世界測地系 (測地成果2011)

所在	地番	公簿地目	現況地目	地積	所有者
前橋市六供町三丁目	186-保-2			59.00 m ²	

点名	X座標	Y座標	辺長	方向角	測角	DX	倍積 (Y×DX)
186-107	41079.708	-68070.005	11.626	179-22-27	90-07-49	-11.692	795874.498460
186-108	41068.083	-68069.878	3.617	89-07-44	89-45-17	-11.570	787568.488460
186-30	41068.138	-68066.261	1.458	89-57-39	180-49-55	0.056	-3811.710616
186-25	41068.139	-68064.803	11.637	359-22-47	89-25-08	11.637	-792070.112511
186-12	41079.775	-68064.929	5.076	269-14-38	89-51-51	11.569	-787443.163601
						倍面積	118.000192
						面積	59.0000960

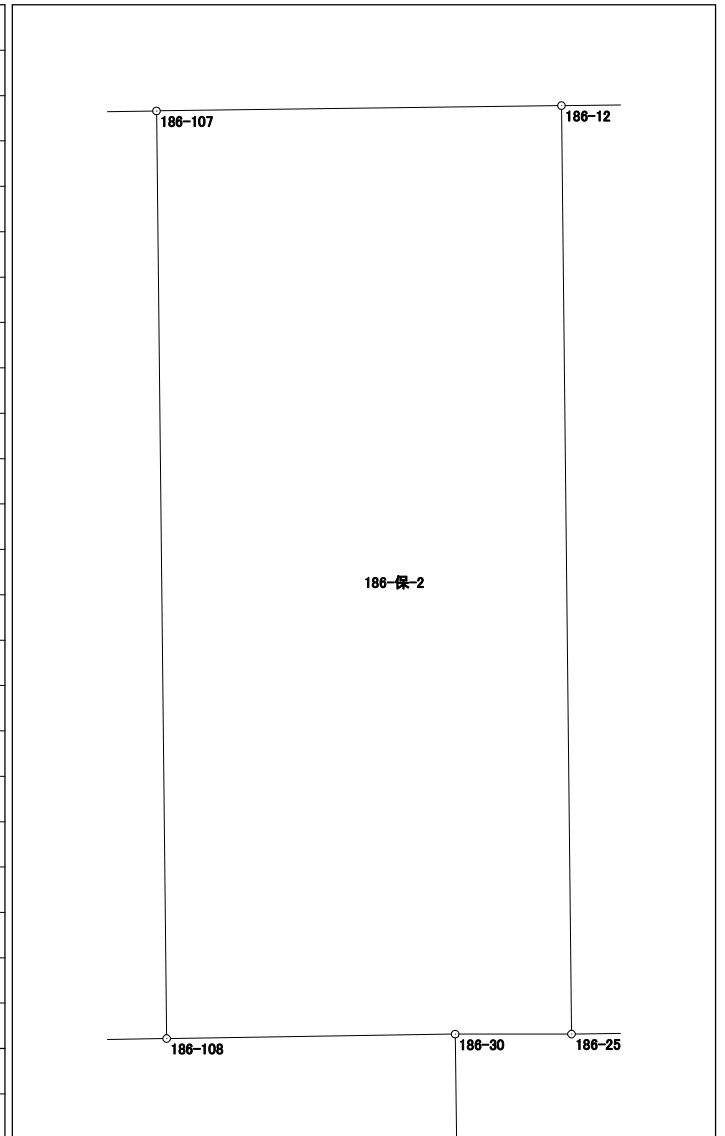


面積計算書（座標法）

世界測地系（測地成果2011）

所 在	地 番	公簿地目	現況地目	地 積	所 有 者
前橋市六供町三丁目	186-保-3			94.00 m ²	

点 名	X 座標	Y 座標	辺 長	方 向 角	測 角	DX	倍 積 (Y×DX)
186-102	41055.878	-68149.336	4.632	176-31-18	86-42-34	-4.690	319620.385840
186-20	41051.255	-68149.055	16.921	89-48-37	93-17-19	-4.567	311236.734185
186-103	41051.311	-68132.134	3.299	89-48-32	179-59-55	0.067	-4564.852978
186-21	41051.322	-68128.835	4.623	359-16-08	89-27-36	4.634	-315709.021390
186-101	41055.945	-68128.894	20.442	269-48-44	90-32-36	4.556	-310395.241064
倍面積						188.004593	
面 積						94.0022965	

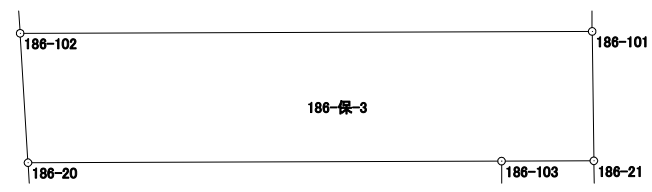


面積計算書 (座標法)

所在	地番	公簿地目	現況地目	地積	所有者
前橋市六供町三丁目	186-保-4			35.00 m ²	

点名	X 座標	Y 座標	辺長	方向角	測角	DX	倍積 (Y×DX)
186-116	41048.165	-68132.093	7.462	179-14-23	179-59-11	-10.607	722677.110451
186-104	41040.704	-68131.994	3.300	89-50-37	90-36-14	-7.452	507719.619288
186-19	41040.713	-68128.694	10.610	359-14-19	89-23-42	10.618	-723390.472892
186-21	41051.322	-68128.835	3.299	269-48-32	90-34-13	10.598	-722029.393330
186-103	41051.311	-68132.134	3.146	179-15-12	89-26-40	-3.157	215093.147038

倍面積	70.010555
面積	35.0052775

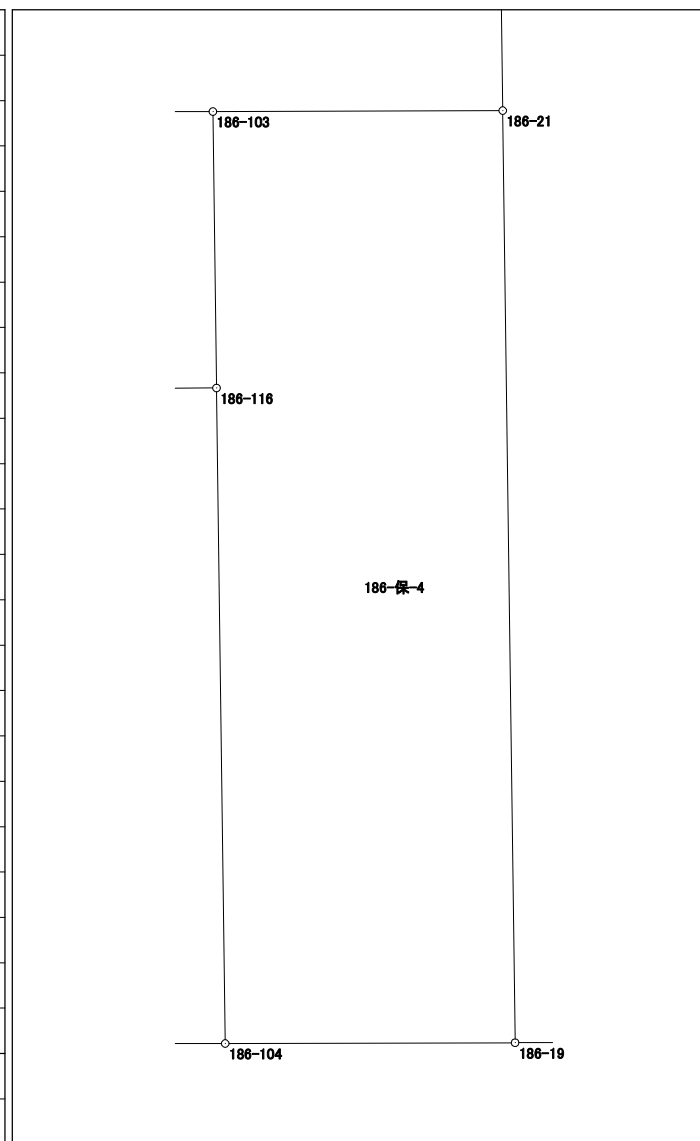

面積計算書 (座標法)

世界測地系 (測地成果2011)

所 在	地 番	公簿地目	現況地目	地 積	所 有 者
前橋市六供町三丁目	186-保-5			53.00 m ²	

点 名	X 座標	Y 座標	辺 長	方 向 角	測 角	DX	倍 積 (Y×DX)
186-115	41048.109	-68148.863	16.770	89-48-31	93-18-04	-3.090	210579.986670
186-116	41048.165	-68132.093	3.146	359-15-12	89-26-41	3.202	-218158.961786
186-103	41051.311	-68132.134	16.921	269-48-37	90-33-25	3.090	-210528.294060
186-20	41051.255	-68149.055	3.152	176-30-27	86-41-50	-3.202	218213.274110
倍面積						106.004934	
面 積						53.0024670	

