



19-1街区 (2843.50m<sup>2</sup>)  
 19-2街区 (1261.99m<sup>2</sup>)

# 画地出来形確認図

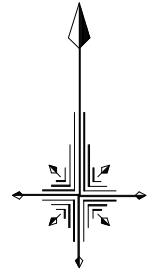

S=1/500

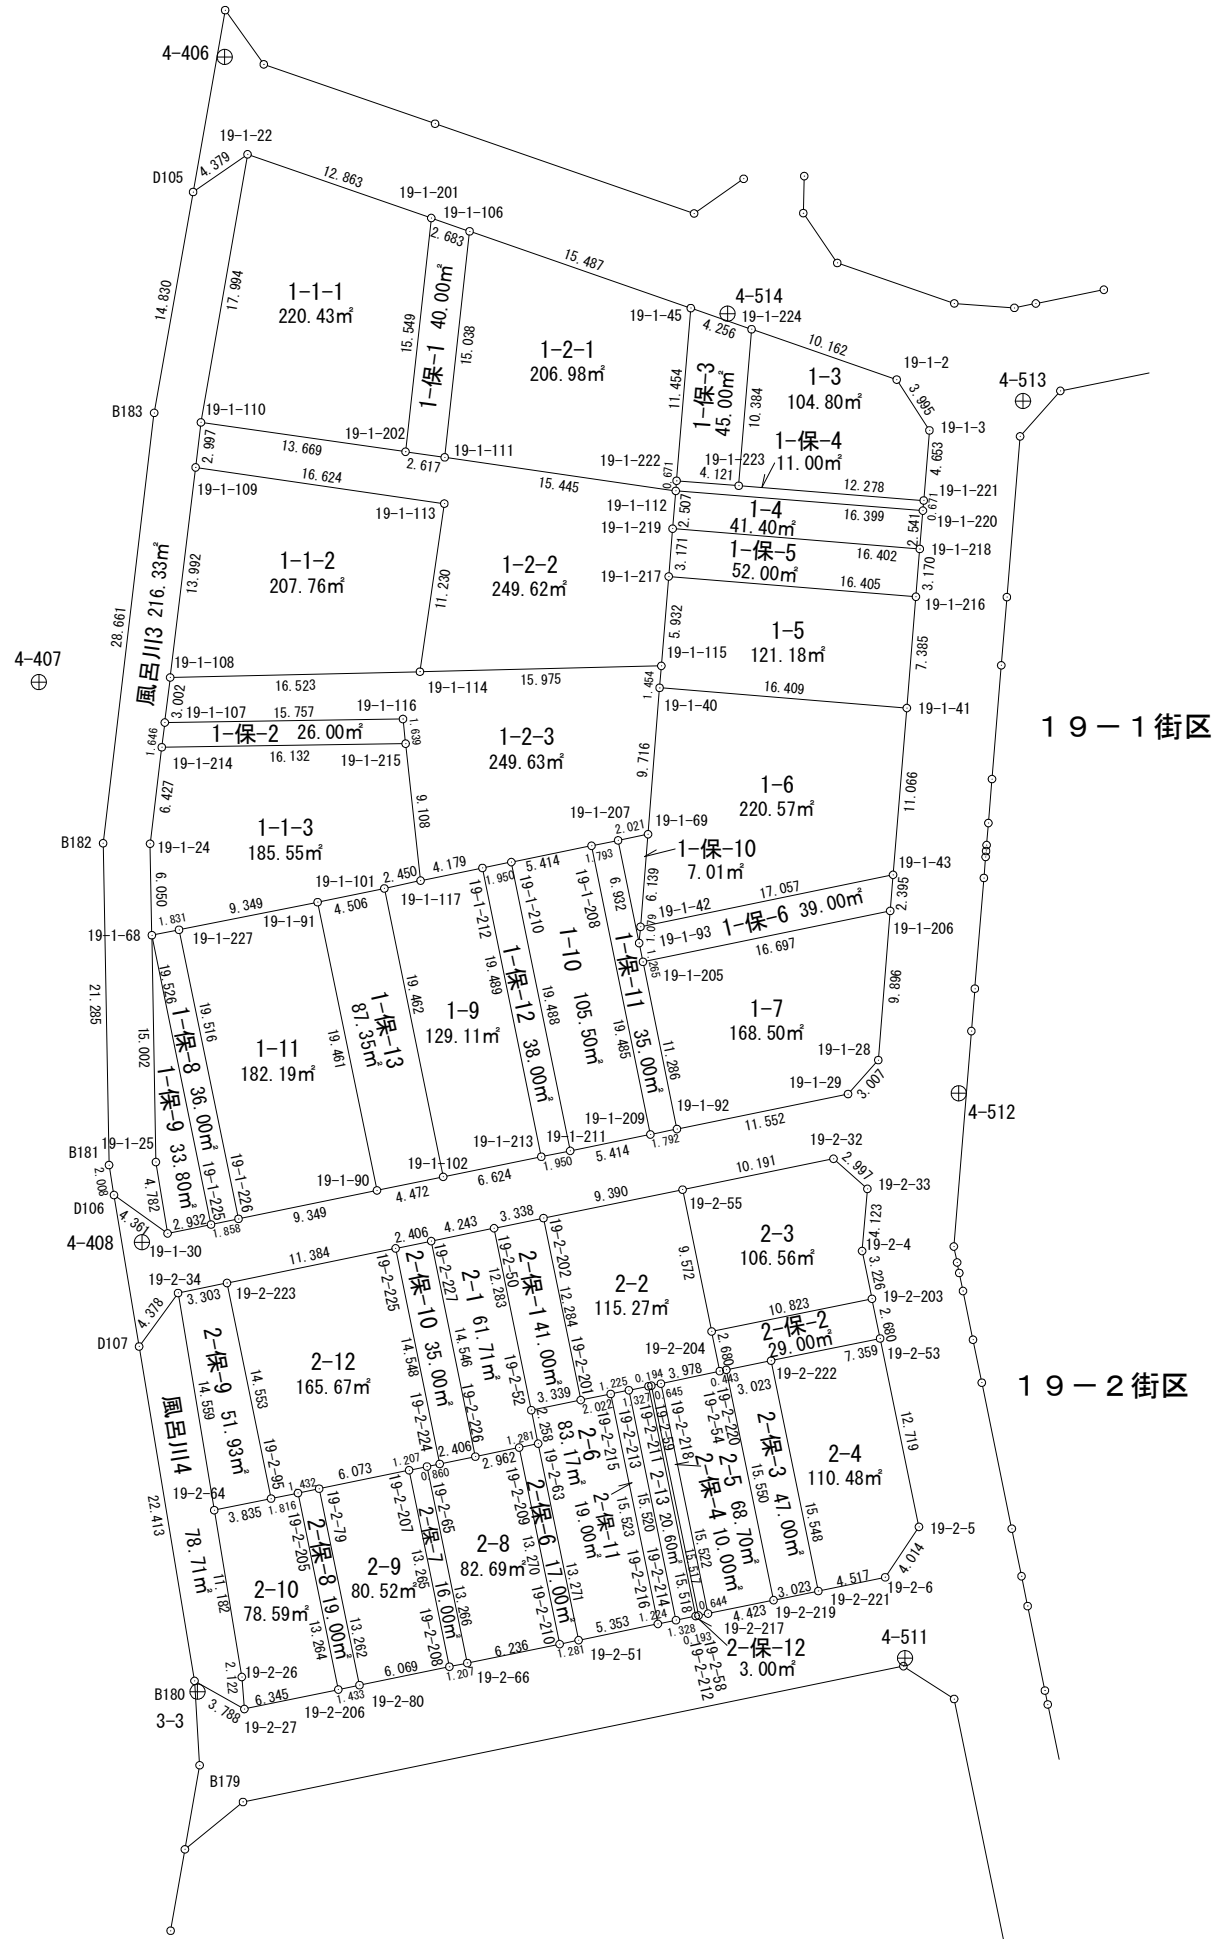


# 面積計算書（座標法）

世界測地系（測地成果2011）

所 在	地 番	公簿地目	現況地目	地 積	所 有 者
前橋市六供町一丁目	19-1-1-1			220.43 m <sup>2</sup>	

点 名	X 座標	Y 座標	辺 長	方 向 角	測 角	DX	倍 積 (Y×DX)
19-1-201	41758.054	-68559.929	12.863	289-07-10	102-49-40	19.668	-1348436.683572
19-1-22	41762.267	-68572.082	17.994	189-51-44	80-44-34	-13.515	926751.688230
19-1-110	41744.539	-68575.164	13.669	98-09-33	88-17-49	-19.668	1348736.325552
19-1-202	41742.599	-68561.633	15.549	6-17-30	88-07-57	13.515	-926610.469995
						倍面積	440.860215
						面積	220.4301075

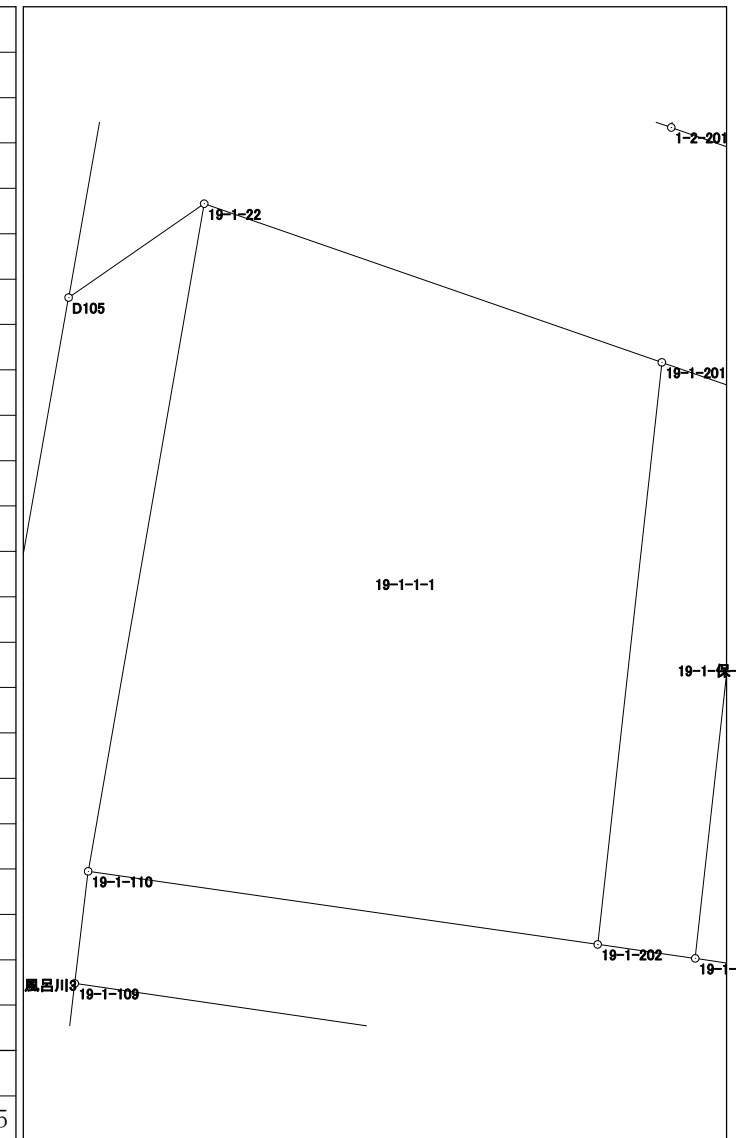


## 面積計算書（座標法）

世界測地系（測地成果2011）

所在	地番	公簿地目	現況地目	地積	所有者
前橋市六供町一丁目	19-1-1-2			207.76 m <sup>2</sup>	

点名	X座標	Y座標	辺長	方向角	測角	DX	倍積 (Y×DX)
19-1-109	41741.563	-68575.519	13.992	186-53-45	88-36-46	-11.496	788344.166424
19-1-108	41727.672	-68577.199	16.523	88-40-31	81-46-46	-13.509	926409.381291
19-1-114	41728.054	-68560.680	11.230	8-15-10	99-34-39	11.496	-788173.577280
19-1-113	41739.168	-68559.068	16.624	278-16-59	90-01-49	13.509	-926164.449612
						倍面積	415.520823
						面積	207.7604115

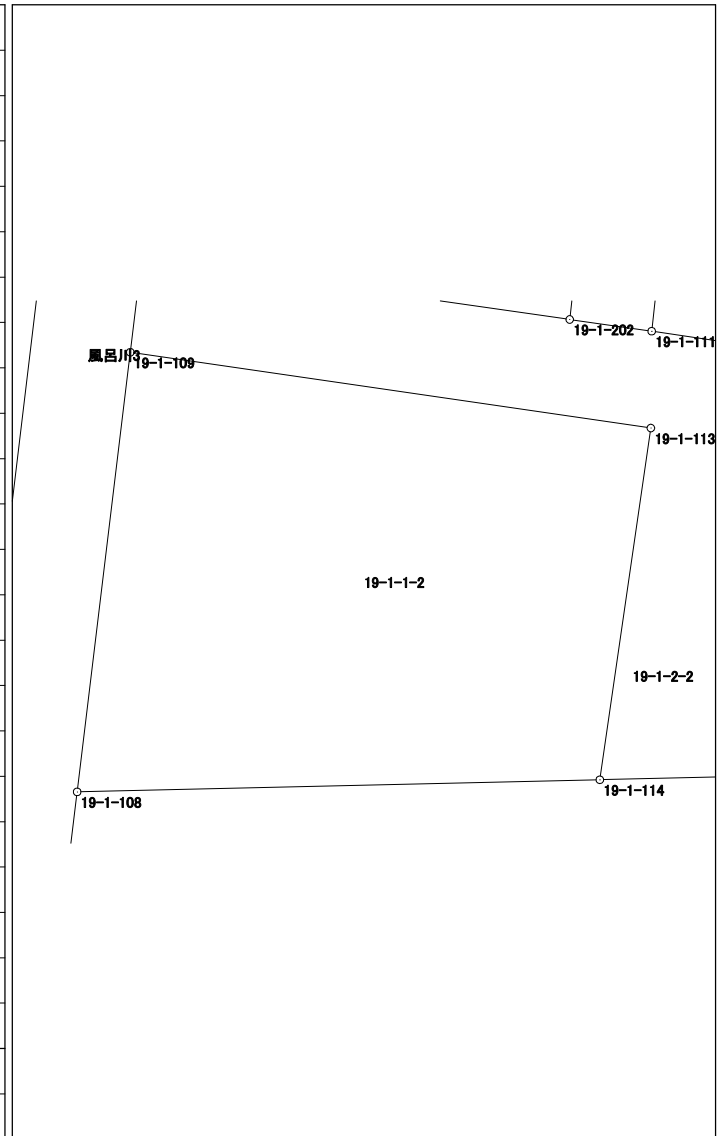


# 面積計算書（座標法）

世界測地系（測地成果2011）

所 在	地 番	公簿地目	現況地目	地 積	所 有 者
前橋市六供町一丁目	19-1-1-3			185.55 m <sup>2</sup>	

点 名	X 座 標	Y 座 標	辺 長	方 向 角	測 角	DX	倍 積 (Y×DX)
19-1-214	41723.057	-68577.755	6.427	186-54-30	97-45-00	-6.617	453779.004835
19-1-24	41716.677	-68578.528	6.050	178-53-31	171-59-01	-12.429	852362.524512
19-1-68	41710.628	-68578.411	1.831	78-43-37	79-50-06	-5.691	390279.737001
19-1-227	41710.986	-68576.615	9.349	78-44-13	180-00-36	2.184	-149771.327160
19-1-91	41712.812	-68567.446	4.506	78-21-39	179-37-26	2.735	-187531.964810
19-1-101	41713.721	-68563.033	2.450	77-46-05	179-24-26	1.428	-97908.011124
19-1-117	41714.240	-68560.639	9.108	353-47-05	96-01-00	9.573	-656330.997147
19-1-215	41723.294	-68561.625	16.132	269-09-30	95-22-25	8.817	-604507.847625

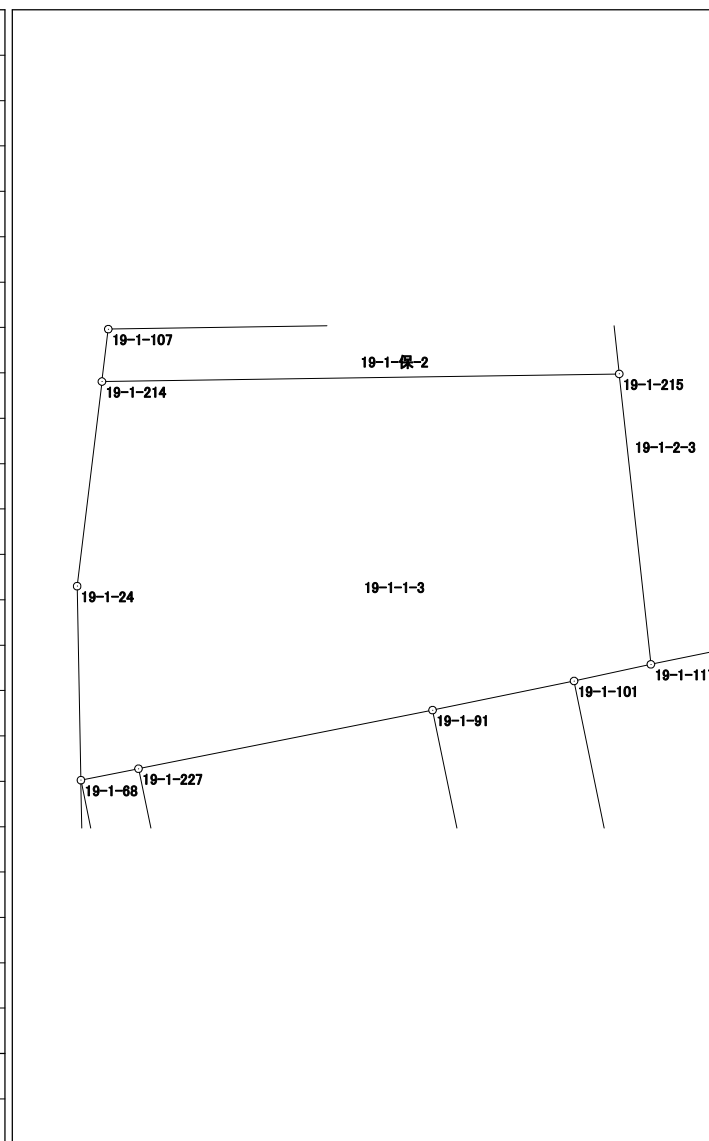

倍面積	371.118482
面 積	185.5592410


# 面積計算書 (座標法)

世界測地系 (測地成果2011)

所在	地番	公簿地目	現況地目	地積	所有者
前橋市六供町一丁目	19-1-2-1			206.98 m <sup>2</sup>	

点名	X座標	Y座標	辺長	方向角	測角	DX	倍積 (Y×DX)
19-1-106	41757.175	-68557.394	15.038	186-17-30	77-08-35	-9.867	676455.806598
19-1-111	41742.228	-68559.042	15.445	98-15-24	91-57-54	-17.165	1176815.955930
19-1-112	41740.010	-68543.757	0.671	4-41-59	86-26-35	-1.549	106174.279593
19-1-222	41740.679	-68543.702	11.454	4-41-50	179-59-51	12.085	-828350.638670
19-1-45	41752.095	-68542.764	15.487	289-08-55	104-27-05	16.496	-1130681.434944

倍面積	413.968507
面積	206.9842535

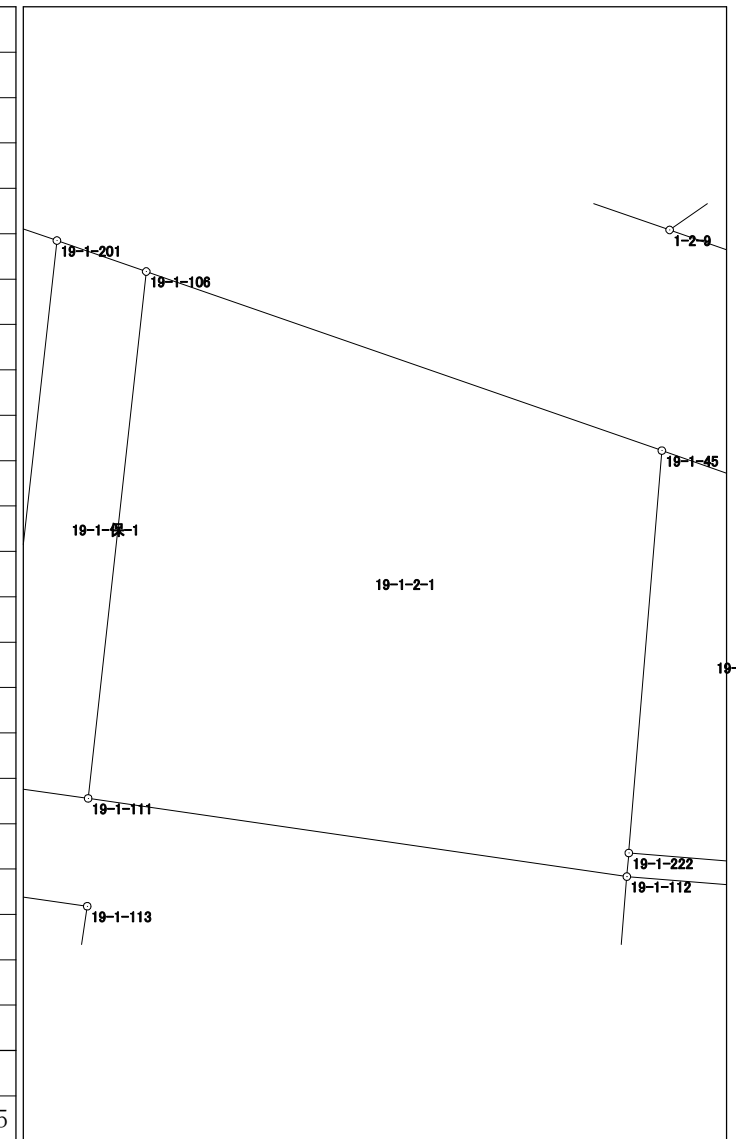


# 面積計算書（座標法）

世界測地系（測地成果2011）

所在	地番	公簿地目	現況地目	地積	所有者
前橋市六供町一丁目	19-1-2-2			249.62 m <sup>2</sup>	

点名	X座標	Y座標	辺長	方向角	測角	DX	倍積 (Y×DX)
19-1-110	41744.539	-68575.164	2.997	186-48-09	88-38-36	-1.036	71043.869904
19-1-109	41741.563	-68575.519	16.624	98-16-59	91-28-50	-5.371	368319.112549
19-1-113	41739.168	-68559.068	11.230	188-15-10	269-58-11	-13.509	926164.449612
19-1-114	41728.054	-68560.680	15.975	88-37-08	80-21-58	-10.729	735587.535720
19-1-115	41728.439	-68544.710	5.932	4-42-33	96-05-25	6.297	-431626.038870
19-1-217	41734.351	-68544.223	3.171	4-42-13	179-59-40	9.072	-621833.191056
19-1-219	41737.511	-68543.963	2.507	4-42-45	180-00-32	5.659	-387890.286617
19-1-112	41740.010	-68543.757	15.445	278-15-24	93-32-39	4.717	-323320.901769
19-1-111	41742.228	-68559.042	2.617	278-08-55	179-53-31	2.589	-177499.359738
19-1-202	41742.599	-68561.633	13.669	278-09-33	180-00-38	2.311	-158445.933863

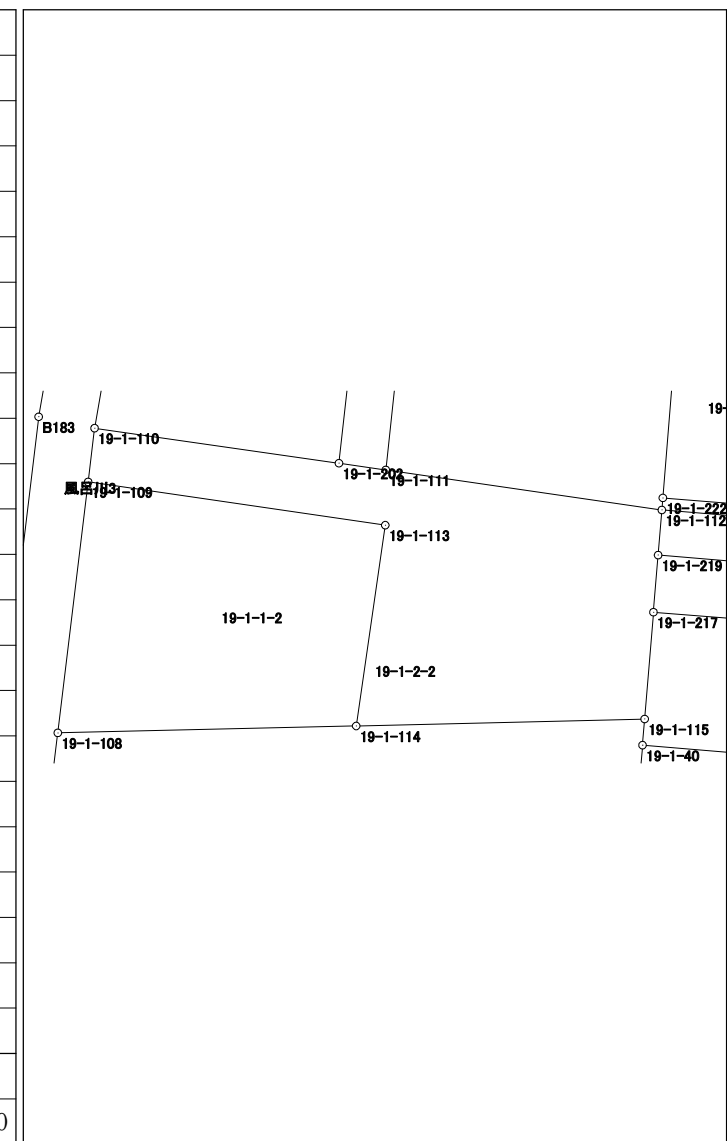

倍面積	499.255872
面積	249.6279360




# 面積計算書 (座標法)

世界測地系 (測地成果2011)

所在	地番	公簿地目	現況地目	地積	所有者
前橋市六供町一丁目	19-1-3			104.80 m <sup>2</sup>	

点名	X座標	Y座標	辺長	方向角	測角	DX	倍積 (Y×DX)
19-1-223	41740.351	-68539.594	12.278	94-33-51	89-51-48	-11.326	776279.441644
19-1-221	41739.374	-68527.355	4.653	4-39-34	90-05-43	3.661	-250878.646655
19-1-3	41744.012	-68526.977	3.995	327-10-52	142-31-18	7.995	-547873.181115
19-1-2	41747.369	-68529.142	10.162	289-08-02	141-57-10	6.688	-458322.901696
19-1-224	41750.700	-68538.743	10.384	184-42-03	75-34-01	-7.018	481004.898374
倍面積							209.610552
面積							104.8052760

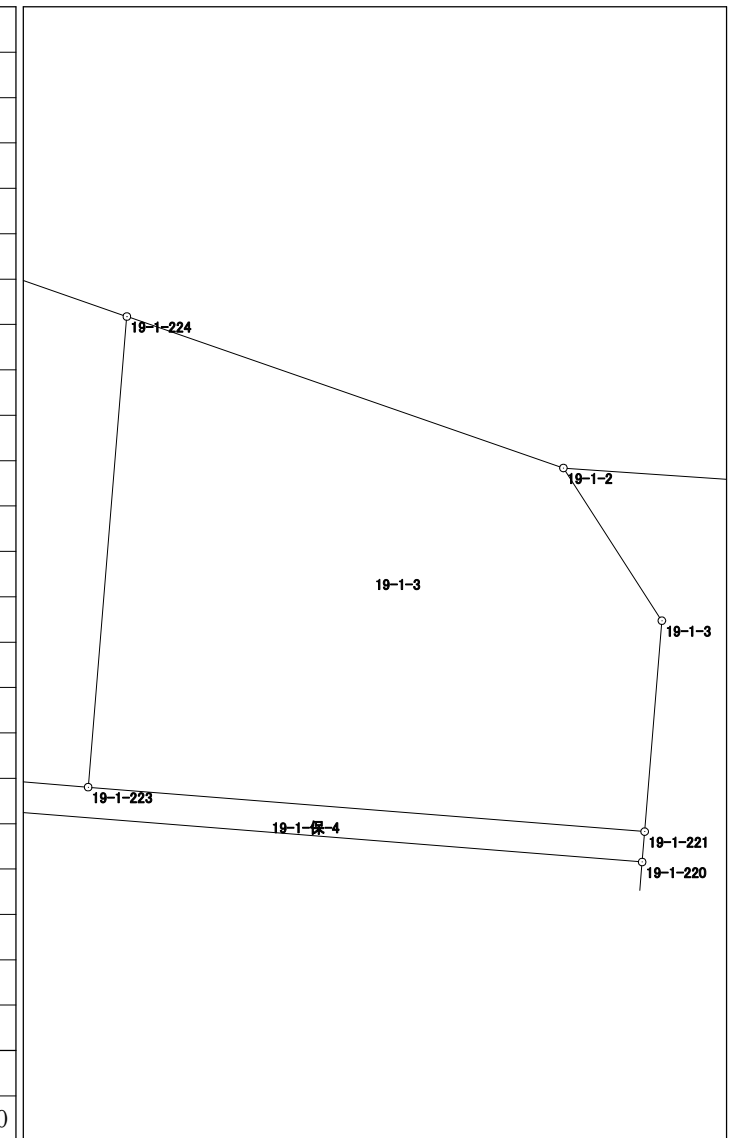




# 面積計算書（座標法）

世界測地系（測地成果2011）

所在	地番	公簿地目	現況地目	地積	所有者
前橋市六供町一丁目	19-1-4			41.40 m <sup>2</sup>	

点名	X座標	Y座標	辺長	方向角	測角	DX	倍積 (Y×DX)
19-1-112	41740.010	-68543.757	2.507	184-42-45	90-08-53	-1.194	81841.245858
19-1-219	41737.511	-68543.963	16.402	94-40-58	89-58-13	-3.838	263071.729994
19-1-218	41736.172	-68527.616	2.541	4-38-58	89-58-00	1.194	-81821.973504
19-1-220	41738.705	-68527.410	16.399	274-33-52	89-54-54	3.838	-263008.199580
						倍面積	82.802768
						面積	41.4013840

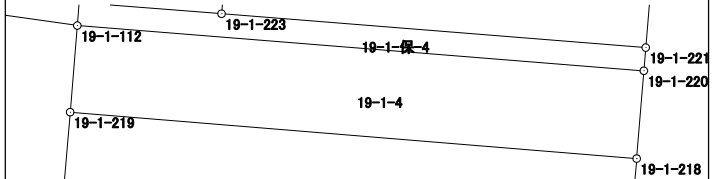


# 面積計算書 (座標法)

世界測地系 (測地成果2011)

所在	地番	公簿地目	現況地目	地積	所有者
前橋市六供町一丁目	19-1-5			121.18 m <sup>2</sup>	

点名	X座標	Y座標	辺長	方向角	測角	DX	倍積 (Y×DX)
19-1-40	41726.990	-68544.826	16.409	94-40-51	90-06-14	-2.788	191102.974888
19-1-41	41725.651	-68528.472	7.385	4-39-08	89-58-17	6.022	-412678.458384
19-1-216	41733.012	-68527.873	16.405	274-40-55	90-01-47	8.700	-596192.495100
19-1-217	41734.351	-68544.223	5.932	184-42-33	90-01-38	-4.573	313452.731779
19-1-115	41728.439	-68544.710	1.454	184-34-37	179-52-04	-7.361	504557.610310
						倍面積	242.363493
						面積	121.1817465

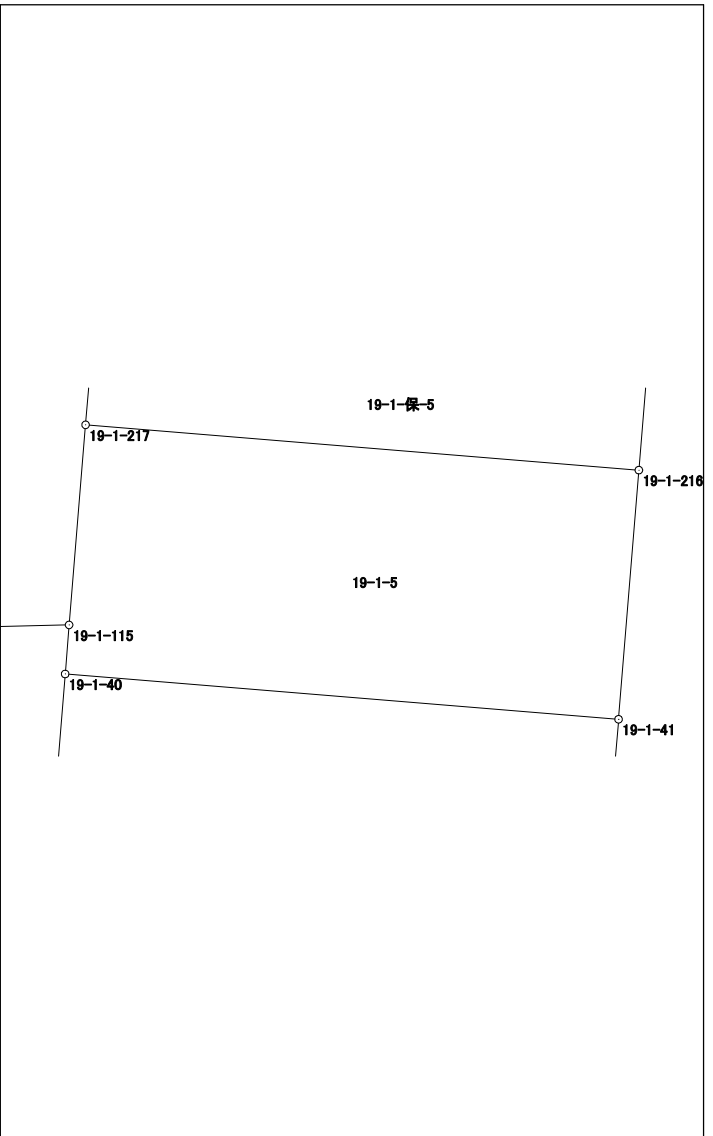


# 面積計算書（座標法）

世界測地系（測地成果2011）

所 在	地 番	公簿地目	現況地目	地 積	所 有 者
前橋市六供町一丁目	19-1-6			220.57 m <sup>2</sup>	

点 名	X 座標	Y 座標	辺 長	方 向 角	測 角	DX	倍 積 (Y×DX)
19-1-40	41726.990	-68544.826	9.716	184-30-57	89-50-06	-8.347	572143.662622
19-1-69	41717.304	-68545.591	6.139	184-39-10	180-08-13	-15.805	1083363.065755
19-1-42	41711.185	-68546.089	17.057	78-22-31	73-43-21	-2.682	183840.610698
19-1-43	41714.622	-68529.382	11.066	4-43-00	106-20-29	14.466	-991346.040012
19-1-41	41725.651	-68528.472	16.409	274-40-51	89-57-51	12.368	-847560.141696

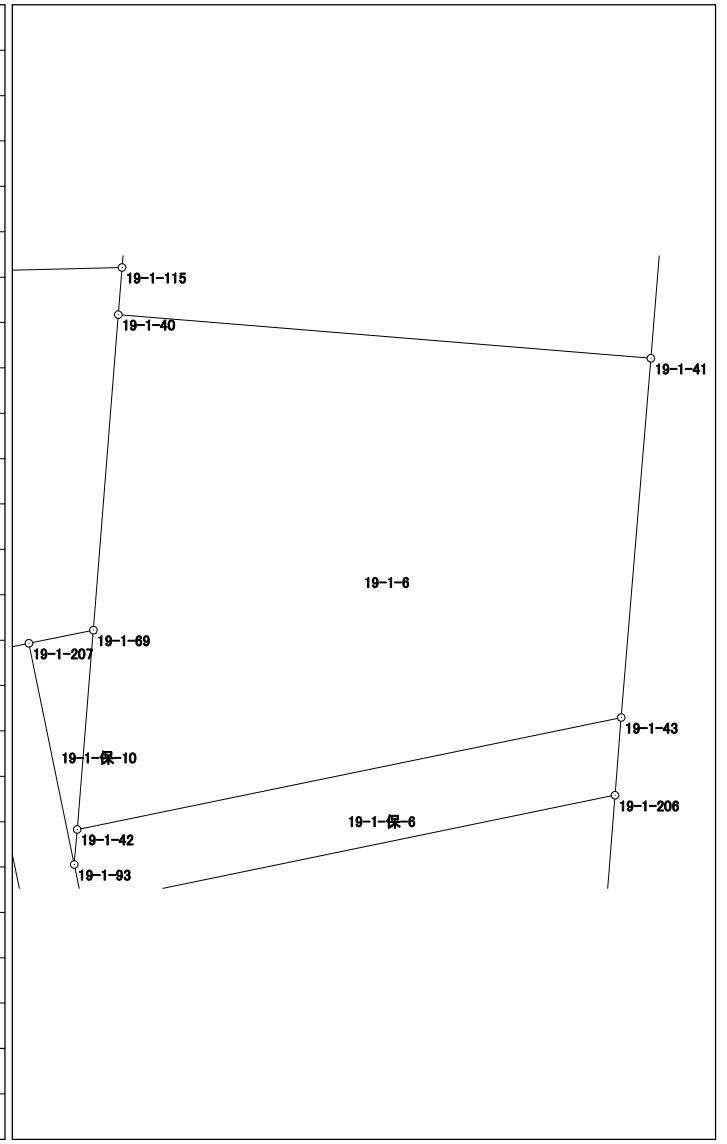


倍面積	441.157367
面 積	220.5786835

# 面積計算書（座標法）

世界測地系（測地成果2011）

所在	地番	公簿地目	現況地目	地積	所有者
前橋市六供町一丁目	19-1-7			168.50 m <sup>2</sup>	


点名	X座標	Y座標	辺長	方向角	測角	DX	倍積 (Y×DX)
19-1-205	41708.870	-68545.927	11.286	168-30-39	90-08-16	-14.425	988774.996975
19-1-92	41697.810	-68543.679	11.552	78-26-24	89-55-45	-8.745	599414.472855
19-1-29	41700.125	-68532.361	3.007	41-41-49	143-15-25	4.560	-312507.566160
19-1-28	41702.370	-68530.361	9.896	4-34-01	142-52-12	12.110	-829902.671710
19-1-206	41712.235	-68529.573	16.697	258-22-23	73-48-22	6.500	-445442.224500
						倍面積	337.007460
						面積	168.5037300

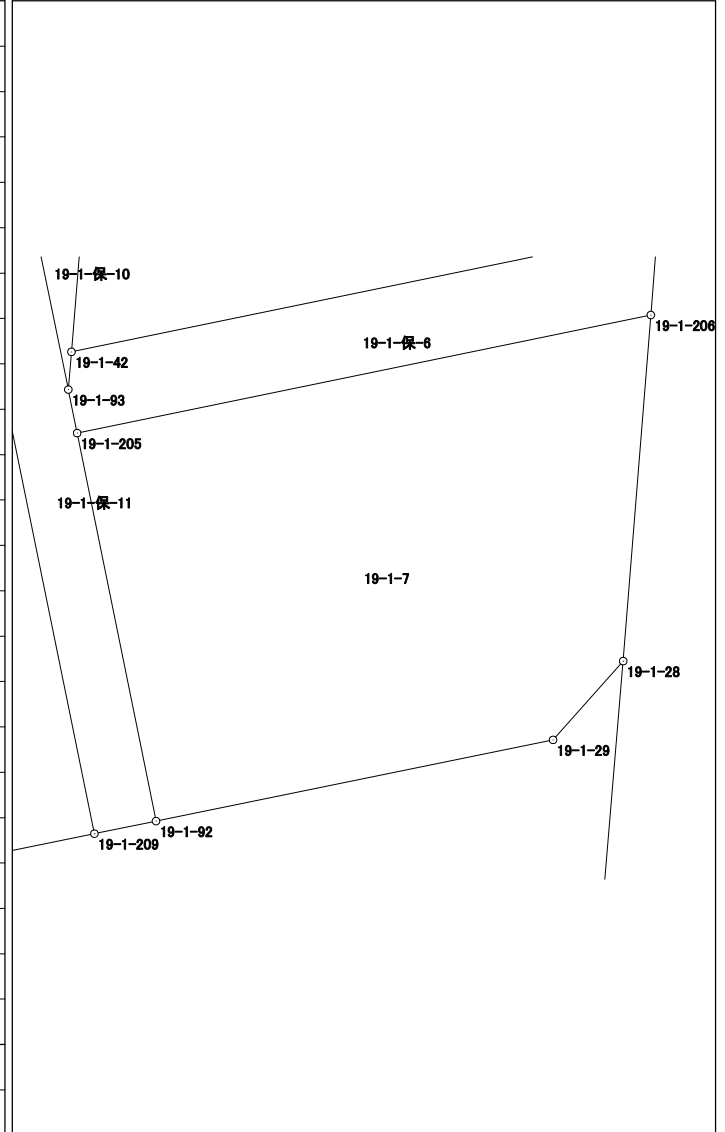

# 面積計算書（座標法）

所在	地番	公簿地目	現況地目	地積	所有者
前橋市六供町一丁目	19-1-9			129.11 m <sup>2</sup>	

点名	X座標	Y座標	辺長	方向角	測角	DX	倍積(Y×DX)
19-1-212	41715.074	-68556.544	4.179	258-29-18	90-00-40	18.262	-1251979.606528
19-1-117	41714.240	-68560.639	2.450	257-46-05	179-16-47	-1.353	92762.544567
19-1-101	41713.721	-68563.033	19.462	168-27-52	90-41-47	-19.588	1343012.690404
19-1-102	41694.652	-68559.141	6.624	78-27-09	89-59-17	-17.743	1216444.838763
19-1-213	41695.978	-68552.651	19.489	348-28-38	90-01-29	20.422	-1399982.238722
						倍面積	258.228484
						面積	129.1142420

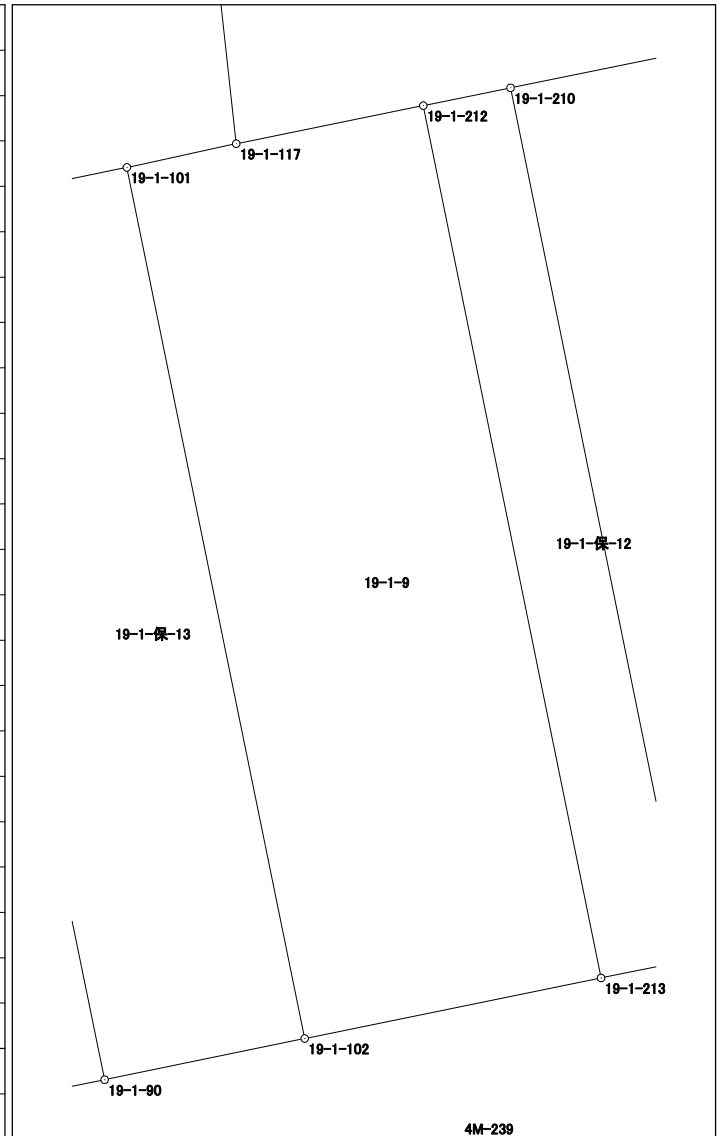




# 面積計算書 (座標法)

世界測地系 (測地成果2011)

所在	地番	公簿地目	現況地目	地積	所有者
前橋市六供町一丁目	19-1-11			182.19 m <sup>2</sup>	

点名	X 座標	Y 座標	辺長	方向角	測角	DX	倍積 (Y×DX)
19-1-226	41691.871	-68572.679	9.349	78-23-57	90-02-04	-17.235	1181850.122565
19-1-90	41693.751	-68563.521	19.461	348-21-52	89-57-55	20.941	-1435788.693261
19-1-91	41712.812	-68567.446	9.349	258-44-13	90-22-21	17.235	-1181759.931810
19-1-227	41710.986	-68576.615	19.516	168-21-53	89-37-40	-20.941	1436062.894715


倍面積	364.392209
面積	182.1961045

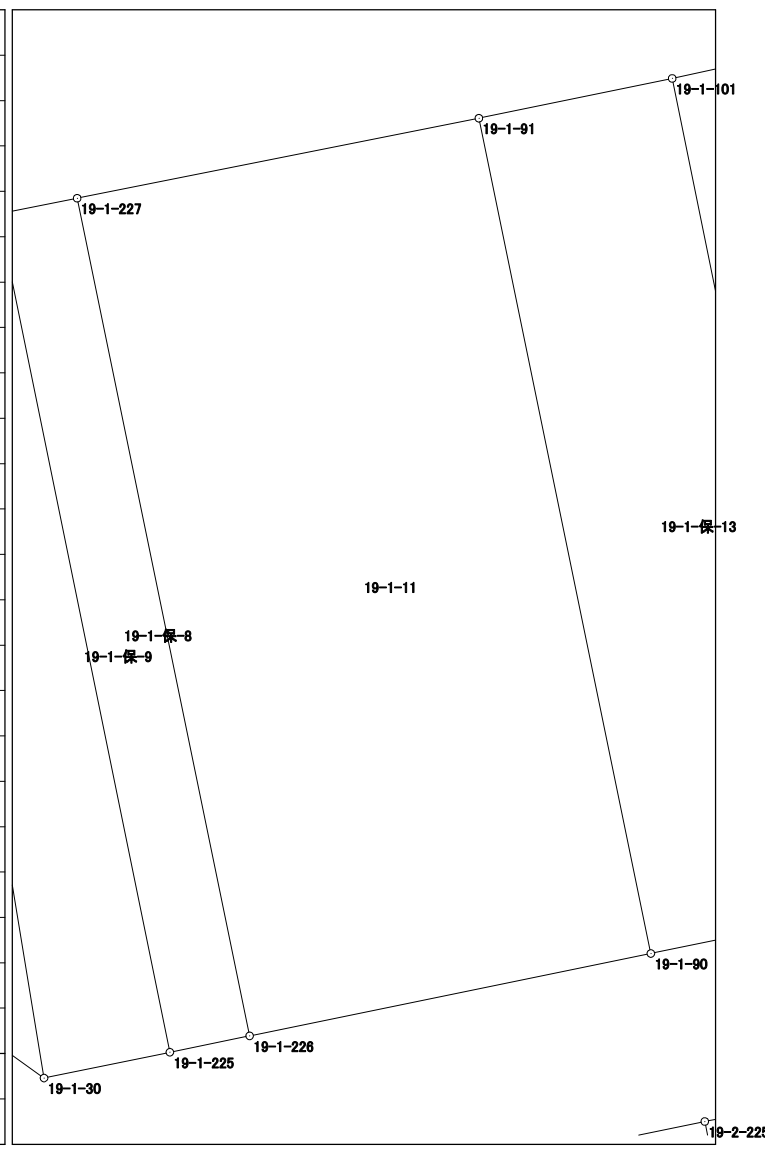

# 面積計算書（座標法）

所在	地番	公簿地目	現況地目	地積	所有者
前橋市六供町一丁目	19-1-保-1			40.00 m <sup>2</sup>	

点名	X座標	Y座標	辺長	方向角	測角	DX	倍積 (Y×DX)
19-1-111	41742.228	-68559.042	15.038	6-17-30	88-08-35	14.576	-999316.596192
19-1-106	41757.175	-68557.394	2.683	289-07-26	102-49-56	15.826	-1084989.317444
19-1-201	41758.054	-68559.929	15.549	186-17-30	77-10-04	-14.576	999329.525104
19-1-202	41742.599	-68561.633	2.617	98-08-55	91-51-25	-15.826	1085056.403858

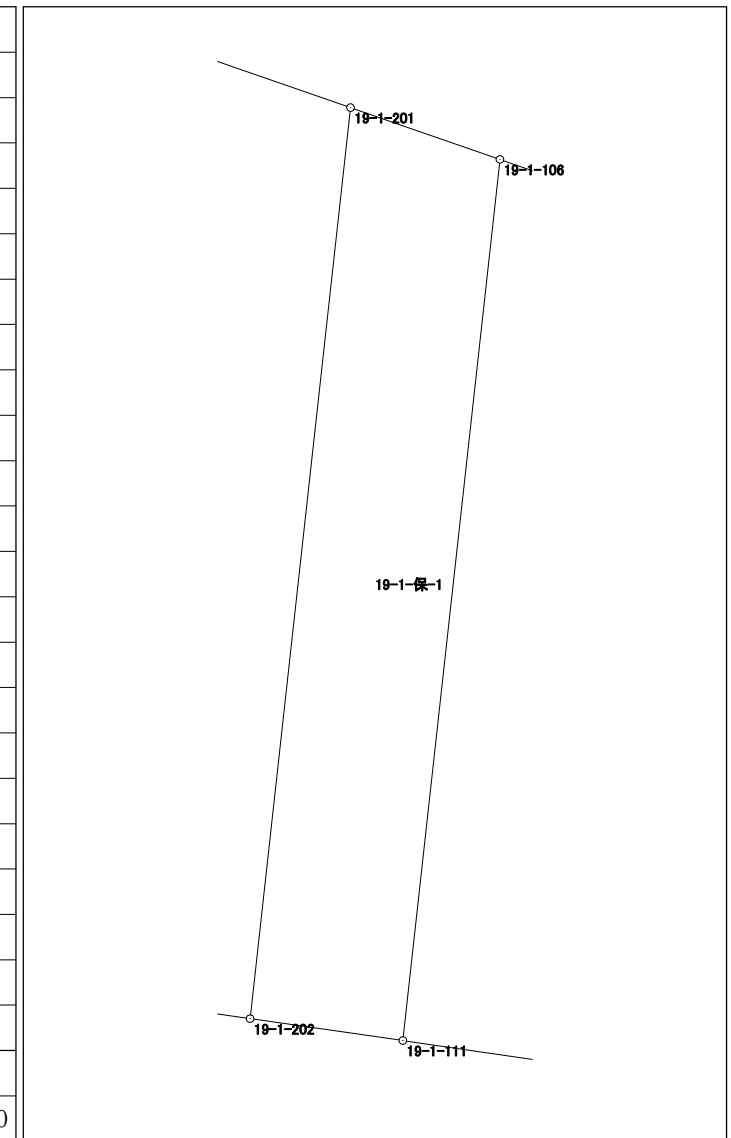

倍面積	80.015326
面積	40.0076630




# 面積計算書 (座標法)

世界測地系 (測地成果2011)

所在	地番	公簿地目	現況地目	地積	所有者
前橋市六供町一丁目	19-1-保-2			26.00 m <sup>2</sup>	

点名	X座標	Y座標	辺長	方向角	測角	DX	倍積 (Y×DX)
19-1-107	41724.691	-68577.557	1.646	186-54-33	97-45-10	-1.866	127965.721362
19-1-214	41723.057	-68577.755	16.132	89-09-30	82-14-57	-1.397	95803.123735
19-1-215	41723.294	-68561.625	1.639	353-47-56	84-38-26	1.866	-127935.992250
19-1-116	41724.923	-68561.802	15.757	269-09-23	95-21-27	1.397	-95780.837394
						倍面積	52.015453
						面積	26.007265

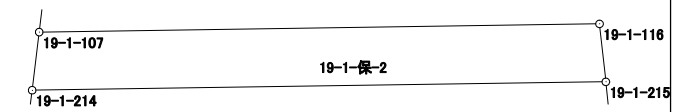


# 面積計算書 (座標法)

世界測地系 (測地成果2011)

所在	地番	公簿地目	現況地目	地積	所有者
前橋市六供町一丁目	19-1-保-3			45.00 m <sup>2</sup>	

点名	X座標	Y座標	辺長	方向角	測角	DX	倍積 (Y×DX)
19-1-45	41752.095	-68542.764	11.454	184-41-50	75-33-51	-10.021	686867.038044
19-1-222	41740.679	-68543.702	4.121	94-33-54	89-52-04	-11.744	804977.236288
19-1-223	41740.351	-68539.594	10.384	4-42-03	90-08-09	10.021	-686835.271474
19-1-224	41750.700	-68538.743	4.256	289-07-59	104-25-56	11.744	-804918.997792
						倍面積	90.005066
						面積	45.0025330

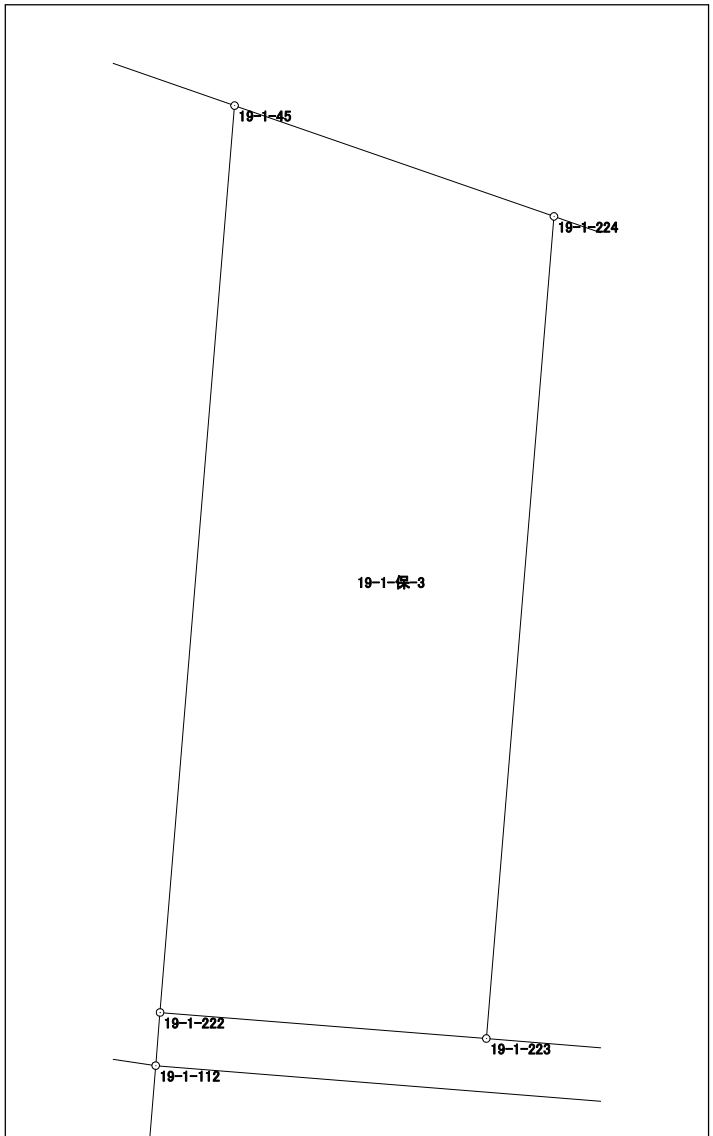

# 面積計算書（座標法）

世界測地系（測地成果2011）

所 在	地 番	公簿地目	現況地目	地 積	所 有 者
前橋市六供町一丁目	19-1-保-4			11.00 m <sup>2</sup>	


点 名	X 座標	Y 座標	辺 長	方 向 角	測 角	DX	倍 積 (Y×DX)	
19-1-112	41740.010	-68543.757	16.399	94-33-52	89-51-53	-1.974	135305.376318	
19-1-220	41738.705	-68527.410	0.671	4-41-59	90-08-07	-0.636	43583.432760	
19-1-221	41739.374	-68527.355	12.278	274-33-51	89-51-52	1.646	-112796.026330	
19-1-223	41740.351	-68539.594	4.121	274-33-54	180-00-03	1.305	-89444.170170	
19-1-222	41740.679	-68543.702	0.671	184-41-59	90-08-05	-0.341	23373.402382	
						倍面積	22.014960	
						面 積	11.0074800	

# 面積計算書 (座標法)

世界測地系 (測地成果2011)

所在	地番	公簿地目	現況地目	地積	所有者
前橋市六供町一丁目	19-1-保-5			52.00 m <sup>2</sup>	

点名	X座標	Y座標	辺長	方向角	測角	DX	倍積 (Y×DX)
19-1-216	41733.012	-68527.873	3.170	4-38-58	89-58-03	1.821	-124789.256733
19-1-218	41736.172	-68527.616	16.402	274-40-58	90-02-00	4.499	-308305.744384
19-1-219	41737.511	-68543.963	3.171	184-42-13	90-01-15	-1.821	124818.556623
19-1-217	41734.351	-68544.223	16.405	94-40-55	89-58-42	-4.499	308380.459277

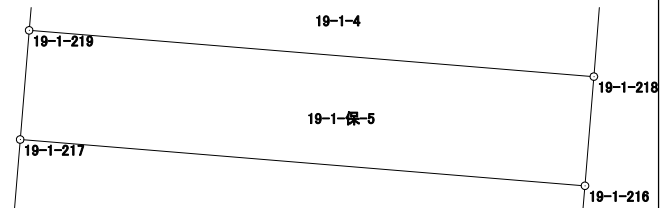


倍面積	104.014783
面積	52.0073915

# 面積計算書（座標法）

世界測地系（測地成果2011）

所在	地番	公簿地目	現況地目	地積	所有者
前橋市六供町一丁目	19-1-保-6			39.00 m <sup>2</sup>	

点名	X座標	Y座標	辺長	方向角	測角	DX	倍積 (Y×DX)
19-1-42	41711.185	-68546.089	1.079	184-47-09	106-24-38	-4.512	309279.953568
19-1-93	41710.110	-68546.179	1.265	168-30-45	163-43-36	-2.315	158684.404385
19-1-205	41708.870	-68545.927	16.697	78-22-23	89-51-38	2.125	-145660.094875
19-1-206	41712.235	-68529.573	2.395	4-34-30	106-12-07	5.752	-394182.103896
19-1-43	41714.622	-68529.382	17.057	258-22-31	73-48-01	-1.050	71955.851100

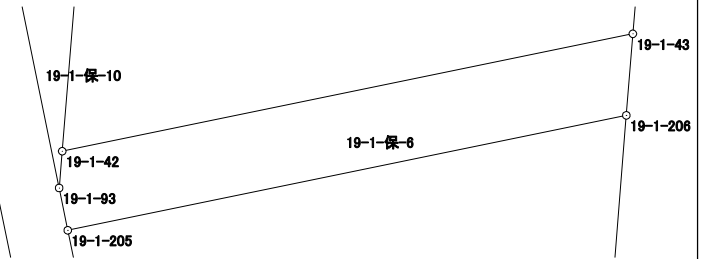


倍面積	78.010282
面積	39.0051410

# 面積計算書（座標法）

世界測地系（測地成果2011）

所 在	地 番	公簿地目	現況地目	地 積	所 有 者
前橋市六供町一丁目	19-1-保-8			36.00 m <sup>2</sup>	

点 名	X 座標	Y 座標	辺 長	方 向 角	測 角	DX	倍 積 (Y×DX)
19-1-225	41691.498	-68574.499	1.858	78-25-04	89-58-31	-18.757	1286251.877743
19-1-226	41691.871	-68572.679	19.516	348-21-53	89-56-49	19.488	-1336344.368352
19-1-227	41710.986	-68576.615	1.831	258-43-37	90-21-44	18.757	-1286291.567555
19-1-68	41710.628	-68578.411	19.526	168-26-33	89-42-56	-19.488	1336456.073568
倍面積							72.015404
面 積							36.0077020

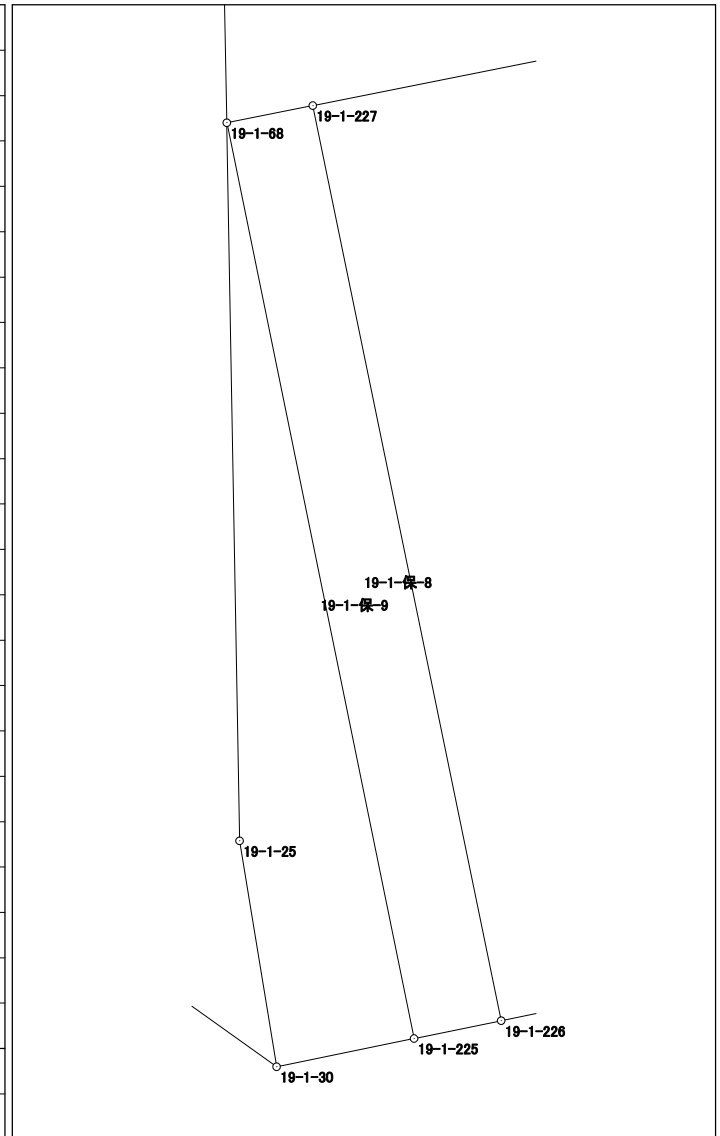


# 面積計算書（座標法）

世界測地系（測地成果2011）

所在	地番	公簿地目	現況地目	地積	所有者
前橋市六供町一丁目	19-1-保-9			33.80 m <sup>2</sup>	

点名	X座標	Y座標	辺長	方向角	測角	DX	倍積 (Y×DX)
19-1-68	41710.628	-68578.411	15.002	178-59-03	10-32-30	4.130	-283228.837430
19-1-25	41695.628	-68578.145	4.782	170-41-07	171-42-04	-19.719	1352292.441255
19-1-30	41690.909	-68577.371	2.932	78-24-37	87-43-30	-4.130	283224.542230
19-1-225	41691.498	-68574.499	19.526	348-26-33	90-01-56	19.719	-1352220.545781
						倍面積	67.600274
						面積	33.8001370

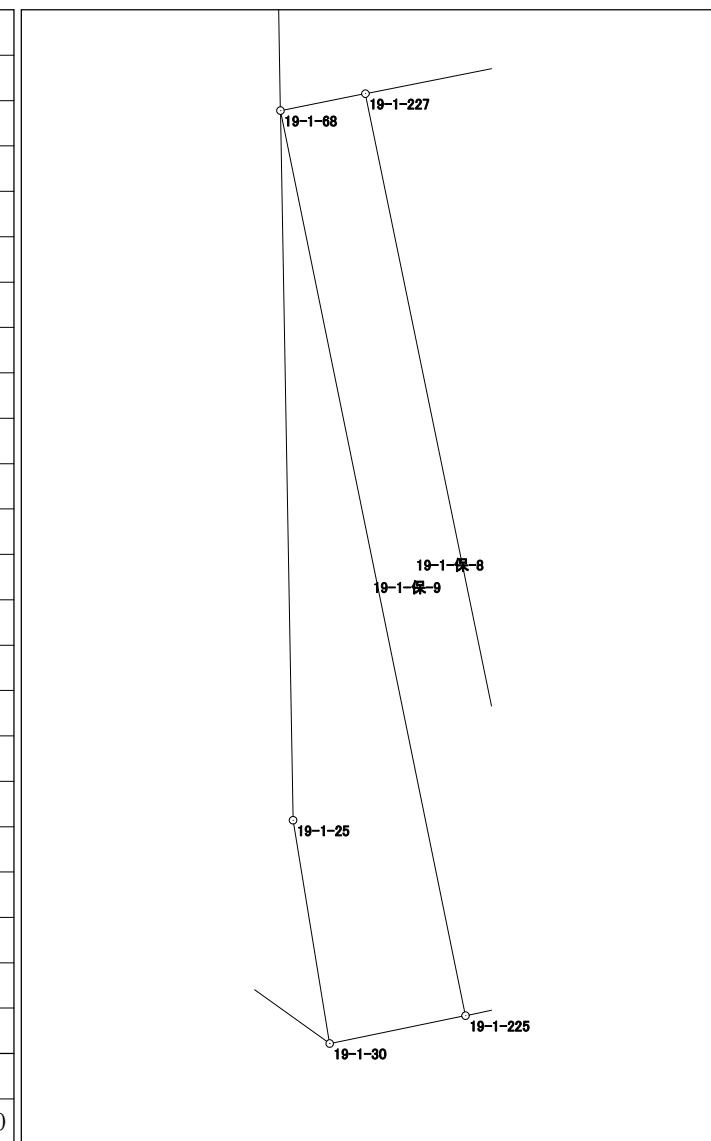


# 面積計算書 (座標法)

世界測地系 (測地成果2011)

所在	地番	公簿地目	現況地目	地積	所有者
前橋市六供町一丁目	19-1-保-10			7.01 m <sup>2</sup>	

点名	X座標	Y座標	辺長	方向角	測角	DX	倍積 (Y×DX)
19-1-93	41710.110	-68546.179	1.079	4-47-09	16-22-11	-5.716	391809.959164
19-1-42	41711.185	-68546.089	6.139	4-39-10	179-52-01	7.194	-493120.564266
19-1-69	41717.304	-68545.591	2.021	258-29-44	73-50-34	5.716	-391806.598156
19-1-207	41716.901	-68547.571	6.932	168-24-58	89-55-14	-7.194	493131.225774
倍面積							14.022516
面積							7.0112580

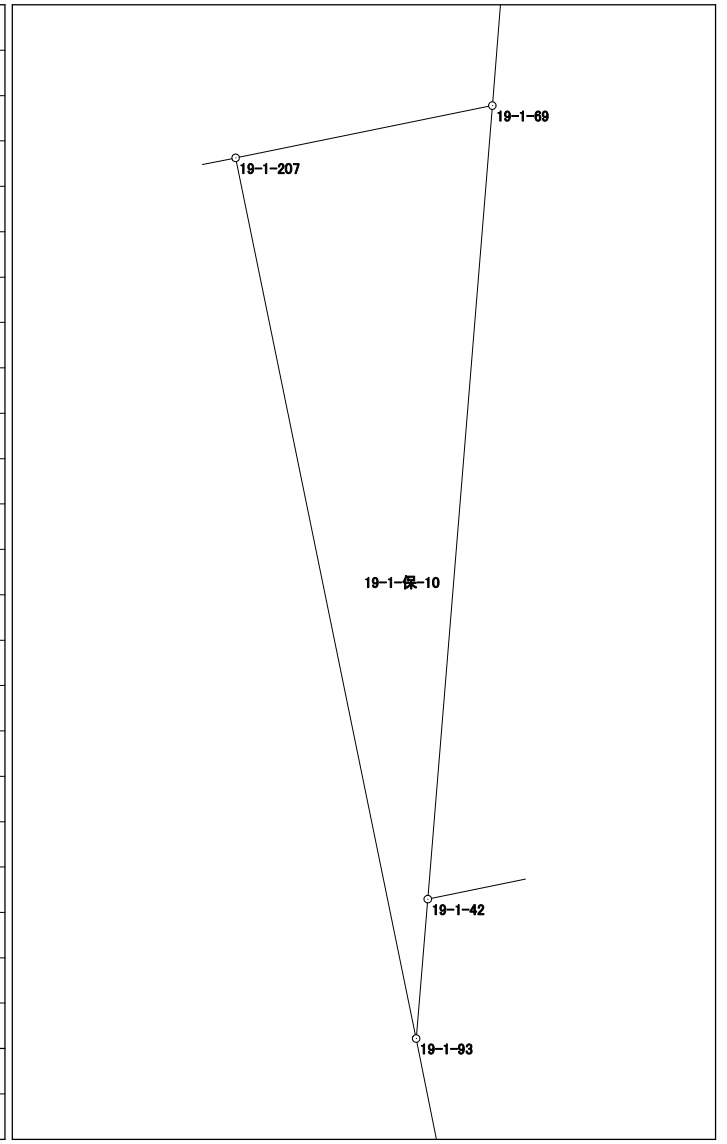




# 面積計算書（座標法）

世界測地系（測地成果2011）

所 在	地 番	公簿地目	現況地目	地 積	所 有 者
前橋市六供町一丁目	19-1-保-11			35.00 m <sup>2</sup>	

点 名	X 座標	Y 座標	辺 長	方 向 角	測 角	DX	倍 積 (Y×DX)
19-1-93	41710.110	-68546.179	6.932	348-24-58	179-54-13	8.031	-550494.363549
19-1-207	41716.901	-68547.571	1.793	258-29-00	90-04-02	6.433	-440966.524243
19-1-208	41716.543	-68549.328	19.485	168-28-30	89-59-30	-19.450	1333284.429600
19-1-209	41697.451	-68545.435	1.792	78-26-44	89-58-14	-18.733	1284061.633855
19-1-92	41697.810	-68543.679	11.286	348-30-39	90-03-55	11.419	-782700.270501
19-1-205	41708.870	-68545.927	1.265	348-30-45	180-00-06	12.300	-843114.902100
						倍面積	70.003062
						面積	35.0015310

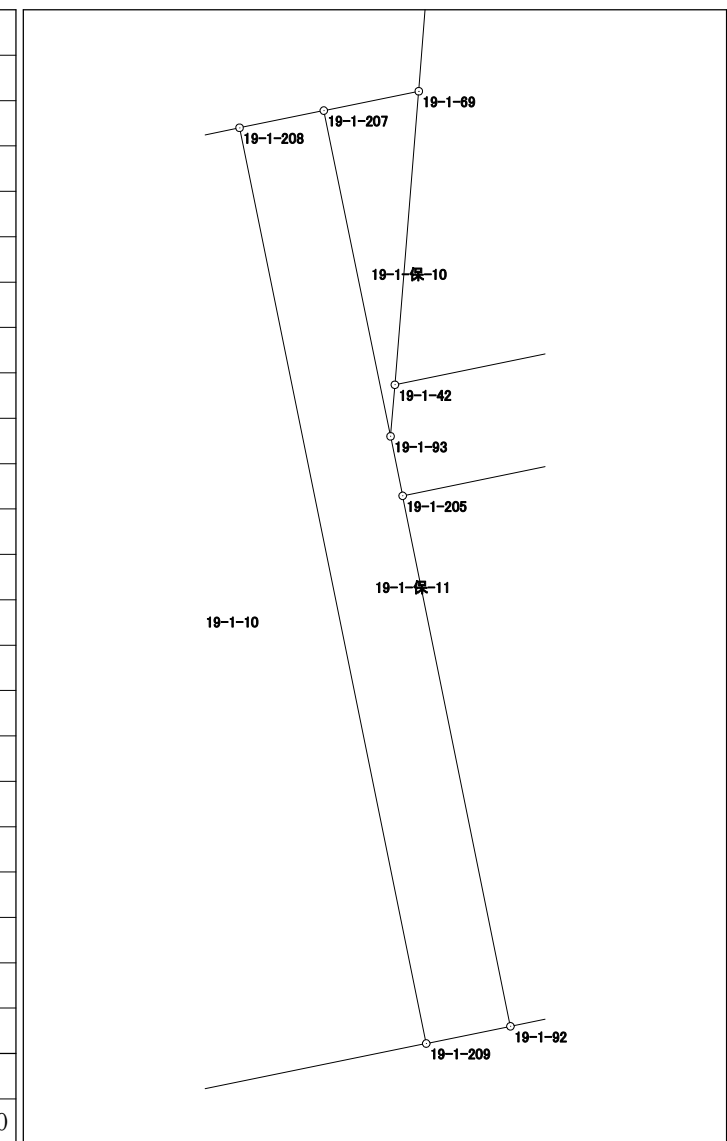


# 面積計算書（座標法）

世界測地系（測地成果2011）

所在	地番	公簿地目	現況地目	地積	所有者
前橋市六供町一丁目	19-1-保-12			38.00 m <sup>2</sup>	

点名	X座標	Y座標	辺長	方向角	測角	DX	倍積 (Y×DX)
19-1-211	41696.368	-68550.740	19.488	348-28-36	90-00-41	19.485	-1335711.168900
19-1-210	41715.463	-68554.633	1.950	258-29-39	90-01-03	18.706	-1282382.964898
19-1-212	41715.074	-68556.544	19.489	168-28-38	89-58-59	-19.485	1335824.259840
19-1-213	41695.978	-68552.651	1.950	78-27-55	89-59-17	-18.706	1282345.889606
						倍面積	76.015648
						面積	38.0078240

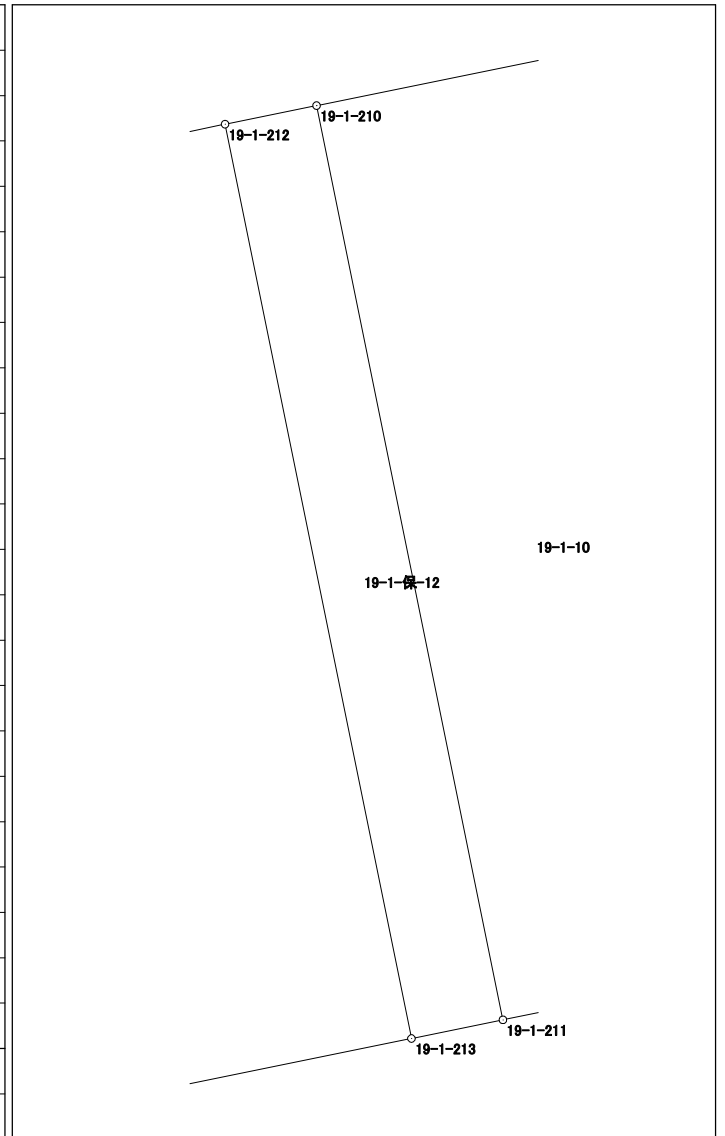

# 面積計算書（座標法）

世界測地系（測地成果2011）

所 在	地 番	公簿地目	現況地目	地 積	所 有 者
前橋市六供町一丁目	19-1-保-13			87.35 m <sup>2</sup>	

点 名	X 座 標	Y 座 標	辺 長	方 向 角	測 角	DX	倍 積 (Y×DX)
19-1-91	41712.812	-68567.446	19.461	168-21-52	90-00-13	-19.970	1369291.896620
19-1-90	41693.751	-68563.521	4.472	78-22-33	90-00-41	-18.160	1245113.541360
19-1-102	41694.652	-68559.141	19.462	348-27-52	90-05-19	19.970	-1369126.045770
19-1-101	41713.721	-68563.033	4.506	258-21-39	89-53-47	18.160	-1245104.679280

倍面積	174.712930
面 積	87.3564650

