



1-1街区 (2167.95㎡)  
 1-2街区 (856.57㎡)  
**画地出来形確認図**

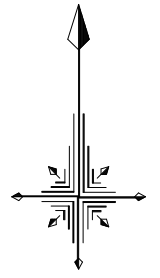


S=1/500

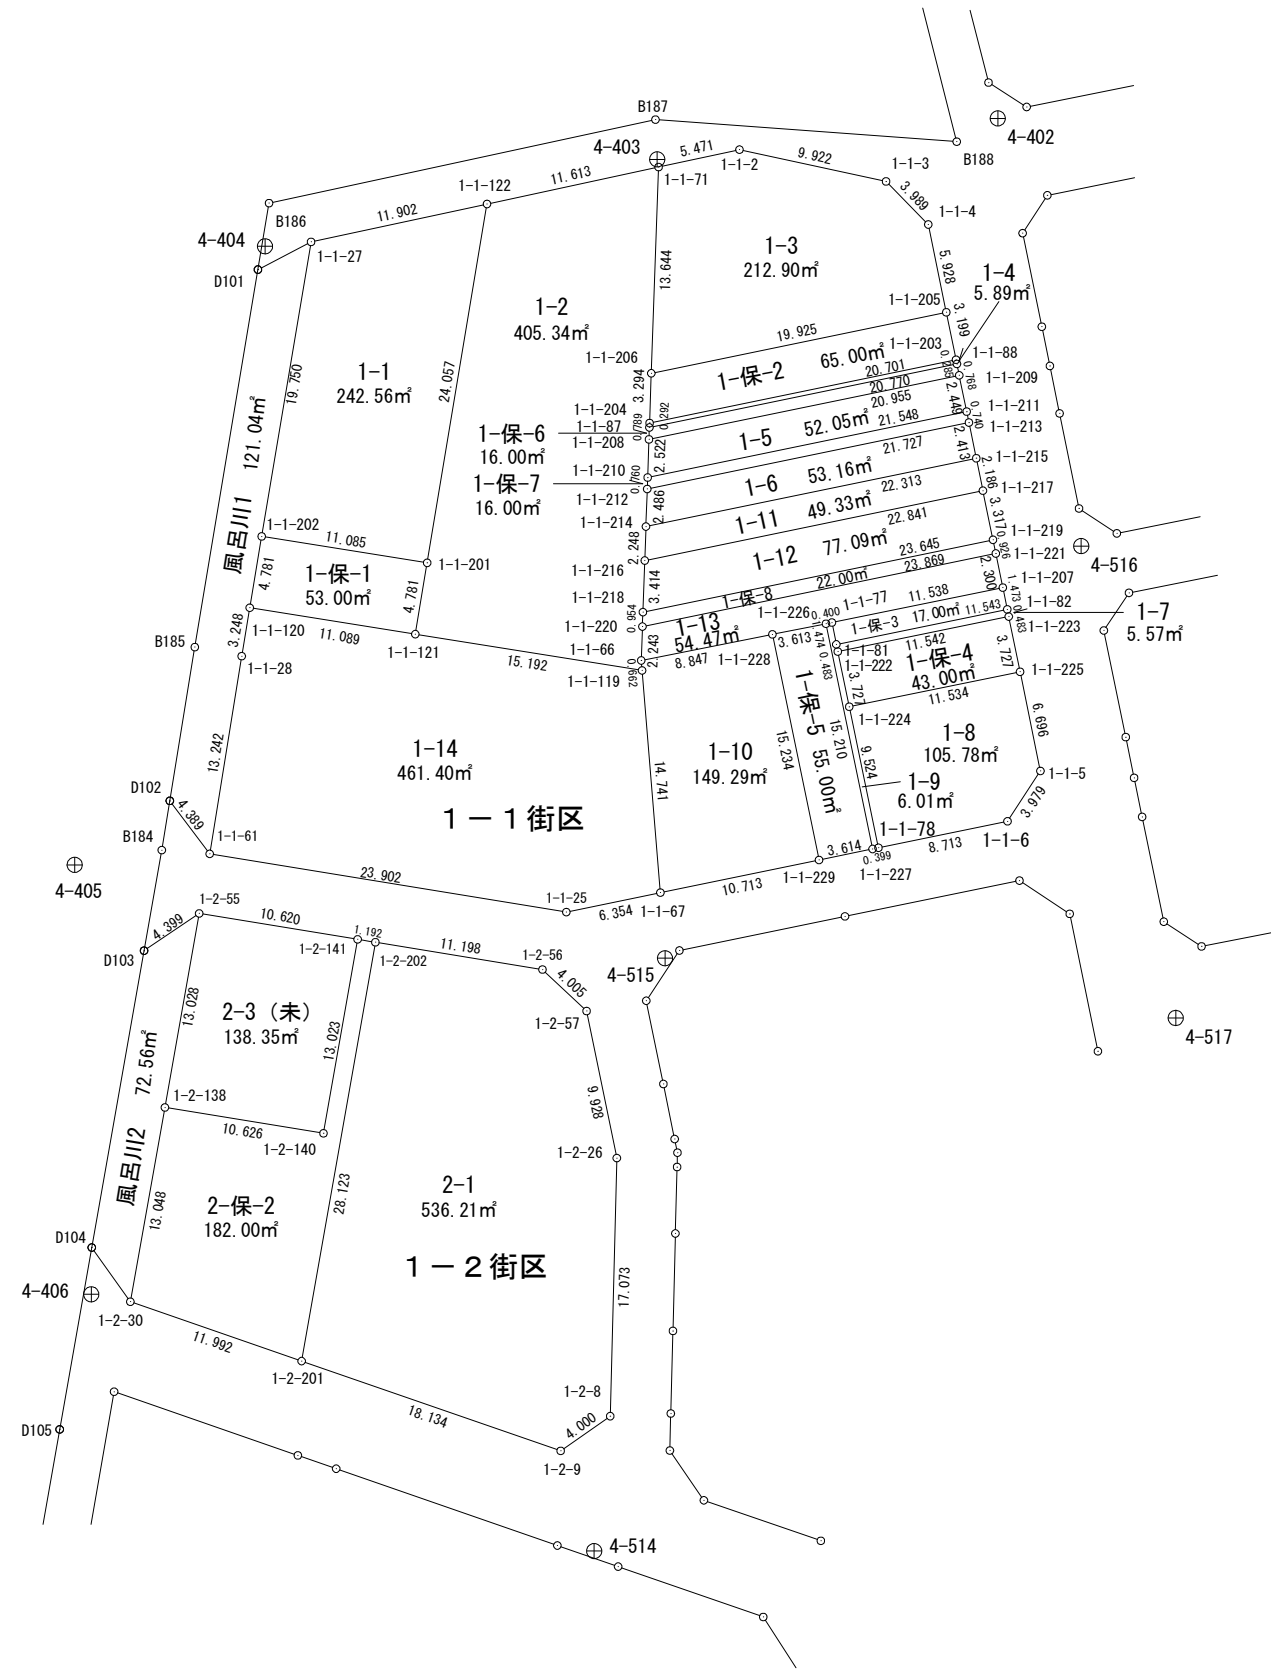

# 面積計算書 (座標法)

所在	地番	公簿地目	現況地目	地積	所有者
前橋市六供町一丁目	1-2-1			536.21 m <sup>2</sup>	

点名	X座標	Y座標	辺長	方向角	測角	DX	倍積 (Y×DX)
1-2-201	41764.291	-68559.678	18.134	109-06-27	99-07-01	-33.633	2305867.650174
1-2-9	41758.355	-68542.543	4.000	55-01-07	125-54-40	-3.643	249700.484149
1-2-8	41760.648	-68539.266	17.073	1-27-36	126-26-29	19.360	-1326920.189760
1-2-26	41777.715	-68538.831	9.928	348-23-25	166-55-49	26.792	-1836292.360152
1-2-57	41787.440	-68540.829	4.005	313-13-46	144-50-21	12.468	-854567.055972
1-2-56	41790.183	-68543.747	11.198	279-16-32	146-02-46	4.548	-311736.961356
1-2-202	41791.988	-68554.799	28.123	189-59-26	90-42-54	-25.892	1775020.855708

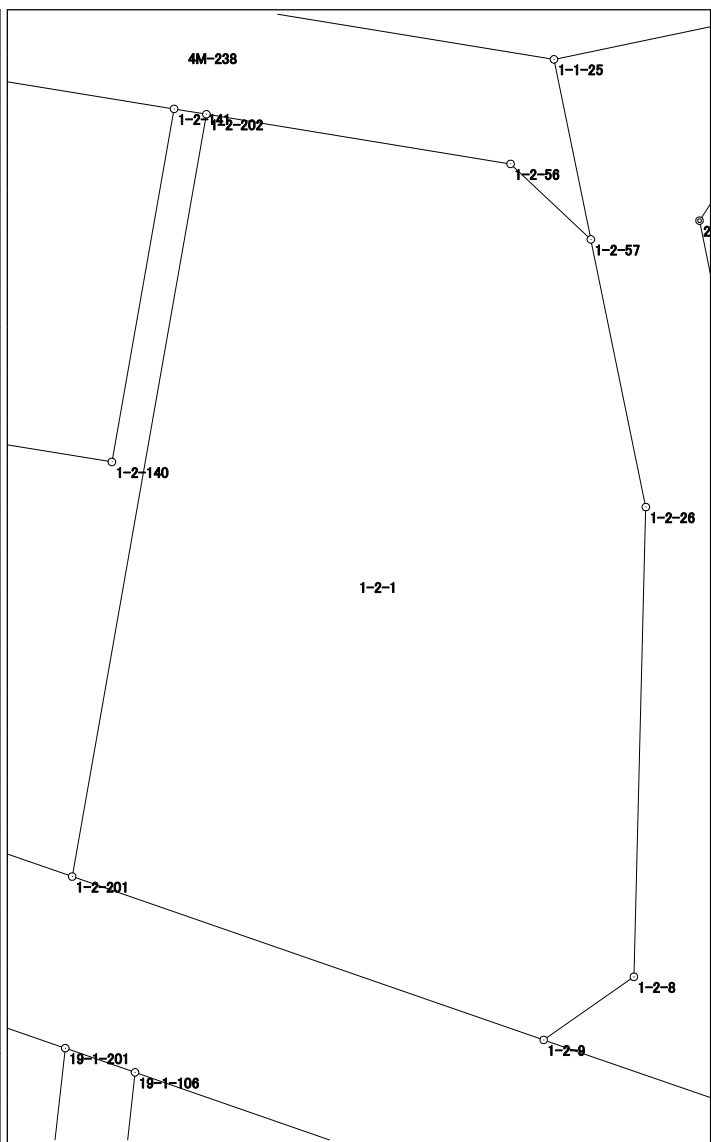

倍面積	1072.422791
面積	536.2113955



# 面積計算書 (座標法)

所在	地番	公簿地目	現況地目	地積	所有者
前橋市六供町一丁目	1-2-保-2			182.00 m <sup>2</sup>	

点名	X座標	Y座標	辺長	方向角	測角	DX	倍積 (Y×DX)
1-2-30	41768.217	-68571.009	11.992	109-06-37	99-00-56	-16.772	1150072.962948
1-2-201	41764.291	-68559.678	28.123	9-59-26	80-52-49	23.771	-1629732.105738
1-2-202	41791.988	-68554.799	1.192	279-16-21	89-16-55	27.889	-1911924.789311
1-2-141	41792.180	-68555.975	13.023	189-59-20	90-42-59	-12.634	866136.188150
1-2-140	41779.354	-68558.234	10.626	279-15-18	269-15-58	-11.117	762161.887378
1-2-138	41781.063	-68568.722	13.048	190-05-41	90-50-23	-11.137	763649.856914
倍面積							364.000341
面積							182.0001705

