



201街区 画地出来形確認図 (1678.79m²)

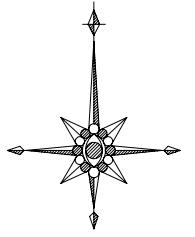

S=1:250

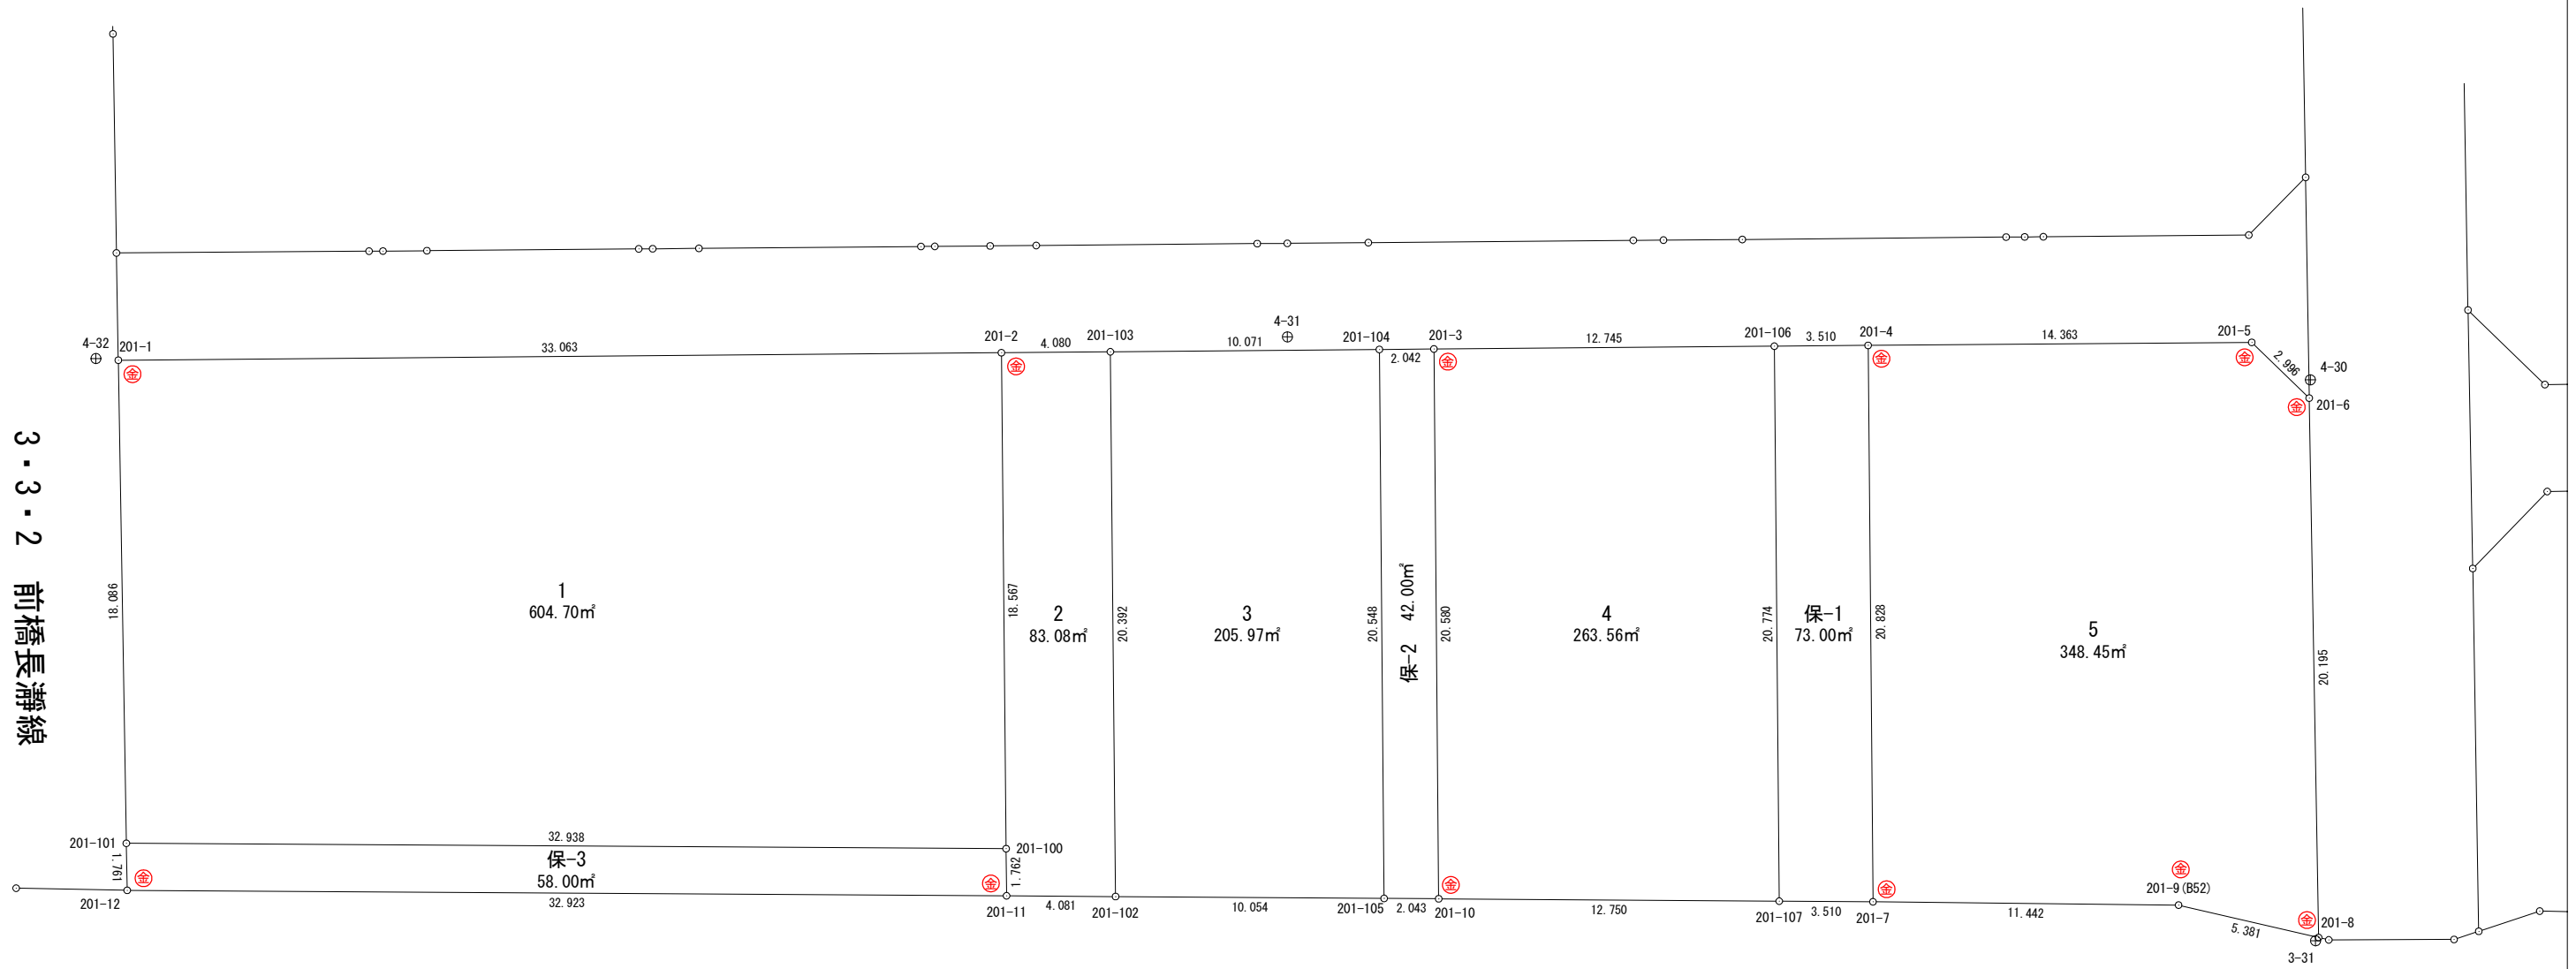


凡	例
事項	記号
金属プレート	⊕
コンクリート杭	⊖
金属鉄	⊗
合成樹脂杭	⊙
マーキング	⊚

面積計算書（座標法）

世界測地系（測地成果2011）

所在	地番	公簿地目	現況地目	地積	所有者
前橋市六供町三丁目	201-1			604.70 m ²	

点名	X座標	Y座標	辺長	方向角	測角	DX	倍積 (Y×DX)
201-100	40466.751	-68240.265	18.567	359-27-25	89-06-14	18.363	-1253095.986195
201-2	40485.317	-68240.441	33.063	269-30-53	90-03-28	18.286	-1247844.704126
201-1	40485.037	-68273.503	18.086	179-02-47	89-31-54	-18.363	1253706.335589
201-101	40466.954	-68273.202	32.938	90-21-11	91-18-24	-18.286	1248443.771772

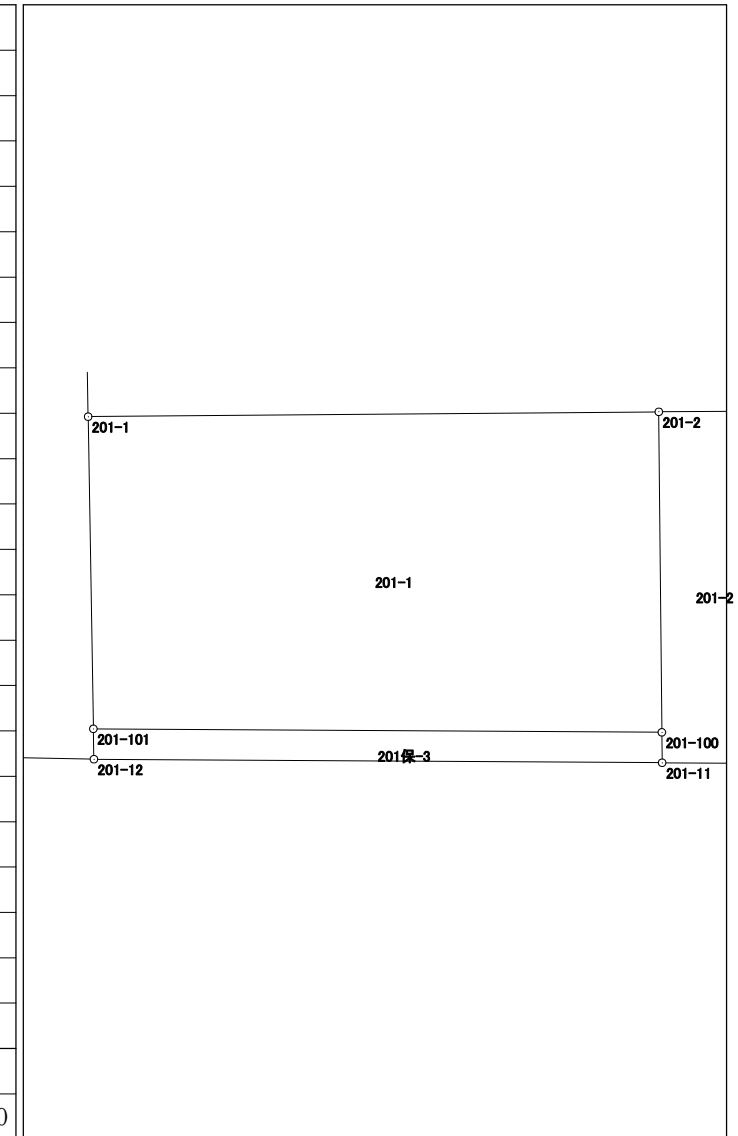


倍面積	1209.417040
面積	604.7085200

面積計算書 (座標法)

世界測地系 (測地成果2011)

所在	地番	公簿地目	現況地目	地積	所有者
前橋市六供町三丁目	201-2			83.08 m ²	

点名	X座標	Y座標	辺長	方向角	測角	DX	倍積 (Y×DX)
201-100	40466.751	-68240.265	1.762	179-26-50	179-59-25	-20.328	1387188.106920
201-11	40464.989	-68240.248	4.081	90-23-35	90-56-45	-1.790	122150.043920
201-102	40464.961	-68236.167	20.392	359-27-18	89-03-43	20.363	-1389493.068621
201-103	40485.352	-68236.361	4.080	269-30-31	90-03-13	20.356	-1389019.364516
201-2	40485.317	-68240.441	18.567	179-27-25	89-56-54	-18.601	1269340.443041
						倍面積	166.160744
						面積	83.0803720

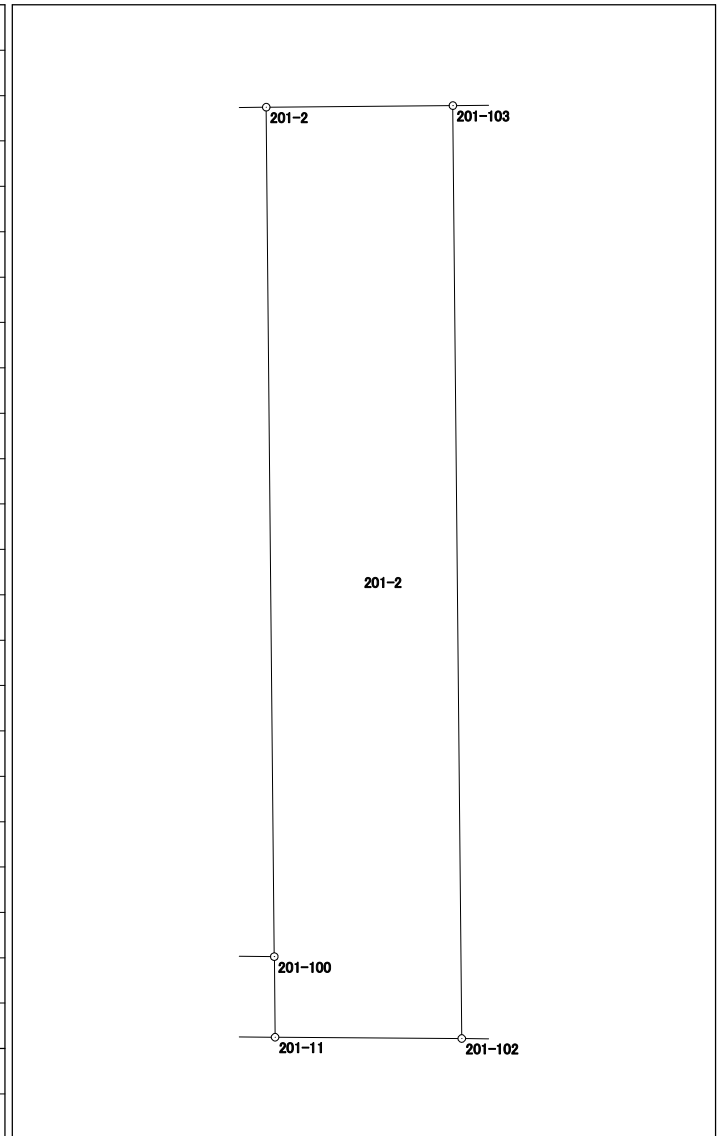


面積計算書 (座標法)

世界測地系 (測地成果2011)

所 在	地 番	公簿地目	現況地目	地 積	所 有 者
前橋市六供町三丁目	201-3			205.97 m ²	

点 名	X 座標	Y 座標	辺 長	方 向 角	測 角	DX	倍 積 (Y×DX)
201-104	40485.438	-68226.290	10.071	269-30-39	90-00-16	20.461	-1395978.119690
201-103	40485.352	-68236.361	20.392	179-27-18	89-56-39	-20.477	1397275.964197
201-102	40464.961	-68236.167	10.054	90-23-56	90-56-38	-20.461	1396180.212987
201-105	40464.891	-68226.113	20.548	359-30-23	89-06-27	20.477	-1397066.115901

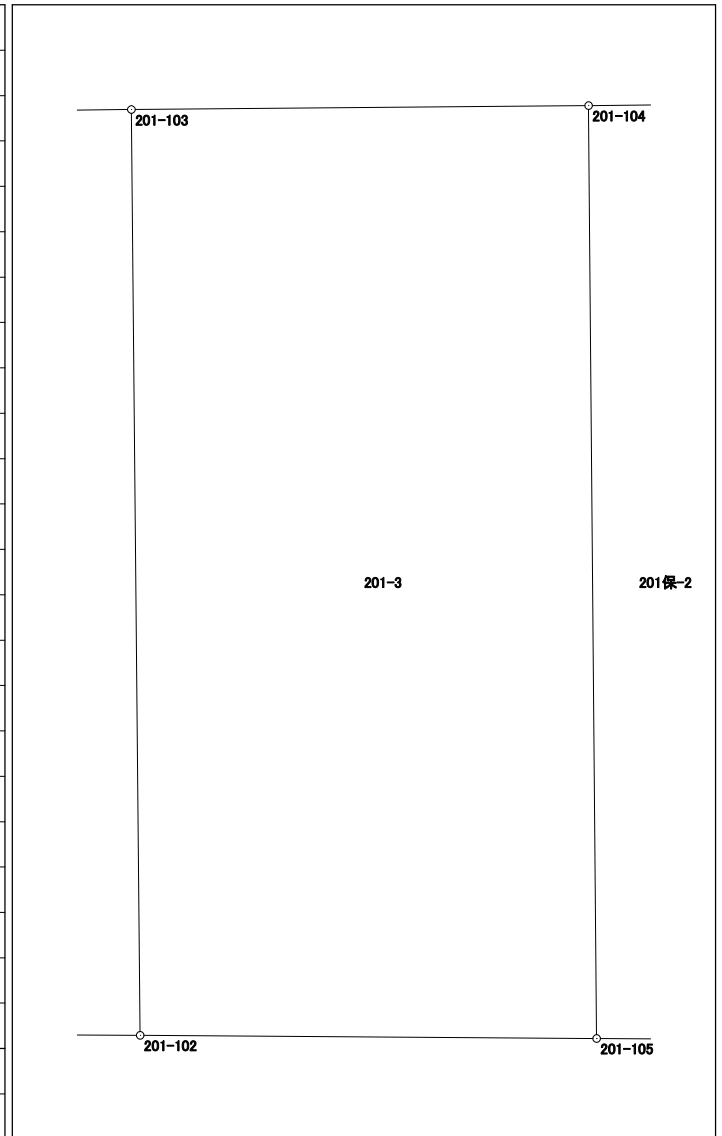

倍面積	411.941593
面積	205.9707965

面積計算書（座標法）

世界測地系（測地成果2011）

所在	地番	公簿地目	現況地目	地積	所有者
前橋市六供町三丁目	201-4			263.56 m ²	


点名	X座標	Y座標	辺長	方向角	測角	DX	倍積 (Y×DX)
201-106	40485.561	-68211.503	12.745	269-31-41	90-01-58	20.668	-1409795.344004
201-3	40485.456	-68224.248	20.580	179-30-16	89-58-35	-20.684	1411150.345632
201-10	40464.877	-68224.070	12.750	90-24-00	90-53-44	-20.668	1410055.078760
201-107	40464.788	-68211.320	20.774	359-29-43	89-05-43	20.684	-1410882.942880
						倍面積	527.137508
						面積	263.5687540

面積計算書 (座標法)

世界測地系 (測地成果2011)

所在	地番	公簿地目	現況地目	地積	所有者
前橋市六供町三丁目	201-5			348.45 m ²	

点名	X座標	Y座標	辺長	方向角	測角	DX	倍積 (Y×DX)
201-4	40485.591	-68207.993	20.828	179-29-48	89-56-51	-20.940	1428275.373420
201-7	40464.764	-68207.810	11.442	90-36-57	91-07-09	-20.950	1428953.619500
201-9(B52)	40464.641	-68196.369	5.381	103-02-22	192-25-25	-1.337	91178.545353
201-8	40463.427	-68191.127	20.195	359-00-05	75-57-43	18.978	-1294131.208206
201-6	40483.619	-68191.479	2.996	314-06-27	135-06-22	22.277	-1519101.577683
201-5	40485.704	-68193.630	14.363	269-32-57	135-26-30	1.972	-134477.838360

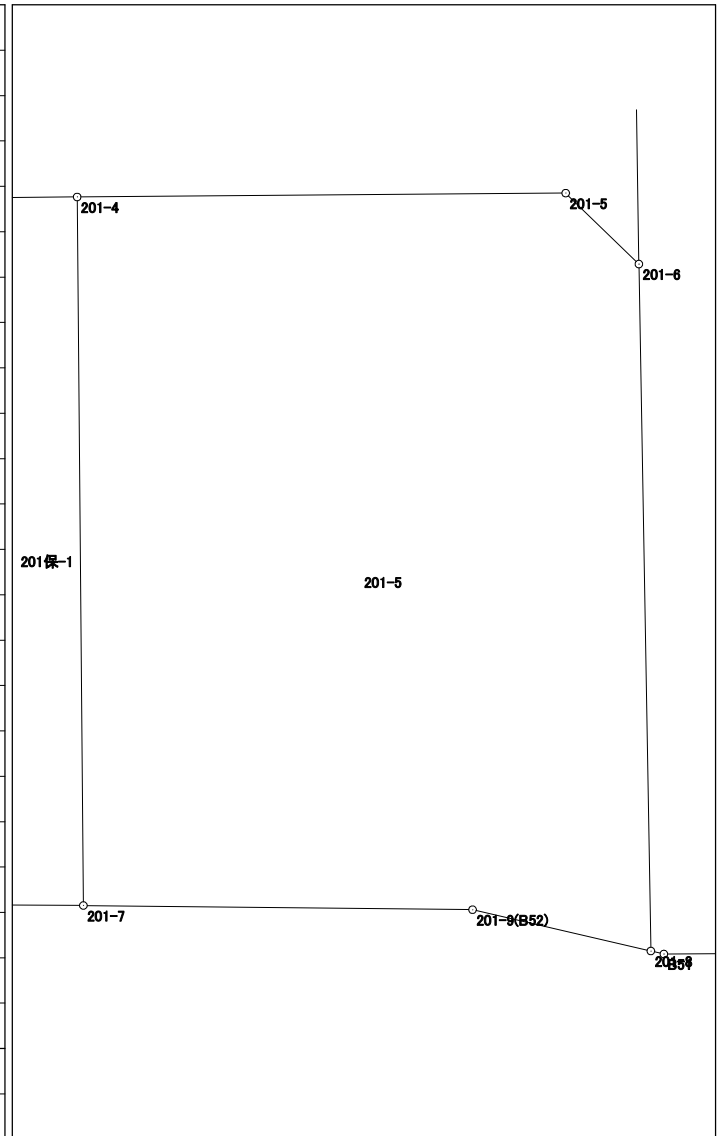

倍面積	696.914024
面積	348.4570120


面積計算書（座標法）

世界測地系（測地成果2011）

所 在	地 番	公簿地目	現況地目	地 積	所 有 者
前橋市六供町三丁目	201保-1			73.00 m ²	

点 名	X 座標	Y 座標	辺 長	方 向 角	測 角	DX	倍 積 (Y×DX)
201-7	40464.764	-68207.810	20.828	359-29-48	89-06-18	20.803	-1418927.071430
201-4	40485.591	-68207.993	3.510	269-30-37	90-00-49	20.797	-1418521.630421
201-106	40485.561	-68211.503	20.774	179-29-43	89-59-06	-20.803	1419003.896909
201-107	40464.788	-68211.320	3.510	90-23-30	90-53-47	-20.797	1418590.822040

倍面積	146.017098
面 積	73.0085490

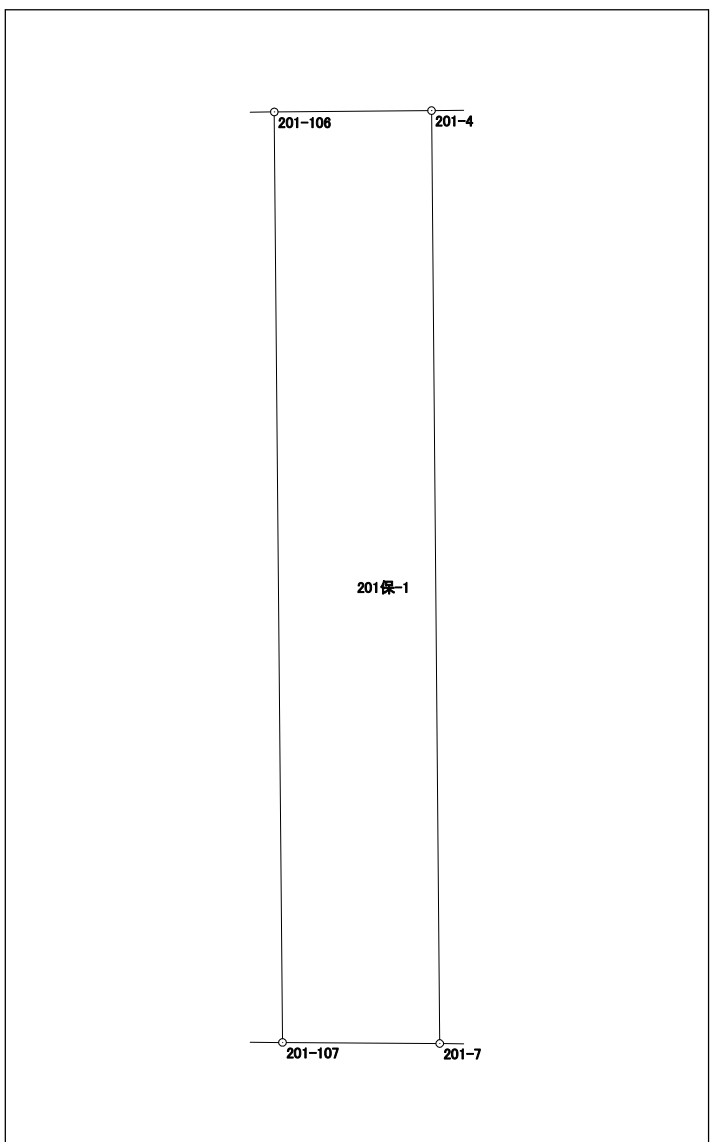


面積計算書（座標法）

世界測地系（測地成果2011）

所 在	地 番	公簿地目	現況地目	地 積	
前橋市六供町三丁目	201保-2			42.00 m ²	所 有 者

点 名	X 座標	Y 座標	辺 長	方 向 角	測 角	DX	倍 積 (Y×DX)
201-10	40464.877	-68224.070	20.580	359-30-16	89-06-43	20.565	-1403027.999550
201-3	40485.456	-68224.248	2.042	269-29-42	89-59-26	20.561	-1402758.763128
201-104	40485.438	-68226.290	20.548	179-30-23	90-00-41	-20.565	1403073.653850
201-105	40464.891	-68226.113	2.043	90-23-33	90-53-10	-20.561	1402797.109393

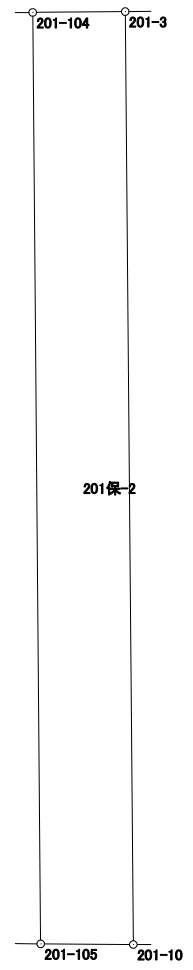

倍面積	84.000565
面 積	42.0002825

面積計算書（座標法）

世界測地系（測地成果2011）

所 在	地 番	公簿地目	現況地目	地 積	所 有 者
前橋市六供町三丁目	201保-3			58.00 m ²	

点 名	X 座標	Y 座標	辺 長	方 向 角	測 角	DX	倍 積 (Y×DX)		
201-12	40465.193	-68273.170	32.923	90-21-18	91-23-46	-1.965	134156.779050		
201-11	40464.989	-68240.248	1.762	359-26-50	89-05-32	1.558	-106318.306384		
201-100	40466.751	-68240.265	32.938	270-21-11	90-54-21	1.965	-134092.120725		
201-101	40466.954	-68273.202	1.761	178-57-32	88-36-21	-1.558	106369.648716		
							倍面積		116.000657
							面 積		58.0003285