



205街区 画地出来形確認図 (1491.09m²)

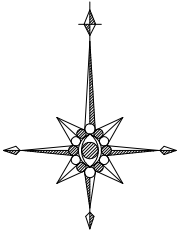

S=1:250

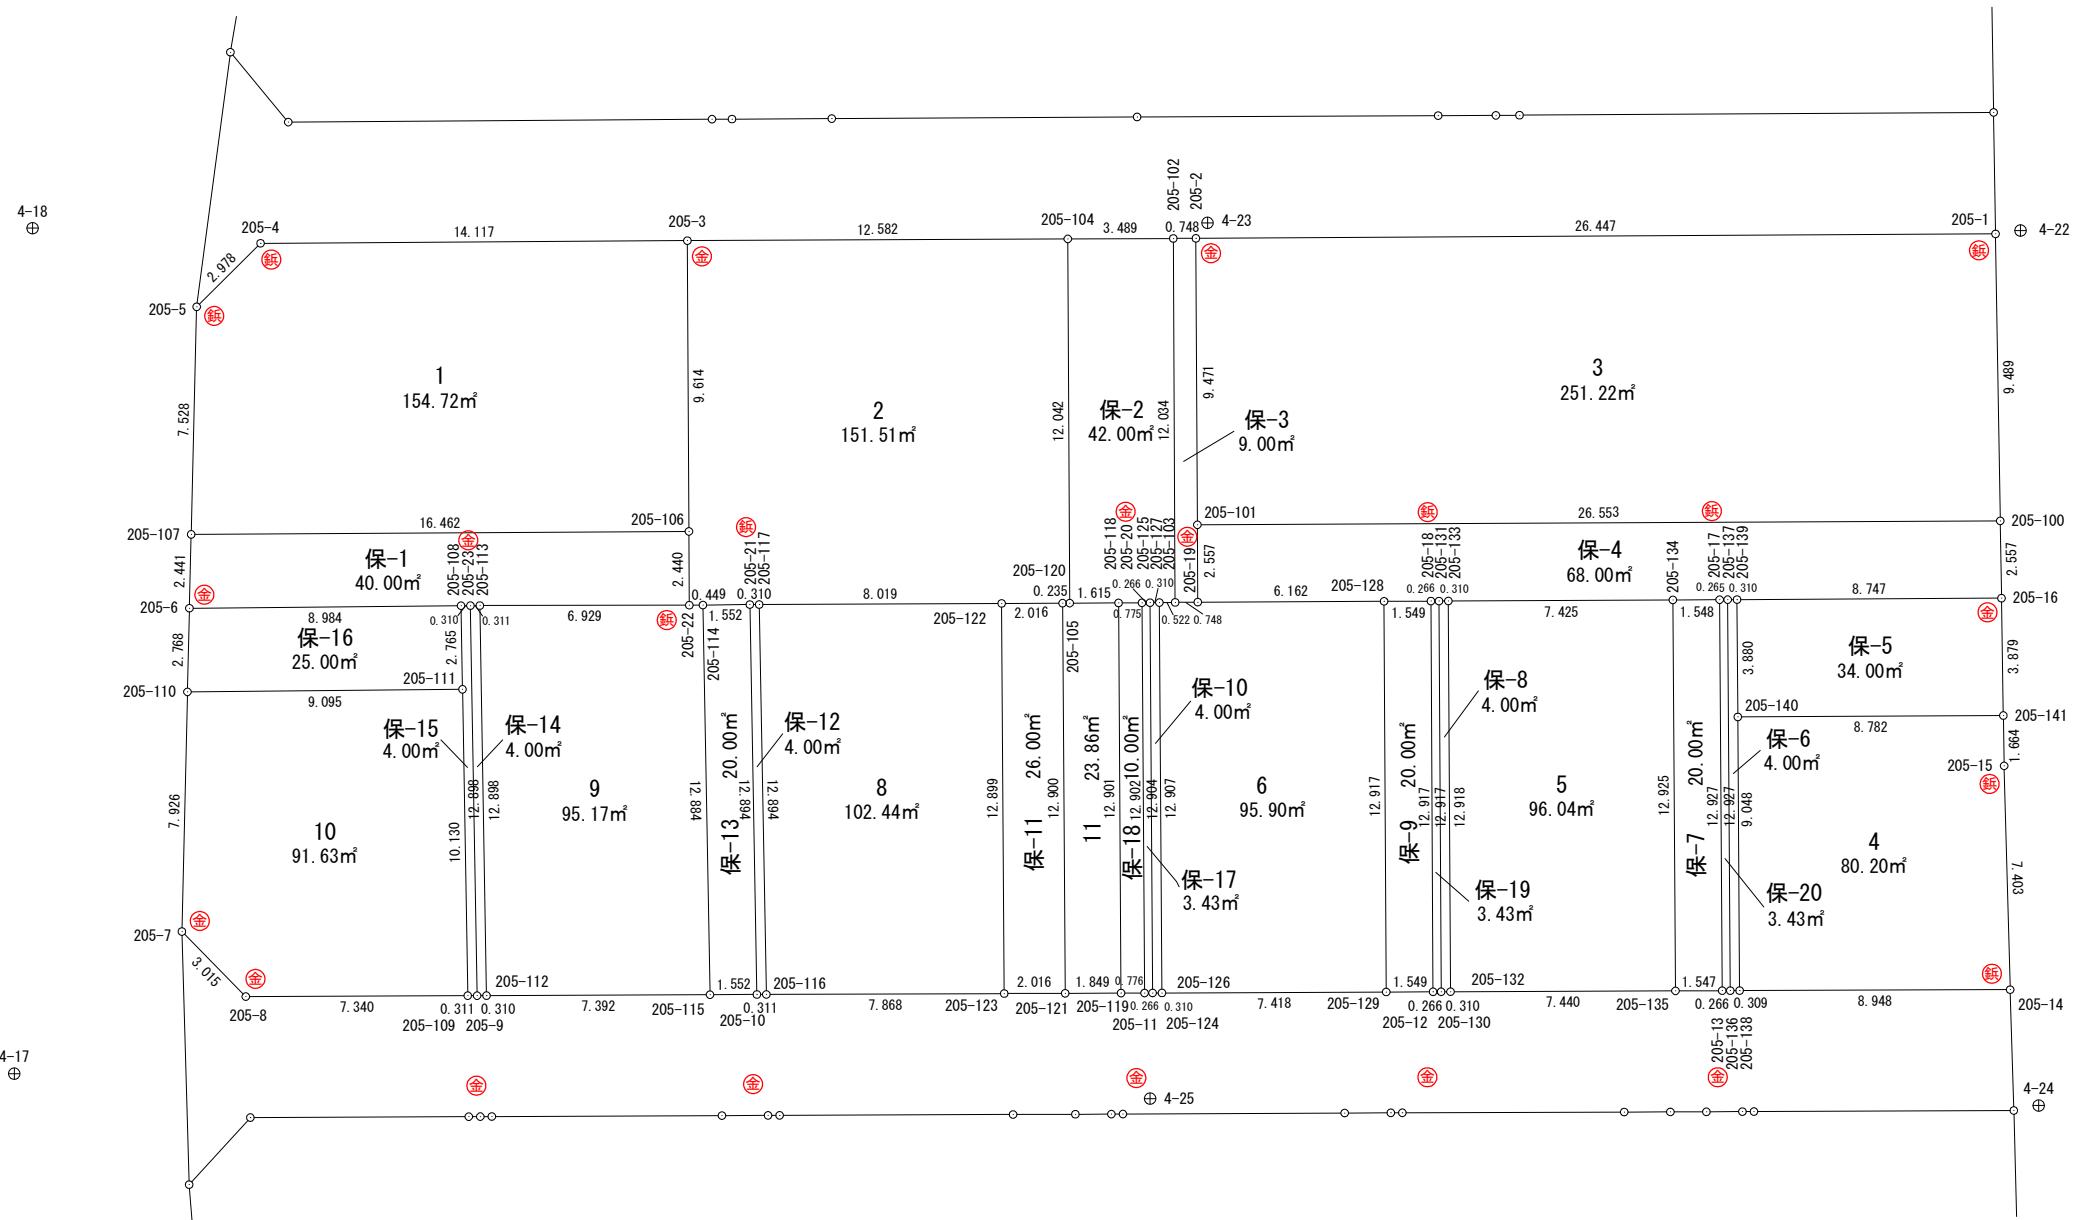

3・3・2 前橋長瀬線


凡	例
事項	記号
金属プレート	Ⓜ
コンクリート杭	Ⓜ
金属釘	Ⓜ
合成樹脂杭	Ⓜ
マーキング	Ⓜ

面積計算書 (座標法)

世界測地系 (測地成果2011)

所在	地番	公簿地目	現況地目	地積	所有者
前橋市六供町三丁目	205-1			154.72 m ²	

点名	X座標	Y座標	辺長	方向角	測角	DX	倍積 (Y×DX)
205-106	40562.549	-68343.693	9.614	359-41-46	90-02-26	9.713	-663822.290109
205-3	40572.163	-68343.744	14.117	269-38-34	89-56-48	9.526	-651042.505344
205-4	40572.075	-68357.861	2.978	225-10-37	135-32-03	-2.187	149498.642007
205-5	40569.976	-68359.973	7.528	181-23-07	136-12-30	-9.625	657964.740125
205-107	40562.450	-68360.155	16.462	89-39-20	88-16-13	-7.427	507710.871185

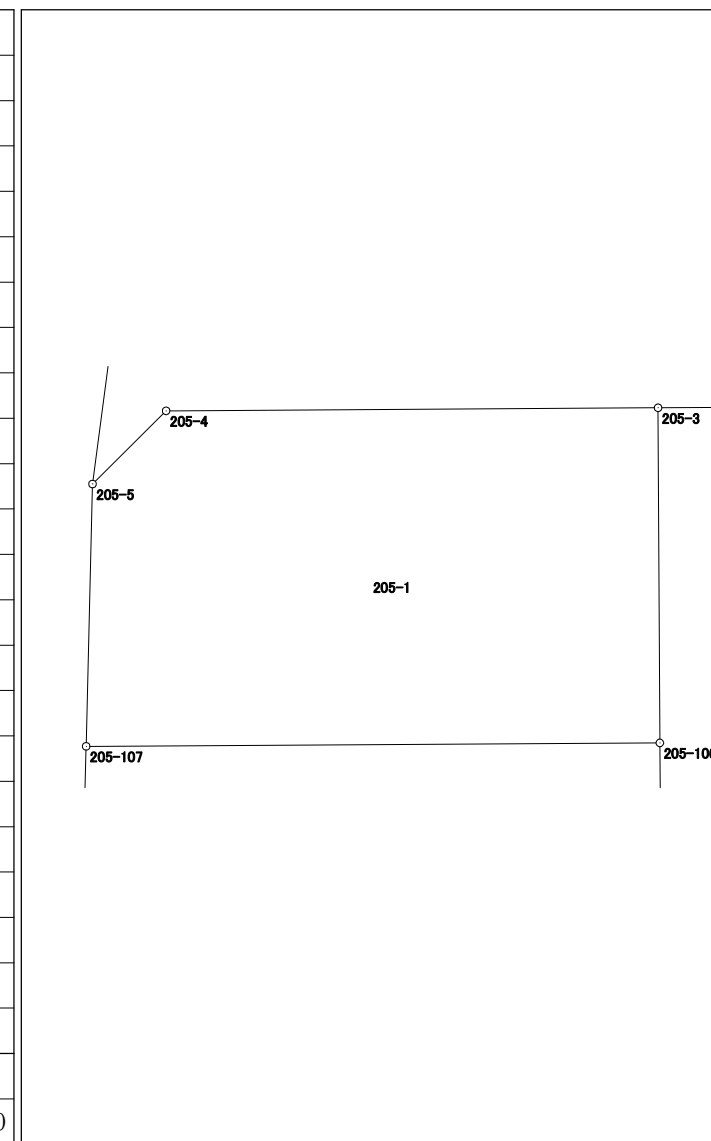


倍面積	309.457864
面積	154.7289320

面積計算書（座標法）

世界測地系（測地成果2011）

所 在	地 番	公簿地目	現況地目	地 積	所 有 者
前橋市六供町三丁目	205-3			251.22 m ²	

点 名	X 座標	Y 座標	辺 長	方 向 角	測 角	DX	倍 積 (Y×DX)
205-100	40562.898	-68300.323	9.489	359-03-51	89-20-41	9.618	-656912.506614
205-1	40572.386	-68300.478	26.447	269-40-54	90-37-03	9.341	-637994.764998
205-2	40572.239	-68326.925	9.471	179-42-13	90-01-19	-9.618	657168.364650
205-101	40562.768	-68326.876	26.553	89-43-10	90-00-57	-9.341	638241.348716

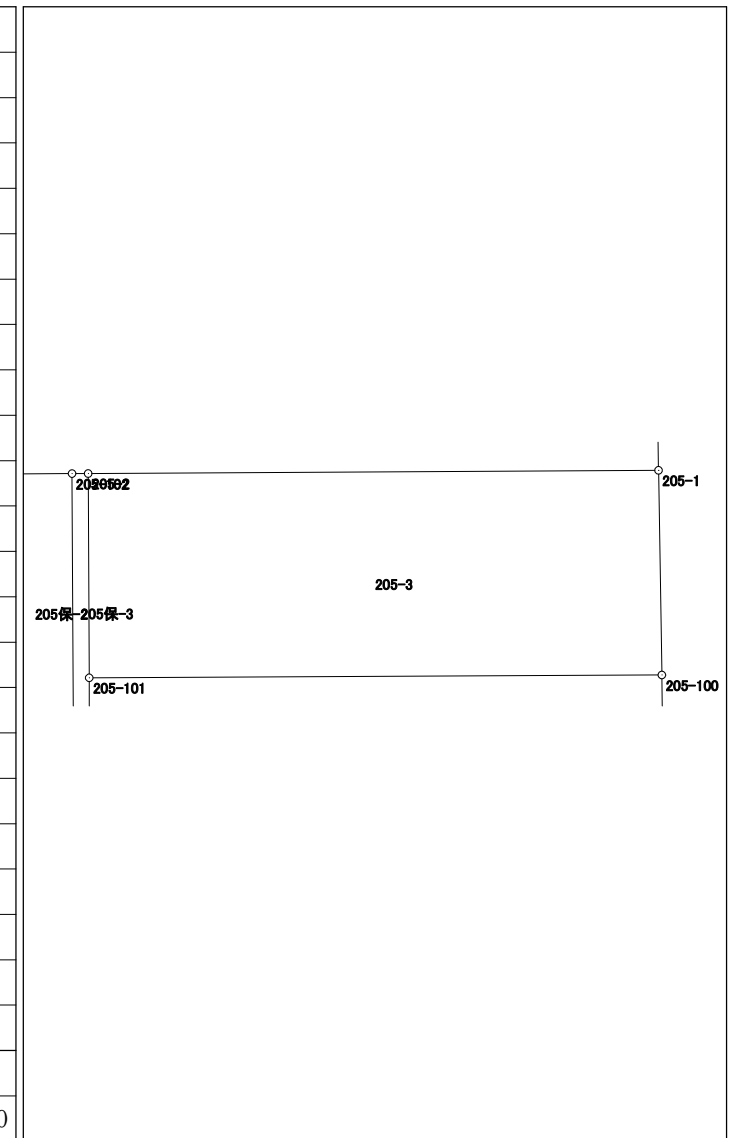


倍面積	502.441754
面積	251.2208770

面積計算書 (座標法)

世界測地系 (測地成果2011)

所在	地番	公簿地目	現況地目	地積	所有者
前橋市六供町三丁目	205-4			80.20 m ²	

点名	X座標	Y座標	辺長	方向角	測角	DX	倍積 (Y×DX)
205-140	40556.415	-68309.002	9.048	179-37-35	89-55-59	-9.095	621270.373190
205-138	40547.367	-68308.943	8.948	89-46-33	90-08-58	-9.013	615668.503259
205-14	40547.402	-68299.995	7.399	358-27-31	88-40-58	7.431	-507537.262845
205-15	40554.798	-68300.194	1.664	359-06-17	180-38-46	9.060	-618799.757640
205-141	40556.462	-68300.220	8.782	269-41-36	90-35-19	1.617	-110441.455740

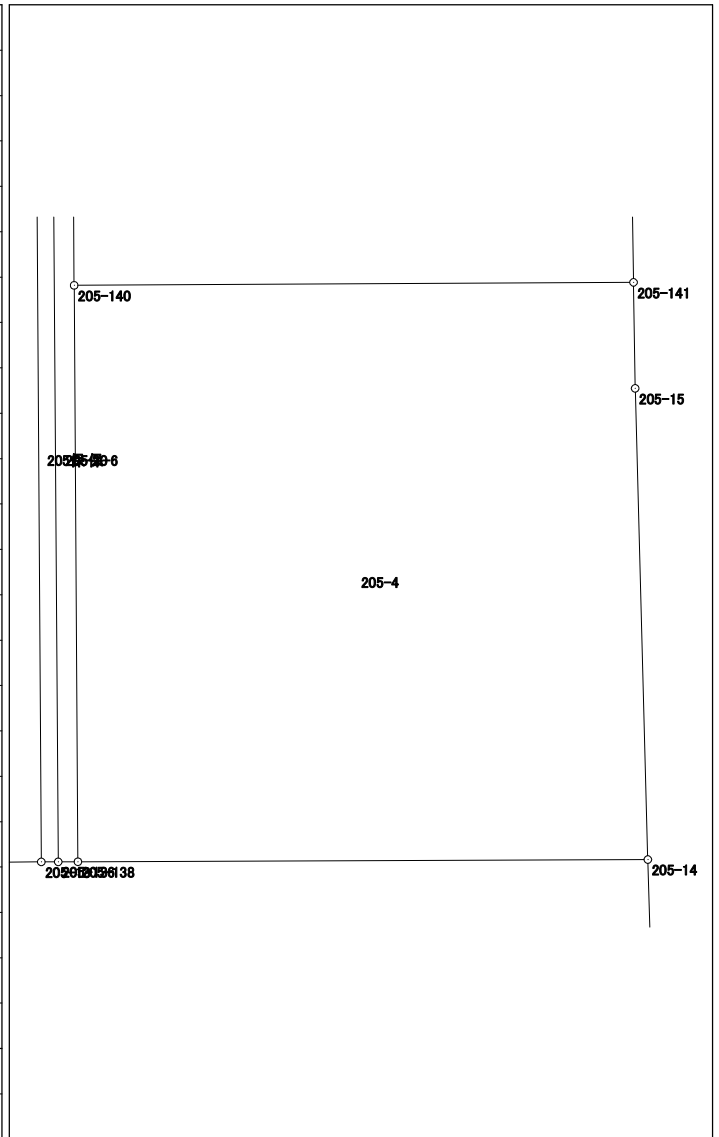


倍面積	160.400224
面積	80.2001120

面積計算書 (座標法)

世界測地系 (測地成果2011)

所 在	地 番	公簿地目	現況地目	地 積	所 有 者
前橋市六供町三丁目	205-5			96.04 m ²	

点 名	X 座標	Y 座標	辺 長	方 向 角	測 角	DX	倍 積 (Y×DX)
205-134	40560.284	-68311.151	7.425	269-43-20	90-06-12	12.889	-880462.425239
205-133	40560.248	-68318.576	12.918	179-41-06	89-57-46	-12.954	884998.833504
205-132	40547.330	-68318.505	7.440	89-46-36	90-05-30	-12.889	880557.210945
205-135	40547.359	-68311.065	12.925	359-37-08	89-50-32	12.954	-884901.536010
						倍面積	192.083200
						面 積	96.0416000

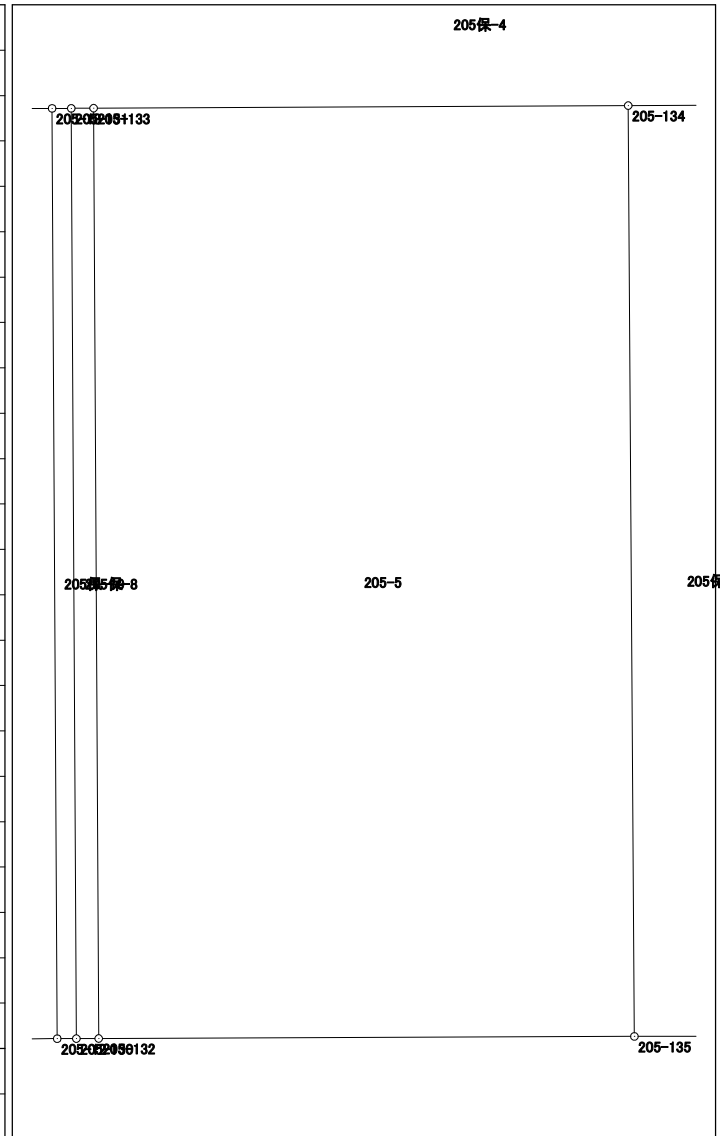


面積計算書（座標法）

世界測地系（測地成果2011）

所 在	地 番	公簿地目	現況地目	地 積	所 有 者
前橋市六供町三丁目	205-6			95.90 m ²	

点 名	X 座 標	Y 座 標	辺 長	方 向 角	測 角	DX	倍 積 (Y×DX)
205-128	40560.238	-68320.701	6.162	269-44-56	90-03-50	12.890	-880653.835890
205-19	40560.211	-68326.863	0.748	269-18-38	179-33-42	-0.036	2459.767068
205-103	40560.202	-68327.611	0.522	269-20-29	180-01-51	-0.015	1024.914165
205-127	40560.196	-68328.133	12.907	179-37-22	90-16-53	-12.913	882321.181429
205-126	40547.289	-68328.048	7.418	89-45-10	90-07-48	-12.875	879723.618000
205-129	40547.321	-68320.630	12.917	359-41-06	89-55-56	12.949	-884683.837870

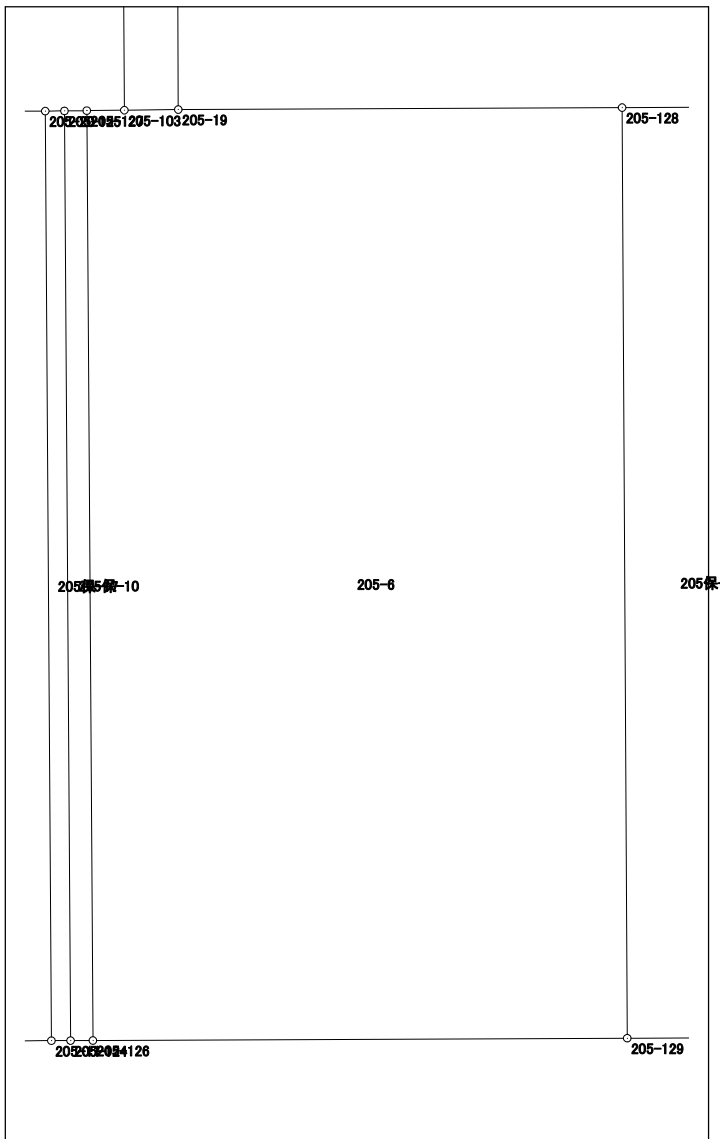

倍面積	191.806902
面 積	95.9034510

面積計算書 (座標法)

世界測地系 (測地成果2011)

所在	地番	公簿地目	現況地目	地積	所有者
前橋市六供町三丁目	205-8			102.44 m ²	


点名	X座標	Y座標	辺長	方向角	測角	DX	倍積 (Y×DX)
205-122	40560.168	-68333.350	8.019	269-44-34	90-07-13	12.863	-878971.881050
205-117	40560.132	-68341.369	12.894	178-57-05	89-12-31	-12.928	883517.218432
205-116	40547.240	-68341.133	7.868	89-47-20	90-50-15	-12.863	879071.993779
205-123	40547.269	-68333.265	12.899	359-37-21	89-50-01	12.928	-883412.449920
						倍面積	204.881241
						面積	102.4406205

面積計算書（座標法）

世界測地系（測地成果2011）

所在	地番	公簿地目	現況地目	地積	所有者
前橋市六供町三丁目	205-9			95.17 m ²	

点名	X座標	Y座標	辺長	方向角	測角	DX	倍積(Y×DX)
205-114	40560.114	-68343.231	0.449	269-21-43	90-24-25	12.877	-880055.785587
205-22	40560.109	-68343.680	6.929	269-54-03	180-32-20	-0.017	1161.842560
205-113	40560.097	-68350.609	12.898	179-01-06	89-07-03	-12.908	882269.660972
205-112	40547.201	-68350.388	7.392	89-45-35	90-44-29	-12.865	879327.741620
205-115	40547.232	-68342.996	12.884	358-57-18	89-11-43	12.913	-882513.107348

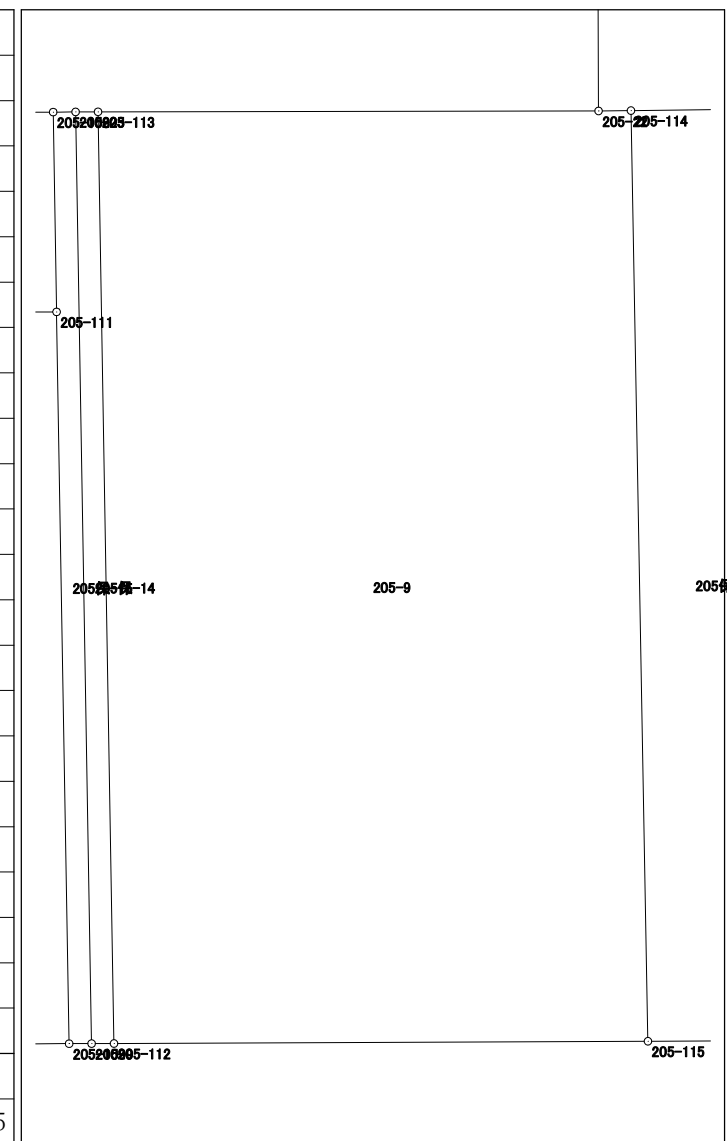


倍面積	190.352217
面積	95.1761085

面積計算書 (座標法)

世界測地系 (測地成果2011)

所在	地番	公簿地目	現況地目	地積	所有者
前橋市六供町三丁目	205-10			91.63 m ²	

点名	X座標	Y座標	辺長	方向角	測角	DX	倍積 (Y×DX)
205-110	40557.243	-68360.278	7.926	181-19-49	91-51-57	-8.009	547497.466502
205-7	40549.319	-68360.462	3.015	135-29-50	134-10-01	-10.074	688663.294188
205-8	40547.169	-68358.349	7.340	89-45-57	134-16-07	-2.120	144919.699880
205-109	40547.199	-68351.009	10.130	359-00-57	89-15-00	10.159	-694377.900431
205-111	40557.328	-68351.183	9.095	269-27-52	90-26-55	10.044	-686519.282052
						倍面積	183.278087
						面積	91.6390435

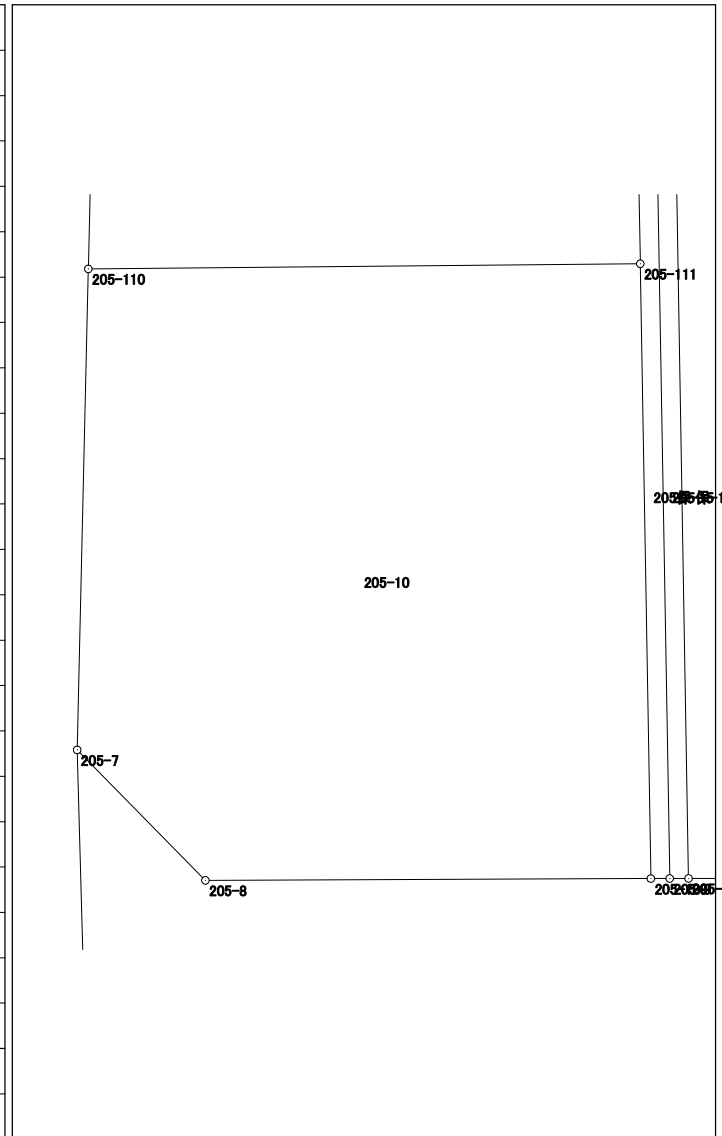


面積計算書（座標法）

世界測地系（測地成果2011）

所在	地番	公簿地目	現況地目	地積	所有者
前橋市六供町三丁目	205-11			23.86 m ²	

点名	X座標	Y座標	辺長	方向角	測角	DX	倍積 (Y×DX)
205-119	40547.284	-68329.400	12.901	359-37-37	89-50-38	12.908	-881995.895200
205-118	40560.185	-68329.484	1.615	269-45-06	90-07-29	12.894	-881040.366696
205-105	40560.178	-68331.099	0.235	269-45-22	180-00-16	-0.008	546.648792
205-120	40560.177	-68331.334	12.900	179-37-21	89-51-59	-12.901	881542.539934
205-121	40547.277	-68331.249	1.849	89-46-59	90-09-38	-12.893	880994.793357

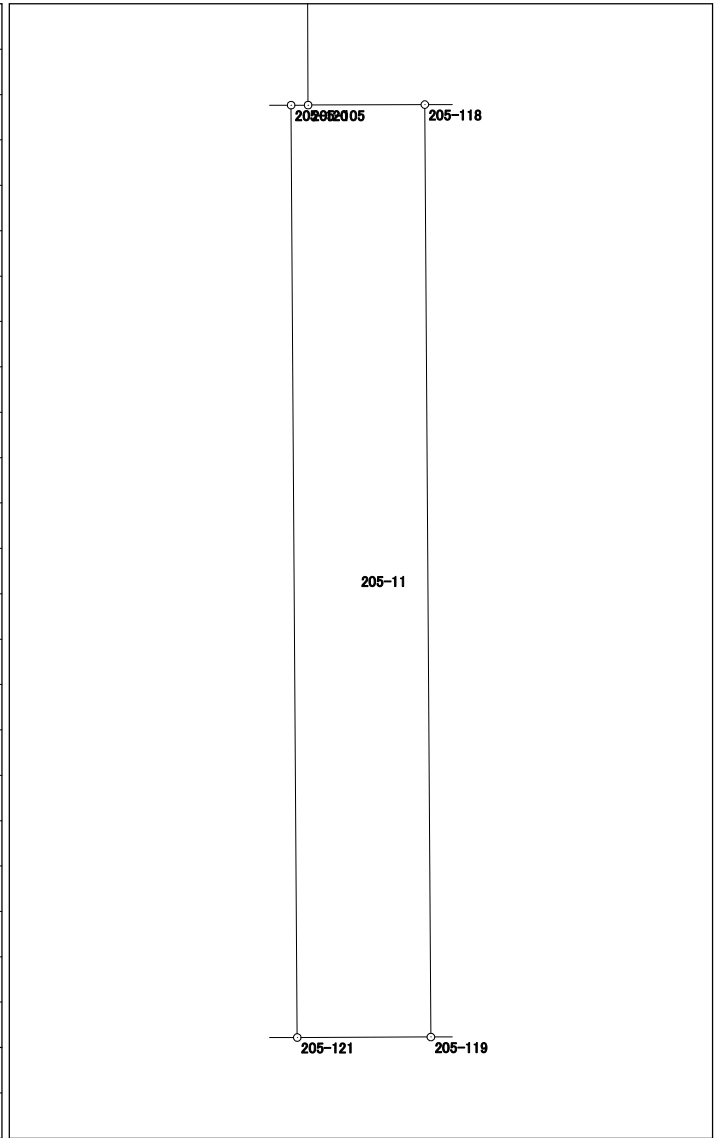


倍面積	47.720187
面積	23.8600935

面積計算書（座標法）

世界測地系（測地成果2011）

所 在	地 番	公簿地目	現況地目	地 積	所 有 者
前橋市六供町三丁目	205保-1			40.00 m ²	

点 名	X 座標	Y 座標	辺 長	方 向 角	測 角	D _X	倍 積 (Y×D _X)
205-22	40560.109	-68343.680	2.440	359-41-41	89-47-38	2.452	-167578.703360
205-106	40562.549	-68343.693	16.462	269-39-20	89-57-39	2.341	-159992.585313
205-107	40562.450	-68360.155	2.441	181-23-07	91-43-47	-2.539	173566.433545
205-6	40560.010	-68360.214	8.984	89-28-14	88-05-07	-2.357	161125.024398
205-108	40560.093	-68351.230	0.310	89-26-44	179-58-30	0.086	-5878.205780
205-23	40560.096	-68350.920	0.311	89-48-57	180-22-13	0.004	-273.403680
205-113	40560.097	-68350.609	6.929	89-54-03	180-05-06	0.013	-888.557917

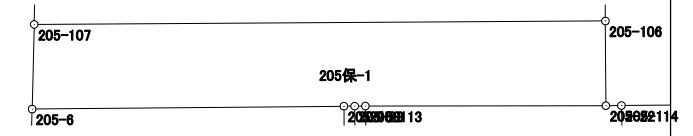


倍面積	80.001893
面 積	40.0009465

面積計算書 (座標法)

世界測地系 (測地成果2011)

所在	地番	公簿地目	現況地目	地積	所有者
前橋市六供町三丁目	205保-2			42.00 m ²	

点名	X座標	Y座標	辺長	方向角	測角	DX	倍積 (Y×DX)
205-102	40572.236	-68327.673	3.489	269-44-14	90-01-57	12.018	-821161.974114
205-104	40572.220	-68331.162	12.042	179-42-01	89-57-47	-12.058	823937.151396
205-105	40560.178	-68331.099	1.615	89-45-06	90-03-05	-12.035	822364.776465
205-118	40560.185	-68329.484	0.775	89-42-15	179-57-09	0.011	-751.624324
205-20	40560.189	-68328.709	0.266	89-21-14	179-38-59	0.007	-478.300963
205-125	40560.192	-68328.443	0.310	89-15-39	179-54-25	0.007	-478.299101
205-127	40560.196	-68328.133	0.522	89-20-29	180-04-50	0.010	-683.281330
205-103	40560.202	-68327.611	12.034	359-42-17	90-21-48	12.040	-822664.436440

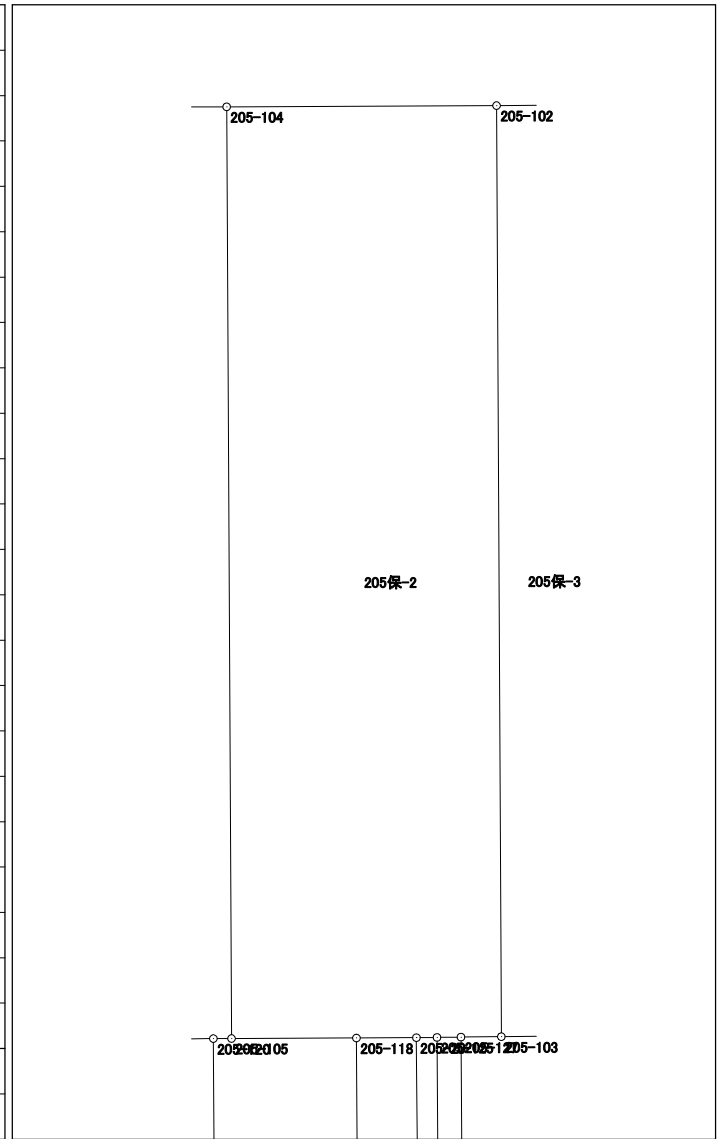


倍面積	84.011589
面積	42.0057945

面積計算書 (座標法)

世界測地系 (測地成果2011)

所在	地番	公簿地目	現況地目	地積	所有者
前橋市六供町三丁目	205保-3			9.00 m ²	

点名	X座標	Y座標	辺長	方向角	測角	D _X	倍積 (Y×D _X)
205-101	40562.768	-68326.876	9.471	359-42-13	179-59-42	12.028	-821835.664528
205-2	40572.239	-68326.925	0.748	269-46-13	90-04-00	9.468	-646919.325900
205-102	40572.236	-68327.673	12.034	179-42-17	89-56-04	-12.037	822460.199901
205-103	40560.202	-68327.611	0.748	89-18-38	89-36-21	-12.025	821639.522275
205-19	40560.211	-68326.863	2.557	359-42-31	90-23-53	2.566	-175326.730458
						倍面積	18.001290
						面積	9.0006450

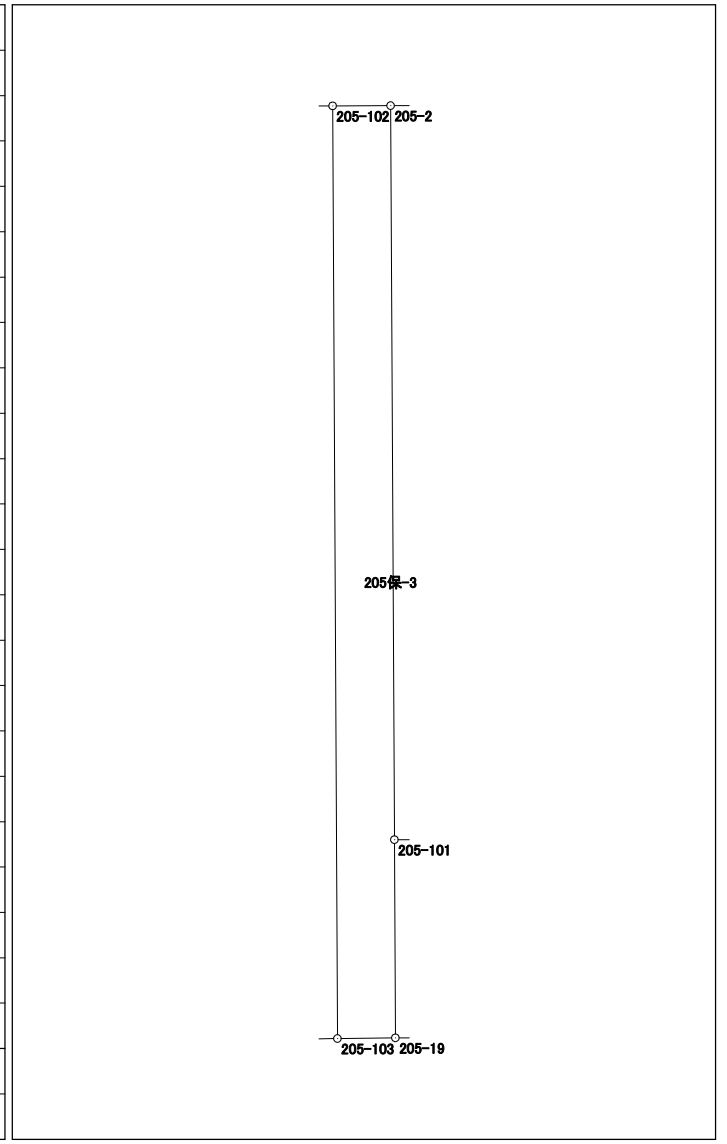


面積計算書（座標法）

世界測地系（測地成果2011）

所在	地番	公簿地目	現況地目	地積	所有者
前橋市六供町三丁目	205保-4			68.00 m ²	

点名	X座標	Y座標	辺長	方向角	測角	DX	倍積 (Y×DX)
205-18	40560.245	-68319.152	0.266	89-47-05	180-02-37	0.008	-546.553216
205-131	40560.246	-68318.886	0.310	89-37-49	179-50-44	0.003	-204.956658
205-133	40560.248	-68318.576	7.425	89-43-20	180-05-31	0.038	-2596.105888
205-134	40560.284	-68311.151	1.548	89-42-14	179-58-54	0.044	-3005.690644
205-17	40560.292	-68309.603	0.265	89-47-02	180-04-48	0.009	-614.786427
205-137	40560.293	-68309.338	0.310	89-37-49	179-50-47	0.003	-204.928014
205-139	40560.295	-68309.028	8.747	89-41-55	180-04-06	0.048	-3278.833344
205-16	40560.341	-68300.281	2.557	359-03-32	89-21-37	2.603	-177785.631443
205-100	40562.898	-68300.323	26.553	269-43-10	90-39-38	2.427	-165764.883921
205-101	40562.768	-68326.876	2.557	179-42-31	89-59-21	-2.687	183594.315812
205-19	40560.211	-68326.863	6.162	89-44-56	90-02-25	-2.530	172866.963390
205-128	40560.238	-68320.701	1.549	89-44-28	179-59-32	0.034	-2322.903834

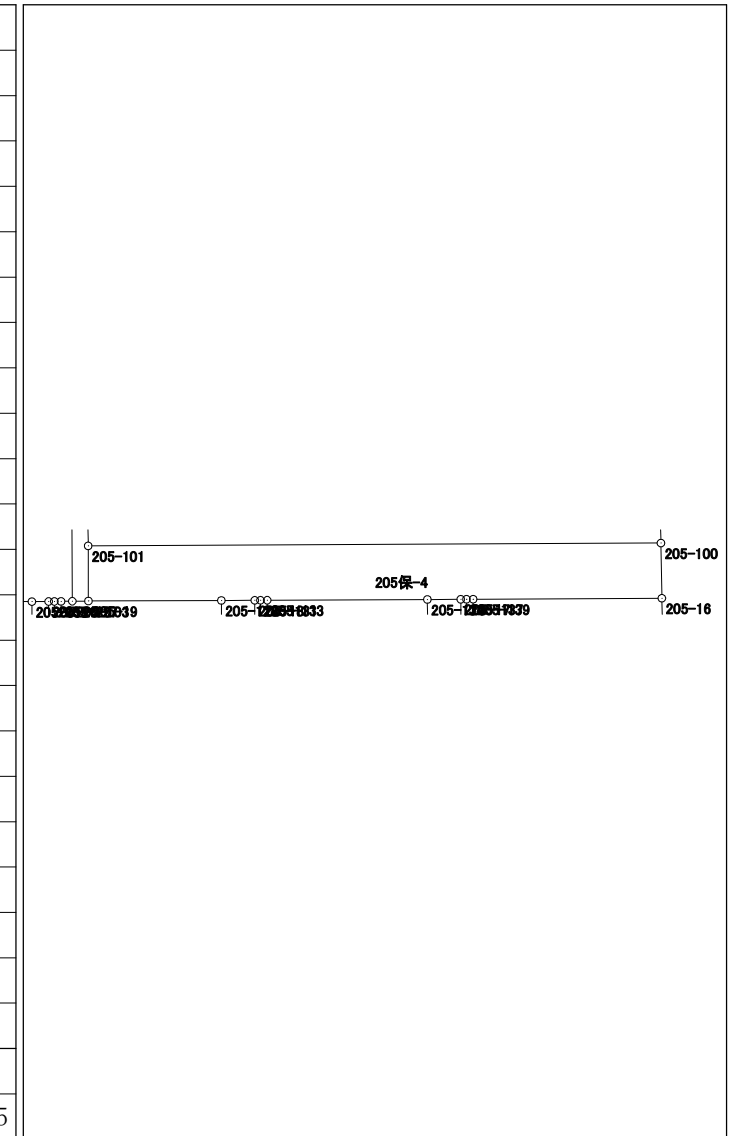

倍面積	136.005813
面積	68.0029065


面積計算書 (座標法)

世界測地系 (測地成果2011)

所 在	地 番	公簿地目	現況地目	地 積	所 有 者
前橋市六供町三丁目	205保-5			34.00 m ²	

点 名	X 座標	Y 座標	辺 長	方 向 角	測 角	DX	倍 積 (Y×DX)
205-139	40560.295	-68309.028	3.880	179-36-58	89-55-03	-3.926	268181.243928
205-140	40556.415	-68309.002	8.782	89-41-36	90-04-38	-3.833	261828.404666
205-141	40556.462	-68300.220	3.879	359-05-57	89-24-21	3.926	-268146.663720
205-16	40560.341	-68300.281	8.747	269-41-55	90-35-58	3.833	-261794.977073

倍面積	68.007801
面 積	34.0039005

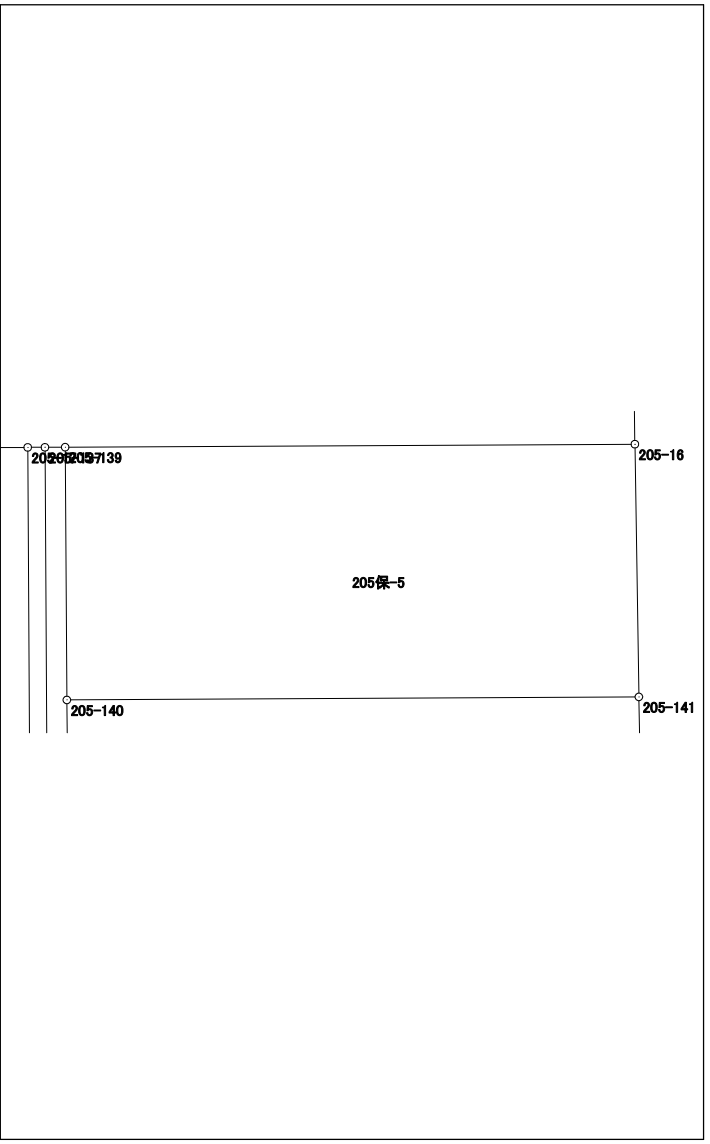


面積計算書 (座標法)

世界測地系 (測地成果2011)

所在	地番	公簿地目	現況地目	地積	所有者
前橋市六供町三丁目	205保-6			4.00 m ²	

点名	X座標	Y座標	辺長	方向角	測角	DX	倍積 (Y×DX)
205-137	40560.293	-68309.338	12.927	179-37-08	89-59-19	-12.929	883171.431002
205-136	40547.366	-68309.252	0.309	89-48-52	90-11-44	-12.926	882965.391352
205-138	40547.367	-68308.943	9.048	359-37-35	89-48-43	9.049	-618127.625207
205-140	40556.415	-68309.002	3.880	359-36-58	179-59-23	12.928	-883098.777856
205-139	40560.295	-68309.028	0.310	269-37-49	90-00-51	3.878	-264902.410584
倍面積							8.008707
面積							4.0043535

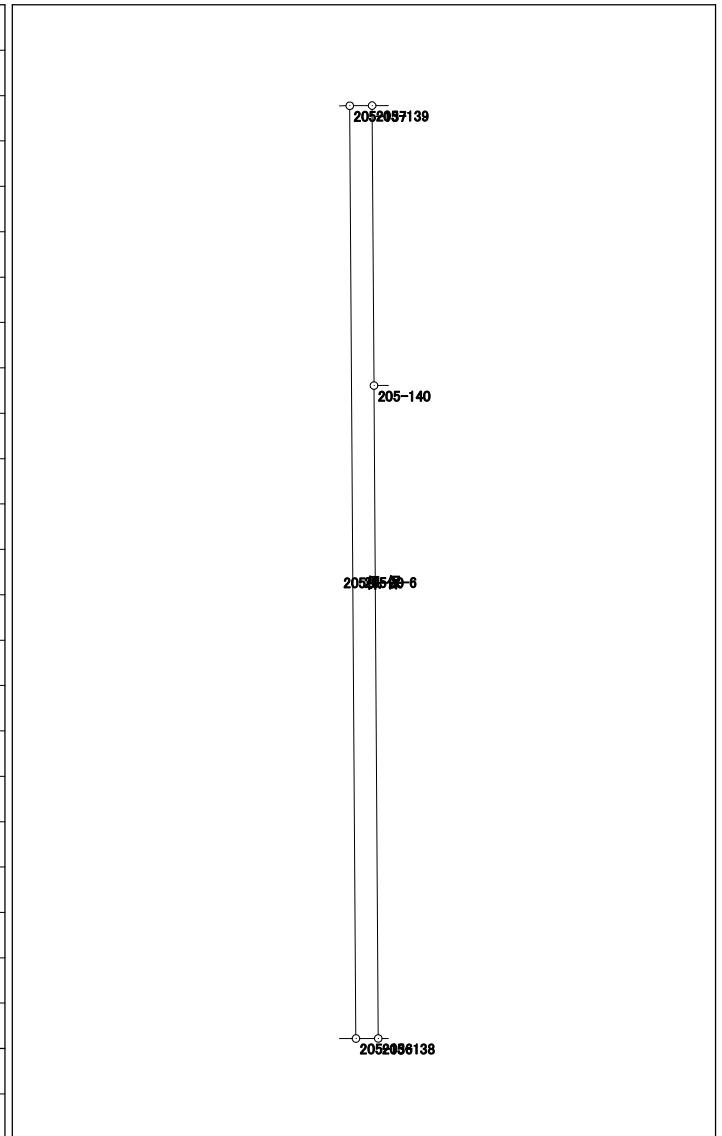


面積計算書（座標法）

世界測地系（測地成果2011）

所 在	地 番	公簿地目	現況地目	地 積	所 有 者
前橋市六供町三丁目	205保-8			4.00 m ²	

点 名	X 座標	Y 座標	辺 長	方 向 角	測 角	DX	倍 積 (Y×DX)
205-130	40547.329	-68318.815	0.310	89-48-55	90-07-49	-12.916	882405.814540
205-132	40547.330	-68318.505	12.918	359-41-06	89-52-11	12.919	-882606.766095
205-133	40560.248	-68318.576	0.310	269-37-49	89-56-43	12.916	-882402.727616
205-131	40560.246	-68318.886	12.917	179-41-06	90-03-17	-12.919	882611.688234
						倍面積	8.009063
						面 積	4.0045315

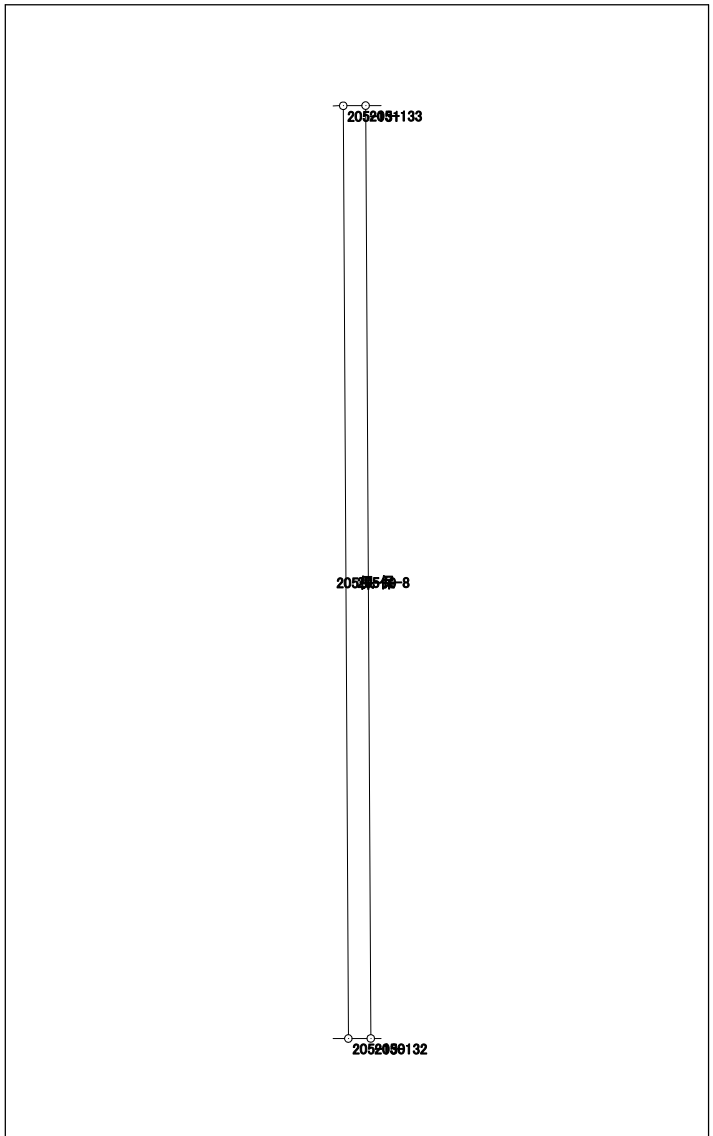


面積計算書 (座標法)

世界測地系 (測地成果2011)

所 在	地 番	公簿地目	現況地目	地 積	所 有 者
前橋市六供町三丁目	205保-9			20.00 m ²	

点 名	X 座標	Y 座標	辺 長	方 向 角	測 角	DX	倍 積 (Y×DX)
205-12	40547.328	-68319.081	12.917	359-41-06	89-56-38	12.924	-882955.802844
205-18	40560.245	-68319.152	1.549	269-44-28	90-03-22	12.910	-882000.252320
205-128	40560.238	-68320.701	12.917	179-41-06	89-56-38	-12.924	882976.739724
205-129	40547.321	-68320.630	1.549	89-44-28	90-03-22	-12.910	882019.333300
倍面積							40.017860
面 積							20.0089300

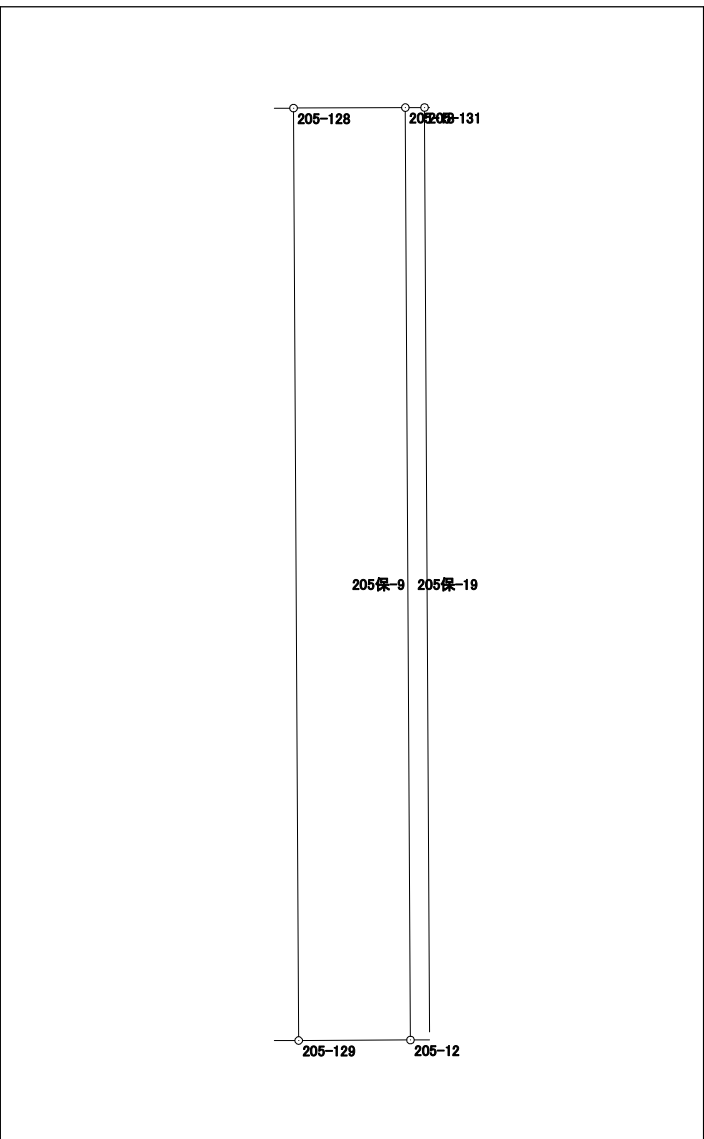


面積計算書（座標法）

世界測地系（測地成果2011）

所 在	地 番	公簿地目	現況地目	地 積	所 有 者
前橋市六供町三丁目	205保-10			4.00 m ²	

点 名	X 座標	Y 座標	辺 長	方 向 角	測 角	DX	倍 積 (Y×DX)
205-124	40547.288	-68328.358	0.310	89-48-55	90-11-34	-12.903	881640.803274
205-126	40547.289	-68328.048	12.907	359-37-22	89-48-27	12.908	-881978.443584
205-127	40560.196	-68328.133	0.310	269-15-39	89-38-17	12.903	-881637.900099
205-125	40560.192	-68328.443	12.904	179-37-21	90-21-42	-12.908	881983.542244
						倍面積	8.001835
						面 積	4.0009175

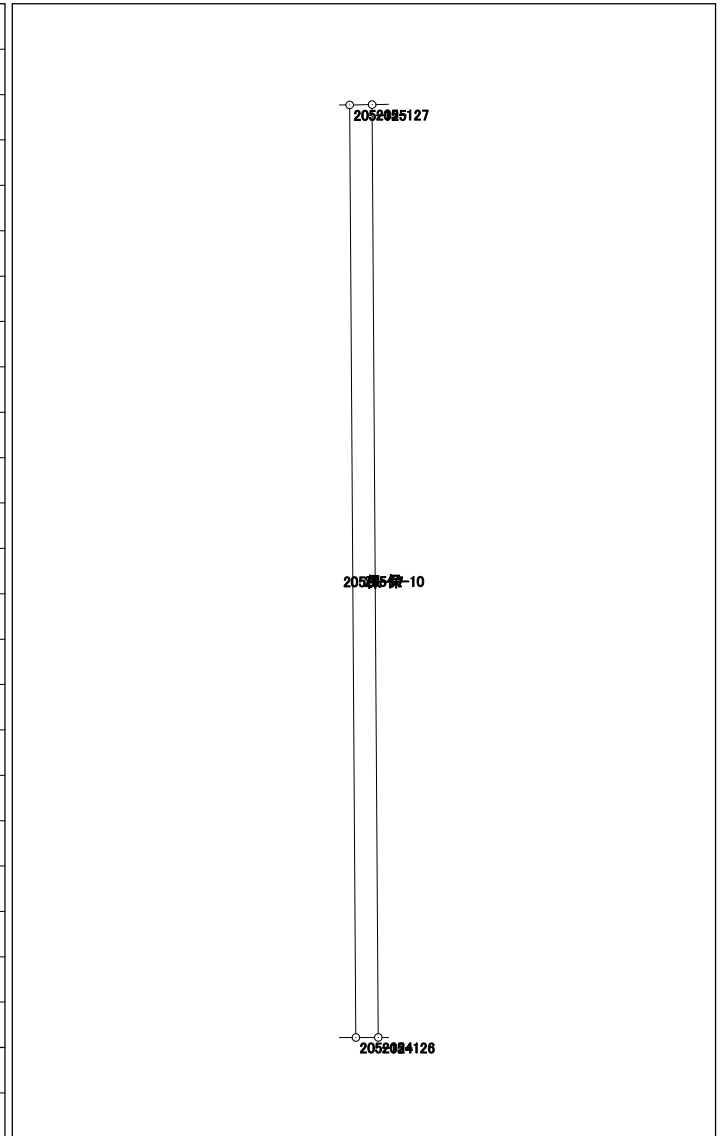


面積計算書（座標法）

世界測地系（測地成果2011）

所在	地番	公簿地目	現況地目	地積	所有者
前橋市六供町三丁目	205保-11			26.00 m ²	

点名	X座標	Y座標	辺長	方向角	測角	DX	倍積 (Y×DX)	
205-120	40560.177	-68331.334	2.016	269-44-39	90-07-18	12.891	-880859.226594	
205-122	40560.168	-68333.350	12.899	179-37-21	89-52-42	-12.908	882046.881800	
205-123	40547.269	-68333.265	2.016	89-46-21	90-09-00	-12.891	880884.119115	
205-121	40547.277	-68331.249	12.900	359-37-21	89-51-00	12.908	-882019.762092	
							倍面積	52.012229
							面積	26.0061145

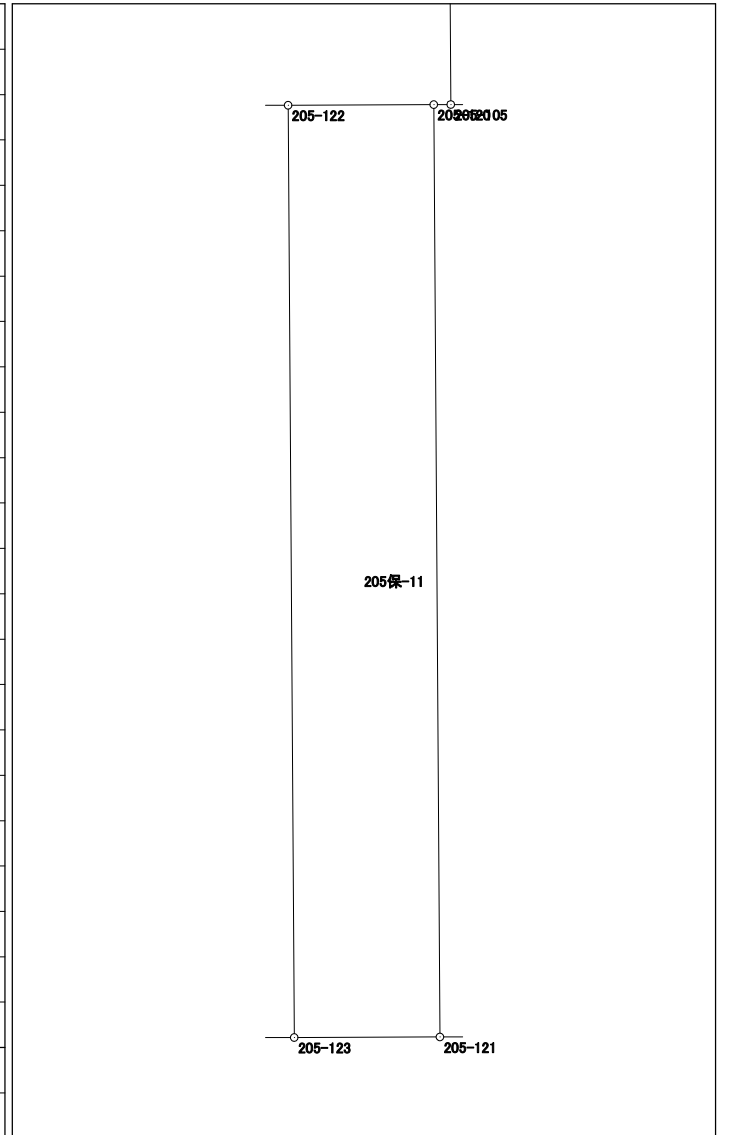

面積計算書（座標法）

世界測地系（測地成果2011）

所 在	地 番	公簿地目	現況地目	地 積	所 有 者
前橋市六供町三丁目	205保-14			4.00 m ²	


点 名	X 座標	Y 座標	辺 長	方 向 角	測 角	DX	倍 積 (Y×DX)
205-9	40547.200	-68350.698	0.310	89-48-55	90-48-05	-12.895	881382.250710
205-112	40547.201	-68350.388	12.898	359-01-06	89-12-11	12.897	-881514.954036
205-113	40560.097	-68350.609	0.311	269-48-57	90-47-51	12.895	-881381.103055
205-23	40560.096	-68350.920	12.898	179-00-50	89-11-53	-12.897	881521.815240
倍面積							8.008859
面 積							4.0044295

面積計算書（座標法）

世界測地系（測地成果2011）

所 在	地 番	公簿地目	現況地目	地 積	所 有 者
前橋市六供町三丁目	205保-15			4.00 m ²	

点 名	X 座標	Y 座標	辺 長	方 向 角	測 角	DX	倍 積 (Y×DX)
205-23	40560.096	-68350.920	0.310	269-26-44	90-25-54	12.893	-881248.411560
205-108	40560.093	-68351.230	2.765	179-01-34	89-34-50	-2.768	189196.204640
205-111	40557.328	-68351.183	10.130	179-00-57	179-59-23	-12.894	881320.153602
205-109	40547.199	-68351.009	0.311	89-48-57	90-48-00	-10.128	692259.019152
205-9	40547.200	-68350.698	12.898	359-00-50	89-11-53	12.897	-881518.952106
						倍面積	8.013728
						面 積	4.0068640

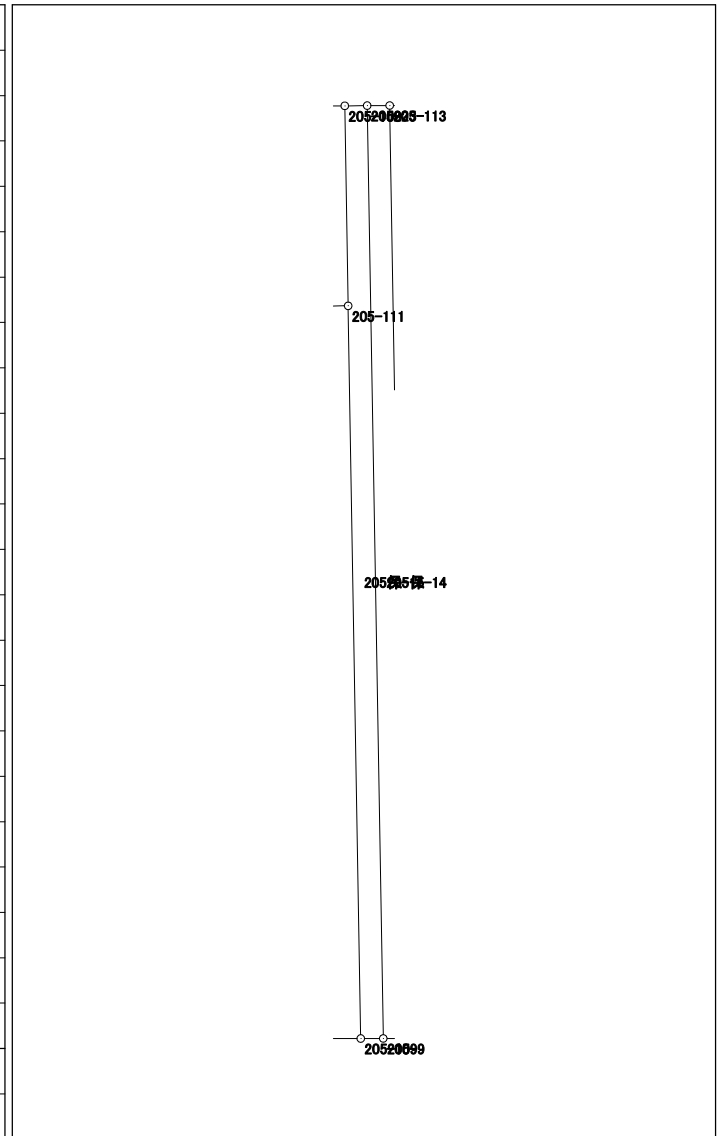


面積計算書 (座標法)

世界測地系 (測地成果2011)

所在	地番	公簿地目	現況地目	地積	所有者
前橋市六供町三丁目	205保-16			25.00 m ²	

点名	X座標	Y座標	辺長	方向角	測角	DX	倍積 (Y×DX)
205-108	40560.093	-68351.230	8.984	269-28-14	90-26-40	2.682	-183317.998860
205-6	40560.010	-68360.214	2.768	181-19-30	91-51-16	-2.850	194826.609900
205-110	40557.243	-68360.278	9.095	89-27-52	88-08-22	-2.682	183342.265596
205-111	40557.328	-68351.183	2.765	359-01-34	89-33-42	2.850	-194800.871550

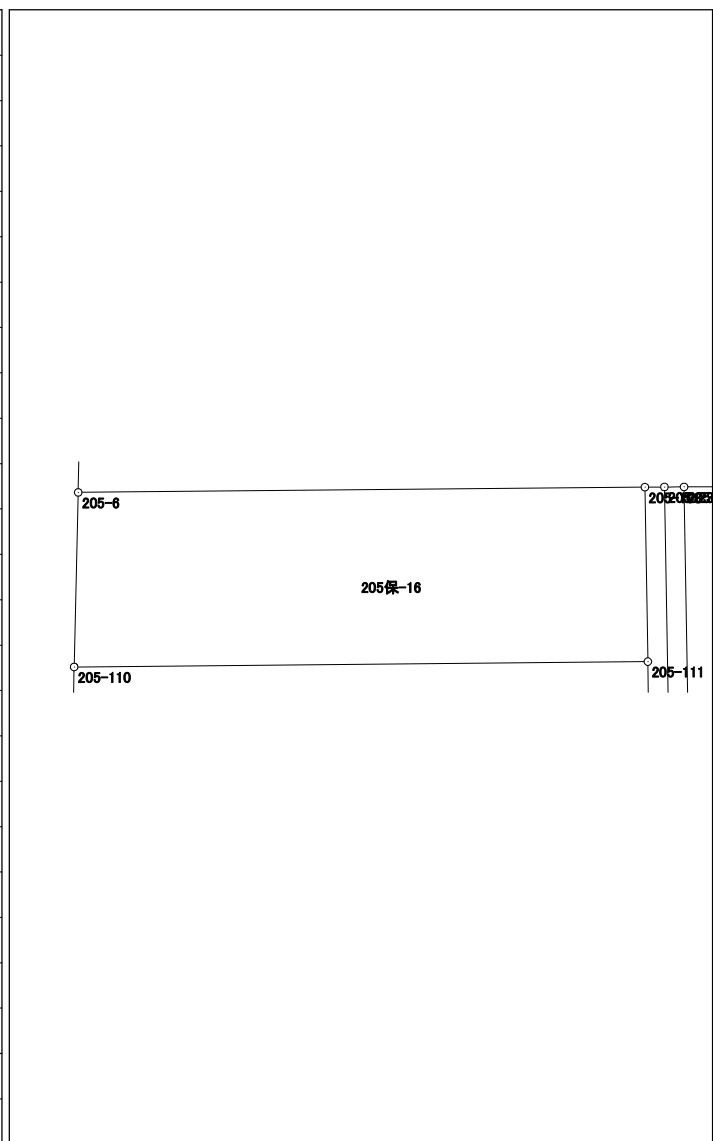


倍面積	50.005086
面積	25.0025430

面積計算書（座標法）

所 在	地 番	公簿地目	現況地目	地 積	所 有 者
前橋市六供町三丁目	205保-17			3.43 m ²	

点 名	X 座標	Y 座標	辺 長	方 向 角	測 角	DX	倍 積 (Y×DX)
205-20	40560.189	-68328.709	12.902	179-37-21	90-16-07	-12.905	881781.989645
205-11	40547.287	-68328.624	0.266	89-47-05	90-09-44	-12.901	881507.578224
205-124	40547.288	-68328.358	12.904	359-37-21	89-50-16	12.905	-881777.459990
205-125	40560.192	-68328.443	0.266	269-21-14	89-43-53	12.901	-881505.243143
						倍面積	6.864736
						面 積	3.4323680

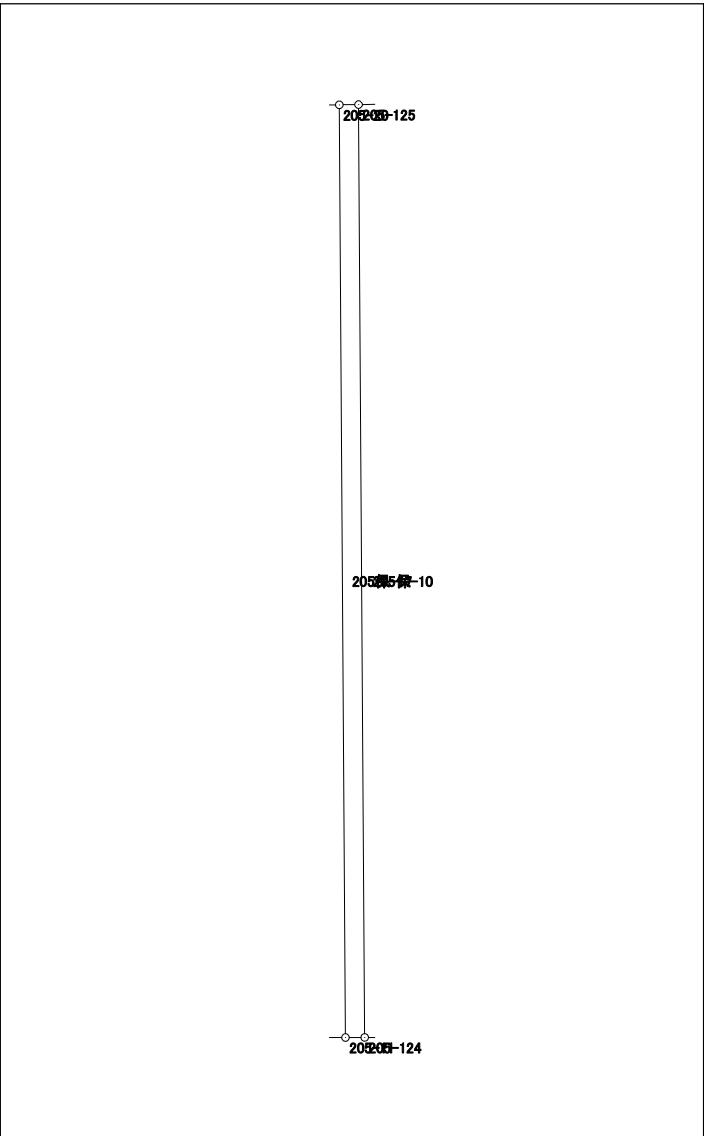


面積計算書（座標法）

世界測地系（測地成果2011）

所 在	地 番	公簿地目	現況地目	地 積	所 有 者
前橋市六供町三丁目	205保-18			10.00 m ²	

点 名	X 座 標	Y 座 標	辺 長	方 向 角	測 角	DX	倍 積 (Y×DX)
205-20	40560.189	-68328.709	0.775	269-42-15	90-04-54	12.898	-881303.688682
205-118	40560.185	-68329.484	12.901	179-37-37	89-55-22	-12.905	881791.991020
205-119	40547.284	-68329.400	0.776	89-46-43	90-09-06	-12.898	881312.601200
205-11	40547.287	-68328.624	12.902	359-37-21	89-50-38	12.905	-881780.892720
						倍面積	20.010818
						面 積	10.0054090

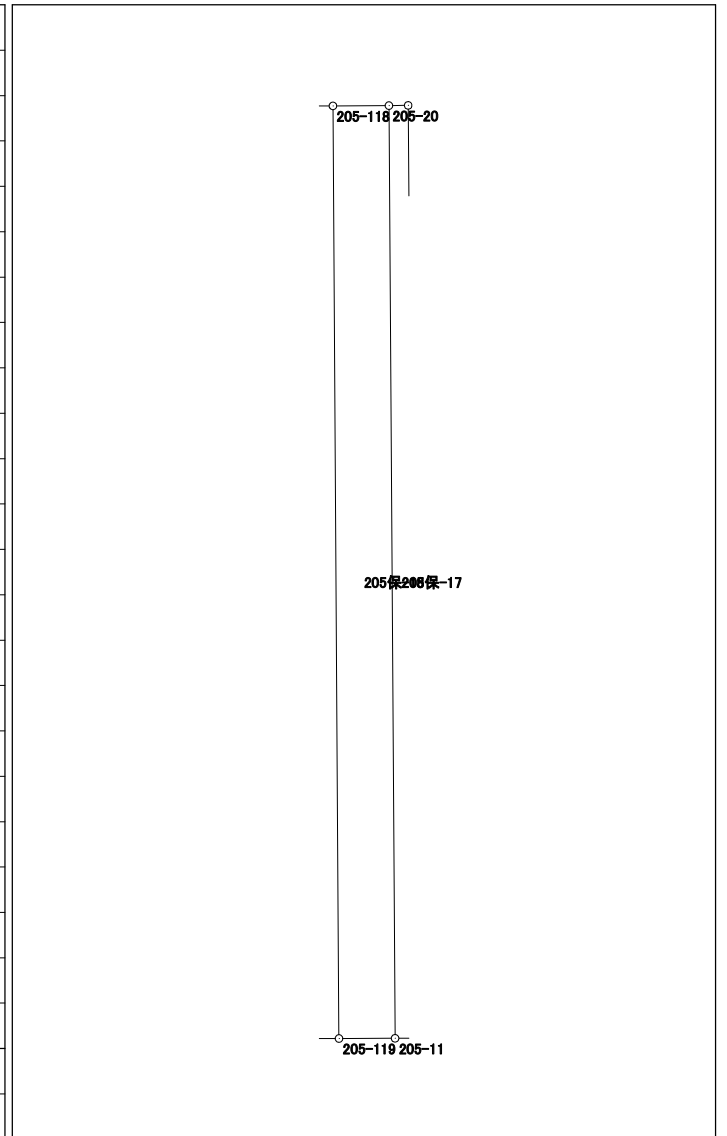


面積計算書 (座標法)

世界測地系 (測地成果2011)

所在	地番	公簿地目	現況地目	地積	所有者
前橋市六供町三丁目	205保-19			3.43 m ²	

点名	X座標	Y座標	辺長	方向角	測角	DX	倍積 (Y×DX)
205-18	40560.245	-68319.152	12.917	179-41-06	89-54-01	-12.918	882546.805536
205-12	40547.328	-68319.081	0.266	89-47-05	90-05-59	-12.916	882409.250196
205-130	40547.329	-68318.815	12.917	359-41-06	89-54-01	12.918	-882542.452170
205-131	40560.246	-68318.886	0.266	269-47-05	90-05-59	12.916	-882406.731576

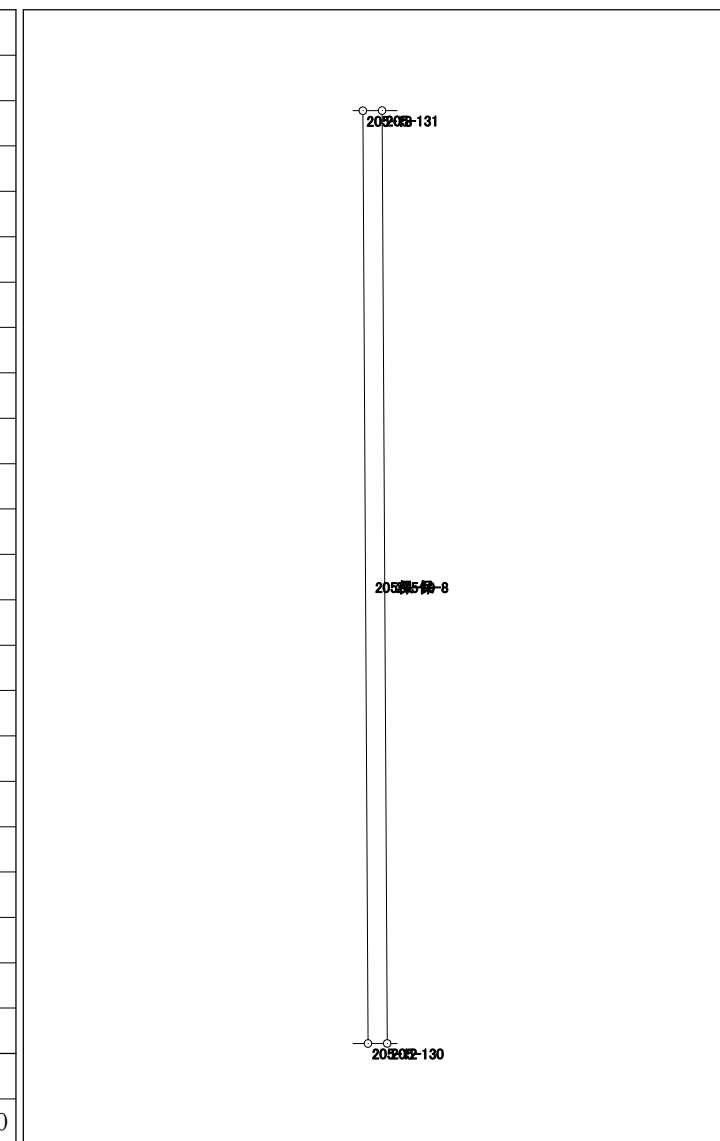

倍面積	6.871986
面積	3.4359930

面積計算書 (座標法)

世界測地系 (測地成果2011)

所在	地番	公簿地目	現況地目	地積	所有者
前橋市六供町三丁目	205保-20			3.43 m ²	

点名	X座標	Y座標	辺長	方向角	測角	DX	倍積 (Y×DX)
205-17	40560.292	-68309.603	12.927	179-37-24	89-50-22	-12.928	883106.547584
205-13	40547.365	-68309.518	0.266	89-47-05	90-09-41	-12.926	882968.829668
205-136	40547.366	-68309.252	12.927	359-37-08	89-50-03	12.928	-883102.009856
205-137	40560.293	-68309.338	0.265	269-47-02	90-09-54	12.926	-882966.502988
						倍面積	6.864408
						面積	3.432040

