



206街区 画地出来形確認図 (3778.18m²)

3・3・2 前橋長瀬線

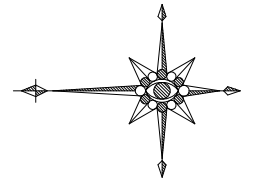

S=1:250

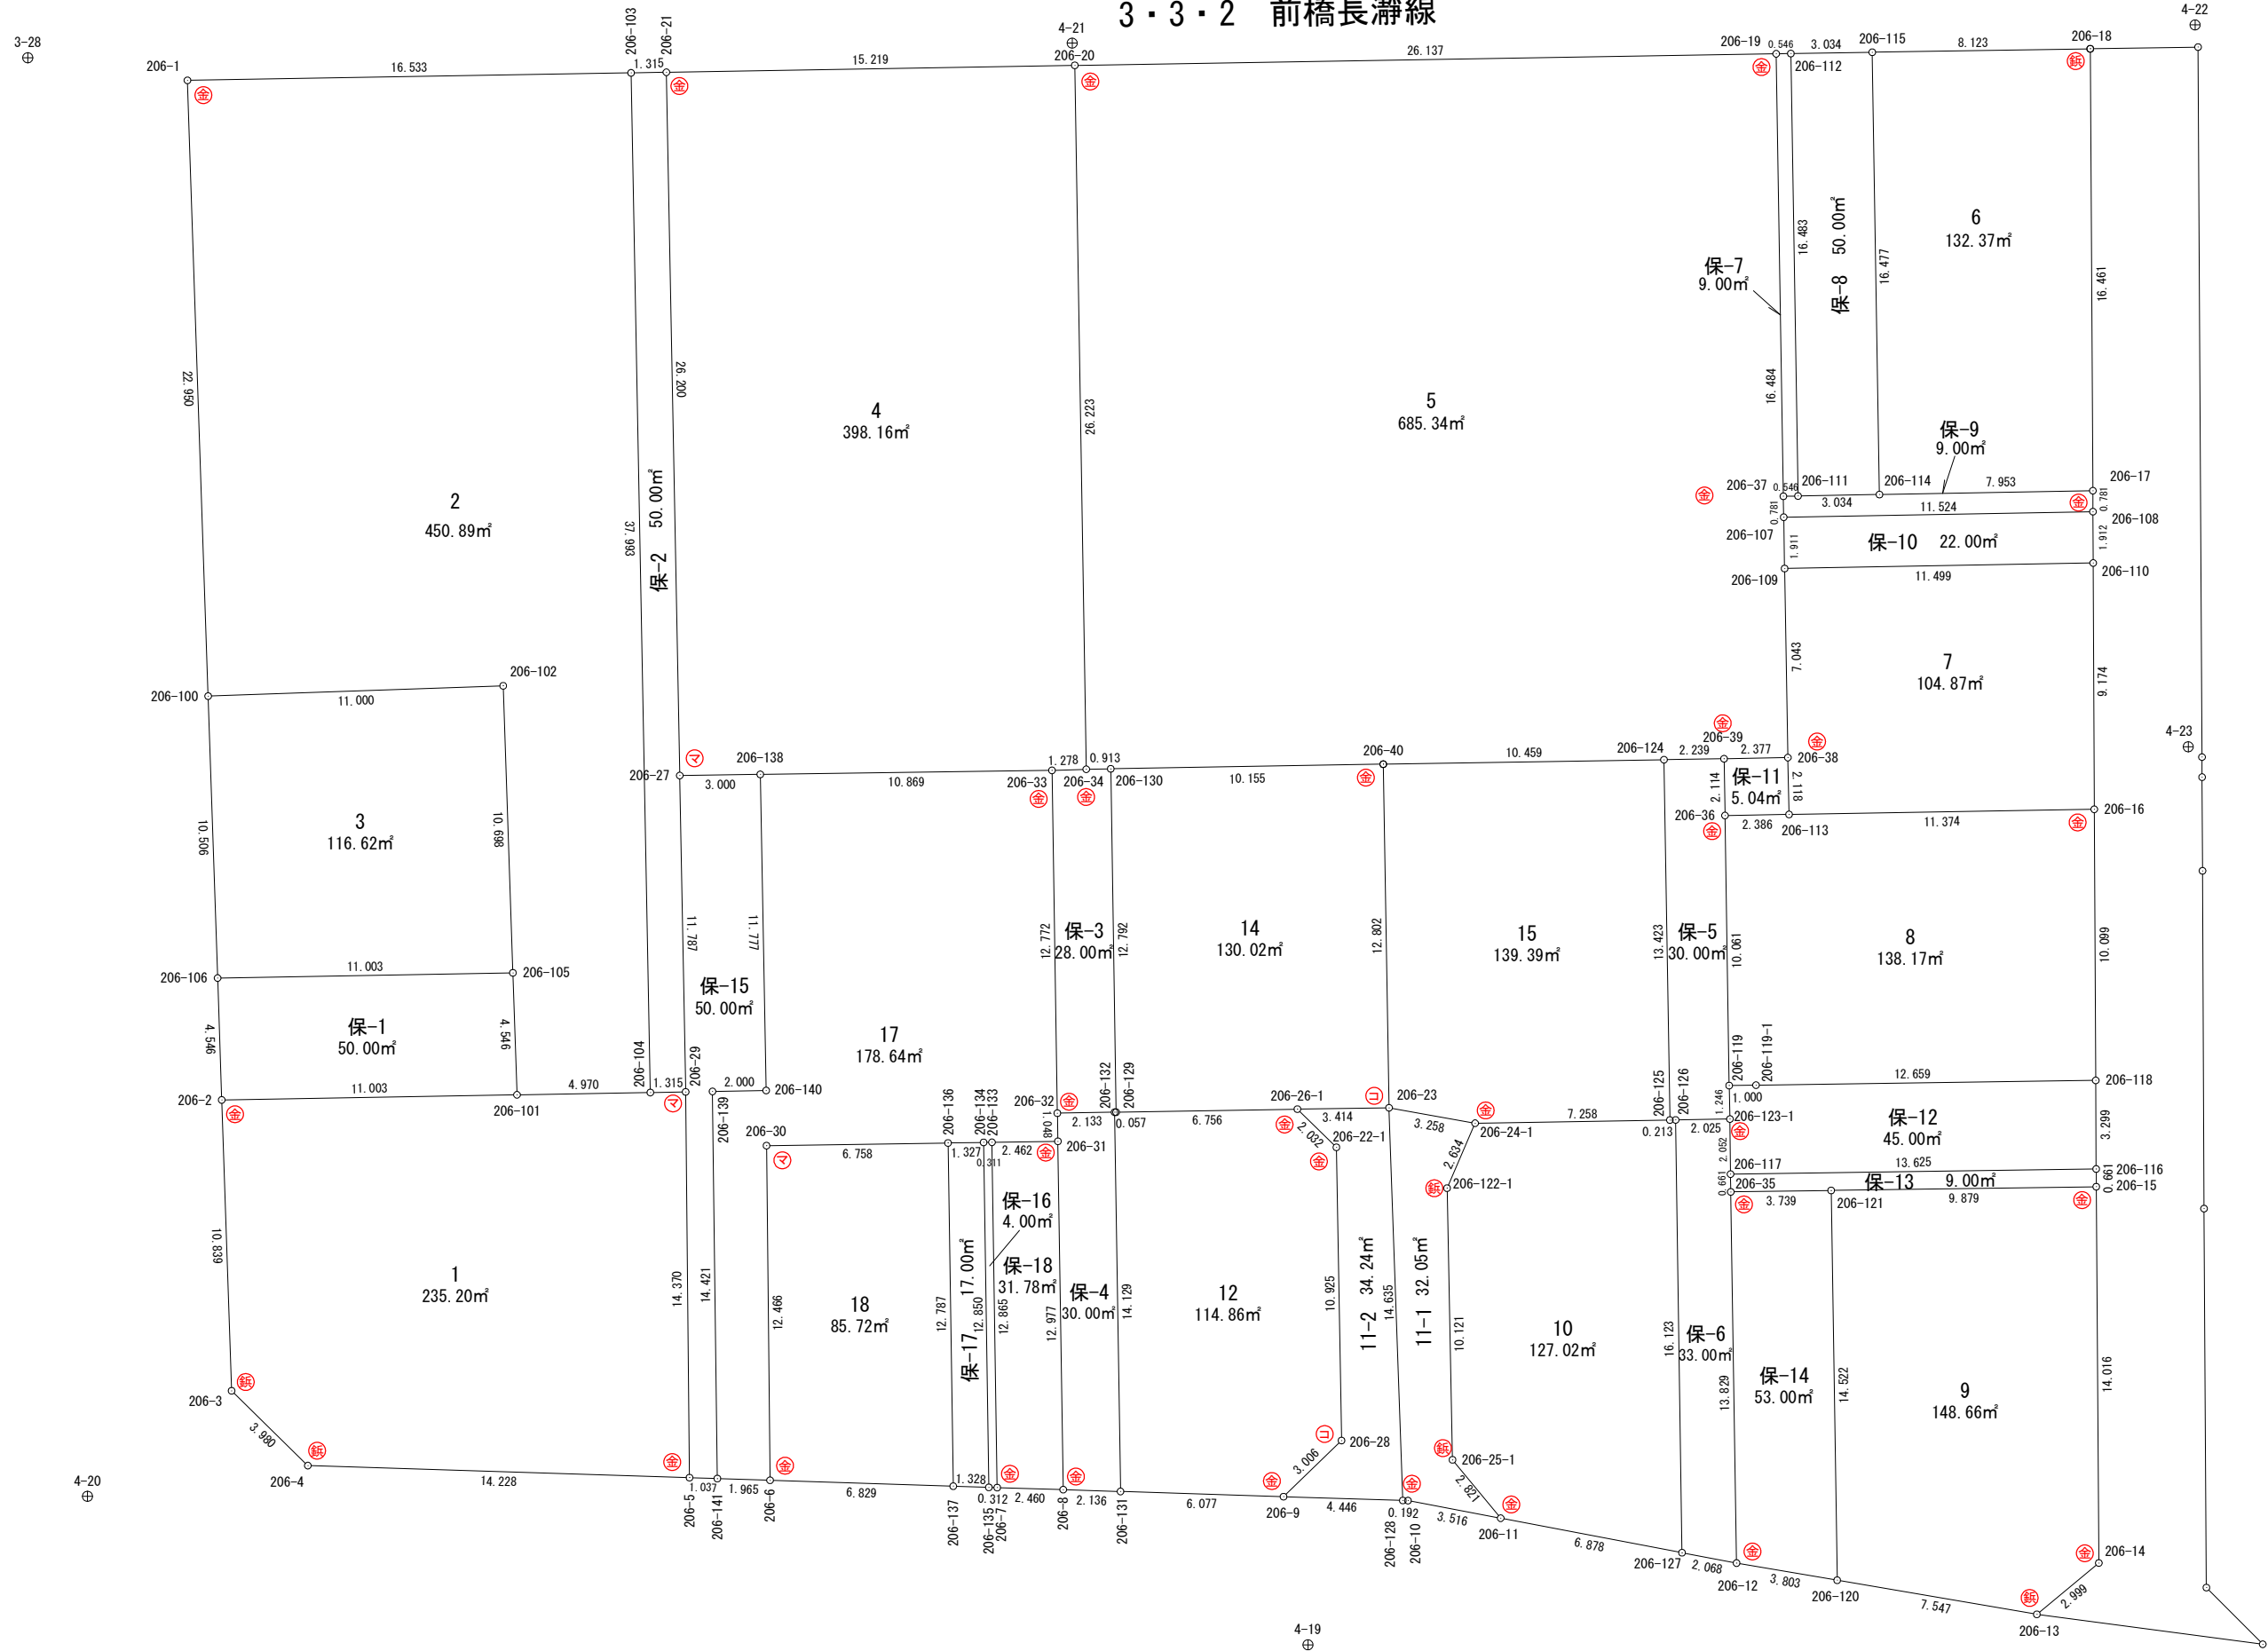


凡 例	
事 項	記 号
金属プレート	⊕
コンクリート杭	⊖
金属釘	⊗
合成樹脂杭	⊙
マーキング	⊚

面積計算書 (座標法)

世界測地系 (測地成果2011)

所 在	地 番	公簿地目	現況地目	地 積	所 有 者
前橋市六供町三丁目	206-8			138.17 m ²	

点 名	X 座標	Y 座標	辺 長	方 向 角	測 角	DX	倍 積 (Y×DX)
206-118	40576.199	-68338.969	10.099	89-41-37	90-29-25	-12.604	861344.365276
206-16	40576.253	-68328.870	11.374	359-01-58	89-20-21	11.426	-780725.668620
206-113	40587.625	-68329.062	2.386	359-02-22	180-00-24	13.758	-940071.234996
206-36	40590.011	-68329.102	10.061	269-07-23	90-05-01	2.232	-152510.555664
206-119	40589.857	-68339.162	1.000	179-01-34	89-54-11	-1.154	78863.392948
206-119-1	40588.857	-68339.145	12.659	179-12-12	180-10-38	-13.658	933376.042410

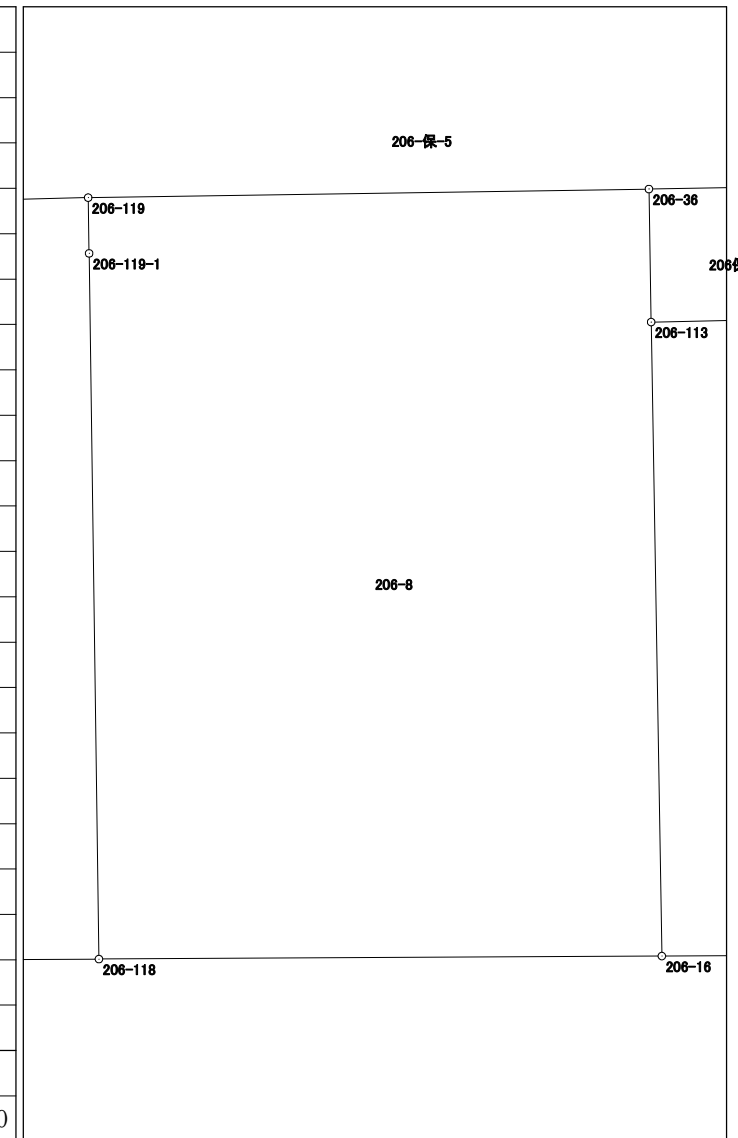


倍面積	276.341354
面 積	138.1706770

面積計算書（座標法）

世界測地系（測地成果2011）

所在	地番	公簿地目	現況地目	地積	所有者
前橋市六供町三丁目	206-10			127.02 m ²	

点名	X座標	Y座標	辺長	方向角	測角	DX	倍積 (Y×DX)
206-126	40591.852	-68340.441	0.213	358-55-27	89-46-25	0.452	-30889.879332
206-125	40592.065	-68340.445	7.258	359-03-38	180-08-11	7.470	-510503.124150
206-24-1	40599.322	-68340.564	2.634	293-22-22	114-18-44	8.302	-567363.362328
206-122-1	40600.367	-68342.982	10.121	268-51-23	155-29-01	0.843	-57613.133826
206-25-1	40600.165	-68353.101	2.821	230-28-50	141-37-27	-1.997	136501.142697
206-11	40598.370	-68355.277	6.878	190-46-03	140-17-13	-8.552	584574.328904
206-127	40591.613	-68356.562	16.123	89-09-02	78-22-59	-6.518	445548.071116

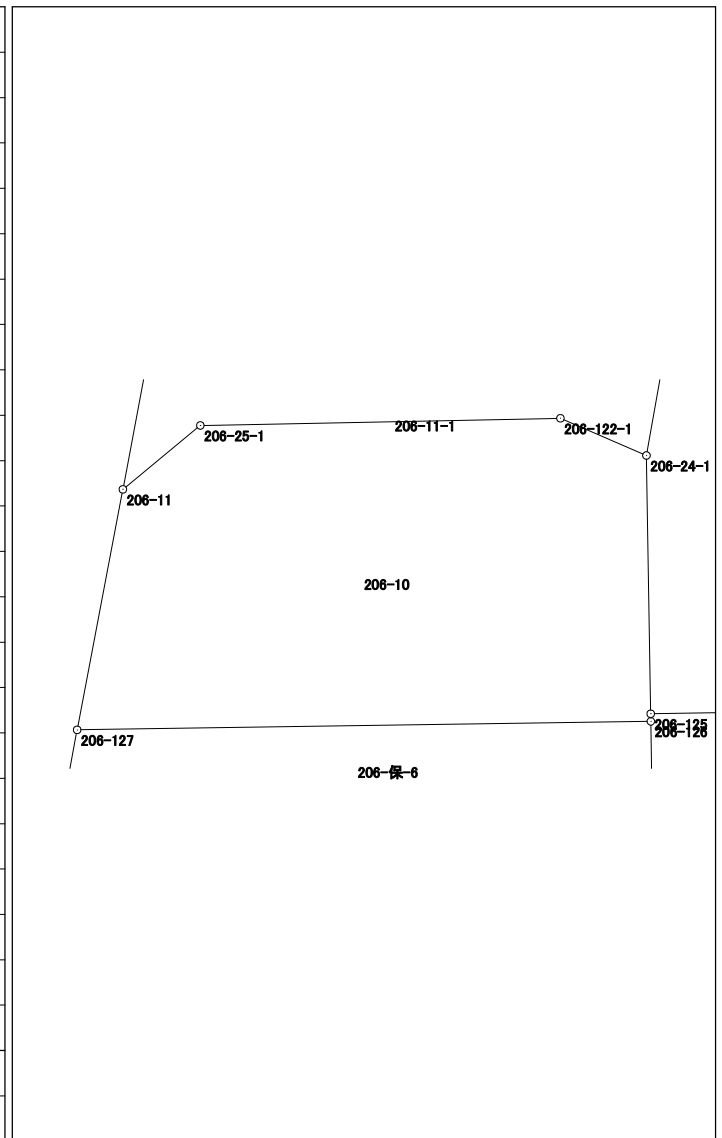


倍面積	254.043081
面積	127.0215405

面積計算書 (座標法)

所在	地番	公簿地目	現況地目	地積	所有者
前橋市六供町三丁目	206-11-1			32.05 m ²	

点名	X座標	Y座標	辺長	方向角	測角	DX	倍積 (Y×DX)
206-23	40602.529	-68339.990	14.635	267-59-28	77-50-37	2.694	-184107.933060
206-128	40602.016	-68354.616	0.192	181-47-24	93-47-56	-0.705	48190.004280
206-10	40601.824	-68354.622	3.516	190-44-16	188-56-52	-3.646	249220.951812
206-11	40598.370	-68355.277	2.821	50-28-50	39-44-34	-1.659	113401.404543
206-25-1	40600.165	-68353.101	10.121	88-51-23	218-22-33	1.997	-136501.142697
206-122-1	40600.367	-68342.982	2.634	113-22-22	204-30-59	-0.843	57613.133826
206-24-1	40599.322	-68340.564	3.258	10-08-51	76-46-29	2.162	-147752.299368

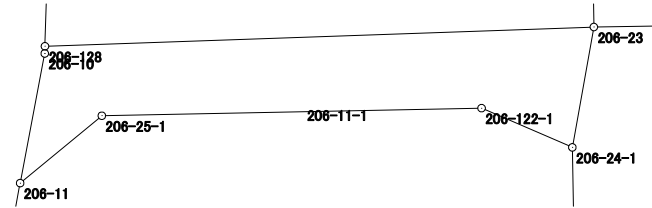


倍面積	64.119336
面積	32.0596680

面積計算書（座標法）

世界測地系（測地成果2011）

所在	地番	公簿地目	現況地目	地積	所有者
前橋市六供町三丁目	206-11-2			34.24 m ²	

点名	X座標	Y座標	辺長	方向角	測角	DX	倍積 (Y×DX)
206-23	40602.529	-68339.990	3.414	359-10-40	91-11-12	3.927	-268371.140730
206-26-1	40605.943	-68340.039	2.032	224-24-07	45-13-27	1.962	-134083.156518
206-22-1	40604.491	-68341.461	10.925	268-59-54	224-35-47	-1.643	112285.020423
206-28	40604.300	-68352.384	3.006	315-55-48	226-55-54	1.969	-134585.844096
206-9	40606.460	-68354.475	4.446	181-49-02	45-53-14	-2.284	156121.620900
206-128	40602.016	-68354.616	14.635	87-59-28	86-10-26	-3.931	268701.995496

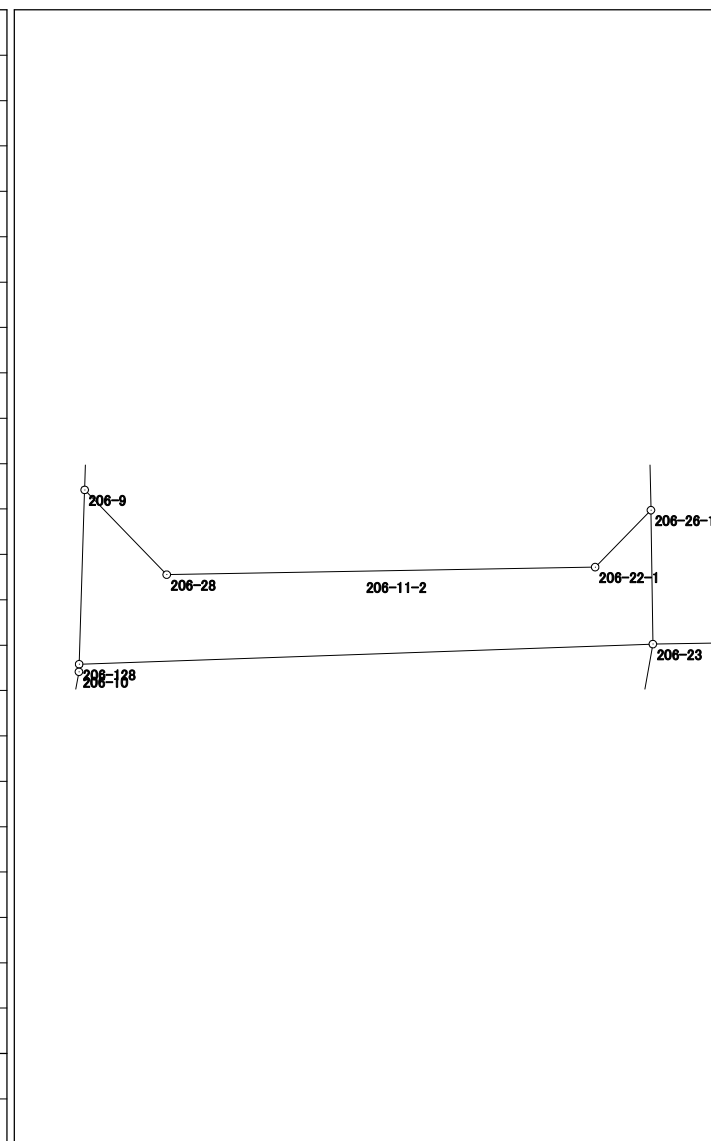

倍面積	68.495475
面積	34.247375

面積計算書（座標法）

世界測地系（測地成果2011）

所 在	地 番	公簿地目	現況地目	地 積	所 有 者
前橋市六供町三丁目	206-14			130.02 m ²	


点 名	X 座標	Y 座標	辺 長	方 向 角	測 角	DX	倍 積 (Y×DX)	
206-129	40612.698	-68340.153	6.756	179-01-59	89-55-44	-6.955	475305.764115	
206-26-1	40605.943	-68340.039	3.414	179-10-40	180-08-41	-10.169	694949.856591	
206-23	40602.529	-68339.990	12.802	89-02-16	89-51-36	-3.199	218619.628010	
206-40	40602.744	-68327.190	10.155	359-01-26	89-59-10	10.369	-708484.633110	
206-130	40612.898	-68327.363	12.792	269-06-15	90-04-49	9.954	-680130.571302	
							倍面積	260.044304
							面 積	130.0221520

面積計算書 (座標法)

世界測地系 (測地成果2011)

所在	地番	公簿地目	現況地目	地積	所有者
前橋市六供町三丁目	206-15			139.39 m ²	

点名	X座標	Y座標	辺長	方向角	測角	DX	倍積 (Y×DX)
206-124	40592.286	-68327.024	10.459	359-05-26	90-02-02	10.679	-729664.289296
206-40	40602.744	-68327.190	12.802	269-02-16	89-56-50	10.243	-699875.407170
206-23	40602.529	-68339.990	3.258	190-08-51	101-06-35	-3.422	233859.445780
206-24-1	40599.322	-68340.564	7.258	179-03-38	168-54-47	-10.464	715115.661696
206-125	40592.065	-68340.445	13.423	89-03-24	89-59-46	-7.036	480843.371020

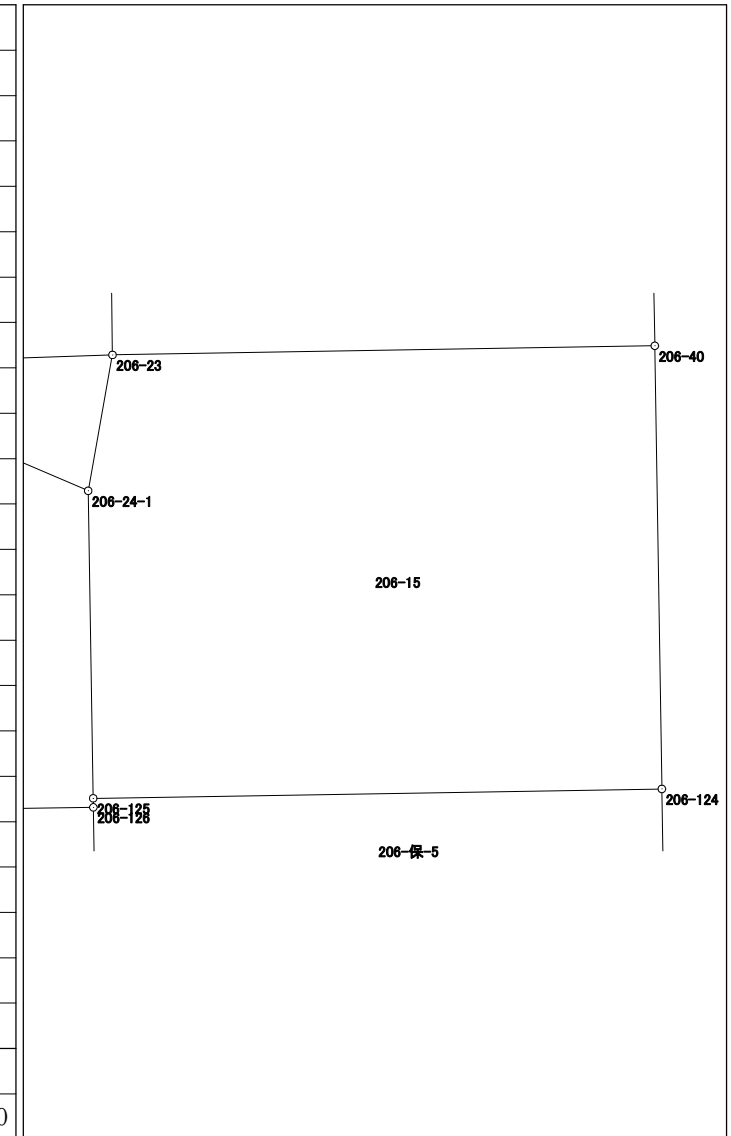


倍面積	278.782030
面積	139.3910150

面積計算書（座標法）

世界測地系（測地成果2011）

所 在	地 番	公簿地目	現況地目	地 積	所 有 者
前橋市六供町三丁目	206-17			178.64 m ²	

点 名	X 座標	Y 座標	辺 長	方 向 角	測 角	DX	倍 積 (Y×DX)
206-141	40627.556	-68353.800	1.965	181-51-59	92-35-08	-2.145	146618.901000
206-6	40625.592	-68353.864	12.466	89-23-36	87-31-37	-1.832	125224.278848
206-30	40625.724	-68341.399	6.758	179-09-38	269-46-02	-6.625	452761.768375
206-136	40618.967	-68341.300	1.327	179-08-11	179-58-33	-8.084	552471.069200
206-134	40617.640	-68341.280	0.311	179-04-44	179-56-33	-1.638	111943.016640
206-133	40617.329	-68341.275	2.462	179-08-20	180-03-36	-2.773	189510.355575
206-31	40614.867	-68341.238	1.048	88-51-07	89-42-47	-2.441	166820.961958
206-32	40614.888	-68340.190	12.772	89-06-10	180-15-03	0.221	-15103.181990
206-33	40615.088	-68327.420	10.869	359-12-33	90-06-23	11.068	-756247.884560
206-138	40625.956	-68327.570	11.777	268-56-04	89-43-31	10.649	-727620.292930
206-140	40625.737	-68339.345	2.000	358-59-51	270-03-47	1.781	-121712.373445
206-139	40627.737	-68339.380	14.421	269-16-51	90-17-00	1.819	-124309.332220
倍面積							357.286451
面 積							178.6432255

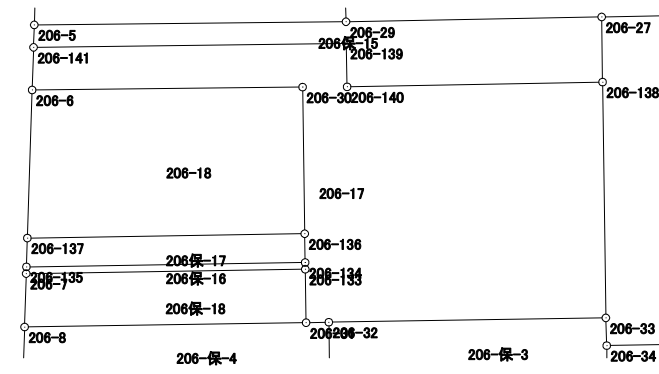


面積計算書（座標法）

世界測地系（測地成果2011）

所 在	地 番	公簿地目	現況地目	地 積	所 有 者
前橋市六供町三丁目	206-18			85.72 m ²	

点 名	X 座標	Y 座標	辺 長	方 向 角	測 角	DX	倍 積 (Y×DX)
206-136	40618.967	-68341.300	6.758	359-09-38	90-03-24	6.957	-475450.424100
206-30	40625.724	-68341.399	12.466	269-23-36	90-13-58	6.625	-452761.768375
206-6	40625.592	-68353.864	6.829	181-51-17	92-27-41	-6.957	475537.831848
206-137	40618.767	-68354.085	12.787	89-06-14	87-14-57	-6.625	452845.813125
						倍面積	171.452498
						面 積	85.7262490

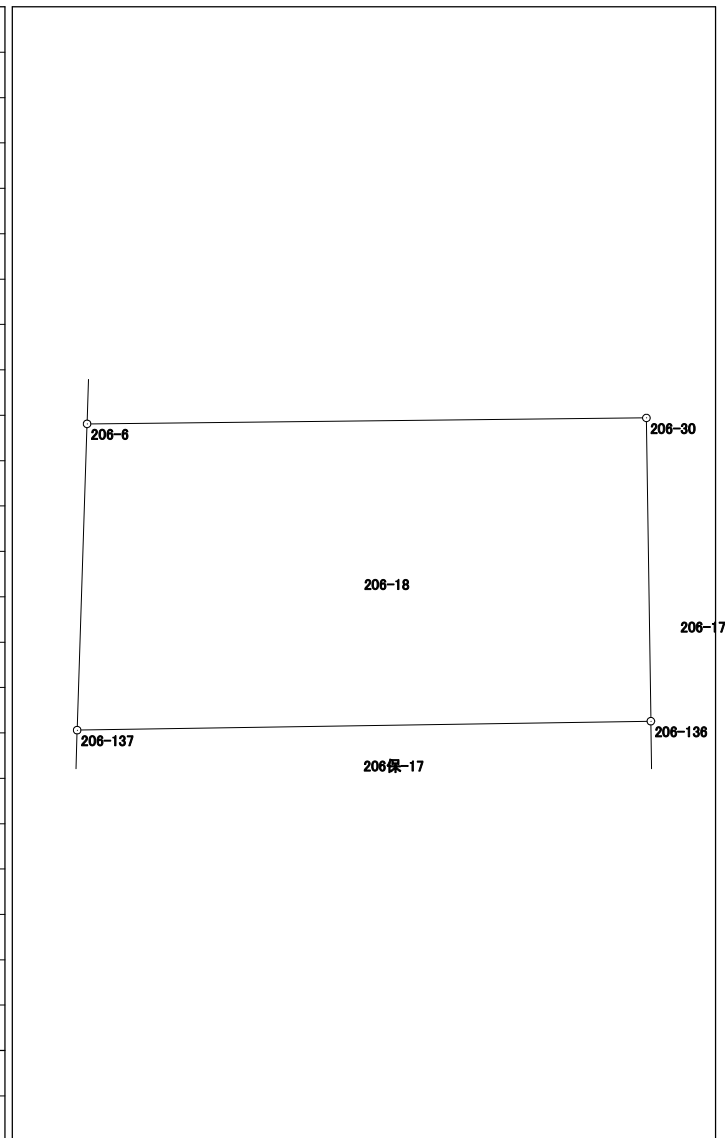


面積計算書 (座標法)

世界測地系 (測地成果2011)

所 在	地 番	公簿地目	現況地目	地 積	所 有 者
前橋市六供町三丁目	206-保-3			28.00 m ²	

点 名	X 座標	Y 座標	辺 長	方 向 角	測 角	DX	倍 積 (Y×DX)
206-33	40615.088	-68327.420	12.772	269-06-10	90-56-30	1.077	-73588.631340
206-32	40614.888	-68340.190	2.133	179-01-59	89-55-49	-2.333	159437.663270
206-132	40612.755	-68340.154	0.057	178-59-42	179-57-43	-2.190	149664.937260
206-129	40612.698	-68340.153	12.792	89-06-15	90-06-33	0.143	-9772.641879
206-130	40612.898	-68327.363	0.913	358-59-46	89-53-31	1.113	-76048.355019
206-34	40613.811	-68327.379	1.278	358-09-40	179-09-54	2.190	-149636.960010
						倍面積	56.012282
						面 積	28.0061410

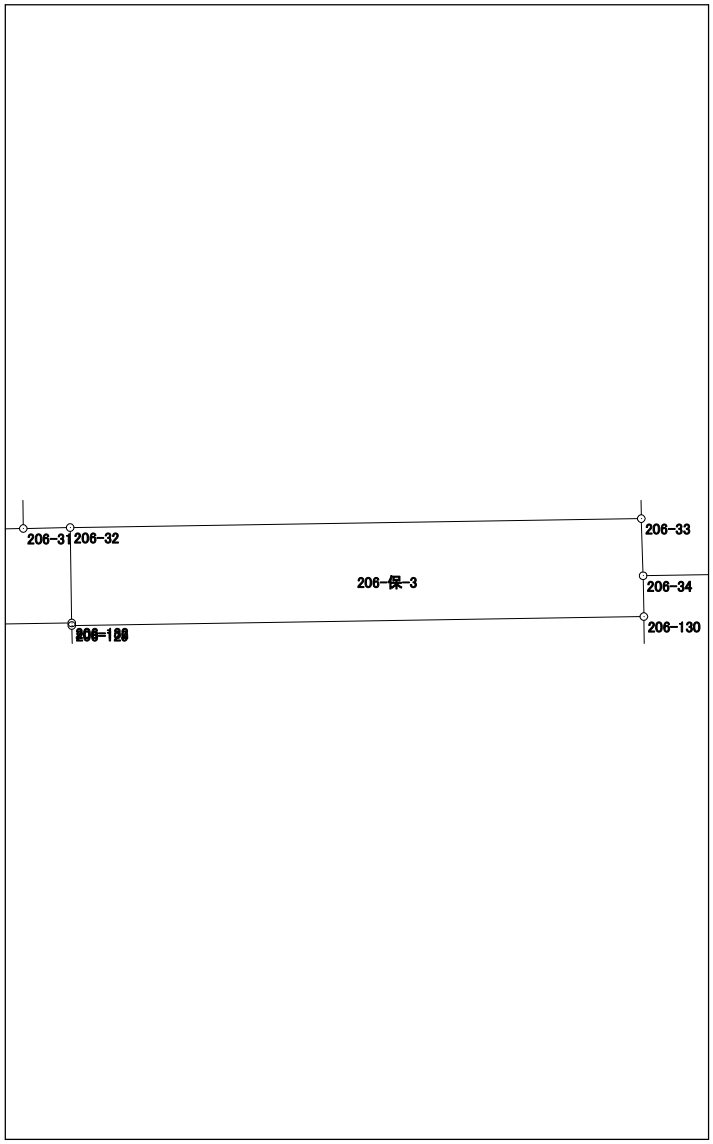


面積計算書（座標法）

世界測地系（測地成果2011）

所在	地番	公簿地目	現況地目	地積	所有者
前橋市六供町三丁目	206-保-4			30.00 m ²	

点名	X座標	Y座標	辺長	方向角	測角	Dx	倍積 (Y×Dx)
206-8	40614.669	-68354.213	2.136	181-49-27	92-41-54	-2.333	159470.378929
206-131	40612.534	-68354.281	14.129	89-06-13	87-16-46	-1.914	130830.093834
206-132	40612.755	-68340.154	2.133	359-01-59	89-55-46	2.354	-160872.722516
206-32	40614.888	-68340.190	1.048	268-51-07	89-49-08	2.112	-144334.481280
206-31	40614.867	-68341.238	12.977	269-07-33	180-16-26	-0.219	14966.731122
						倍面積	60.000089
						面積	30.0000445

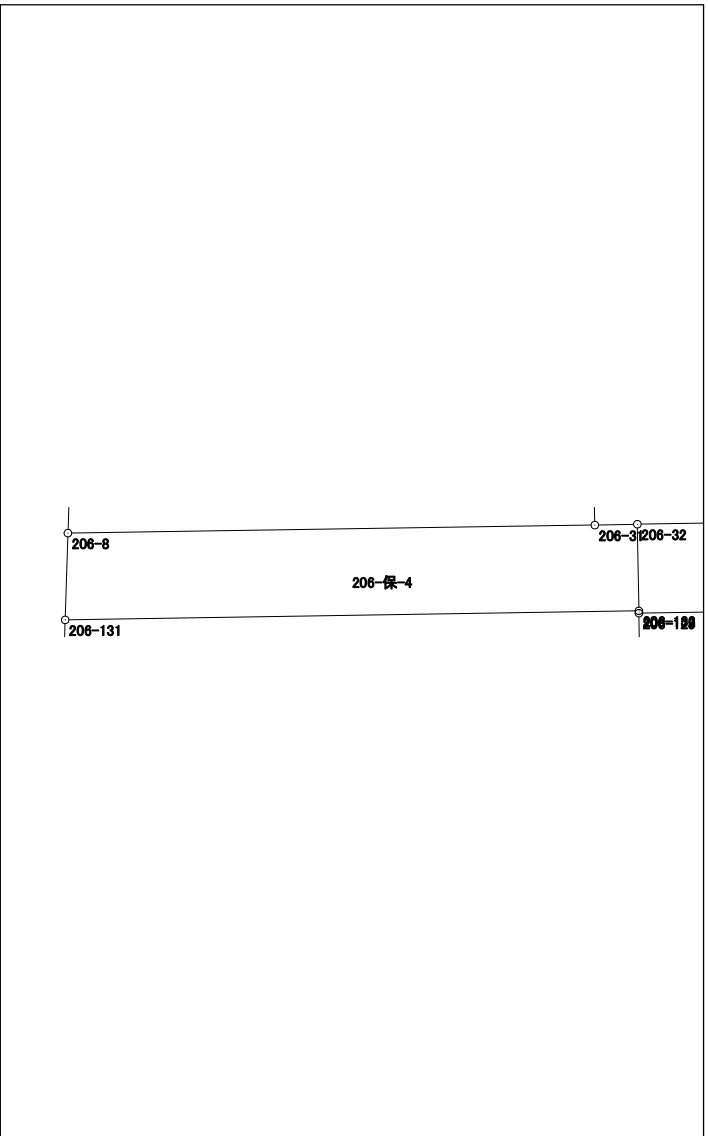


面積計算書 (座標法)

世界測地系 (測地成果2011)

所在	地番	公簿地目	現況地目	地積	所有者
前橋市六供町三丁目	206-保-5			30.00 m ²	

点名	X座標	Y座標	辺長	方向角	測角	D _X	倍積 (Y×D _X)
206-36	40590.011	-68329.102	2.114	89-01-28	179-54-05	0.190	-12982.529380
206-39	40590.047	-68326.988	2.239	359-04-44	90-03-16	2.275	-155443.897700
206-124	40592.286	-68327.024	13.423	269-03-24	89-58-40	2.018	-137883.934432
206-125	40592.065	-68340.445	0.213	178-55-27	89-52-03	-0.434	29659.753130
206-126	40591.852	-68340.441	2.025	179-03-59	180-08-32	-2.238	152945.906958
206-123-1	40589.827	-68340.408	1.246	88-37-15	89-33-16	-1.995	136339.113960
206-119	40589.857	-68339.162	10.061	89-07-23	180-30-08	0.184	-12574.405808

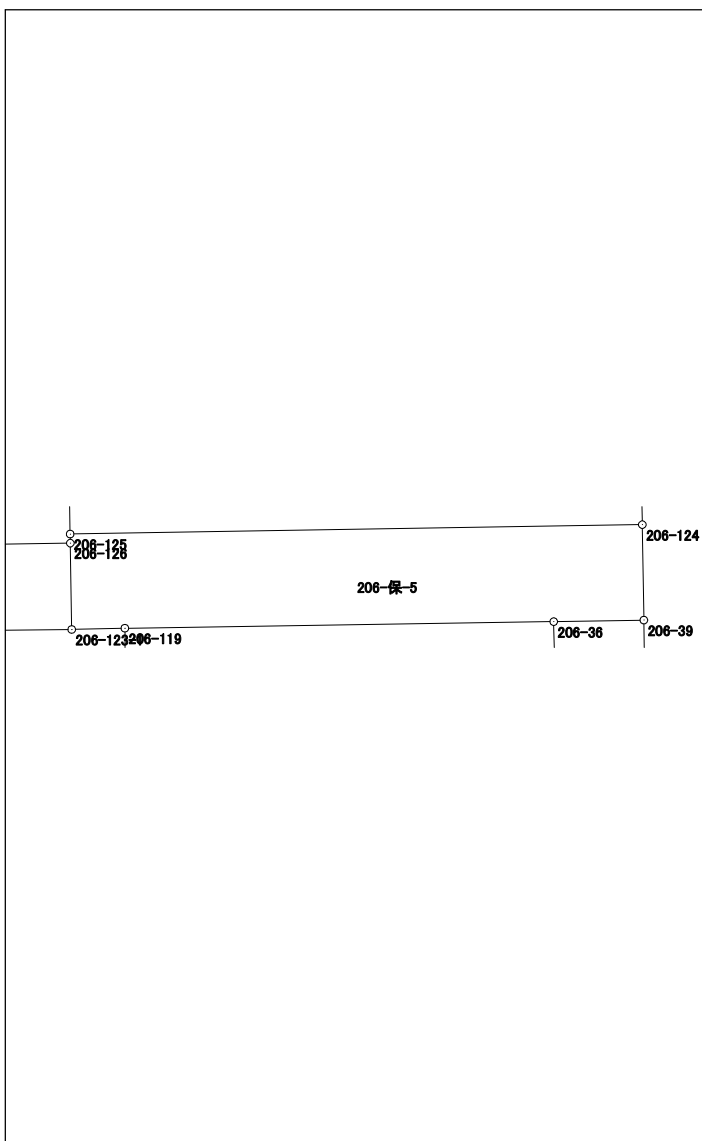

倍面積	60.006728
面積	30.0033640

面積計算書（座標法）

世界測地系（測地成果2011）

所在	地番	公簿地目	現況地目	地積	所有者
前橋市六供町三丁目	206-保-6			33.00 m ²	

点名	X座標	Y座標	辺長	方向角	測角	DX	倍積 (Y×DX)	
206-12	40589.581	-68356.948	13.829	89-06-33	78-21-12	-1.817	124204.574516	
206-35	40589.796	-68343.121	0.661	89-08-00	180-01-27	0.225	-15377.202225	
206-117	40589.806	-68342.460	2.052	89-24-49	180-16-49	0.031	-2118.616260	
206-123-1	40589.827	-68340.408	2.025	359-03-59	89-39-10	2.046	-139824.474768	
206-126	40591.852	-68340.441	16.123	269-09-02	90-05-03	1.786	-122056.027626	
206-127	40591.613	-68356.562	2.068	190-45-21	101-36-19	-2.271	155237.752302	
						倍面積	66.005939	
						面積	33.0029695	

面積計算書 (座標法)

世界測地系 (測地成果2011)

所在	地番	公簿地目	現況地目	地積	所有者
前橋市六供町三丁目	206-保-7			9.00 m ²	


点名	X座標	Y座標	辺長	方向角	測角	DX	倍積 (Y×DX)
206-37	40587.837	-68317.210	0.546	178-57-03	89-52-57	-0.814	55610.208940
206-111	40587.291	-68317.200	16.483	89-04-06	90-07-03	-0.278	18992.181600
206-112	40587.559	-68300.719	0.546	359-03-20	89-59-14	0.814	-55596.785266
206-19	40588.105	-68300.728	16.484	269-04-06	90-00-46	0.278	-18987.602384
						倍面積	18.002890
						面積	9.0014450

面積計算書 (座標法)

世界測地系 (測地成果2011)

所在	地番	公簿地目	現況地目	地積	所有者
前橋市六供町三丁目	206-保-8			50.00 m ²	

点名	X座標	Y座標	辺長	方向角	測角	DX	倍積 (Y×DX)
206-112	40587.559	-68300.719	16.483	269-04-06	89-58-29	2.766	-188919.788754
206-111	40587.291	-68317.200	3.034	178-58-49	89-54-43	-3.302	225583.394400
206-114	40584.257	-68317.146	16.477	89-04-05	90-05-16	-2.766	188965.225836
206-115	40584.525	-68300.671	3.034	359-05-37	90-01-32	3.302	-225528.815642
						倍面積	100.015840
						面積	50.0079200

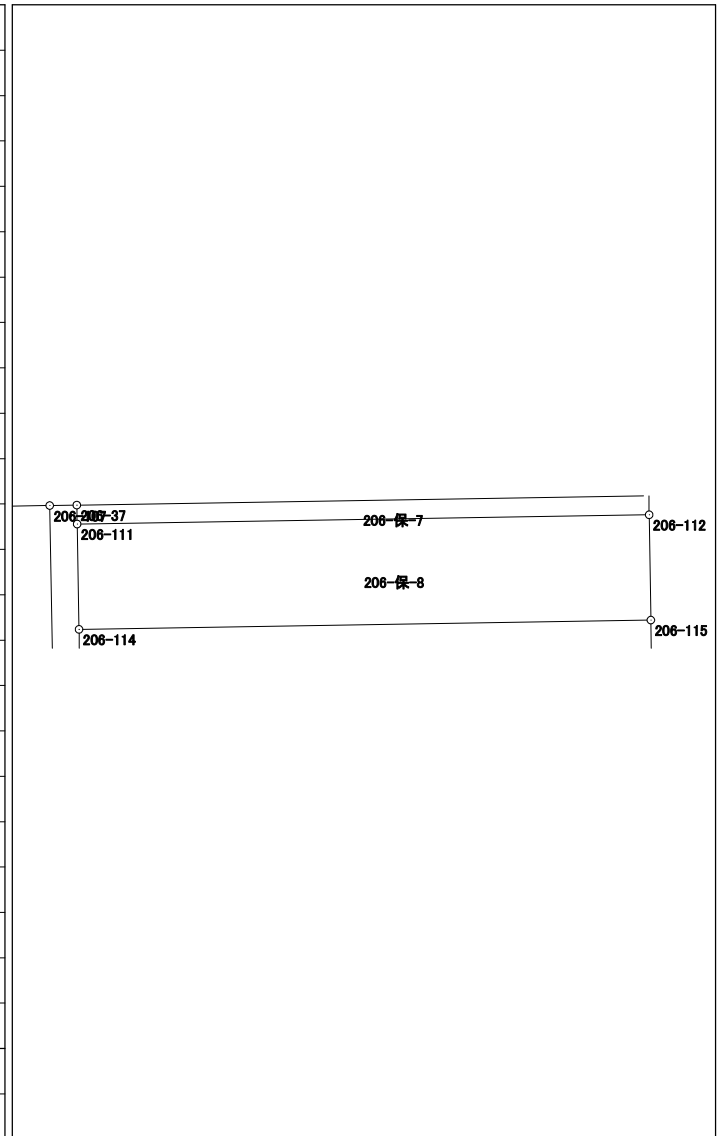


面積計算書（座標法）

世界測地系（測地成果2011）

所在	地番	公簿地目	現況地目	地積	所有者
前橋市六供町三丁目	206-保-9			9.00 m ²	

点名	X座標	Y座標	辺長	方向角	測角	DX	倍積 (Y×DX)
206-17	40576.305	-68317.003	7.953	358-58-11	89-11-23	7.955	-543461.758865
206-114	40584.257	-68317.146	3.034	358-58-49	180-00-38	10.986	-750532.165956
206-111	40587.291	-68317.200	0.546	358-57-03	179-58-14	3.580	-244575.576000
206-37	40587.837	-68317.210	0.781	269-02-47	90-05-44	0.533	-36413.072930
206-107	40587.824	-68317.991	11.524	178-58-15	89-55-28	-11.535	788048.026185
206-108	40576.302	-68317.784	0.781	89-46-48	90-48-33	-11.519	786952.553896
						倍面積	18.006330
						面積	9.0031650

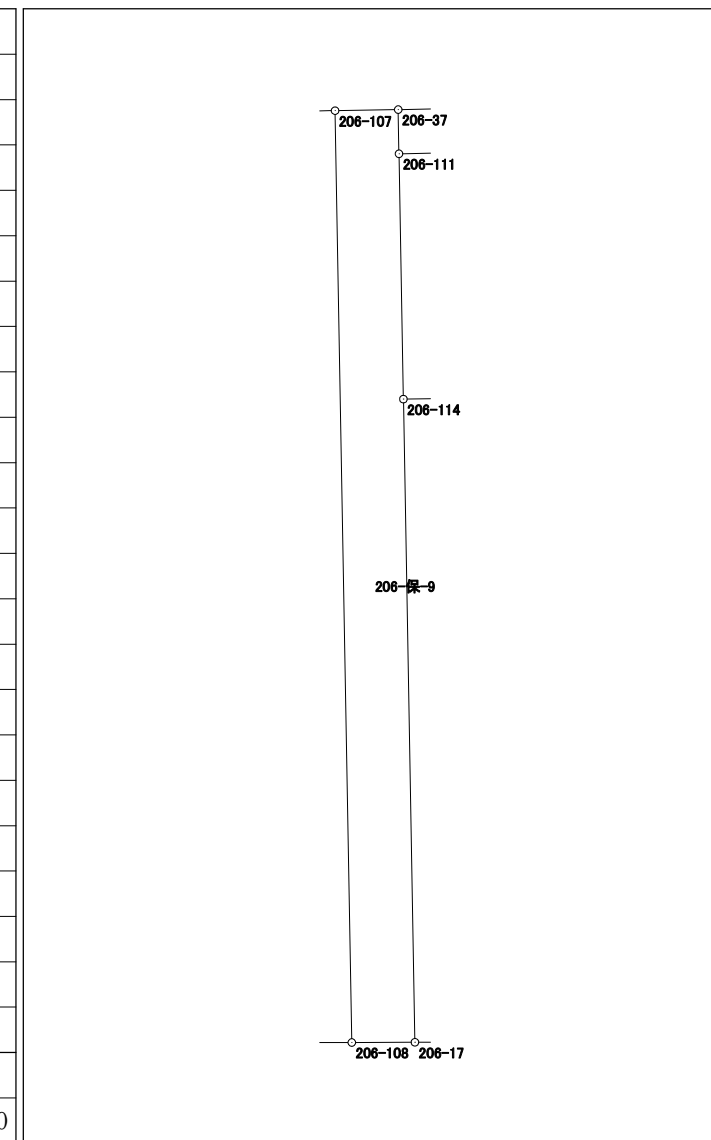


面積計算書（座標法）

世界測地系（測地成果2011）

所 在	地 番	公簿地目	現況地目	地 積	所 有 者
前橋市六供町三丁目	206-保-10			22.00 m ²	

点 名	X 座 標	Y 座 標	辺 長	方 向 角	測 角	DX	倍 積 (Y×DX)
206-108	40576.302	-68317.784	11.524	358-58-15	89-12-38	11.530	-787704.049520
206-107	40587.824	-68317.991	1.911	269-00-38	90-02-23	11.489	-784905.398599
206-109	40587.791	-68319.902	11.499	178-58-25	89-57-47	-11.530	787728.470060
206-110	40576.294	-68319.696	1.912	89-45-37	90-47-12	-11.489	784924.987344

倍面積	44.009285
面 積	22.0046425

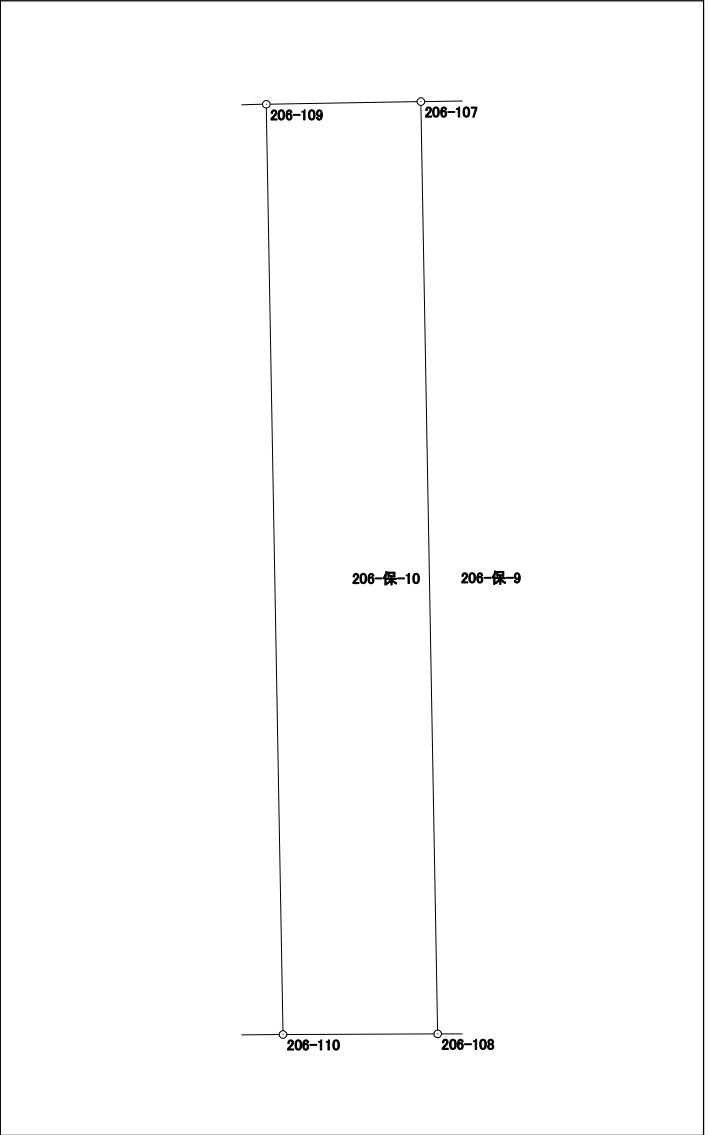


面積計算書 (座標法)

世界測地系 (測地成果2011)

所在	地番	公簿地目	現況地目	地積	所有者
前橋市六供町三丁目	206保-1			50.00 m ²	

点名	X座標	Y座標	辺長	方向角	測角	DX	倍積 (Y×DX)
206-2	40646.022	-68339.698	11.003	179-00-00	90-55-44	-11.154	762260.991492
206-101	40635.021	-68339.506	4.546	88-04-16	89-04-16	-10.848	741346.961088
206-105	40635.174	-68334.963	11.003	359-00-00	90-55-44	11.154	-762208.177302
206-106	40646.175	-68335.155	4.546	268-04-16	89-04-16	10.848	-741299.761440
						倍面積	100.013838
						面積	50.0069190

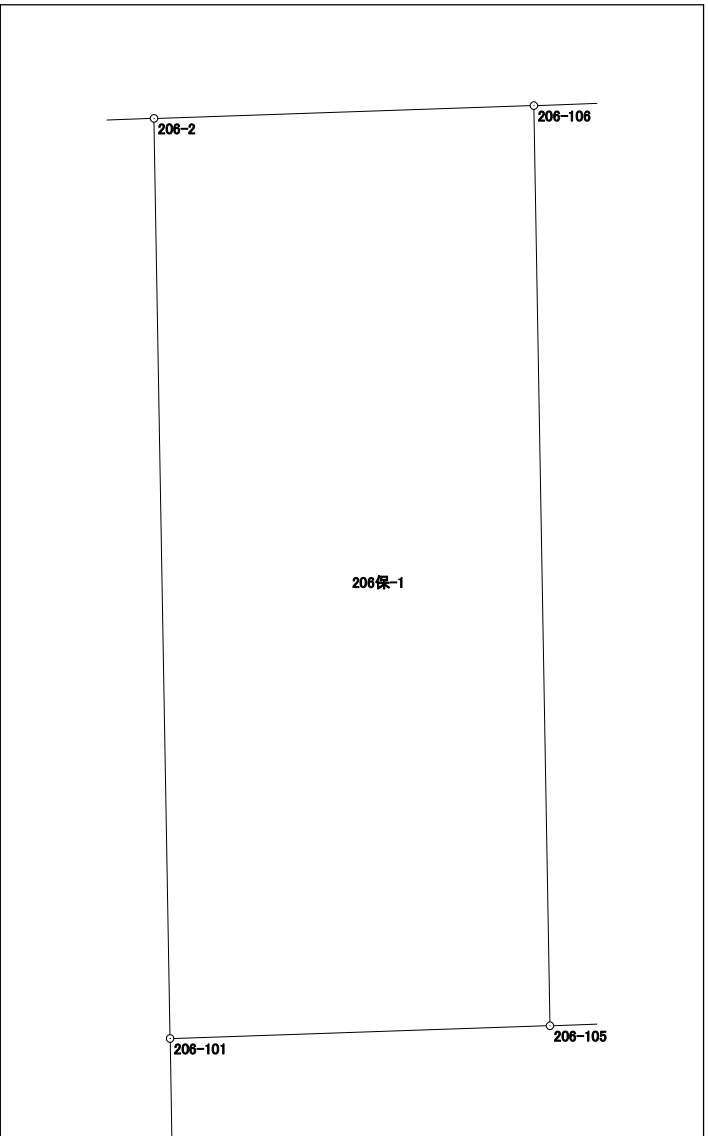


面積計算書（座標法）

世界測地系（測地成果2011）

所 在	地 番	公簿地目	現況地目	地 積	所 有 者
前橋市六供町三丁目	206保-2			50.00 m ²	

点 名	X 座標	Y 座標	辺 長	方 向 角	測 角	D _X	倍 積 (Y×DX)
206-27	40628.956	-68327.612	26.205	88-54-32	179-58-25	0.718	-49059.225416
206-21	40629.455	-68301.412	1.313	359-02-24	90-07-52	1.812	-123762.158544
206-103	40630.768	-68301.434	37.993	268-55-13	89-52-49	0.597	-40775.956098
206-104	40630.052	-68339.420	1.315	178-59-53	90-04-40	-2.031	138797.362020
206-29	40628.737	-68339.397	11.787	88-56-07	89-56-14	-1.096	74899.979112

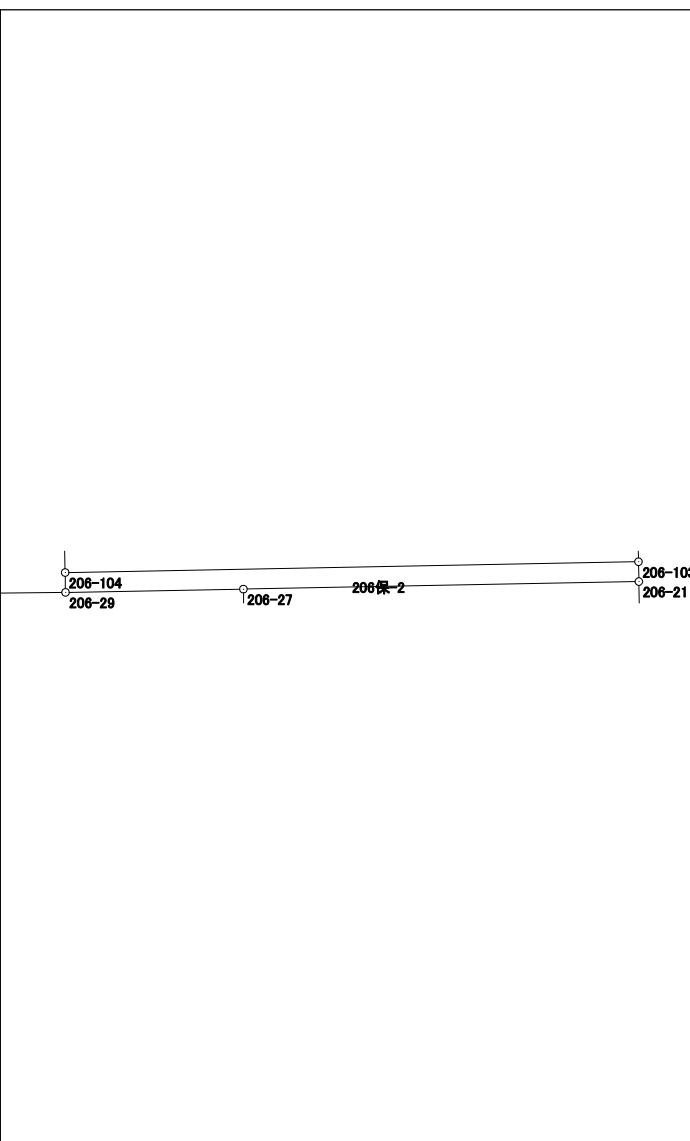

倍面積	100.001074
面 積	50.0005370

面積計算書 (座標法)

世界測地系 (測地成果2011)

所在	地番	公簿地目	現況地目	地積	所有者
前橋市六供町三丁目	206保-11			5.04 m ²	

点名	X座標	Y座標	辺長	方向角	測角	DX	倍積 (Y×DX)
206-36	40590.011	-68329.102	2.386	179-02-22	90-00-54	-2.422	165493.085044
206-113	40587.625	-68329.062	2.118	88-46-58	89-44-36	-2.341	159958.334142
206-38	40587.670	-68326.944	2.377	358-56-22	90-09-24	2.422	-165487.858368
206-39	40590.047	-68326.988	2.114	269-01-28	90-05-06	2.341	-159953.478908
倍面積							10.081910
面積							5.0409550


Diagram illustrating the surveyed area (206保-11) with vertices labeled 206-36, 206-39, 206-38, and 206-113.

面積計算書（座標法）

世界測地系（測地成果2011）

所 在	地 番	公簿地目	現況地目	地 積	所 有 者
前橋市六供町三丁目	206保-12			45.00 m ²	

点 名	X 座標	Y 座標	辺 長	方 向 角	測 角	DX	倍 積 (Y×DX)
206-116	40576.182	-68342.268	3.299	89-42-17	90-30-44	-13.607	929933.240676
206-118	40576.199	-68338.969	12.659	359-12-12	89-29-55	12.675	-866196.432075
206-119-1	40588.857	-68339.145	1.000	359-01-34	179-49-22	13.658	-933376.042410
206-119	40589.857	-68339.162	1.246	268-37-15	89-35-41	0.970	-66288.987140
206-123-1	40589.827	-68340.408	2.052	269-24-49	180-47-34	-0.051	3485.360808
206-117	40589.806	-68342.460	13.625	179-11-33	89-46-44	-13.645	932532.866700
						倍面積	90.006559
						面 積	45.0032795

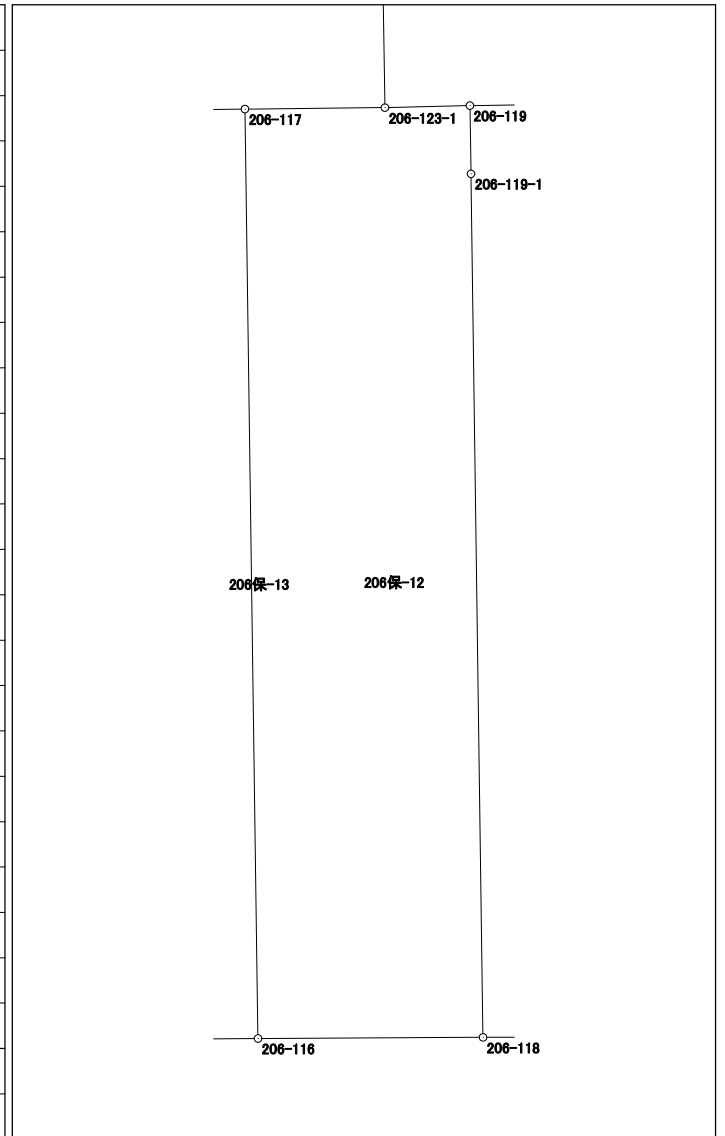


面積計算書（座標法）

世界測地系（測地成果2011）

所在	地番	公簿地目	現況地目	地積	所有者
前橋市六供町三丁目	206保-13			9.00 m ²	

点名	X 座標	Y 座標	辺長	方向角	測角	DX	倍積 (Y×DX)
206-35	40589.796	-68343.121	3.739	179-11-16	90-03-16	-3.749	256218.360629
206-121	40586.057	-68343.068	9.879	179-11-38	180-00-22	-13.617	930627.556956
206-15	40576.179	-68342.929	0.661	89-44-24	90-32-46	-9.875	674886.423875
206-116	40576.182	-68342.268	13.625	359-11-33	89-27-09	13.627	-931300.086036
206-117	40589.806	-68342.460	0.661	269-08-00	89-56-27	13.614	-930414.250440

倍面積	18.004984
面積	9.0024920

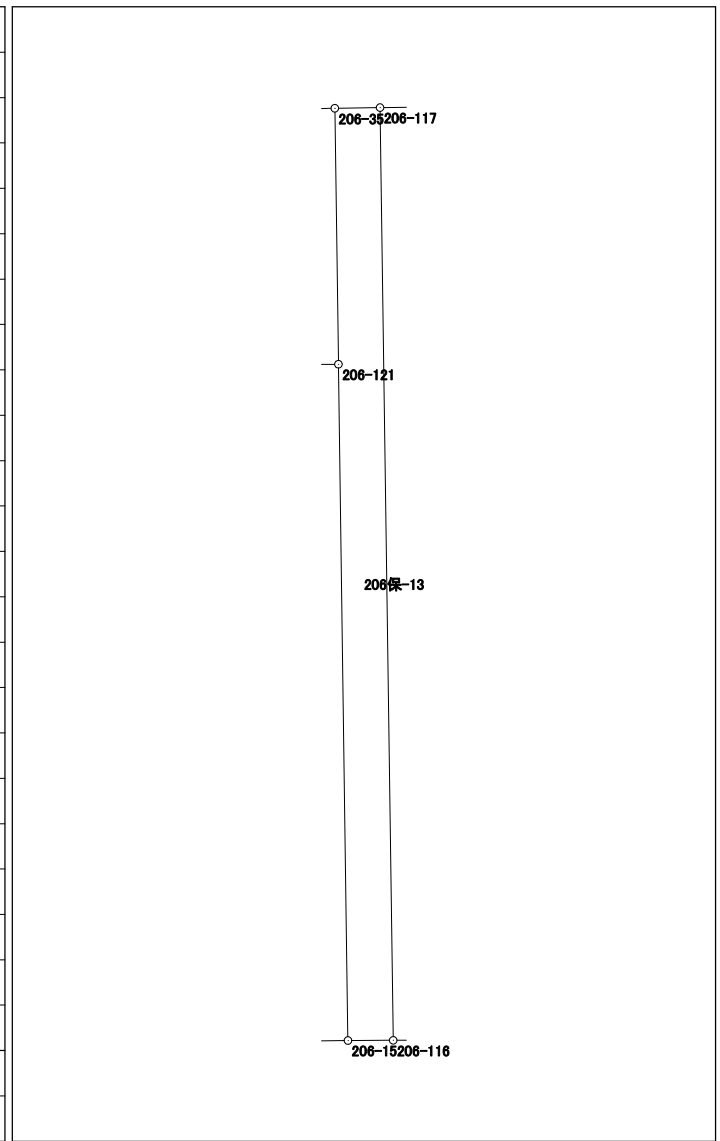


面積計算書（座標法）

世界測地系（測地成果2011）

所在	地番	公簿地目	現況地目	地積	所有者
前橋市六供町三丁目	206保-15			50.00 m ²	

点名	X座標	Y座標	辺長	方向角	測角	DX	倍積 (Y×DX)
206-139	40627.737	-68339.380	2.000	178-59-51	269-43-00	-1.819	124309.332220
206-140	40625.737	-68339.345	11.777	88-56-04	89-56-13	-1.781	121712.373445
206-138	40625.956	-68327.570	3.000	359-11-52	90-15-48	3.219	-219946.447830
206-27	40628.956	-68327.612	11.787	268-56-07	89-44-15	2.781	-190019.088972
206-29	40628.737	-68339.397	14.370	269-25-19	180-29-12	-0.364	24875.540508
206-5	40628.592	-68353.766	1.037	181-52-47	92-27-28	-1.181	80725.797646
206-141	40627.556	-68353.800	14.421	89-16-51	87-24-04	-0.855	58442.499000
						倍面積	100.006017
						面積	50.0030085

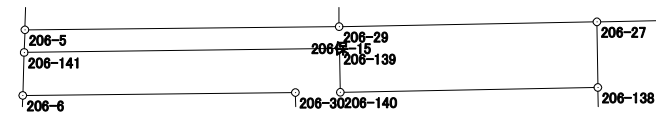

面積計算書 (座標法)

世界測地系 (測地成果2011)

所在	地番	公簿地目	現況地目	地積	所有者
前橋市六供町三丁目	206保-16			4.00 m ²	

点名	X座標	Y座標	辺長	方向角	測角	DX	倍積 (Y×DX)	
206-7	40617.128	-68354.138	12.865	89-06-17	87-16-08	-0.111	7587.309318	
206-133	40617.329	-68341.275	0.311	359-04-44	89-58-27	0.512	-34990.732800	
206-134	40617.640	-68341.280	12.850	269-06-29	90-01-45	0.111	-7585.882080	
206-135	40617.440	-68354.128	0.312	181-50-09	92-43-40	-0.512	34997.313536	
							倍面積	8.007974
							面積	4.0039870


Diagram showing a horizontal line with points labeled 206-135, 206-7, 206保-16, 206-134, and 206-133. The line connects the X-coordinates of points 206-135 and 206-134, representing the width of the area.

面積計算書 (座標法)

世界測地系 (測地成果2011)

所在	地番	公簿地目	現況地目	地積	所有者
前橋市六供町三丁目	206保-17			17.00 m ²	

点名	X座標	Y座標	辺長	方向角	測角	DX	倍積 (Y×DX)
206-134	40617.640	-68341.280	1.327	359-08-11	90-01-42	1.527	-104357.134560
206-136	40618.967	-68341.300	12.787	269-06-14	89-58-03	1.127	-77020.645100
206-137	40618.767	-68354.085	1.328	181-51-21	92-45-07	-1.527	104376.687795
206-135	40617.440	-68354.128	12.850	89-06-29	87-15-08	-1.127	77035.102256
						倍面積	34.010391
						面積	17.0051955

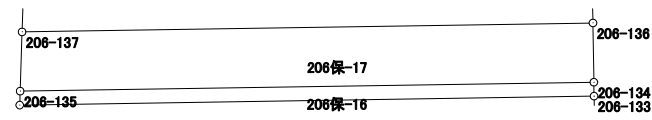


面積計算書（座標法）

世界測地系（測地成果2011）

所 在	地 番	公簿地目	現況地目	地 積	所 有 者
前橋市六供町三丁目	206保-18			31.78 m ²	

点 名	X 座標	Y 座標	辺 長	方 向 角	測 角	DX	倍 積 (Y×DX)
206-7	40617.128	-68354.138	2.460	181-44-49	92-38-32	-2.660	181822.007080
206-8	40614.669	-68354.213	12.977	89-07-33	87-22-44	-2.261	154548.875593
206-31	40614.867	-68341.238	2.462	359-08-20	90-00-47	2.660	-181787.693080
206-133	40617.329	-68341.275	12.865	269-06-17	89-57-57	2.261	-154519.622775

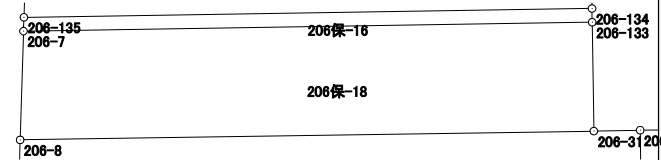

倍面積	63.566818
面 積	31.7834090