



20街区 画地出来形確認図 (2367.58m²)

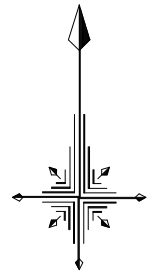

S=1/500

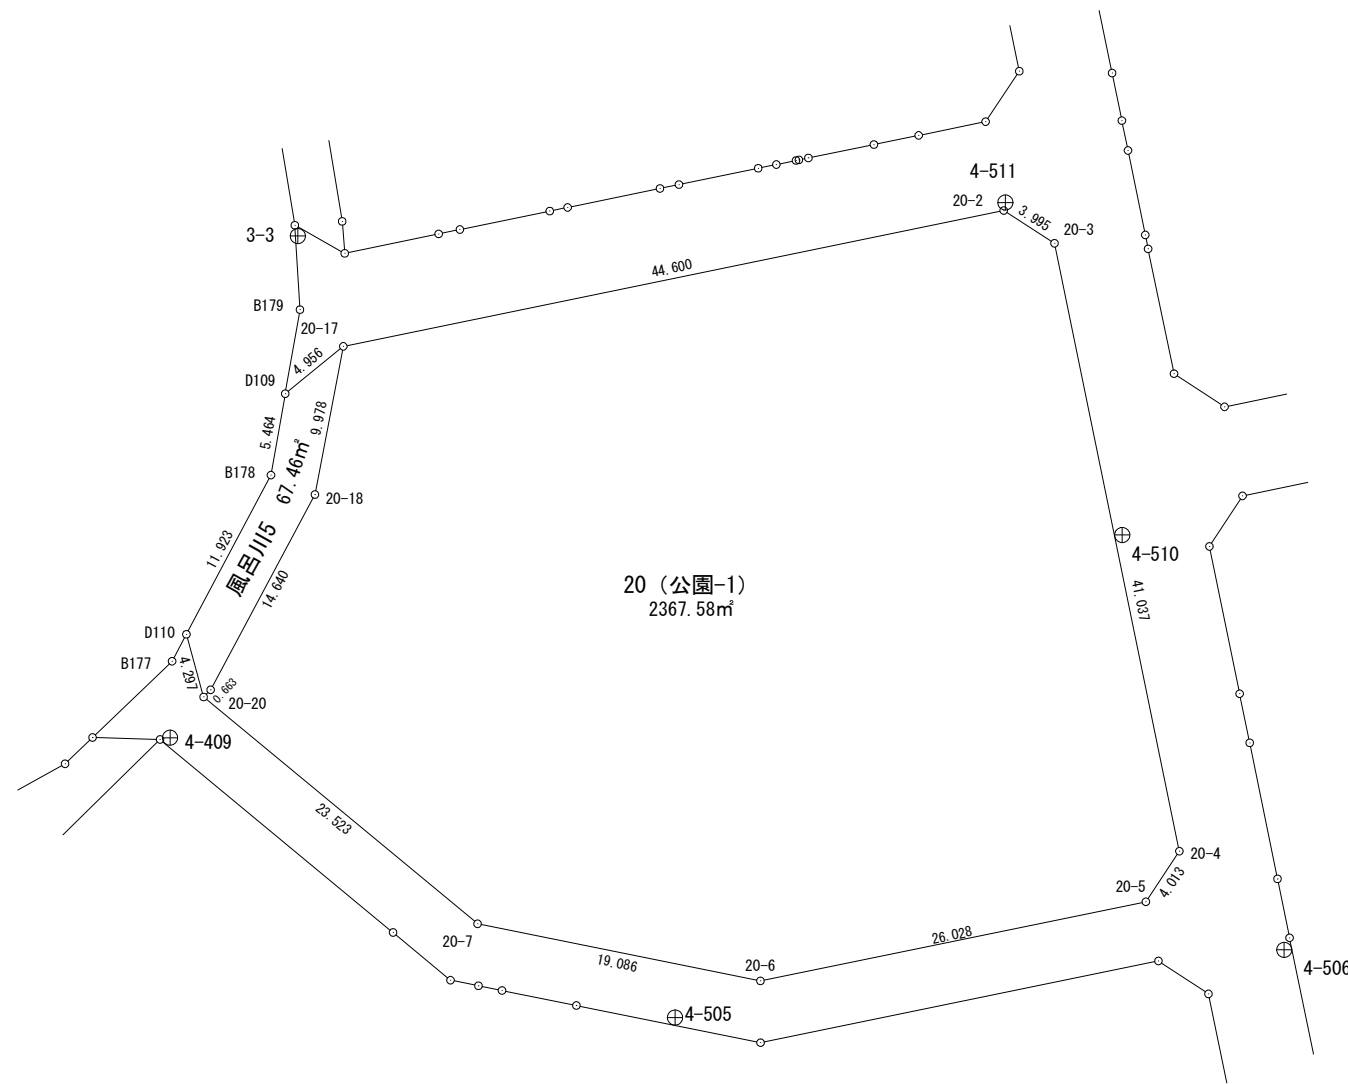

面積計算書（座標法）

世界測地系（測地成果2011）

| 所在 | 地番 | 公簿地目 | 現況地目 | 地積 | 所有者 |
|-----------|----------|------|------|------------------------|-----|
| 前橋市六供町一丁目 | 20（公園-1） | | | 2367.58 m ² | |

| 点名 | X座標 | Y座標 | 辺長 | 方向角 | 測角 | DX | 倍積 (Y×DX) |
|-------|-----------|------------|--------|-----------|-----------|---------|-----------------|
| 20-18 | 41643.510 | -68574.262 | 14.640 | 208-07-22 | 197-16-49 | -22.712 | 1557458.638544 |
| 20-19 | 41630.598 | -68581.163 | 0.663 | 224-16-01 | 196-08-39 | -13.387 | 918096.029081 |
| 20-20 | 41630.123 | -68581.626 | 23.523 | 129-36-47 | 85-20-46 | -15.473 | 1061163.499098 |
| 20-7 | 41615.125 | -68563.505 | 19.086 | 101-24-28 | 151-47-41 | -18.773 | 1287142.679365 |
| 20-6 | 41611.350 | -68544.796 | 26.028 | 78-24-22 | 156-59-54 | 1.456 | -99801.222976 |
| 20-5 | 41616.581 | -68519.299 | 4.013 | 33-32-08 | 135-07-46 | 8.576 | -587621.508224 |
| 20-4 | 41619.926 | -68517.082 | 41.037 | 348-23-12 | 134-51-04 | 43.542 | -2983370.784444 |
| 20-3 | 41660.123 | -68525.343 | 3.995 | 302-51-46 | 134-28-34 | 42.365 | -2903076.156195 |
| 20-2 | 41662.291 | -68528.699 | 44.600 | 258-22-59 | 135-31-13 | -6.813 | 466886.026287 |
| 20-17 | 41653.310 | -68572.385 | 9.978 | 190-50-33 | 112-27-34 | -18.781 | 1287857.962685 |
| | | | | | | | |
| | | | | | | | |
| | | | | | | 倍面積 | 4735.163221 |
| | | | | | | 面積 | 2367.5816105 |

