



22街区 画地出来形確認図 (2572.03m²)

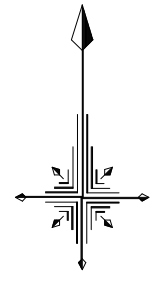

S=1/500

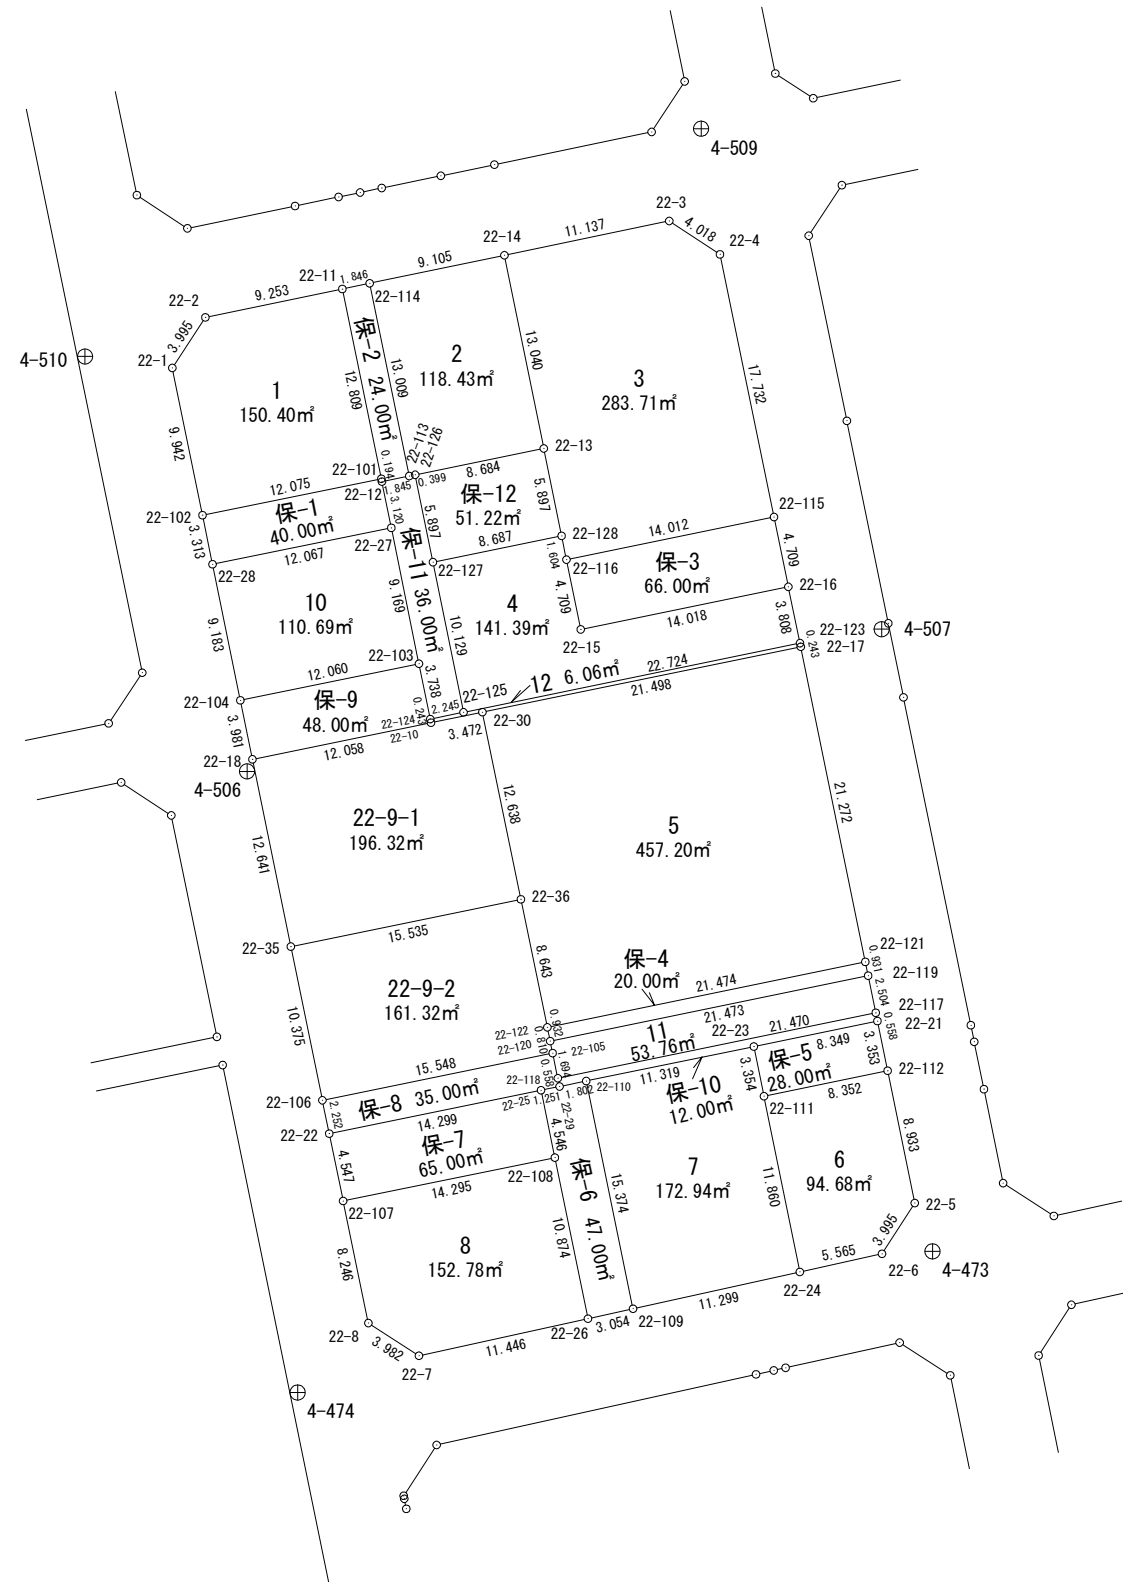


面積計算書 (座標法)

所在	地番	公簿地目	現況地目	地積	所有者
前橋市六供町一丁目	22-1			150.40 m ²	

点名	X座標	Y座標	辺長	方向角	測角	DX	倍積 (Y×DX)
22-101	41632.753	-68501.265	12.809	348-22-46	89-54-26	14.959	-1024710.423135
22-11	41645.299	-68503.845	9.253	258-17-48	89-55-02	10.669	-730867.522305
22-2	41643.422	-68512.906	3.995	213-11-34	134-53-46	-5.220	357637.369320
22-1	41640.079	-68515.093	9.942	168-24-43	135-13-09	-13.082	896314.446626
22-102	41630.340	-68513.096	12.075	78-28-20	90-03-37	-7.326	501926.941296


倍面積	300.811802
面積	150.4059010

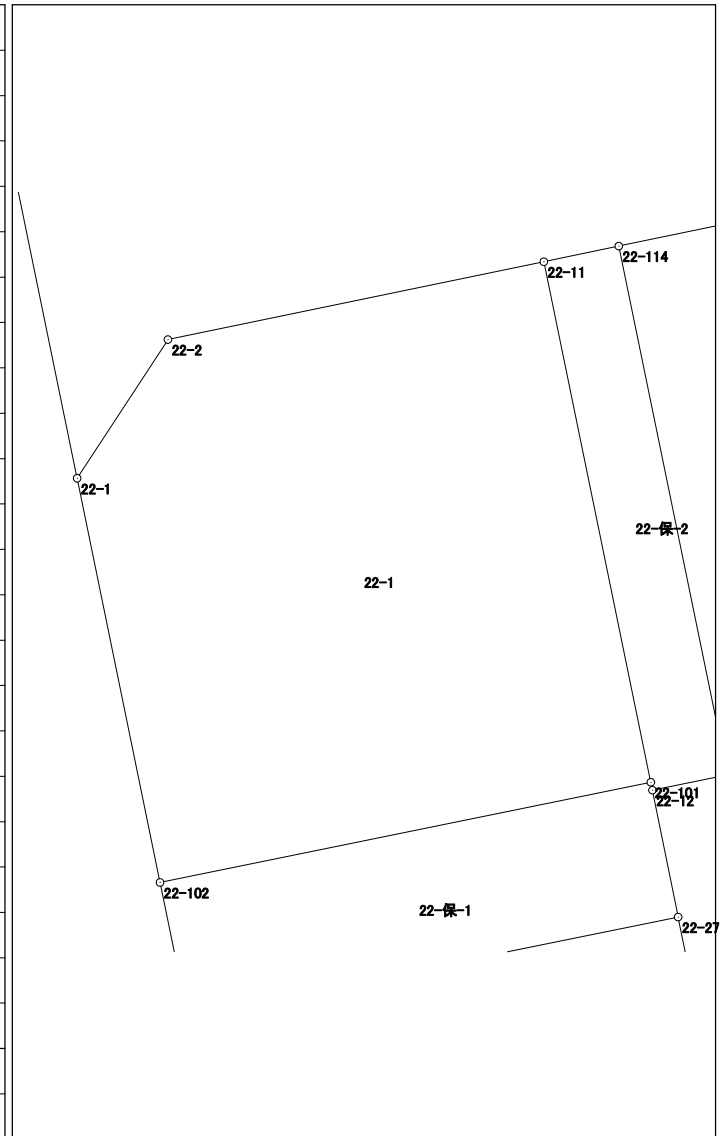

面積計算書 (座標法)

所在	地番	公簿地目	現況地目	地積	所有者
前橋市六供町一丁目	22-3			283.71 m ²	

点名	X座標	Y座標	辺長	方向角	測角	DX	倍積 (Y×DX)
22-115	41630.220	-68475.293	17.732	348-22-44	89-58-51	20.187	-1382310.739791
22-4	41647.589	-68478.865	4.018	303-21-14	134-58-30	19.578	-1340679.218970
22-3	41649.798	-68482.221	11.137	258-14-39	134-53-25	-0.060	4108.933260
22-14	41647.529	-68493.124	13.040	168-28-35	90-13-56	-15.046	1030547.543704
22-13	41634.752	-68490.519	5.897	168-28-02	179-59-27	-18.555	1270841.580045
22-128	41628.974	-68489.340	1.604	168-27-32	179-59-30	-7.350	503396.649000
22-116	41627.402	-68489.019	14.012	78-23-53	89-56-21	1.246	-85337.317674

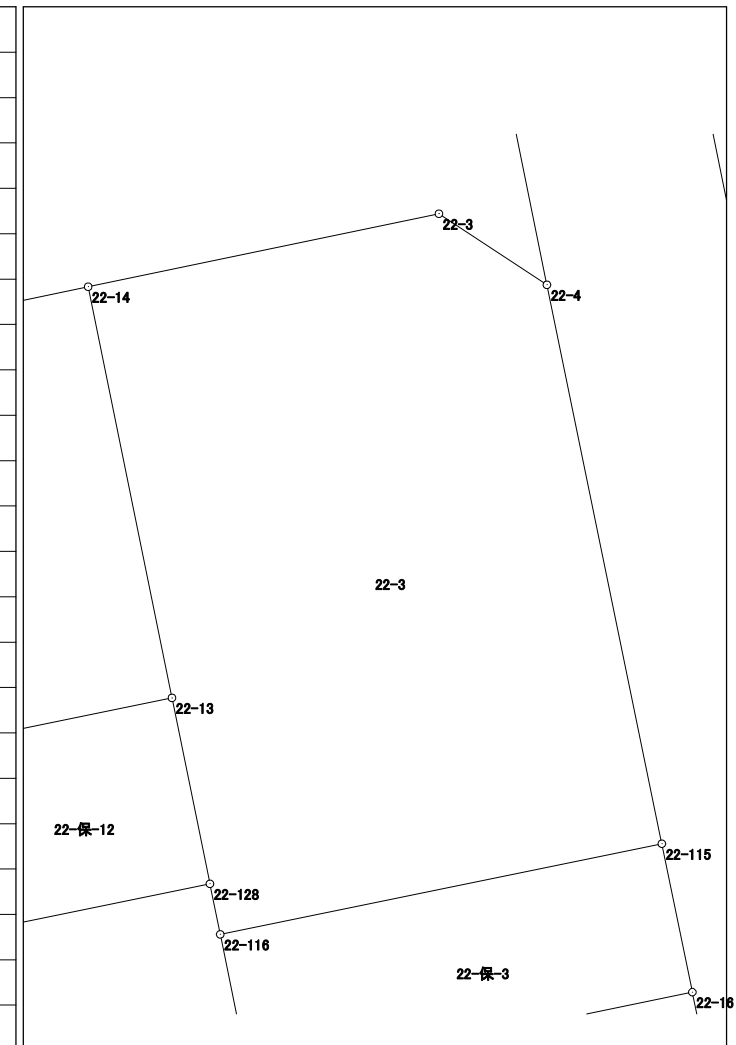


倍面積	567.429574
面積	283.7147870

面積計算書 (座標法)

世界測地系 (測地成果2011)

所在	地番	公簿地目	現況地目	地積	所有者
前橋市六供町一丁目	22-5			457.20 m ²	

点名	X座標	Y座標	辺長	方向角	測角	DX	倍積 (Y×DX)
22-121	41600.802	-68469.251	21.272	348-25-03	90-02-42	25.167	-1723165.639917
22-17	41621.641	-68473.522	21.498	258-23-49	89-58-46	16.515	-1130840.215830
22-30	41617.317	-68494.581	12.638	168-22-25	89-58-36	-16.703	1144064.986443
22-36	41604.938	-68492.034	8.643	168-19-06	179-56-41	-20.843	1427579.464662
22-122	41596.474	-68490.284	21.474	78-22-21	90-03-15	-4.136	283275.814624

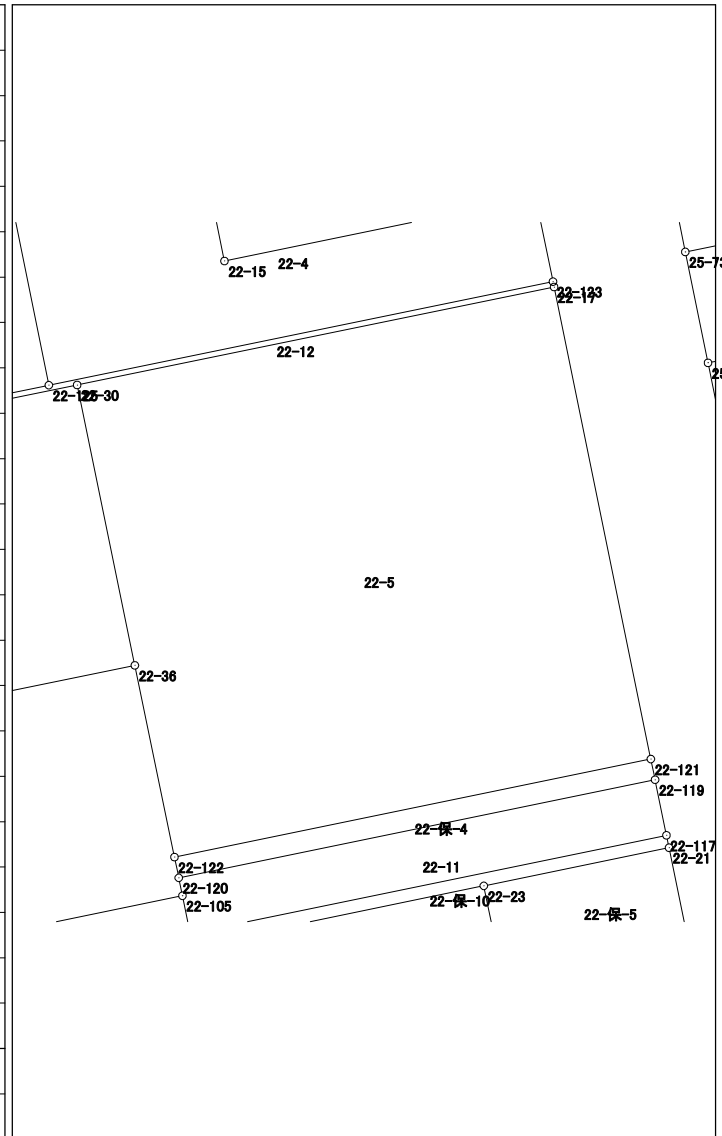


倍面積	914.409982
面積	457.2049910

面積計算書 (座標法)

世界測地系 (測地成果2011)

所在	地番	公簿地目	現況地目	地積	所有者
前橋市六供町一丁目	22-6			94.68 m ²	

点名	X座標	Y座標	辺長	方向角	測角	DX	倍積 (Y×DX)
22-111	41591.919	-68475.955	11.860	168-27-29	90-06-16	-13.306	911141.057230
22-24	41580.299	-68473.582	5.565	77-33-26	89-05-57	-10.421	713563.198022
22-6	41581.498	-68468.148	3.995	32-51-03	135-17-37	4.555	-311872.414140
22-5	41584.854	-68465.981	8.933	348-24-53	135-33-50	12.107	-828917.631967
22-112	41593.605	-68467.775	8.352	258-21-13	89-56-20	7.065	-483724.830375

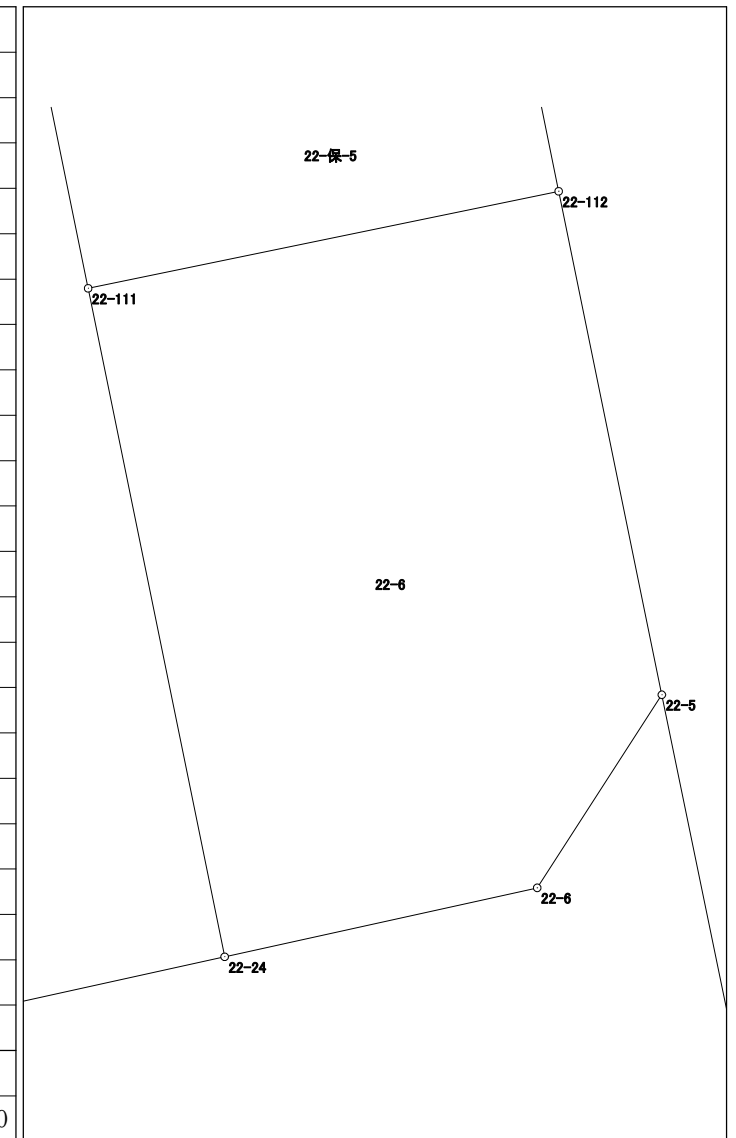


倍面積	189.378770
面積	94.6893850

面積計算書（座標法）

世界測地系（測地成果2011）

所在	地番	公簿地目	現況地目	地積	所有者
前橋市六供町一丁目	22-7			172.94 m ²	

点名	X座標	Y座標	辺長	方向角	測角	DX	倍積 (Y×DX)
22-109	41577.866	-68484.616	11.299	77-33-55	89-11-12	-12.626	864686.761616
22-24	41580.299	-68473.582	11.860	348-27-29	90-53-34	14.053	-962259.247846
22-111	41591.919	-68475.955	3.354	348-27-32	180-00-03	14.906	-1020702.585230
22-23	41595.205	-68476.626	11.319	258-22-46	89-55-14	1.006	-68887.485756
22-110	41592.925	-68487.713	15.374	168-22-43	89-59-57	-17.339	1187508.455707

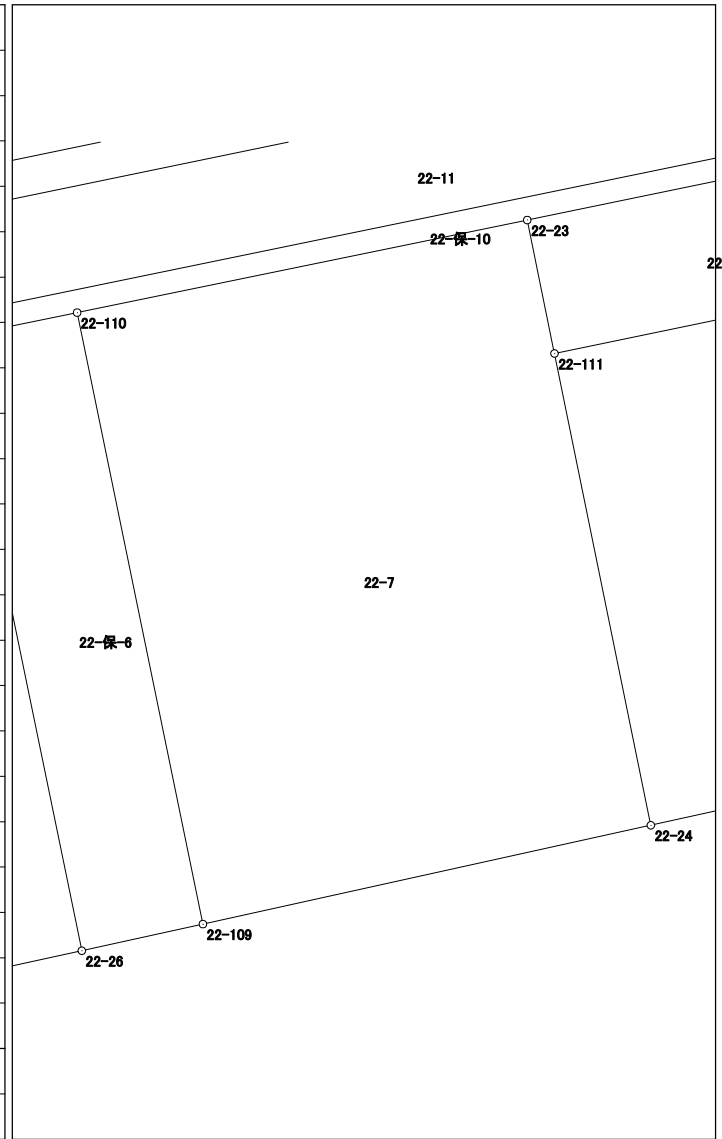

倍面積	345.898491
面積	172.9492455

面積計算書 (座標法)

世界測地系 (測地成果2011)

所 在	地 番	公簿地目	現況地目	地 積	所 有 者
前橋市六供町一丁目	22-9-2			161.32 m ²	


点 名	X 座標	Y 座標	辺 長	方 向 角	測 角	DX	倍 積 (Y×DX)	
22-35	41601.814	-68507.252	10.375	168-23-44	89-59-47	-13.287	910255.857324	
22-106	41591.651	-68505.165	15.548	78-26-06	90-02-22	-7.046	482687.392590	
22-105	41594.768	-68489.933	0.810	348-23-05	89-56-59	3.910	-267795.638030	
22-120	41595.561	-68490.096	0.932	348-21-53	179-58-48	1.706	-116844.103776	
22-122	41596.474	-68490.284	8.643	348-19-06	179-57-13	9.377	-642233.393068	
22-36	41604.938	-68492.034	15.535	258-23-57	90-04-51	5.340	-365747.461560	
							倍面積	322.653480
							面 積	161.3267400

面積計算書 (座標法)

世界測地系 (測地成果2011)

所在	地番	公簿地目	現況地目	地積	所有者
前橋市六供町一丁目	22-10			110.69 m ²	

点名	X座標	Y座標	辺長	方向角	測角	DX	倍積 (Y×DX)
22-103	41620.520	-68498.777	9.169	348-29-16	90-04-41	11.408	-781434.048016
22-27	41629.505	-68500.607	12.067	258-28-30	89-59-14	6.574	-450322.990418
22-28	41627.094	-68512.431	9.183	168-26-30	89-58-00	-11.408	781589.812848
22-104	41618.097	-68510.591	12.060	78-24-35	89-58-05	-6.574	450388.625234
						倍面積	221.399648
						面積	110.6998240

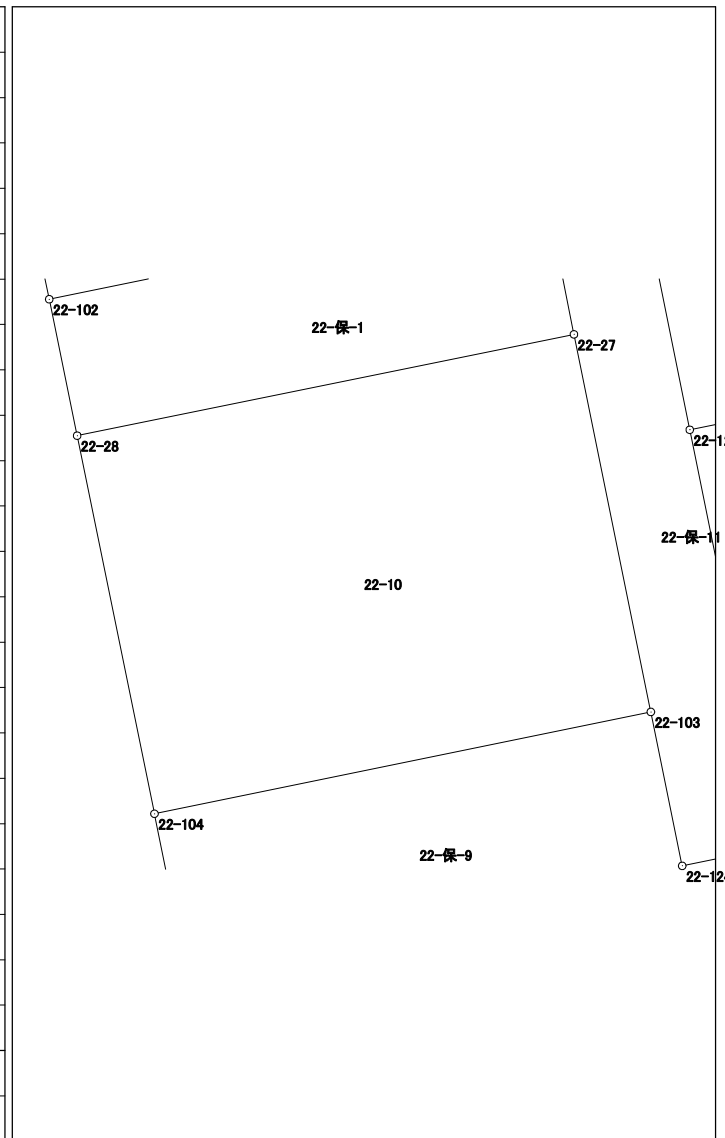


面積計算書 (座標法)

世界測地系 (測地成果2011)

所 在	地 番	公簿地目	現況地目	地 積	所 有 者
前橋市六供町一丁目	22-保-3			66.00 m ²	

点 名	X 座標	Y 座標	辺 長	方 向 角	測 角	DX	倍 積 (Y×DX)
22-15	41622.788	-68488.077	14.018	78-23-57	89-56-17	-1.795	122936.098215
22-16	41625.607	-68474.345	4.709	348-23-13	89-59-16	7.432	-508901.332040
22-115	41630.220	-68475.293	14.012	258-23-53	90-00-40	1.795	-122913.150935
22-116	41627.402	-68489.019	4.709	168-27-40	90-03-47	-7.432	509010.389208

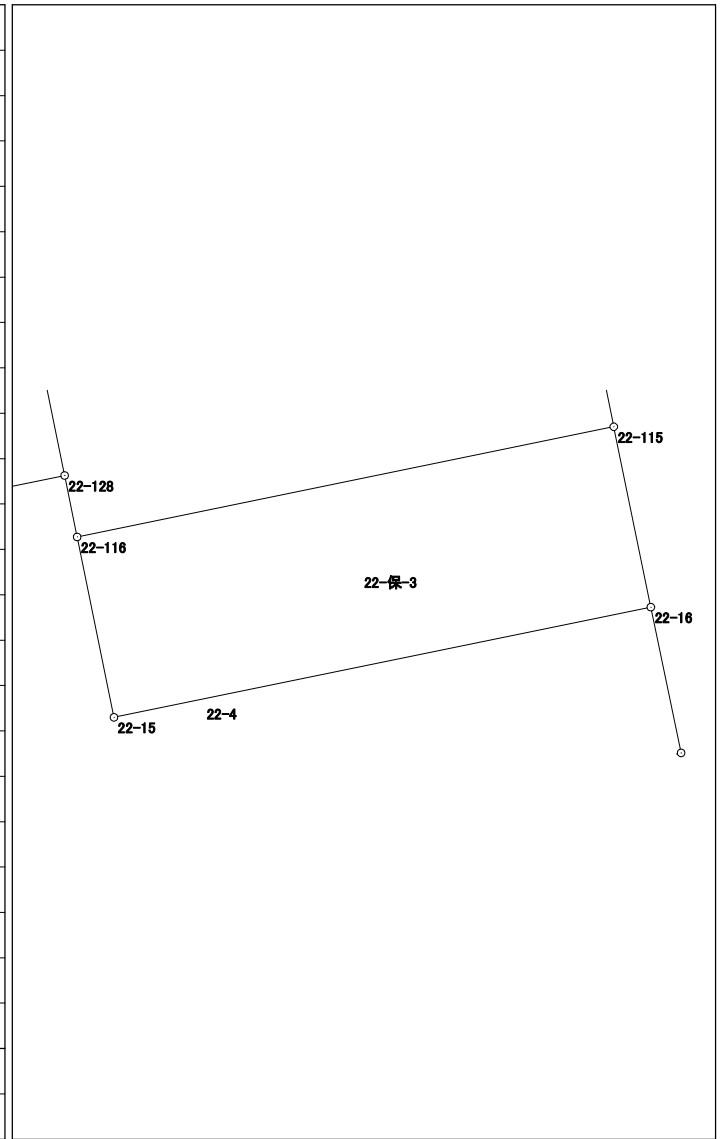


倍面積	132.004448
面 積	66.0022240

面積計算書 (座標法)

世界測地系 (測地成果2011)

所 在	地 番	公簿地目	現況地目	地 積	所 有 者
前橋市六供町一丁目	22-保-4			20.00 m ²	

点 名	X 座標	Y 座標	辺 長	方 向 角	測 角	DX	倍 積 (Y×DX)
22-120	41595.561	-68490.096	21.473	78-22-09	90-00-16	3.416	-233962.167936
22-119	41599.890	-68469.064	0.931	348-24-45	90-02-36	5.241	-358846.364424
22-121	41600.802	-68469.251	21.474	258-22-21	89-57-36	-3.416	233890.961416
22-122	41596.474	-68490.284	0.932	168-21-53	89-59-32	-5.241	358957.578444

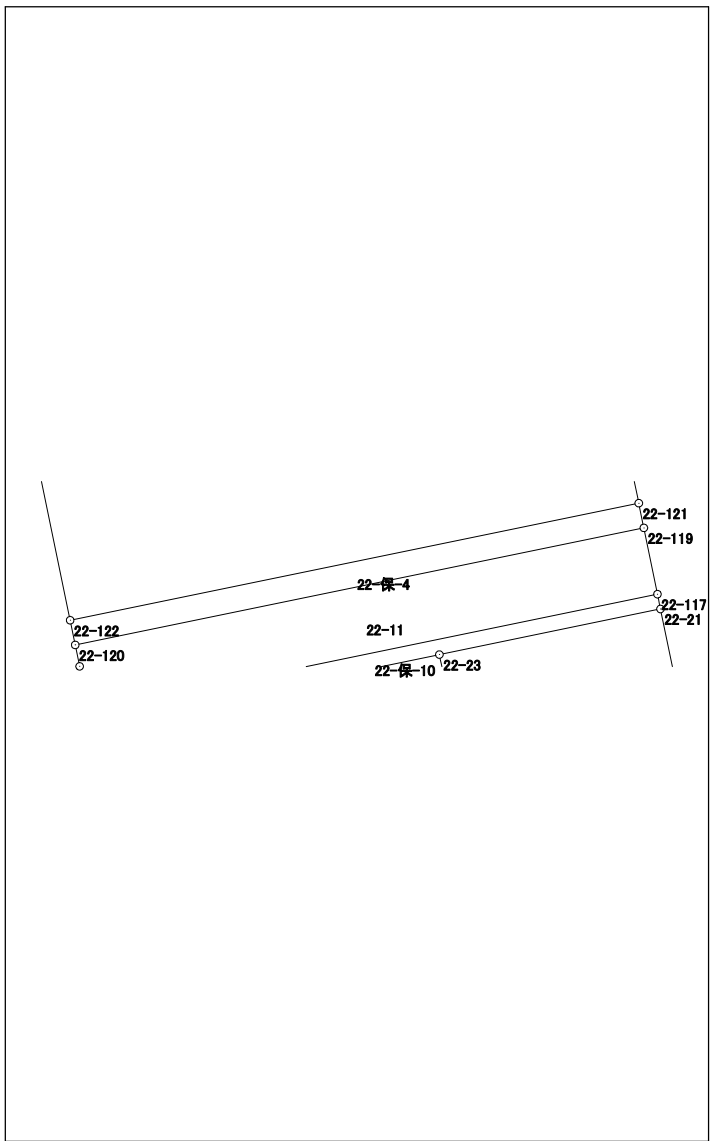


倍面積	40.007500
面 積	20.0037500

面積計算書（座標法）

世界測地系（測地成果2011）

所在	地番	公簿地目	現況地目	地積	所有者
前橋市六供町一丁目	22-保-5			28.00 m ²	

点名	X座標	Y座標	辺長	方向角	測角	DX	倍積 (Y×DX)
22-23	41595.205	-68476.626	3.354	168-27-32	90-06-09	-4.971	340397.307846
22-111	41591.919	-68475.955	8.352	78-21-13	89-53-41	-1.600	109561.528000
22-112	41593.605	-68467.775	3.353	348-24-19	90-03-06	4.971	-340353.309525
22-21	41596.890	-68468.449	8.349	258-21-23	89-57-04	1.600	-109549.518400

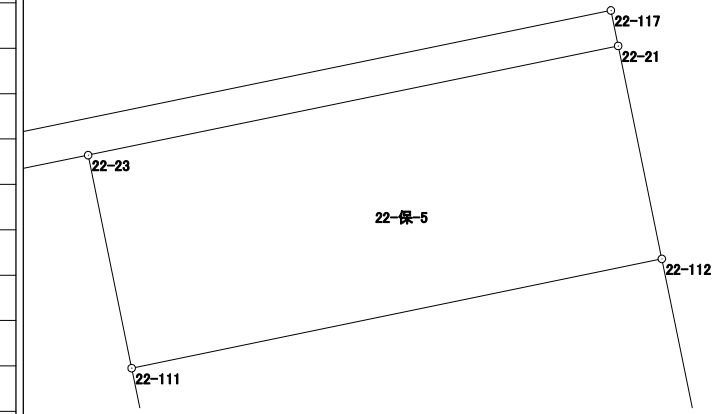


倍面積	56.007921
面積	28.0039605

面積計算書 (座標法)

世界測地系 (測地成果2011)

所在	地番	公簿地目	現況地目	地積	所有者
前橋市六供町一丁目	22-保-6			47.00 m ²	

点名	X座標	Y座標	辺長	方向角	測角	DX	倍積 (Y×DX)
22-26	41577.209	-68487.598	3.054	77-34-30	89-11-38	-9.994	684465.054412
22-109	41577.866	-68484.616	15.374	348-22-43	90-48-13	15.716	-1076304.225056
22-110	41592.925	-68487.713	1.802	258-22-42	89-59-59	14.696	-1006495.430248
22-29	41592.562	-68489.478	1.251	258-31-10	180-08-28	-0.612	41915.560536
22-25	41592.313	-68490.704	4.546	168-22-34	89-51-24	-4.702	322043.290208
22-108	41587.860	-68489.788	10.874	168-22-52	180-00-18	-15.104	1034469.757952
						倍面積	94.007804
						面積	47.0039020

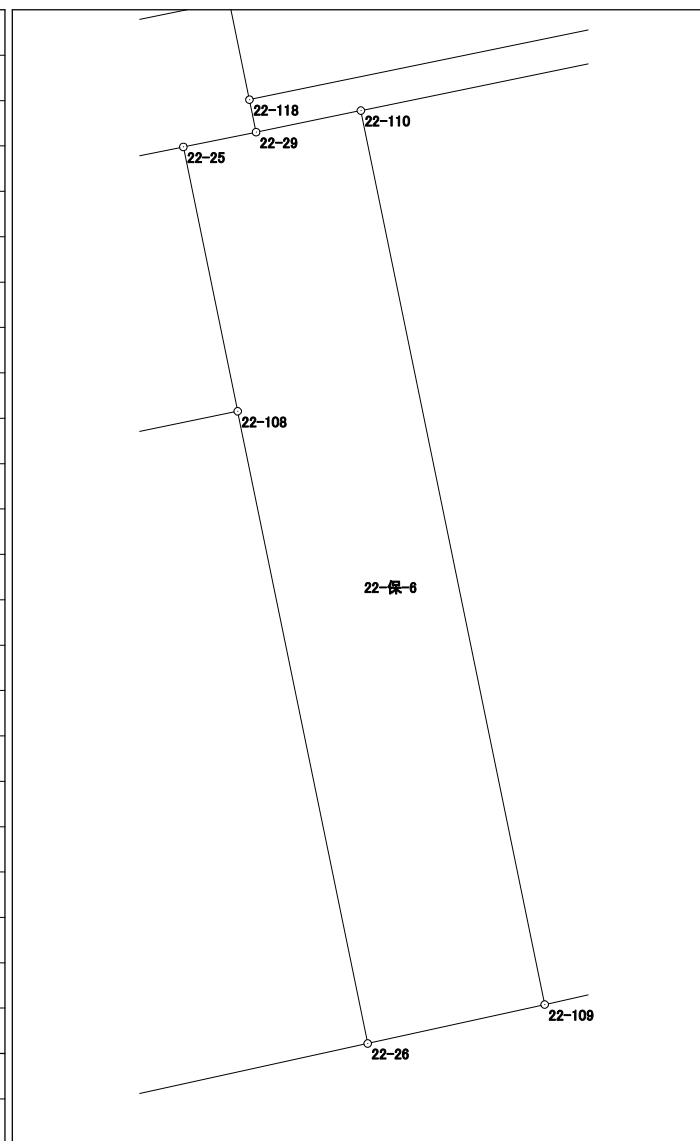


面積計算書（座標法）

世界測地系（測地成果2011）

所 在	地 番	公簿地目	現況地目	地 積	所 有 者
前橋市六供町一丁目	22-保-7			65.00 m ²	

点 名	X 座標	Y 座標	辺 長	方 向 角	測 角	DX	倍 積 (Y×DX)
22-22	41589.445	-68504.712	4.547	168-19-36	89-53-51	-7.321	501522.996552
22-107	41584.992	-68503.792	14.295	78-25-33	90-05-57	-1.585	108578.510320
22-108	41587.860	-68489.788	4.546	348-22-34	89-57-01	7.321	-501413.737948
22-25	41592.313	-68490.704	14.299	258-25-45	90-03-11	1.585	-108557.765840
						倍面積	130.003084
						面 積	65.0015420

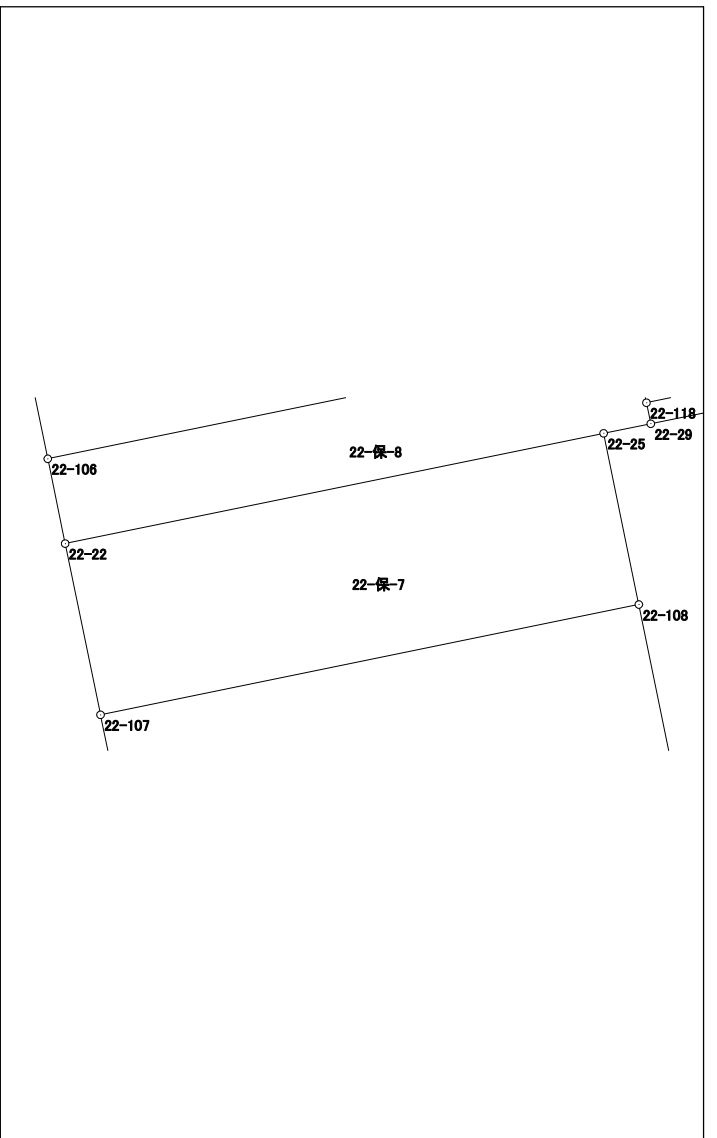


面積計算書（座標法）

世界測地系（測地成果2011）

所 在	地 番	公簿地目	現況地目	地 積	所 有 者
前橋市六供町一丁目	22-保-8			35.00 m ²	

点 名	X 座標	Y 座標	辺 長	方 向 角	測 角	DX	倍 積 (Y×DX)
22-29	41592.562	-68489.478	0.558	348-25-42	89-54-32	0.796	-54517.624488
22-118	41593.109	-68489.590	1.694	348-19-07	179-53-25	2.206	-151088.035540
22-105	41594.768	-68489.933	15.548	258-26-06	90-06-59	-1.458	99858.322314
22-106	41591.651	-68505.165	2.252	168-23-44	89-57-38	-5.323	364652.993295
22-22	41589.445	-68504.712	14.299	78-25-45	90-02-01	0.662	-45350.119344
22-25	41592.313	-68490.704	1.251	78-31-10	180-05-25	3.117	-213485.524368
						倍面積	70.011869
						面 積	35.0059345

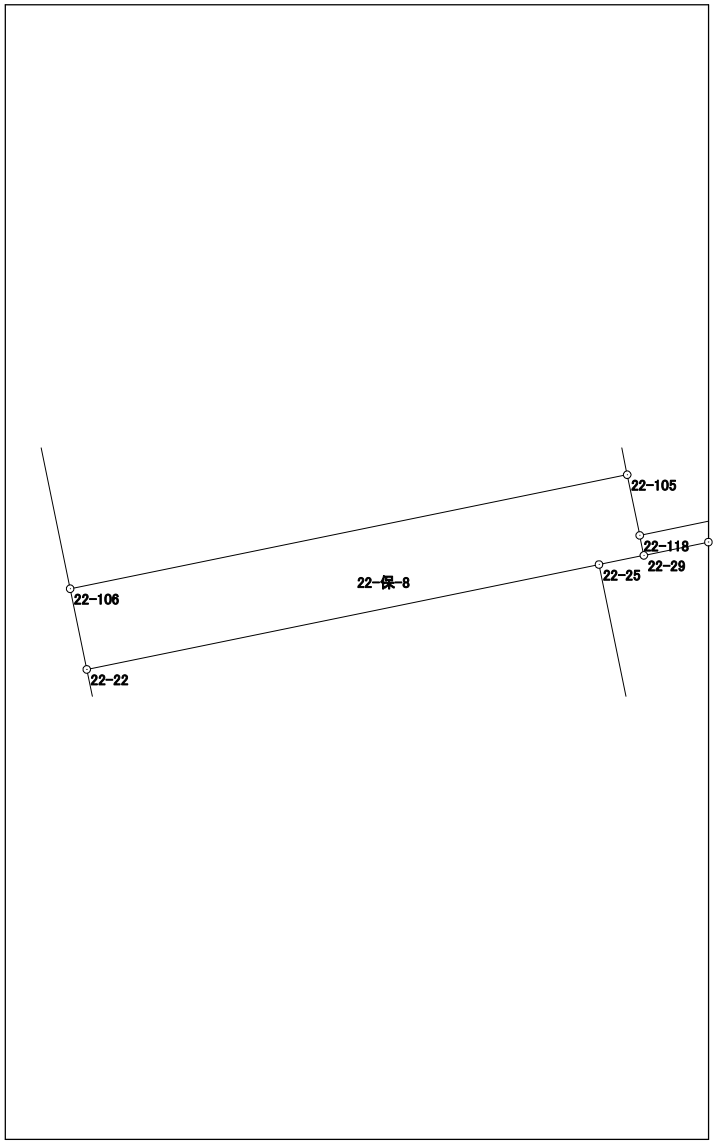


面積計算書（座標法）

世界測地系（測地成果2011）

所 在	地 番	公簿地目	現況地目	地 積	所 有 者
前橋市六供町一丁目	22-保-9			48.00 m ²	

点 名	X 座 標	Y 座 標	辺 長	方 向 角	測 角	DX	倍 積 (Y×DX)
22-18	41614.197	-68509.794	12.058	78-24-44	89-57-44	-1.478	101257.475532
22-10	41616.619	-68497.982	0.243	348-35-51	90-11-07	2.660	-182204.632120
22-124	41616.857	-68498.030	3.738	348-28-25	179-52-34	3.901	-267210.815030
22-103	41620.520	-68498.777	12.060	258-24-35	89-56-10	1.240	-84938.483480
22-104	41618.097	-68510.591	3.981	168-27-00	90-02-25	-6.323	433192.466893
						倍面積	96.011795
						面積	48.0058975

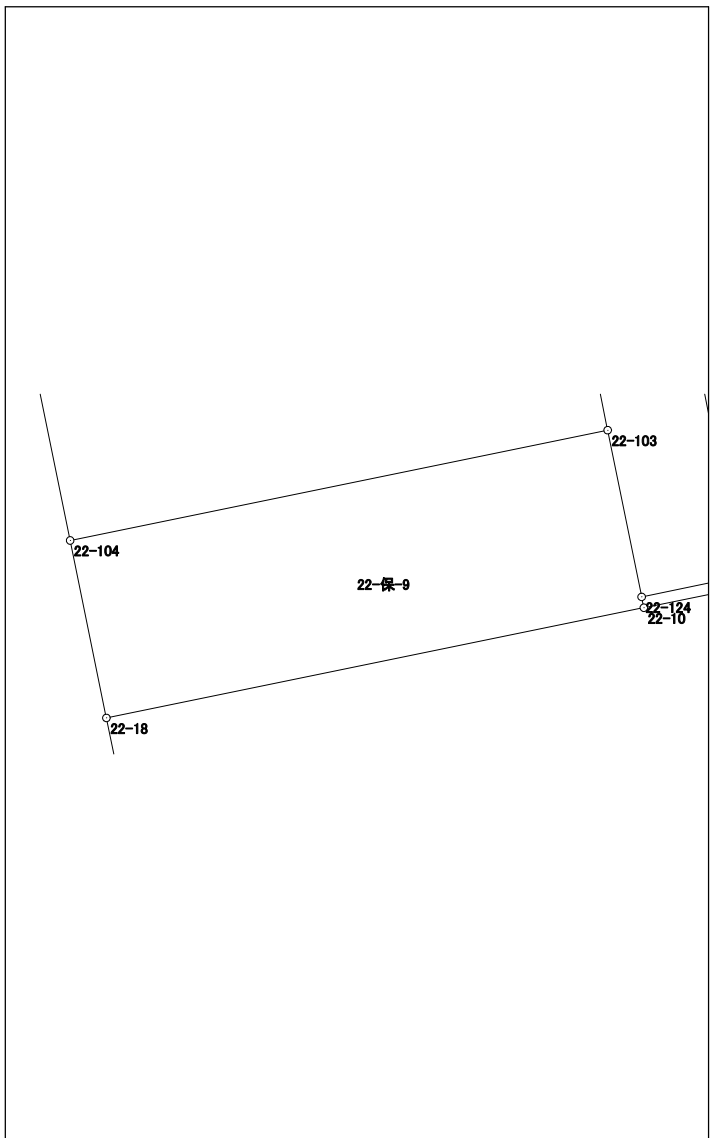

面積計算書（座標法）

世界測地系（測地成果2011）

所 在	地 番	公簿地目	現況地目	地 積	所 有 者
前橋市六供町一丁目	22-保-10			12.00 m ²	

点 名	X 座標	Y 座標	辺 長	方 向 角	測 角	DX	倍 積 (Y×DX)	
22-23	41595.205	-68476.626	8.349	78-21-23	179-58-37	3.965	-271509.822090	
22-21	41596.890	-68468.449	0.558	348-25-42	90-04-19	2.232	-152821.578168	
22-117	41597.437	-68468.561	21.470	258-22-13	89-56-31	-3.781	258879.629141	
22-118	41593.109	-68489.590	0.558	168-25-42	90-03-29	-4.875	333886.751250	
22-29	41592.562	-68489.478	1.802	78-22-42	89-57-00	-0.184	12602.063952	
22-110	41592.925	-68487.713	11.319	78-22-46	180-00-04	2.643	-181013.025459	
						倍面積	24.018626	
						面 積	12.0093130	

面積計算書（座標法）

世界測地系（測地成果2011）

所在	地番	公簿地目	現況地目	地積	所有者
前橋市六供町一丁目	22-保-12			51.22 m ²	

点名	X座標	Y座標	辺長	方向角	測角	DX	倍積 (Y×DX)
22-126	41633.013	-68499.027	5.897	168-29-51	90-02-58	-7.518	514975.684986
22-127	41627.234	-68497.851	8.687	78-26-44	89-56-53	-4.039	276662.820189
22-128	41628.974	-68489.340	5.897	348-28-02	90-01-18	7.518	-514902.858120
22-13	41634.752	-68490.519	8.684	258-26-53	89-58-51	4.039	-276633.206241

