


25街区 画地出来形確認図 (3569.78m²)



S=1/500

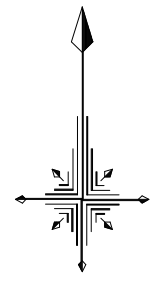


面積計算書（座標法）

世界測地系（測地成果2011）

所 在	地 番	公簿地目	現況地目	地 積	所 有 者
前橋市六供町一丁目	25-1			199.80 m ²	

点 名	X 座標	Y 座標	辺 長	方 向 角	測 角	D _X	倍 積 (Y×DX)
25-2	41652.165	-68470.804	3.995	213-14-40	135-00-47	-5.475	374877.651900
25-1	41648.824	-68472.994	12.500	168-21-37	135-06-57	-15.584	1067083.138496
25-68	41636.581	-68470.472	13.314	78-14-00	89-52-23	-9.528	652386.657216
25-69	41639.296	-68457.438	15.325	348-14-29	90-00-29	17.718	-1212928.886484
25-66	41654.299	-68460.561	10.463	258-13-53	89-59-24	12.869	-881018.959509
倍面積							399.601619
面 積							199.8008095

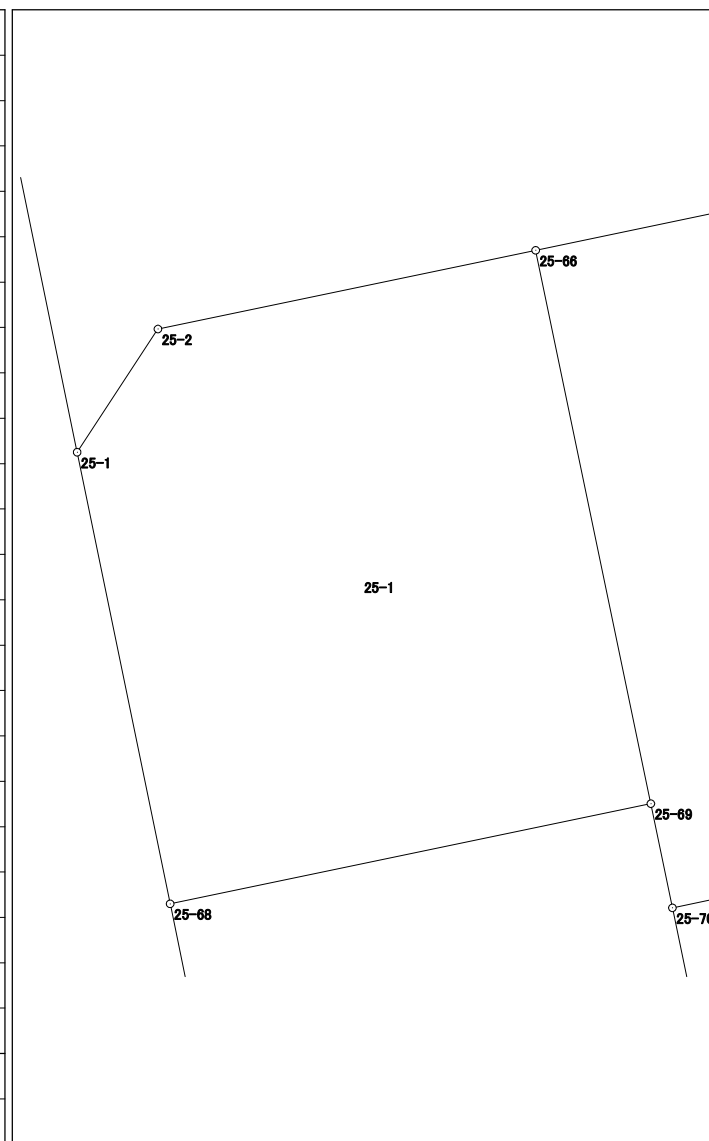


面積計算書（座標法）

世界測地系（測地成果2011）

所在	地番	公簿地目	現況地目	地積	所有者
前橋市六供町一丁目	25-3			174.61 m ²	

点名	X座標	Y座標	辺長	方向角	測角	DX	倍積 (Y×DX)
25-105	41635.005	-68433.522	3.027	168-14-14	89-43-56	-6.111	418197.252942
25-111	41632.042	-68432.905	8.030	168-15-33	180-01-19	-10.825	740786.196625
25-53	41624.180	-68431.271	15.686	78-46-23	90-30-50	-4.808	329017.550968
25-14	41627.234	-68415.885	11.130	348-49-31	90-03-08	13.973	-955975.161105
25-106	41638.153	-68418.042	15.797	258-30-18	89-40-47	7.771	-531676.604382

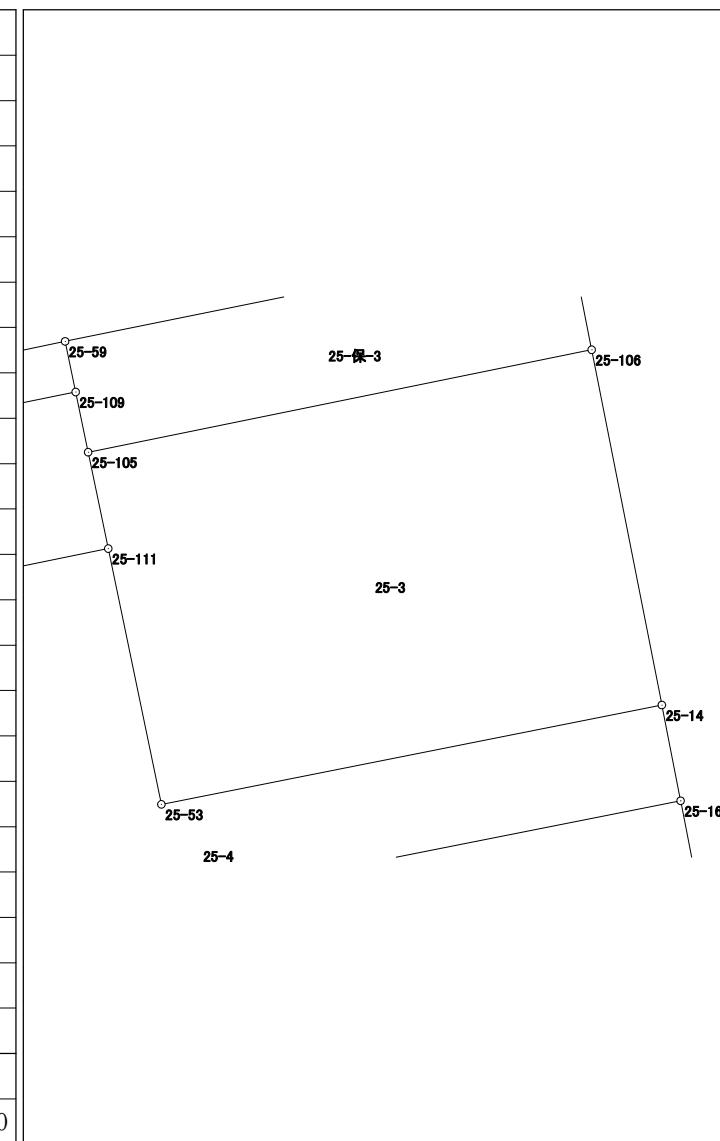


倍面積	349.235048
面積	174.6175240

面積計算書（座標法）

世界測地系（測地成果2011）

所在	地番	公簿地目	現況地目	地積	所有者
前橋市六供町一丁目	25-5			254.20 m ²	

点名	X 座標	Y 座標	辺長	方向角	測角	DX	倍積 (Y×DX)
25-114	41617.124	-68430.133	15.936	168-45-38	89-59-27	-18.734	1281970.111622
25-112	41601.494	-68427.027	15.948	78-50-07	90-04-29	-12.542	858211.772634
25-35	41604.582	-68411.381	15.954	348-43-34	89-53-27	18.734	-1281618.811654
25-115	41620.228	-68414.500	15.938	258-46-11	90-02-37	12.542	-858054.659000
						倍面積	508.413602
						面積	254.2068010

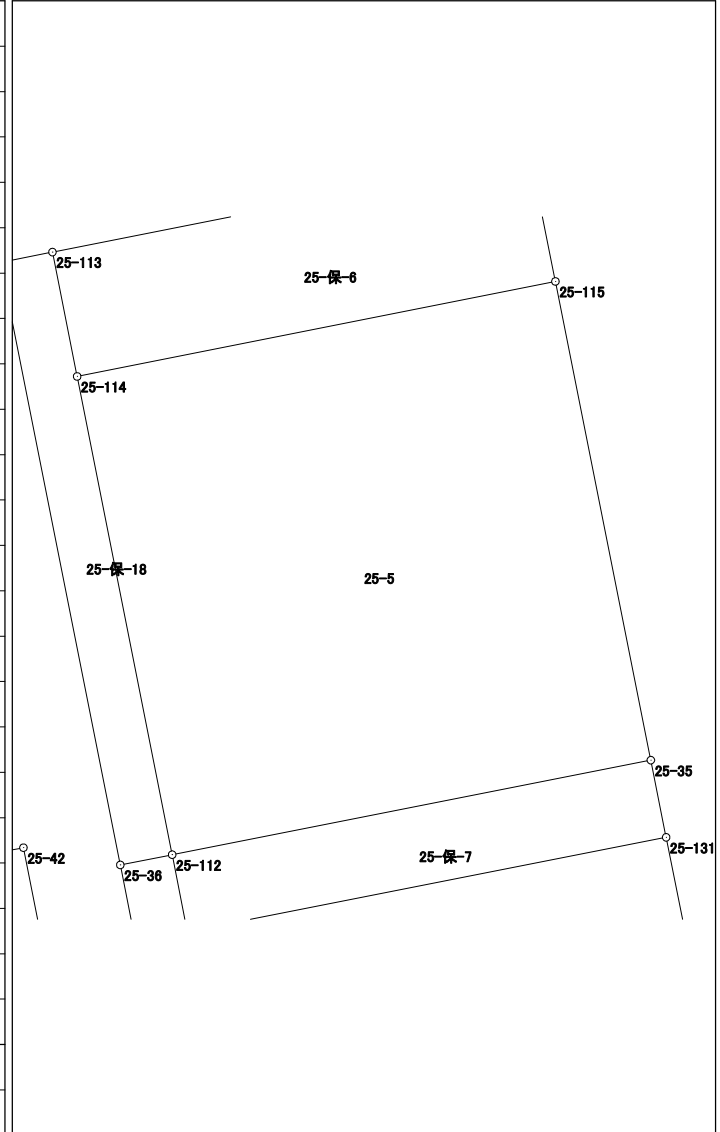


面積計算書 (座標法)

世界測地系 (測地成果2011)

所在	地番	公簿地目	現況地目	地積	所有者
前橋市六供町一丁目	25-9			236.66 m ²	

点名	X座標	Y座標	辺長	方向角	測角	DX	倍積 (Y×DX)
25-134	41600.244	-68439.365	7.621	78-48-34	90-07-12	-17.055	1167233.370075
25-42	41601.723	-68431.889	11.947	168-46-05	269-57-31	-10.239	700674.111471
25-37	41590.005	-68429.562	3.004	77-36-05	88-50-00	-11.073	757720.540026
25-33	41590.650	-68426.628	10.716	348-43-33	91-07-28	11.154	-763230.608712
25-36	41601.159	-68428.723	20.077	348-45-40	180-02-07	30.201	-2066615.863323
25-32	41620.851	-68432.636	10.058	258-46-06	90-00-26	17.733	-1213515.934188
25-107	41618.892	-68442.501	0.582	258-42-34	179-56-28	-2.073	141881.304573
25-135	41618.778	-68443.072	18.901	168-41-22	89-58-48	-18.648	1276326.406656
						倍面積	473.326578
						面積	236.6632890

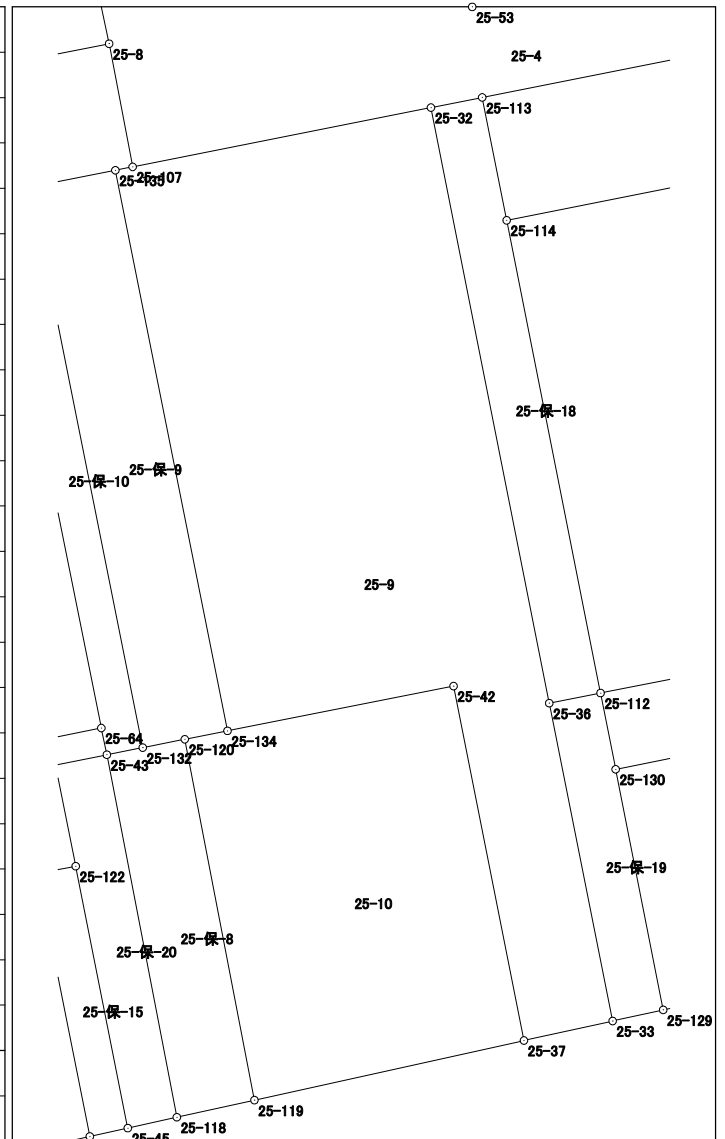


面積計算書（座標法）

世界測地系（測地成果2011）

所在	地番	公簿地目	現況地目	地積	所有者
前橋市六供町一丁目	25-18			99.65 m ²	

点名	X座標	Y座標	辺長	方向角	測角	DX	倍積 (Y×DX)
25-125	41594.619	-68450.161	11.465	258-45-31	89-59-54	6.541	-447732.503101
25-121	41592.384	-68461.406	6.340	168-27-48	89-42-17	-8.447	578293.496482
25-6	41586.172	-68460.138	3.997	122-52-45	134-24-57	-8.382	573832.876716
25-5	41584.002	-68456.781	8.564	77-35-12	134-42-27	-0.329	22522.280949
25-126	41585.843	-68448.417	8.948	348-45-37	91-10-25	10.617	-726716.843289
						倍面積	199.307757
						面積	99.6538785

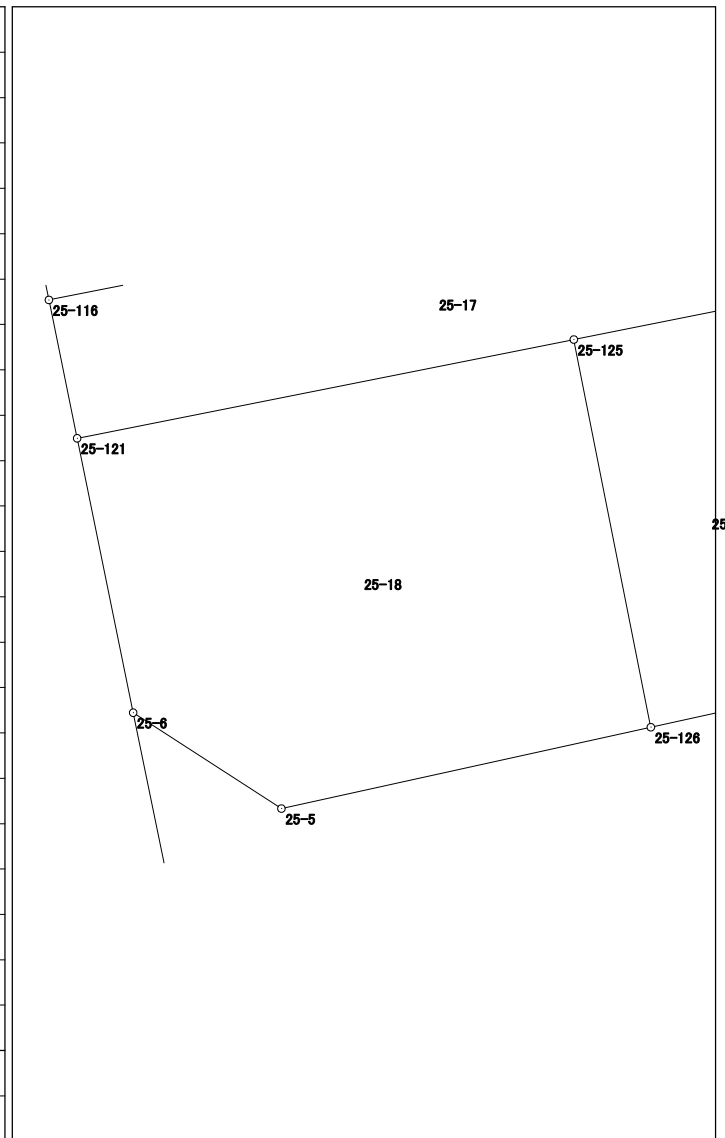


面積計算書（座標法）

世界測地系（測地成果2011）

所 在	地 番	公簿地目	現況地目	地 積	所 有 者
前橋市六供町一丁目	25-21			221.20 m ²	

点 名	X 座標	Y 座標	辺 長	方 向 角	測 角	DX	倍 積 (Y×DX)
25-73	41623.191	-68467.729	4.997	168-26-01	89-41-33	-5.969	408683.874401
25-7	41618.295	-68466.727	19.234	78-45-16	90-19-15	-1.145	78394.402415
25-61	41622.046	-68447.862	4.674	78-41-07	179-55-51	4.668	-319514.619816
25-8	41622.963	-68443.279	6.813	348-15-11	89-34-04	7.587	-519279.157773
25-110	41629.633	-68444.666	4.915	348-15-37	180-00-26	11.482	-785881.655012
25-108	41634.445	-68445.666	1.590	348-14-42	179-59-05	6.369	-435930.446754
25-57	41636.002	-68445.990	2.117	348-35-02	180-20-20	3.632	-248595.835680
25-102	41638.077	-68446.409	0.558	348-31-44	179-56-42	2.622	-179466.484398
25-71	41638.624	-68446.520	10.555	258-14-08	89-42-24	-1.605	109856.664600
25-70	41636.472	-68456.853	12.892	168-13-29	89-59-21	-14.773	1011313.089369
25-74	41623.851	-68454.222	5.894	258-45-31	270-32-02	-13.770	942614.636940
25-79	41622.702	-68460.003	2.810	303-46-09	225-00-38	0.413	-28273.981239
25-77	41624.264	-68462.339	5.496	258-44-28	134-58-19	0.489	-33478.083771

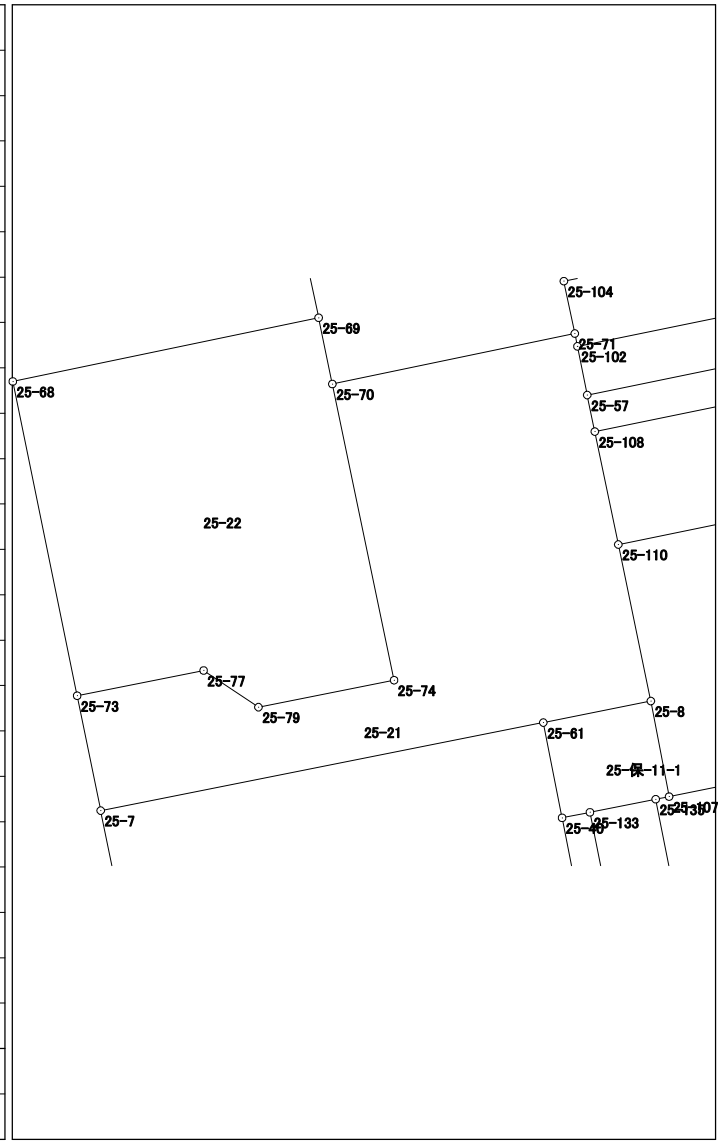


倍面積	442.403282
面 積	221.2016410

面積計算書 (座標法)

世界測地系 (測地成果2011)

所在	地番	公簿地目	現況地目	地積	所有者
前橋市六供町一丁目	25-22			196.72 m ²	

点名	X座標	Y座標	辺長	方向角	測角	DX	倍積 (Y×DX)
25-68	41636.581	-68470.472	13.668	168-25-22	90-11-22	-16.105	1102716.951560
25-73	41623.191	-68467.729	5.496	78-44-28	90-19-06	-12.317	843317.018093
25-77	41624.264	-68462.339	2.810	123-46-09	225-01-41	-0.489	33478.083771
25-79	41622.702	-68460.003	5.894	78-45-31	134-59-22	-0.413	28273.981239
25-74	41623.851	-68454.222	12.892	348-13-29	89-27-58	13.770	-942614.636940
25-70	41636.472	-68456.853	2.884	348-17-48	180-04-19	15.445	-1057316.094585
25-69	41639.296	-68457.438	13.314	258-14-00	89-56-12	0.109	-7461.860742
						倍面積	393.442396
						面積	196.7211980

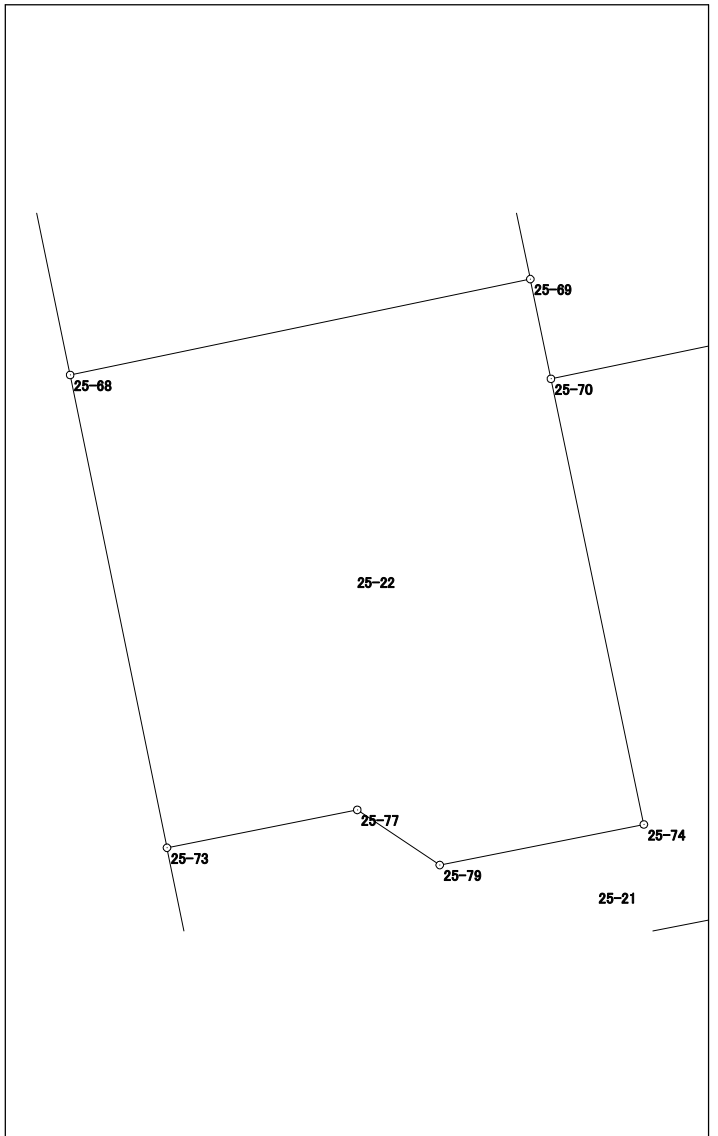

面積計算書 (座標法)

世界測地系 (測地成果2011)

所在	地番	公簿地目	現況地目	地積	所有者
前橋市六供町一丁目	25-保-2			58.80 m ²	

点名	X座標	Y座標	辺長	方向角	測角	Dx	倍積 (Y×Dx)	
25-57	41636.002	-68445.990	12.004	78-25-24	89-50-22	0.334	-22860.960660	
25-59	41638.411	-68434.230	15.831	78-30-30	180-05-06	5.563	-380699.621490	
25-58	41641.565	-68418.716	2.118	348-45-13	90-14-43	5.231	-357898.303396	
25-101	41643.642	-68419.129	27.842	258-28-12	89-42-59	-3.488	238645.921952	
25-102	41638.077	-68446.409	2.117	168-35-02	90-06-50	-7.640	522930.564760	
						倍面積	117.601166	
						面積	58.8005830	

面積計算書（座標法）

世界測地系（測地成果2011）

所在	地番	公簿地目	現況地目	地積	所有者
前橋市六供町一丁目	25-保-3			55.00 m ²	


点名	X座標	Y座標	辺長	方向角	測角	DX	倍積 (Y×DX)	
25-59	41638.411	-68434.230	1.590	168-14-42	89-44-12	-4.711	322393.657530	
25-109	41636.854	-68433.906	1.888	168-16-03	180-01-21	-3.406	233085.883836	
25-105	41635.005	-68433.522	15.797	78-30-18	90-14-15	1.299	-88895.145078	
25-106	41638.153	-68418.042	3.478	348-49-33	90-19-15	6.560	-448822.355520	
25-58	41641.565	-68418.716	15.831	258-30-30	89-40-57	0.258	-17652.028728	
						倍面積	110.012040	
						面積	55.0060200	

面積計算書（座標法）

世界測地系（測地成果2011）

所 在	地 番	公簿地目	現況地目	地 積	所 有 者
前橋市六供町一丁目	25-保-4			59.00 m ²	

点 名	X 座標	Y 座標	辺 長	方 向 角	測 角	DX	倍 積 (Y×DX)
25-108	41634.445	-68445.666	4.915	168-15-37	89-50-13	-7.221	494246.154186
25-110	41629.633	-68444.666	12.005	78-25-27	90-09-50	-2.403	164472.532398
25-111	41632.042	-68432.905	3.027	348-14-14	89-48-47	5.372	-367621.565660
25-105	41635.005	-68433.522	1.888	348-16-03	180-01-49	4.812	-329302.107864
25-109	41636.854	-68433.906	12.004	258-25-24	90-09-21	-0.560	38322.987360
						倍面積	118.000420
						面 積	59.0002100

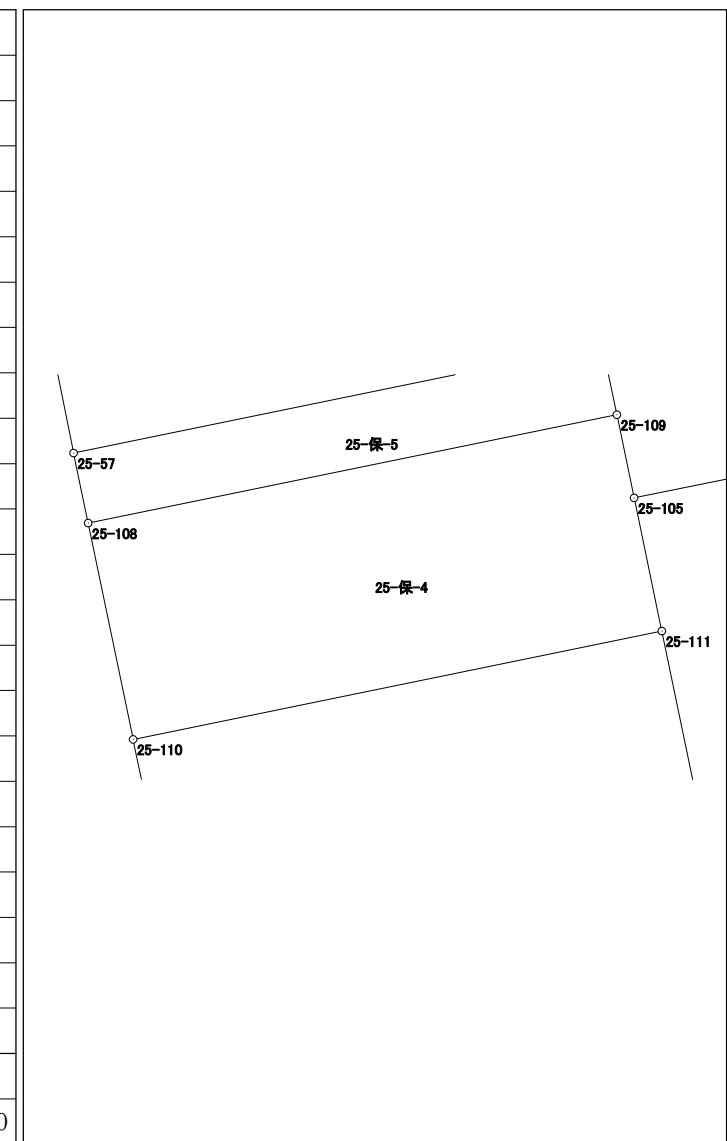


面積計算書 (座標法)

世界測地系 (測地成果2011)

所在	地番	公簿地目	現況地目	地積	所有者
前橋市六供町一丁目	25-保-6			66.00 m ²	


点名	X座標	Y座標	辺長	方向角	測角	DX	倍積 (Y×DX)
25-16	41624.289	-68415.309	15.937	258-46-34	90-02-33	0.959	-65610.281331
25-113	41621.187	-68430.941	4.143	168-45-09	89-58-35	-7.165	490307.692265
25-114	41617.124	-68430.133	15.938	78-46-11	90-01-02	-0.959	65624.497547
25-115	41620.228	-68414.500	4.141	348-44-01	89-57-50	7.165	-490189.892500
						倍面積	132.015981
						面積	66.0079905

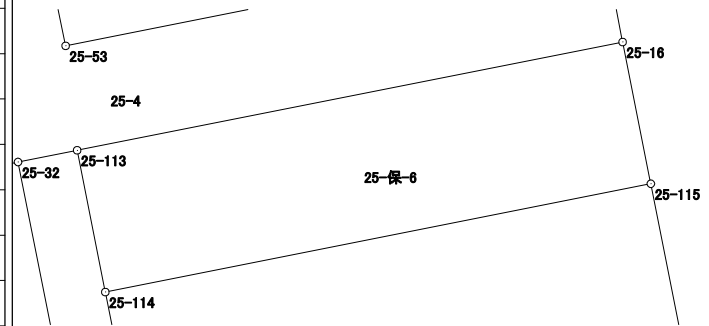

面積計算書（座標法）

世界測地系（測地成果2011）

所 在	地 番	公簿地目	現況地目	地 積	所 有 者
前橋市六供町一丁目	25-保-7			41.00 m ²	

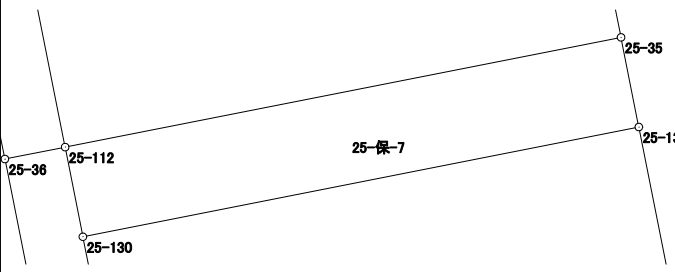
点 名	X 座標	Y 座標	辺 長	方 向 角	測 角	DX	倍 積 (Y×DX)	
25-112	41601.494	-68427.027	2.571	168-48-29	89-58-22	-5.610	383875.621470	
25-130	41598.972	-68426.528	15.950	78-50-12	90-01-43	0.566	-38729.414848	
25-131	41602.060	-68410.880	2.571	348-45-52	89-55-40	5.610	-383785.036800	
25-35	41604.582	-68411.381	15.948	258-50-07	90-04-15	-0.566	38720.841646	
倍面積							82.011468	
面 積							41.0057340	

面積計算書（座標法）

世界測地系（測地成果2011）

所 在	地 番	公簿地目	現況地目	地 積	所 有 者
前橋市六供町一丁目	25-保-9			54.00 m ²	

点 名	X 座標	Y 座標	辺 長	方 向 角	測 角	D X	倍 積 (Y×DX)
25-132	41599.689	-68442.168	1.419	78-47-06	90-05-46	-18.257	1249548.661176
25-120	41599.965	-68440.776	1.438	78-48-54	180-01-48	0.555	-37984.630680
25-134	41600.244	-68439.365	18.901	348-41-22	89-52-28	18.813	-1287549.773745
25-135	41618.778	-68443.072	2.858	258-46-50	90-05-28	17.978	-1230469.548416
25-133	41618.222	-68445.875	18.900	168-41-20	89-54-30	-19.089	1306563.307875
						倍面積	108.016210
						面 積	54.0081050

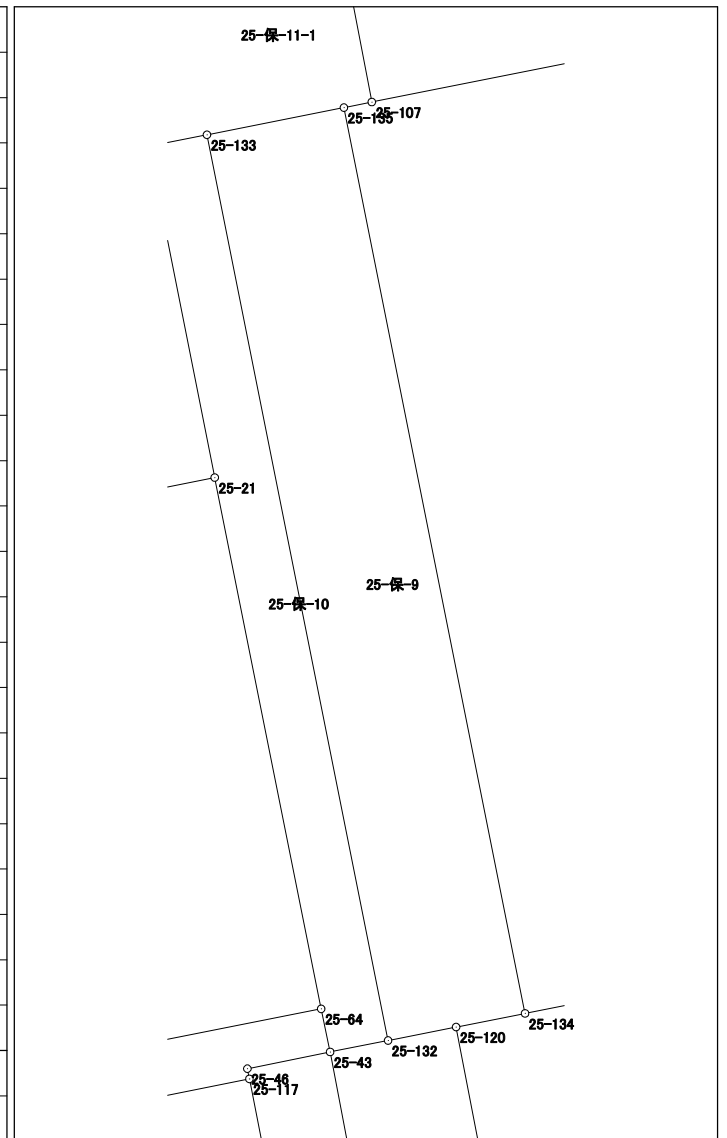


面積計算書（座標法）

世界測地系（測地成果2011）

所 在	地 番	公簿地目	現況地目	地 積	所 有 者
前橋市六供町一丁目	25-保-10			22.98 m ²	

点 名	X 座標	Y 座標	辺 長	方 向 角	測 角	DX	倍 積 (Y×DX)
25-64	41600.337	-68443.537	0.901	168-16-42	179-36-45	-11.753	804416.890361
25-43	41599.455	-68443.354	1.209	78-50-20	90-33-38	-0.648	44351.293392
25-132	41599.689	-68442.168	18.900	348-41-20	89-51-00	18.767	-1284454.166856
25-133	41618.222	-68445.875	1.209	258-47-32	90-06-12	18.298	-1252422.620750
25-40	41617.987	-68447.061	6.911	168-46-40	89-59-08	-7.014	480087.685854
25-21	41611.208	-68445.716	11.087	168-39-57	179-53-17	-17.650	1208066.887400
						倍面積	45.969401
						面 積	22.9847005

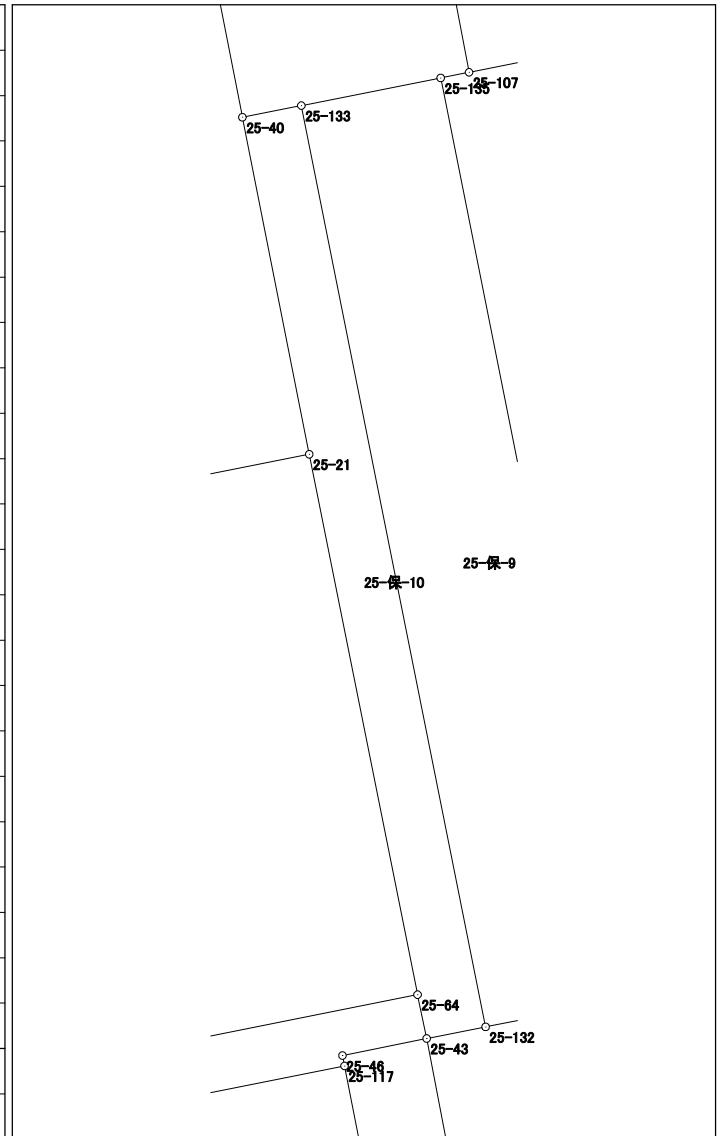


面積計算書（座標法）

世界測地系（測地成果2011）

所在	地番	公簿地目	現況地目	地積	所有者
前橋市六供町一丁目	25-保-11-1			19.30 m ²	

点名	X座標	Y座標	辺長	方向角	測角	DX	倍積 (Y×DX)
25-8	41622.963	-68443.279	4.674	258-41-07	89-30-16	3.154	-215870.101966
25-61	41622.046	-68447.862	4.137	168-50-12	90-09-05	-4.976	340596.561312
25-40	41617.987	-68447.061	1.209	78-47-32	89-57-20	-3.824	261741.561264
25-133	41618.222	-68445.875	2.858	78-46-50	179-59-18	0.791	-54140.687125
25-135	41618.778	-68443.072	0.582	78-42-34	179-55-44	0.670	-45856.858240
25-107	41618.892	-68442.501	4.145	349-10-51	90-28-17	4.185	-286431.866685

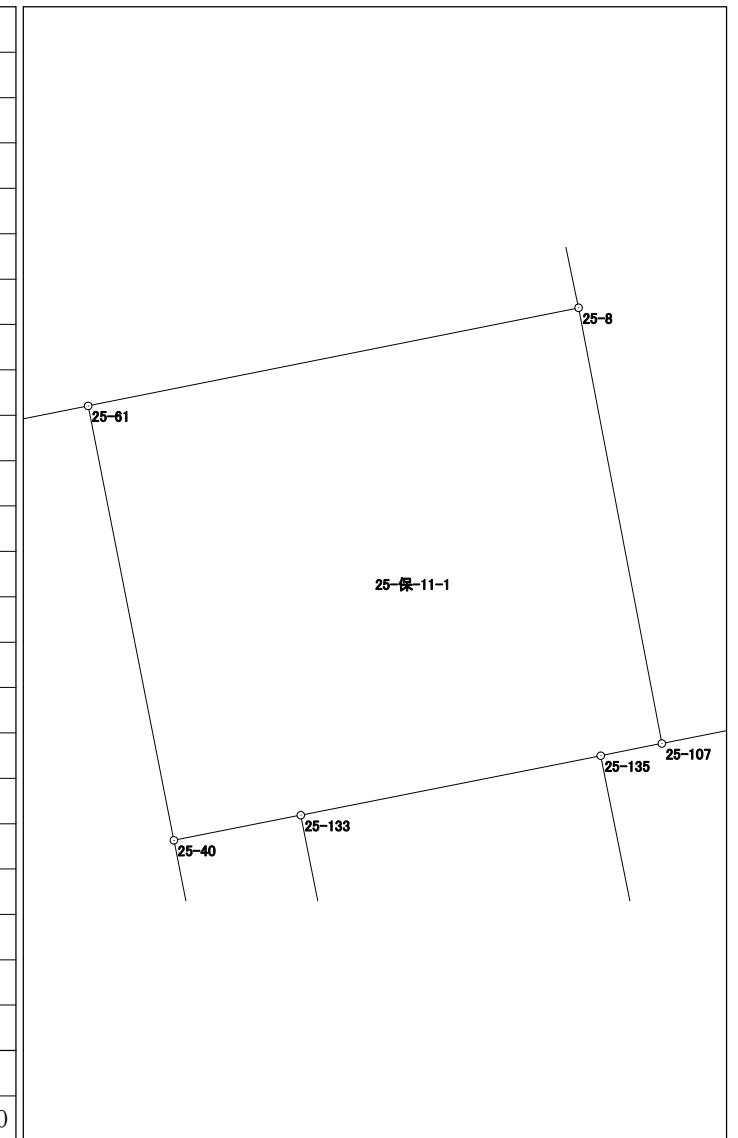


倍面積	38.608560
面積	19.3042800

面積計算書（座標法）

世界測地系（測地成果2011）

所在	地番	公簿地目	現況地目	地積	所有者
前橋市六供町一丁目	25-保-15			11.36 m ²	

点名	X座標	Y座標	辺長	方向角	測角	DX	倍積 (Y×DX)
25-45	41587.109	-68442.661	8.829	348-45-09	91-08-46	8.935	-611535.176035
25-122	41595.768	-68444.383	1.285	258-44-02	89-58-53	8.408	-575480.372264
25-123	41595.517	-68445.643	8.854	168-45-31	90-01-29	-8.935	611561.820205
25-124	41586.833	-68443.917	1.286	77-36-23	88-50-52	-8.408	575476.454136
						倍面積	22.726042
						面積	11.3630210

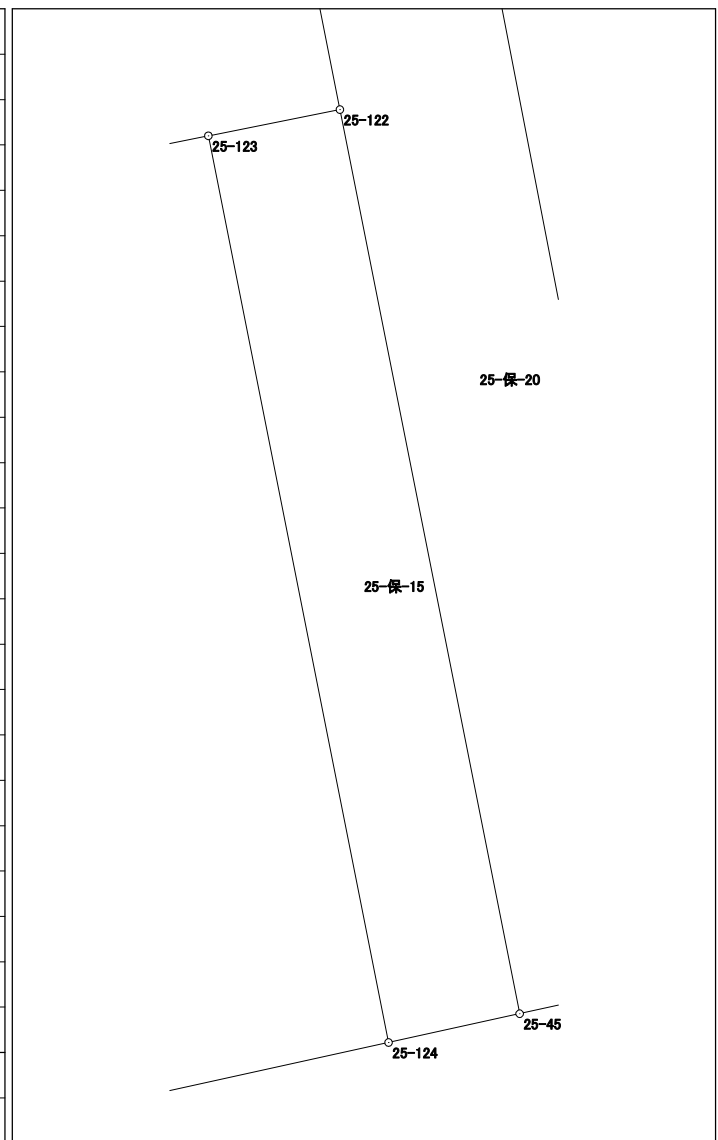


面積計算書（座標法）

世界測地系（測地成果2011）

所 在	地 番	公簿地目	現況地目	地 積	所 有 者
前橋市六供町一丁目	25-保-18			34.70 m ²	

点 名	X 座標	Y 座標	辺 長	方 向 角	測 角	DX	倍 積 (Y×DX)
25-32	41620.851	-68432.636	20.077	168-45-40	89-58-25	-20.028	1370568.833808
25-36	41601.159	-68428.723	1.729	78-49-36	90-03-56	-19.357	1324574.791111
25-112	41601.494	-68427.027	15.936	348-45-38	89-56-02	15.965	-1092437.486055
25-114	41617.124	-68430.133	4.143	348-45-09	179-59-31	19.693	-1347594.609169
25-113	41621.187	-68430.941	1.728	258-47-15	90-02-06	3.727	-255042.117107
						倍面積	69.412588
						面 積	34.7062940

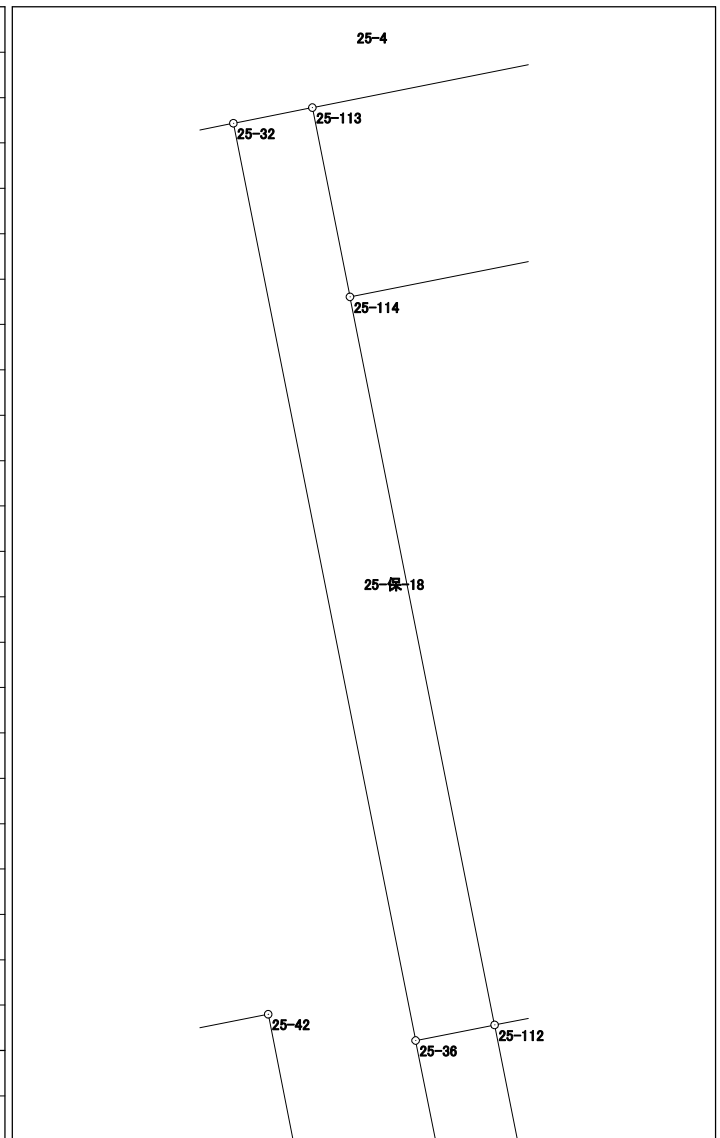


面積計算書 (座標法)

世界測地系 (測地成果2011)

所在	地番	公簿地目	現況地目	地積	所有者
前橋市六供町一丁目	25-保-19			18.40 m ²	

点名	X座標	Y座標	辺長	方向角	測角	DX	倍積 (Y×DX)
25-112	41601.494	-68427.027	1.729	258-49-36	90-01-07	2.187	-149649.908049
25-36	41601.159	-68428.723	10.716	168-43-33	89-53-57	-10.844	742041.072212
25-33	41590.650	-68426.628	1.712	77-33-17	88-49-44	-10.140	693846.007920
25-129	41591.019	-68424.956	8.107	348-49-08	91-15-51	8.322	-569432.483832
25-130	41598.972	-68426.528	2.571	348-48-29	179-59-21	10.475	-716767.880800
						倍面積	36.807451
						面積	18.4037255

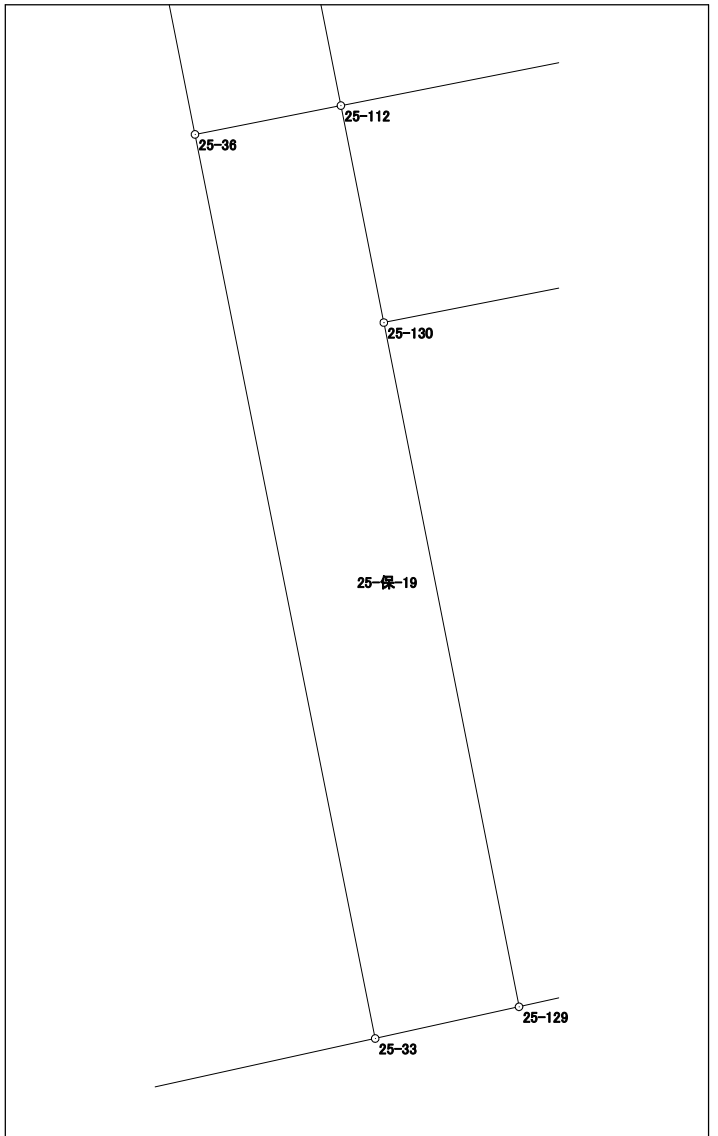


面積計算書 (座標法)

世界測地系 (測地成果2011)

所在	地番	公簿地目	現況地目	地積	所有者
前橋市六供町一丁目	25-保-20			20.70 m ²	

点名	X座標	Y座標	辺長	方向角	測角	DX	倍積 (Y×DX)
25-43	41599.455	-68443.354	1.728	258-35-10	89-30-41	11.646	-797091.300684
25-46	41599.113	-68445.048	0.213	168-38-14	90-03-04	-0.551	37713.221448
25-117	41598.904	-68445.006	3.197	168-45-50	180-07-36	-3.345	228948.545070
25-122	41595.768	-68444.383	8.829	168-45-09	179-59-19	-11.795	807301.497485
25-45	41587.109	-68442.661	1.660	77-32-46	88-47-37	-8.301	568142.528961
25-118	41587.467	-68441.040	12.209	349-04-29	91-31-43	12.346	-844973.079840
						倍面積	41.412440
						面積	20.7062200

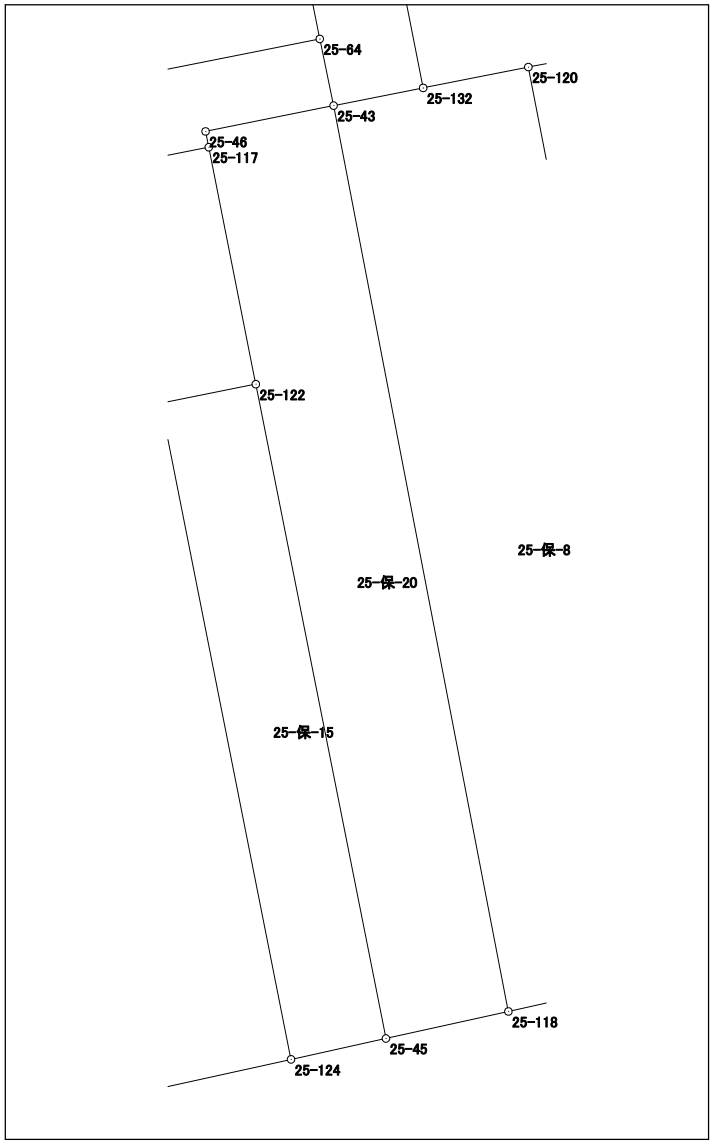


面積計算書（座標法）

世界測地系（測地成果2011）

所在	地番	公簿地目	現況地目	地積	所有者
前橋市六供町一丁目	25-保-22-1			212.01 m ²	

点名	X座標	Y座標	辺長	方向角	測角	DX	倍積 (Y×DX)
25-7	41618.295	-68466.727	11.047	168-22-11	89-36-55	-14.571	997628.679117
25-20	41607.475	-68464.500	19.151	78-45-36	90-23-25	-7.087	485207.911500
25-21	41611.208	-68445.716	6.911	348-46-40	90-01-04	10.512	-719501.366592
25-40	41617.987	-68447.061	4.137	348-50-12	180-03-32	10.838	-741829.247118
25-61	41622.046	-68447.862	19.234	258-45-16	89-55-04	0.308	-21081.941496

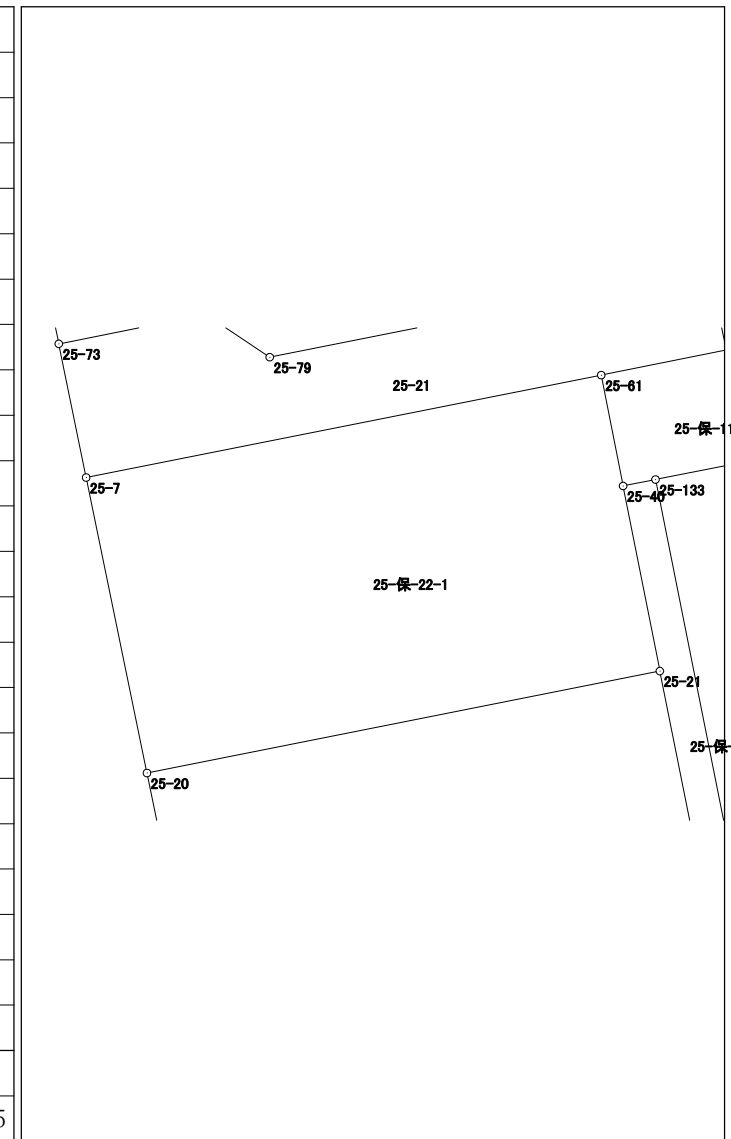


倍面積	424.035411
面積	212.0177055

面積計算書（座標法）

世界測地系（測地成果2011）

所在	地番	公簿地目	現況地目	地積	所有者
前橋市六供町一丁目	25-保-22-2			212.05 m ²	

点名	X座標	Y座標	辺長	方向角	測角	DX	倍積 (Y×DX)
25-20	41607.475	-68464.500	11.089	168-23-54	89-38-18	-14.595	999239.377500
25-65	41596.613	-68462.270	19.100	78-45-24	90-21-30	-7.138	488683.683260
25-64	41600.337	-68443.537	11.087	348-39-57	89-54-33	14.595	-998933.422515
25-21	41611.208	-68445.716	19.151	258-45-36	90-05-39	7.138	-488565.520808

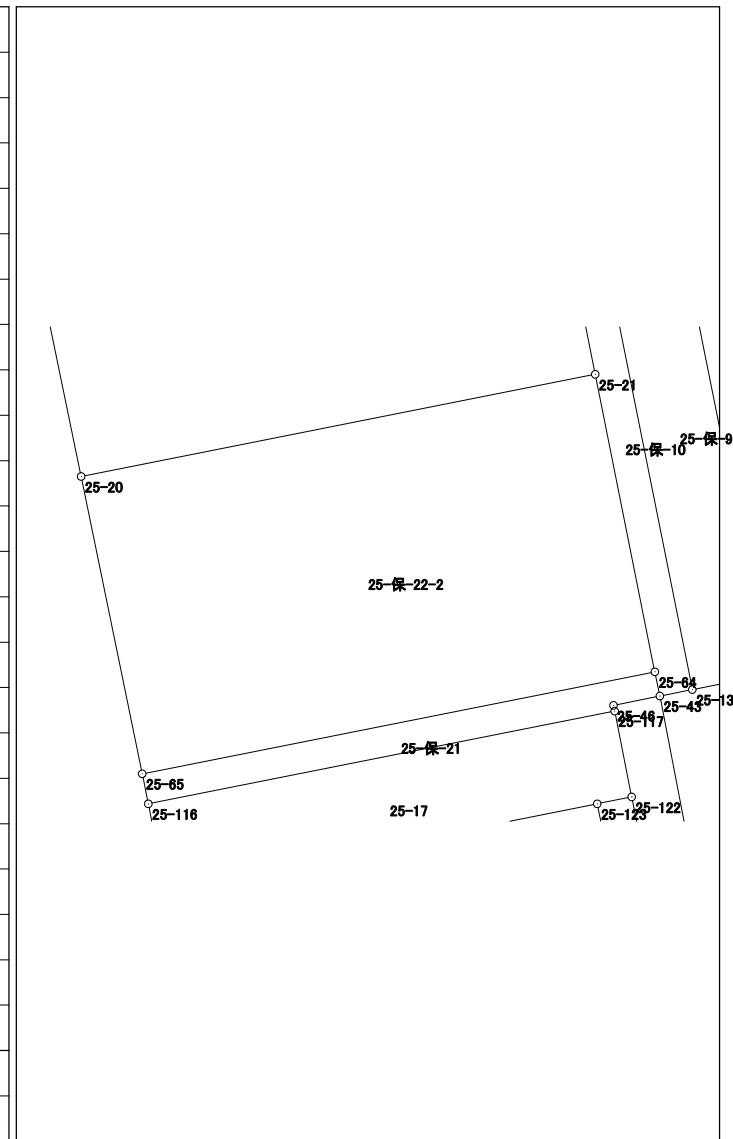

倍面積	424.117437
面積	212.0587185