



26街区 画地出来形確認図 (2885.88㎡)

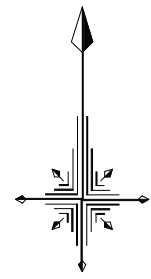

S=1/500

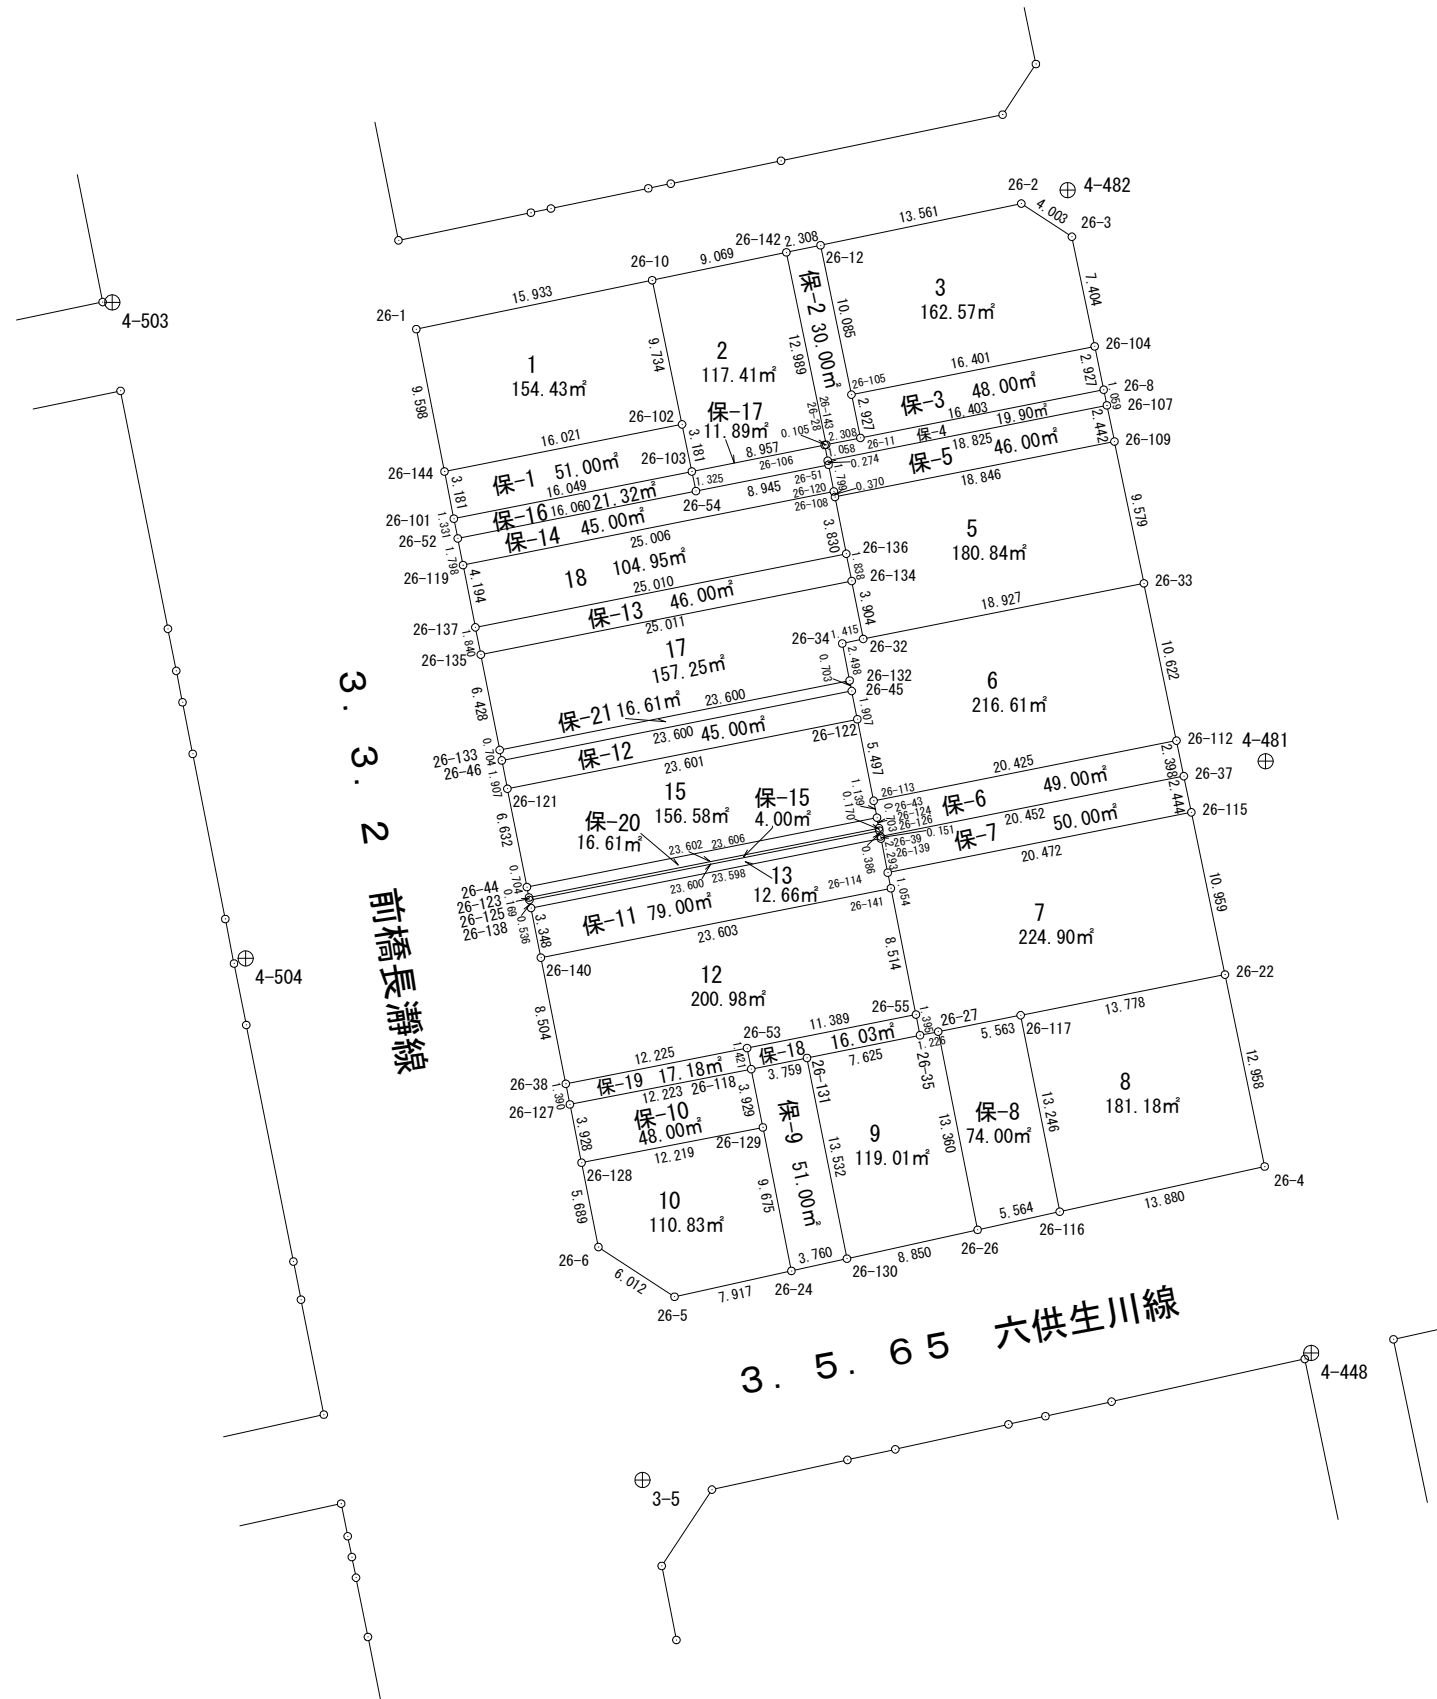


面積計算書（座標法）

世界測地系（測地成果2011）

所在	地番	公簿地目	現況地目	地積	所有者
前橋市六供町一丁目	26-1			154.43 m ²	

点名	X座標	Y座標	辺長	方向角	測角	DX	倍積 (Y×DX)
26-102	41659.943	-68385.672	9.734	348-16-12	89-29-20	12.648	-864941.979456
26-10	41669.474	-68387.651	15.933	258-17-35	90-01-23	6.298	-430705.425998
26-1	41666.241	-68403.253	9.598	168-47-22	90-29-47	-12.648	865164.343944
26-144	41656.826	-68401.387	16.021	78-46-52	89-59-30	-6.298	430791.935326
						倍面積	308.873816
						面積	154.4369080

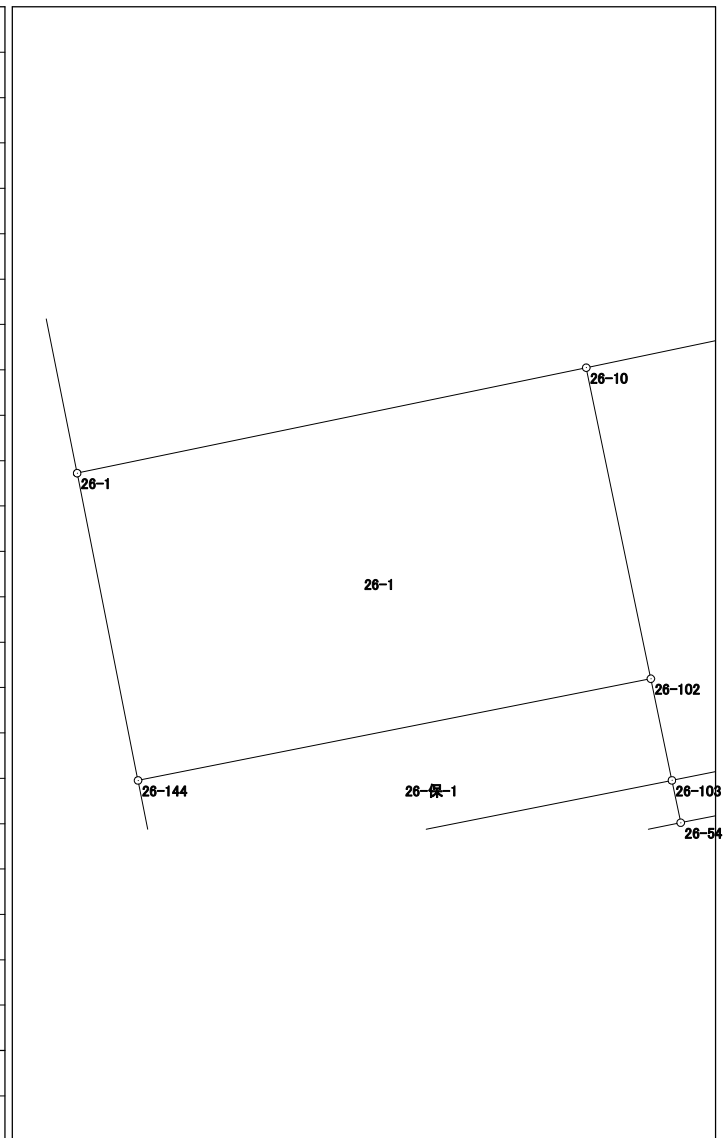


面積計算書（座標法）

世界測地系（測地成果2011）

所在	地番	公簿地目	現況地目	地積	所有者
前橋市六供町一丁目	26-2			117.41 m ²	

点名	X座標	Y座標	辺長	方向角	測角	DX	倍積 (Y×DX)
26-10	41669.474	-68387.651	9.734	168-16-12	90-00-04	-11.375	777909.530125
26-102	41659.943	-68385.672	3.181	168-17-02	180-00-50	-12.646	864805.208112
26-103	41656.828	-68385.026	8.957	78-43-58	90-26-56	-1.365	93345.560490
26-28	41658.578	-68376.242	0.105	79-00-41	180-16-43	1.770	-121025.948340
26-143	41658.598	-68376.139	12.989	348-18-34	89-17-53	12.740	-871112.010860
26-142	41671.318	-68378.771	9.069	258-16-08	89-57-34	10.876	-743687.513396

倍面積	234.826131
面積	117.4130655

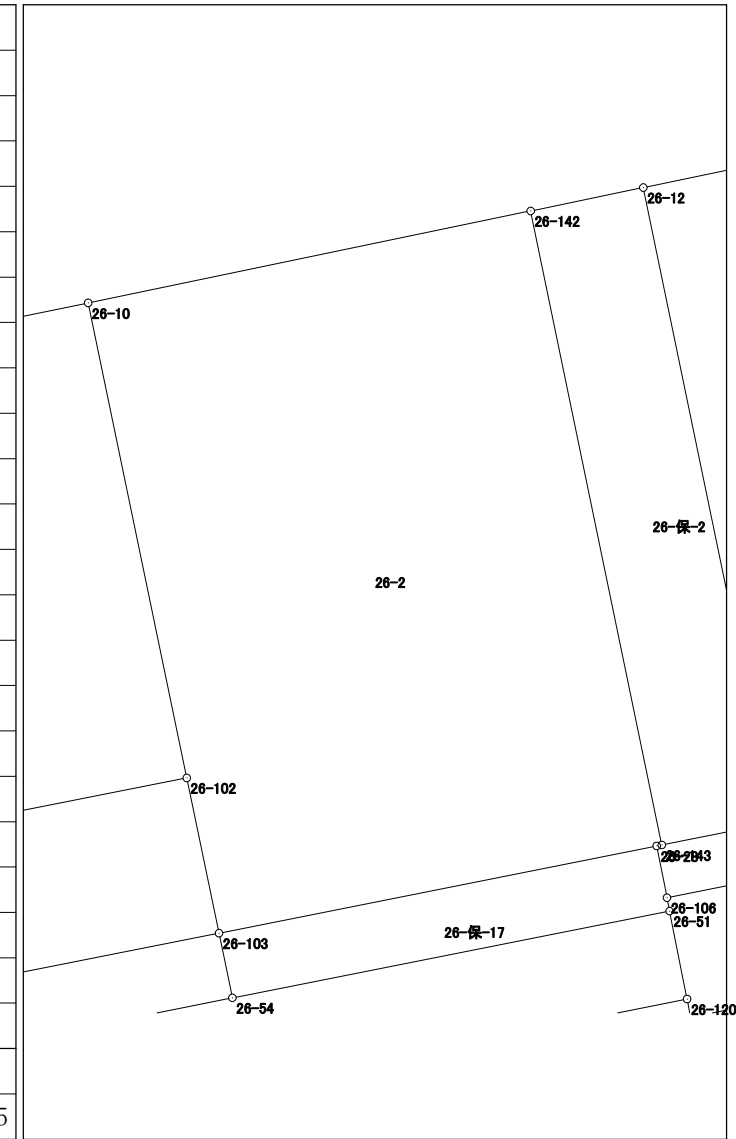


面積計算書（座標法）

世界測地系（測地成果2011）

所在	地番	公簿地目	現況地目	地積	所有者
前橋市六供町一丁目	26-3			162.57 m ²	

点名	X座標	Y座標	辺長	方向角	測角	D _X	倍積 (Y×D _X)
26-104	41665.101	-68358.380	7.404	348-15-49	89-28-44	10.439	-713593.128820
26-3	41672.350	-68359.886	4.003	303-15-26	134-59-37	9.444	-645590.763384
26-2	41674.545	-68363.233	13.561	258-15-57	135-00-31	-0.563	38488.500179
26-12	41671.787	-68376.511	10.085	168-18-44	90-02-47	-12.634	863868.839974
26-105	41661.911	-68374.468	16.401	78-47-05	90-28-21	-6.686	457151.693048

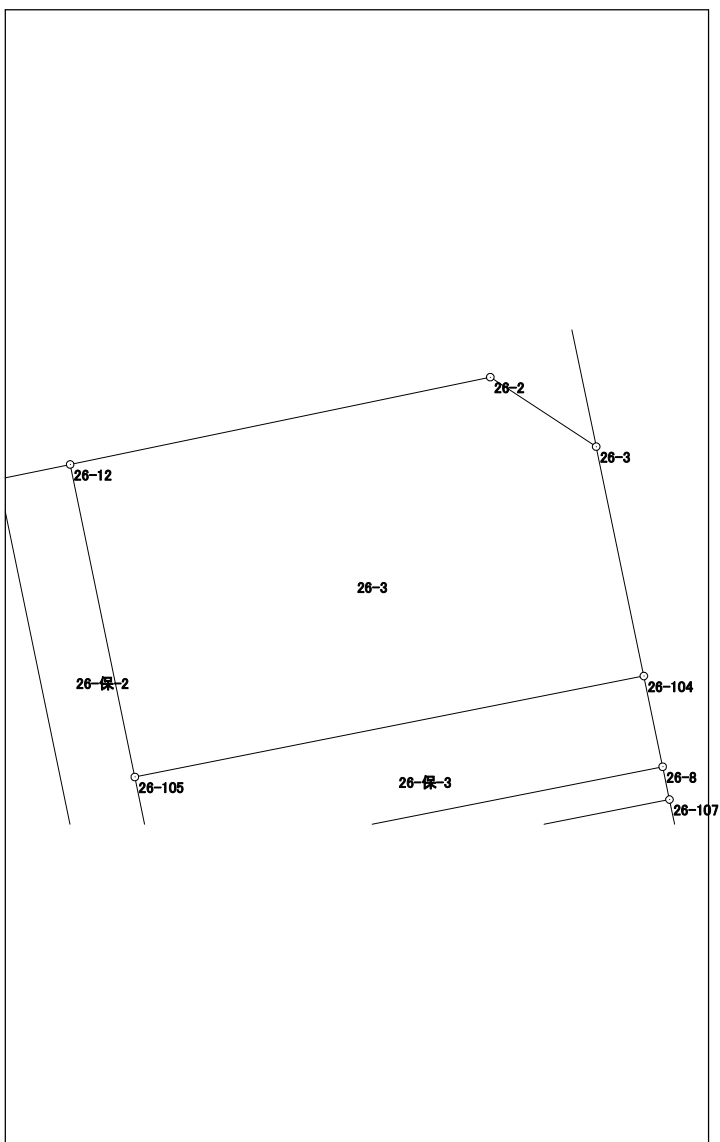


倍面積	325.140997
面積	162.5704985

面積計算書 (座標法)

世界測地系 (測地成果2011)

所在	地番	公簿地目	現況地目	地積	所有者
前橋市六供町一丁目	26-5			180.84 m ²	

点名	X座標	Y座標	辺長	方向角	測角	DX	倍積 (Y×DX)
26-108	41655.144	-68375.560	3.830	168-43-20	89-55-47	-7.419	507278.279640
26-136	41651.388	-68374.811	1.838	168-44-20	180-01-00	-5.559	380095.574349
26-134	41649.585	-68374.452	3.904	168-44-41	180-00-21	-5.632	385084.913664
26-32	41645.756	-68373.690	18.927	78-48-36	90-03-55	-0.156	10666.295640
26-33	41649.429	-68355.123	9.579	348-15-13	89-26-37	13.051	-892102.710273
26-109	41658.807	-68357.073	18.846	258-47-33	90-32-20	5.715	-390660.672195
						倍面積	361.680825
						面積	180.8404125

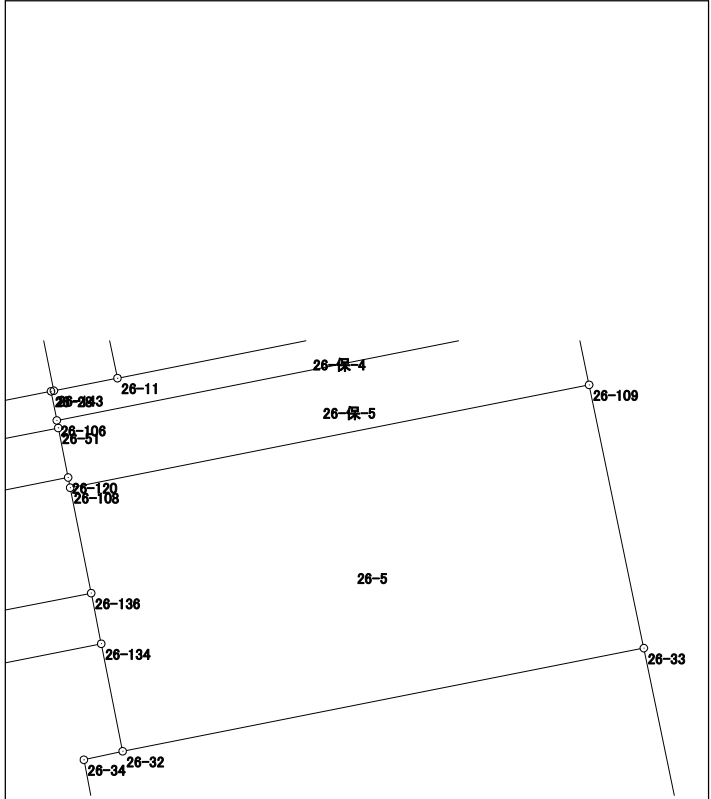

面積計算書 (座標法)

世界測地系 (測地成果2011)

所 在	地 番	公簿地目	現況地目	地 積	所 有 者
前橋市六供町一丁目	26-6			216.61 m ²	


点 名	X 座標	Y 座標	辺 長	方 向 角	測 角	DX	倍 積 (Y×DX)	
26-112	41639.028	-68352.968	10.622	348-17-40	89-31-11	14.377	-982710.620936	
26-33	41649.429	-68355.123	18.927	258-48-36	90-30-56	6.728	-459893.267544	
26-32	41645.756	-68373.690	1.415	257-38-01	178-49-25	-3.976	271853.791440	
26-34	41645.453	-68375.072	2.498	168-46-48	91-08-47	-2.753	188236.573216	
26-132	41643.003	-68374.586	0.703	168-46-12	179-59-24	-3.140	214696.200040	
26-45	41642.313	-68374.449	1.907	168-44-56	179-58-44	-2.560	175038.589440	
26-122	41640.443	-68374.077	5.497	168-43-22	179-58-26	-7.261	496464.173097	
26-113	41635.052	-68373.002	20.425	78-46-29	90-03-07	-1.415	96747.797830	
倍面積							433.236583	
面 積							216.6182915	

面積計算書（座標法）

世界測地系（測地成果2011）

所在	地番	公簿地目	現況地目	地積	所有者
前橋市六供町一丁目	26-7			224.90 m ²	

点名	X座標	Y座標	辺長	方向角	測角	DX	倍積 (Y×DX)
26-114	41630.301	-68372.066	1.054	168-43-58	89-57-37	-5.020	343227.771320
26-141	41629.267	-68371.860	8.514	168-45-27	180-01-29	-9.385	641669.906100
26-55	41620.916	-68370.200	1.395	168-57-50	180-12-23	-9.720	664558.344000
26-35	41619.547	-68369.933	1.226	78-48-33	89-50-43	-1.131	77326.394223
26-27	41619.785	-68368.730	5.563	78-45-10	179-56-37	1.323	-90451.829790
26-117	41620.870	-68363.274	13.778	78-45-31	180-00-21	3.771	-257797.906254
26-22	41623.556	-68349.760	10.959	348-16-52	89-31-21	13.417	-917048.729920
26-115	41634.287	-68351.986	20.472	258-46-21	90-29-29	6.745	-461034.145570
						倍面積	449.804109
						面積	224.9020545

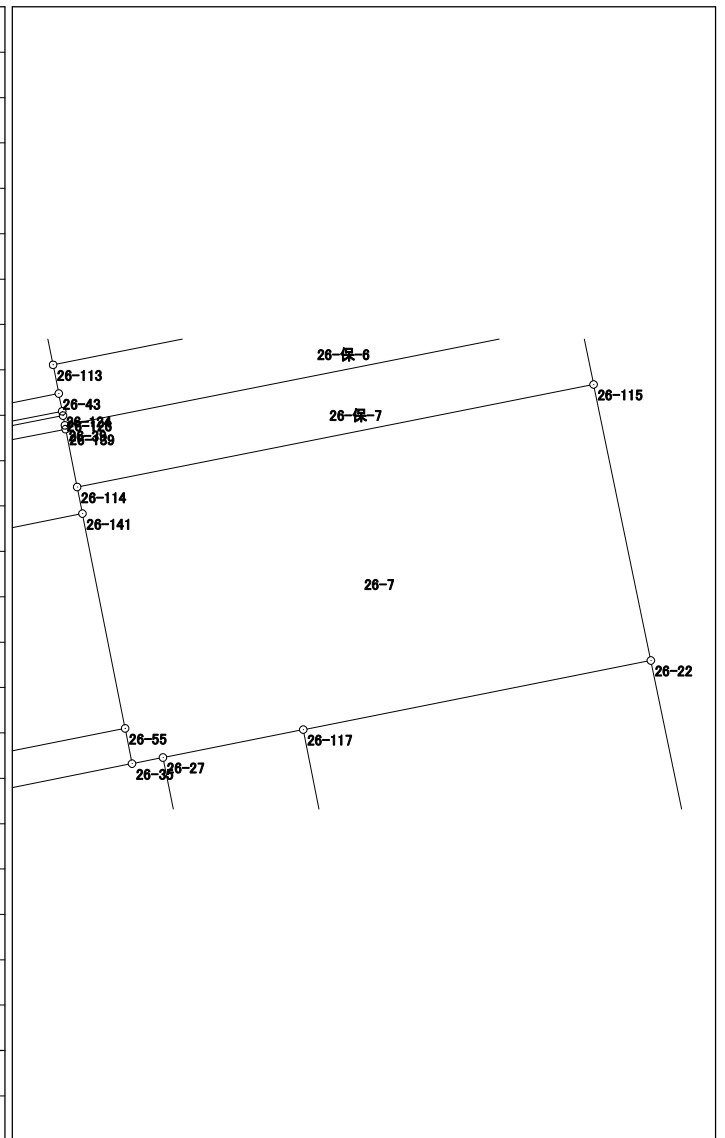


面積計算書 (座標法)

世界測地系 (測地成果2011)

所 在	地 番	公簿地目	現況地目	地 積	所 有 者
前橋市六供町一丁目	26-8			181.18 m ²	

点 名	X 座標	Y 座標	辺 長	方 向 角	測 角	DX	倍 積 (Y×DX)
26-116	41607.878	-68360.691	13.880	77-34-08	88-48-49	-10.004	683880.352764
26-4	41610.866	-68347.136	12.958	348-19-02	90-44-54	15.678	-1071546.398208
26-22	41623.556	-68349.760	13.778	258-45-31	90-26-29	10.004	-683770.999040
26-117	41620.870	-68363.274	13.246	168-45-19	89-59-48	-15.678	1071799.409772
						倍面積	362.365288
						面 積	181.1826440

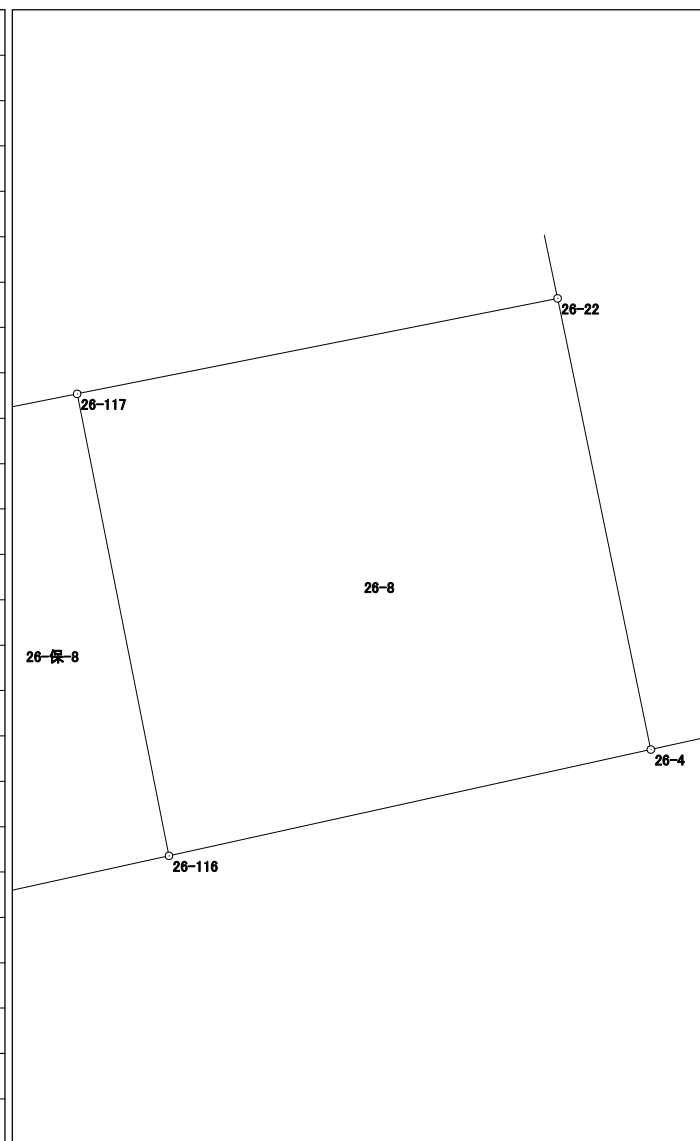


面積計算書（座標法）

世界測地系（測地成果2011）

所在	地番	公簿地目	現況地目	地積	所有者
前橋市六供町一丁目	26-10			110.83 m ²	

点名	X座標	Y座標	辺長	方向角	測角	DX	倍積 (Y×DX)
26-128	41611.120	-68392.321	5.689	168-40-34	89-40-44	-7.910	540983.259110
26-6	41605.542	-68391.204	6.012	123-08-35	134-28-01	-8.865	606288.023460
26-5	41602.255	-68386.170	7.917	77-32-31	134-23-56	-1.579	107981.762430
26-24	41603.963	-68378.439	9.675	348-44-49	91-12-18	11.197	-765633.381483
26-129	41613.452	-68380.327	12.219	258-59-50	90-15-01	7.157	-489398.000339

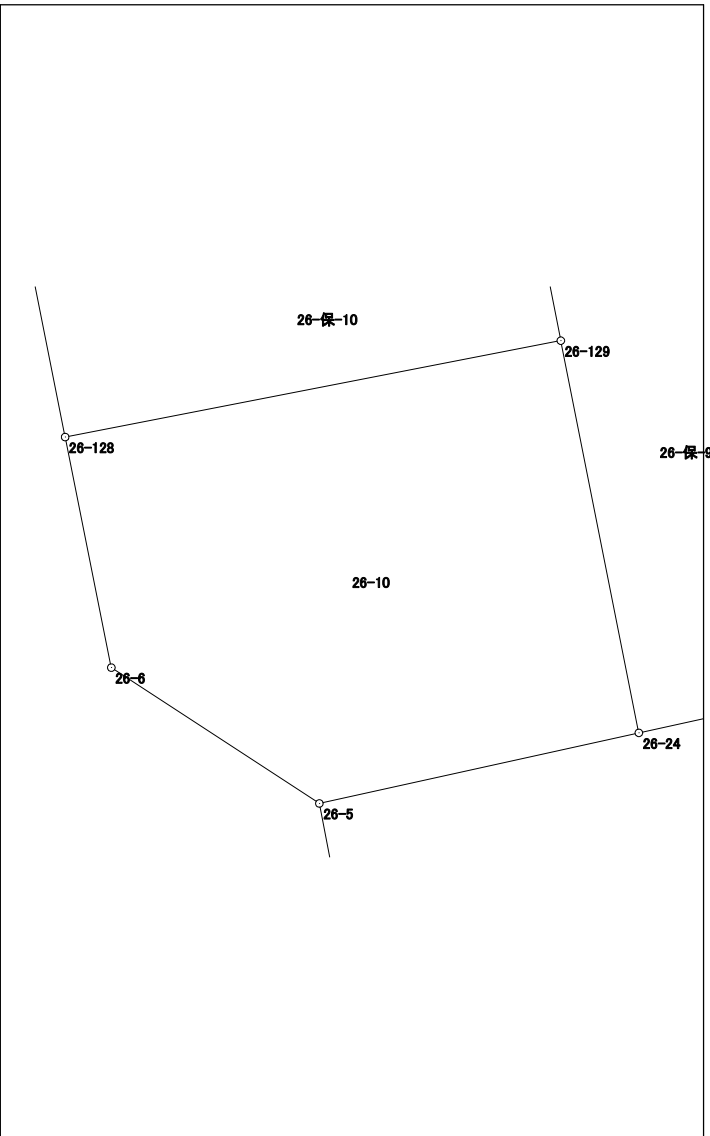


倍面積	221.663178
面積	110.8315890

面積計算書（座標法）

世界測地系（測地成果2011）

所 在	地 番	公簿地目	現況地目	地 積	所 有 者
前橋市六供町一丁目	26-12			200.98 m ²	

点 名	X 座標	Y 座標	辺 長	方 向 角	測 角	DX	倍 積 (Y×DX)
26-140	41624.678	-68395.013	8.504	168-49-34	90-02-13	-12.932	884484.308116
26-38	41616.335	-68393.365	12.225	78-51-00	90-01-26	-5.979	408923.929335
26-53	41618.699	-68381.371	11.389	78-46-30	179-55-30	4.581	-313255.060551
26-55	41620.916	-68370.200	8.514	348-45-27	89-58-57	10.568	-722536.273600
26-141	41629.267	-68371.860	23.603	258-47-21	90-01-54	3.762	-257214.937320
						倍面積	401.965980
						面 積	200.9829900

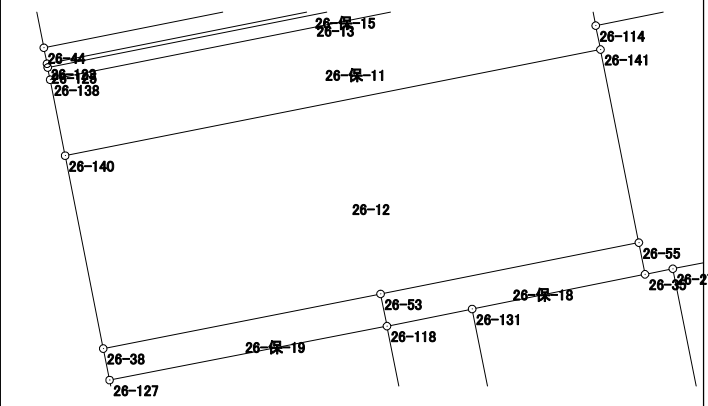


面積計算書（座標法）

世界測地系（測地成果2011）

所在	地番	公簿地目	現況地目	地積	所有者
前橋市六供町一丁目	26-15			156.58 m ²	

点名	X座標	Y座標	辺長	方向角	測角	DX	倍積 (Y×DX)
26-121	41635.850	-68397.227	6.632	168-45-59	89-59-18	-11.098	759072.425246
26-44	41629.345	-68395.935	23.606	78-47-16	90-01-17	-1.915	130978.215525
26-43	41633.935	-68372.780	1.139	348-45-33	89-58-17	5.707	-390203.455460
26-113	41635.052	-68373.002	5.497	348-43-22	179-57-49	6.508	-444971.497016
26-122	41640.443	-68374.077	23.601	258-46-41	90-03-19	0.798	-54562.513446
						倍面積	313.174849
						面積	156.5874245

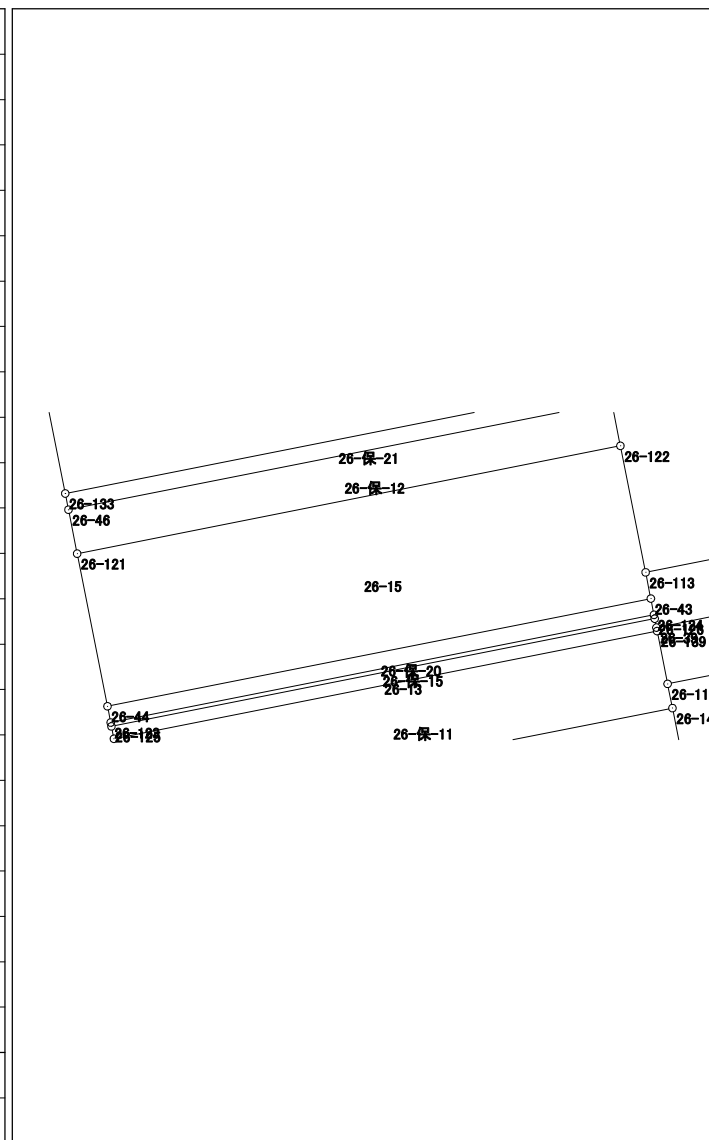


面積計算書 (座標法)

世界測地系 (測地成果2011)

所在	地番	公簿地目	現況地目	地積	所有者
前橋市六供町一丁目	26-17			157.25 m ²	

点名	X座標	Y座標	辺長	方向角	測角	D _X	倍積 (Y×DX)
26-132	41643.003	-68374.586	2.498	348-46-48	89-59-51	7.041	-481425.460026
26-34	41645.453	-68375.072	1.415	77-38-01	268-51-13	2.753	-188236.573216
26-32	41645.756	-68373.690	3.904	348-44-41	91-06-40	4.132	-282520.087080
26-134	41649.585	-68374.452	25.011	258-46-36	90-01-55	-1.039	71041.055628
26-135	41644.717	-68398.985	6.428	168-47-10	90-00-34	-11.173	764221.859405
26-133	41638.412	-68397.735	23.600	78-46-57	89-59-47	-1.714	117233.717790

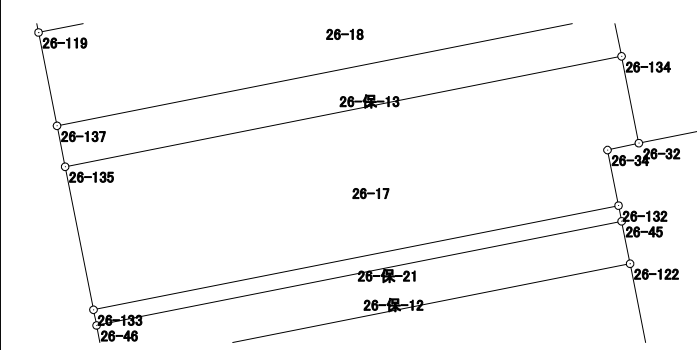


倍面積	314.512501
面積	157.2562505

面積計算書（座標法）

世界測地系（測地成果2011）

所 在	地 番	公簿地目	現況地目	地 積	所 有 者
前橋市六供町一丁目	26-18			104.95 m ²	

点 名	X 座標	Y 座標	辺 長	方 向 角	測 角	DX	倍 積 (Y×DX)
26-136	41651.388	-68374.811	3.830	348-43-20	89-56-29	8.622	-589527.620442
26-108	41655.144	-68375.560	0.370	348-46-52	180-03-32	4.119	-281638.931640
26-120	41655.507	-68375.632	25.006	258-46-02	89-59-10	-4.508	308237.349056
26-119	41650.636	-68400.159	4.194	168-46-52	90-00-50	-8.985	614575.428615
26-137	41646.522	-68399.343	25.010	78-46-51	89-59-59	0.752	-51436.305936
						倍面積	209.919653
						面 積	104.9598265

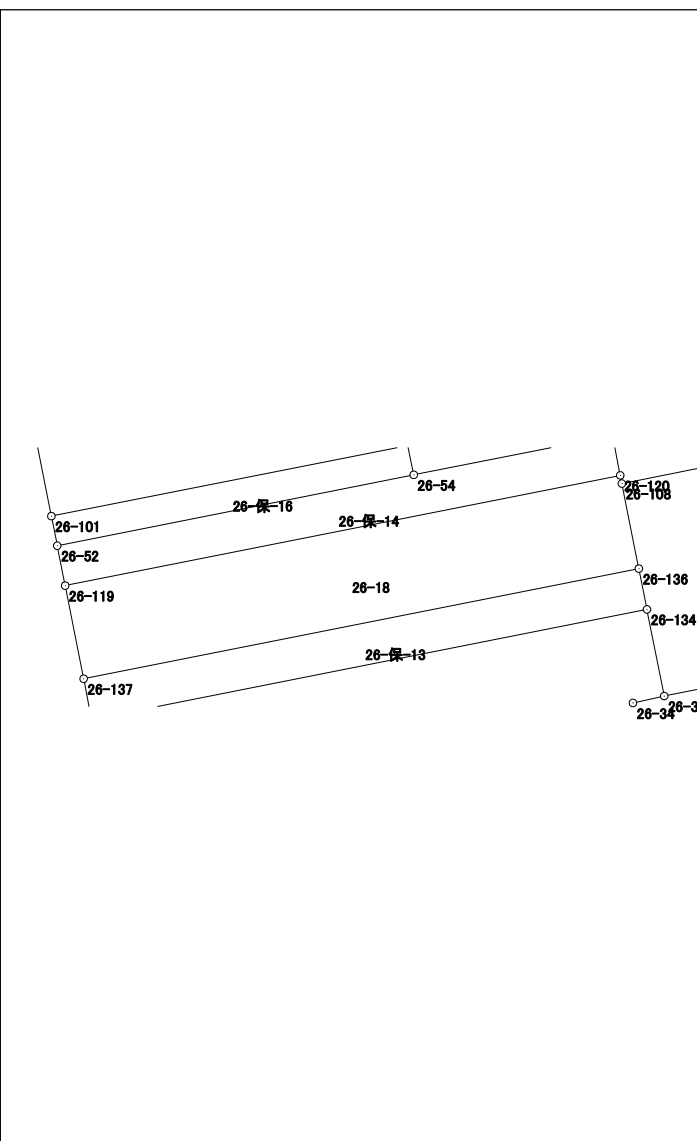


面積計算書 (座標法)

世界測地系 (測地成果2011)

所在	地番	公簿地目	現況地目	地積	所有者
前橋市六供町一丁目	26-保-1			51.00 m ²	

点名	X座標	Y座標	辺長	方向角	測角	DX	倍積 (Y×DX)
26-103	41656.828	-68385.026	3.181	348-17-02	89-30-05	6.237	-426517.407162
26-102	41659.943	-68385.672	16.021	258-46-52	90-29-50	-0.002	136.771344
26-144	41656.826	-68401.387	3.181	168-46-42	89-59-50	-6.237	426619.450719
26-101	41653.706	-68400.768	16.049	78-46-57	90-00-15	0.002	-136.801536
						倍面積	102.013365
						面積	51.0066825

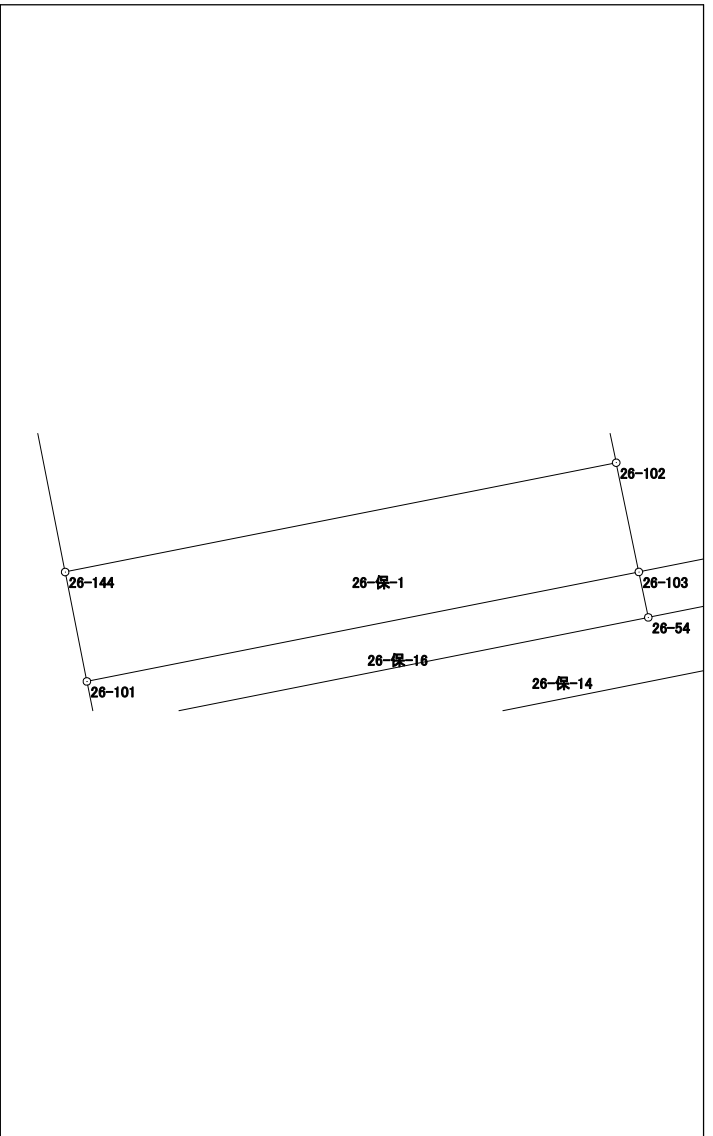


面積計算書（座標法）

世界測地系（測地成果2011）

所 在	地 番	公簿地目	現況地目	地 積	所 有 者
前橋市六供町一丁目	26-保-2			30.00 m ²	

点 名	X 座標	Y 座標	辺 長	方 向 角	測 角	DX	倍 積 (Y×DX)
26-12	41671.787	-68376.511	2.308	258-16-35	89-57-51	9.407	-643217.838977
26-142	41671.318	-68378.771	12.989	168-18-34	90-01-59	-13.189	901847.610719
26-143	41658.598	-68376.139	2.308	78-49-53	90-31-19	-12.273	839180.353947
26-11	41659.045	-68373.875	2.927	348-18-36	89-28-43	3.313	-226522.647875
26-105	41661.911	-68374.468	10.085	348-18-44	180-00-08	12.742	-871227.471256
						倍面積	60.006558
						面 積	30.0032790

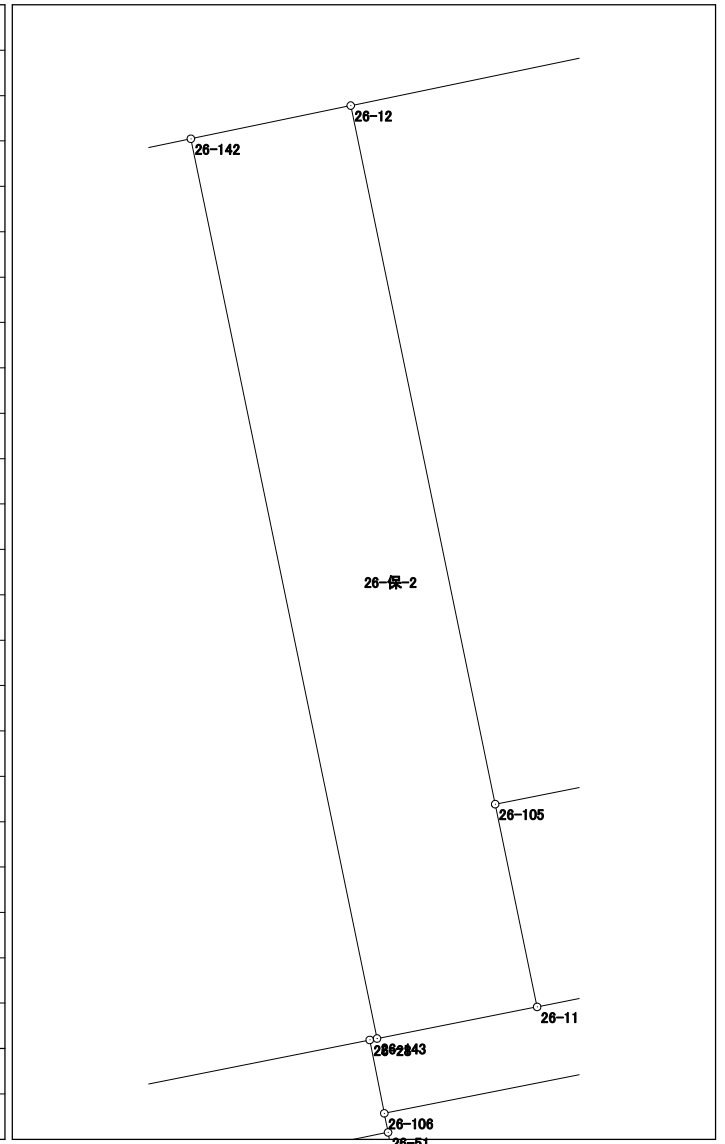


面積計算書（座標法）

世界測地系（測地成果2011）

所 在	地 番	公簿地目	現況地目	地 積	所 有 者
前橋市六供町一丁目	26-保-4			19.90 m ²	

点 名	X 座標	Y 座標	辺 長	方 向 角	測 角	DX	倍 積 (Y×DX)
26-8	41662.235	-68357.785	16.403	258-47-09	90-29-56	-2.153	147174.311105
26-11	41659.045	-68373.875	2.308	258-49-53	180-02-44	-3.637	248675.783375
26-143	41658.598	-68376.139	0.105	259-00-41	180-10-48	-0.467	31931.656913
26-28	41658.578	-68376.242	1.058	168-46-30	89-45-49	-1.058	72342.064036
26-106	41657.540	-68376.036	18.825	78-47-42	90-01-12	2.620	-179145.214320
26-107	41661.198	-68357.570	1.059	348-17-13	89-29-31	4.695	-320938.791150
倍面積						39.809959	
面 積						19.9049795	

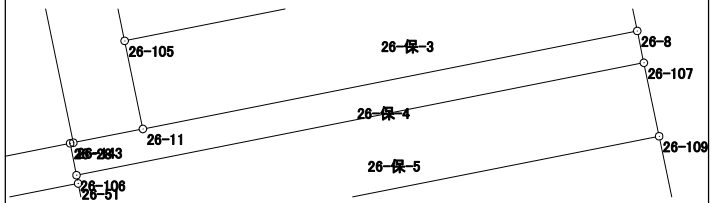


面積計算書 (座標法)

世界測地系 (測地成果2011)

所在	地番	公簿地目	現況地目	地積	所有者
前橋市六供町一丁目	26-保-5			46.00 m ²	

点名	X座標	Y座標	辺長	方向角	測角	DX	倍積 (Y×DX)
26-106	41657.540	-68376.036	0.274	168-51-14	90-03-32	-3.927	268512.693372
26-51	41657.271	-68375.983	1.799	168-44-47	179-53-33	-2.033	139008.373439
26-120	41655.507	-68375.632	0.370	168-46-52	180-02-05	-2.127	145434.969264
26-108	41655.144	-68375.560	18.846	78-47-33	90-00-41	3.300	-225639.348000
26-109	41658.807	-68357.073	2.442	348-15-27	89-27-54	6.054	-413833.719942
26-107	41661.198	-68357.570	18.825	258-47-42	90-32-15	-1.267	86609.041190

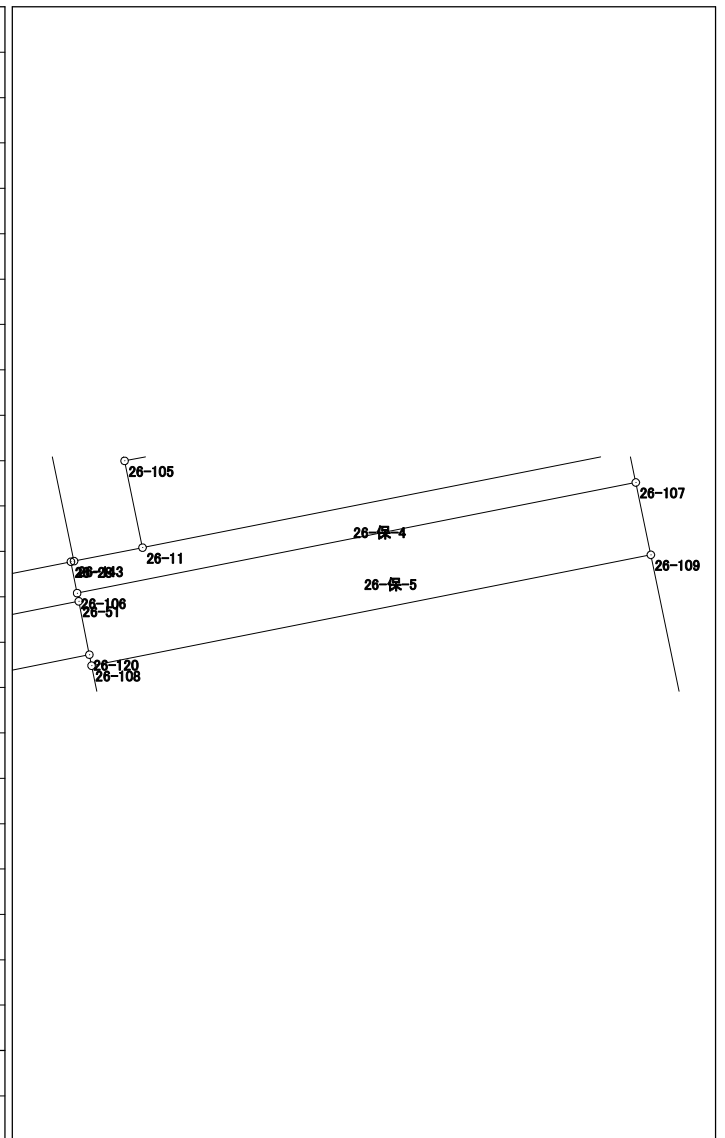


倍面積	92.009323
面積	46.0046615

面積計算書（座標法）

世界測地系（測地成果2011）

所 在	地 番	公簿地目	現況地目	地 積	所 有 者
前橋市六供町一丁目	26-保-6			49.00 m ²	

点 名	X 座標	Y 座標	辺 長	方 向 角	測 角	DX	倍 積 (Y×DX)
26-39	41632.698	-68372.543	20.452	78-46-23	89-40-31	3.603	-246346.272429
26-37	41636.680	-68352.482	2.398	348-18-21	89-31-58	6.330	-432671.211060
26-112	41639.028	-68352.968	20.425	258-46-29	90-28-08	-1.628	111278.631904
26-113	41635.052	-68373.002	1.139	168-45-33	89-59-04	-5.093	348223.699186
26-43	41633.935	-68372.780	0.703	169-11-07	180-25-34	-1.808	123617.986240
26-124	41633.244	-68372.648	0.170	169-09-10	179-58-03	-0.858	58663.731984
26-126	41633.077	-68372.616	0.386	169-05-52	179-56-42	-0.546	37331.448336

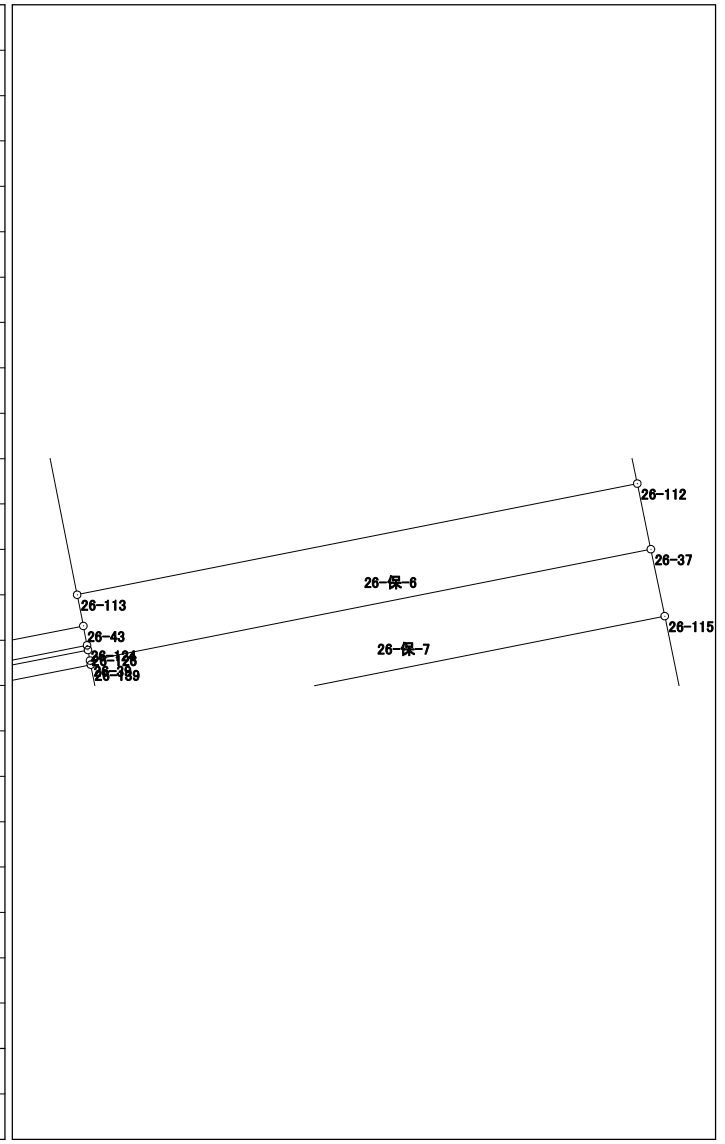


倍面積	98.014161
面積	49.0070805

面積計算書（座標法）

世界測地系（測地成果2011）

所 在	地 番	公簿地目	現況地目	地 積	所 有 者
前橋市六供町一丁目	26-保-7			50.00 m ²	

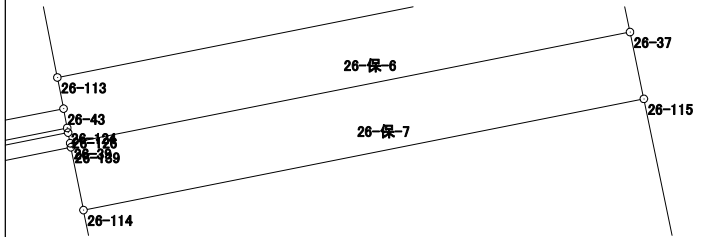
点 名	X 座標	Y 座標	辺 長	方 向 角	測 角	DX	倍 積 (Y×DX)		
26-39	41632.698	-68372.543	0.151	168-54-49	90-08-26	-4.130	282378.602590		
26-139	41632.550	-68372.514	2.293	168-44-03	179-49-14	-2.397	163888.916058		
26-114	41630.301	-68372.066	20.472	78-46-21	90-02-18	1.737	-118762.278642		
26-115	41634.287	-68351.986	2.444	348-17-24	89-31-03	6.379	-436017.318694		
26-37	41636.680	-68352.482	20.452	258-46-23	90-28-59	-1.589	108612.093898		
							倍面積		100.015210
							面 積		50.0076050

面積計算書（座標法）

世界測地系（測地成果2011）

所 在	地 番	公簿地目	現況地目	地 積	所 有 者
前橋市六供町一丁目	26-保-8			74.00 m ²	

点 名	X 座標	Y 座標	辺 長	方 向 角	測 角	DX	倍 積 (Y×DX)
26-26	41606.681	-68366.125	5.564	77-34-38	88-49-15	-11.907	814035.450375
26-116	41607.878	-68360.691	13.246	348-45-19	91-10-41	14.189	-969969.844599
26-117	41620.870	-68363.274	5.563	258-45-10	89-59-51	11.907	-814001.503518
26-27	41619.785	-68368.730	13.360	168-45-23	90-00-13	-14.189	970083.909970
						倍面積	148.012228
						面 積	74.0061140

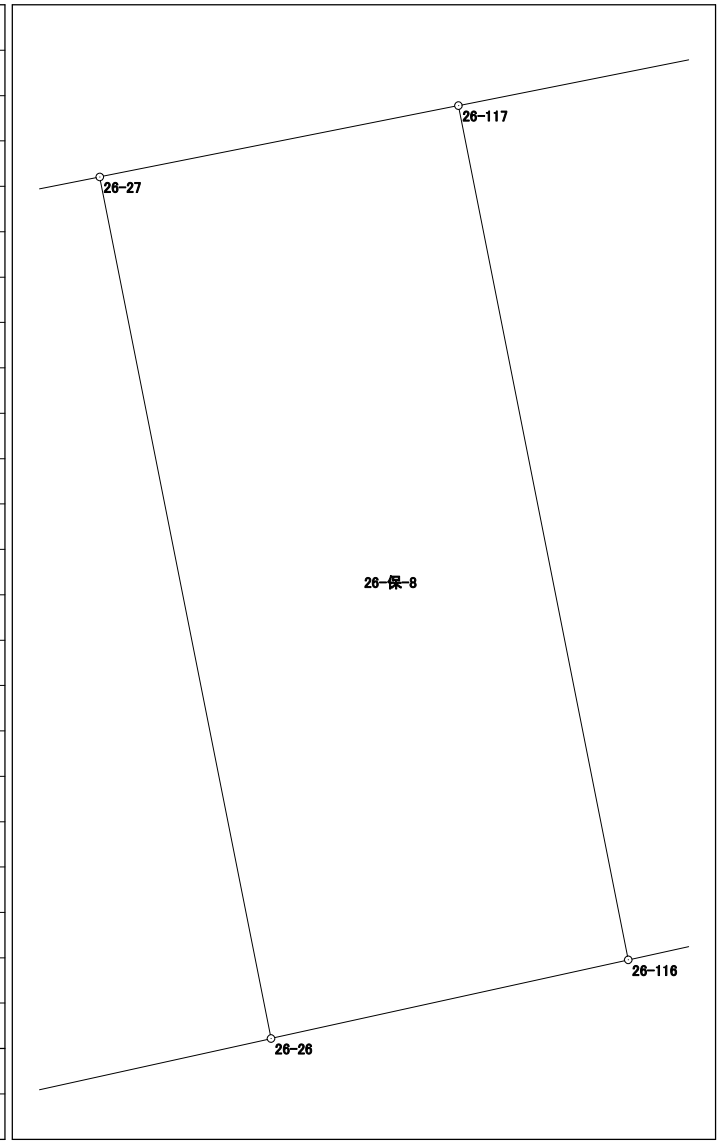


面積計算書（座標法）

世界測地系（測地成果2011）

所在	地番	公簿地目	現況地目	地積	所有者
前橋市六供町一丁目	26-保-9			51.00 m ²	

点名	X座標	Y座標	辺長	方向角	測角	DX	倍積 (Y×DX)
26-118	41617.305	-68381.094	3.929	168-44-30	90-05-47	-4.593	314074.364742
26-129	41613.452	-68380.327	9.675	168-44-49	180-00-19	-13.342	912330.322834
26-24	41603.963	-68378.439	3.760	77-33-38	88-48-49	-8.679	593456.472081
26-130	41604.773	-68374.767	13.532	348-44-30	91-10-52	14.082	-962853.468894
26-131	41618.045	-68377.409	3.759	258-38-43	89-54-13	12.532	-856905.689588
倍面積							102.001175
面積							51.0005875

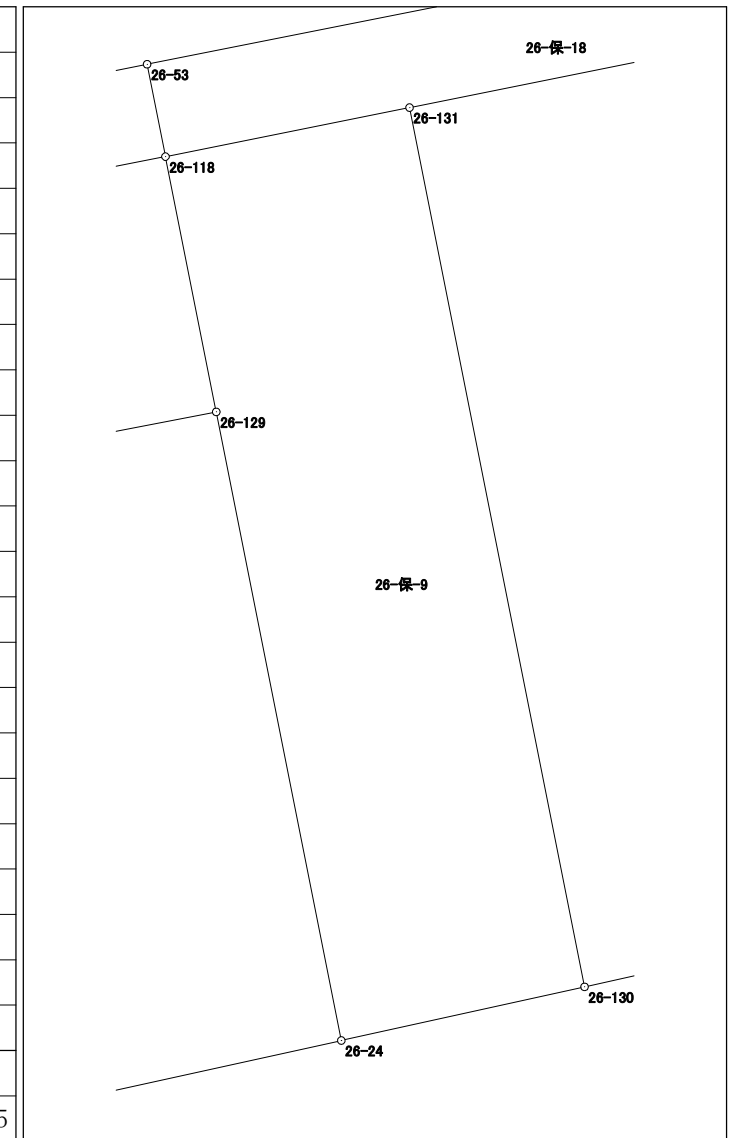


面積計算書 (座標法)

世界測地系 (測地成果2011)

所在	地番	公簿地目	現況地目	地積	所有者
前橋市六供町一丁目	26-保-10			48.00 m ²	

点名	X座標	Y座標	辺長	方向角	測角	DX	倍積 (Y×DX)
26-127	41614.972	-68393.092	3.928	168-40-53	89-41-07	-6.185	423011.274020
26-128	41611.120	-68392.321	12.219	78-59-50	90-18-57	-1.520	103956.327920
26-129	41613.452	-68380.327	3.929	348-44-30	89-44-40	6.185	-422932.322495
26-118	41617.305	-68381.094	12.223	258-59-46	90-15-16	1.520	-103939.262880
						倍面積	96.016565
						面積	48.0082825

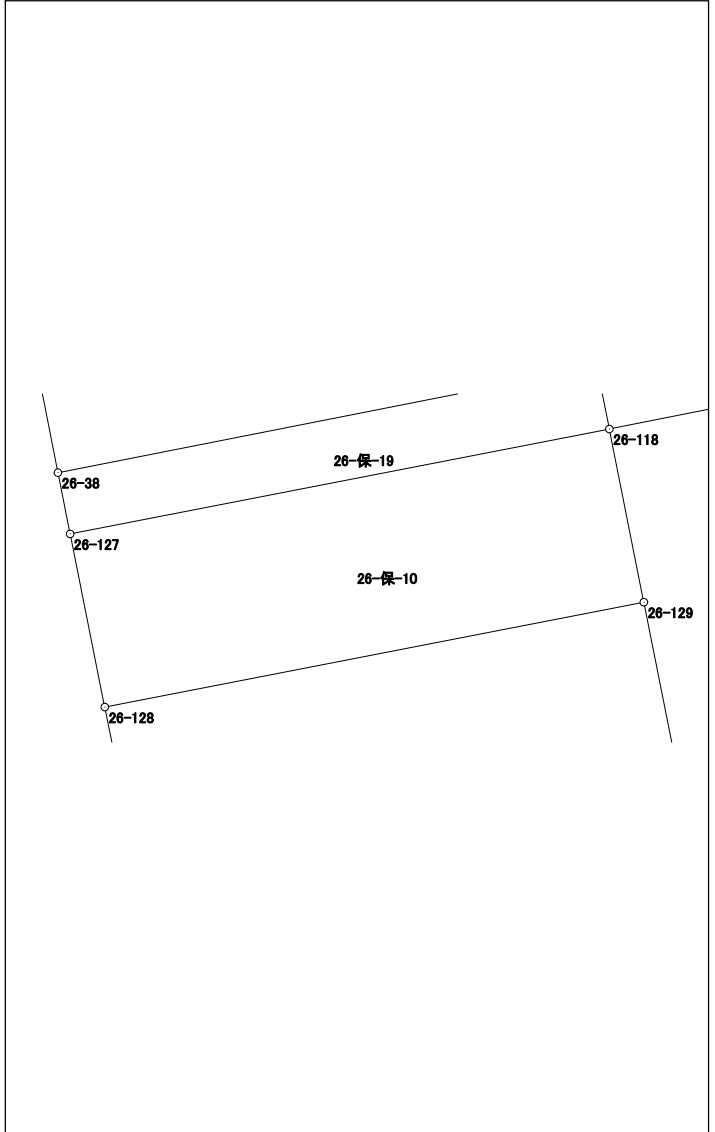


面積計算書（座標法）

世界測地系（測地成果2011）

所在	地番	公簿地目	現況地目	地積	所有者
前橋市六供町一丁目	26-保-12			45.00 m ²	

点名	X座標	Y座標	辺長	方向角	測角	DX	倍積(Y×DX)
26-46	41637.721	-68397.598	1.907	168-47-04	90-00-16	-6.463	442053.675874
26-121	41635.850	-68397.227	23.601	78-46-41	89-59-37	2.722	-186177.251894
26-122	41640.443	-68374.077	1.907	348-44-56	89-58-15	6.463	-441901.659651
26-45	41642.313	-68374.449	23.600	258-46-48	90-01-52	-2.722	186115.250178

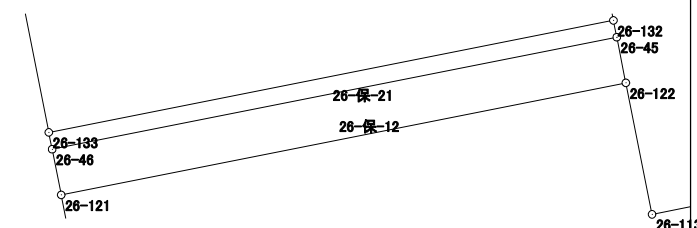

倍面積	90.014507
面積	45.0072535


面積計算書 (座標法)

世界測地系 (測地成果2011)

所在	地番	公簿地目	現況地目	地積	所有者
前橋市六供町一丁目	26-保-13			46.00 m ²	

点名	X座標	Y座標	辺長	方向角	測角	DX	倍積 (Y×DX)
26-135	41644.717	-68398.985	25.011	78-46-36	89-59-42	3.063	-209506.091055
26-134	41649.585	-68374.452	1.838	348-44-20	89-57-44	6.671	-456125.969292
26-136	41651.388	-68374.811	25.010	258-46-51	90-02-31	-3.063	209432.046093
26-137	41646.522	-68399.343	1.840	168-46-54	90-00-03	-6.671	456292.017153

倍面積	92.002899
面積	46.0014495

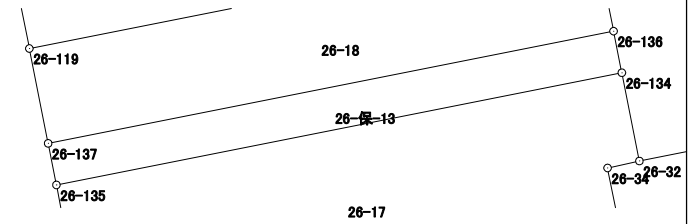


面積計算書（座標法）

世界測地系（測地成果2011）

所在	地番	公簿地目	現況地目	地積	所有者
前橋市六供町一丁目	26-保-14			45.00 m ²	

点名	X座標	Y座標	辺長	方向角	測角	DX	倍積 (Y×DX)
26-54	41655.531	-68384.757	16.060	258-45-29	179-58-30	-4.871	333102.151347
26-52	41652.400	-68400.509	1.798	168-46-39	90-01-10	-4.895	334820.491555
26-119	41650.636	-68400.159	25.006	78-46-02	89-59-23	3.107	-212519.294013
26-120	41655.507	-68375.632	1.799	348-44-47	89-58-45	6.635	-453672.318320
26-51	41657.271	-68375.983	8.945	258-46-59	90-02-12	0.024	-1641.023592
倍面積						90.006977	
面積						45.0034885	

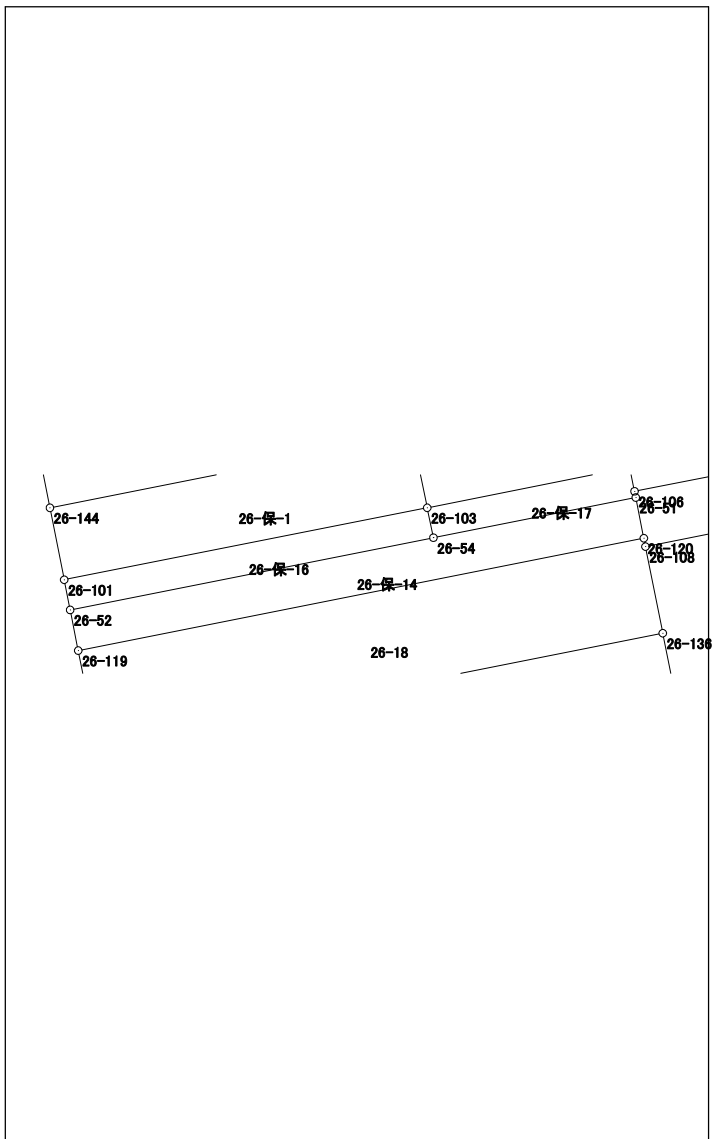


面積計算書（座標法）

世界測地系（測地成果2011）

所在	地番	公簿地目	現況地目	地積	所有者
前橋市六供町一丁目	26-保-16			21.32 m ²	

点名	X座標	Y座標	辺長	方向角	測角	DX	倍積 (Y×DX)
26-103	41656.828	-68385.026	16.049	258-46-57	90-29-59	-1.825	124802.672450
26-101	41653.706	-68400.768	1.331	168-46-58	90-00-01	-4.428	302878.600704
26-52	41652.400	-68400.509	16.060	78-45-29	89-58-31	1.825	-124830.928925
26-54	41655.531	-68384.757	1.325	348-16-58	89-31-29	4.428	-302807.703996
						倍面積	42.640233
						面積	21.3201165

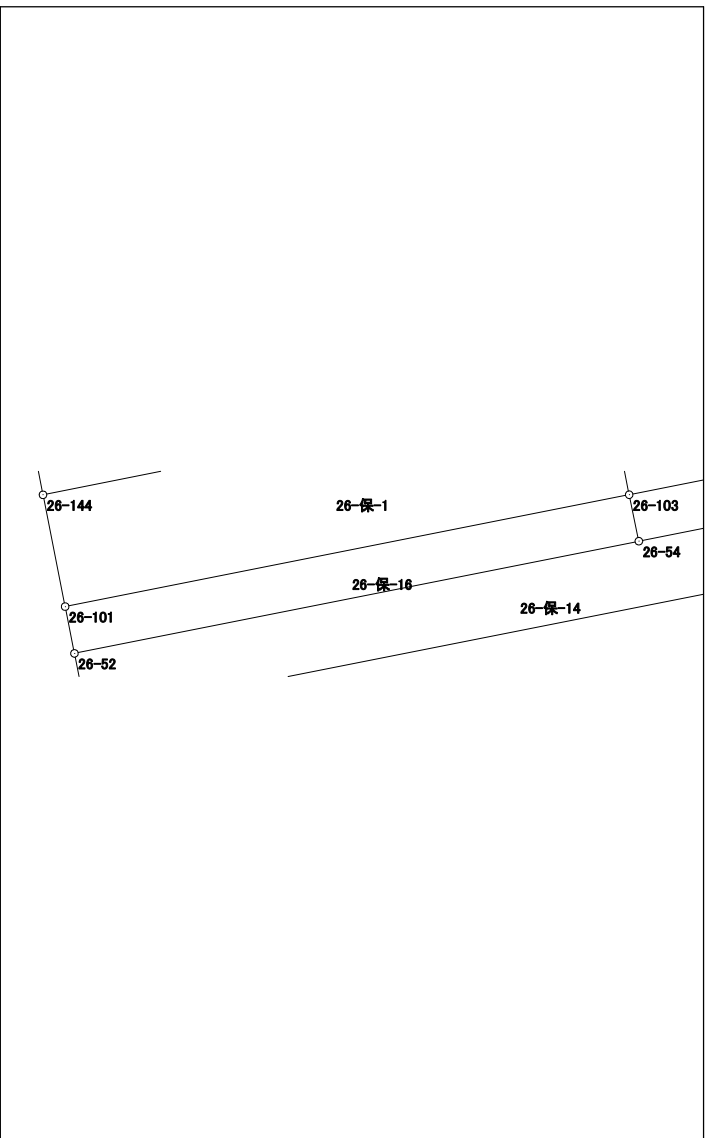


面積計算書 (座標法)

世界測地系 (測地成果2011)

所在	地番	公簿地目	現況地目	地積	所有者
前橋市六供町一丁目	26-保-17			11.89 m ²	

点名	X座標	Y座標	辺長	方向角	測角	DX	倍積 (Y×DX)
26-28	41658.578	-68376.242	8.957	258-43-58	89-57-28	-0.712	48683.884304
26-103	41656.828	-68385.026	1.325	168-16-58	89-33-00	-3.047	208369.174222
26-54	41655.531	-68384.757	8.945	78-46-59	90-30-01	0.443	-30294.447351
26-51	41657.271	-68375.983	0.274	348-51-14	90-04-15	2.009	-137367.349847
26-106	41657.540	-68376.036	1.058	348-46-30	179-55-16	1.307	-89367.479052
						倍面積	23.782276
						面積	11.8911380

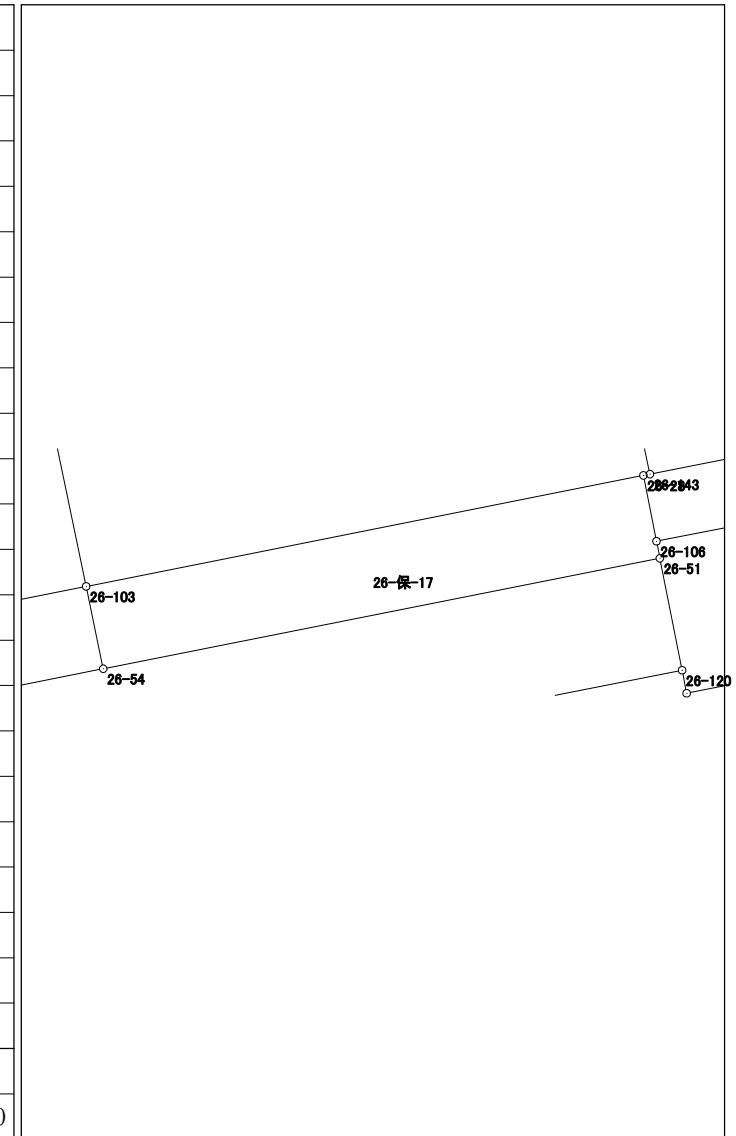


面積計算書（座標法）

世界測地系（測地成果2011）

所在	地番	公簿地目	現況地目	地積	所有者
前橋市六供町一丁目	26-保-18			16.03 m ²	

点名	X座標	Y座標	辺長	方向角	測角	DX	倍積 (Y×DX)
26-35	41619.547	-68369.933	1.395	348-57-50	90-19-26	2.871	-196290.077643
26-55	41620.916	-68370.200	11.389	258-46-30	89-48-40	-0.848	57977.929600
26-53	41618.699	-68381.371	1.421	168-45-40	89-59-10	-3.611	246925.130681
26-118	41617.305	-68381.094	3.759	78-38-43	89-53-03	-0.654	44721.235476
26-131	41618.045	-68377.409	7.625	78-38-24	179-59-41	2.242	-153302.150978
倍面積						32.067136	
面積						16.0335680	

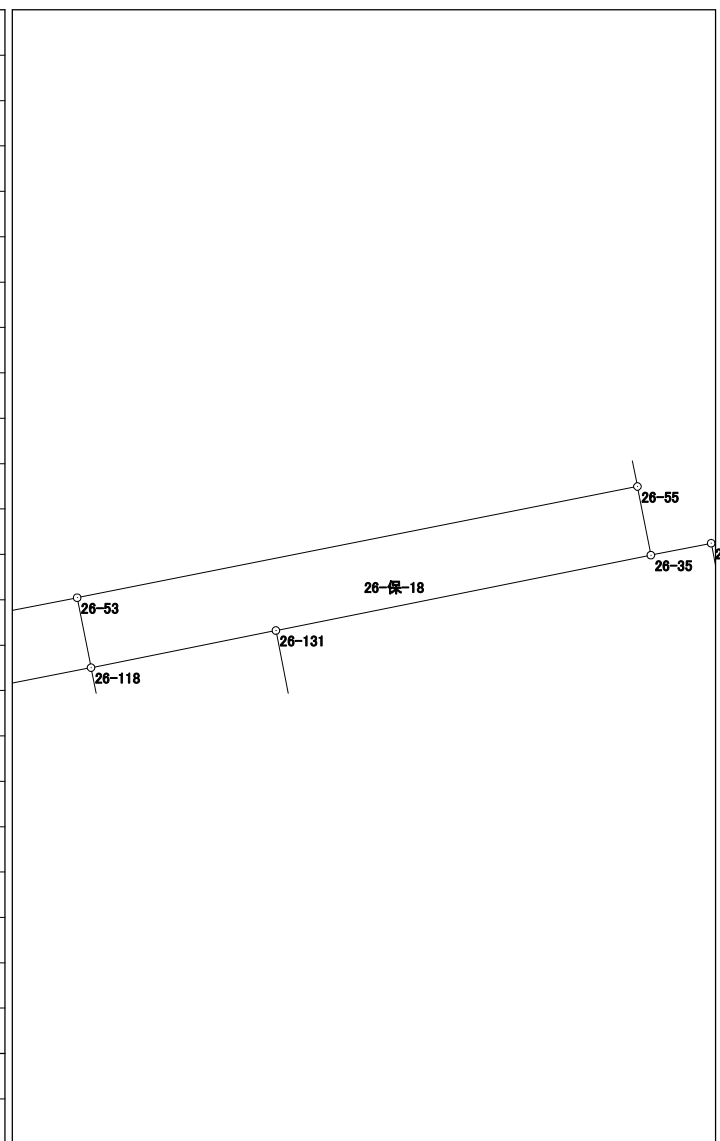


面積計算書（座標法）

世界測地系（測地成果2011）

所在	地番	公簿地目	現況地目	地積	所有者
前橋市六供町一丁目	26-保-19			17.18 m ²	

点名	X座標	Y座標	辺長	方向角	測角	DX	倍積 (Y×DX)
26-118	41617.305	-68381.094	1.421	348-45-40	89-45-54	3.727	-254856.337338
26-53	41618.699	-68381.371	12.225	258-51-00	90-05-20	-0.970	66329.929870
26-38	41616.335	-68393.365	1.390	168-40-26	89-49-26	-3.727	254902.071355
26-127	41614.972	-68393.092	12.223	78-59-46	90-19-20	0.970	-66341.299240

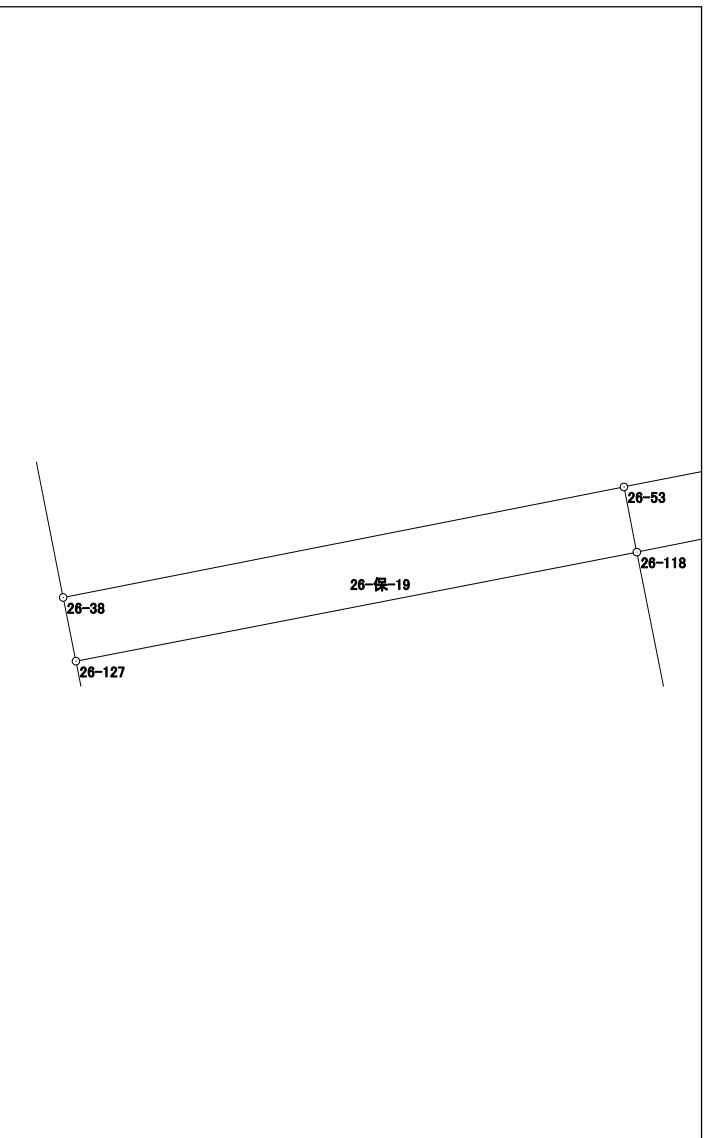


倍面積	34.364647
面積	17.1823235

面積計算書 (座標法)

世界測地系 (測地成果2011)

所在	地番	公簿地目	現況地目	地積	所有者
前橋市六供町一丁目	26-保-21			16.61 m ²	

点名	X座標	Y座標	辺長	方向角	測角	DX	倍積 (Y×DX)
26-45	41642.313	-68374.449	0.703	348-46-12	89-59-24	5.282	-361153.839618
26-132	41643.003	-68374.586	23.600	258-46-57	90-00-45	-3.901	266729.259986
26-133	41638.412	-68397.735	0.704	168-47-09	90-00-12	-5.282	361276.836270
26-46	41637.721	-68397.598	23.600	78-46-48	89-59-39	3.901	-266819.029798

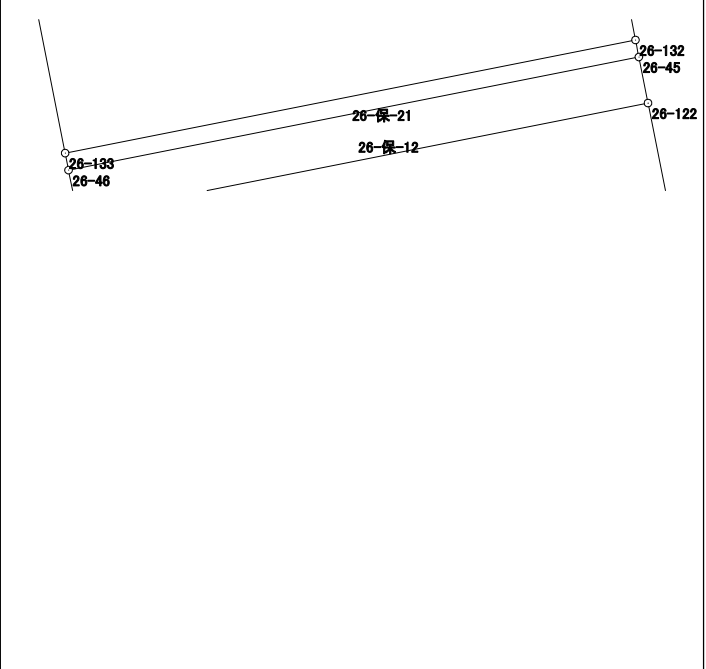

倍面積	33.226840
面積	16.6134200