


28街区 画地出来形確認図 (4892.06㎡)



S=1/500

⊕ 4-448

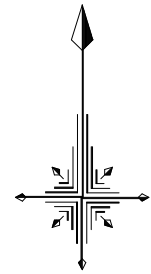

⊕ 4-438

⊕ 4-452

⊕ 4-451

⊕ 4-440


⊕ 4-439

面積計算書 (座標法)

世界測地系 (測地成果2011)

所在	地番	公簿地目	現況地目	地積	所有者
前橋市六供町二丁目	28-1			719.01 m ²	

点名	X座標	Y座標	辺長	方向角	測角	D _X	倍積 (Y×D _X)
28-101	41544.558	-68289.412	19.666	347-29-22	89-43-42	27.046	-1846955.436952
28-56	41563.757	-68293.672	33.948	257-33-30	90-04-08	11.885	-811670.291720
28-40	41556.443	-68326.823	3.998	212-47-59	135-14-29	-10.675	729388.835525
28-39	41553.082	-68328.989	16.721	168-15-38	135-27-39	-19.732	1348267.610948
28-102	41536.711	-68325.587	37.016	77-45-40	89-30-02	-8.524	582407.303588
倍面積						1438.021389	
面積						719.0106945	

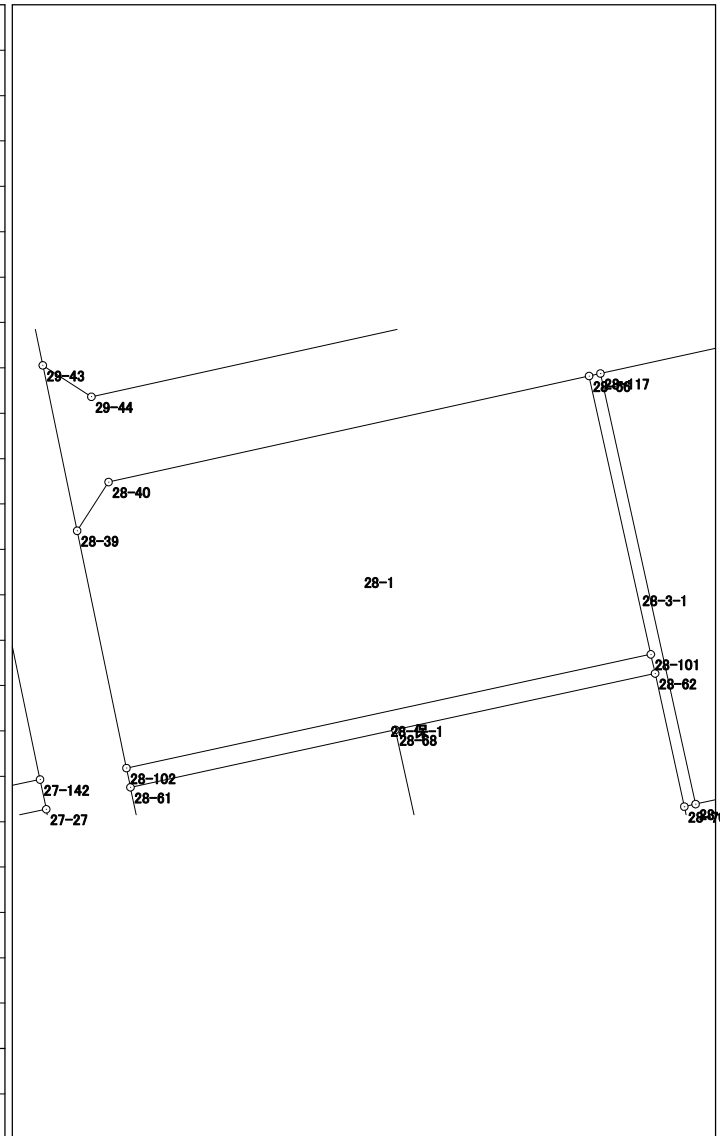


面積計算書 (座標法)

世界測地系 (測地成果2011)

所 在	地 番	公簿地目	現況地目	地 積	所 有 者
前橋市六供町二丁目	28-3-1			24.11 m ²	

点 名	X 座 標	Y 座 標	辺 長	方 向 角	測 角	DX	倍 積 (Y×DX)
28-117	41563.930	-68292.889	0.802	257-32-27	90-00-16	29.529	-2016620.719281
28-56	41563.757	-68293.672	19.666	167-29-22	89-56-55	-19.372	1322985.013984
28-101	41544.558	-68289.412	1.352	167-29-06	179-59-44	-20.519	1401230.444828
28-62	41543.238	-68289.119	9.401	167-37-00	180-07-54	-10.502	717172.327738
28-70	41534.056	-68287.103	0.798	77-32-57	89-55-57	-9.010	615266.798030
28-118	41534.228	-68286.324	30.419	347-32-11	89-59-14	29.874	-2039985.643176
						倍面積	48.222123
						面 積	24.1110615

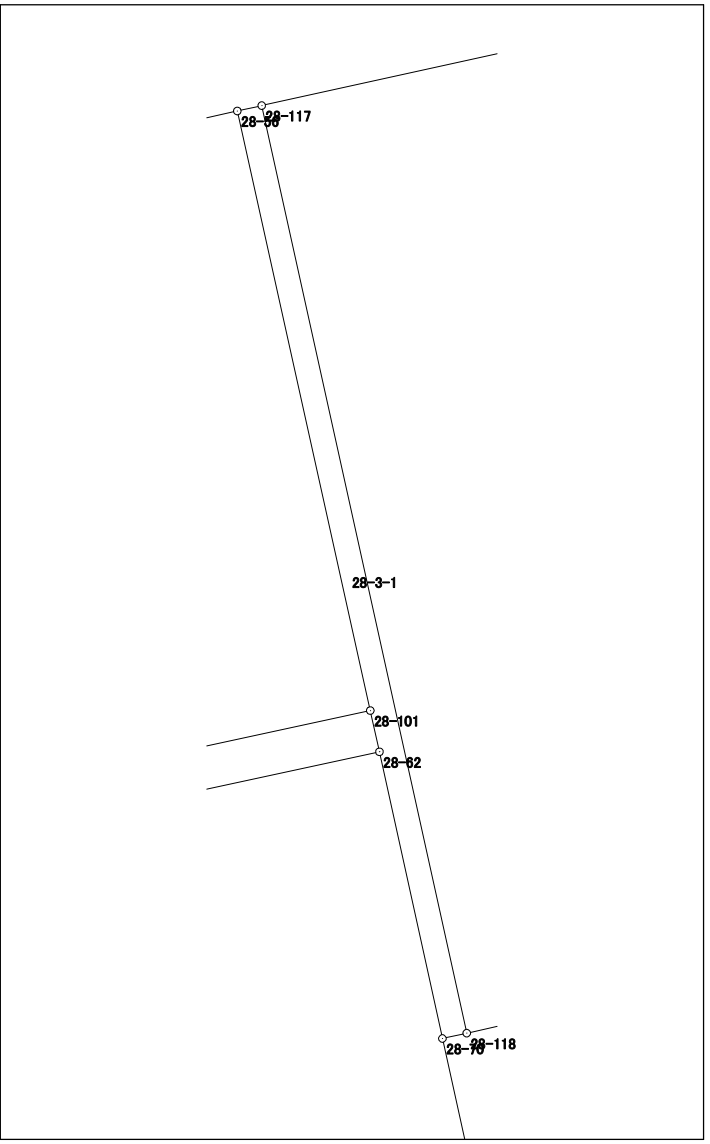


面積計算書 (座標法)

世界測地系 (測地成果2011)

所在	地番	公簿地目	現況地目	地積	所有者
前橋市六供町二丁目	28-3-2			299.83 m ²	

点名	X座標	Y座標	辺長	方向角	測角	DX	倍積 (Y×DX)
28-115	41566.050	-68283.261	9.859	257-34-56	90-02-35	27.575	-1882910.922075
28-117	41563.930	-68292.889	30.419	167-32-11	89-57-15	-31.822	2173216.313758
28-118	41534.228	-68286.324	9.857	77-32-19	90-00-08	-27.575	1882995.384300
28-116	41536.355	-68276.699	30.411	347-32-21	90-00-02	31.822	-2172701.115578
						倍面積	599.660405
						面積	299.8302025

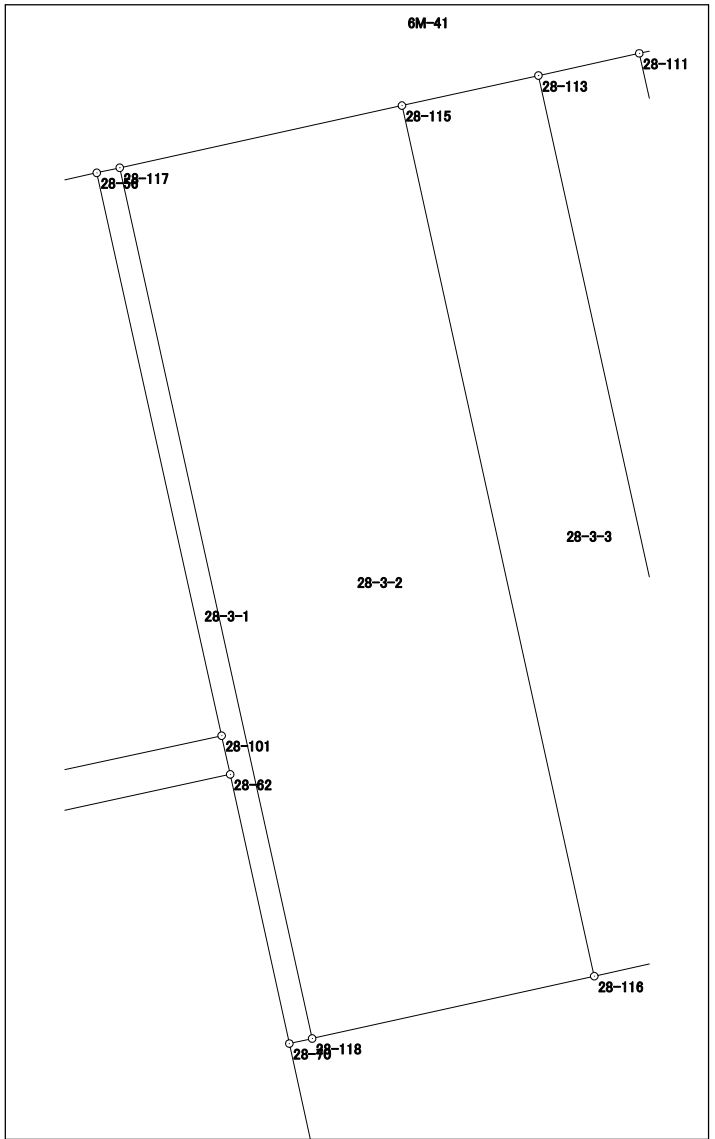


面積計算書 (座標法)

世界測地系 (測地成果2011)

所 在	地 番	公簿地目	現況地目	地 積	所 有 者
前橋市六供町二丁目	28-3-3			144.98 m ²	

点 名	X 座標	Y 座標	辺 長	方 向 角	測 角	DX	倍 積 (Y×DX)
28-113	41567.075	-68278.605	4.767	257-35-05	90-02-50	28.666	-1957274.490930
28-115	41566.050	-68283.261	30.411	167-32-21	89-57-16	-30.720	2097661.777920
28-116	41536.355	-68276.699	4.768	77-32-16	89-59-55	-28.666	1957219.853534
28-114	41537.384	-68272.043	30.407	347-32-15	89-59-59	30.720	-2097317.160960
						倍面積	289.979564
						面 積	144.9897820

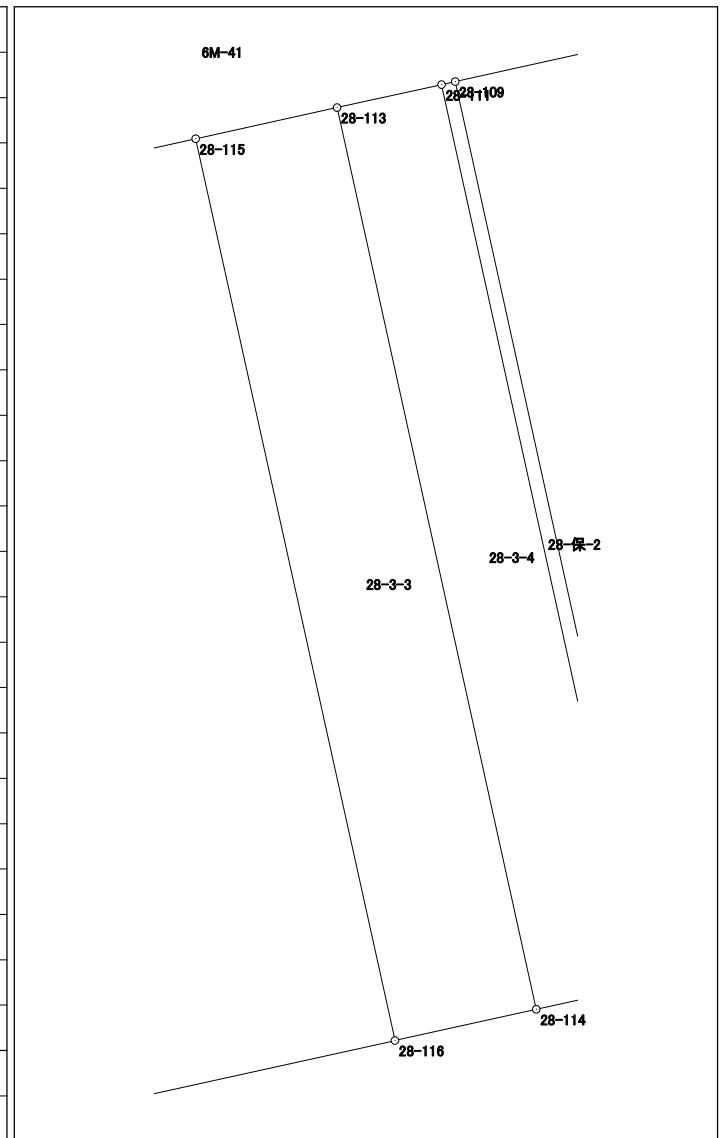


面積計算書 (座標法)

所在	地番	公簿地目	現況地目	地積	所有者
前橋市六供町二丁目	28-3-5			423.99 m ²	

点名	X座標	Y座標	辺長	方向角	測角	D _X	倍積 (Y×D _X)
28-107	41570.931	-68261.092	13.947	257-34-59	90-02-42	26.680	-1821205.934560
28-109	41567.932	-68274.713	30.406	167-32-12	89-57-13	-32.688	2231763.818544
28-110	41538.243	-68268.151	0.403	77-31-03	89-58-51	-29.602	2020873.805902
28-122	41538.330	-68267.758	2.574	77-32-46	180-01-43	0.642	-43827.900636
28-124	41538.885	-68265.245	2.718	77-32-56	180-00-10	1.141	-77890.644545
28-126	41539.471	-68262.591	8.060	77-32-23	179-59-27	2.325	-158710.524075
28-128	41541.210	-68254.721	0.193	77-24-24	179-52-01	1.781	-121561.658101
28-108	41541.252	-68254.533	30.395	347-32-17	90-07-53	29.721	-2028592.975293


倍面積	847.987236
面積	423.9936180

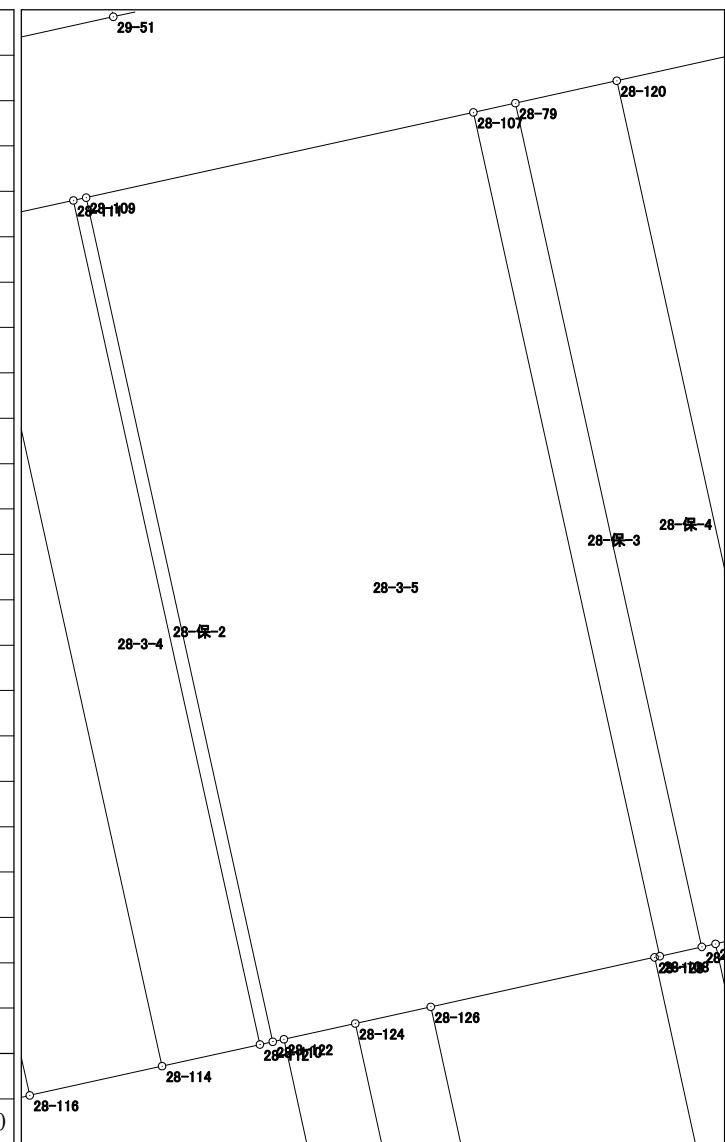

面積計算書（座標法）

世界測地系（測地成果2011）

所在	地番	公簿地目	現況地目	地積	所有者
前橋市六供町二丁目	28-6			578.62 m ²	

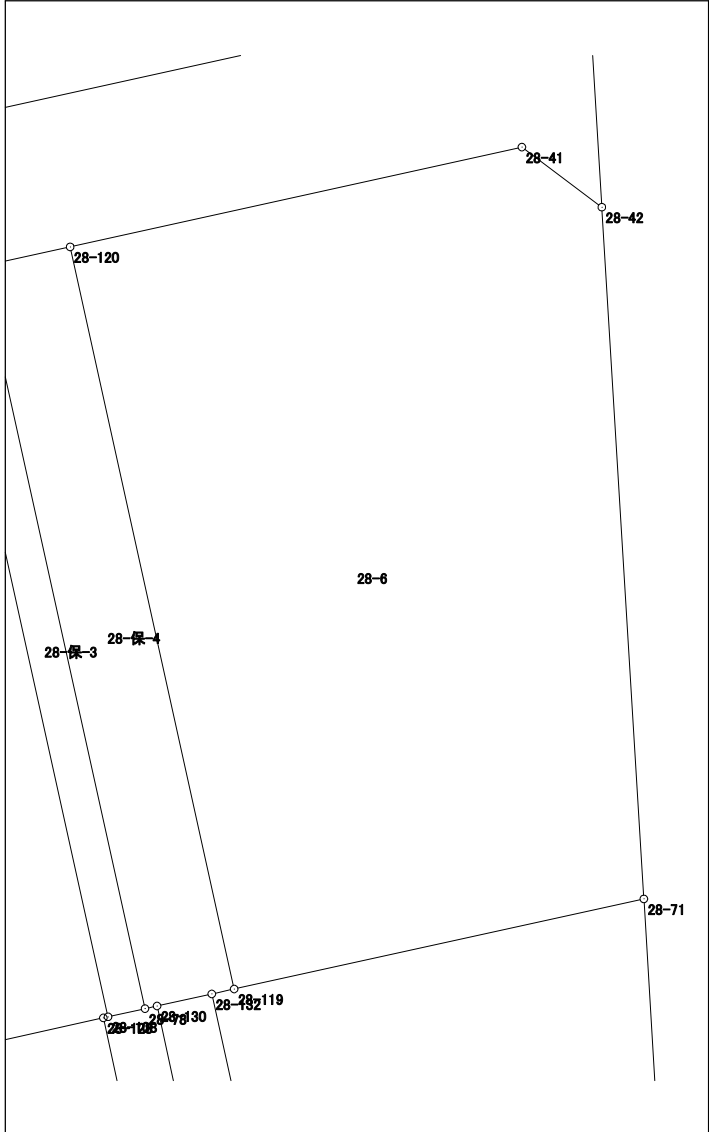
点名	X 座標	Y 座標	辺長	方向角	測角	DX	倍積 (Y×DX)	
28-119	41542.363	-68249.488	16.780	77-35-50	90-03-37	-26.077	1779741.898576	
28-71	41545.967	-68233.100	27.716	356-31-22	98-55-32	31.269	-2133580.803900	
28-42	41573.632	-68234.781	3.999	306-55-48	130-24-26	30.068	-2051683.395108	
28-41	41576.035	-68237.978	18.505	257-32-43	130-36-55	-1.588	108361.909064	
28-120	41572.044	-68256.048	30.397	167-32-13	89-59-30	-33.672	2298317.648256	
倍面積							1157.256888	
面積							578.628440	

面積計算書 (座標法)

世界測地系 (測地成果2011)

所在	地番	公簿地目	現況地目	地積	所有者
前橋市六供町二丁目	28-7			359.51 m ²	

点名	X座標	Y座標	辺長	方向角	測角	DX	倍積 (Y×DX)
28-131	41519.943	-68245.478	11.411	78-19-50	90-46-36	-19.916	1359176.939848
28-6	41522.251	-68234.303	4.014	37-27-29	139-07-39	5.494	-374879.260682
28-5	41525.437	-68231.862	20.567	356-32-57	139-05-28	23.716	-1618186.839192
28-71	41545.967	-68233.100	16.780	257-35-50	81-02-53	16.926	-1154913.450600
28-119	41542.363	-68249.488	0.916	257-38-51	180-03-01	-3.800	259348.054400
28-132	41542.167	-68250.383	22.759	167-33-14	89-54-23	-22.420	1530173.586860

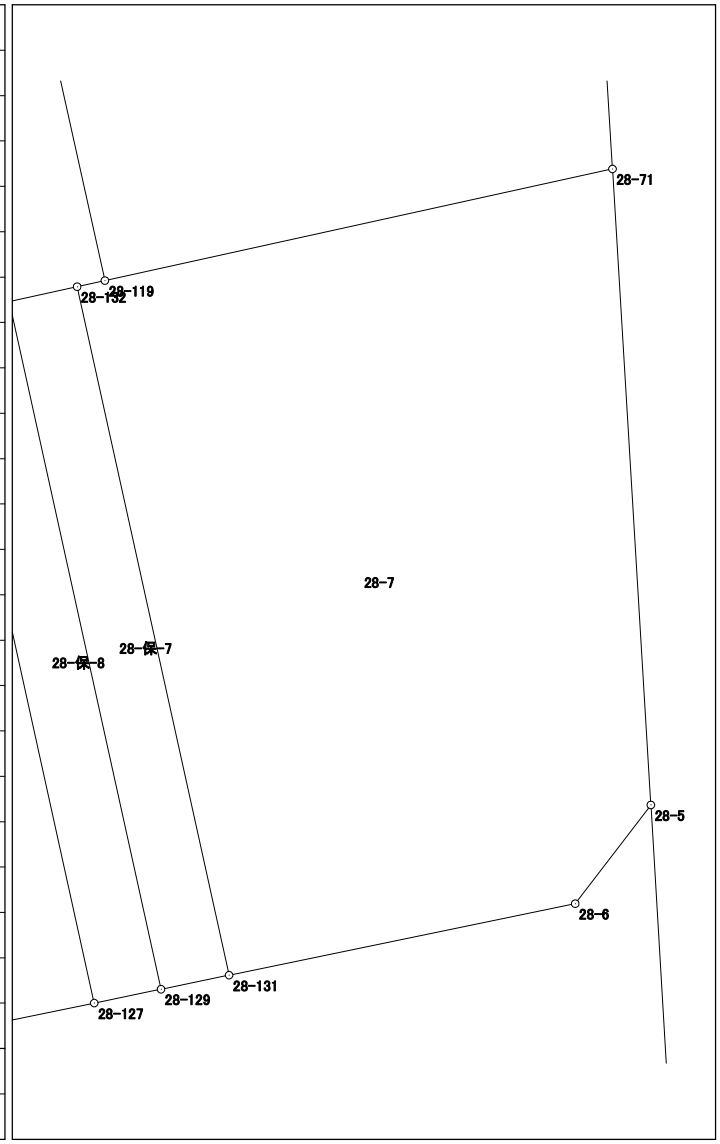


倍面積	719.030634
面積	359.5153170

面積計算書（座標法）

世界測地系（測地成果2011）

所 在	地 番	公簿地目	現況地目	地 積	所 有 者
前橋市六供町二丁目	28-8-1			61.34 m ²	

点 名	X 座標	Y 座標	辺 長	方 向 角	測 角	DX	倍 積 (Y×DX)
28-124	41538.885	-68265.245	22.553	167-33-29	90-00-33	-22.609	1543408.924205
28-123	41516.862	-68260.386	2.718	78-19-35	90-46-06	-21.473	1465755.268578
28-125	41517.412	-68257.724	22.590	347-33-28	89-13-53	22.609	-1543238.881916
28-126	41539.471	-68262.591	2.718	257-32-56	89-59-28	21.473	-1465802.616543
						倍面積	122.694324
						面 積	61.3471620

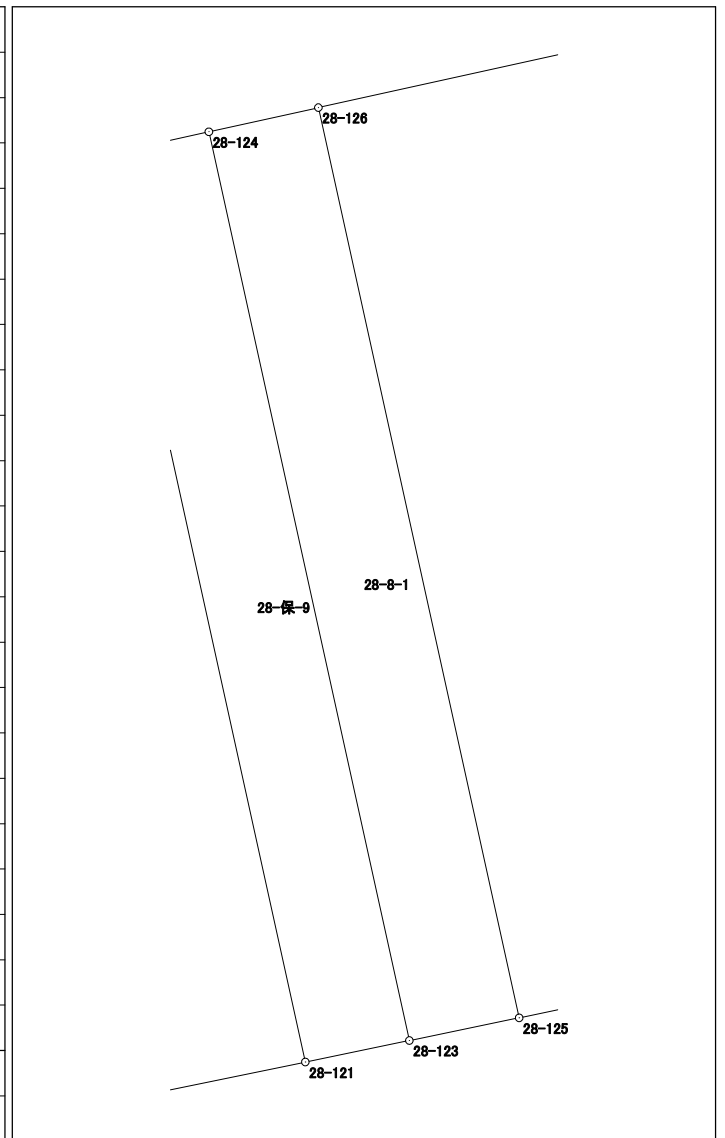


面積計算書 (座標法)

世界測地系 (測地成果2011)

所在	地番	公簿地目	現況地目	地積	所有者
前橋市六供町二丁目	28-8-2			182.50 m ²	

点名	X座標	Y座標	辺長	方向角	測角	DX	倍積 (Y×DX)
28-126	41539.471	-68262.591	22.590	167-33-28	90-01-05	-23.798	1624513.140618
28-125	41517.412	-68257.724	8.060	78-19-29	90-46-01	-20.428	1394368.785872
28-127	41519.043	-68249.831	22.700	347-33-36	89-14-07	23.798	-1624209.478138
28-128	41541.210	-68254.721	8.060	257-32-23	89-58-47	20.428	-1394307.440588

倍面積	365.007764
面積	182.5038820

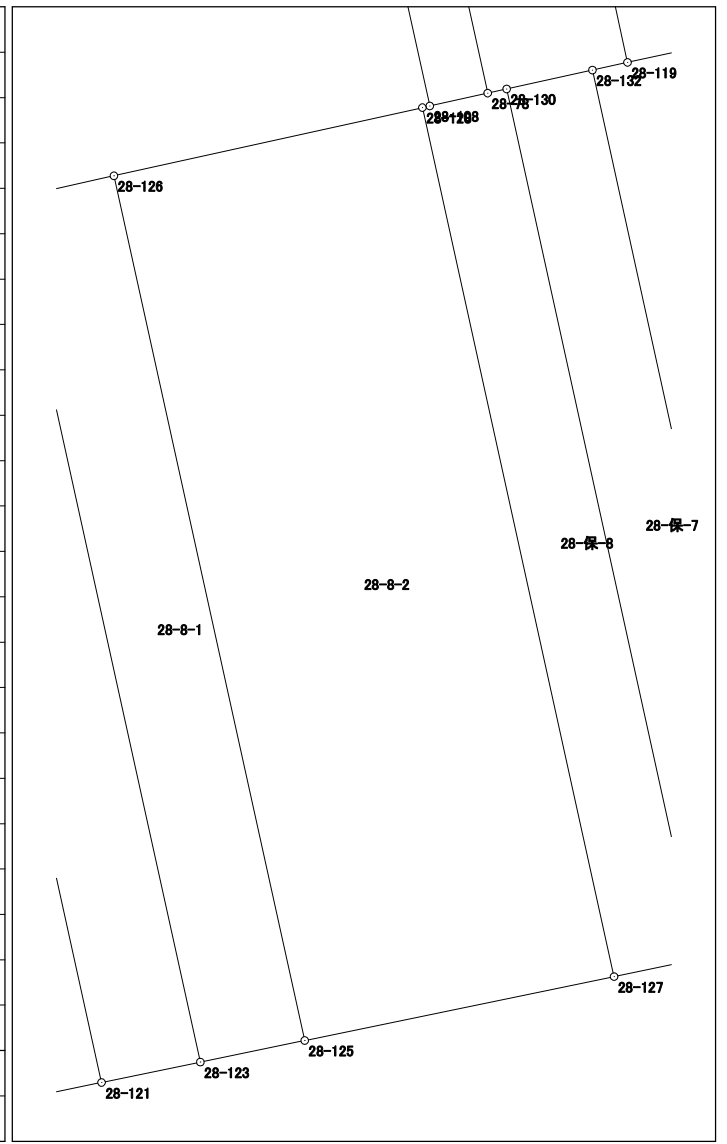


面積計算書 (座標法)

世界測地系 (測地成果2011)

所在	地番	公簿地目	現況地目	地積	所有者
前橋市六供町二丁目	28-9			443.41 m ²	

点名	X座標	Y座標	辺長	方向角	測角	Dx	倍積 (Y×Dx)
28-70	41534.056	-68287.103	10.257	167-33-06	90-00-09	-10.188	695709.005364
28-57	41524.040	-68284.892	11.989	167-33-48	180-00-42	-21.724	1483420.993808
28-55	41512.332	-68282.310	19.813	78-19-33	90-45-45	-7.699	525705.504690
28-121	41516.341	-68262.907	22.518	347-33-33	89-14-00	25.998	-1774699.056186
28-122	41538.330	-68267.758	0.403	257-31-03	89-57-30	21.902	-1495200.435716
28-110	41538.243	-68268.151	0.461	257-42-51	180-11-48	-0.185	12629.607935
28-112	41538.145	-68268.601	3.525	257-31-58	179-49-07	-0.859	58642.728259
28-114	41537.384	-68272.043	4.768	257-32-16	180-00-18	-1.790	122206.956970
28-116	41536.355	-68276.699	9.857	257-32-19	180-00-03	-3.156	215481.262044
28-118	41534.228	-68286.324	0.798	257-32-57	180-00-38	-2.299	156990.258876

倍面積	886.826044
面積	443.4130220

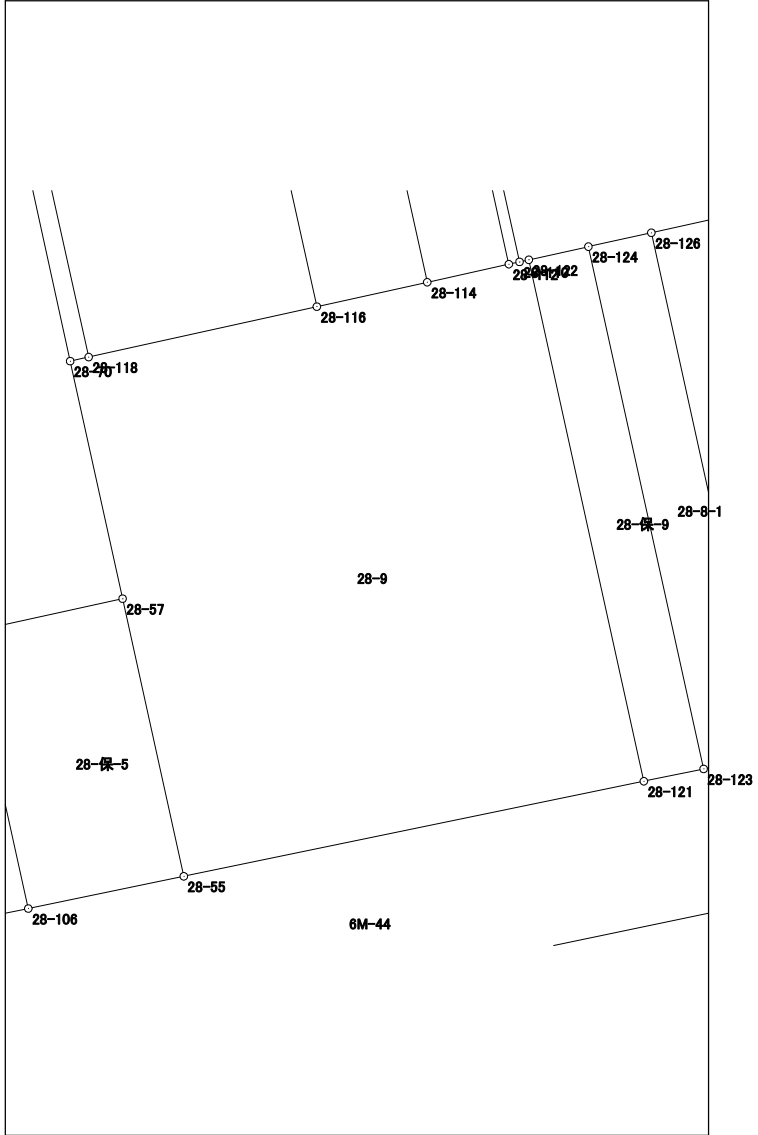

面積計算書（座標法）

世界測地系（測地成果2011）

所在	地番	公簿地目	現況地目	地積	所有者
前橋市六供町二丁目	28-10			222.06 m ²	


点名	X座標	Y座標	辺長	方向角	測角	DX	倍積 (Y×DX)	
28-105	41522.598	-68291.431	18.844	257-33-51	89-59-51	7.567	-516761.258377	
28-59	41518.540	-68309.833	11.663	167-34-55	90-01-04	-15.448	1055250.300184	
28-60	41507.150	-68307.325	18.849	78-17-52	90-42-57	-7.567	516881.528275	
28-106	41510.973	-68288.868	11.904	347-34-00	89-16-08	15.448	-1054926.432864	
						倍面積	444.137218	
						面積	222.0686090	

面積計算書（座標法）

世界測地系（測地成果2011）

所在	地番	公簿地目	現況地目	地積	所有者
前橋市六供町二丁目	28-11			113.66 m ²	

点名	X座標	Y座標	辺長	方向角	測角	DX	倍積 (Y×DX)
28-103	41518.187	-68311.425	10.098	257-30-34	89-55-36	9.184	-627372.127200
28-58	41516.003	-68321.284	8.686	168-16-11	90-45-37	-10.689	730286.204676
28-8	41507.498	-68319.518	3.988	123-12-14	134-56-03	-10.689	730267.327902
28-7	41505.314	-68316.181	7.413	78-17-13	135-04-59	-0.679	46386.686899
28-104	41506.819	-68308.922	11.640	347-34-58	89-17-45	12.873	-879340.752906
倍面積						227.339371	
面積						113.6696855	

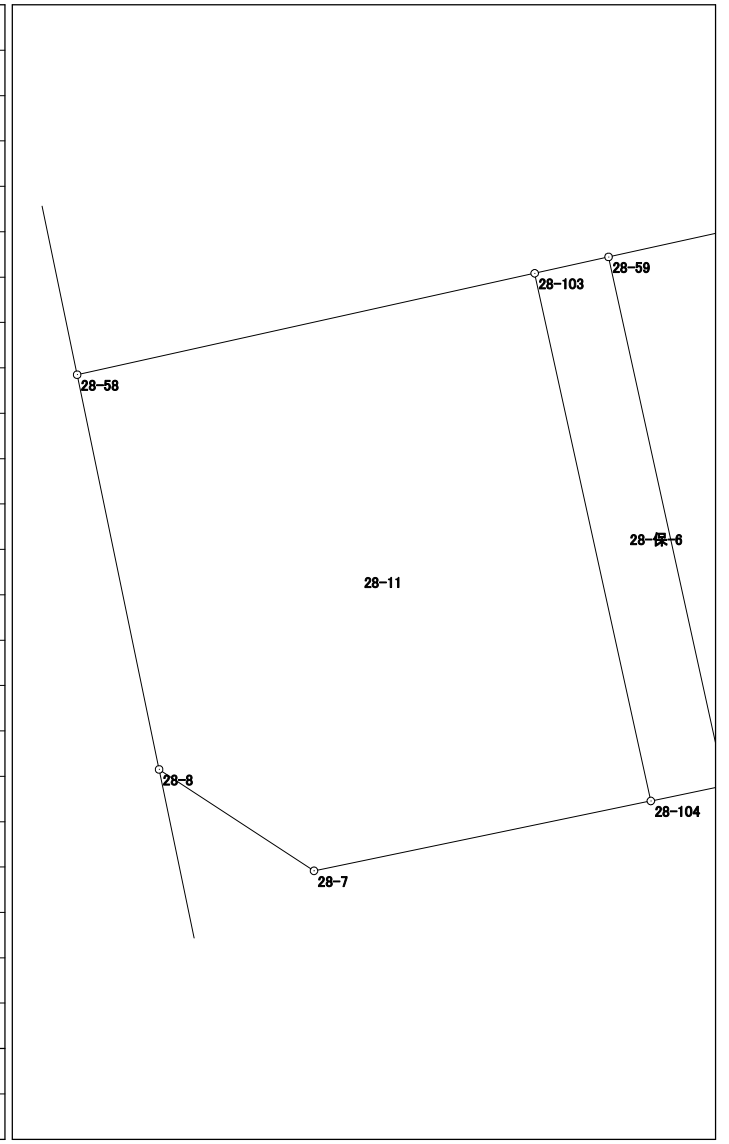


面積計算書 (座標法)

世界測地系 (測地成果2011)

所在	地番	公簿地目	現況地目	地積	所有者
前橋市六供町二丁目	28-13			291.59 m ²	

点名	X座標	Y座標	辺長	方向角	測角	DX	倍積 (Y×DX)
28-61	41535.388	-68325.312	12.792	168-16-22	90-30-59	-16.491	1126752.720192
28-67	41522.863	-68322.712	4.225	122-54-55	134-38-33	-14.821	1012610.914552
28-66	41520.567	-68319.165	15.851	77-35-03	134-40-08	1.112	-75970.911480
28-69	41523.975	-68303.685	15.740	347-42-28	90-07-25	18.787	-1283221.330095
28-68	41539.354	-68307.036	18.701	257-45-23	90-02-55	11.413	-779588.201868

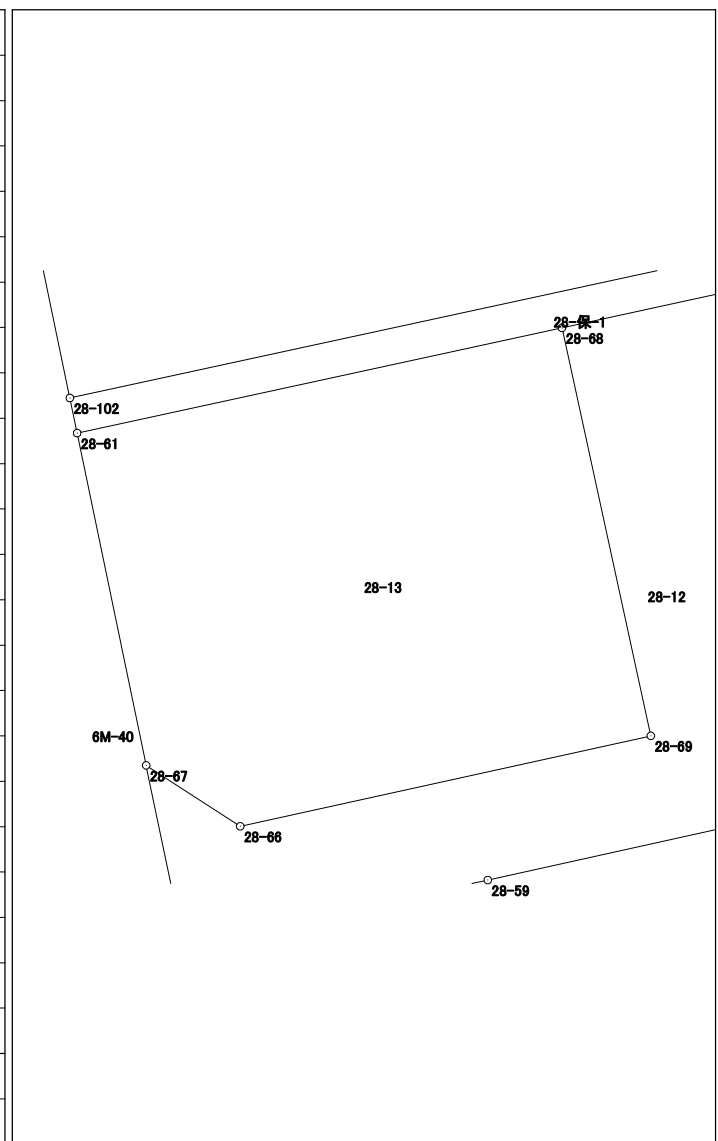


倍面積	583.191301
面積	291.5956505

面積計算書 (座標法)

世界測地系 (測地成果2011)

所在	地番	公簿地目	現況地目	地積	所有者
前橋市六供町二丁目	28-保-1			50.00 m ²	

点名	X座標	Y座標	辺長	方向角	測角	Dx	倍積 (Y×Dx)
28-62	41543.238	-68289.119	1.352	347-29-06	89-42-58	5.204	-355376.575276
28-101	41544.558	-68289.412	37.016	257-45-40	90-16-34	-6.527	445724.992124
28-102	41536.711	-68325.587	1.351	168-15-28	90-29-48	-9.170	626545.632790
28-61	41535.388	-68325.312	18.701	77-45-23	89-29-55	2.643	-180583.799616
28-68	41539.354	-68307.036	18.333	77-46-08	180-00-45	7.850	-536210.232600

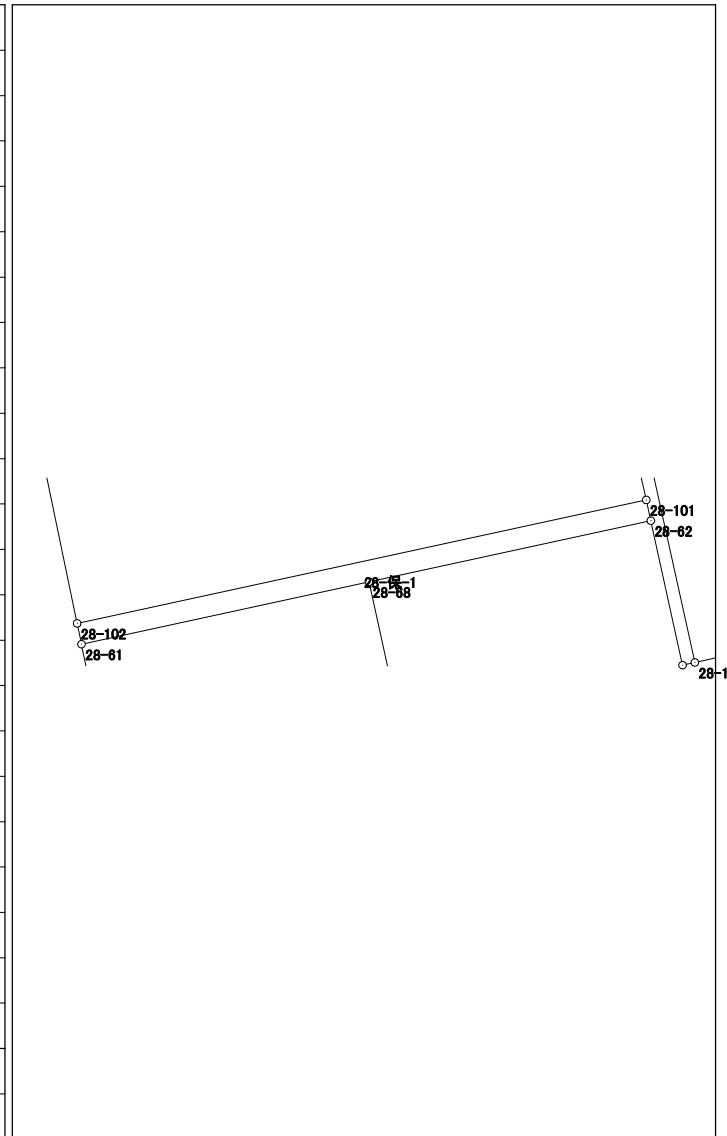


倍面積	100.017422
面積	50.0087110

面積計算書（座標法）

世界測地系（測地成果2011）

所 在	地 番	公簿地目	現況地目	地 積	所 有 者
前橋市六供町二丁目	28-保-2			14.00 m ²	

点 名	X 座標	Y 座標	辺 長	方 向 角	測 角	DX	倍 積 (Y×DX)
28-110	41538.243	-68268.151	30.406	347-32-12	89-49-21	29.787	-2033503.413837
28-109	41567.932	-68274.713	0.461	257-35-33	90-03-21	29.590	-2020248.757670
28-111	41567.833	-68275.163	30.405	167-32-10	89-56-37	-29.787	2033712.280281
28-112	41538.145	-68268.601	0.461	77-42-51	90-10-41	-29.590	2020067.903590
						倍面積	28.012364
						面 積	14.0061820

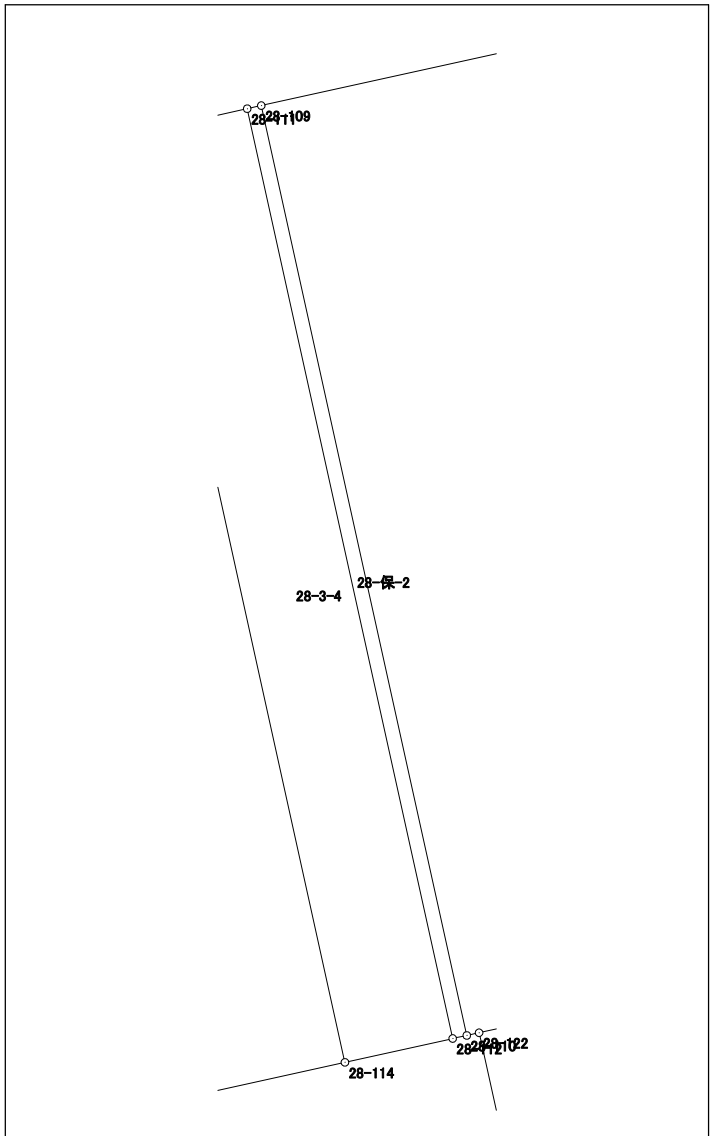


面積計算書 (座標法)

世界測地系 (測地成果2011)

所在	地番	公簿地目	現況地目	地積	所有者
前橋市六供町二丁目	28-保-3			46.00 m ²	

点名	X座標	Y座標	辺長	方向角	測角	DX	倍積 (Y×DX)
28-79	41571.256	-68259.614	1.513	257-35-55	90-03-41	29.352	-2003556.190128
28-107	41570.931	-68261.092	30.395	167-32-17	89-56-22	-30.004	2048105.804368
28-108	41541.252	-68254.533	1.514	77-31-28	89-59-11	-29.352	2003407.052616
28-78	41541.579	-68253.055	30.393	347-32-14	90-00-46	30.004	-2047864.662220
						倍面積	92.004636
						面積	46.0023180

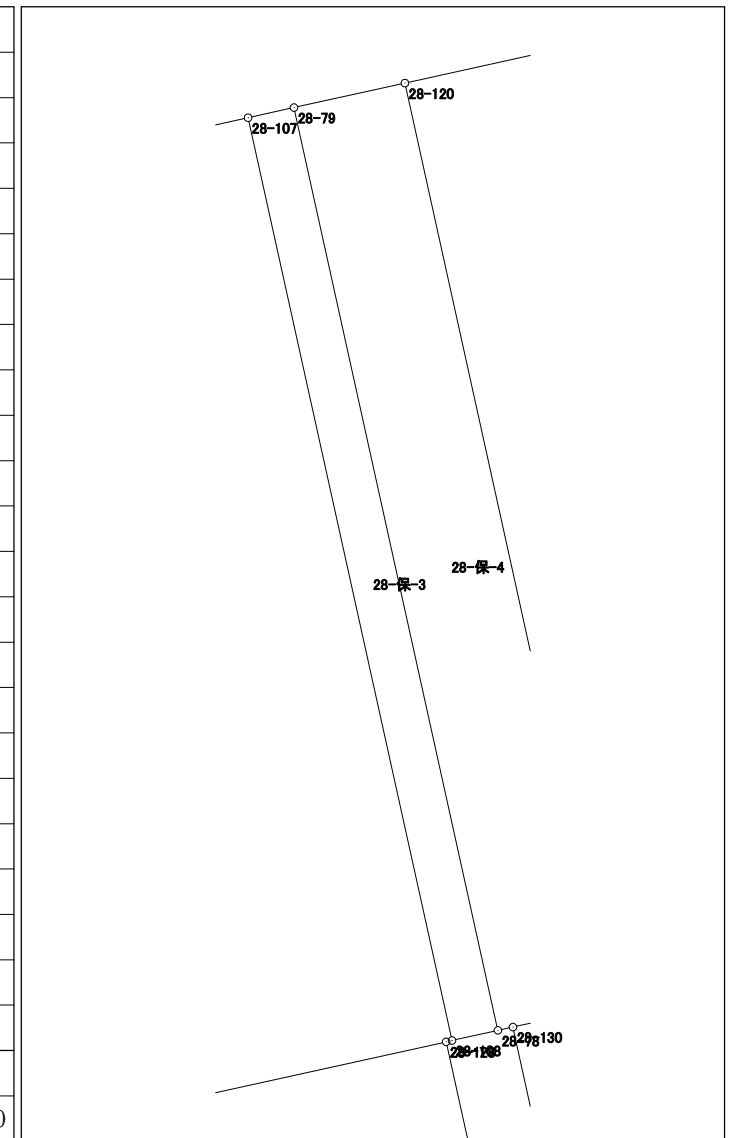


面積計算書（座標法）

世界測地系（測地成果2011）

所在	地番	公簿地目	現況地目	地積	所有者
前橋市六供町二丁目	28-保-4			111.00 m ²	

点名	X座標	Y座標	辺長	方向角	測角	DX	倍積(Y×DX)
28-78	41541.579	-68253.055	0.494	77-37-19	90-05-05	-29.571	2018311.089405
28-130	41541.685	-68252.572	2.241	77-34-56	179-57-37	0.588	-40132.512336
28-132	41542.167	-68250.383	0.916	77-38-51	180-03-55	0.678	-46273.759674
28-119	41542.363	-68249.488	30.397	347-32-13	89-53-22	29.877	-2039089.952976
28-120	41572.044	-68256.048	3.652	257-32-21	90-00-08	28.893	-1972121.994864
28-79	41571.256	-68259.614	30.393	167-32-14	89-59-53	-30.465	2079529.140510
						倍面積	222.010065
						面積	111.0050325

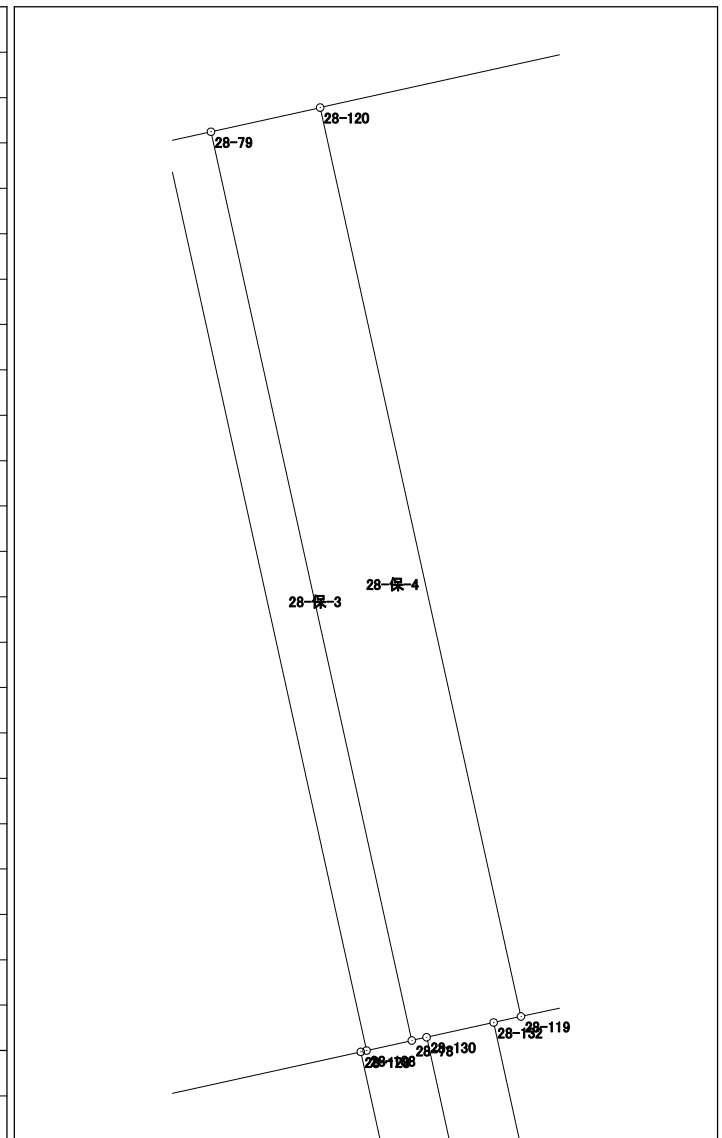


面積計算書 (座標法)

世界測地系 (測地成果2011)

所在	地番	公簿地目	現況地目	地積	所有者
前橋市六供町二丁目	28-保-6			19.00 m ²	

点名	X座標	Y座標	辺長	方向角	測角	DX	倍積 (Y×DX)
28-60	41507.150	-68307.325	11.663	347-34-55	89-17-29	11.721	-800630.156325
28-59	41518.540	-68309.833	1.631	257-29-52	89-54-57	11.037	-753935.626821
28-103	41518.187	-68311.425	11.640	167-34-58	90-05-06	-11.721	800678.212425
28-104	41506.819	-68308.922	1.631	78-17-26	90-42-28	-11.037	753925.572114

倍面積	38.001393
面積	19.0006965

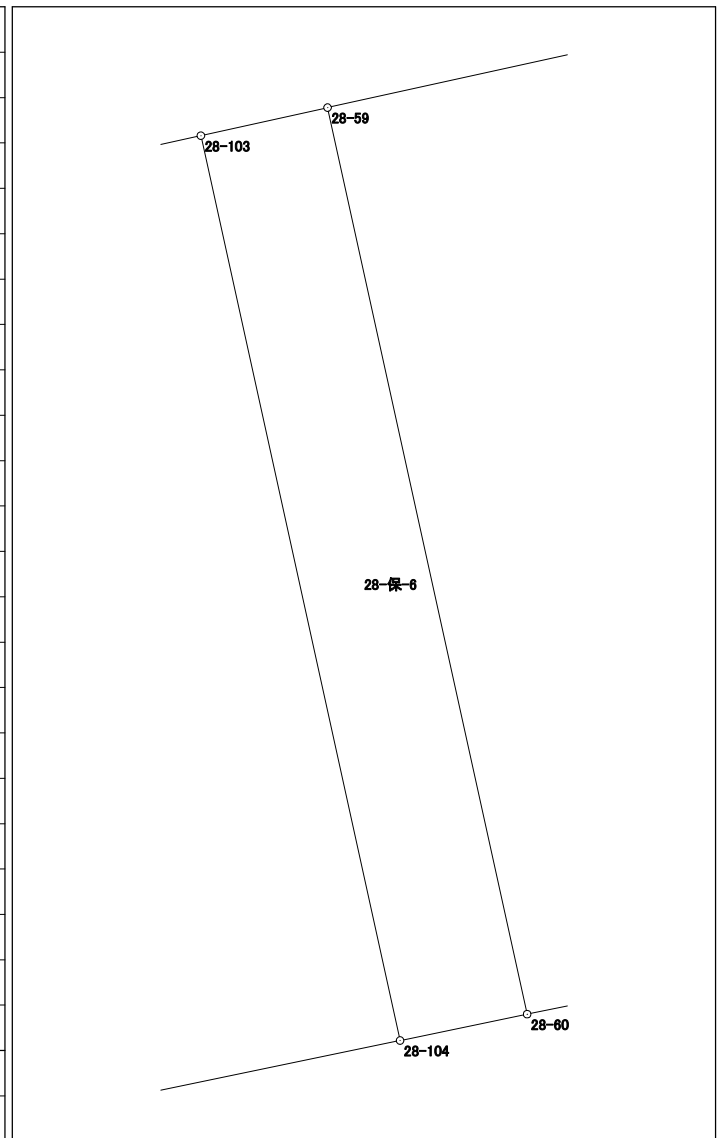


面積計算書 (座標法)

世界測地系 (測地成果2011)

所在	地番	公簿地目	現況地目	地積	所有者
前橋市六供町二丁目	28-保-7			51.00 m ²	

点名	X座標	Y座標	辺長	方向角	測角	DX	倍積 (Y×DX)
28-129	41519.489	-68247.675	2.243	78-19-28	90-45-58	-21.742	1483840.949850
28-131	41519.943	-68245.478	22.759	347-33-14	89-13-46	22.678	-1547670.950084
28-132	41542.167	-68250.383	2.241	257-34-56	90-01-42	21.742	-1483899.827186
28-130	41541.685	-68252.572	22.730	167-33-30	89-58-34	-22.678	1547831.827816
倍面積							102.000396
面積							51.0001980

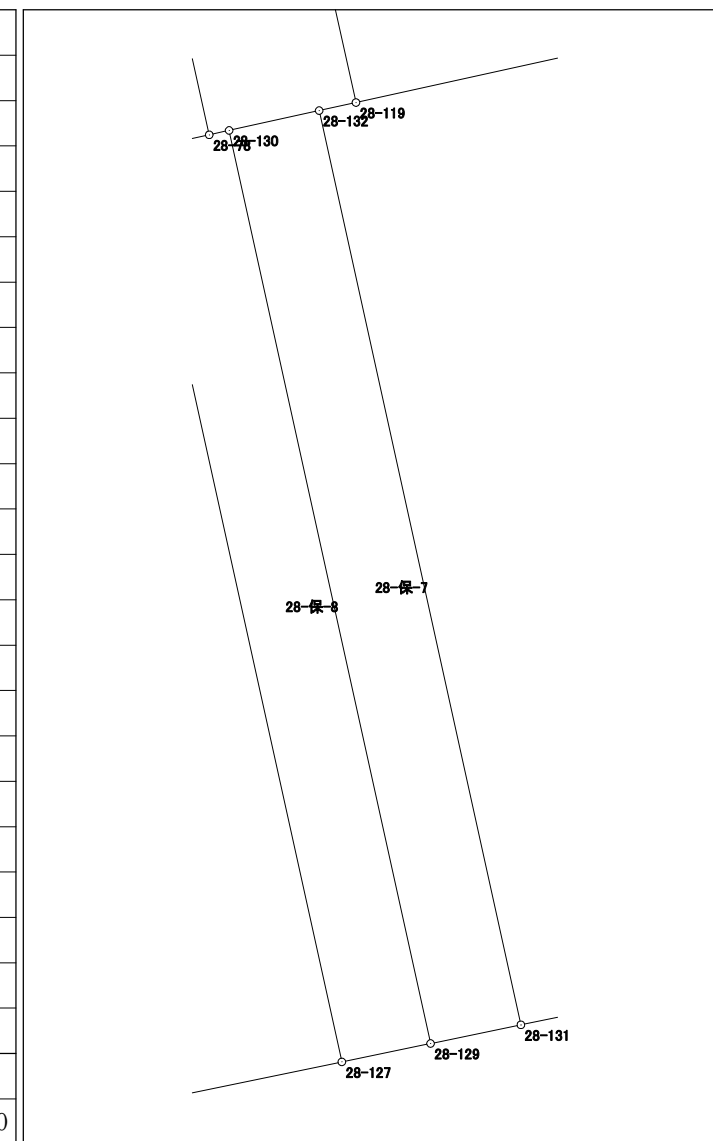

面積計算書 (座標法)

世界測地系 (測地成果2011)

所在	地番	公簿地目	現況地目	地積	所有者
前橋市六供町二丁目	28-保-8			50.00 m ²	

点名	X座標	Y座標	辺長	方向角	測角	DX	倍積 (Y×DX)
28-127	41519.043	-68249.831	2.202	78-18-45	90-45-09	-21.721	1482454.579151
28-129	41519.489	-68247.675	22.730	347-33-30	89-14-45	22.642	-1545263.857350
28-130	41541.685	-68252.572	0.494	257-37-19	90-03-49	22.090	-1507699.315480
28-78	41541.579	-68253.055	1.514	257-31-28	179-54-09	-0.433	29553.572815
28-108	41541.252	-68254.533	0.193	257-24-24	179-52-56	-0.369	25185.922677
28-128	41541.210	-68254.721	22.700	167-33-36	90-09-12	-22.209	1515869.098689
						倍面積	100.000502
						面積	50.0002510

