



29街区 画地出来形確認図 (3867.20m²)

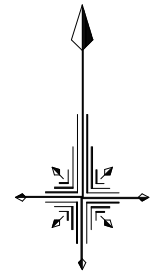

S=1/500

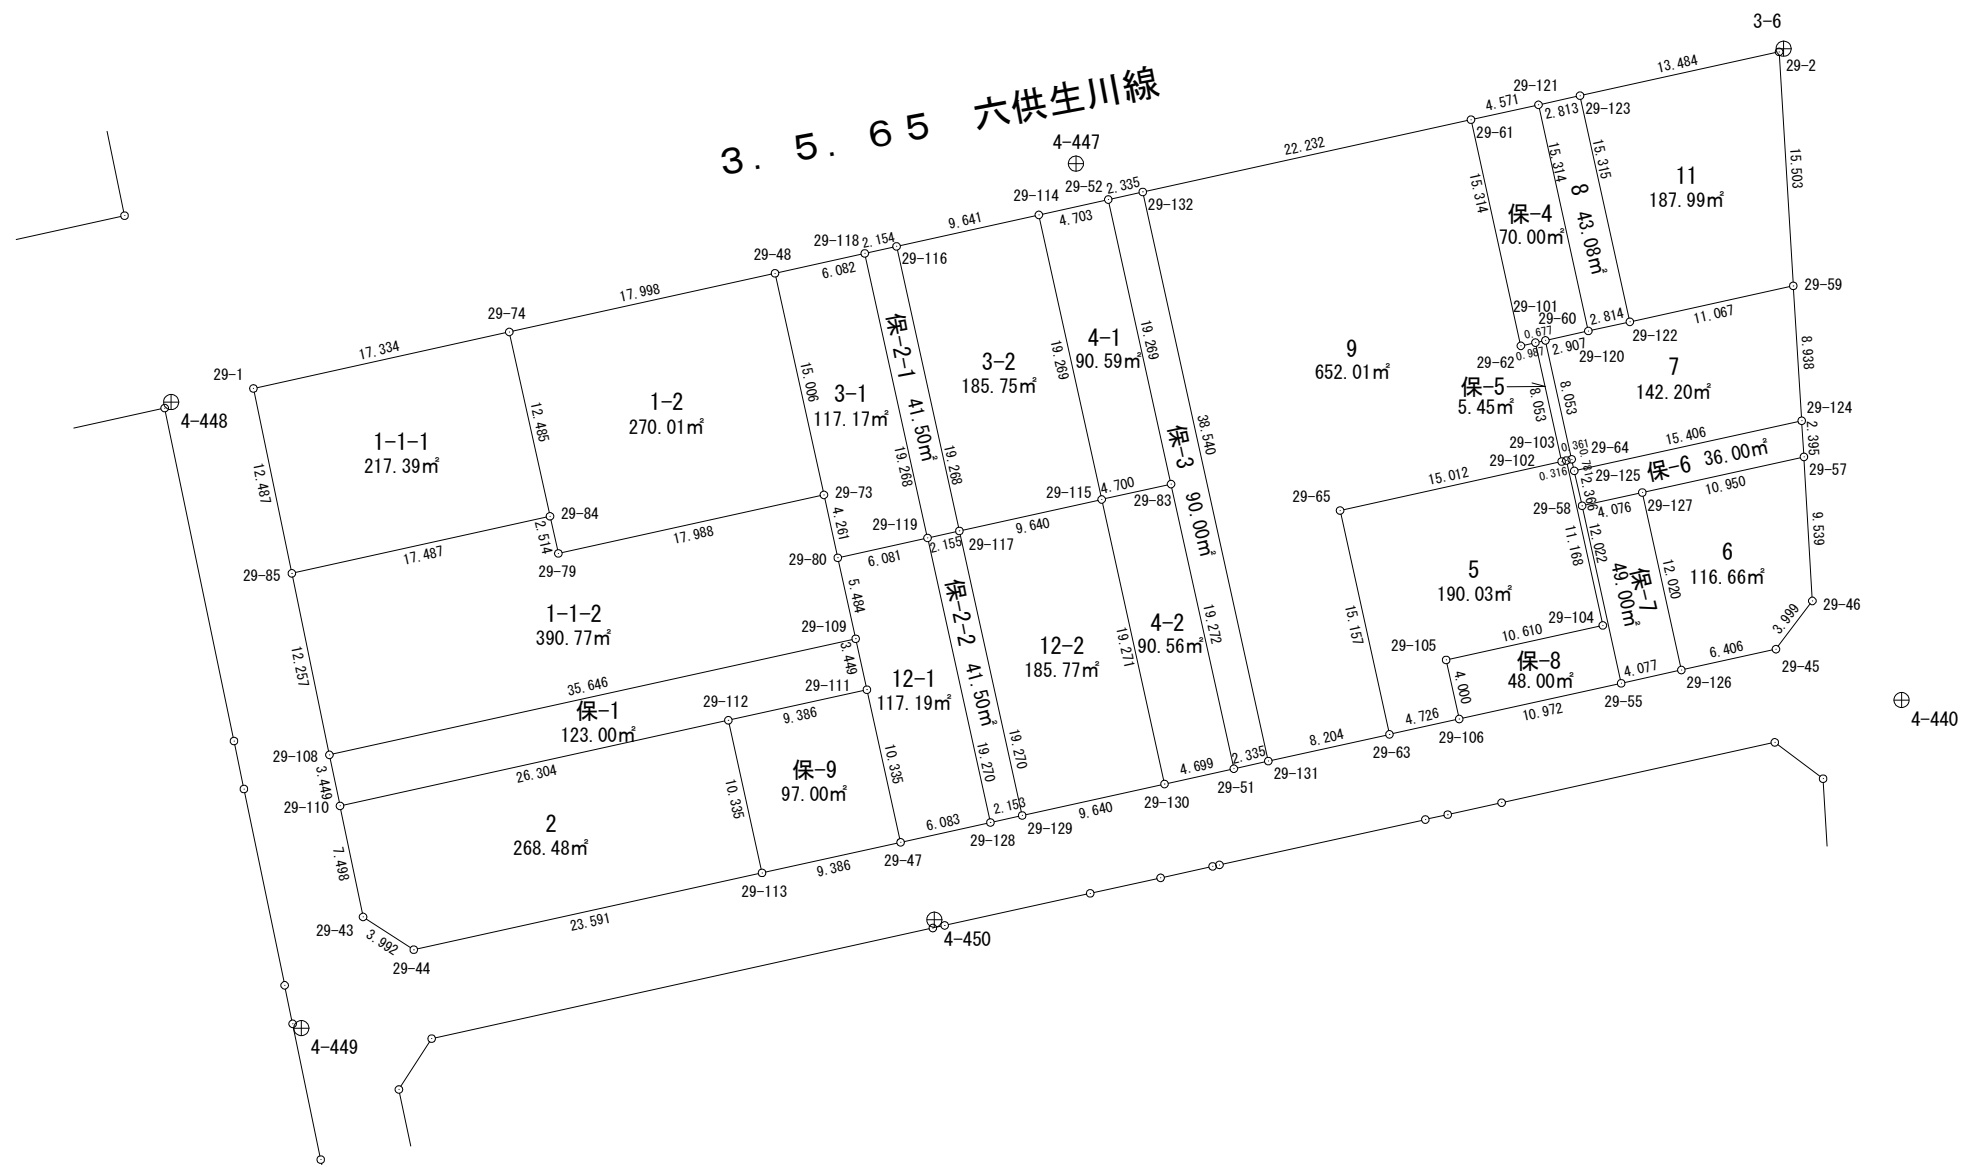

面積計算書（座標法）

世界測地系（測地成果2011）

所在	地番	公簿地目	現況地目	地積	所有者
前橋市六供町二丁目	29-1-1-1			217.39 m ²	


点名	X座標	Y座標	辺長	方向角	測角	DX	倍積 (Y×DX)	
29-1	41599.438	-68338.613	12.487	168-15-16	90-42-03	-15.962	1090820.940706	
29-85	41587.212	-68336.071	17.487	77-33-00	89-17-44	-8.456	577849.816376	
29-84	41590.982	-68318.995	12.485	347-33-12	90-00-12	15.962	-1090507.798190	
29-74	41603.174	-68321.686	17.334	257-33-13	90-00-01	8.456	-577728.176816	
						倍面積	434.782076	
						面積	217.3910380	

面積計算書 (座標法)

世界測地系 (測地成果2011)

所 在	地 番	公簿地目	現況地目	地 積	所 有 者
前橋市六供町二丁目	29-1-2			270.01 m ²	

点 名	X 座標	Y 座標	辺 長	方 向 角	測 角	DX	倍 積 (Y×DX)
29-74	41603.174	-68321.686	12.485	167-33-12	89-59-59	-16.071	1097997.815706
29-84	41590.982	-68318.995	2.514	167-19-05	179-45-53	-14.645	1000531.681775
29-79	41588.529	-68318.443	17.988	77-34-23	90-15-18	1.418	-96875.552174
29-73	41592.400	-68300.876	15.006	347-33-01	89-58-38	18.524	-1265205.427024
29-48	41607.053	-68304.111	17.998	257-33-13	90-00-12	10.774	-735908.491914

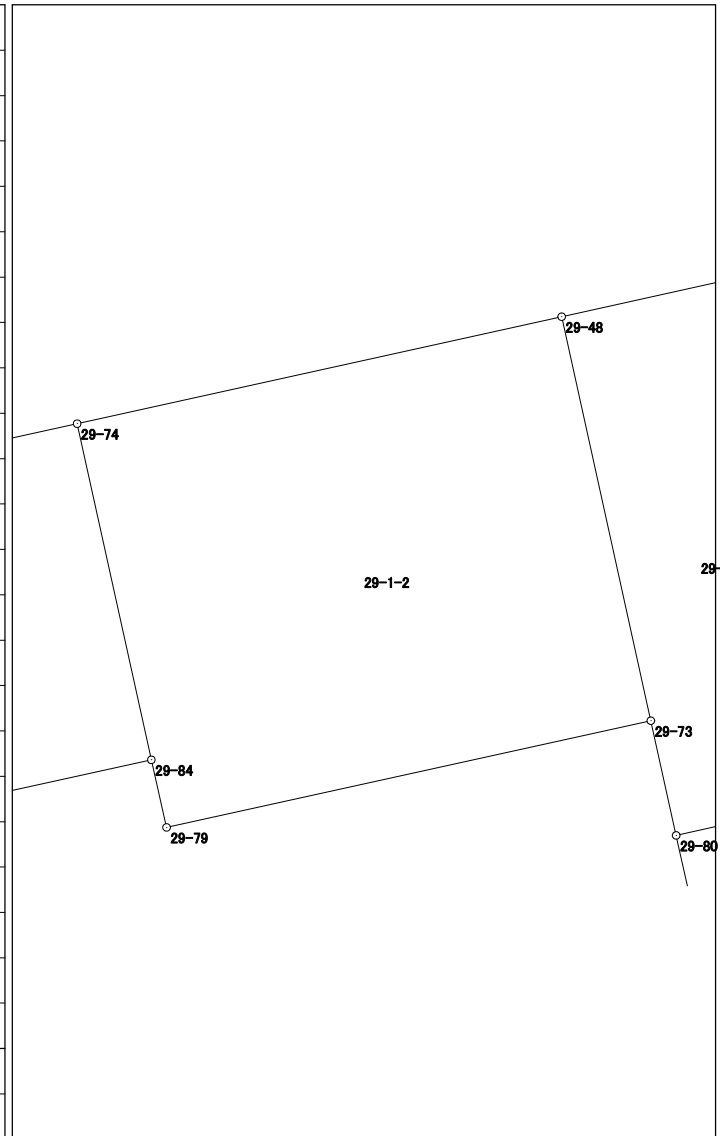


倍面積	540.026369
面 積	270.0131845

面積計算書 (座標法)

世界測地系 (測地成果2011)

所在	地番	公簿地目	現況地目	地積	所有者
前橋市六供町二丁目	29-2			268.48 m ²	

点名	X座標	Y座標	辺長	方向角	測角	DX	倍積 (Y×DX)
29-112	41577.496	-68307.197	26.304	257-34-02	90-01-00	4.429	-302532.575513
29-110	41571.833	-68332.884	7.498	168-16-19	90-42-17	-13.004	888600.823536
29-43	41564.492	-68331.360	3.992	122-52-27	134-36-08	-9.508	649694.570880
29-44	41562.325	-68328.007	23.591	77-34-02	134-41-35	2.912	-198971.156384
29-113	41567.404	-68304.969	10.335	347-33-02	89-59-00	15.171	-1036254.684699
						倍面積	536.977820
						面積	268.4889100

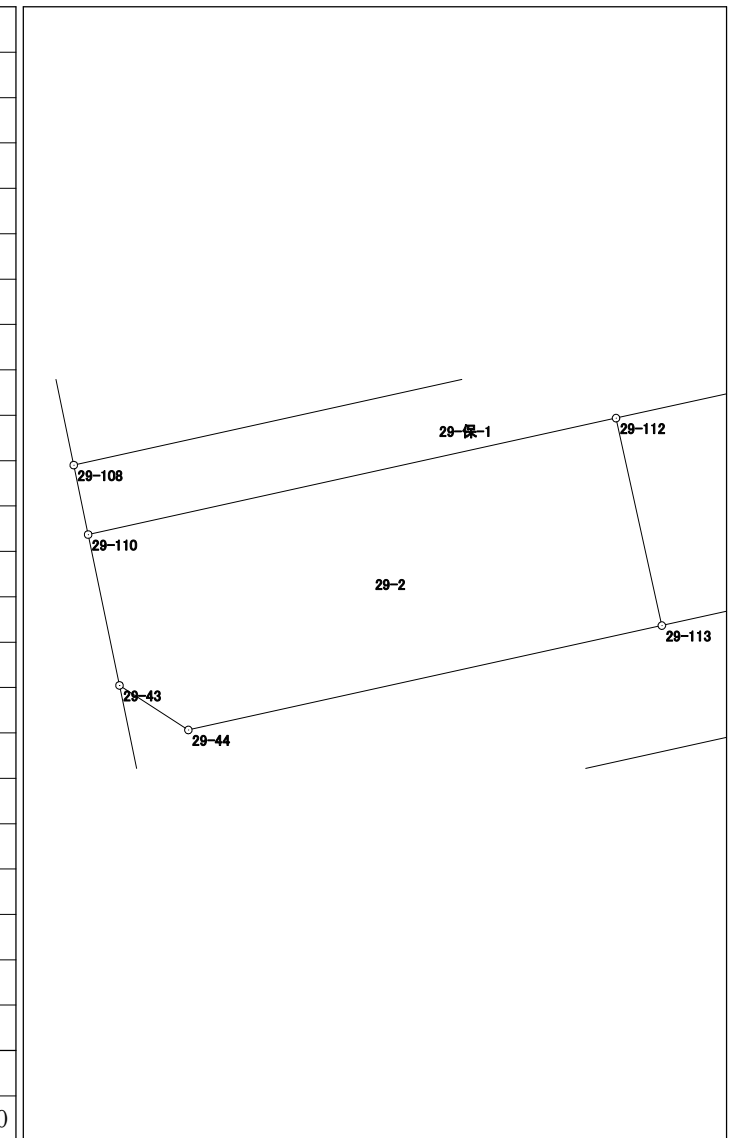


面積計算書 (座標法)

世界測地系 (測地成果2011)

所在	地番	公簿地目	現況地目	地積	所有者
前橋市六供町二丁目	29-4-1			90.59 m ²	

点名	X座標	Y座標	辺長	方向角	測角	DX	倍積 (Y×DX)
29-52	41611.930	-68282.065	4.703	257-31-27	89-57-51	17.801	-1215489.039065
29-114	41610.914	-68286.657	19.269	167-33-02	90-01-35	-19.832	1354260.981624
29-115	41592.098	-68282.503	4.700	77-31-41	89-58-39	-17.801	1215496.835903
29-83	41593.113	-68277.914	19.269	347-33-36	90-01-55	19.832	-1354087.590448
						倍面積	181.188014
						面積	90.5940070

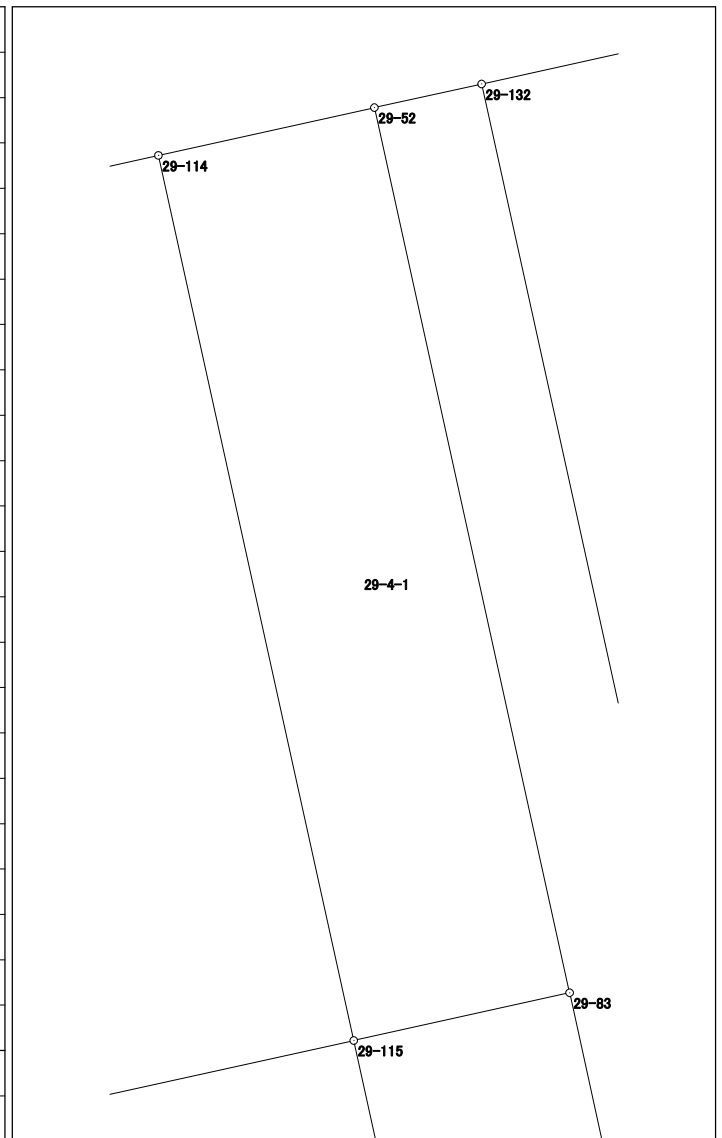


面積計算書 (座標法)

世界測地系 (測地成果2011)

所在	地番	公簿地目	現況地目	地積	所有者
前橋市六供町二丁目	29-5			190.03 m ²	

点名	X座標	Y座標	辺長	方向角	測角	DX	倍積 (Y×DX)
29-65	41591.364	-68266.733	15.157	167-33-37	90-01-42	-18.042	1231668.396786
29-63	41576.563	-68263.468	4.726	77-34-21	90-00-44	-13.784	940943.642912
29-106	41577.580	-68258.853	4.000	347-33-18	89-58-57	4.923	-336038.333319
29-105	41581.486	-68259.715	10.610	77-34-25	270-01-07	6.189	-422459.376135
29-104	41583.769	-68249.354	11.168	347-31-37	89-57-12	13.187	-900004.231198
29-103	41594.673	-68251.766	0.316	257-35-21	90-03-44	10.836	-739576.136376
29-102	41594.605	-68252.075	15.012	257-31-55	179-56-34	-3.309	225846.116175

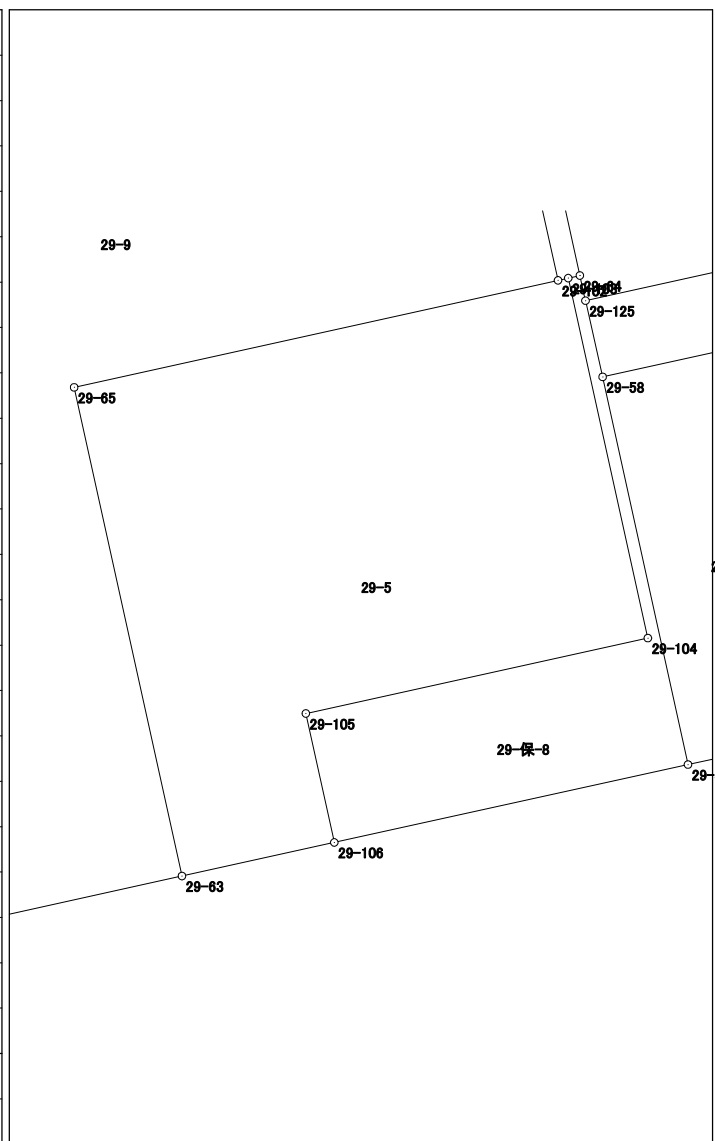


倍面積	380.078845
面積	190.0394225

面積計算書（座標法）

世界測地系（測地成果2011）

所 在	地 番	公簿地目	現況地目	地 積	所 有 者
前橋市六供町二丁目	29-6			116.66 m ²	

点 名	X 座 標	Y 座 標	辺 長	方 向 角	測 角	DX	倍 積 (Y×DX)
29-126	41580.818	-68244.157	6.406	77-34-09	89-59-16	-10.360	707009.466520
29-45	41582.197	-68237.901	3.999	37-02-31	139-28-22	4.571	-311915.445471
29-46	41585.389	-68235.492	9.539	356-39-31	139-37-00	12.715	-867614.280780
29-57	41594.912	-68236.048	10.950	257-34-51	80-55-20	7.168	-489115.992064
29-127	41592.557	-68246.742	12.020	167-34-53	90-00-02	-14.094	961869.581748
						倍面積	233.329953
						面 積	116.6649765

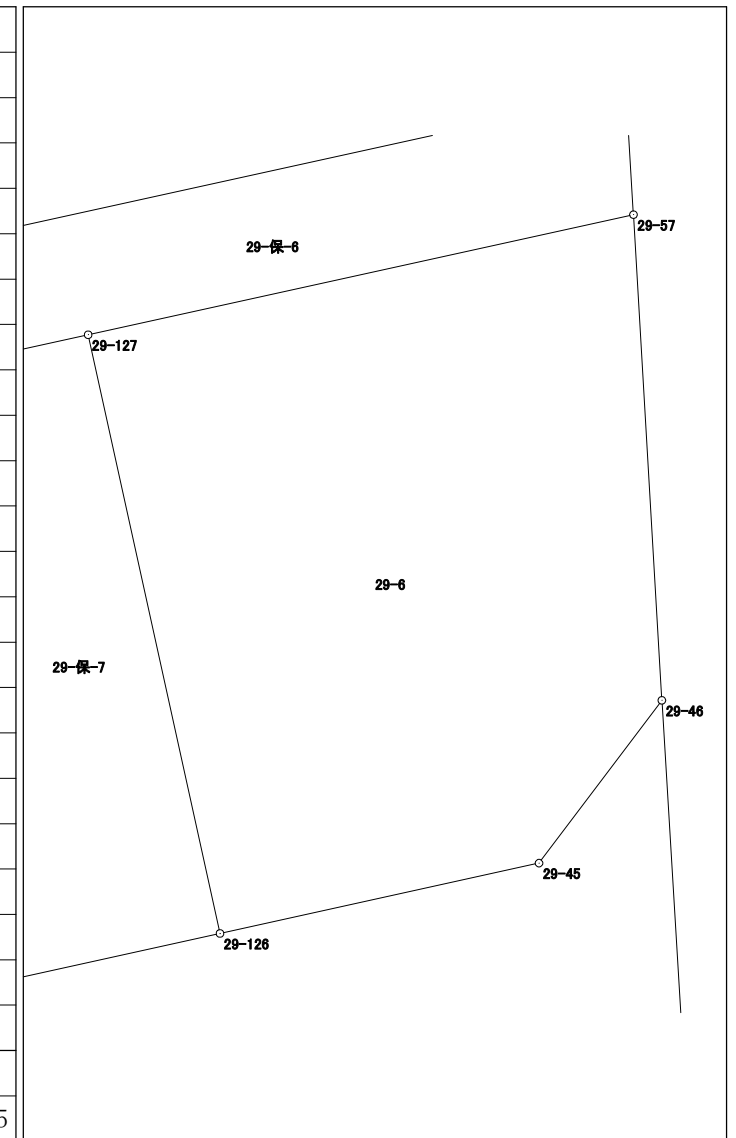


面積計算書（座標法）

世界測地系（測地成果2011）

所在	地番	公簿地目	現況地目	地積	所有者
前橋市六供町二丁目	29-8			43.08 m ²	

点名	X座標	Y座標	辺長	方向角	測角	DX	倍積 (Y×DX)
29-120	41603.240	-68250.311	2.814	77-35-02	90-01-13	-14.350	979391.962850
29-122	41603.845	-68247.563	15.315	347-33-36	89-58-34	15.560	-1061932.080280
29-123	41618.800	-68250.862	2.813	257-34-46	90-01-10	14.350	-979399.869700
29-121	41618.195	-68253.609	15.314	167-33-49	89-59-03	-15.560	1062026.156040
						倍面積	86.168910
						面積	43.0844550

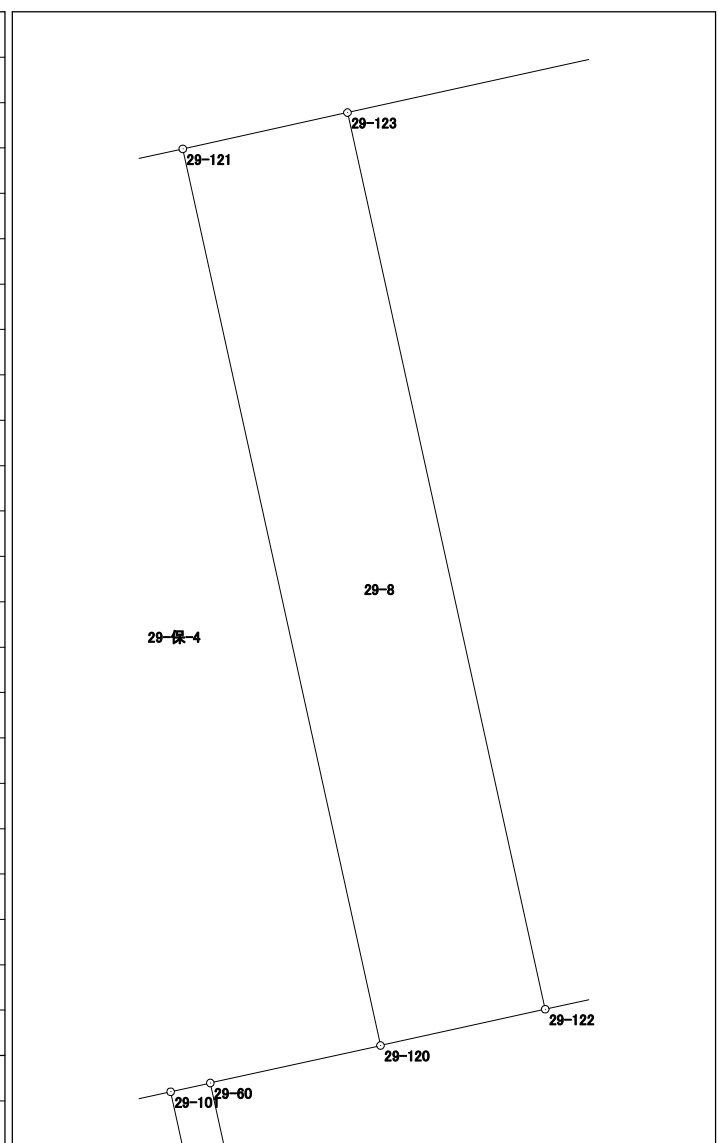


面積計算書 (座標法)

世界測地系 (測地成果2011)

所在	地番	公簿地目	現況地目	地積	所有者
前橋市六供町二丁目	29-12-1			117.19 m ²	

点名	X座標	Y座標	辺長	方向角	測角	DX	倍積 (Y×DX)
29-119	41589.552	-68294.020	6.081	257-31-53	89-59-22	17.503	-1195350.232060
29-80	41588.239	-68299.958	5.484	167-32-33	90-00-40	-6.668	455424.119944
29-109	41582.884	-68298.775	3.449	167-32-36	180-00-03	-8.723	595770.214325
29-111	41579.516	-68298.031	10.335	167-33-02	180-00-26	-13.460	919291.497260
29-47	41569.424	-68295.803	6.083	77-32-41	89-59-39	-8.780	599637.150340
29-128	41570.736	-68289.863	19.270	347-32-31	89-59-50	20.128	-1374538.362464

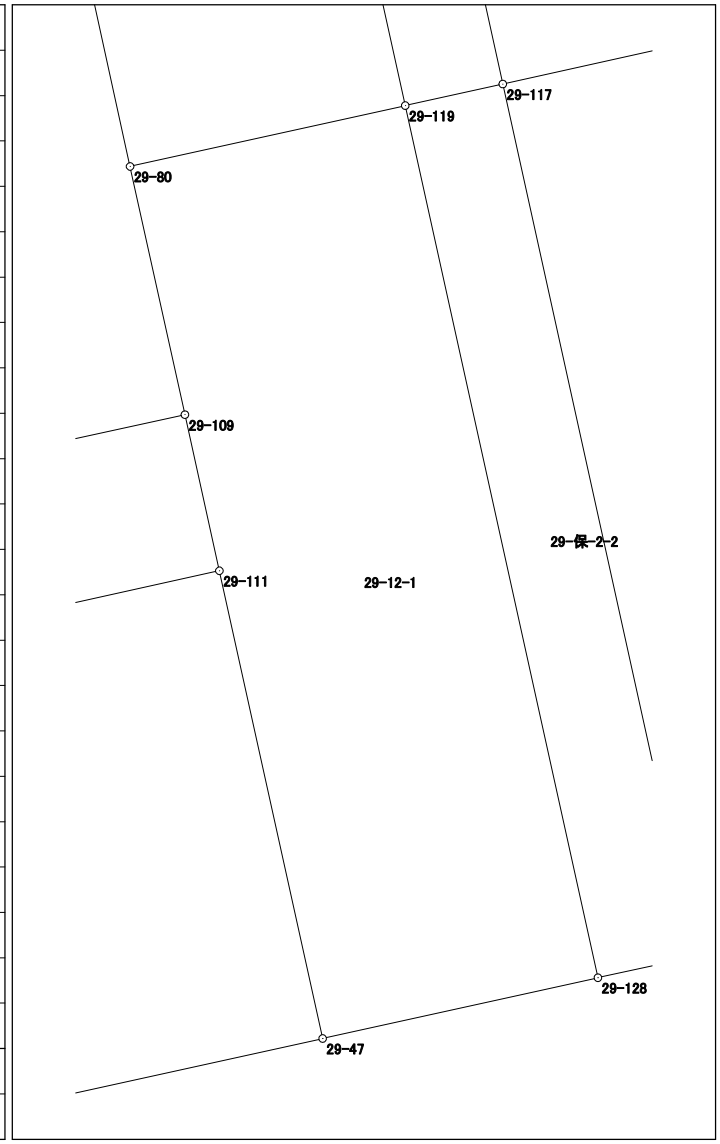


倍面積	234.387345
面積	117.1936725

面積計算書（座標法）

世界測地系（測地成果2011）

所在	地番	公簿地目	現況地目	地積	所有者
前橋市六供町二丁目	29-12-2			185.77 m ²	

点名	X座標	Y座標	辺長	方向角	測角	DX	倍積 (Y×DX)
29-115	41592.098	-68282.503	9.640	257-32-01	89-59-05	16.737	-1142844.252711
29-117	41590.017	-68291.916	19.270	167-32-54	90-00-53	-20.898	1427164.460568
29-129	41571.200	-68287.761	9.640	77-32-22	89-59-28	-16.737	1142932.255857
29-130	41573.280	-68278.348	19.271	347-32-56	90-00-34	20.898	-1426880.916504
						倍面積	371.547210
						面積	185.7736050

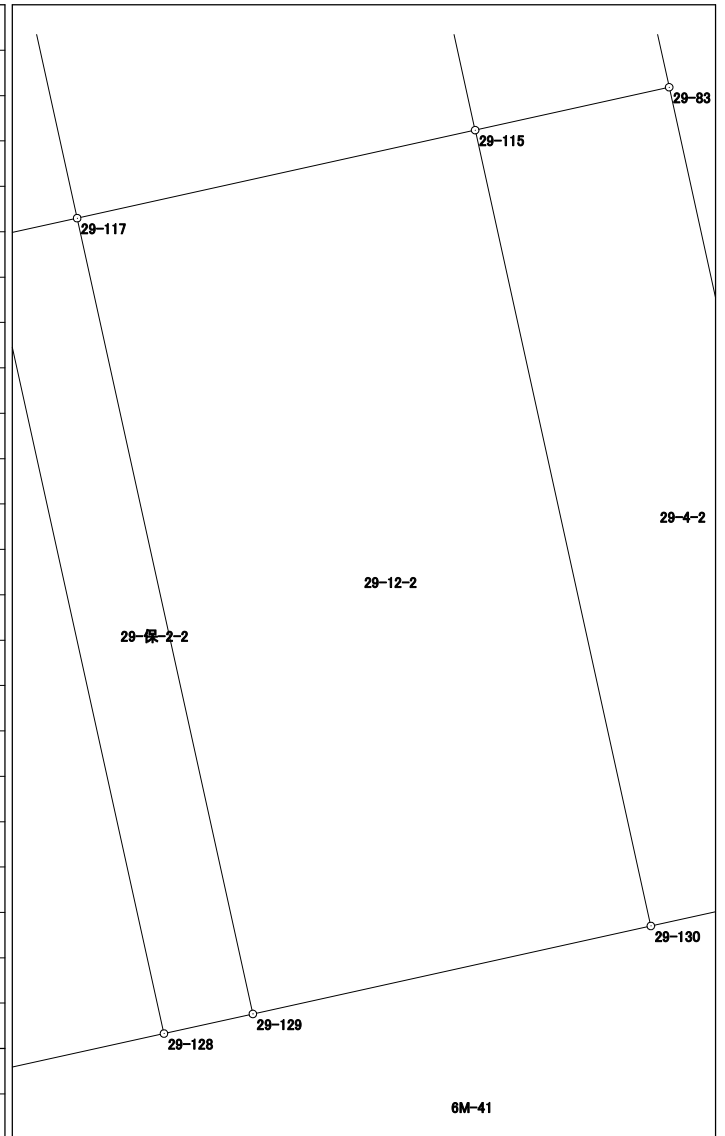


面積計算書 (座標法)

世界測地系 (測地成果2011)

所 在	地 番	公簿地目	現況地目	地 積	所 有 者
前橋市六供町二丁目	29-保-1			123.00 m ²	

点 名	X 座標	Y 座標	辺 長	方 向 角	測 角	DX	倍 積 (Y×DX)
29-109	41582.884	-68298.775	35.646	257-34-04	90-01-28	-4.306	294094.525150
29-108	41575.210	-68333.585	3.449	168-16-23	90-42-19	-11.051	755154.447835
29-110	41571.833	-68332.884	26.304	77-34-02	89-17-39	2.286	-156208.972824
29-112	41577.496	-68307.197	9.386	77-34-19	180-00-17	7.683	-524804.194551
29-111	41579.516	-68298.031	3.449	347-32-36	89-58-17	5.388	-367989.791028
						倍面積	246.014582
						面 積	123.0072910

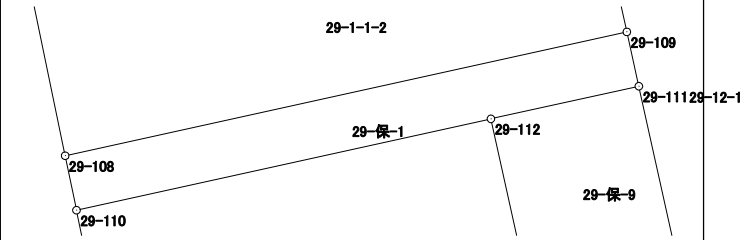


面積計算書（座標法）

世界測地系（測地成果2011）

所 在	地 番	公簿地目	現況地目	地 積	所 有 者
前橋市六供町二丁目	29-保-2-1			41.50 m ²	

点 名	X 座標	Y 座標	辺 長	方 向 角	測 角	DX	倍 積 (Y×DX)
29-117	41590.017	-68291.916	19.268	347-33-00	90-00-45	19.280	-1316668.140480
29-116	41608.832	-68296.070	2.154	257-31-54	89-58-54	18.350	-1253232.884500
29-118	41608.367	-68298.173	19.268	167-33-10	90-01-16	-19.280	1316788.775440
29-119	41589.552	-68294.020	2.155	77-32-15	89-59-05	-18.350	1253195.267000
						倍面積	83.017460
						面 積	41.5087300

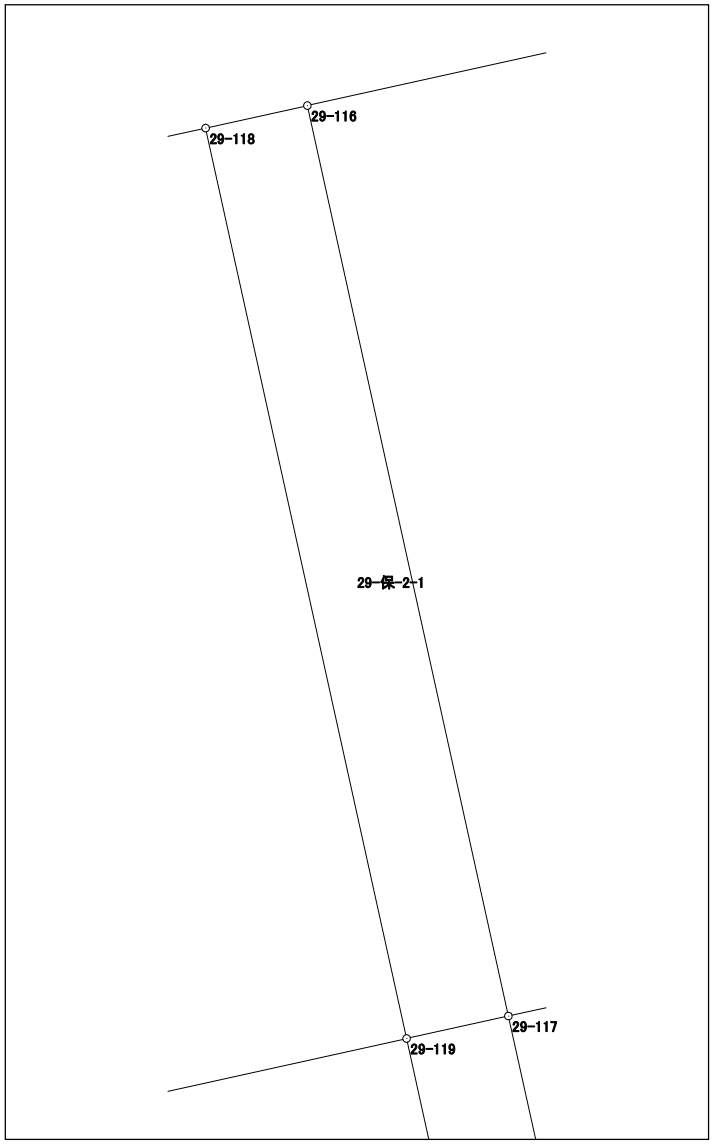


面積計算書 (座標法)

世界測地系 (測地成果2011)

所在	地番	公簿地目	現況地目	地積	所有者
前橋市六供町二丁目	29-保-2-2			41.50 m ²	

点名	X座標	Y座標	辺長	方向角	測角	DX	倍積 (Y×DX)
29-117	41590.017	-68291.916	2.155	257-32-15	89-59-21	18.352	-1253293.242432
29-119	41589.552	-68294.020	19.270	167-32-31	90-00-16	-19.281	1316776.999620
29-128	41570.736	-68289.863	2.153	77-33-07	90-00-36	-18.352	1253255.565776
29-129	41571.200	-68287.761	19.270	347-32-54	89-59-47	19.281	-1316656.319841
						倍面積	83.003123
						面積	41.5015615

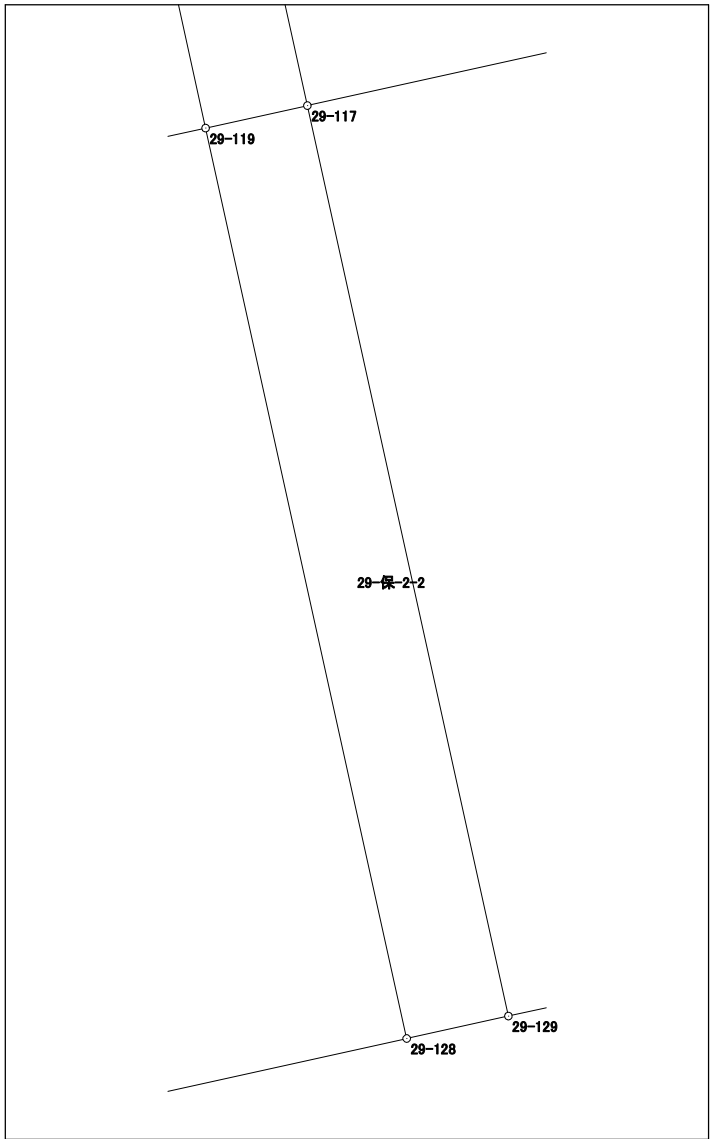


面積計算書（座標法）

世界測地系（測地成果2011）

所在	地番	公簿地目	現況地目	地積	所有者
前橋市六供町二丁目	29-保-4			70.00 m ²	

点名	X座標	Y座標	辺長	方向角	測角	DX	倍積 (Y×DX)
29-61	41617.212	-68258.073	15.314	167-33-49	89-58-56	-15.938	1087897.167474
29-62	41602.257	-68254.775	0.987	77-35-50	90-02-01	-14.743	1006280.147825
29-101	41602.469	-68253.811	0.677	77-32-41	179-56-51	0.358	-24434.864338
29-60	41602.615	-68253.150	2.907	77-35-04	180-02-23	0.771	-52623.178650
29-120	41603.240	-68250.311	15.314	347-33-49	89-58-45	15.580	-1063339.845380
29-121	41618.195	-68253.609	4.571	257-34-53	90-01-04	13.972	-953639.424948
						倍面積	140.001983
						面積	70.0009915

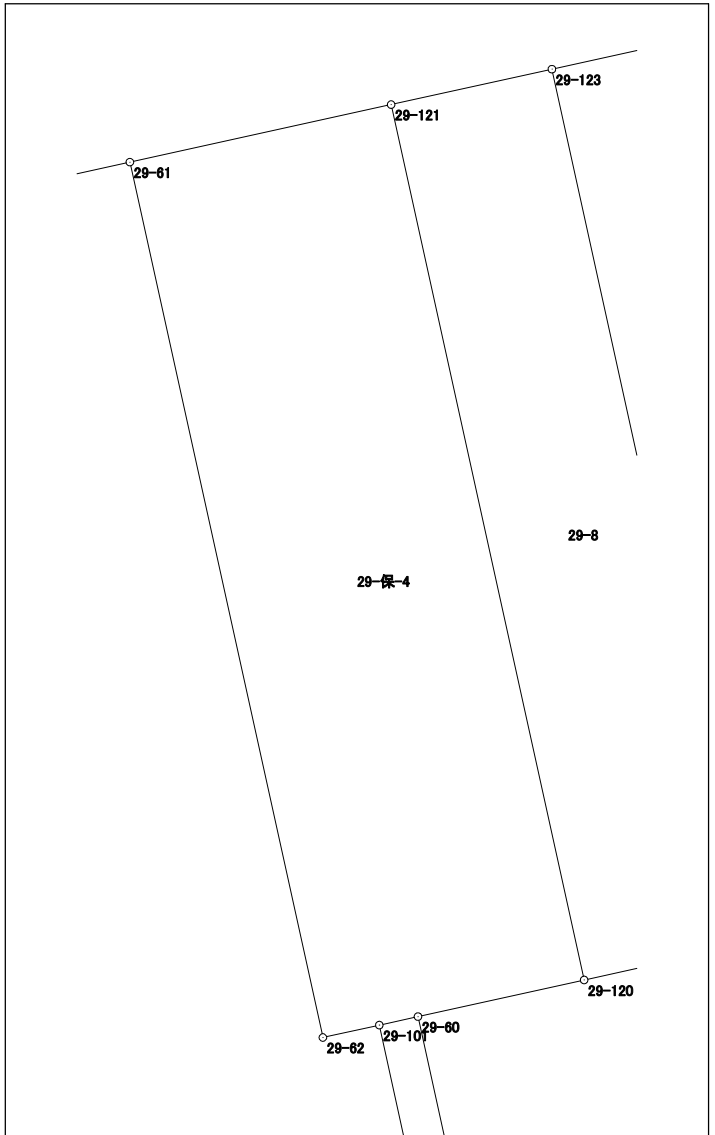


面積計算書 (座標法)

世界測地系 (測地成果2011)

所 在	地 番	公簿地目	現況地目	地 積	所 有 者
前橋市六供町二丁目	29-保-6			36.00 m ²	

点 名	X 座標	Y 座標	辺 長	方 向 角	測 角	DX	倍 積 (Y×DX)
29-58	41591.681	-68250.723	4.076	77-35-24	90-17-13	-1.432	97735.035336
29-127	41592.557	-68246.742	10.950	77-34-51	179-59-27	3.231	-220505.223402
29-57	41594.912	-68236.048	2.395	356-25-57	98-51-06	4.745	-323780.047760
29-124	41597.302	-68236.197	15.406	257-34-56	81-08-59	-0.923	62982.009831
29-125	41593.989	-68251.243	2.366	167-18-11	89-43-15	-5.621	383640.236903
倍面積							72.010908
面 積							36.0054540

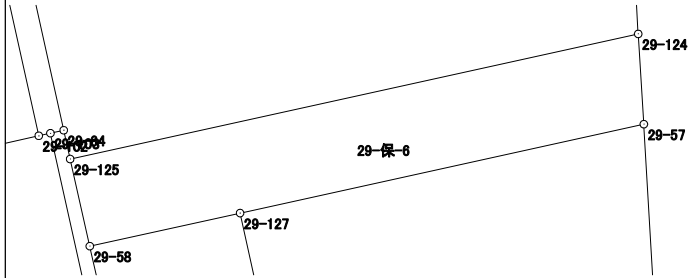


面積計算書（座標法）

世界測地系（測地成果2011）

所在	地番	公簿地目	現況地目	地積	所有者
前橋市六供町二丁目	29-保-8			48.00 m ²	

点名	X座標	Y座標	辺長	方向角	測角	DX	倍積 (Y×DX)
29-58	41591.681	-68250.723	2.366	347-18-11	179-43-11	14.049	-958854.407427
29-125	41593.989	-68251.243	0.781	347-21-07	180-02-56	3.070	-209531.316010
29-64	41594.751	-68251.414	0.361	257-30-20	90-09-13	0.684	-46683.967176
29-103	41594.673	-68251.766	11.168	167-31-37	90-01-17	-10.982	749540.894212
29-104	41583.769	-68249.354	10.610	257-34-25	270-02-48	-13.187	900004.231198
29-105	41581.486	-68259.715	4.000	167-33-18	89-58-53	-6.189	422459.376135
29-106	41577.580	-68258.853	10.972	77-34-44	90-01-26	-1.546	105528.186738
29-55	41579.940	-68248.138	12.022	347-35-00	90-00-16	14.101	-962366.993938

倍面積	96.003732
面積	48.0018660

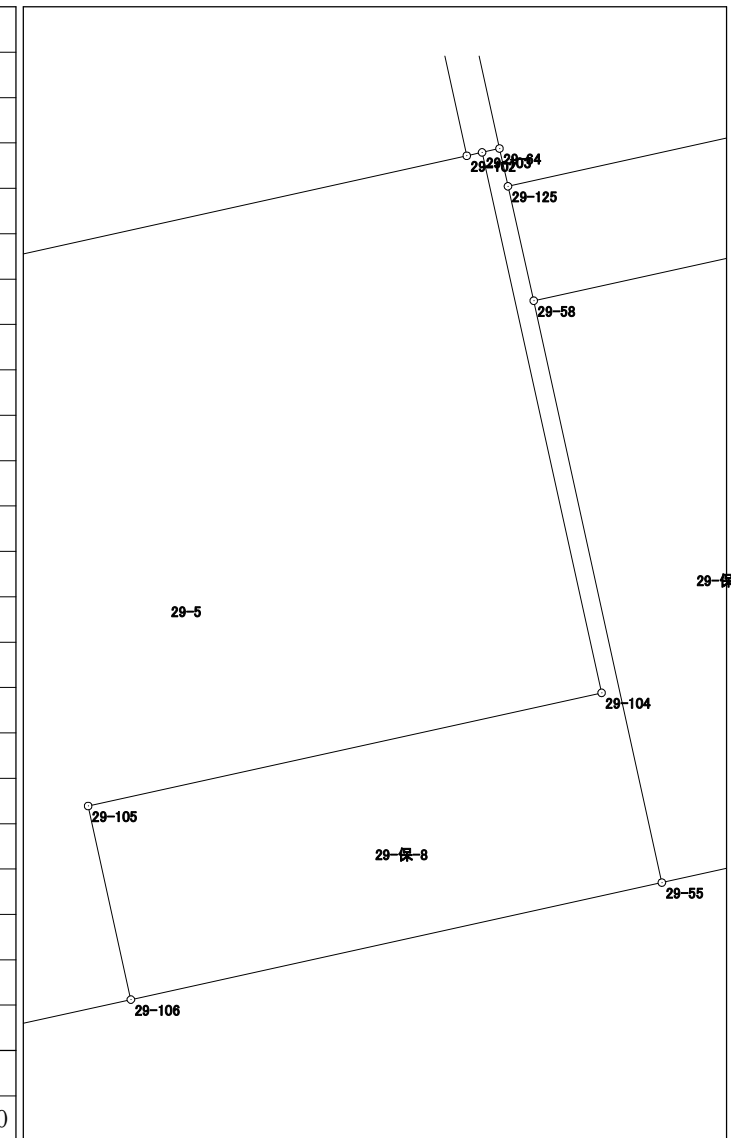

面積計算書（座標法）

世界測地系（測地成果2011）

所 在	地 番	公簿地目	現況地目	地 積	所 有 者
前橋市六供町二丁目	29-保-9			97.00 m ²	

点 名	X 座標	Y 座標	辺 長	方 向 角	測 角	DX	倍 積 (Y×DX)
29-47	41569.424	-68295.803	10.335	347-33-02	89-58-43	12.112	-827198.765936
29-111	41579.516	-68298.031	9.386	257-34-19	90-01-17	8.072	-551301.706232
29-112	41577.496	-68307.197	10.335	167-33-02	89-58-43	-12.112	827336.770064
29-113	41567.404	-68304.969	9.386	77-34-19	90-01-17	-8.072	551357.709768
倍面積						194.007664	
面 積						97.0038320	

